




BEGIN APPROACH STA 15+87 16+00

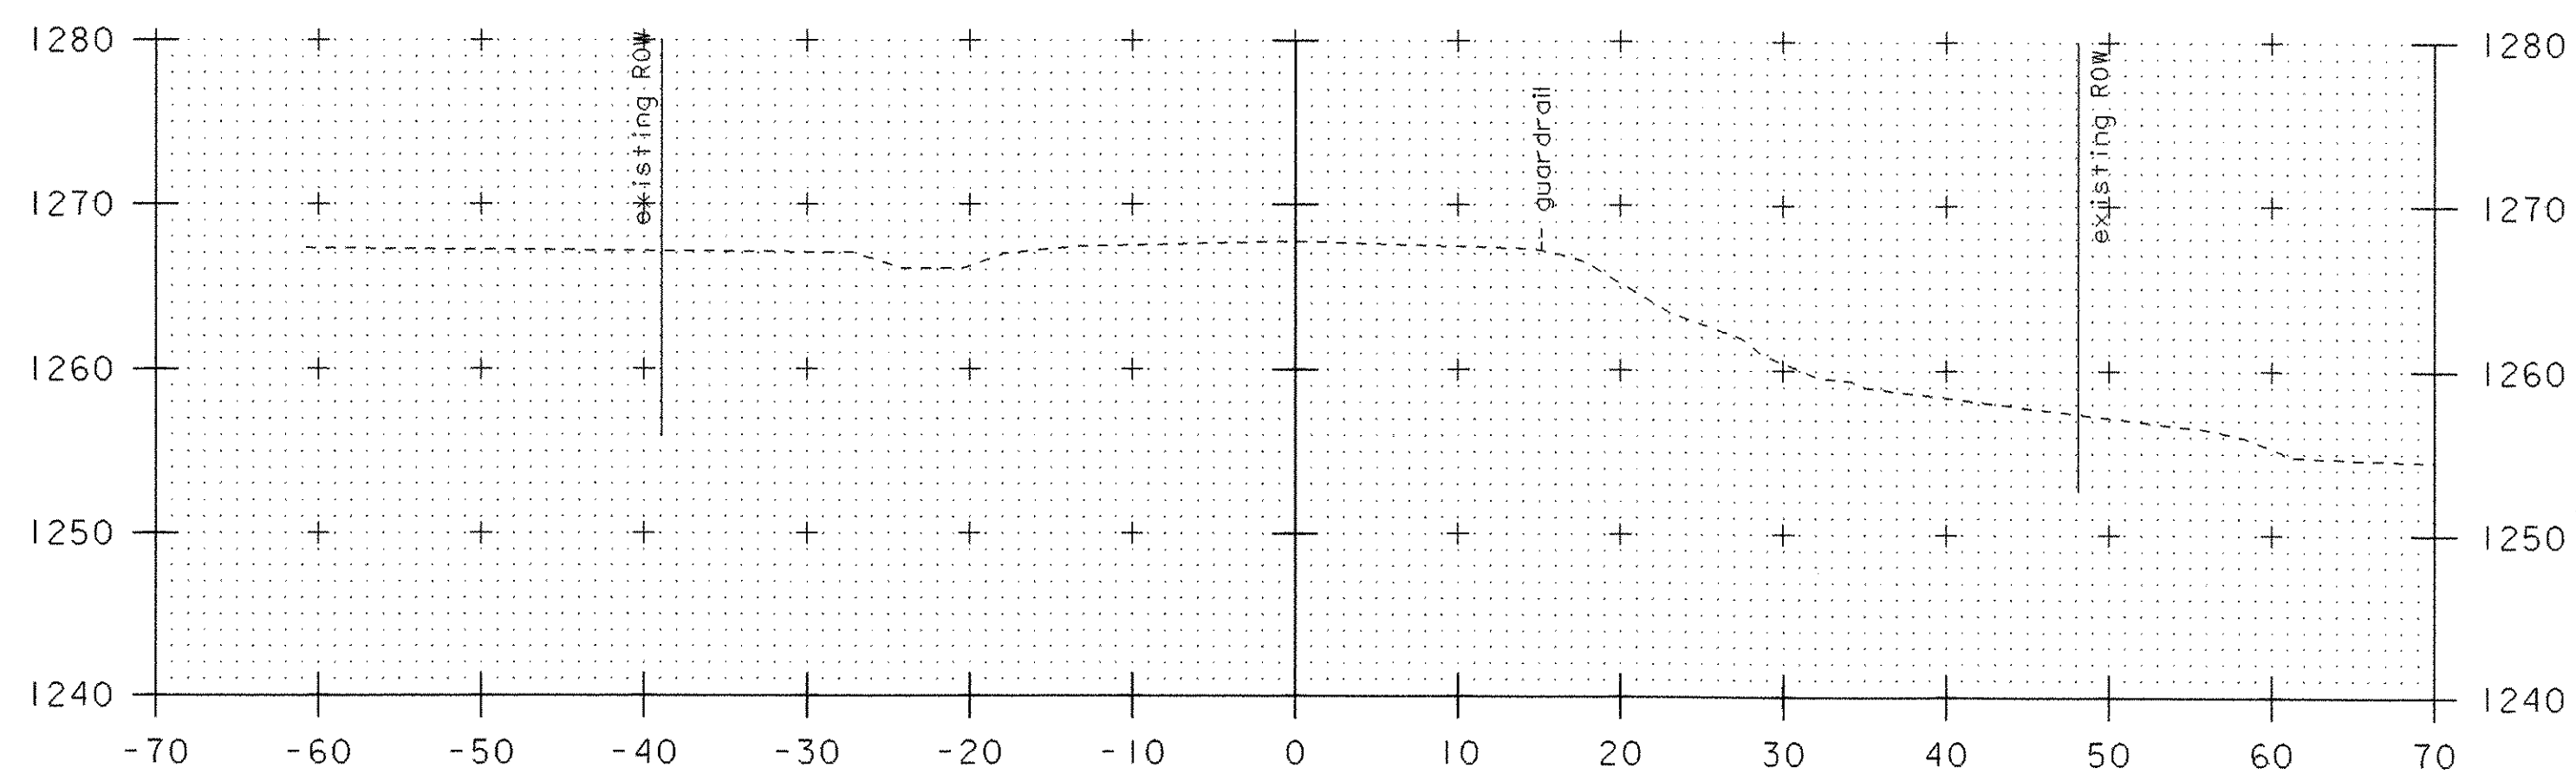


15+75

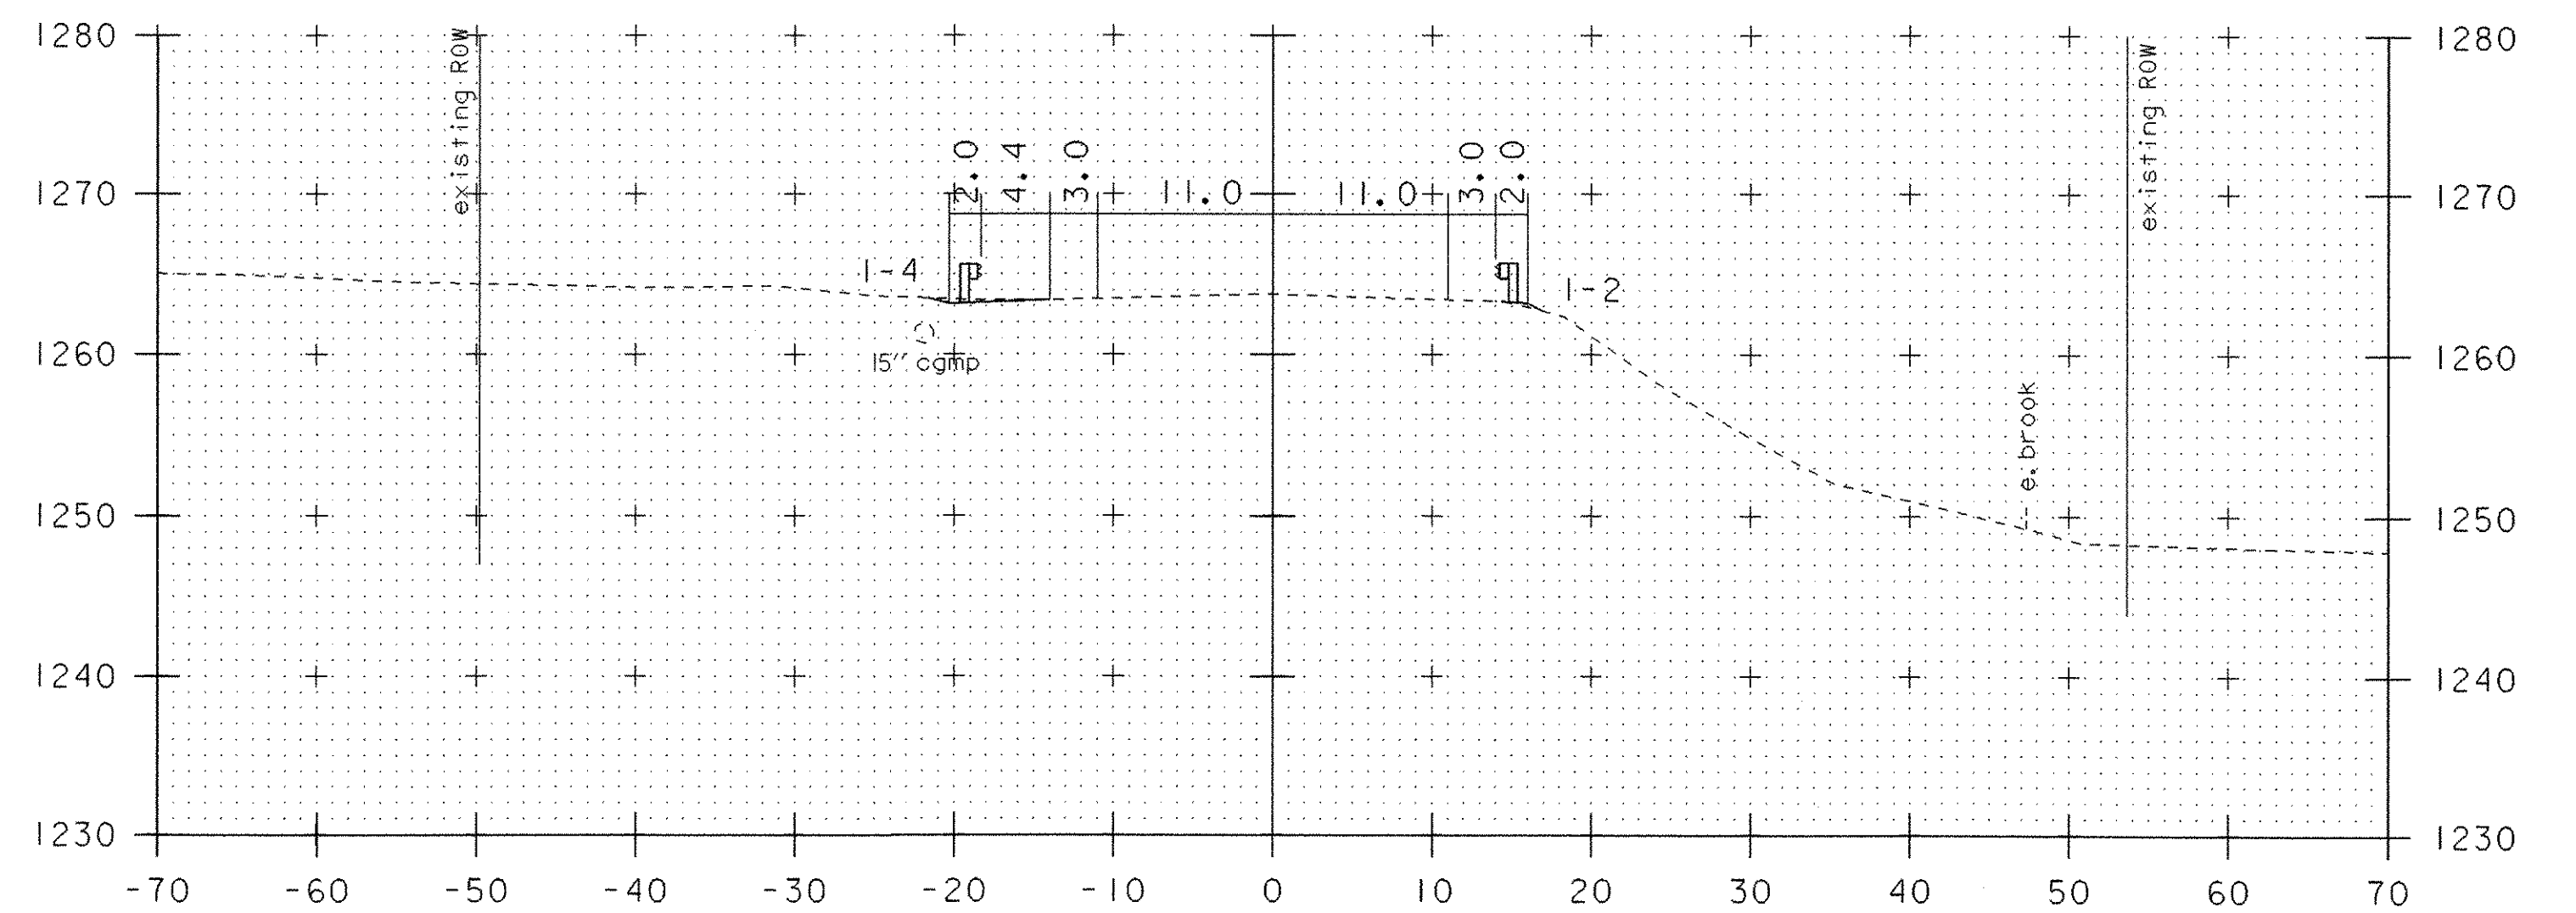

16+50

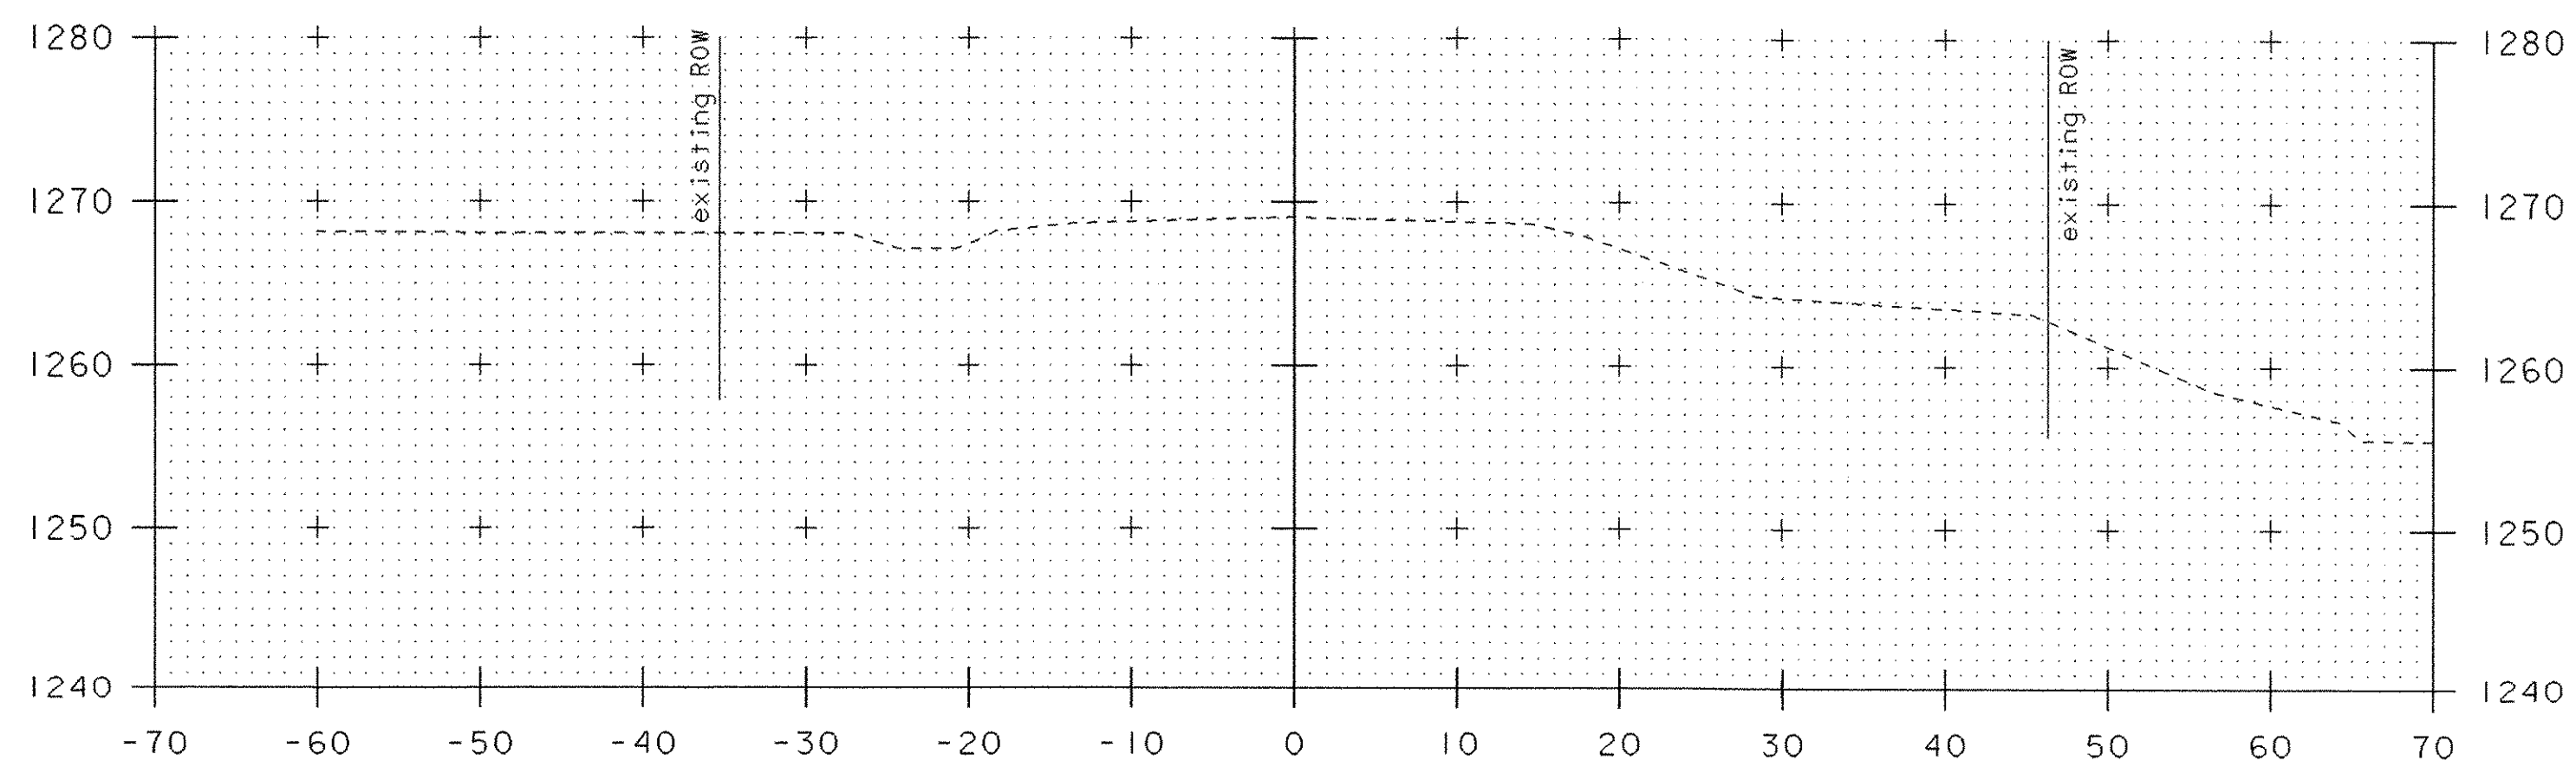

15+50

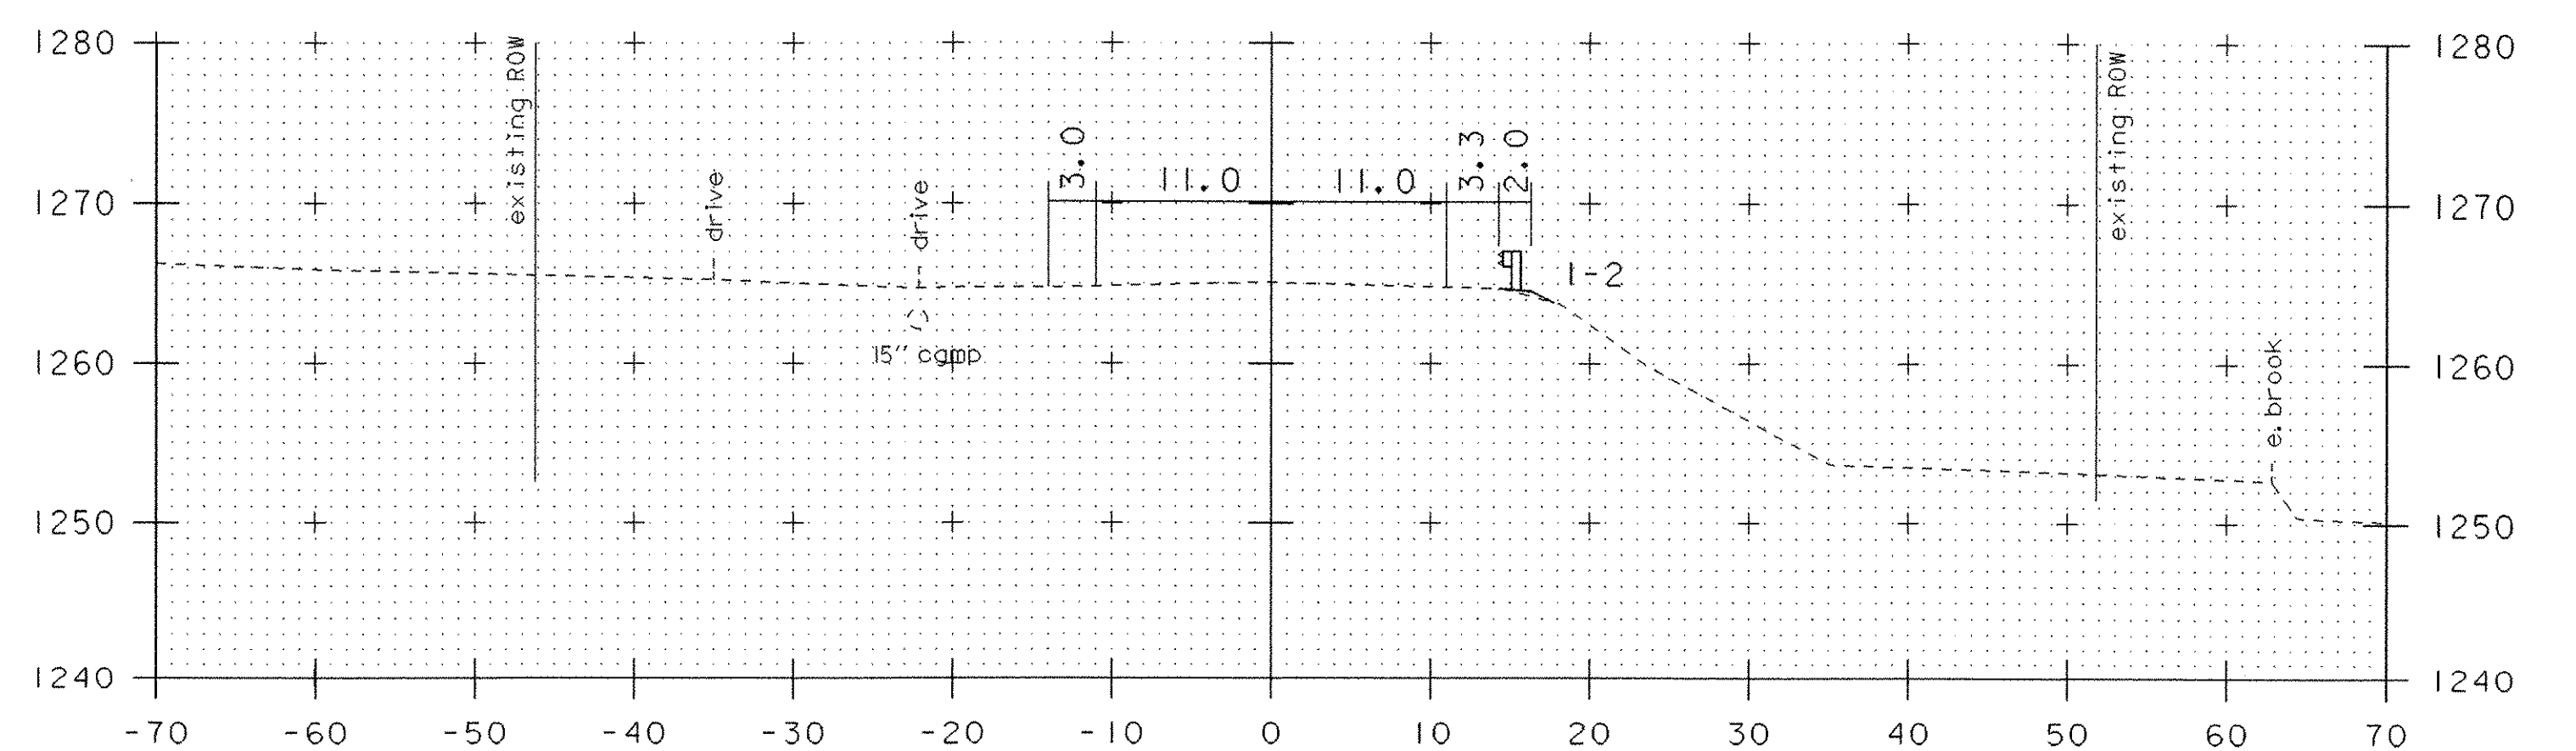

16+25

**MAINLINE CROSS SECTIONS**

PROJECT NAME:	JAY	PLOT DATE:	23-OCT-2006
PROJECT NUMBER:	ST STP CULV (2)	DRAWN BY:	G. SHANGRAW
FILE NAME:	04b140\s04b140bdr.dgn	CHECKED BY:	J. LACROIX
PROJECT LEADER:	W. SYMONDS	SHEET	33 OF 39
DESIGNED BY:	T. SUMNER		
	04b140xsl1		