




52+20

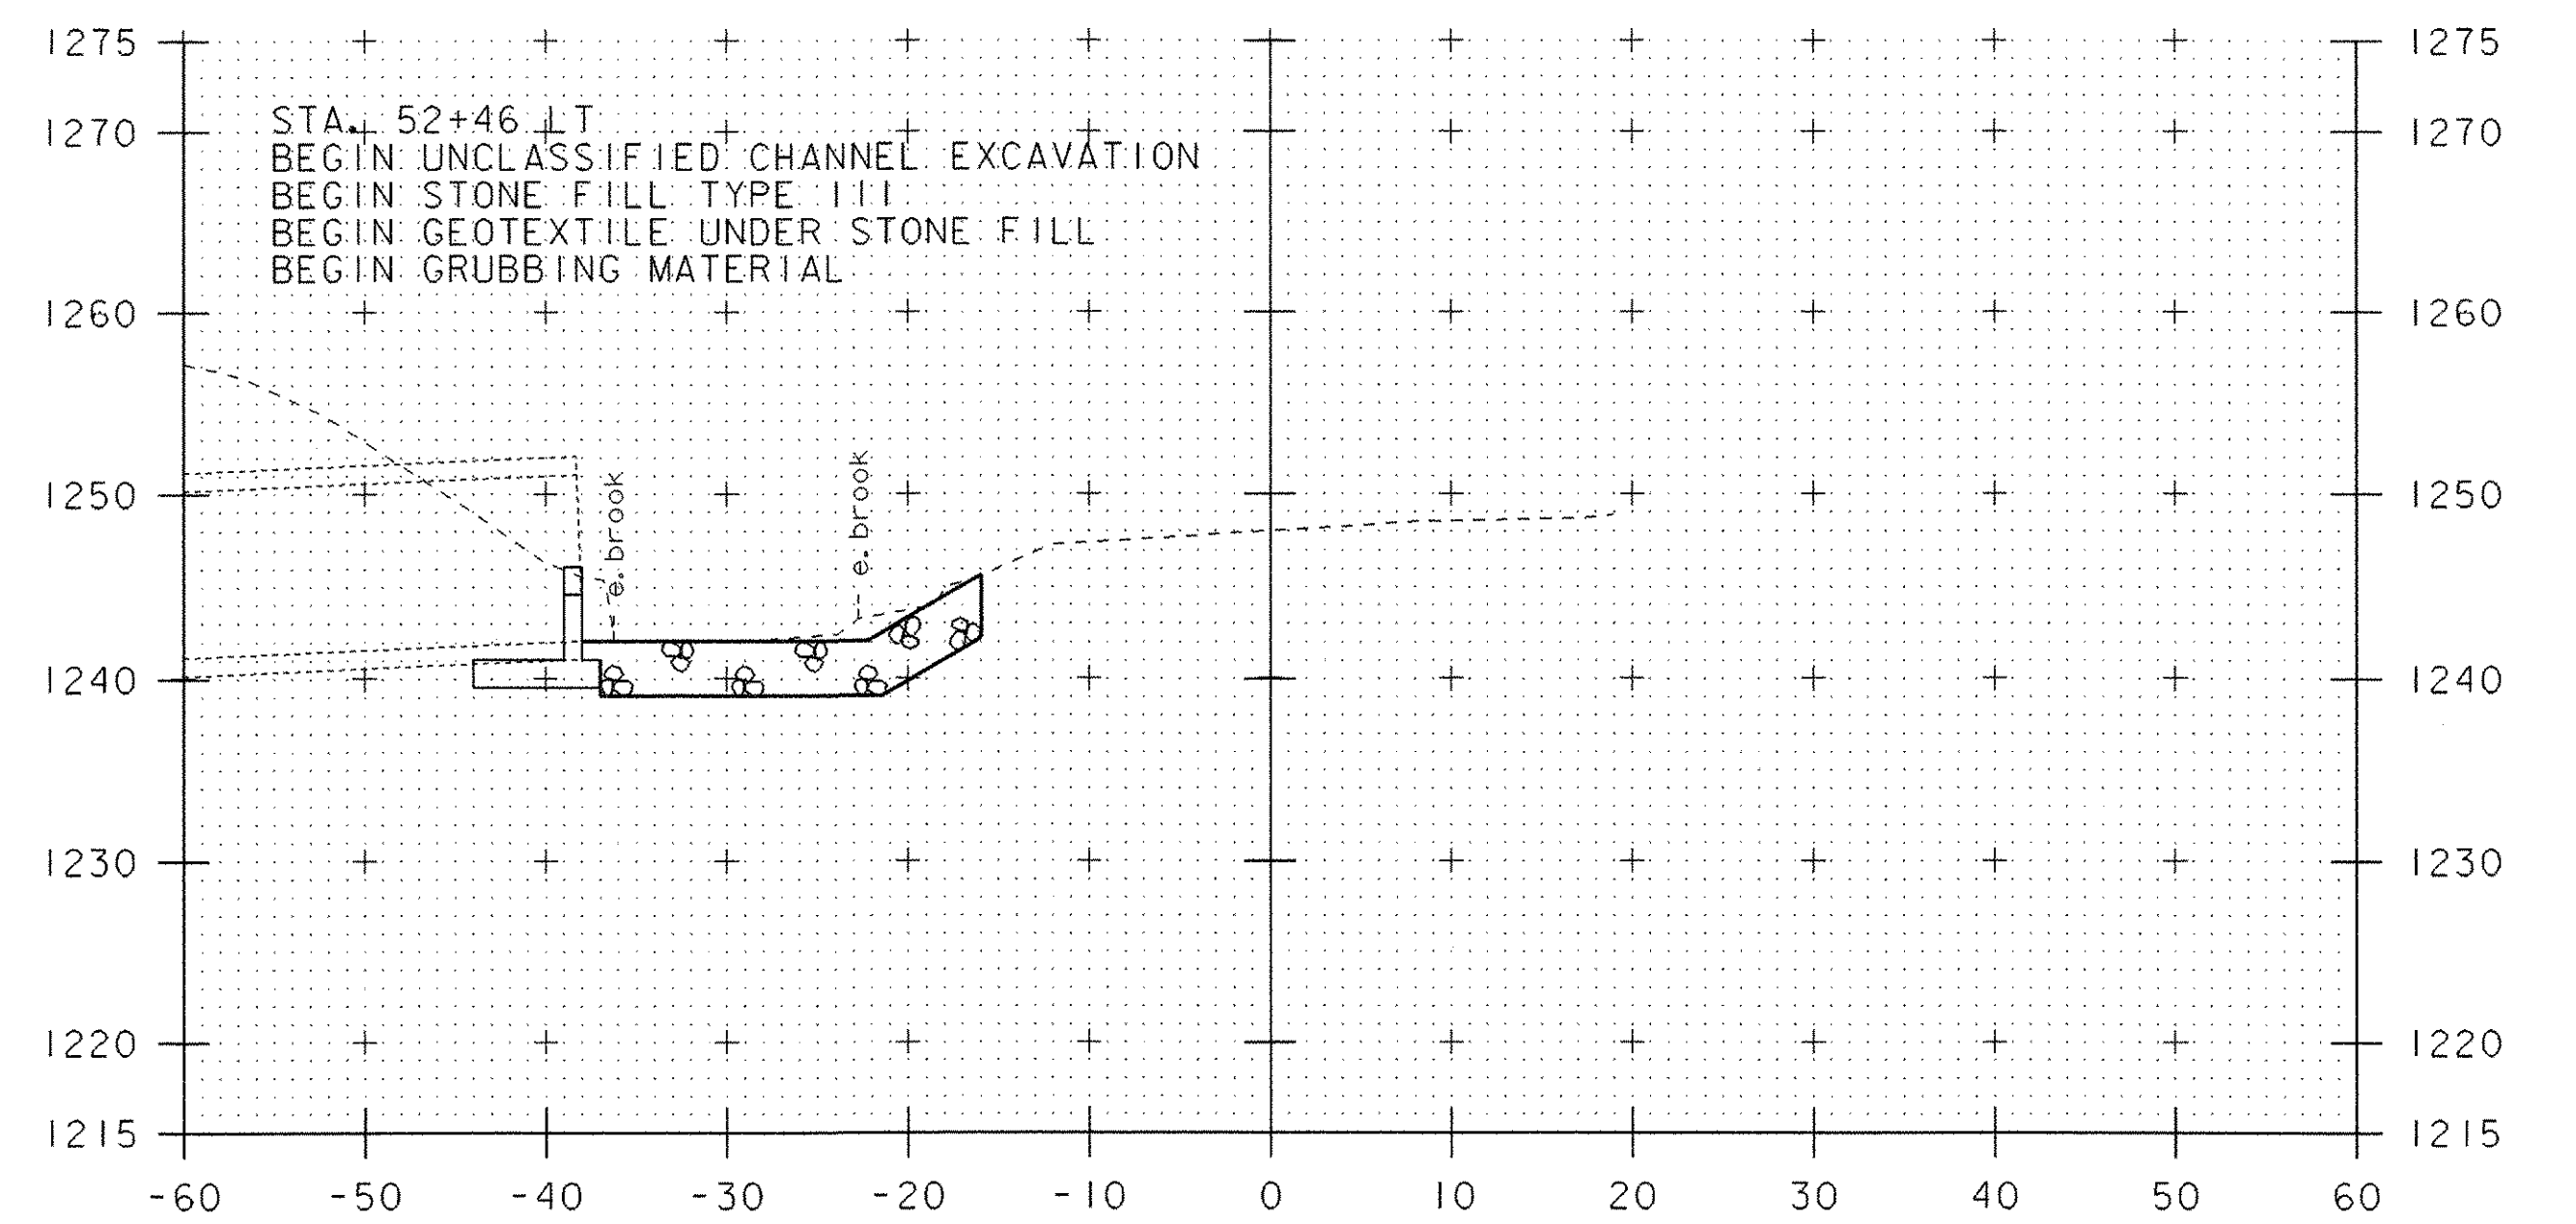

52+60

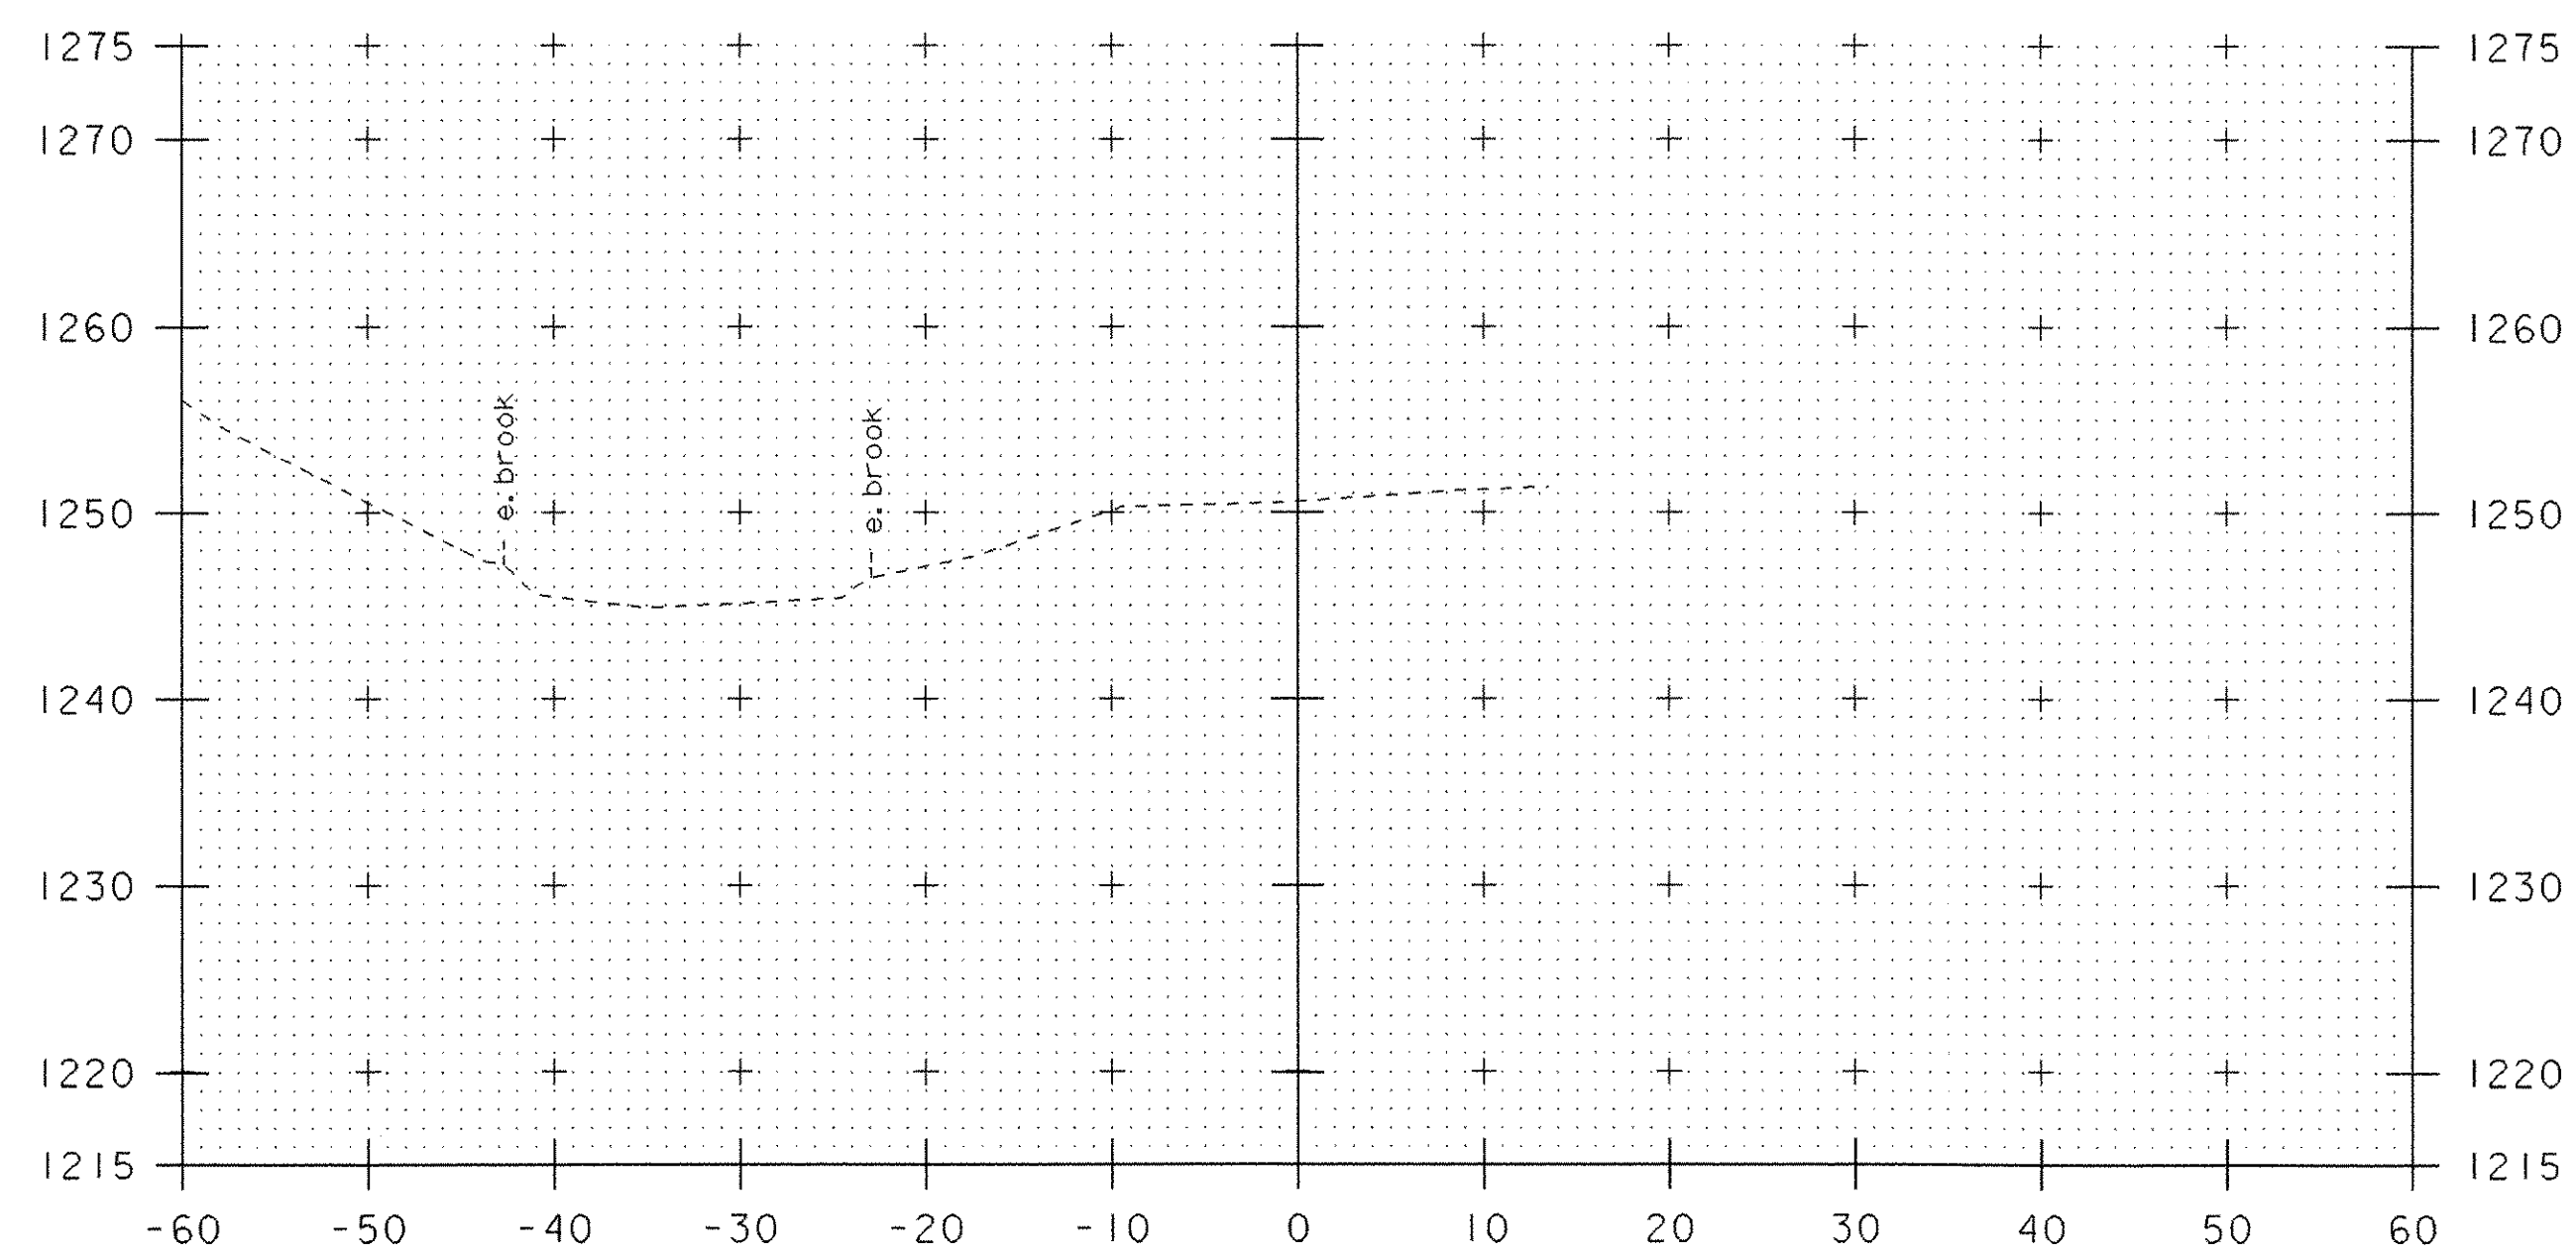

52+00

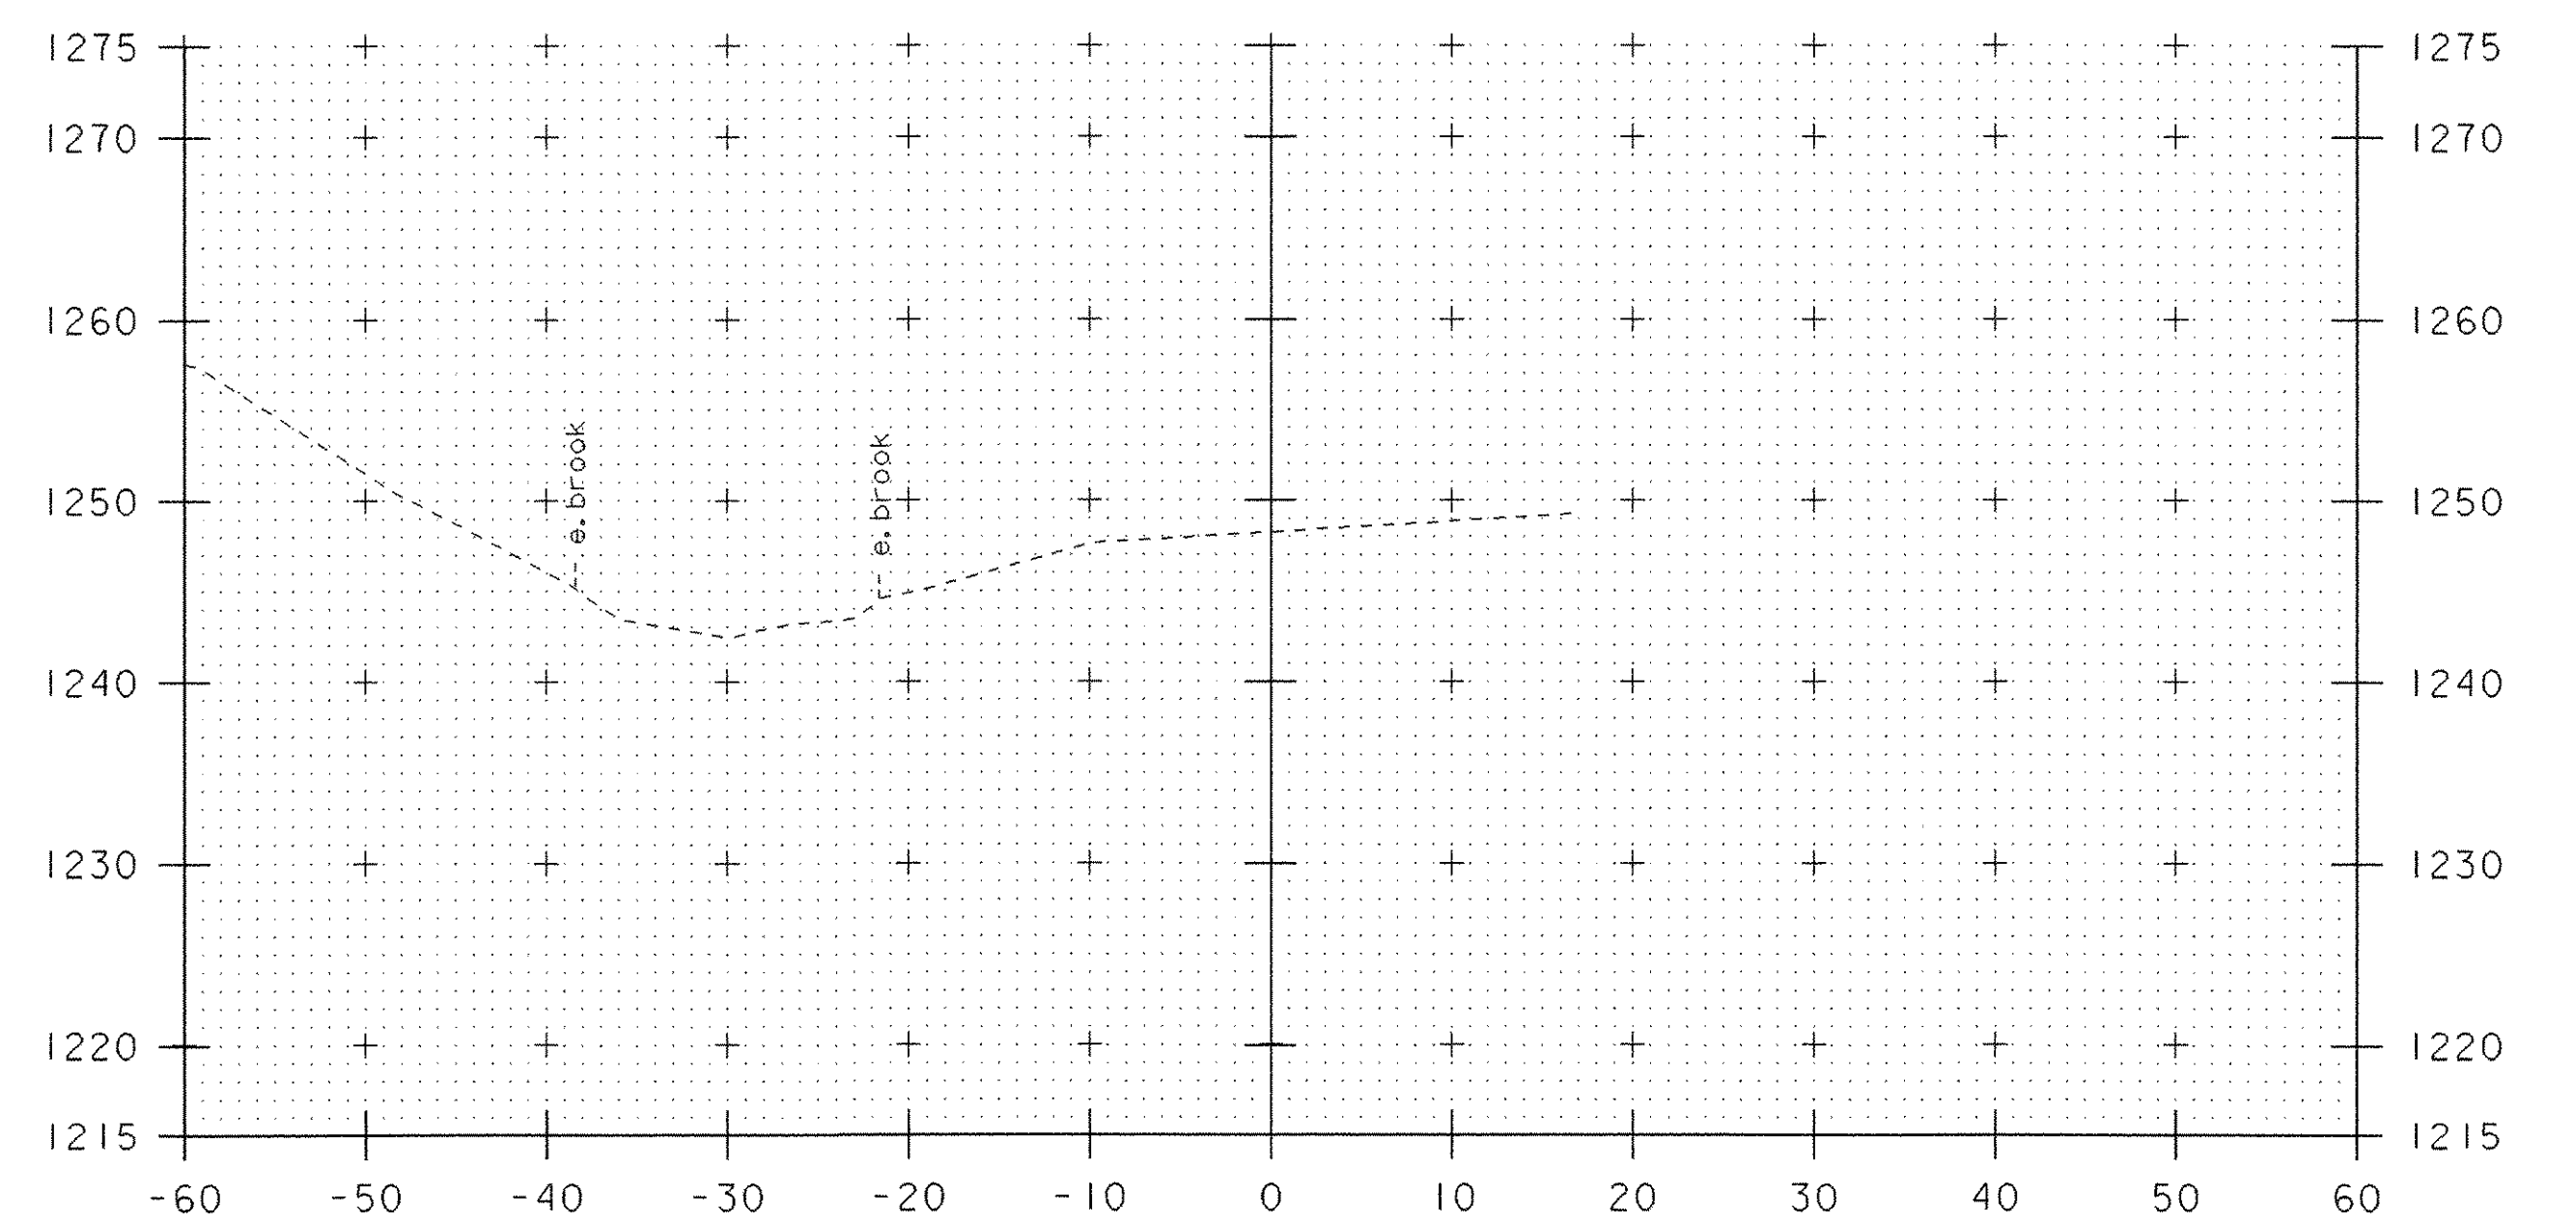

52+40

CHANNEL CROSS SECTIONS

PROJECT NAME:	JAY
PROJECT NUMBER:	ST STP CULV (2)
FILE NAME:	04bl40\s04bl40bdr.dgn
PROJECT LEADER:	W. SYMONDS
DESIGNED BY:	T. SUMNER
04bl40chxsl.i	
PLOT DATE:	23-OCT-2006
DRAWN BY:	G. SHANGRAW
CHECKED BY:	J. LACROIX
SHEET	36 OF 39