




53+00

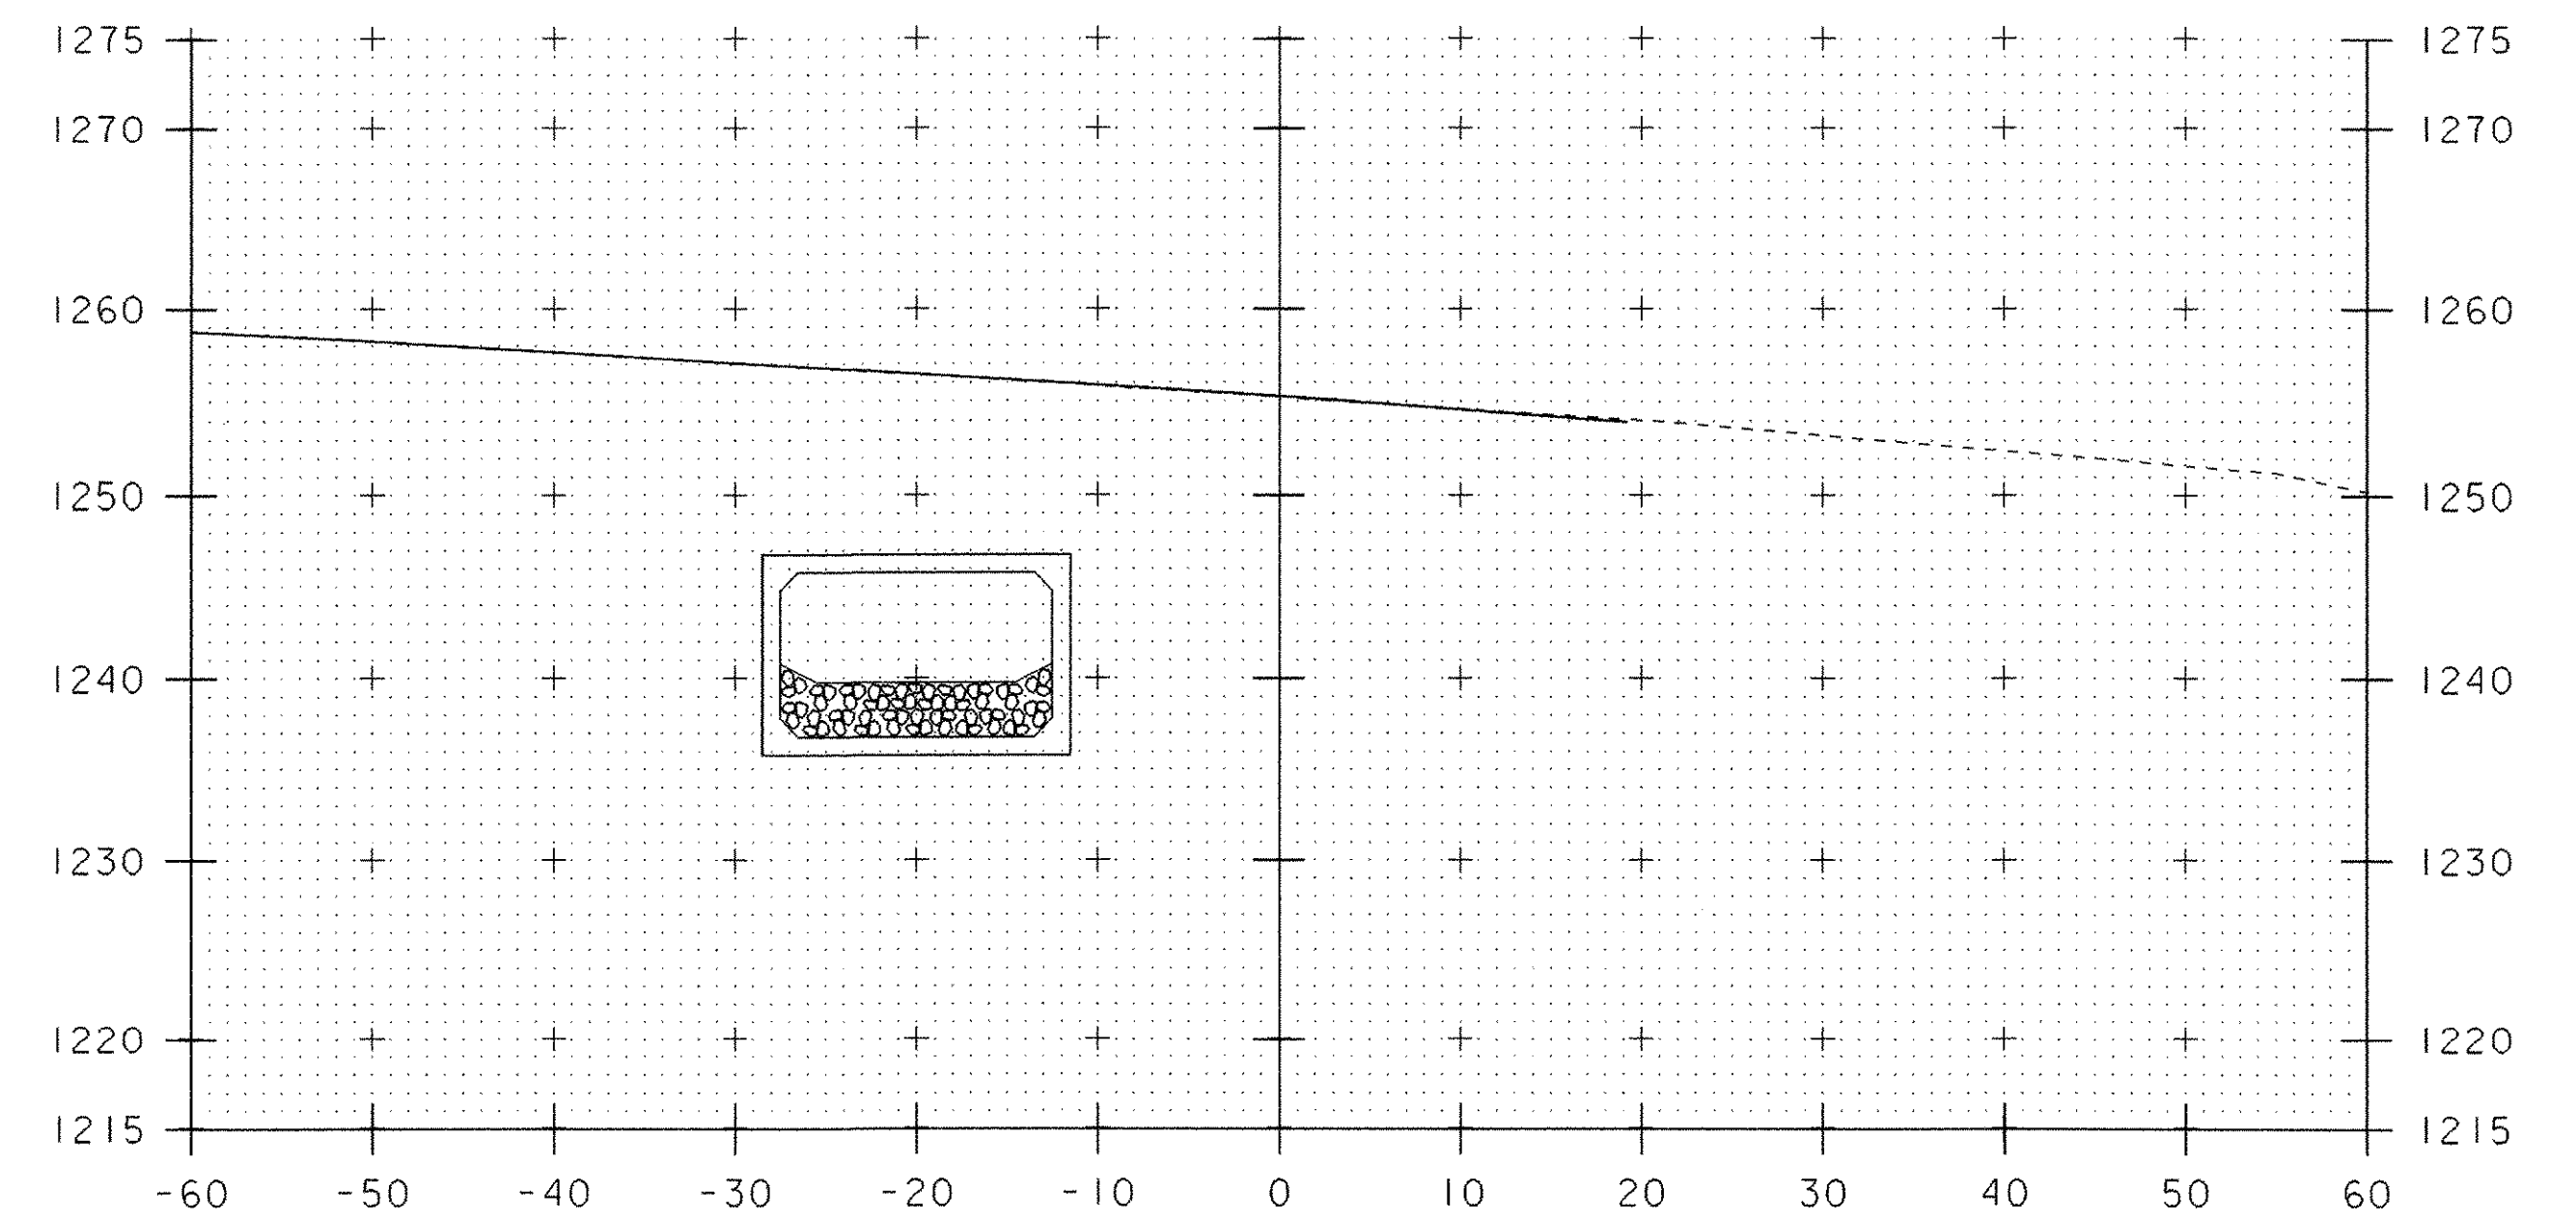

53+40

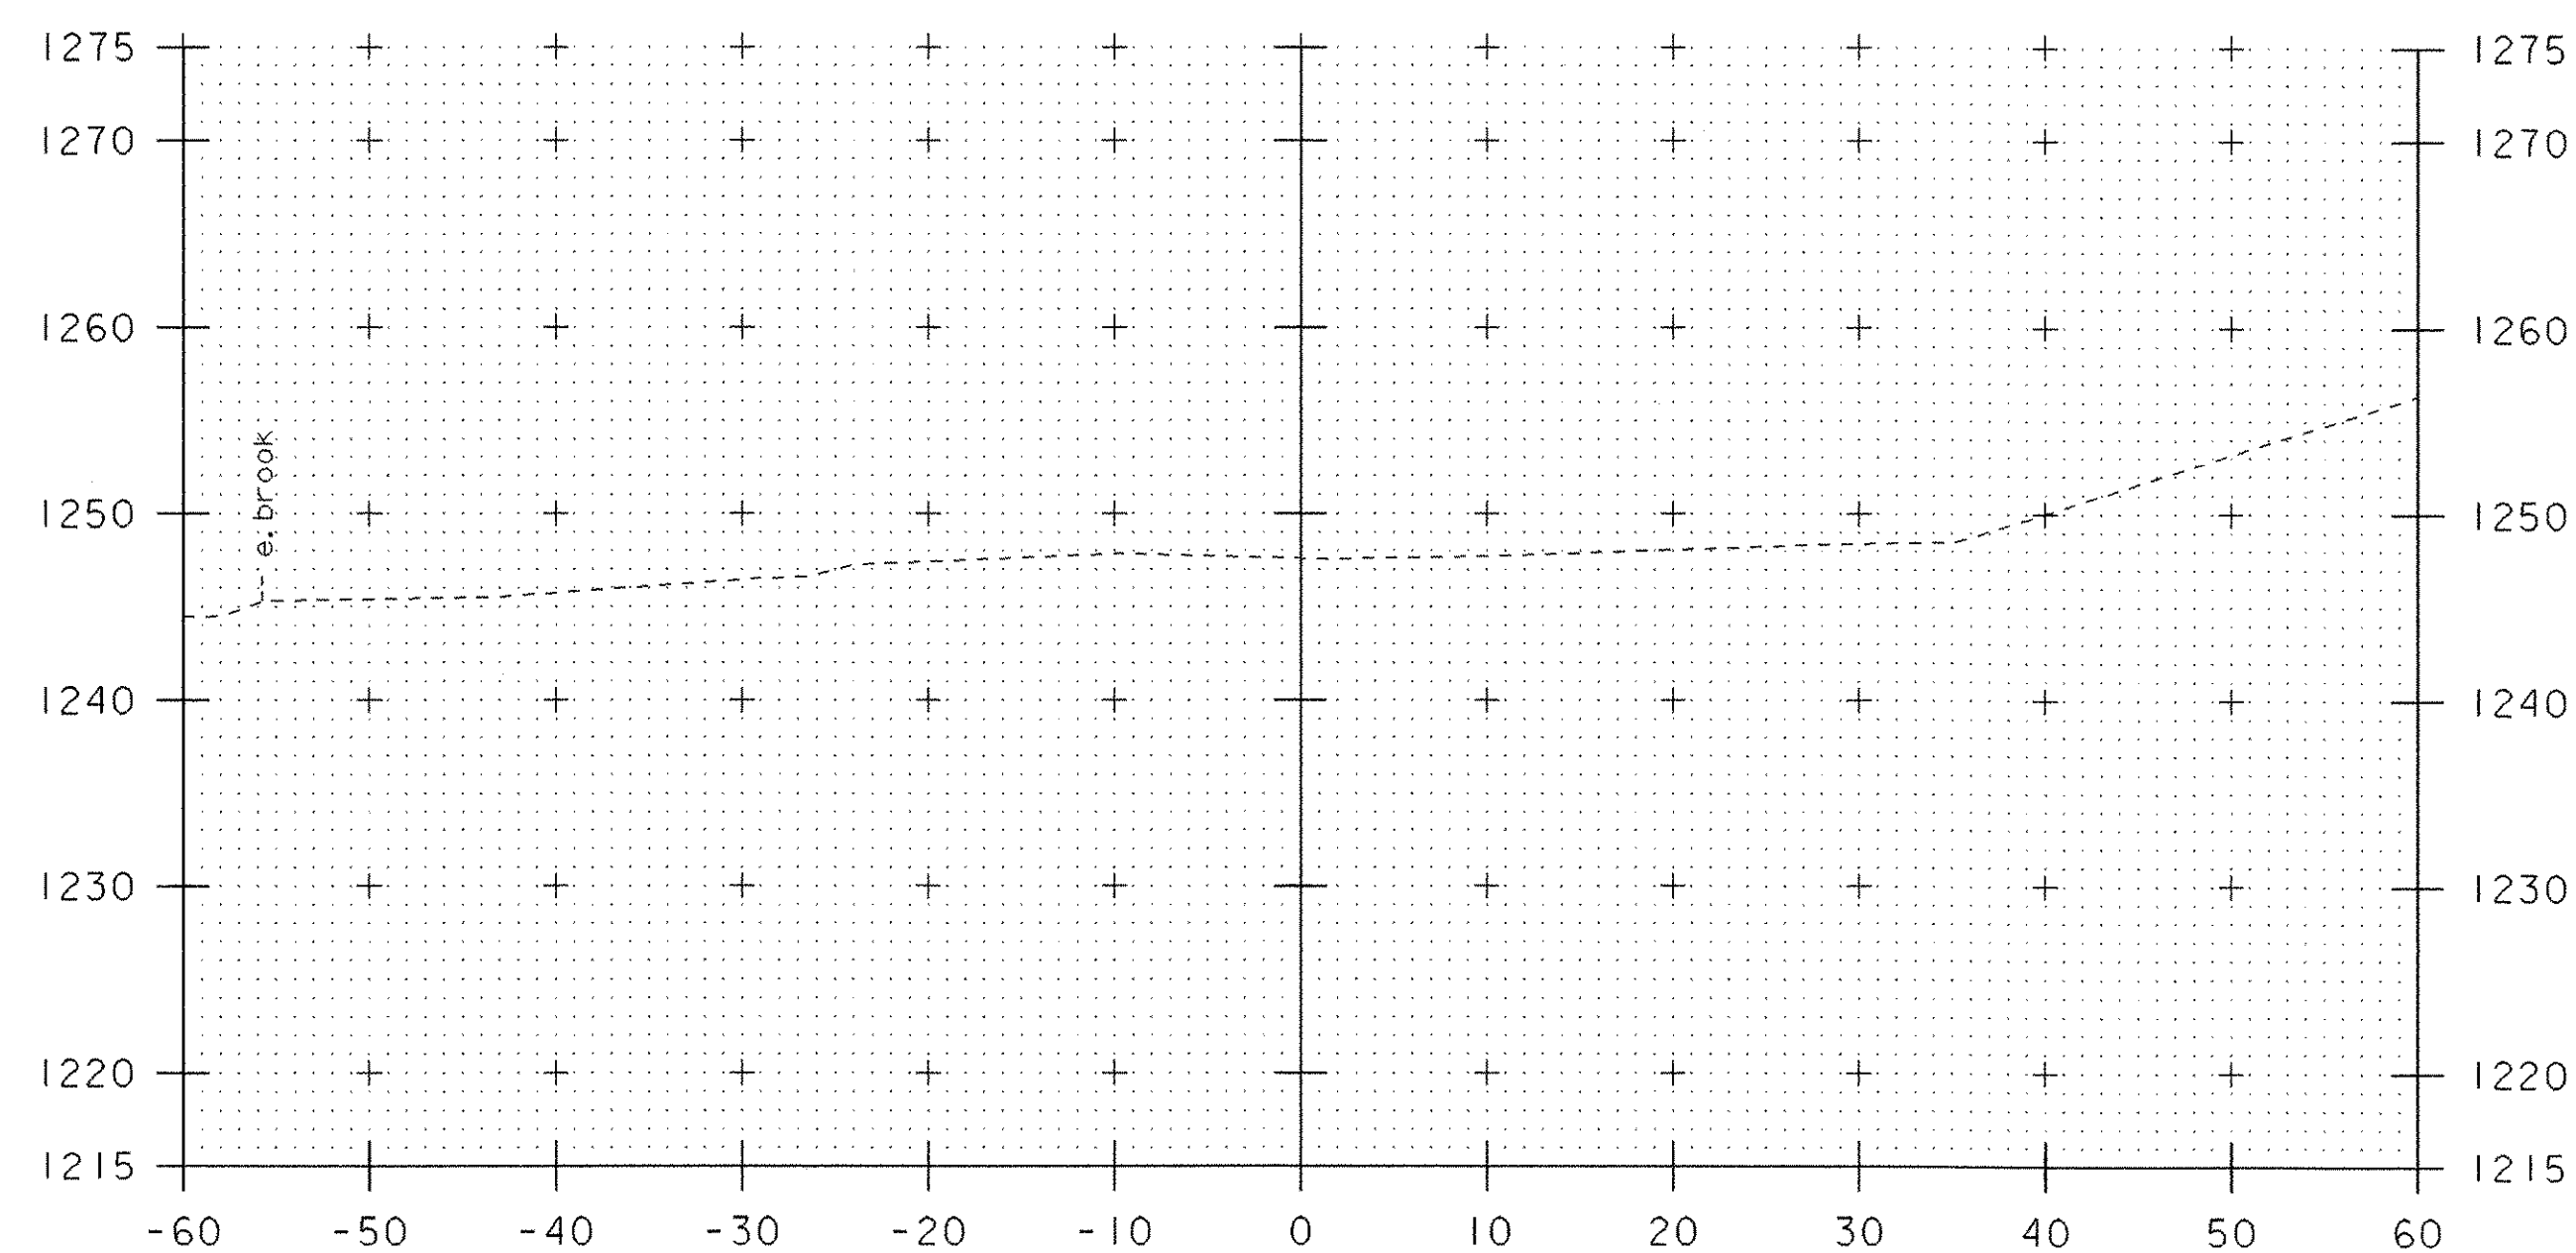

52+80

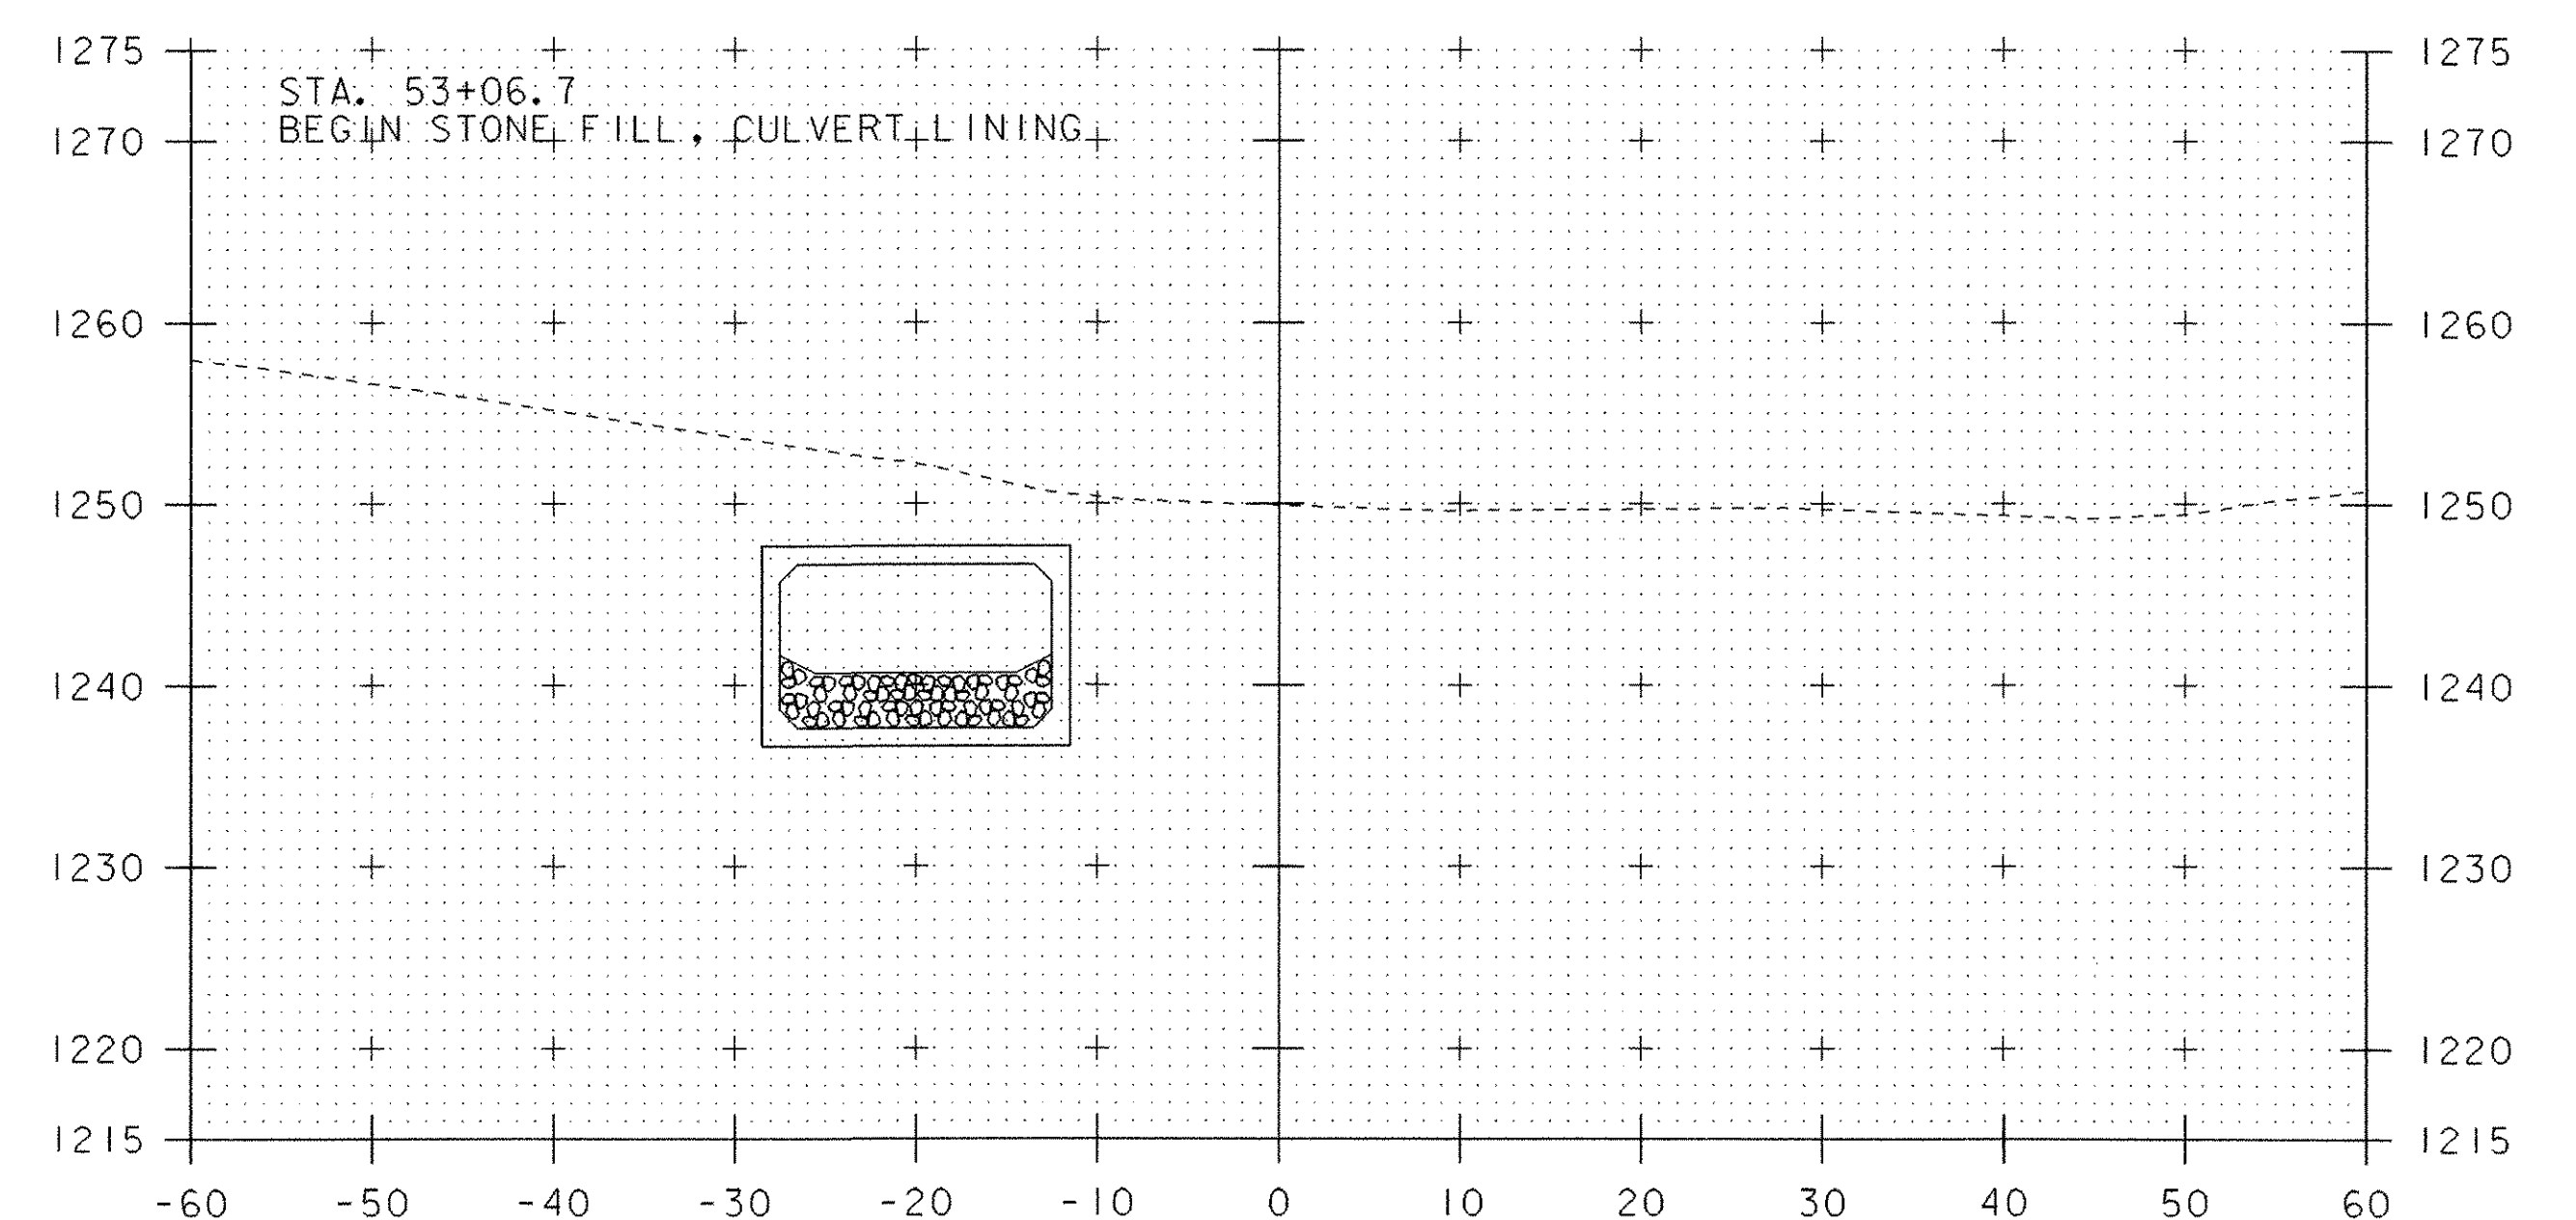

53+20

53+06.7  
 BEGIN BOX

**CHANNEL CROSS SECTIONS**

PROJECT NAME:	JAY	FILE NAME:	04b140\s04b140bdr.dgn	PLOT DATE:	23-OCT-2006
PROJECT NUMBER:	ST STP CULV (2)	PROJECT LEADER:	W. SYMONDS	DRAWN BY:	G. SHANGRAW
		DESIGNED BY:	T. SUMNER	CHECKED BY:	J. LACROIX
			04b140chxs2.i		SHEET 37 OF 39