




53+80

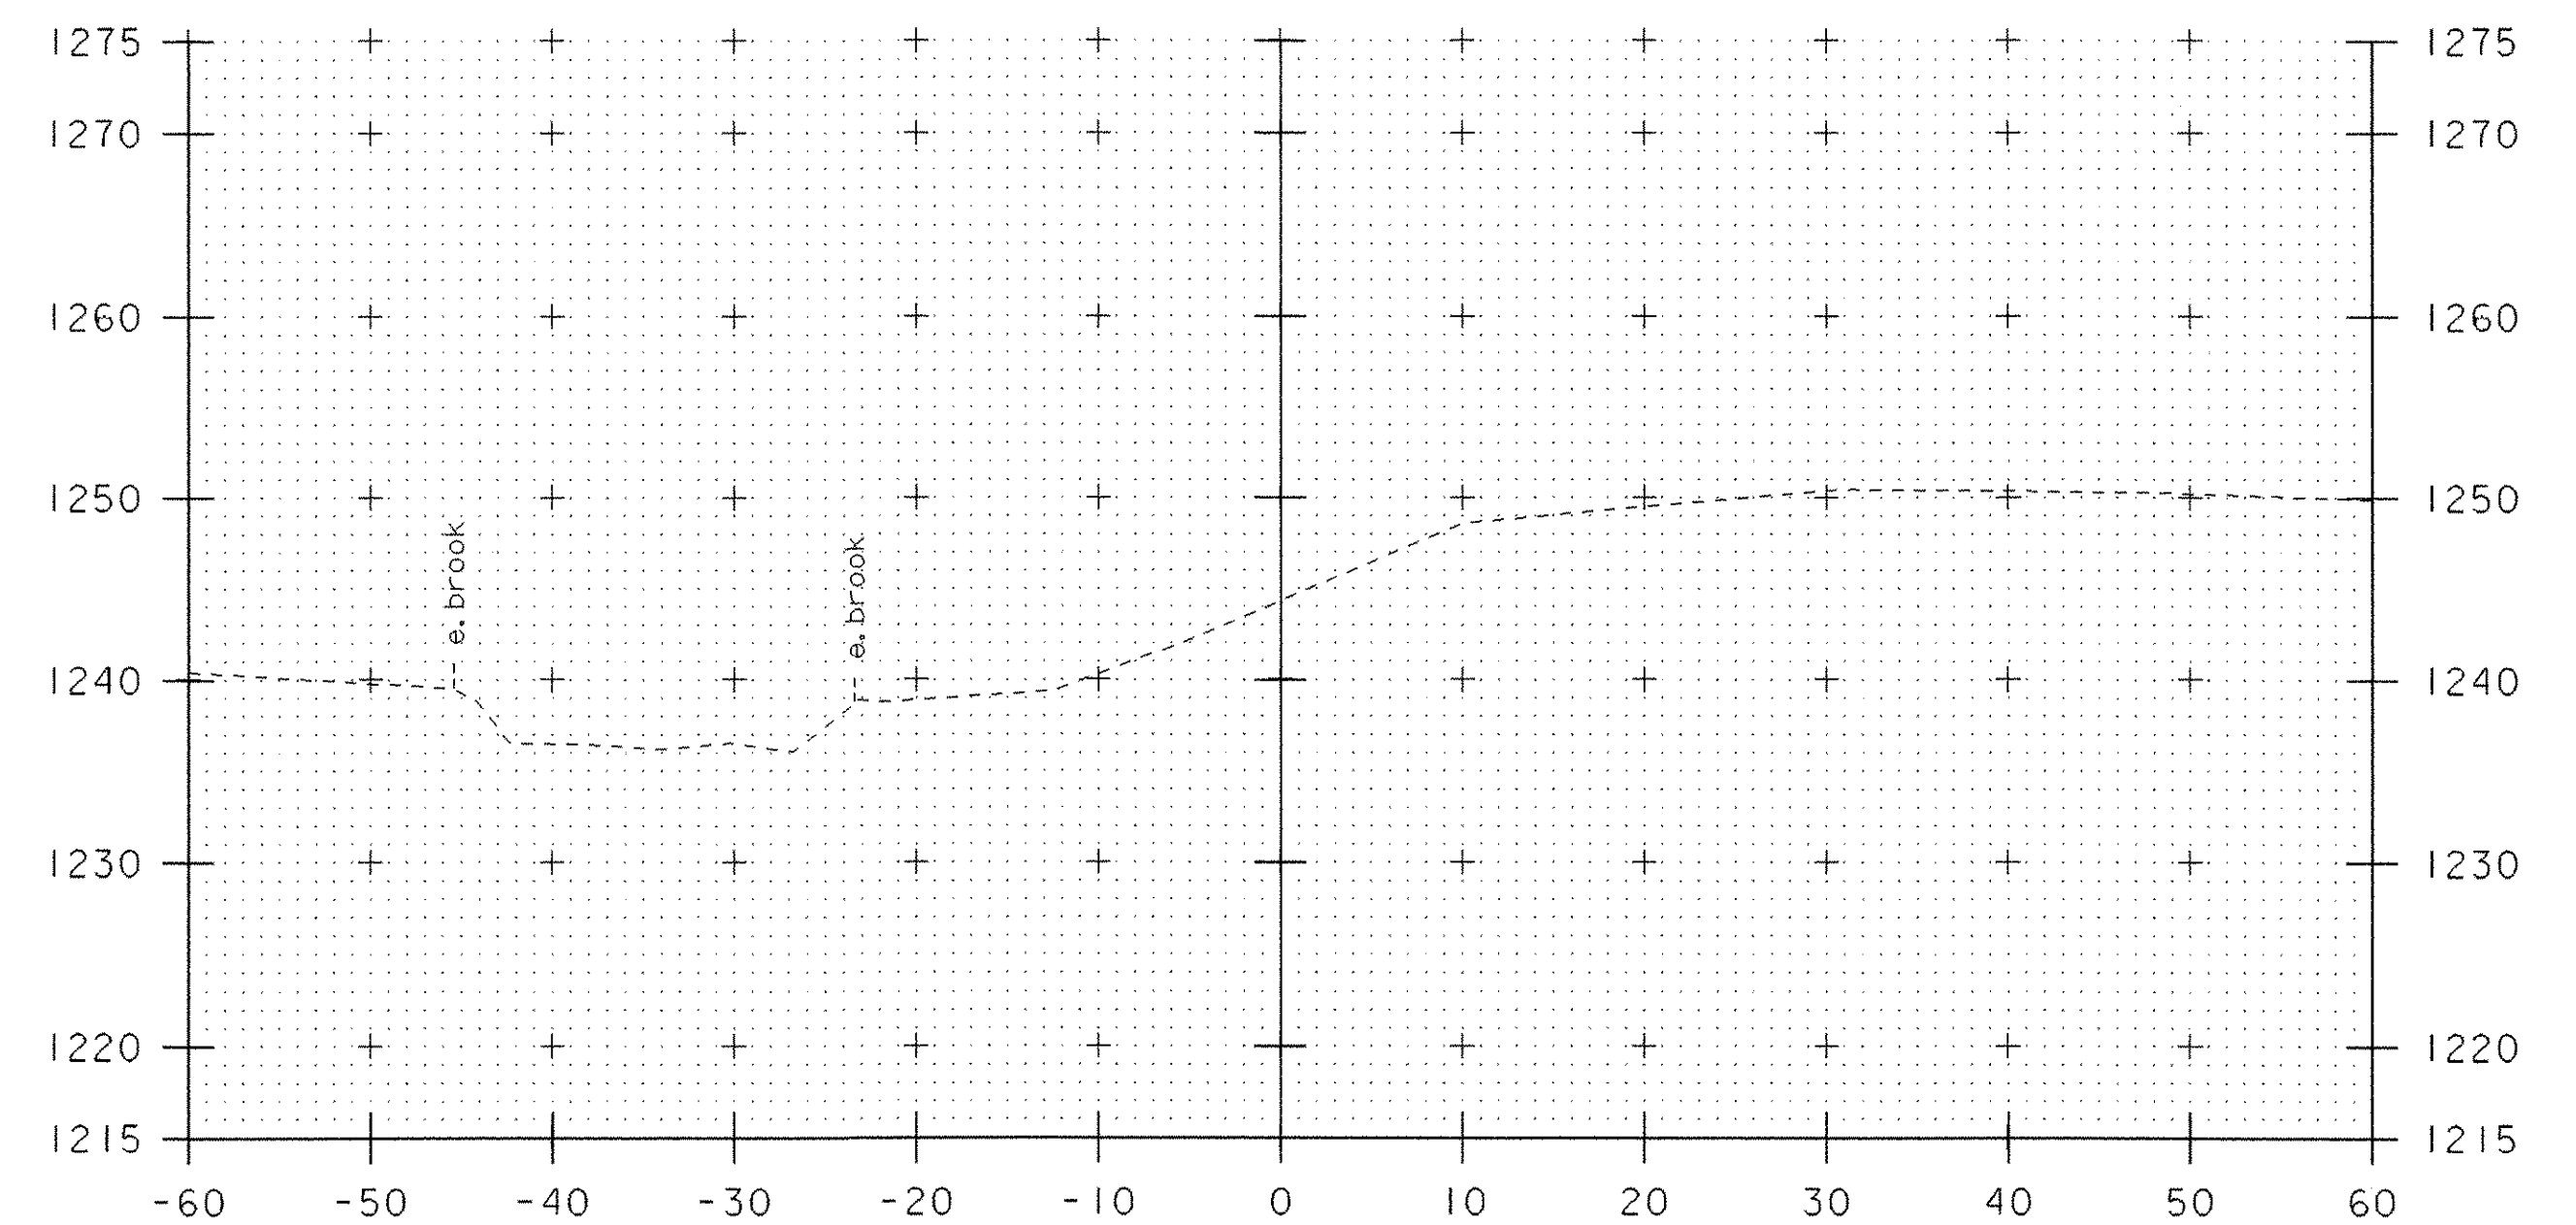

54+20

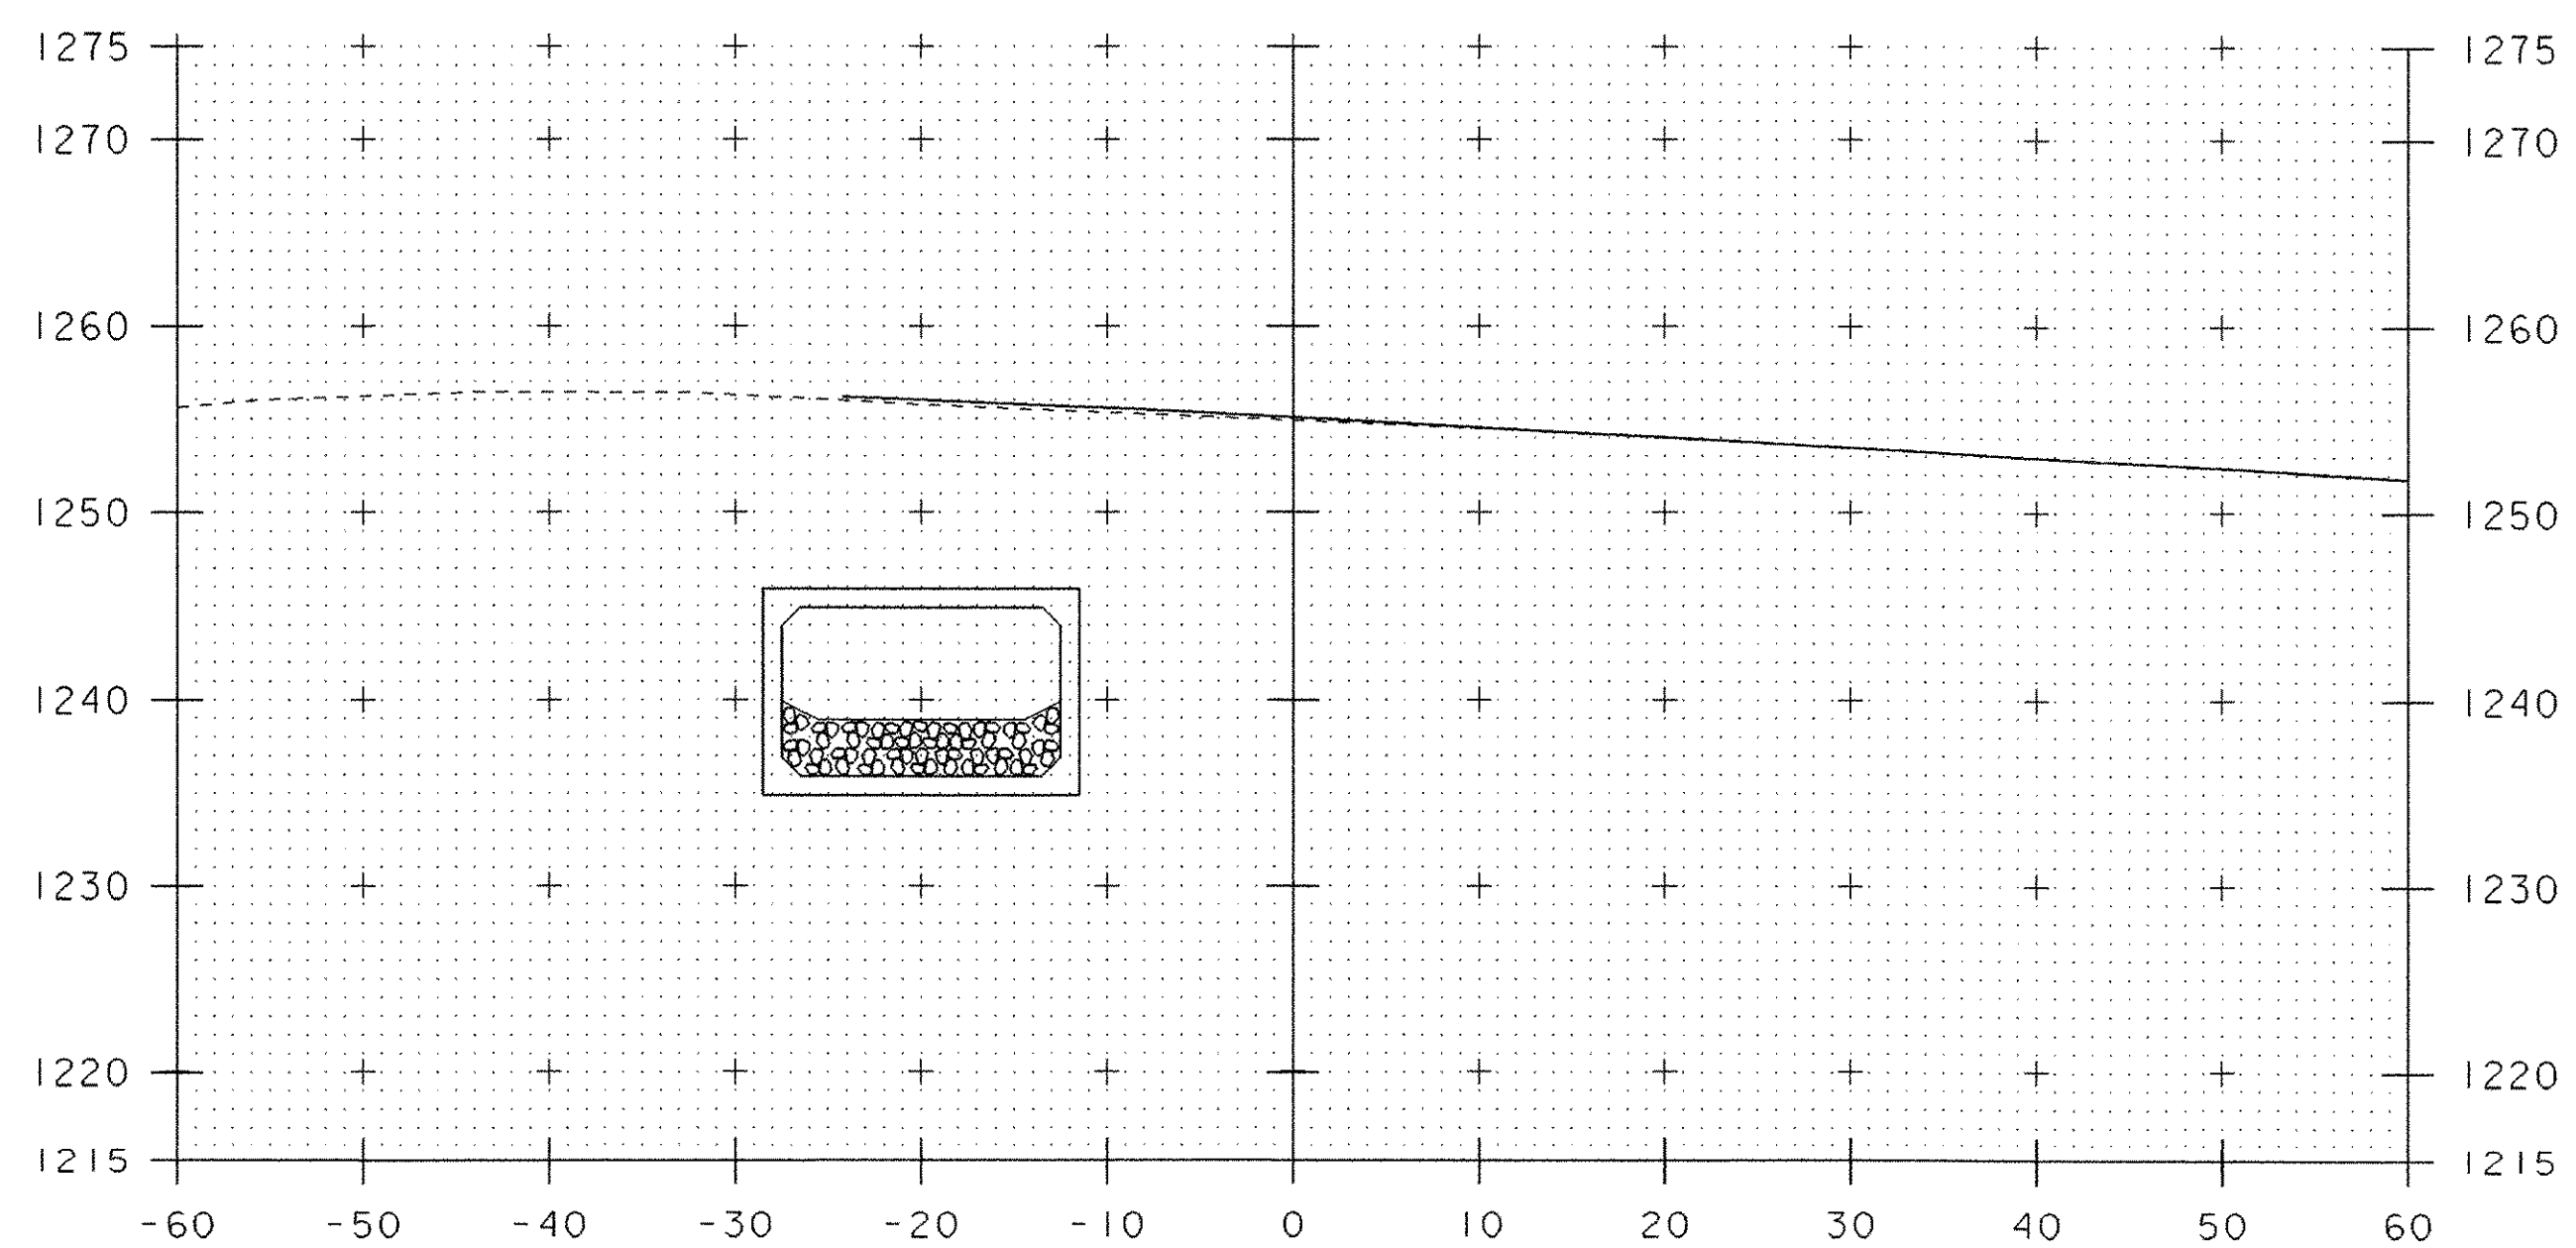

53+60

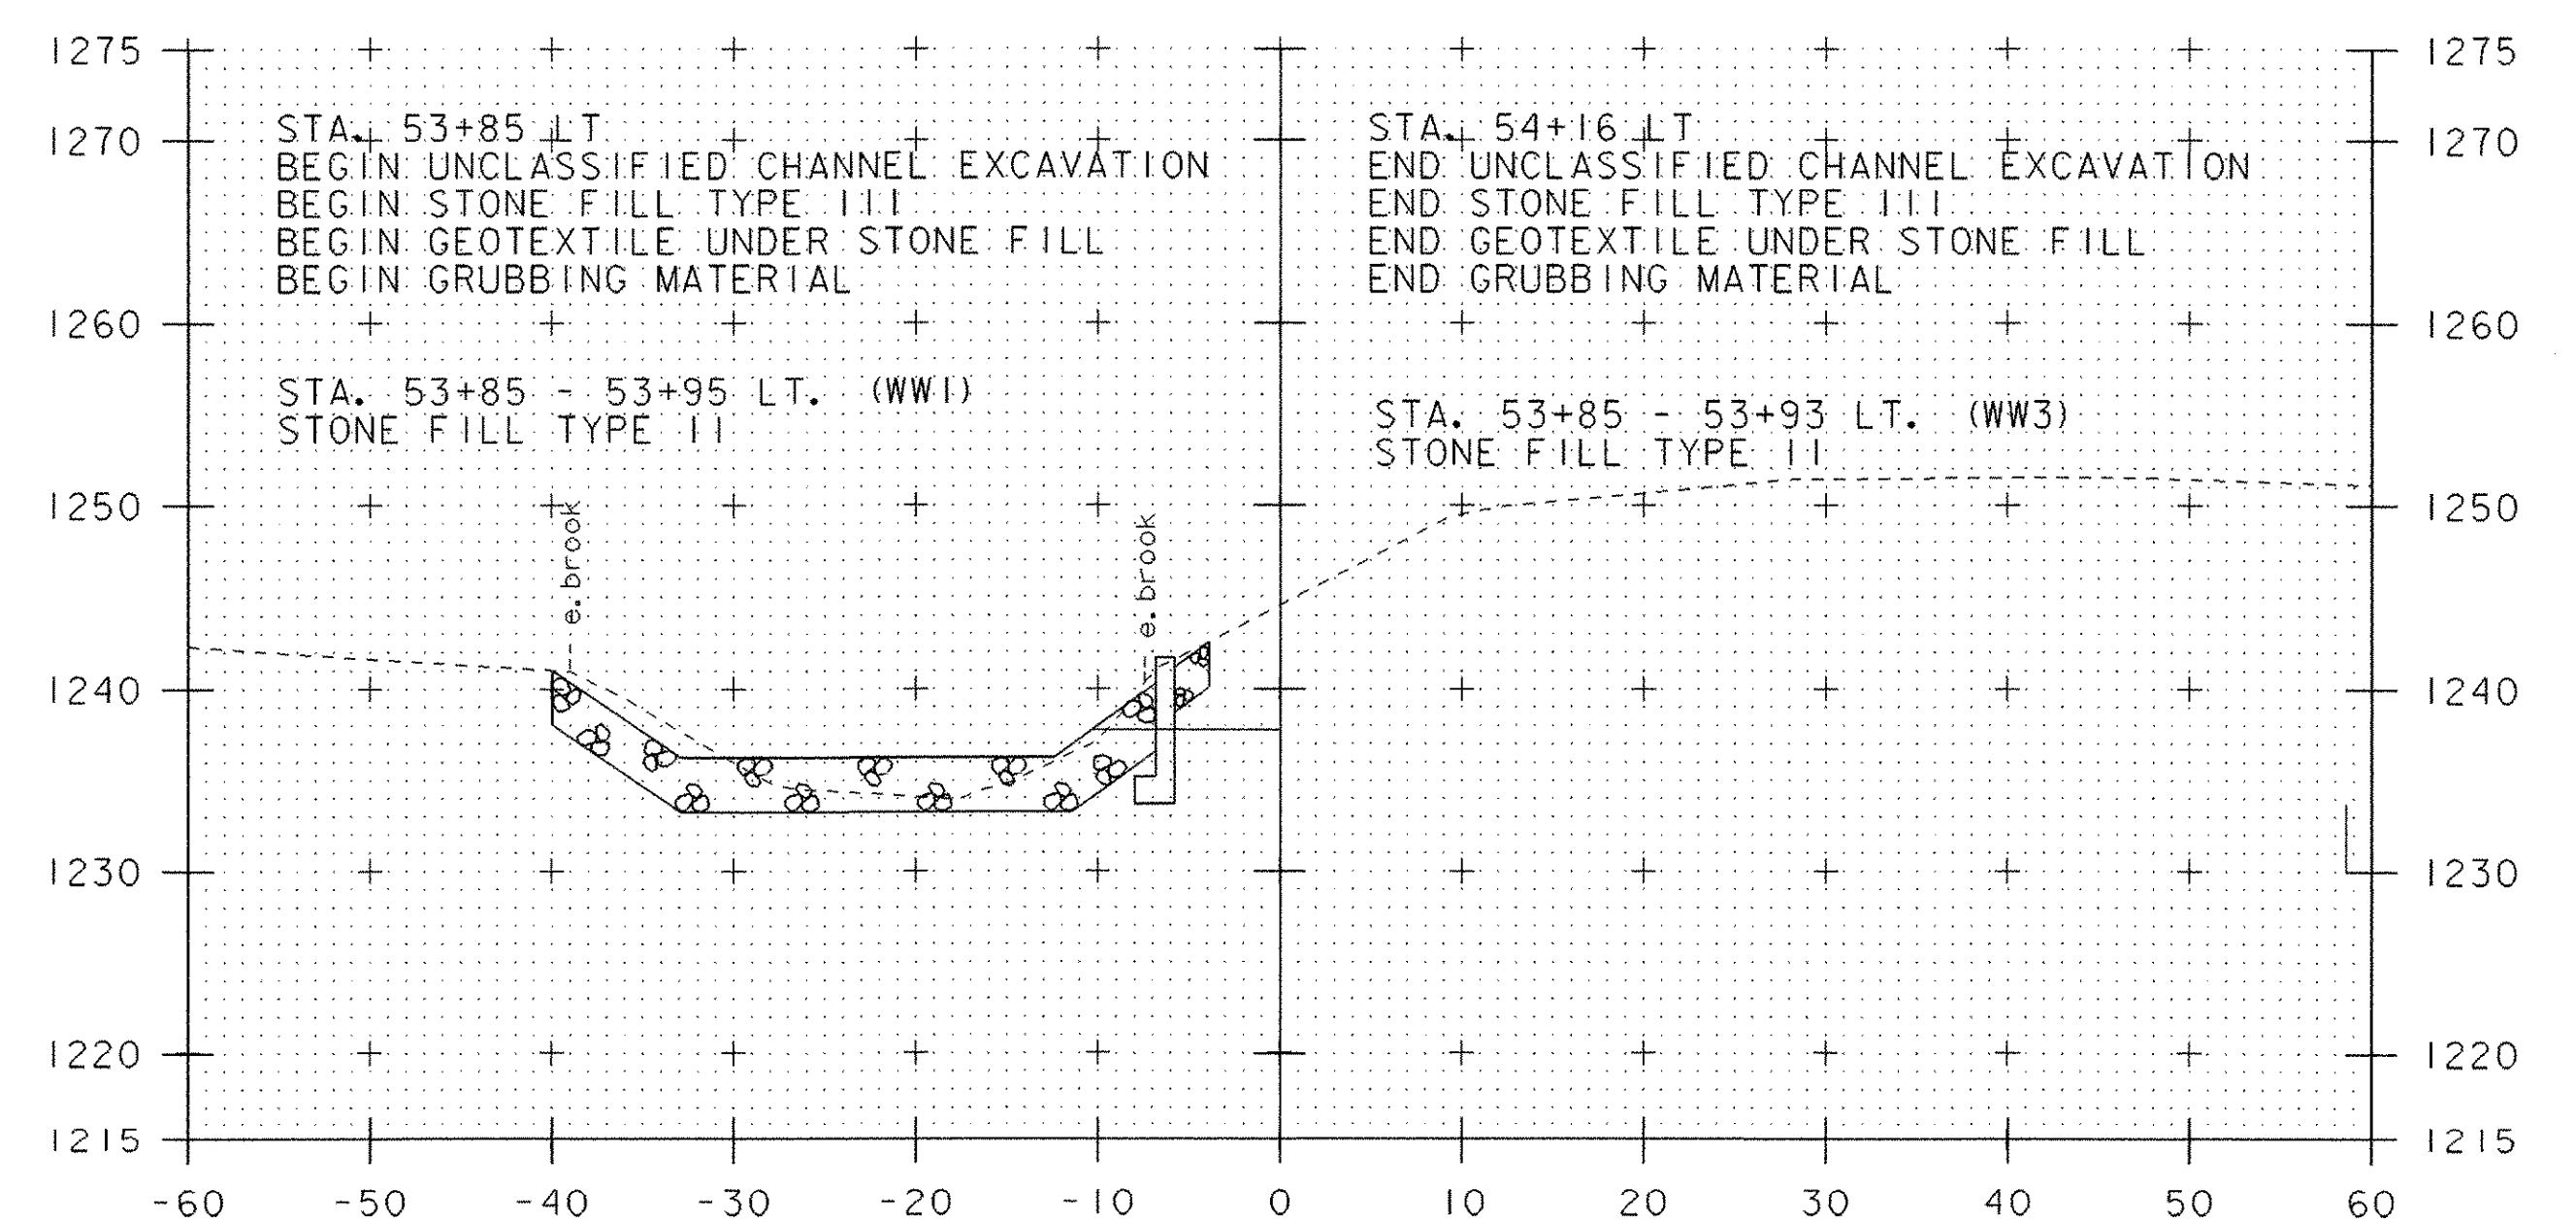

54+00

CHANNEL CROSS SECTIONS

PROJECT NAME:	JAY
PROJECT NUMBER:	ST STP CULV (2)
FILE NAME:	04b140\s04b140bdr.dgn
PROJECT LEADER:	W. SYMONDS
DESIGNED BY:	T. SUMNER
04b140chs3.i	
PLOT DATE:	23-OCT-2006
DRAWN BY:	G. SHANGRAW
CHECKED BY:	J. LACROIX
SHEET	38 OF 39