




54+60

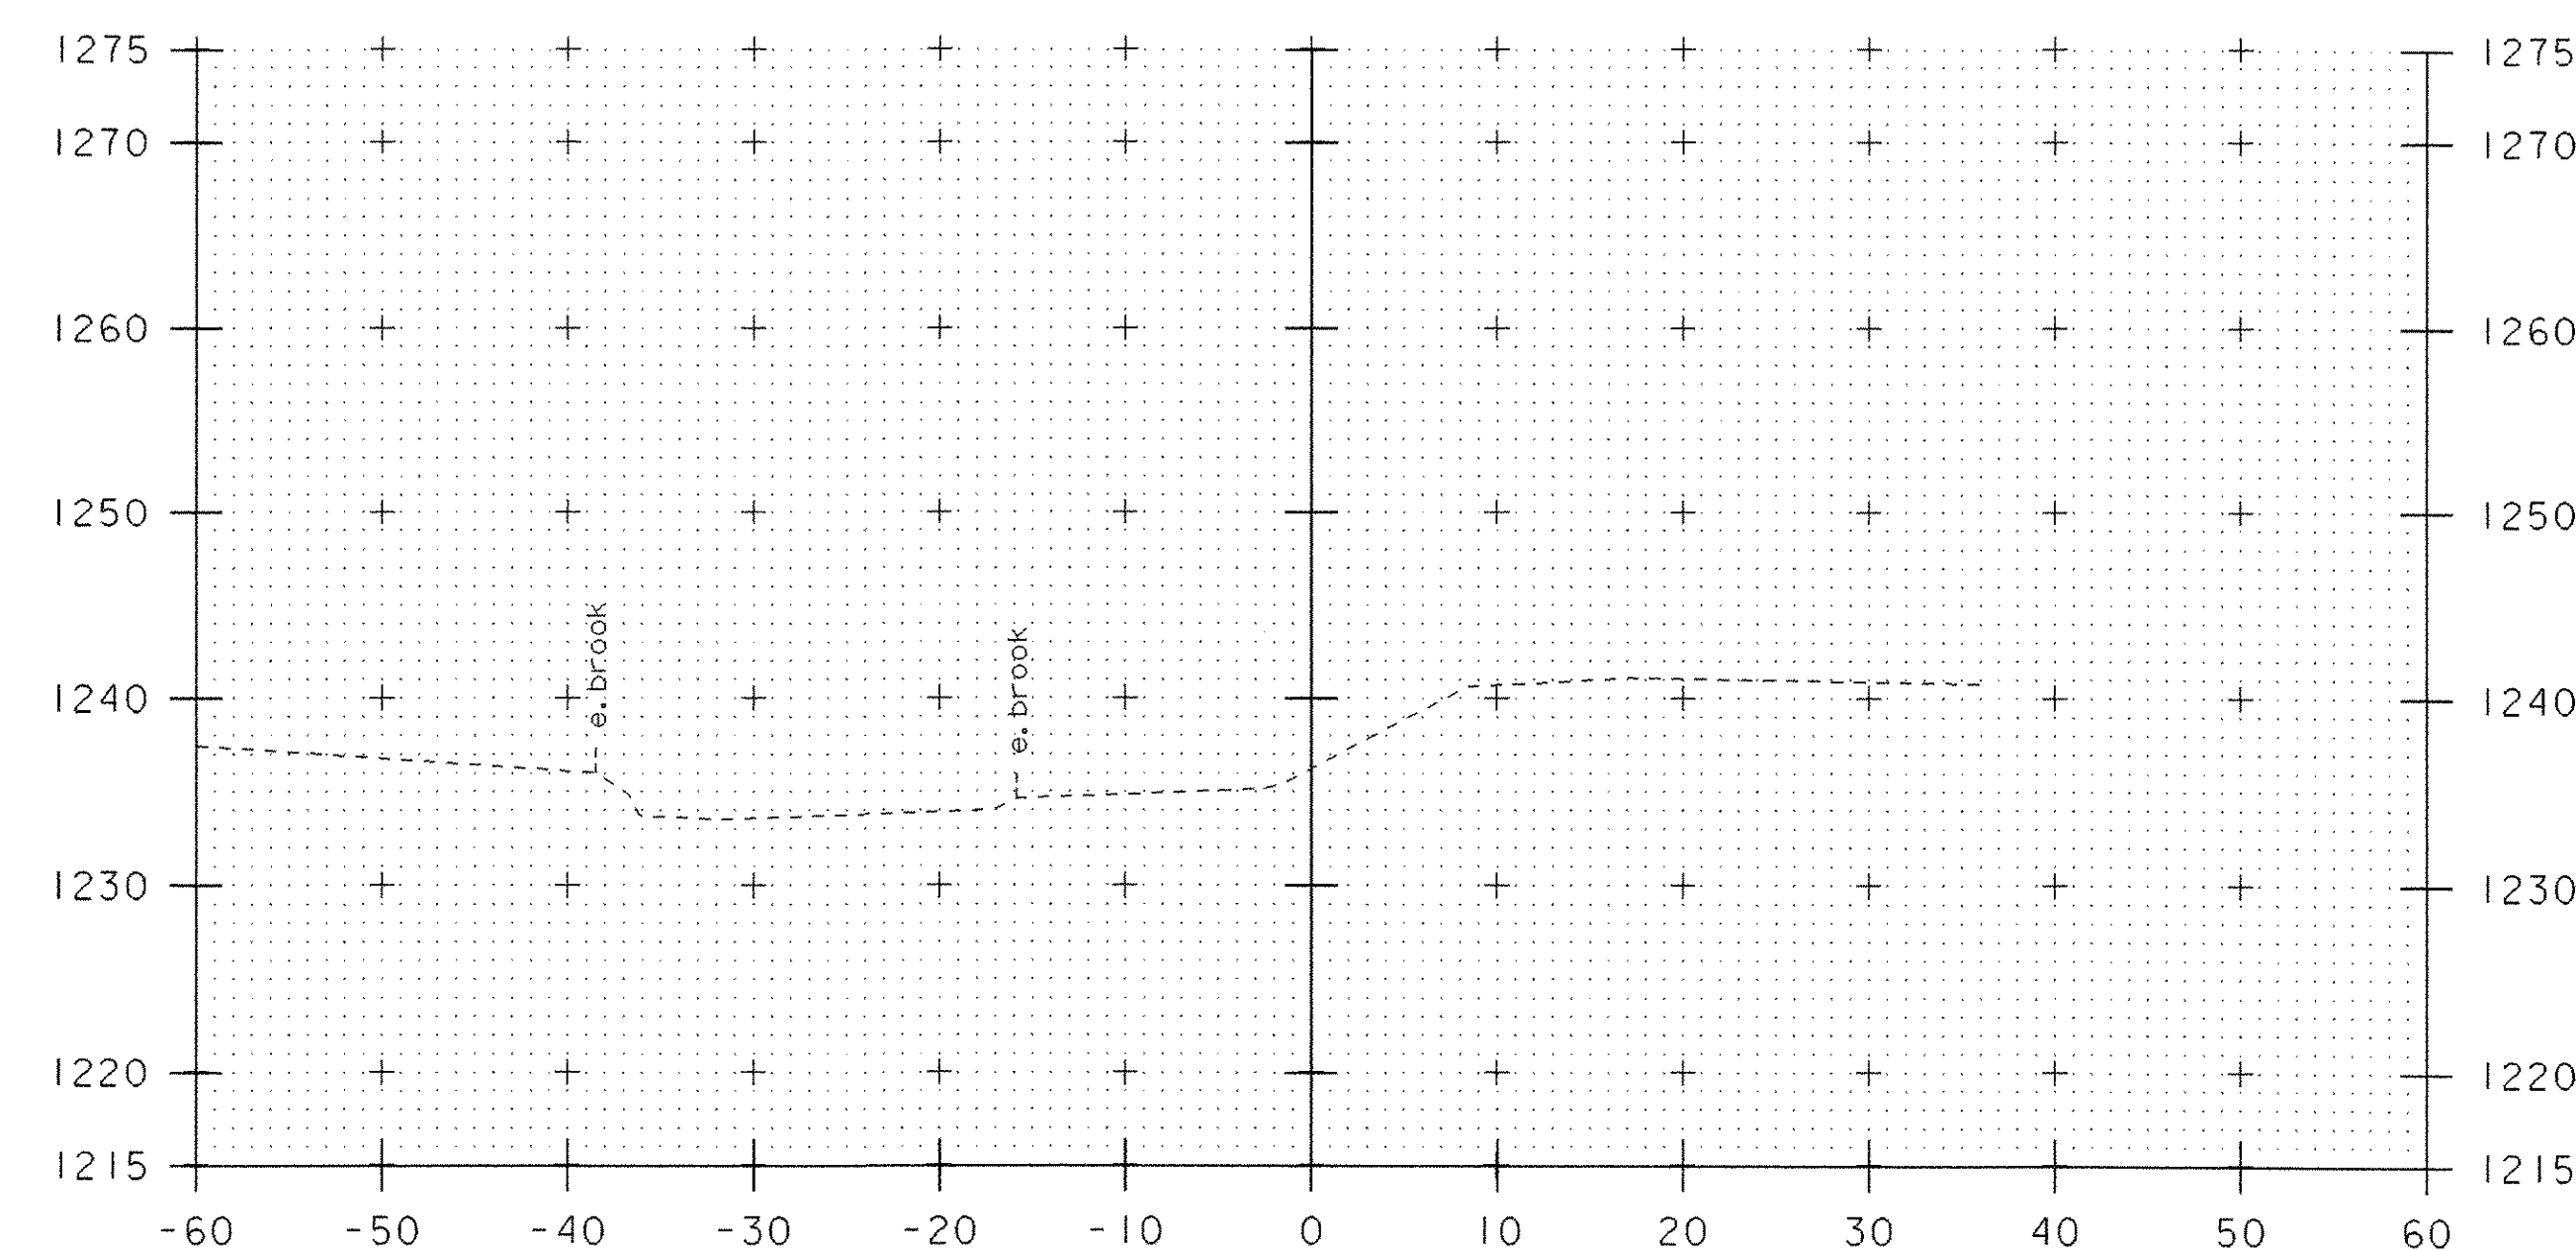

55+00

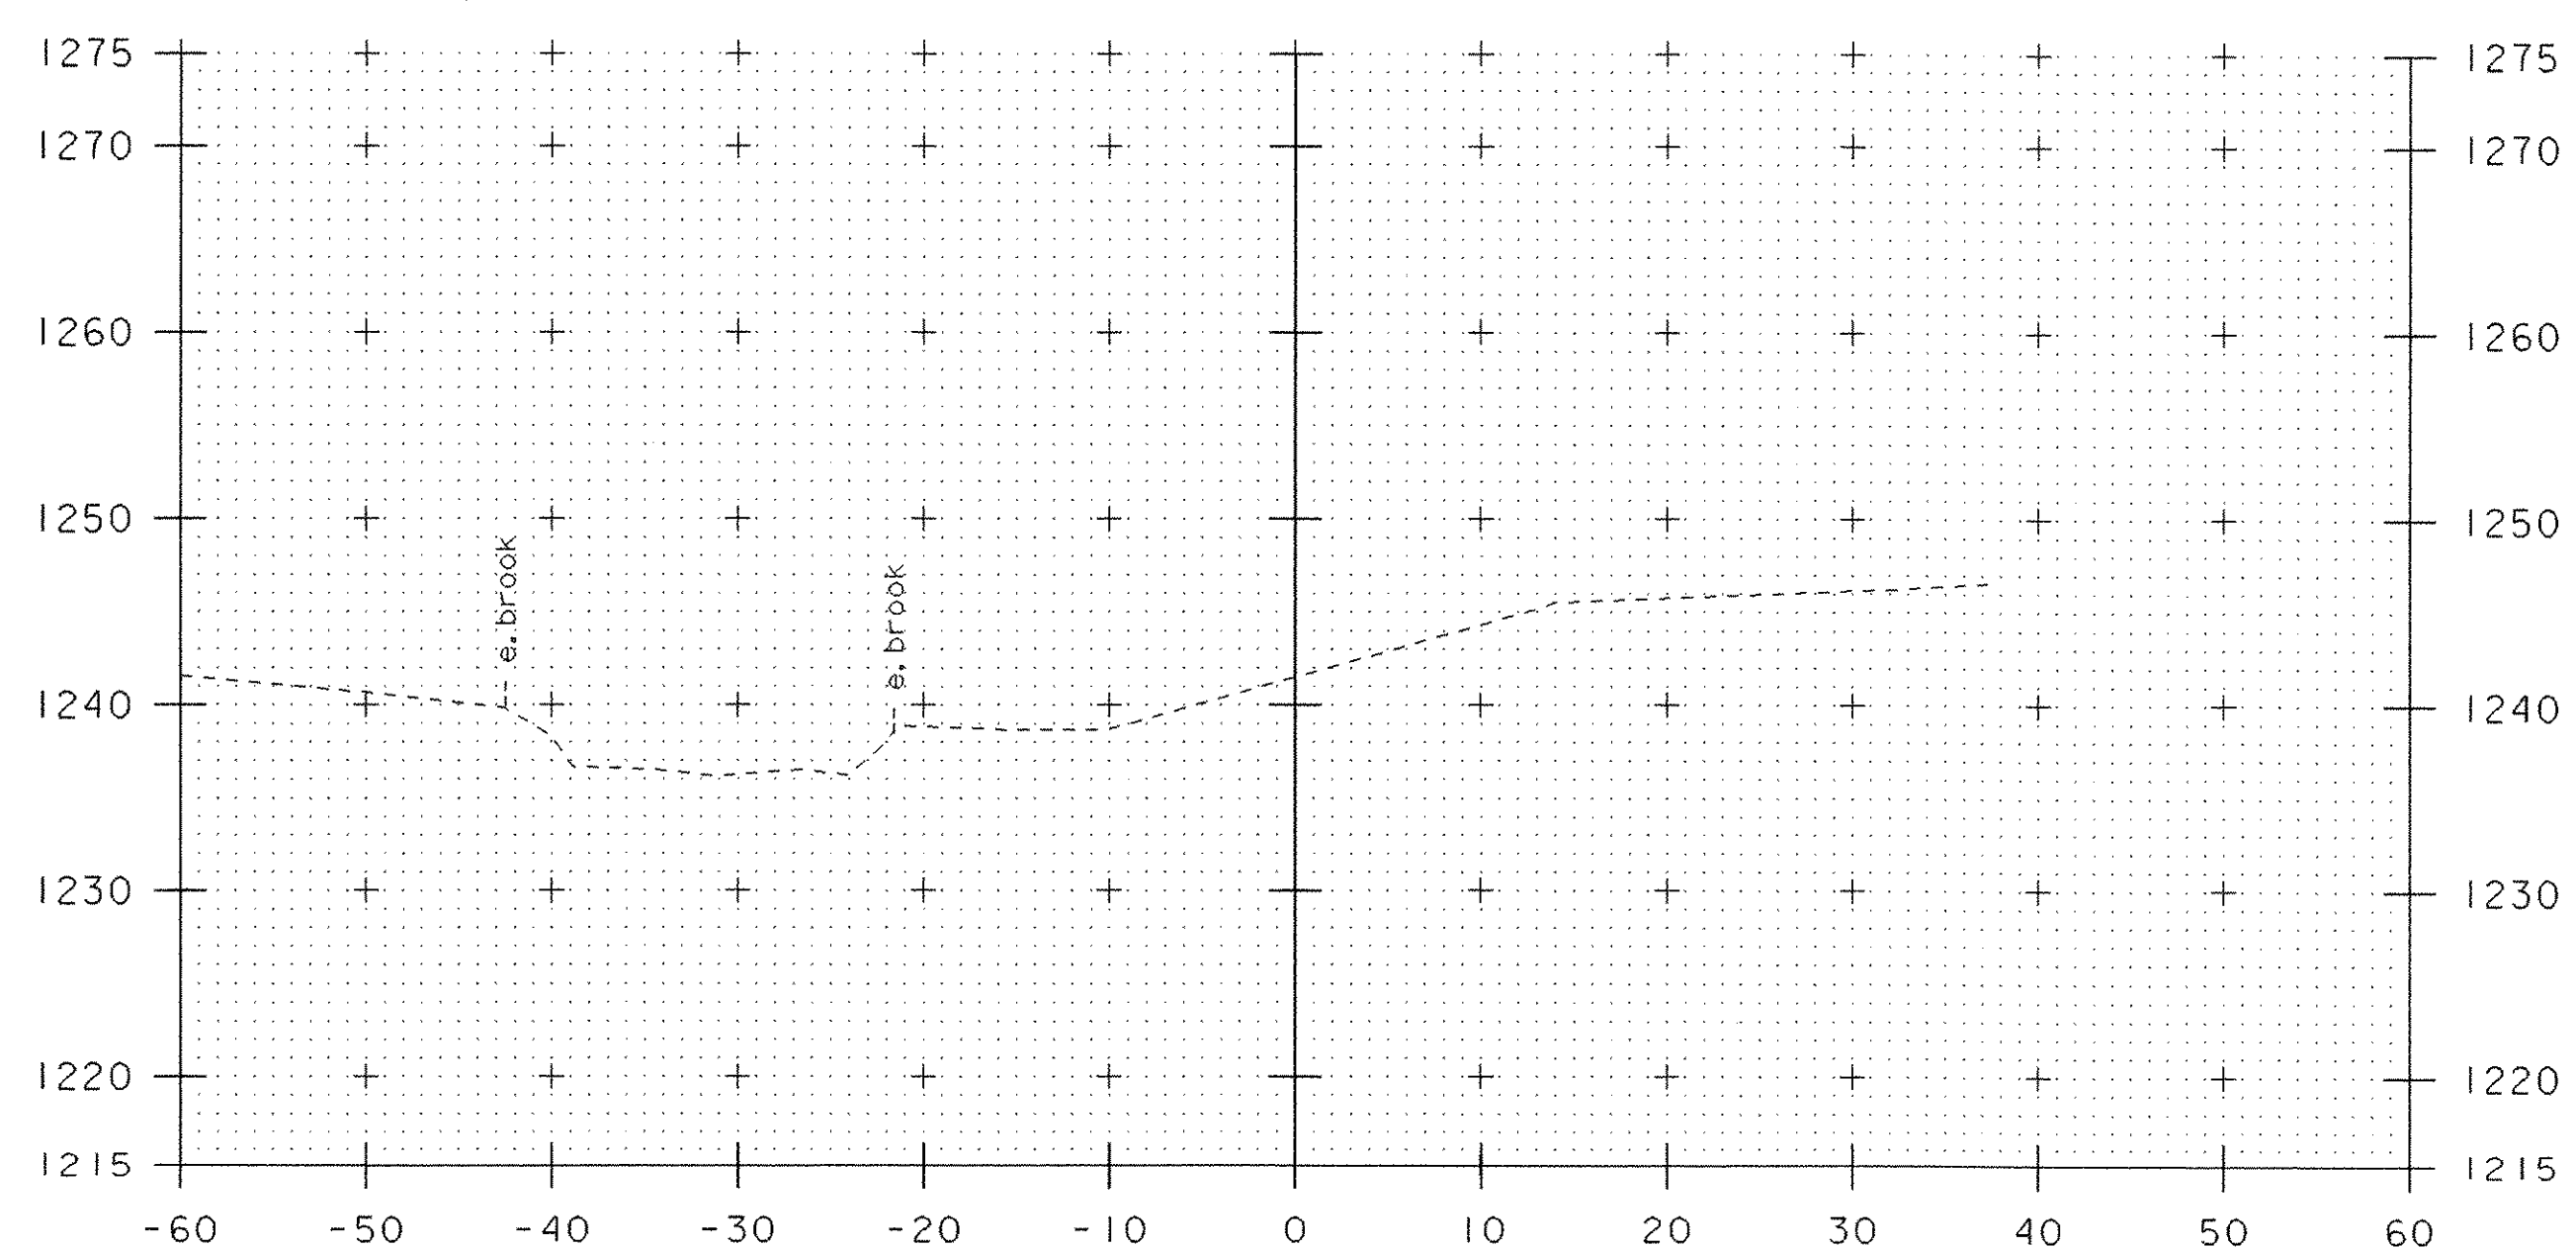

54+40

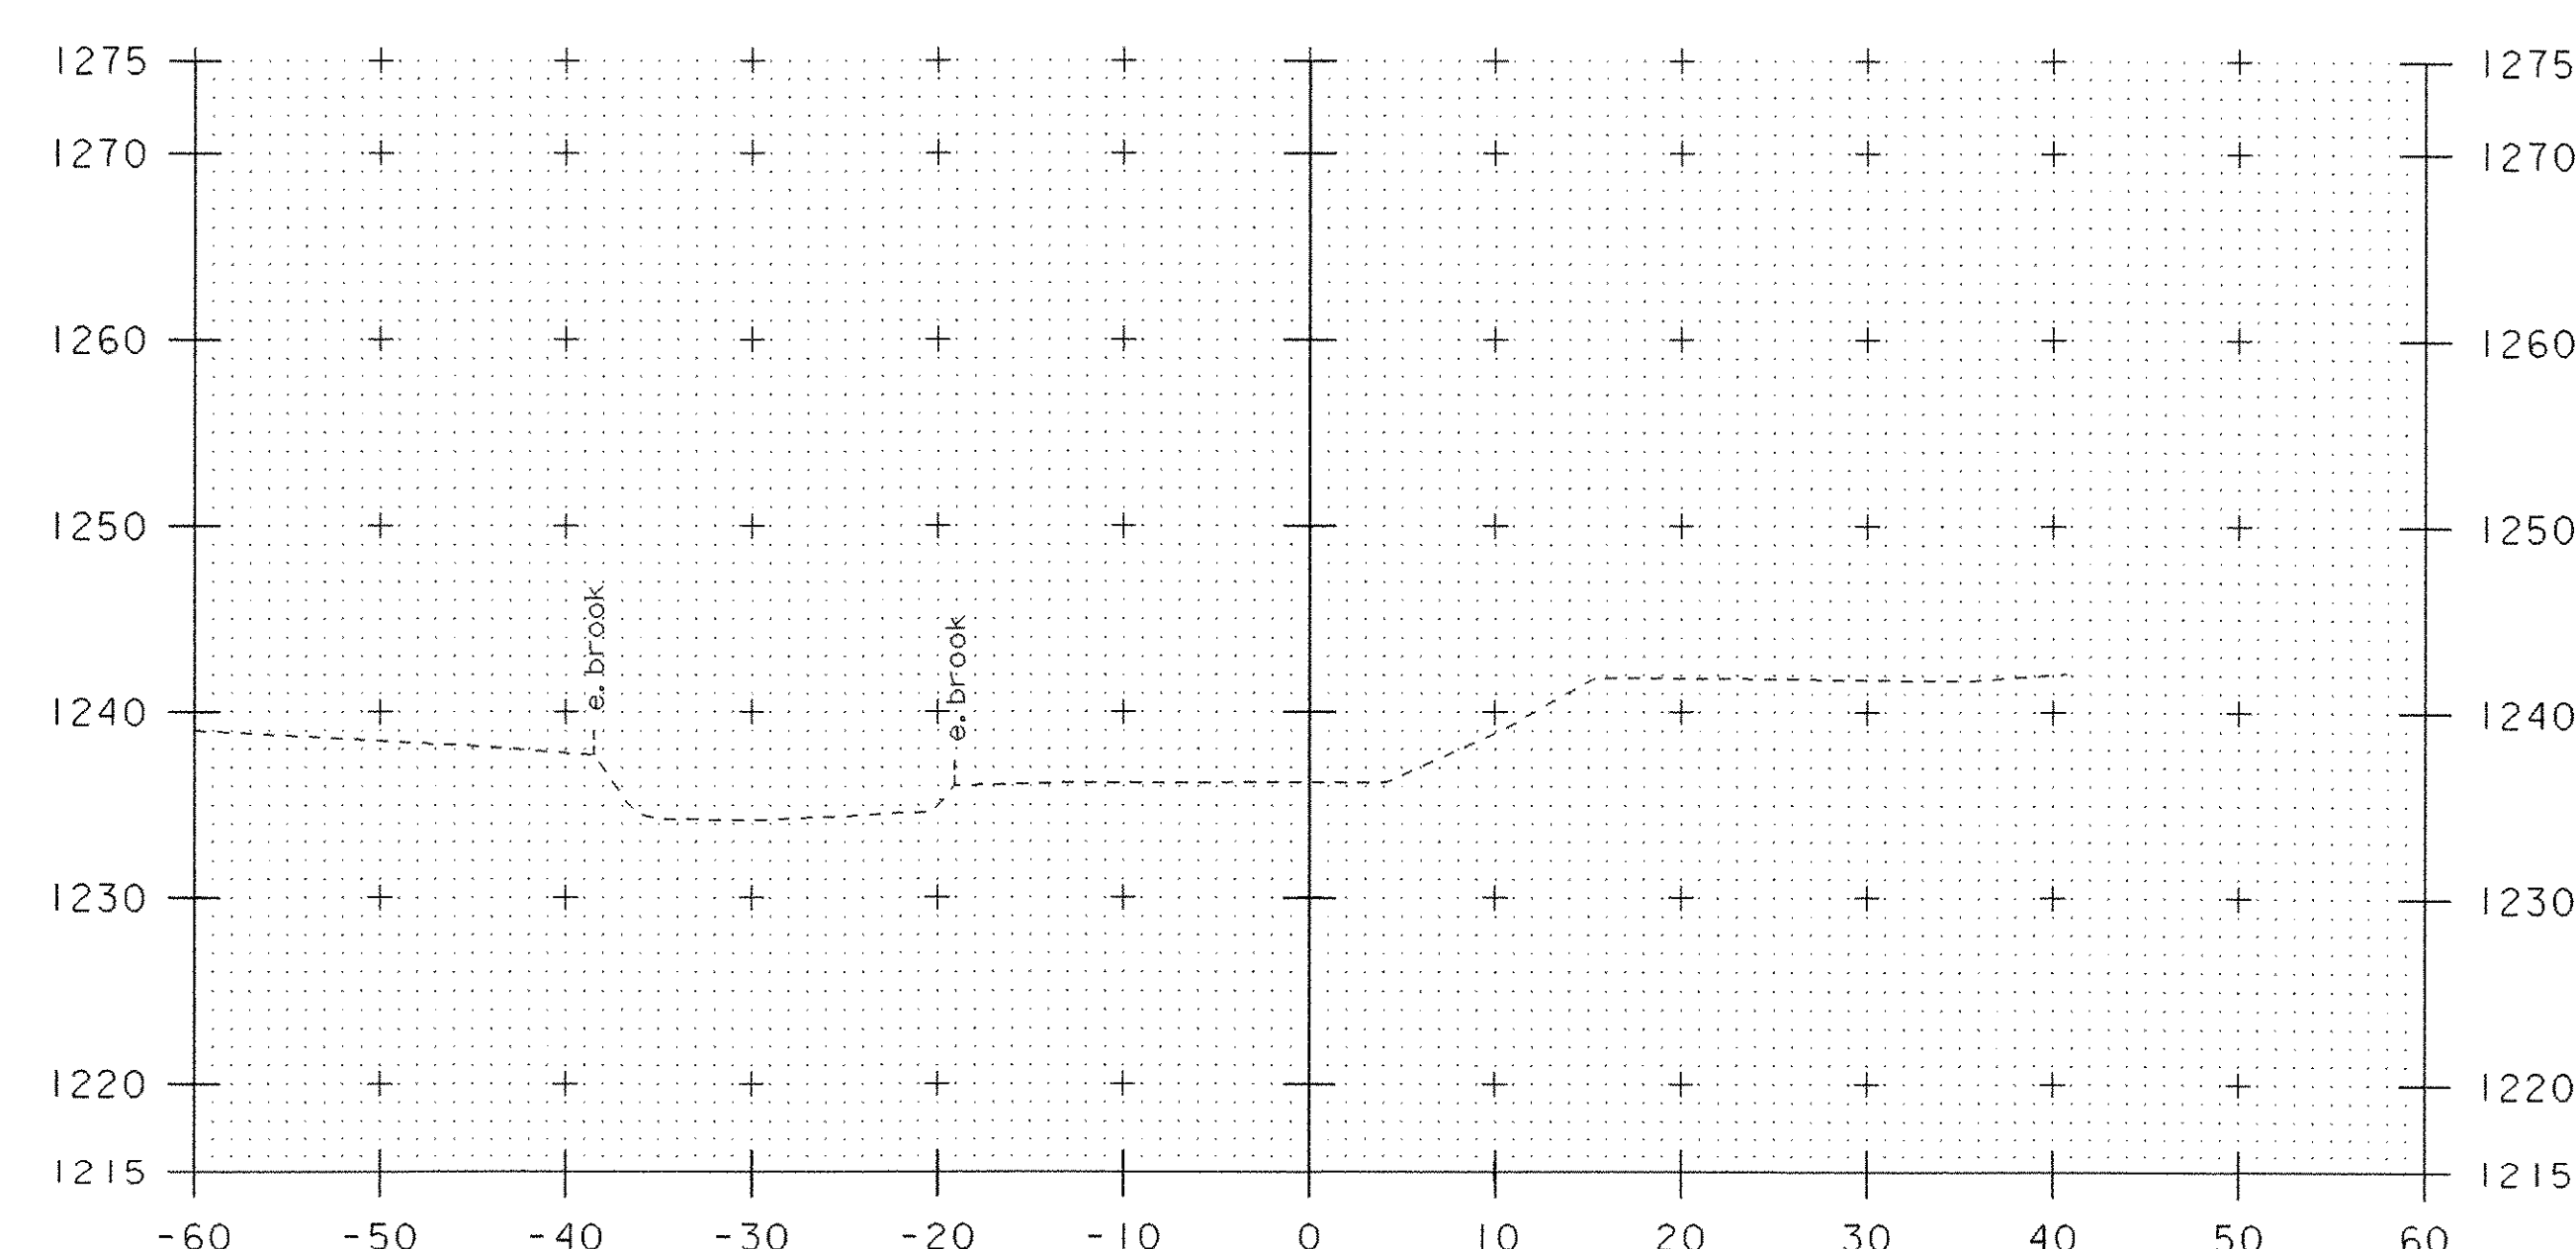

54+80

CHANNEL CROSS SECTIONS

PROJECT NAME:	JAY	PLOT DATE:	23-OCT-2006
PROJECT NUMBER:	ST STP CULV (2)	DRAWN BY:	G. SHANGRAW
FILE NAME:	04b140\s04b140bdr.dgn	DESIGNED BY:	T. SUMNER
		CHECKED BY:	J. LACROIX
		SHEET	39 OF 39