

SEE NEXT SHEET FOR INDEX OF SHEETS

# STATE OF VERMONT AGENCY OF TRANSPORTATION




## PROPOSED IMPROVEMENT BRIDGE PROJECT TOWN OF JAY COUNTY OF ORLEANS

ROUTE NO : VT 105 (MINOR ARTERIAL) BRIDGE # 50

**PROJECT LOCATION**  
BEGINNING AT A POINT ON VT. ROUTE 105 APPROXIMATELY 6.15 MILES EASTERLY OF THE RICHFORD / JAY TOWN LINE AND EXTENDING EASTERLY FOR 0.007 MILES.


**PROJECT DESCRIPTION**  
CONSTRUCTION OF A NEW BOX CULVERT ON THE EXISTING ALIGNMENT WITH NECESSARY ROADWAY APPROACHES AND CHANNEL WORK.

LENGTH OF STRUCTURE : 17.00 FEET 0.0032 MILES  
LENGTH OF ROADWAY : 19.00 FEET 0.0036 MILES  
LENGTH OF PROJECT : 36.00 FEET 0.0068 MILES

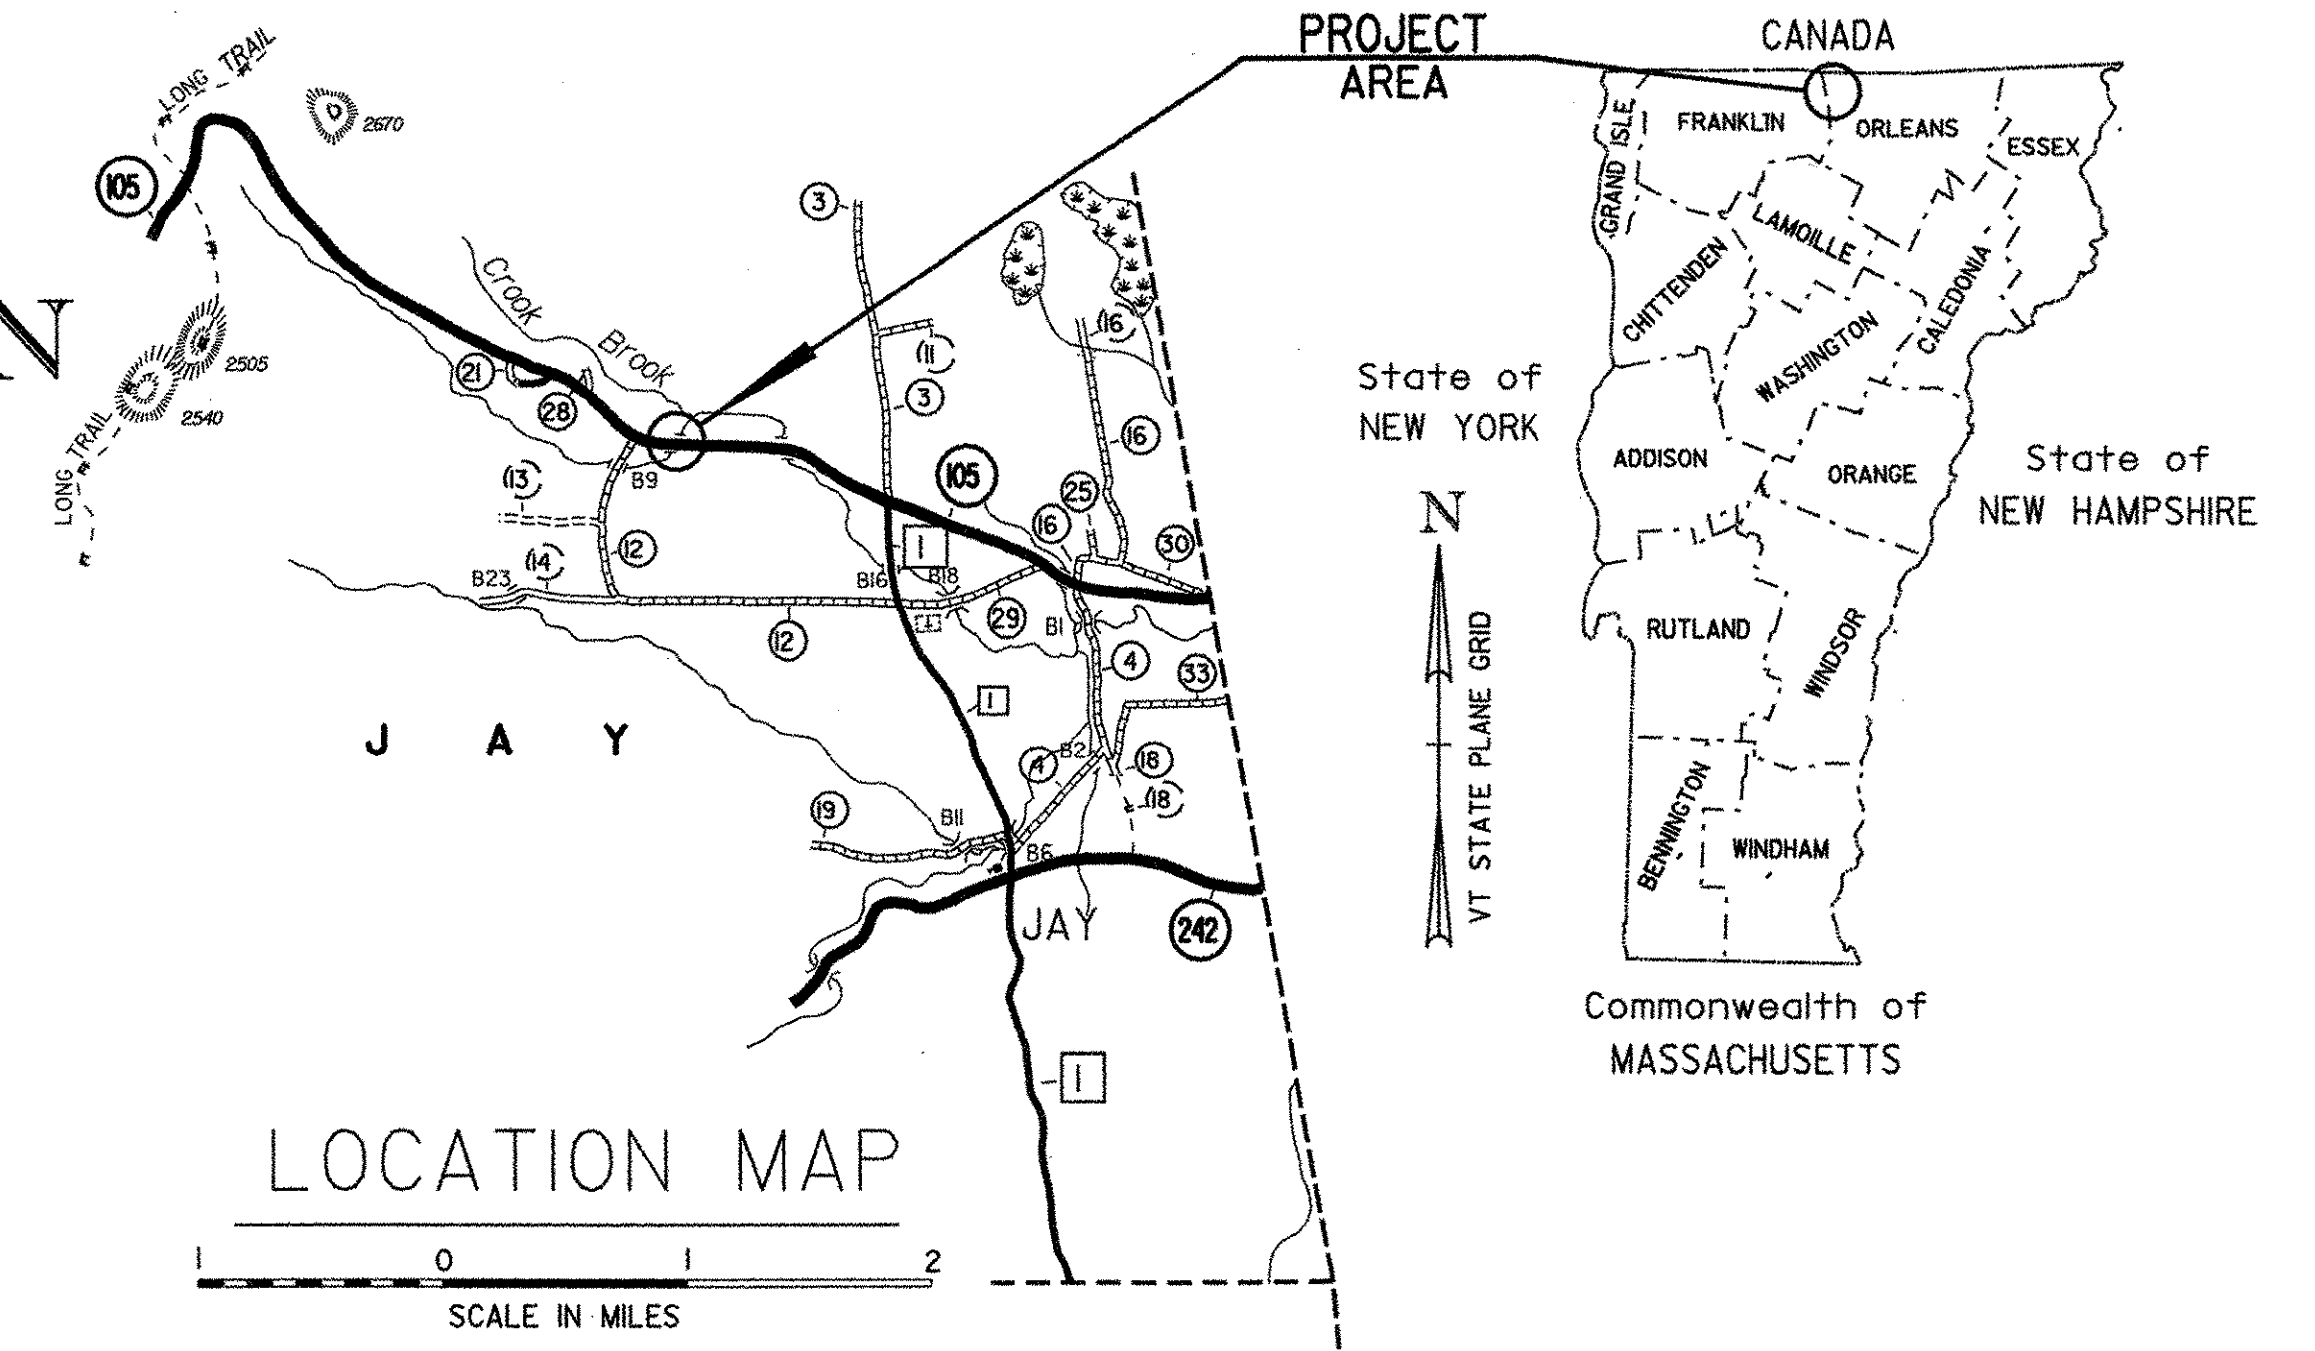


RECORD PLANS	
CONTRACTOR:	S.D. IRELAND BROTHERS CORP. - BURLINGTON, VT
RESIDENT ENGINEER:	DOUG BUMPS
CONSTRUCTION BEGAN:	JULY 16, 2007
CONSTRUCTION COMPLETE:	AUGUST 1, 2007
RECORD PLANS BY:	DOUG BUMPS & CHIP PIERCE
I HEREBY CERTIFY THAT ALL THE CONSTRUCTION REQUIRED BY THIS SET OF DRAWINGS HAS BEEN ACCOMPLISHED AS INDICATED HEREIN.	
BY	<i>Doug Bumps</i> RESIDENT ENGINEER
DATE	3/5/08
NOTE: Any further information concerning final quantities, amounts or other details relative to this project may be found at Central Files in the electronic archives.	

CONVENTIONAL SYMBOLS	
COUNTY LINE	
TOWN LINE	
LIMITS OF ACCESS	
POINT OF ACCESS	
FENCE LINE	
STONE WALL	
TRAVELED WAY	
GUARD RAIL	
RAILROAD	
SURVEY LINE	
CULVERT	
POWER POLE	
TELEPHONE POLE	
TREES	
CONTROL OF ACCESS	
PROPERTY LINE	
R.O.W. TAKING LINE	
SLOPE RIGHTS	
TOP OF CUT	
TOE OF SLOPE	

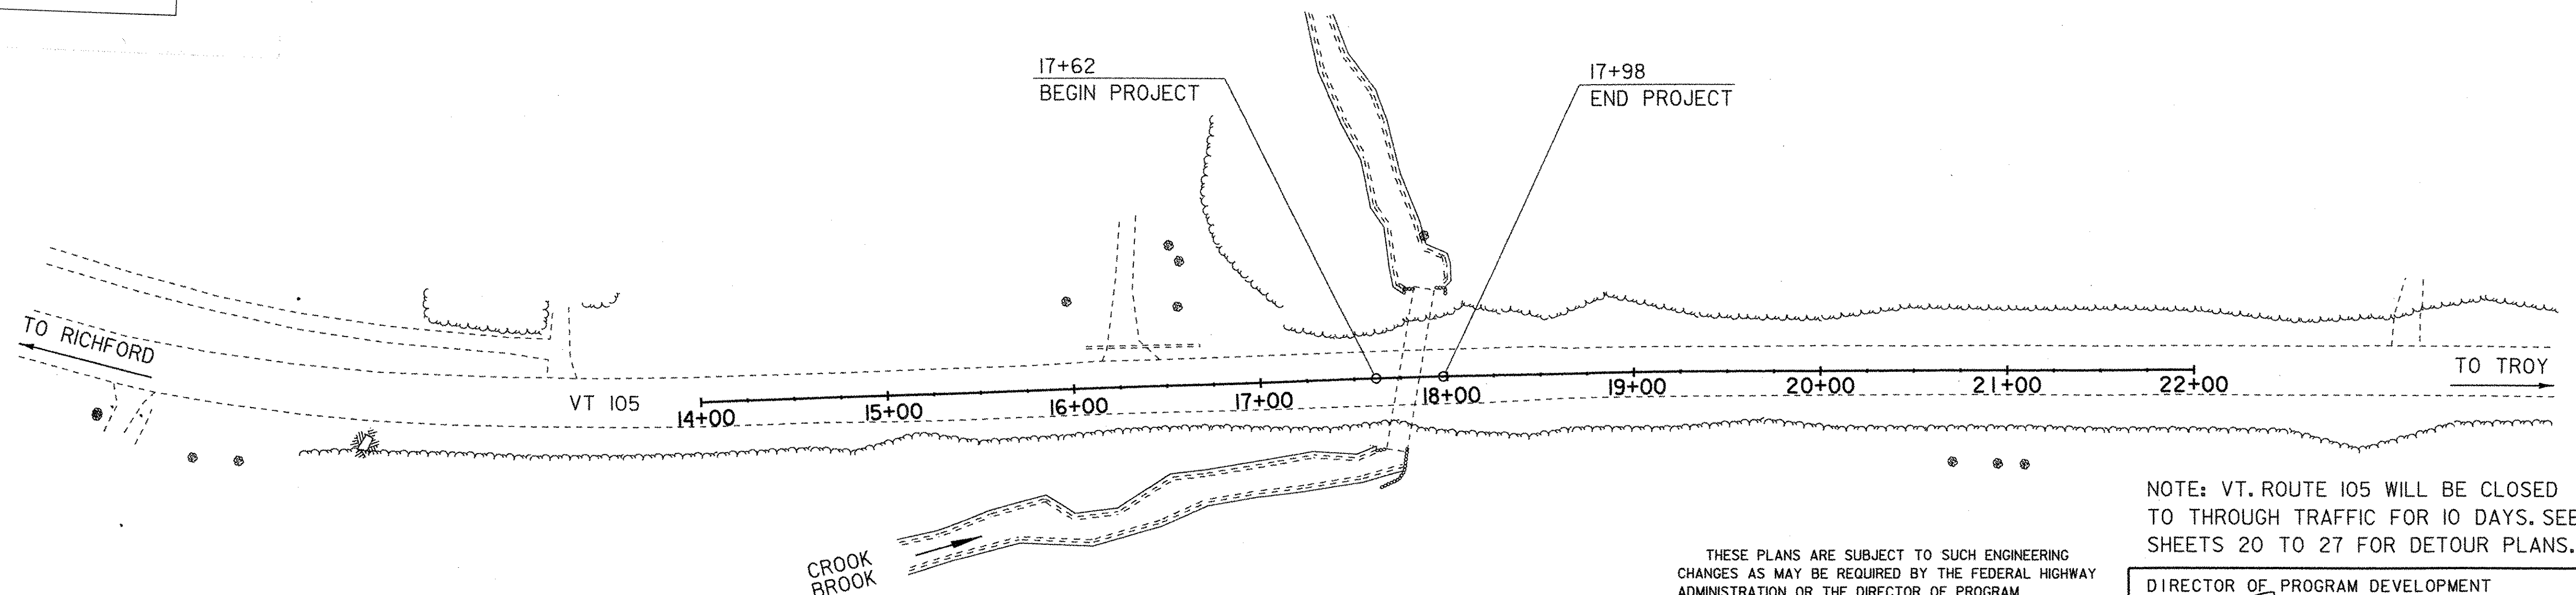

SURVEYED BY : R. GILMAN  
SURVEYED DATE : NOVEMBER 2004

DATUM  
VERTICAL : ASSUMED  
HORIZONTAL : ASSUMED

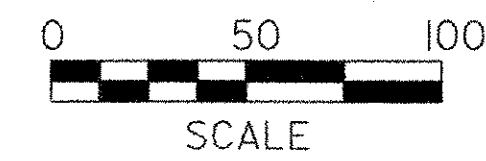

THESE PLANS ARE SUBJECT TO SUCH ENGINEERING CHANGES AS MAY BE REQUIRED BY THE FEDERAL HIGHWAY ADMINISTRATION OR THE DIRECTOR OF PROGRAM DEVELOPMENT.

CONSTRUCTION IS TO BE CARRIED ON IN ACCORDANCE WITH THESE PLANS AND THE STANDARD SPECIFICATIONS FOR CONSTRUCTION DATED 2006, AS APPROVED BY THE FEDERAL HIGHWAY ADMINISTRATION ON JUNE 15, 2006 FOR USE ON THIS PROJECT, INCLUDING ALL SUBSEQUENT REVISIONS AND SUCH REVISED SPECIFICATIONS AND SPECIAL PROVISIONS AS ARE INCORPORATED IN THESE PLANS.

NOTE: VT. ROUTE 105 WILL BE CLOSED TO THROUGH TRAFFIC FOR 10 DAYS. SEE SHEETS 20 TO 27 FOR DETOUR PLANS.

DIRECTOR OF PROGRAM DEVELOPMENT	
APPROVED <i>W. Symonds</i>	DATE 10-3-06
PROJECT MANAGER : W. SYMONDS	
PROJECT NAME : JAY	
PROJECT NUMBER : ST STP CULV (2)	
SHEET 1 OF 39 SHEETS	

# PRELIMINARY INFORMATION SHEET

INDEX OF SHEETS

- 1. TITLE SHEET
- 2. PRELIMINARY INFORMATION SHEET
- 3. TYPICAL SECTIONS SHEET
- 4. TIE SHEET
- 5-6. QUANTITY SHEETS
- 7. PLAN SHEET
- 8. PROFILE AND MATERIAL TRANSITIONS SHEET
- 9-10. BLANK
- 11. -12. EROSION CONTROL NARRATIVE SHEETS
- 13. - 15. EROSION CONTROL PLAN SHEETS
- 16. - 19. EROSION CONTROL DETAIL SHEETS
- 20. - 27. DETOUR SHEETS
- 28. BORING INFORMATION SHEET
- 29. BORING LOG SHEET
- 30. GENERAL NOTES
- 31. BOX LAYOUT SHEET
- 32. PLAN & ELEVATION SHEET
- 33.-35. MAINLINE CROSS SECTION SHEETS
- 36.-39. CHANNEL CROSS SECTION SHEETS

STANDARDS

- B-5 6/1/1994
- D-3 6/1/1994
- E-100 1/2/2004
- E-100A 1/2/2004
- E-101 5/30/2003
- E-102 6/30/2003
- E-102A 5/1/2004
- E-107A 8/8/1995
- E-127 8/8/1995
- E-136A 8/8/1995
- E-136B 8/8/1995
- E-160 5/20/1999
- E-161 8/18/1995
- E-163 5/20/1999
- E-164 5/20/1999
- G-1 1/3/2000
- G-1D 1/3/2000
- G-19 11/15/2002

FINAL HYDRAULIC REPORT

HYDROLOGIC DATA

Date: March 11, 2005

DRAINAGE AREA : 1.5 sq. mi.  
 CHARACTER OF TERRAIN : Hilly to mountainous, mostly forested.  
 STREAM CHARACTERISTICS : Moderately steep, mostly stable with some bank erosion.  
 NATURE OF STREAMBED : Mostly cobbles and gravel.

PEAK FLOW DATA

Q 2.33 = 95 cfs                      Q 50 = 310 cfs  
 Q 10 = 200 cfs                    Q 100 = 360 cfs  
 Q 25 = 260 cfs                    Q 500 = 500 cfs

DATE OF FLOOD OF RECORD : Unknown  
 ESTIMATED DISCHARGE : Unknown  
 WATER SURFACE ELEV. : Unknown  
 NATURAL STREAM VELOCITY : @ Q50 = 10.3 fps  
 ICE CONDITIONS : Moderate  
 DEBRIS : Moderate  
 DOES THE STREAM REACH MAXIMUM HIGHWATER ELEV. RAPIDLY? Yes  
 IS ORDINARY RISE RAPID? Yes  
 IS STAGE AFFECTED BY UPSTREAM OR DOWNSTREAM CONDITIONS? No  
 IF YES, DESCRIBE:

WATERSHED STORAGE: 1%      HEADWATERS: \_\_\_\_\_  
 UNIFORM:  X  
 IMMEDIATELY ABOVE SITE: \_\_\_\_\_

EXISTING STRUCTURE INFORMATION

STRUCTURE TYPE: 10'-8" X 6'-11" CGMPPA  
 YEAR BUILT: 1955  
 CLEAR SPAN(NORMAL TO STREAM): 10'-8"  
 VERTICAL CLEARANCE ABOVE STREAMBED: 6'-11"  
 WATERWAY OF FULL OPENING: 58 sq. ft.  
 DISPOSITION OF STRUCTURE: Remove  
 TYPE OF MATERIAL UNDER SUBSTRUCTURE: Unknown

WATER SURFACE ELEVATIONS AT:

Q2.33 = 1244.0'                      VELOCITY = 9.3 fps  
 Q10 = 1246.2'                      "                      11.8 fps  
 Q25 = 1247.0'                      "                      12.8 fps  
 Q50 = 1247.6'                      "                      13.5 fps  
 Q100 = 1248.4'                      "                      14.1 fps

LONG TERM STREAMBED CHANGES: Probable streambed degradation downstream.  
 Scour hole at outlet.

IS THE ROADWAY OVERTOPPED BELOW Q100: No  
 FREQUENCY: Above Q100  
 RELIEF ELEVATION: 1249.5'  
 DISCHARGE OVER ROAD @Q100: None

UPSTREAM STRUCTURE

TOWN: Jay                                      DISTANCE: 1,300'  
 HIGHWAY #: T.H. 12                      STRUCTURE #: 9  
 CLEAR SPAN: 8'                              CLEAR HEIGHT: 9'  
 YEAR BUILT: Unknown                      FULL WATERWAY: 72 sq. ft.  
 STRUCTURE TYPE: Bridge

DOWNSTREAM STRUCTURE

TOWN: Jay                                      DISTANCE: 2,800'  
 HIGHWAY #: VT 105                      STRUCTURE #: 51  
 CLEAR SPAN: 15'-10"                      CLEAR HEIGHT: 9'-10"  
 YEAR BUILT: 1955                      FULL WATERWAY: 122 sq. ft.  
 STRUCTURE TYPE: CGMPPA

TRAFFIC DATA

YEAR	ADT	DHV	% D	% T	ADTT
2005	610	130	60	21	120
2025	790	140	60	29	210

20 year ESAL for flexible pavement from 2006 to 2026 : 1,240,000  
 40 year ESAL for flexible pavement from 2006 to 2046 : 3,110,000  
 Design Speed : 50 mph

PROPOSED STRUCTURE

STRUCTURE TYPE: Precast concrete box with stone fill in the bottom.

CLEAR SPAN(NORMAL TO STREAM): 15'  
 VERTICAL CLEARANCE ABOVE STREAMBED: 6' maximum to 4.7' minimum  
 WATERWAY OF FULL OPENING: 81 sq. ft.

WATER SURFACE ELEVATIONS AT:

Q2.33 = 1244.0'                      VELOCITY = 8.2 fps  
 Q10 = 1245.8'                      "                      7.6 fps  
 Q25 = 1246.2'                      "                      8.7 fps  
 Q50 = 1246.5'                      "                      9.5 fps  
 Q100 = 1246.8'                      "                      10.1 fps

IS THE ROADWAY OVERTOPPED BELOW Q100: No  
 FREQUENCY: Above Q100  
 RELIEF ELEVATION: 1249.5'  
 DISCHARGE OVER ROAD @Q100: None

AVERAGE LOW ELEVATION OF SUPERSTRUCTURE: 1247.2'  
 VERTICAL CLEARANCE: @ Q50 = 0.7'

SCOUR: NRNA

REQUIRED CHANNEL PROTECTION: Stone Fill, Type III

PERMIT INFORMATION

AVERAGE DAILY FLOW: 3 cfs                      DEPTH OR ELEVATION:  
 ORDINARY LOW WATER: 1 cfs                      Less than 0.5'  
 ORDINARY HIGH WATER: 40 cfs                      2.0'

TEMPORARY BRIDGE REQUIREMENTS

STRUCTURE TYPE: No temporary bridge required.  
 CLEAR SPAN (NORMAL TO STREAM): \_\_\_\_\_  
 VERTICAL CLEARANCE ABOVE STREAMBED: \_\_\_\_\_  
 WATERWAY AREA OF FULL OPENING: \_\_\_\_\_

ADDITIONAL INFORMATION

DESIGN CRITERIA

1. DESIGN LIVE LOAD AASHTO HS-25
2. DESIGN SPAN 15' CLEAR SPAN
3. ALLOWABLE LOAD FOR SPREAD FOOTINGS ON SOIL ON LEDGE
4. ALLOWABLE LOAD FOR PILING TYPE ESTIMATED LENGTH
5. STRUCTURAL STEEL AASHTO M270MM270 GRADE N/A
6. REINFORCNG STEEL GRADE 60
7. CONCRETE, HIGH PERFORMANCE CLASS A fc: N/A  
 CONCRETE, HIGH PERFORMANCE CLASS B fc: 3500 psi
8. DESIGN SOIL UNIT WEIGHT 140 pcf
9. DESIGN LOAD FOR SPREAD FOOTINGS ON SOIL

TRAFFIC MAINTENANCE

1. IS TRAFFIC TO BE MAINTAINED? ROAD CLOSED TO THROUGH TRAFFIC \*  
 IF YES, ON EXISTING STRUCTURE? NA  
 OR ON TEMPORARY BRIDGE? NA  
 ONE OR TWO-WAY TRAVEL? NA
2. TRAFFIC CONTROL SIGNALS REQUIRED? NA
3. ARE SIDEWALKS REQUIRED? NA  
 IF SO, ON WHAT SIDE? NA

\* SEE SHEETS 20-27 FOR DETOUR PLAN

PROJECT NAME: JAY  
 PROJECT NUMBER: ST STP CULV (2)

FILE NAME: s04b140pi.xls                      PLOT DATE: 10/11/2006  
 PROJECT MANAGER: W. SYMONDS                      DRAWN BY: G. SHANGRAW  
 DESIGNED BY: T. FILLBACH                      CHECKED BY: T. SUMNER  
 PRELIMINARY INFORMATION SHEET                      SHEET 2 OF 39

MATERIAL ITEM	TOLERANCE
PAVEMENT	± 1/4" TOTAL THICKNESS
BASE COURSE	± 1/2"
SUBBASE	± 1"
SAND BORROW	± 1"


3" BITUMINOUS CONCRETE PAVEMENT, TYPE III (2 - 1 1/2" LIFTS) (PG 58-34)  
 6" BITUMINOUS CONCRETE PAVEMENT, TYPE I OR II (2 - 3" LIFTS) (PG 58-34)  
 18" SUBBASE OF DENSE GRADED CRUSHED STONE  
 24" SAND BORROW

**SEEDING FORMULA  
 RURAL AREAS**

% WT.	LBS./A.	NAME	PUR %	GERM %
37.5	22.5	CREeping RED FESCUE	98	85
37.5	22.5	TALL FESCUE	95	90
5.0	3.0	RED TOP	95	90
15.0	9.0	BIRDSFOOT TREFOL	98	85
5.0	3.0	ANNUAL RYEGRASS	95	85
100.0	60.0			


**GENERAL NOTES**

SEED MIXTURE: SHALL NOT HAVE A WEED CONTENT EXCEEDING 0.40% BY WEIGHT AND SHALL BE FREE OF ALL NOXIOUS SEED.  
 SEED: TO BE APPLIED PER SEEDING FORMULAS OR AS DIRECTED BY THE ENGINEER.  
 FERTILIZER: FORMULA 10-20-10, TO BE USED WITH SEED, APPLIED AT THE RATE OF 500 LBS./ACRE. (HYDRO SEEDERS MAY USE 19-19-19 FORMULA).  
 AGRICULTURAL LIMESTONE: TO BE APPLIED AT THE RATE OF 2 TONS/ACRE, OR AS DIRECTED BY THE ENGINEER.  
 HAY MULCH: TO BE PLACED ON EARTH SLOPES AT THE RATE OF 2 TONS/ACRE, OR AS DIRECTED BY THE ENGINEER.

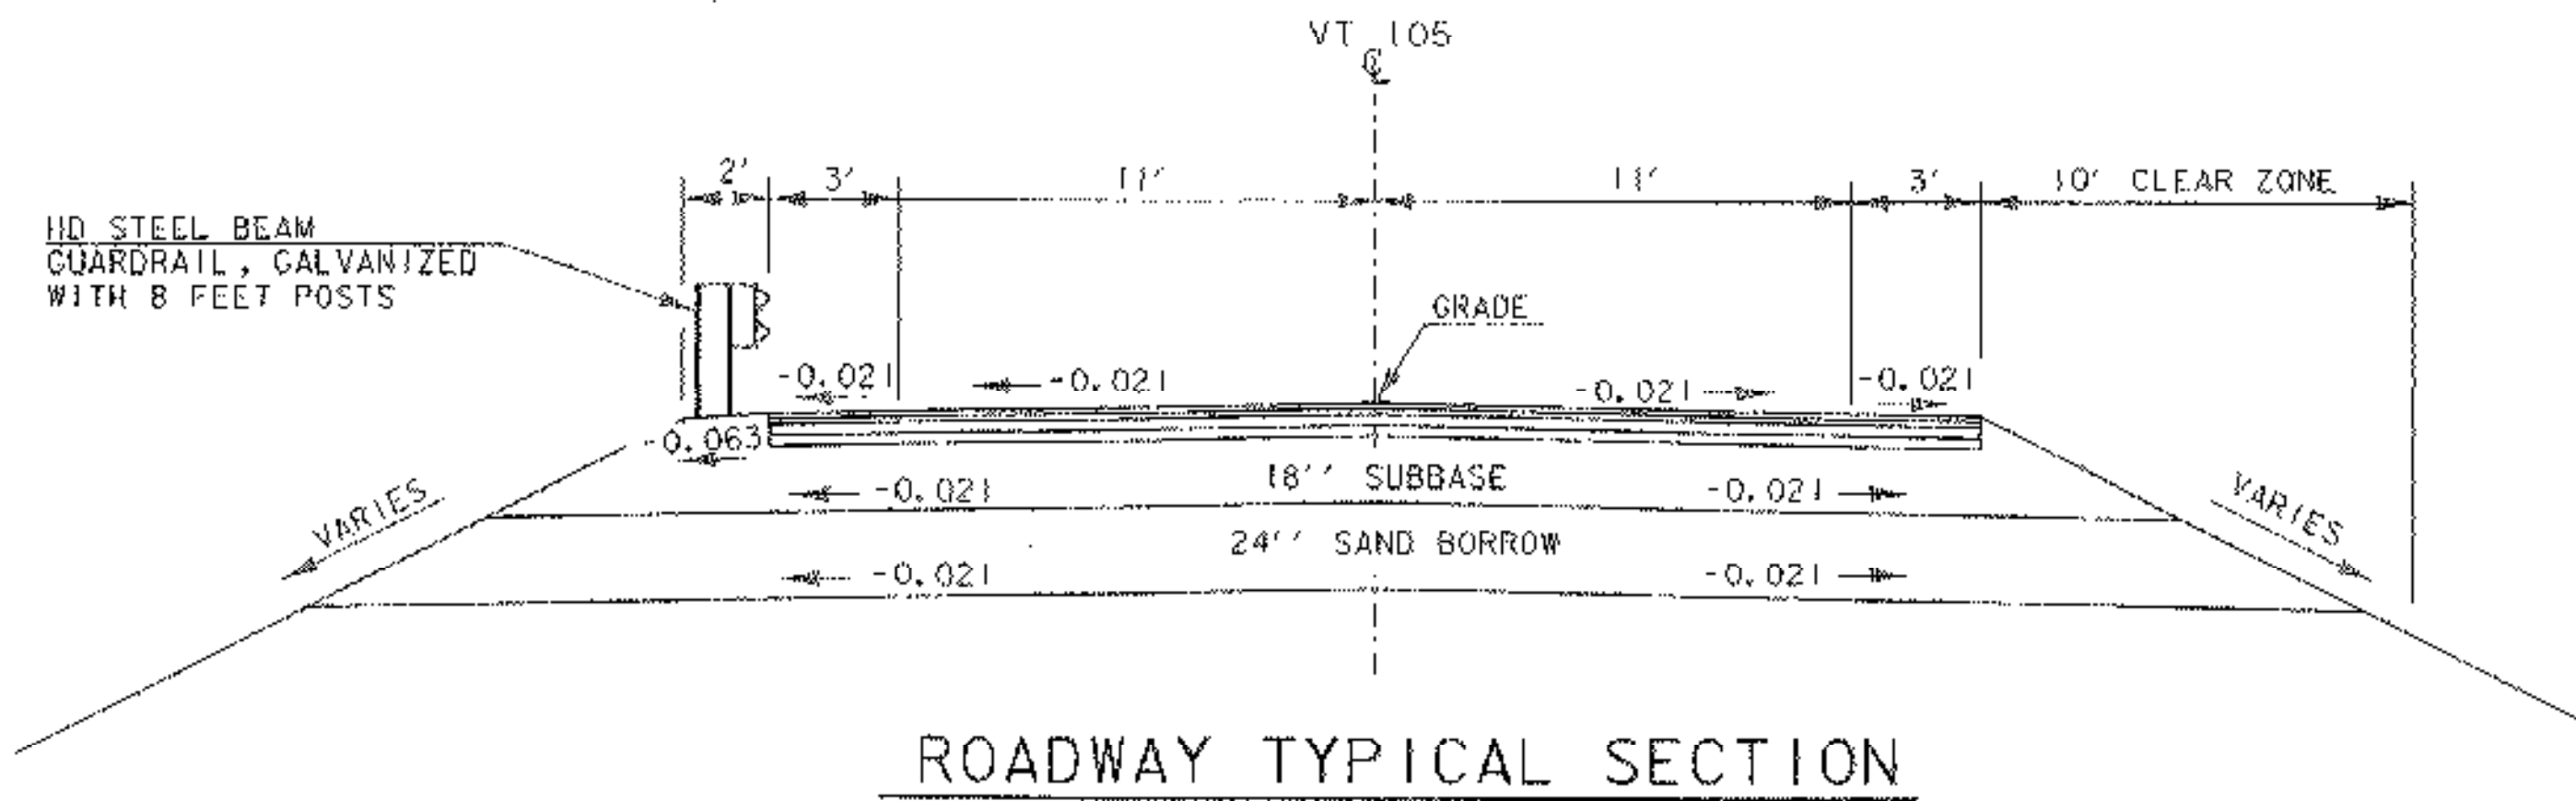


**ROADWAY TYPICAL SECTION**

NOT TO SCALE

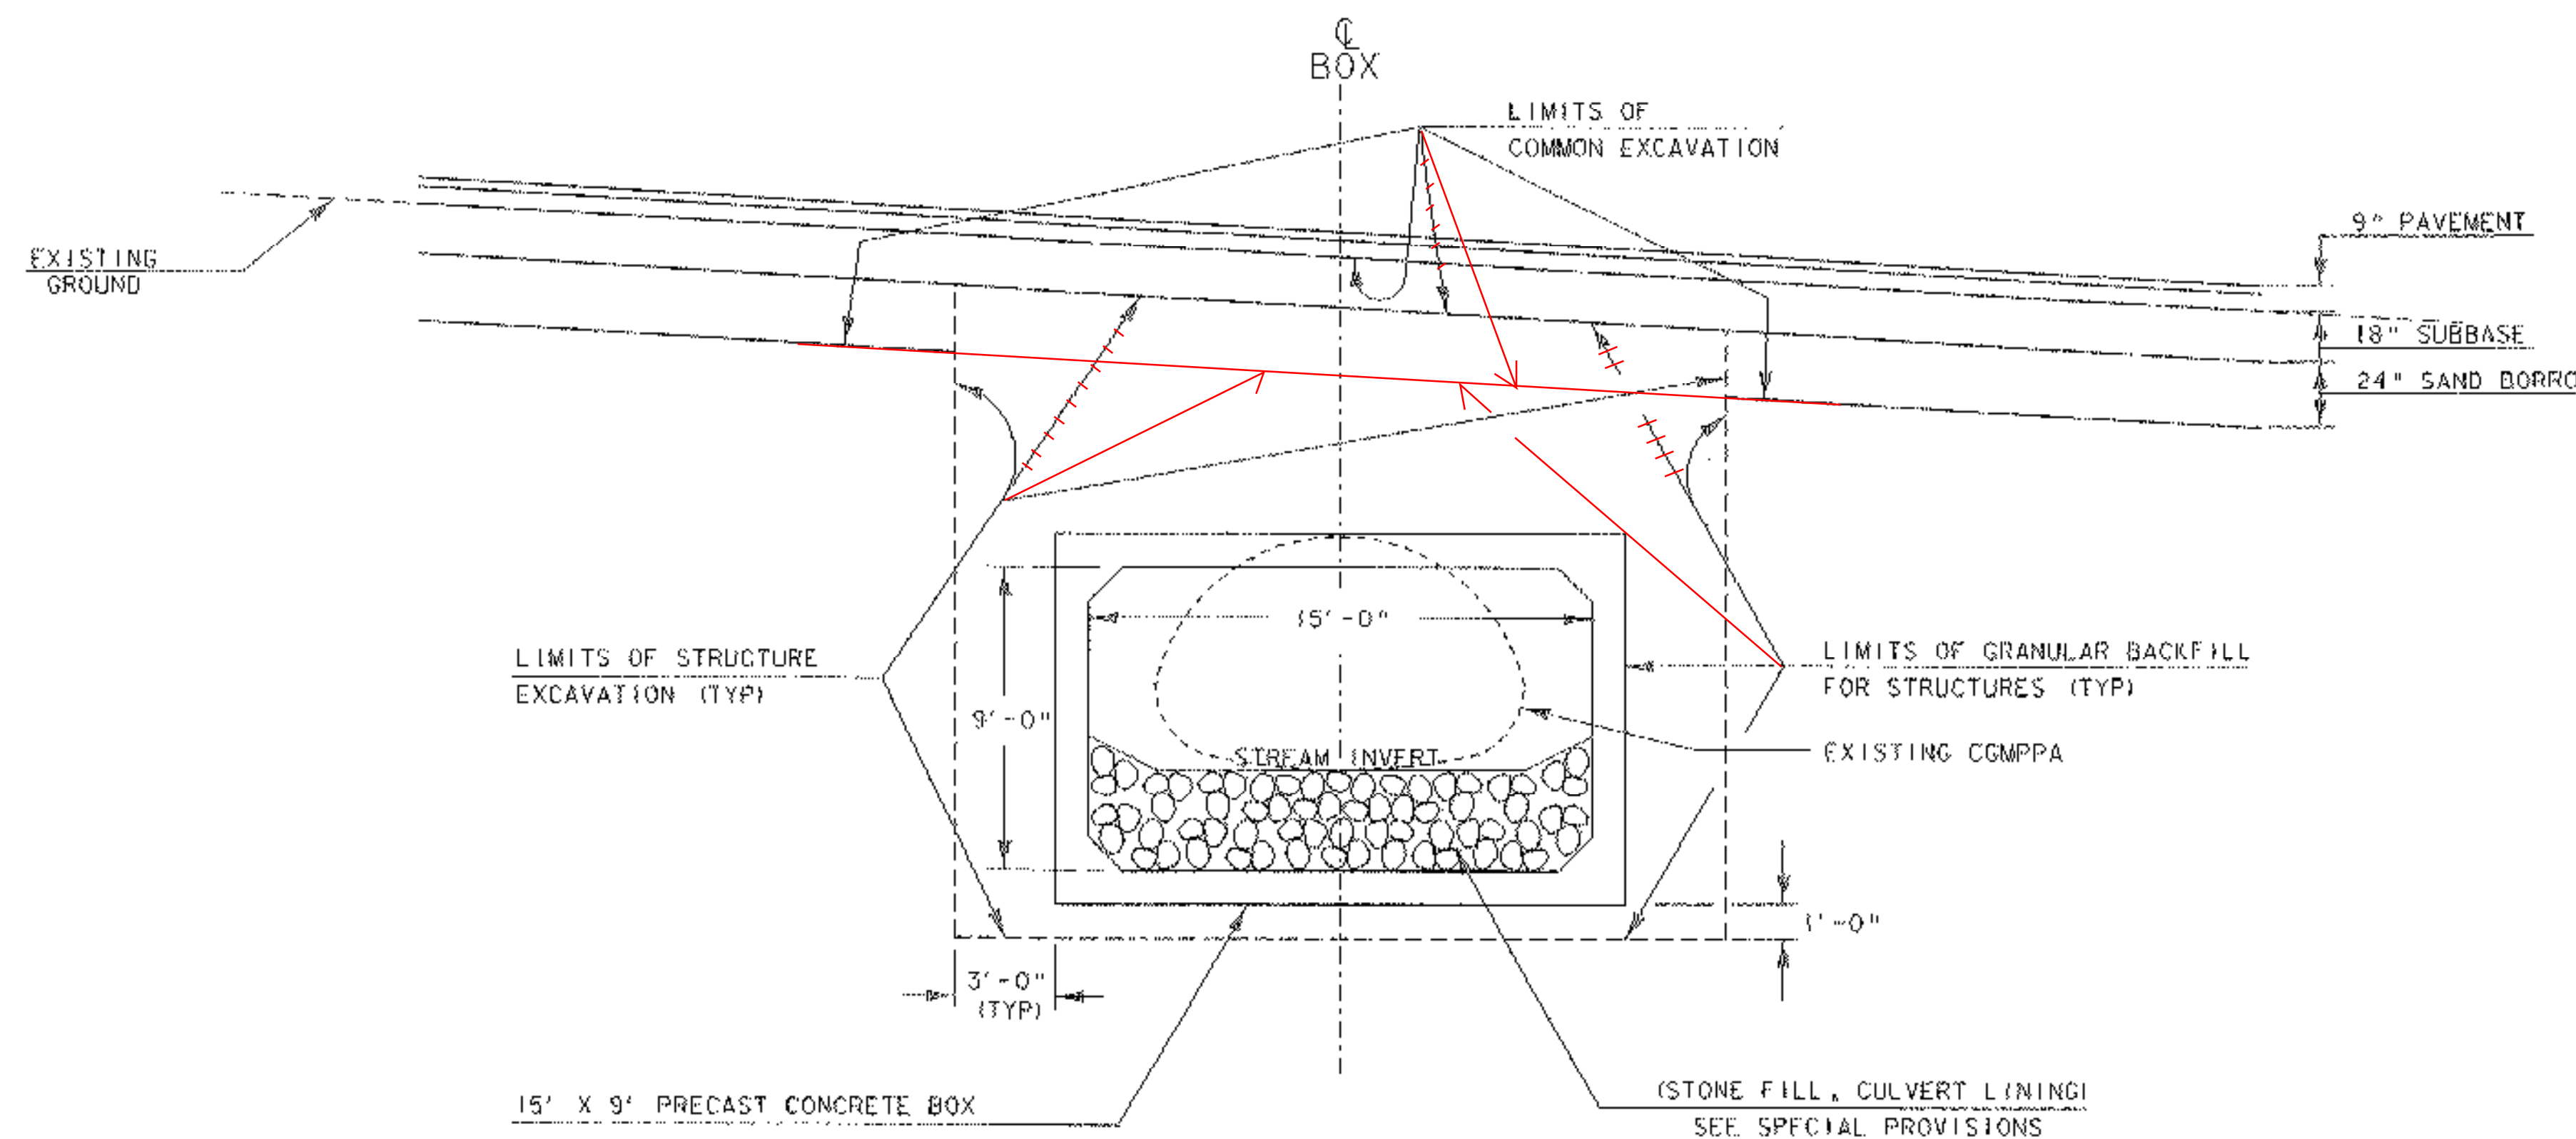

**TYPICAL BOX SECTION**

NOT TO SCALE

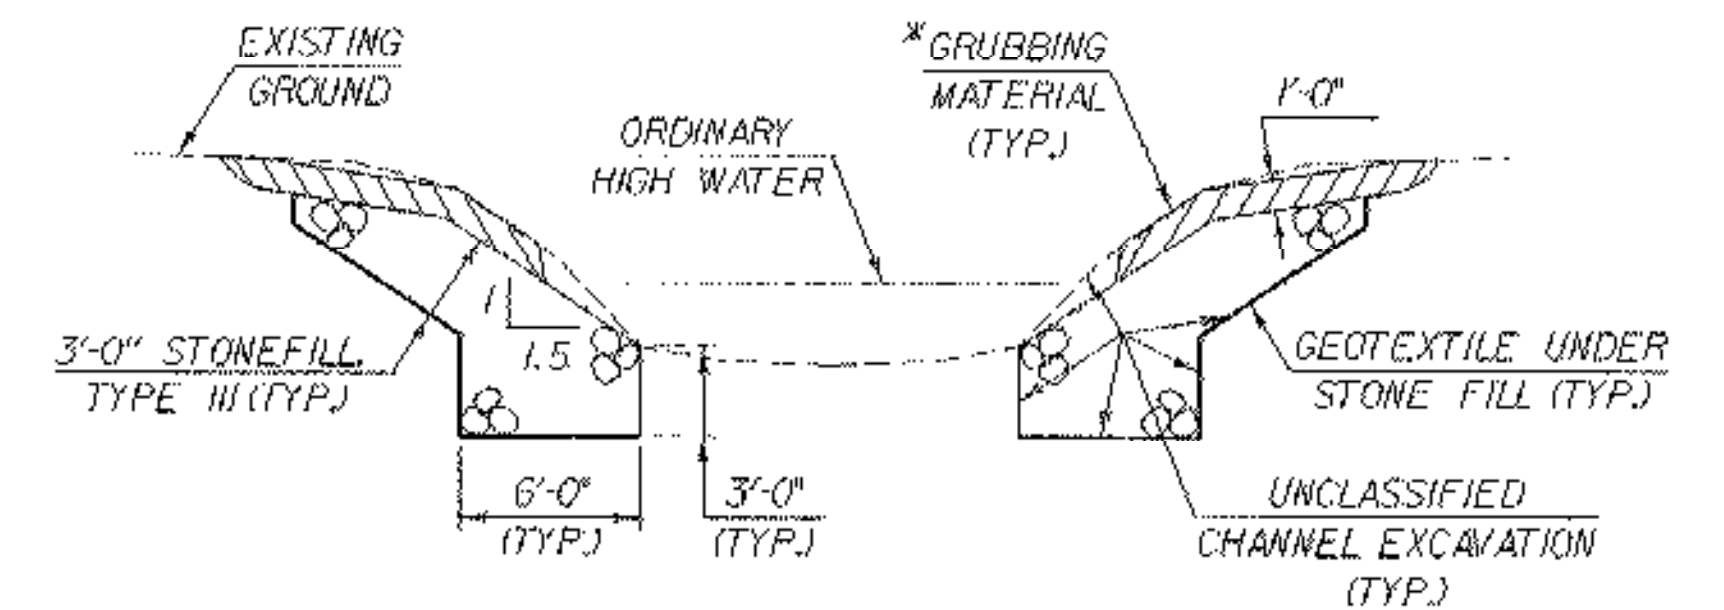

**TYPICAL CHANNEL SECTION**

(NOT TO SCALE)



\*GRUBBING MATERIAL SHALL NOT BE PLACED ON THE STONE FILL IN THE BOX.  
 WHENEVER CHANNEL SLOPE INTERSECTS ROADWAY SUBBASE, GRUBBING MATERIAL SHALL BEGIN AT THE BOTTOM OF SUBBASE.

**TYPICAL SECTIONS**

PROJECT NAME:	JAY
PROJECT NUMBER:	ST STP CULV (2)
FILE NAME:	04b140\04b140typ.dgn
PROJECT LEADER:	W. SYMONDS
DESIGNED BY:	T. FILLBACH
04b140typ.i	
PLOT DATE:	23-OCT-2006
DRAWN BY:	G. SHANDRAW
CHECKED BY:	T. SUMNER
SHEET	3 OF 39




GPS CONTROL POINTS

TRAVERSE TIES

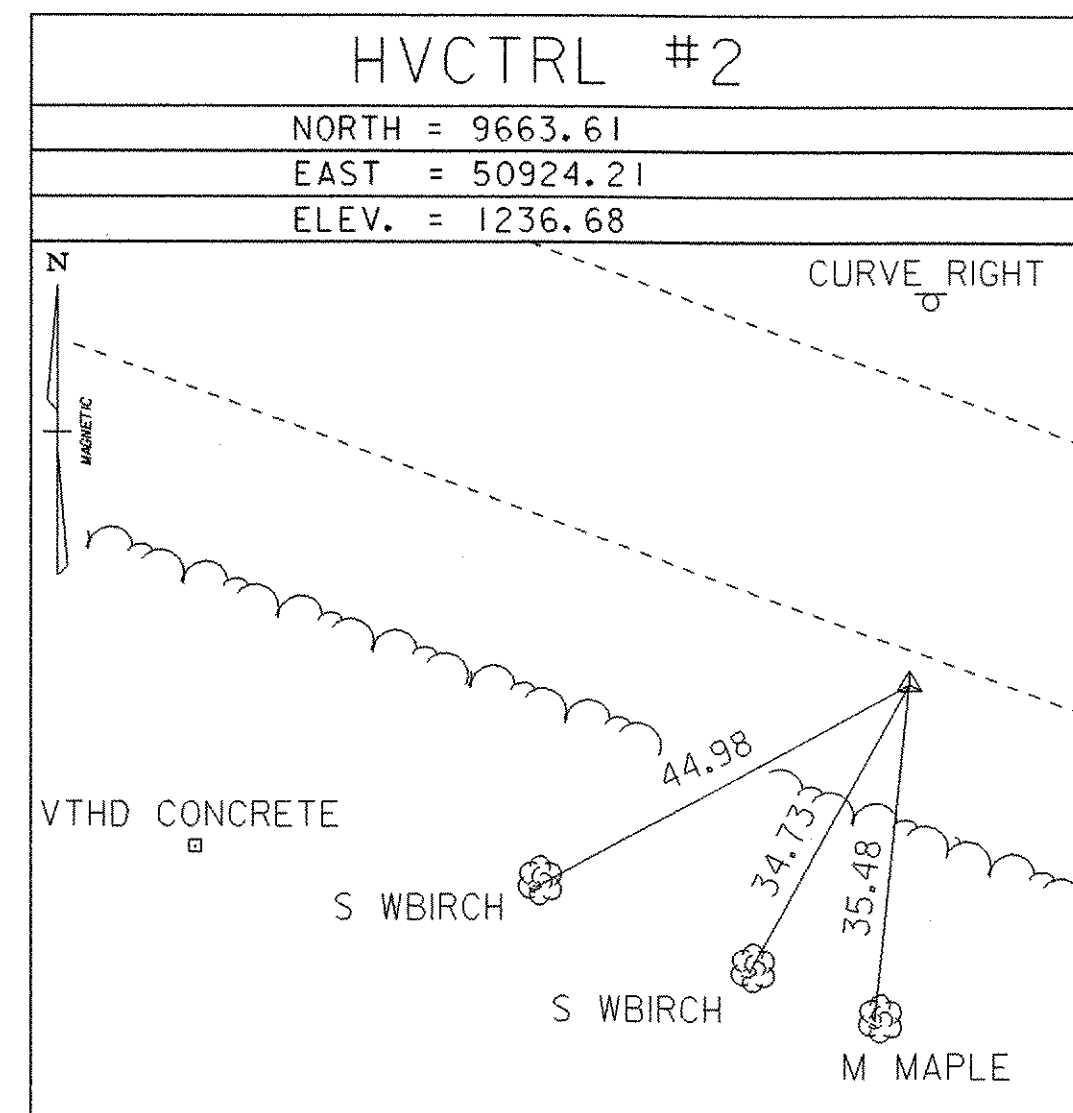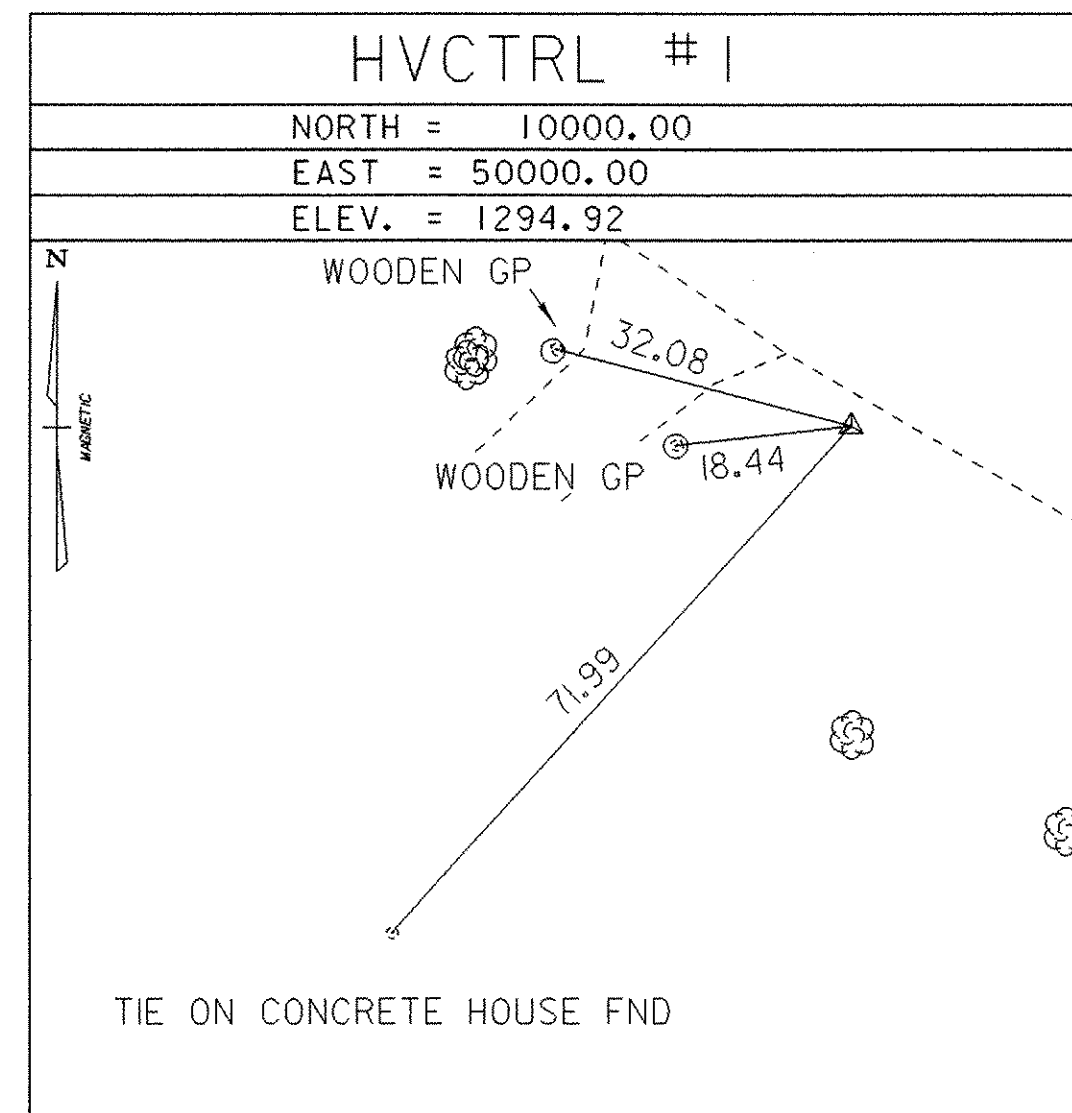

• Traverse Completed 11-08-2004 by R. Gilman P.C. & P. Winters

ALIGNMENT TIES

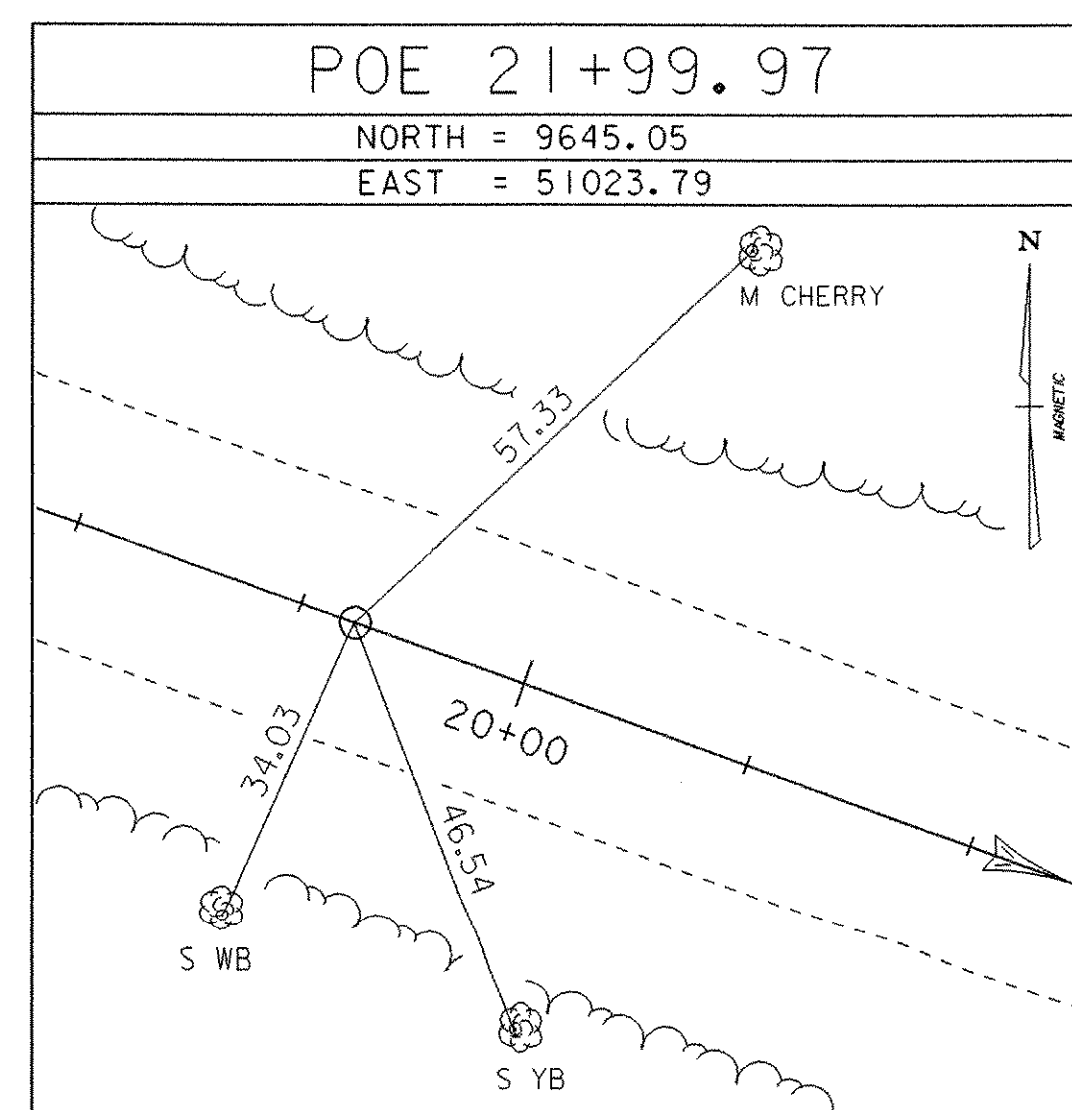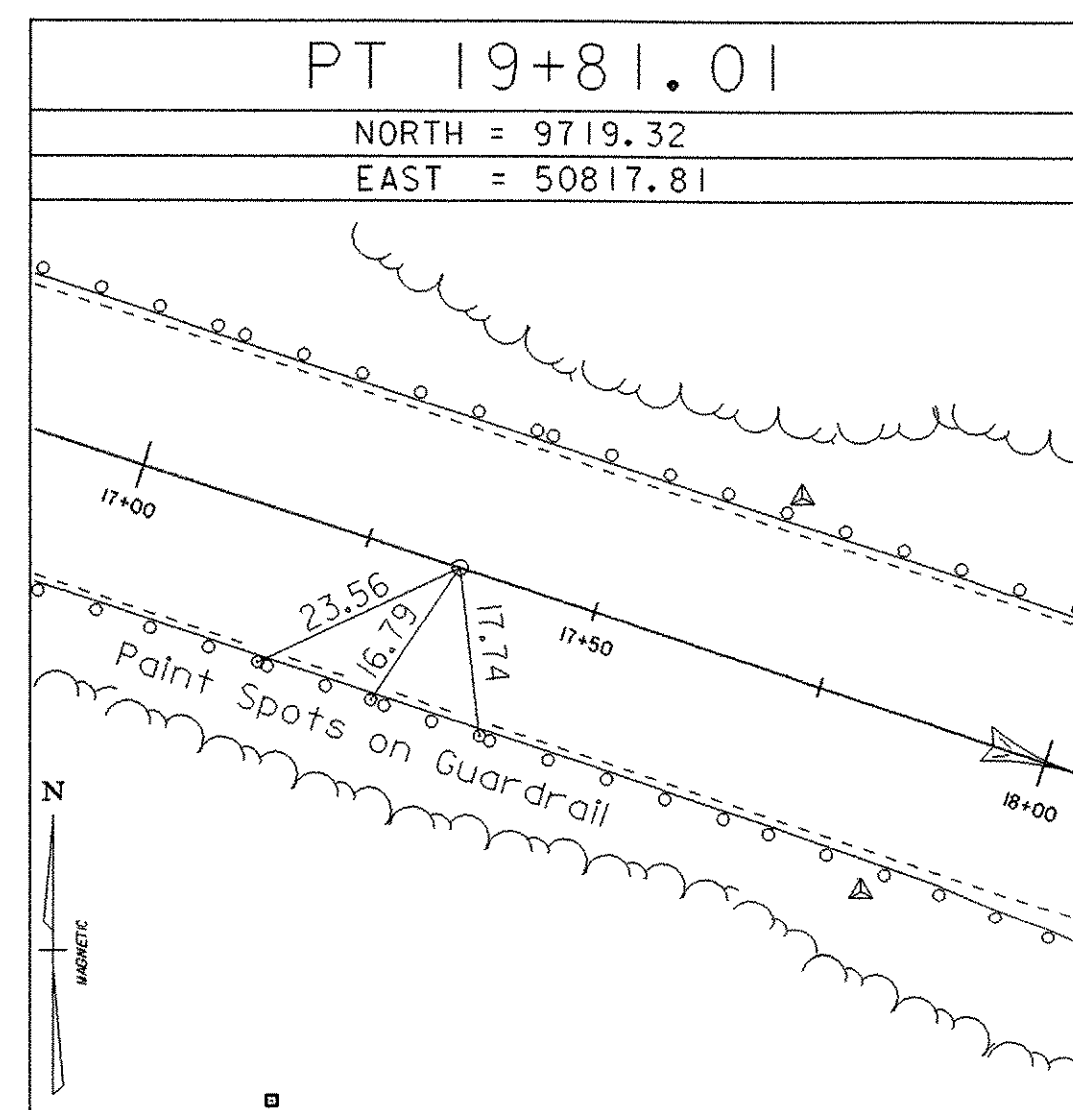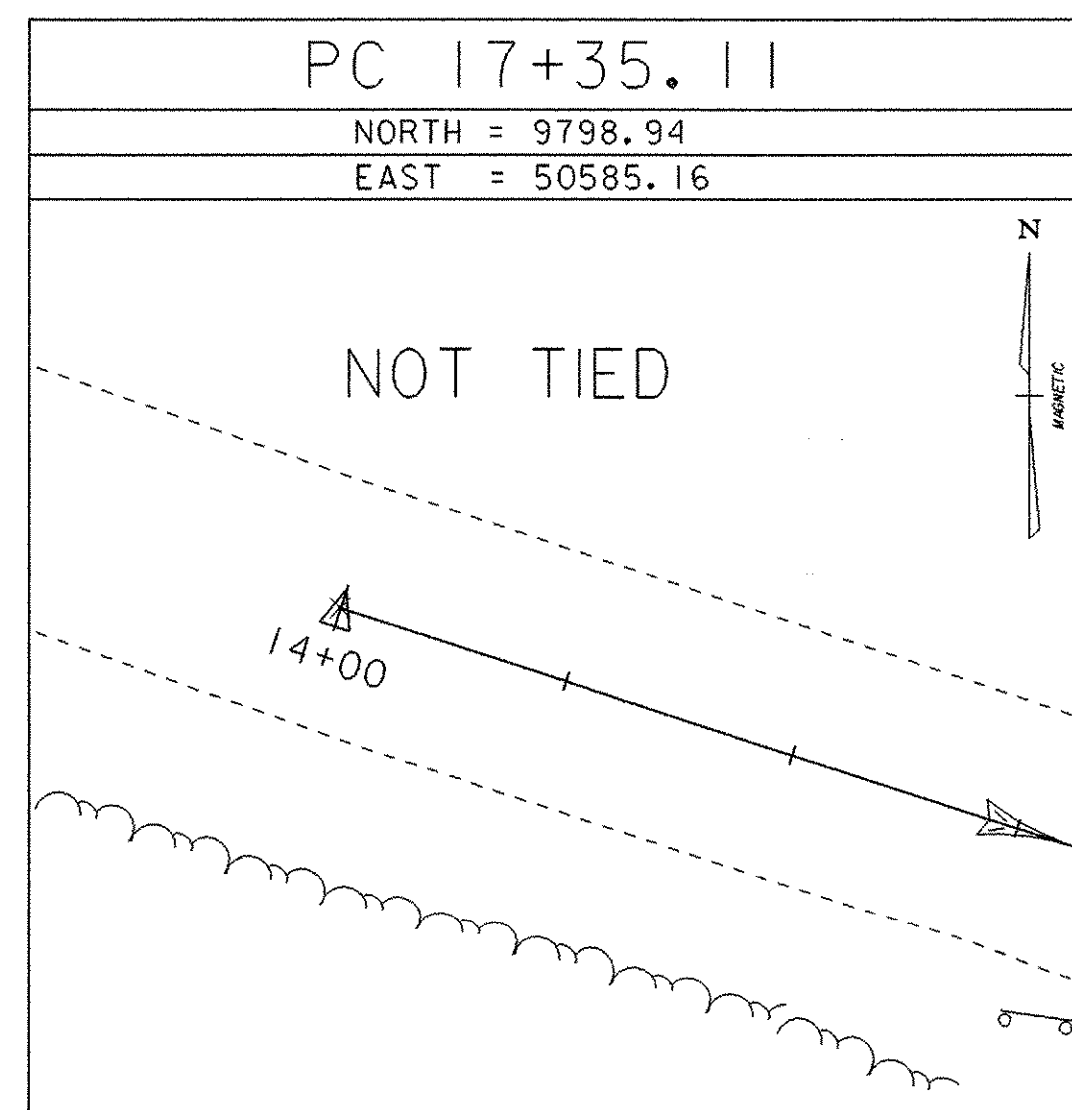

• Alignment Staked 05-15-2006 by R. Gilman P.C. & P. Winters

DATUM	
VERTICAL	NAVD 1929
HORIZONTAL	ASSUMED
ADJUSTMENT	N/A

TIE SHEET

PROJECT NAME:	JAY	PLOT DATE:	23-OCT-2006
PROJECT NUMBER:	ST STP CULV (2)	DRAWN BY:	R. BULLOCK
FILE NAME:	04b140\survey\04b140t1.dgn	CHECKED BY:	P. WINTERS
DESIGNED BY:	R. Gilman	SHEET	4 OF 39

# QUANTITY SHEET


SUMMARY OF ESTIMATED QUANTITIES										TOTALS		DESCRIPTIONS				DETAILED SUMMARY OF QUANTITIES			
							ROADWAY	EROSION CONTROL	BRIDGE	FULL C.E. ITEMS	GRAND TOTAL	FINAL	UNIT	ITEMS	ITEM NUMBER	ROUND	QUANTITIES	UNIT	ITEMS
							1				1		LS	CLEARING AND GRUBBING, INCLUDING INDIVIDUAL TREES AND STUMPS	201.10				
							520				520		CY	COMMON EXCAVATION	203.15				
									210		210		CY	UNCLASSIFIED CHANNEL EXCAVATION	203.27				
							130				130		CY	SAND BORROW	203.31				
							10	10			20		CY	TRENCH EXCAVATION OF EARTH	204.20				
									900		900		CY	STRUCTURE EXCAVATION	204.25				
									500		500		CY	GRANULAR BACKFILL FOR STRUCTURES	204.30				
							315				315		SY	COLD PLANING, BITUMINOUS PAVEMENT	210.10				
							170				170		CY	SUBBASE OF DENSE GRADED CRUSHED STONE	301.35				
							3				3		CWT	EMULSIFIED ASPHALT	404.65				
							250				250		TON	MEDIUM DUTY BITUMINOUS CONCRETE PAVEMENT (PG 58-34)	406.27				
									80		80		SY	SHEET MEMBRANE WATERPROFNG, PREFORMED SHEET	519.21				
									1		1		EACH	REMOVAL OF STRUCTURE (975 SF - EST.)	529.15				
									1		1		LS	PRECAST CONCRETE STRUCTURE (15' X 9' X 80' BOX)	540.10				
							10				10		HR	ALL PURPOSE EXCAVATOR RENTAL, TYPE I	608.25				
							8				8		CY	STONE FILL, TYPE I	613.10				
									12		12		CY	STONE FILL, TYPE II	613.11				
									200		200		CY	STONE FILL, TYPE III	613.12				
							450				450		LF	HD STEEL BEAM GUARDRAIL, GALVANIZED W/8 FEET POSTS	621.215				
							3				3		EACH	MANUFACTURED TERMINAL SECTION, FLARED	621.50				
							434				434		LF	REMOVAL AND DISPOSAL OF GUARDRAIL	621.80				
							100				100		HR	FLAGGERS	630.15				
										1	1		LS	FIELD OFFICE, ENGINEERS	631.10				
										1	1		LS	TESTING EQUIPMENT, BITUMINOUS	631.17				
										1	1		LU	FIELD OFFICE TELEPHONE (N.A.B.I.)	631.25				
							1				1		LS	MOBILIZATION/DEMOBILIZATION	635.11				
							1				1		LS	TRAFFIC CONTROL	641.10				
							2				2		EACH	PORTABLE CHANGEABLE MESSAGE SIGN	641.15				
							410				410		LF	DURABLE 4 INCH WHITE LINE, THERMOPLASTIC	646.402				
							410				410		LF	DURABLE 4 INCH YELLOW LNE, THERMOPLASTIC	646.412				
									275		275		SY	GEOTEXTILE UNDER STONE FILL	649.31				
								10			10		LB	SEED	651.15				
								60			60		LB	FERTILIZER	651.18				
							.5				.5		TON	AGRICULTURAL LIMESTONE	651.20				
							.5				.5		TON	HAYMULCH	651.25				
							70				70		SY	GRUBBING MATERIAL	651.40				
							1				1		LS	EPSC PLAN	652.10				
							15				15		HR	MONITORING EPSC PLAN	652.20				
							1				1		LU	MAINTENANCE OF EPSC PLAN (N.A.B.I.)	652.30				
							620				620		SY	TEMPORARY EROSION MATTING	653.20				

PROJECT NAME: **JAY**  
PROJECT NUMBER: **ST STP CULV(2)**  
FILE NAME: S04B140QS.XLS  
PROJECT MANAGER: W. SYMONDS  
DESIGNED BY: T. FILLBACH  
QUANTITY SHEET #1  
PLOT DATE: 10/10/2006  
DRAWN BY: G. SHANGRAW  
CHECKED BY: J. LACROIX  
SHEET 5 OF 39

# QUANTITY SHEET

SUMMARY OF ESTIMATED QUANTITIES										TOTALS		DESCRIPTIONS			DETAILED SUMMARY OF QUANTITIES				
							ROADWAY	EROSION CONTROL	BRIDGE	FULL C.E. ITEMS	GRAND TOTAL	FINAL	UNIT	ITEMS	ITEM NUMBER	ROUND	QUANTITIES	UNIT	ITEMS
								10			10		CY	TEMPORARY STONE CHECK DAM, TYPE I	653.25				
								10			10		CY	VEHICLE TRACKING PAD	653.35				
								650			650		LF	PROJECT DEMARCATION FENCE	653.55				
							8				8		LF	FLANGED CHANNEL SIGN POST	675.301				
							1				1		EACH	REMOVING SIGNS	675.50				
							1				1		EACH	ERECTING SALVAGED SIGNS	675.60				
									135		135		CY	SPECIAL PROVISION (STONE FILL, CULVERT LINING)	900.608				
									4		4		GAL	SPECIAL PROVISION (WATER REPELLENT, SILANE)	900.625				
							1				1		LS	SPECIAL PROVISION (TEMPORARY RELOCATION OF STREAM)	900.645				
							1				1		LU	SPECIAL PROVISION (NCENTIVE/DISINCENTIVE)(N.A.B.)	900.650				

PROJECT NAME: JAY  
 PROJECT NUMBER: ST STP CULV(2)  
 FILE NAME: S04B140QS.XLS PLOT DATE: 10/10/2006  
 PROJECT MANAGER: W. SYMONDS DRAWN BY: G. SHANGRAW  
 DESIGNED BY: T. FILLBACH CHECKED BY: J. LACROIX  
 QUANTITY SHEET #2 SHEET 6 OF 39

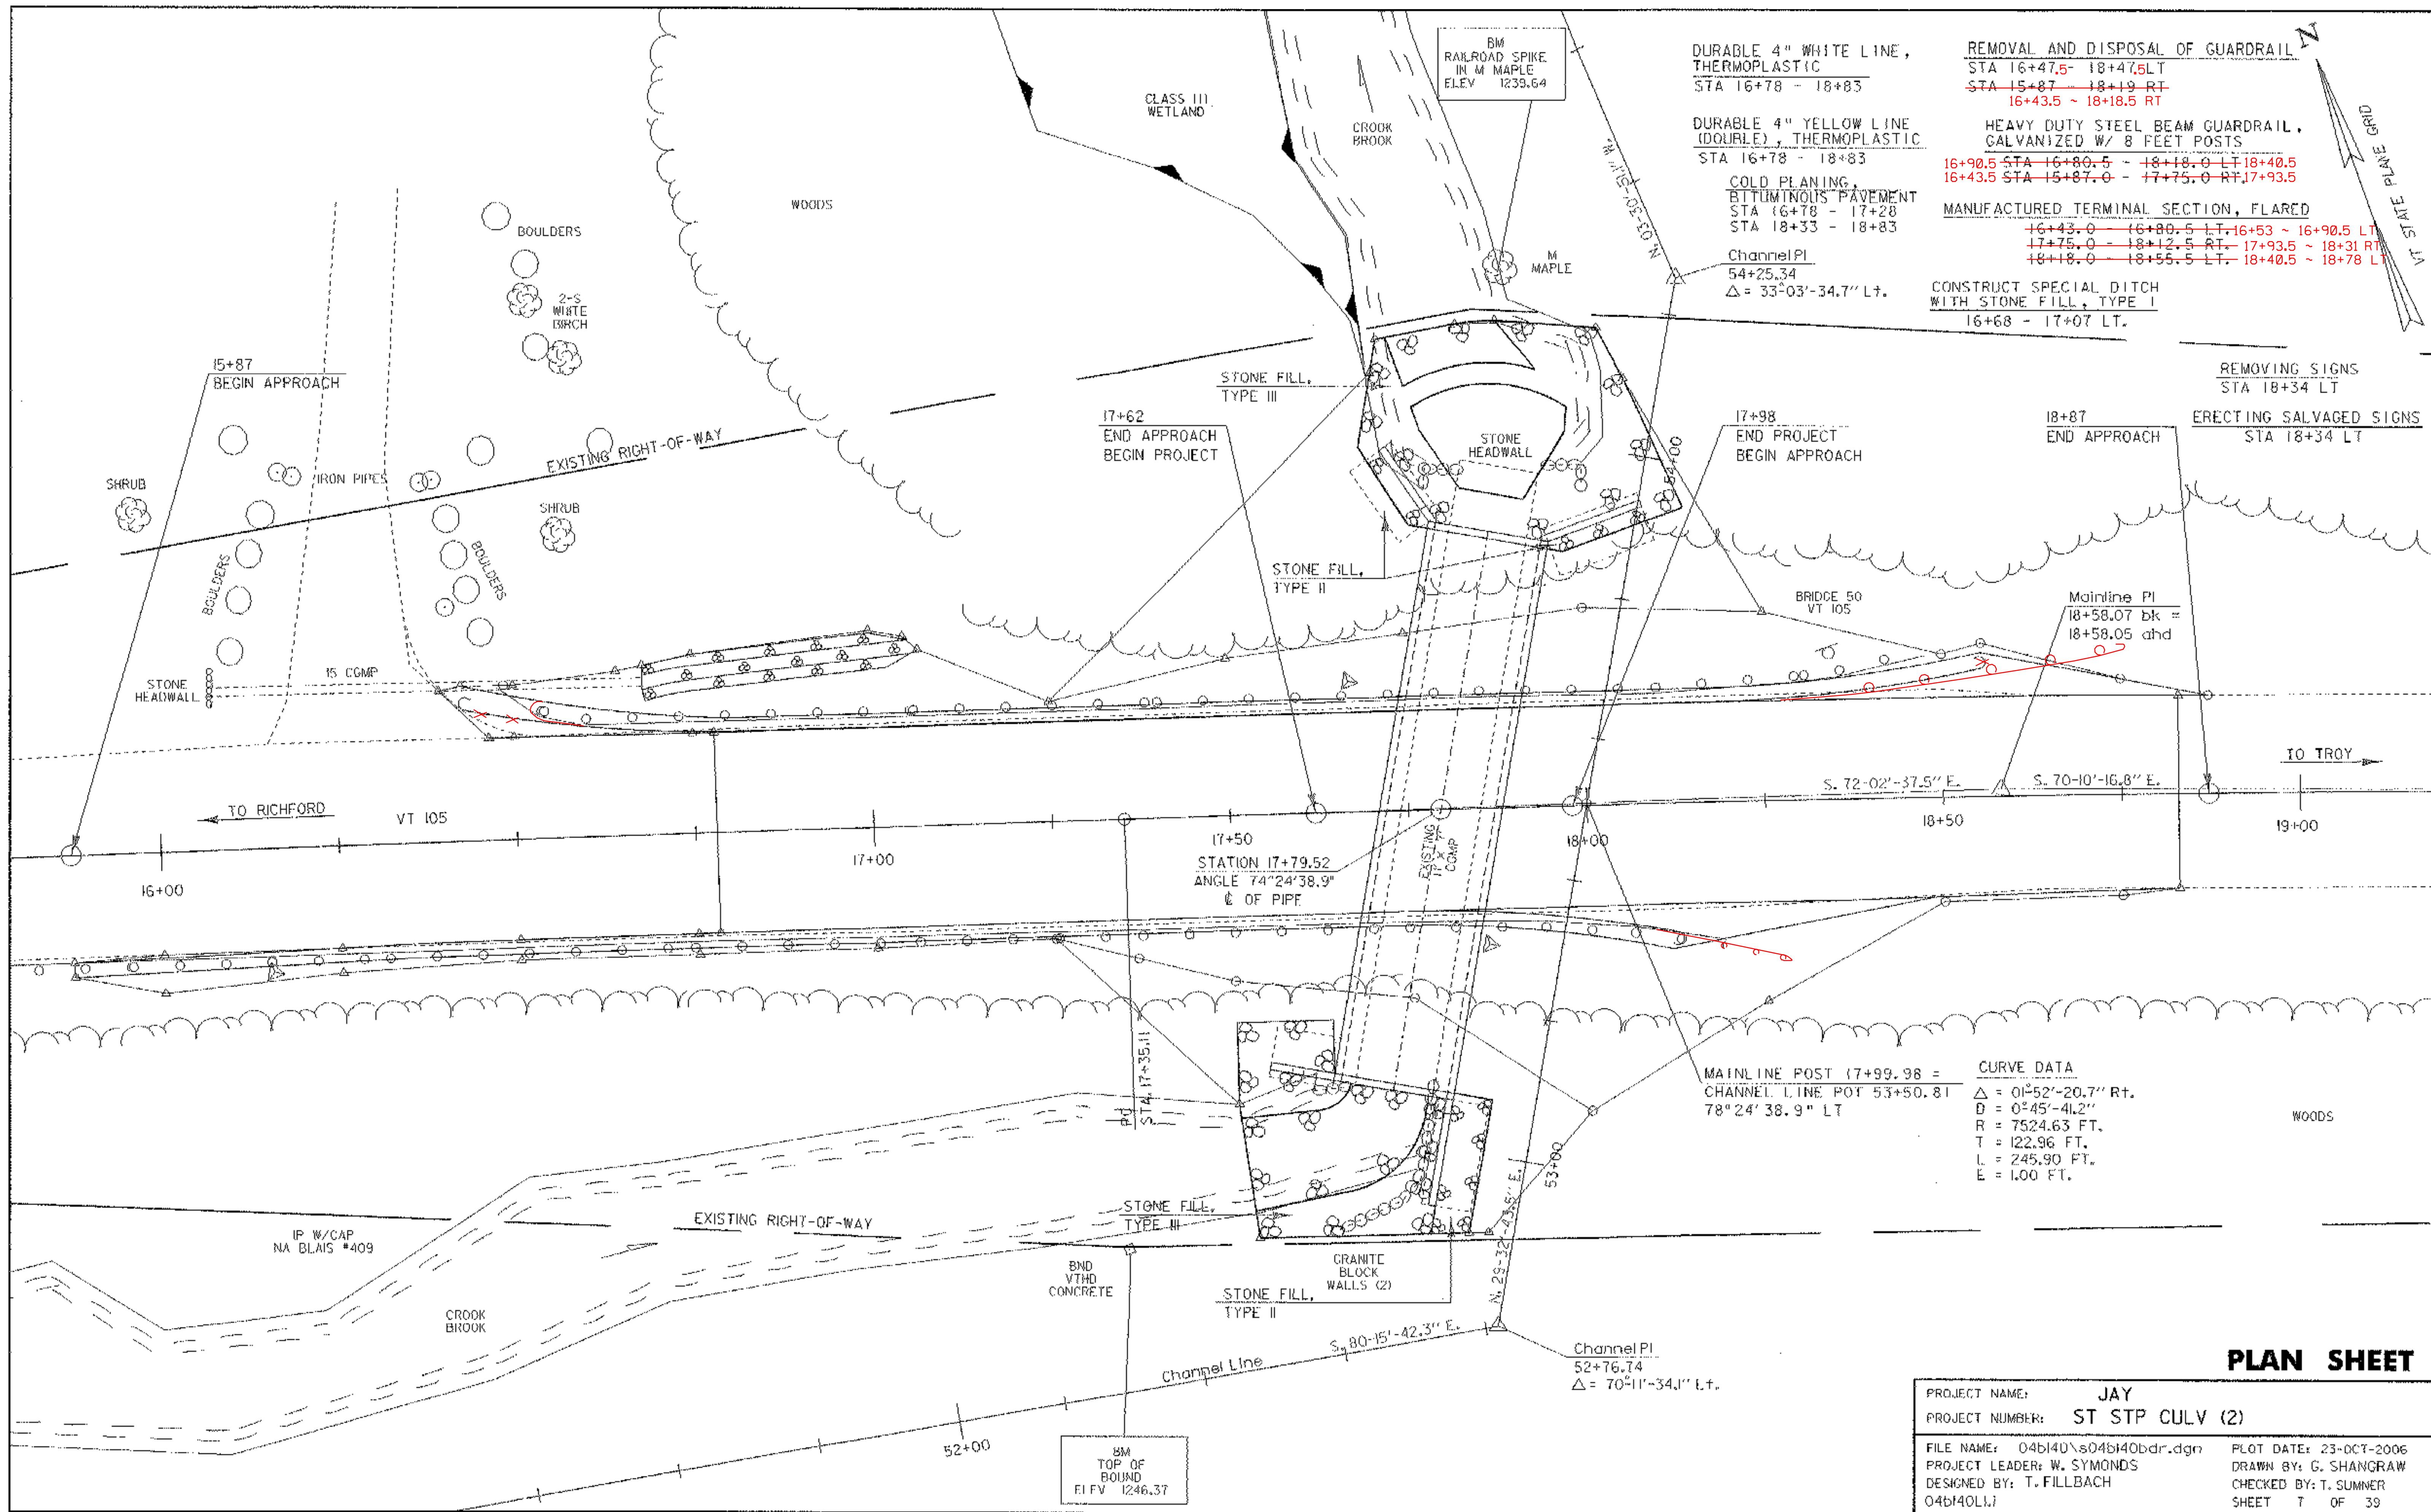

REMOVAL AND DISPOSAL OF GUARDRAIL  
 STA 16+47.5 - 18+47.5 LT  
~~STA 15+87 - 18+19 RT~~  
 16+43.5 ~ 18+18.5 RT

HEAVY DUTY STEEL BEAM GUARDRAIL,  
 GALVANIZED W/ 8 FEET POSTS  
 16+90.5 STA 16+80.5 - 18+18.0 LT 18+40.5  
 16+43.5 STA 15+87.0 - 17+75.0 RT 17+93.5

MANUFACTURED TERMINAL SECTION, FLARED  
 16+43.0 - 18+80.5 LT 16+53 ~ 16+90.5 LT  
 17+75.0 - 18+12.5 RT 17+93.5 ~ 18+31 RT  
 18+18.0 - 18+55.5 LT 18+40.5 ~ 18+78 LT

CONSTRUCT SPECIAL DITCH  
 WITH STONE FILL, TYPE I  
 16+68 - 17+07 LT.

REMOVING SIGNS  
 STA 18+34 LT

ERECTING SALVAGED SIGNS  
 STA 18+34 LT

Mainline PI  
 18+58.07 bk =  
 18+58.05 ahd

TO RICHFORD ← VT 105



TO TROY →

CURVE DATA  
 $\Delta = 01^{\circ}52'20.7''$  Rt.  
 $D = 0^{\circ}45'41.2''$   
 $R = 7524.63$  FT.  
 $T = 122.96$  FT.  
 $L = 245.90$  FT.  
 $E = 1.00$  FT.


Channel PI  
 54+25.34  
 $\Delta = 33^{\circ}03'34.7''$  Lt.

Channel PI  
 52+76.74  
 $\Delta = 70^{\circ}11'34.1''$  Lt.

<b>PLAN SHEET</b>	
PROJECT NAME:	JAY
PROJECT NUMBER:	ST STP CULV (2)
FILE NAME:	04b140\04b140bdr.dgn
PROJECT LEADER:	W. SYMONDS
DESIGNED BY:	T. FILLBACH
PLOT DATE:	23-OCT-2006
DRAWN BY:	G. SHANGRAW
CHECKED BY:	T. SUMNER
SHEET	T OF 39

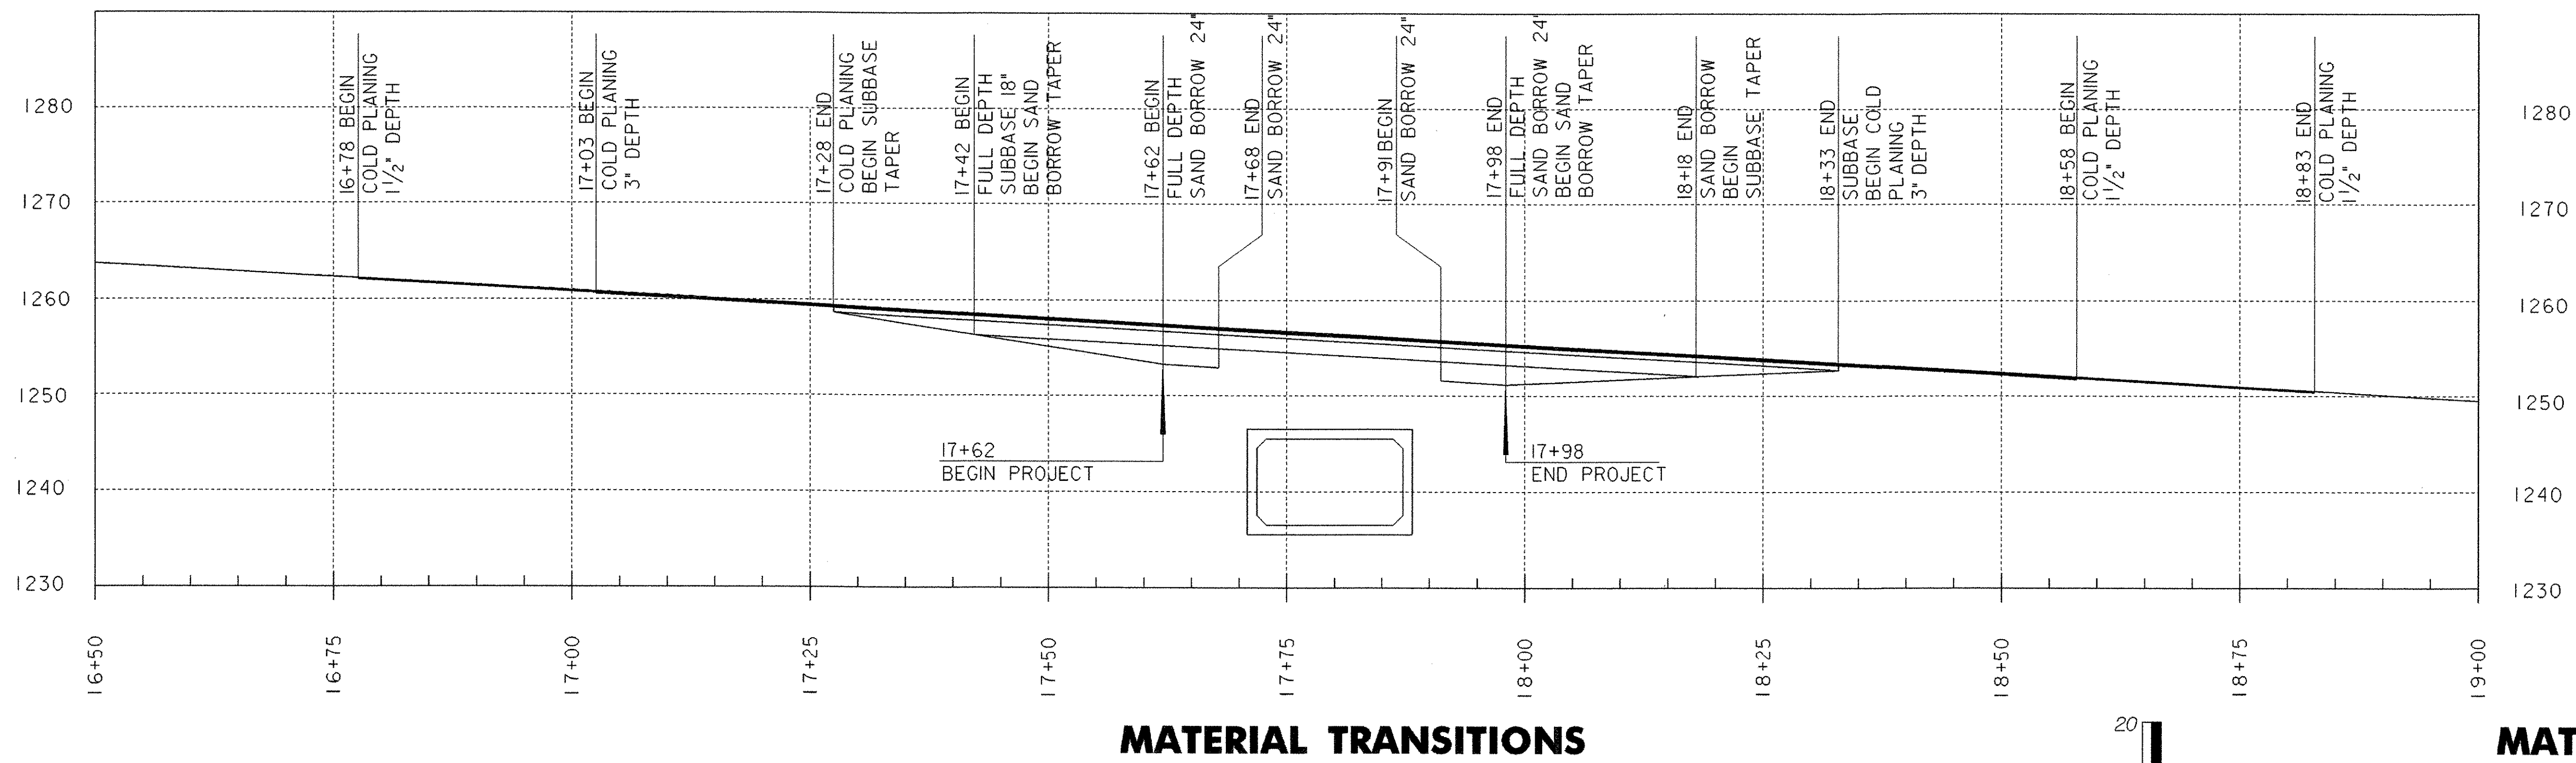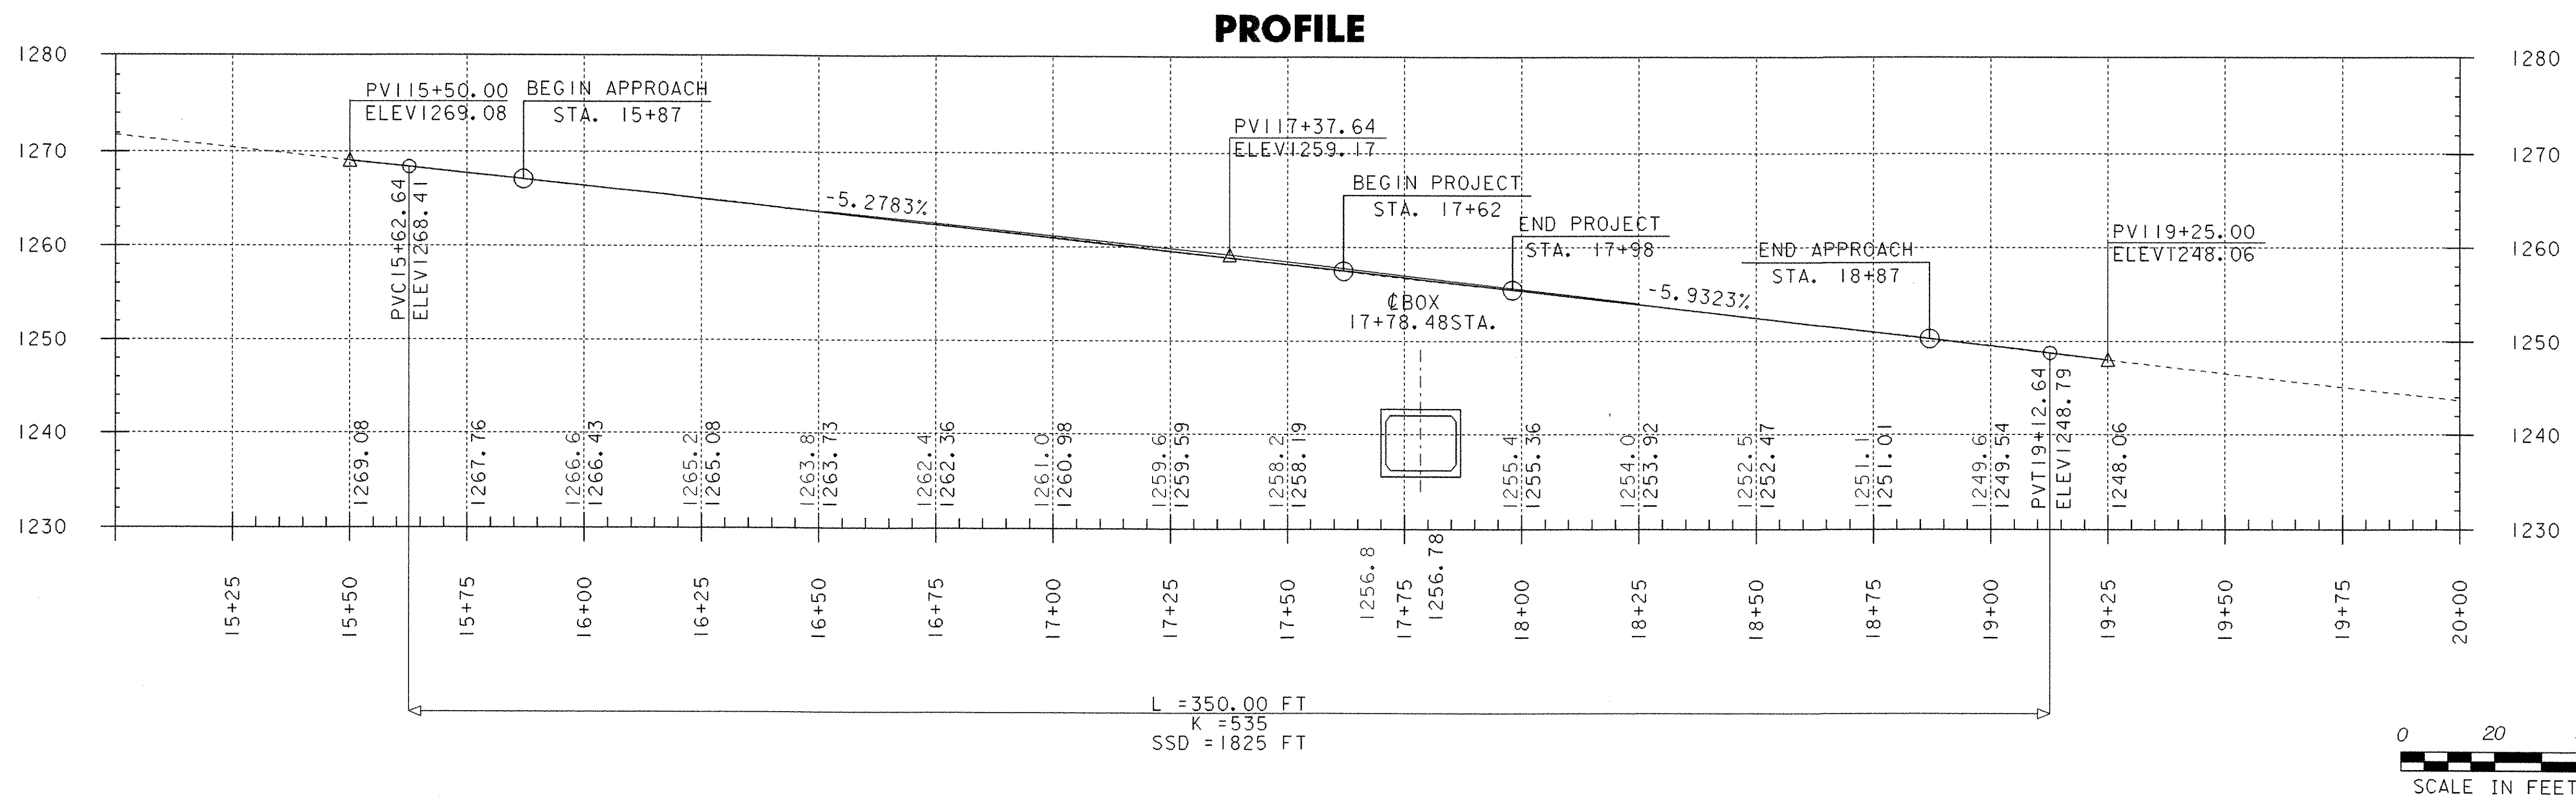

PROJECT NAME:	JAY	
PROJECT NUMBER:	ST STP CULV (2)	
FILE NAME:	04b140\s04b140bdr.dgn	PLOT DATE: 23-OCT-2006
PROJECT LEADER:	W. SYMONDS	DRAWN BY: G. SHANGRAW
DESIGNED BY:	T. FILLBACH	CHECKED BY: T. SUMNER
04b140profile.i		SHEET 8 OF 39

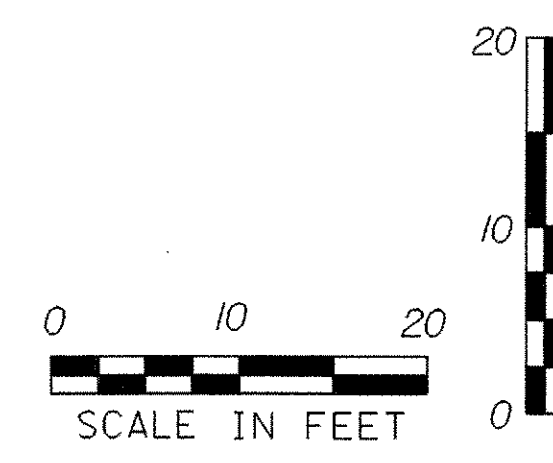

# EROSION CONTROL NARRATIVE

## GENERAL EROSION PREVENTION & SEDIMENT CONTROL (EPSC) GUIDELINES

The Erosion Control plans are intended as a guide for preventing soil erosion and controlling sediment. The work outlined in this narrative consists of applying measures throughout the duration of the project to control erosion and minimize the sedimentation of the receiving waters.

A Temporary erosion control plan will be submitted by the contractor for approval by the Agency of Transportation.

The contractor will use other temporary or permanent erosion control devices as necessitated by the sequence of construction and as directed by the Resident Engineer. See Subsection 105.23 of the 2006 Vermont Standard Specifications for Construction.

The contractor shall coordinate the installation, use, and removal of erosion and sediment control measures with construction activities to assure economical, effective, and continuous erosion and sediment control. The contractor shall employ temporary stabilization practices in incremental stages as construction activities proceed.

The Resident Engineer may direct the installation of certain erosion control measures in order to forestall or mitigate potential or existing erosion problems, or to respond to storm events or damage by construction operations.

The contractor shall install erosion and sediment control measures as sequenced on the EPSC Plan, or as directed by the Resident Engineer. The type, size, and location of any erosion control device shall not be changed unless prior approval is obtained from the Resident Engineer. Any approved changes shall be noted on the EPSC Plans and discussed in the weekly report. The contractor shall inspect all erosion control measures daily and after each rainfall event. The contractor shall repair all damaged erosion control measures immediately. All erosion control measures that trap sediment, such as sediment basins and silt fences, shall be cleaned out when their capacity reaches 50%.

The Resident Engineer's approval should be obtained prior to installing any erosion controls not specified in the EPSC Plans. However, in emergency situations where the Resident Engineer is not immediately available, the contractor should repair or install the erosion controls as he/she deems necessary and report the incident to the Resident Engineer as soon as it is practical.

The contractor shall control all sediment-laden runoff within the project site. Clean runoff from outside the project site shall be routed through the project site using diversion berms, diversion channels, and temporary or permanent culverts.

Construction equipment will not be allowed to operate on the outside of the perimeter control measures.

Construction equipment will not be allowed to cross a flowing stream, or disturb the existing stream banks, unless authorized by the Resident Engineer.

All in-stream construction must take place in a dry channel between June 1st and October 1st.

In general, preserve existing vegetation, shrubs, and trees whenever possible.

Silt fence shall be placed at the toes of all fill slopes and shall be constructed so that flows cannot bypass the ends. Areas directly below (downhill) of the silt fences must be un-disturbed and vegetated.

As construction progresses, implementation of additional erosion control measures may be required as deemed necessary by the On-Site Coordinator and as approved by the Resident Engineer.

## INFORMATION REQUIRED FROM CONTRACTOR

Much of the erosion control information shown on the erosion control plans and described in this narrative is general in nature. More site specific information is not yet available as a contractor has not yet been selected. The following list outlines some of the specific information that is not included in the erosion control plans and described in this narrative:

1. The location of vehicle tracking pads.
2. The location of stockpiles, staging areas, and disposal areas.
3. A specific timetable of construction and earthwork activities.
4. The name, title, qualifications, and contact information for the on-site project coordinator.
5. The sequencing of construction activities and specific measures that will be implemented in conjunction with these activities.
6. The Contractor is required to submit the "EPSC Contractor Checklist" for review and approval by the VTrans Construction Environmental Engineer prior to commencement of construction.

## DESCRIPTION OF PROJECT

This project involves reconstruction of bridge # 50 over Crook Brook on VT 105 in the town of Jay. Crook Brook is characterized as a moderately steep stream with some bank erosion but mostly stable. The streambed consists of Gravel and Cobbles. The total drainage area is 1.5 square miles.

Features of concern with respect to erosion control include embankments immediately adjacent to the project. A new buried precast concrete box will be constructed on the existing alignment. Traffic will be maintained with a detour as shown on the project plans. The construction limits do not approach any buildings or any other structures outside the project limits.

It is anticipated that the project will last one construction season.

Disturbed area (excluding waste, borrow, and staging areas) = 0.20 acres. Estimated Total disturbed area (including waste, staging, and borrow) is anticipated to be less than 1 Acre.

## SITE INVENTORY ANALYSIS

### 1. OFF SITE DRAINAGE CHARACTERISTICS AND TOPOGRAPHY

The area outside the immediate vicinity of this project is primarily Mixed dense woods, and is hilly to mountainous. VT Route 105 is a paved state highway, and is in excess of 6% gradient. There is very limited development, consisting mainly of farms which are located approximately 3000 feet westerly of the project. There is a gravel drive approximately 150 feet westerly of the outlet end of the culvert. A drive culvert beneath the drive drains roadside and drainage from a mown field into the wetland area near the outlet end of the culvert.

### 2. DRAINAGE, WATERWAYS, AND BODIES OF WATER.

There is a manmade pond and a large mown field northwesterly of the project, approximately 100 feet distance from the nearest disturbed soils, and at a higher elevation than the project. The Pond eventually drains into Crook Brook further downstream of the project. A Wetland area has been identified and is located along the northwestern streambank, just outside the project limits. It is shown on the project plans.

### 3. DESCRIPTION OF EXISTING VEGETATIVE COVER

In the immediate vicinity of the project, the existing ground cover is mostly grassy with intermittent deciduous shrubs and small trees, as depicted on the plans by the area survey.

### 4. DESCRIPTION OF EXISTING SOILS

A detailed description of the soil types expected to be encountered in the project area is unavailable at this time. For the purpose of this narrative we are using engineering judgment to classify the soils expected to be encountered.

The soils are mostly engineered fills from a previous project. This soil exhibits a high percolation rate that results in low erodability.

## 5. SENSITIVE RESOURCE AREAS

In the immediate vicinity of the project, only identified areas are Crook Brook, and the Riparian Buffer.

## DESCRIPTION OF SLOPES

The existing shape of the project area can be seen by looking at the erosion control existing conditions sheet where the existing contours are shown. The contours are shown in dashed and depict the half foot interval. Major contours are shown at 5 foot intervals, and are labeled.

## EXISTING SLOPES

Generally speaking, the project impacts steep but short slopes.

## PROPOSED SLOPES

Fill slopes that are 1-2 (50%) or flatter will be seeded and mulched, 1-1.5 slopes will be sodded or lined with stone fill. These slopes will be protected until they are fully vegetated. The slopes along the channel banks will be lined with heavy stone and are at 1-1.5 (67%) slope.

## MAINTENANCE PLAN FOR EROSION AND SEDIMENT CONTROLS

The following maintenance schedule will be followed throughout the duration of the project.

1. An assigned individual who can be associated with the day-to-day operations of the project shall do monitoring of the construction site. The inspector will be familiar with this plan and with erosion & sediment control procedures and with road and bridge construction techniques. Site reviews will be performed at least once every seven calendar days, and within 24 hours of a storm event great enough to cause water to leave the construction site.
2. A copy of the Erosion Prevention and Sediment Control Weekly Plan Review prepared by the site reviewer shall be given to the Resident Engineer each week. The report will be filled out in accordance with the item 652.20 MONITORING EPSC Plan.
3. The plan preparer will be available for on-site consultations with the Resident Engineer within twenty four hours of the request.
4. All silt fences and stone check dams will be inspected each site visit by the designated inspector, as described below:
  - i. These controls will be maintained in good condition. Any silt fence or stone check dam that is ineffective will be repaired or replaced immediately.
  - ii. Sediment deposits will be removed when they reach one-half the height of the sediment control device.
  - iii. All sediments removed will be deposited in an upland portion of the project site, or disposed off-site in the designated project waste site.
5. All slopes will be checked each site visit and any eroded areas will be immediately repaired. Temporary stabilization methods will be used as necessary until final stabilization measures are in place.
6. Both temporary & permanent seeding & mulching will be checked each site visit for vegetative growth. Any areas requiring re-vegetation will be repaired immediately.
7. Drainage structures will be cleaned as necessary to remove any sediment buildup in the sump of the structures or at the inlet of the structure.
  - i. Any inlet control found to be ineffective will be replaced as necessary and will be done immediately.
  - ii. All sediments removed will be deposited in an upland portion of the project site, or disposed off-site in the designated project waste site.
8. Temporary construction accesses will be monitored each site visit. Any control found to be ineffective will be promptly replaced.
9. All temporary erosion control devices will stay in place until final grass growth has been established and complete stabilization of the areas has occurred.
10. Once stabilization has occurred, all temporary erosion control measures will be removed and all disturbed areas will be stabilized with erosion matting and/or seed & mulch.

PROJECT NAME:	JAY
PROJECT NUMBER:	ST STP CULV (2)
FILE NAME: 04b140\604b140x01.dgn	PLOT DATE: 23-OCT-2006
PROJECT LEADER: W. SYMONDS	DRAWN BY: T. FILLBACH
DESIGNED BY: T. FILLBACH	CHECKED BY: C. DIGIAMMARINO
EROSION CONTROL NARRATIVE	SHEET 11 OF 39

# EROSION CONTROL NARRATIVE

## SPECIFIC GUIDELINES

### PHASE 1 - ESTABLISH PERIMETER EROSION CONTROLS

Prior to any construction or staging, the contractor will install Vehicle Tracking pads leading to staging areas and the project site to prevent the tracking of silts and sediments offsite. Coarse stone fill over filter fabric should be utilized where an already established stable entrance does not exist. The crushed stone product used for the construction of the Vehicle Tracking pads shall be monitored for sediment accumulation and replaced as necessary as directed by the Resident Engineer. Vehicle Tracking pads shall also be established and maintained at all offsite waste and borrow areas.

After the clearing of trees and shrubs, but prior to any grubbing and excavation, construct perimeter controls to ensure that any sediment does not leave the site. Water treated with Sediment traps and basins may be directed to nearby streams or swales.

Install perimeter silt barrier in areas of proposed work as shown on the plans prior to grubbing and filling activities. In areas of high exposure, it may be necessary to double up protection with additional silt fencing or placement of hay bales behind the silt fencing. In areas of exposed ledge, stone check dams will be utilized.

During grubbing operations, stone check dam barriers shall be installed at any obvious concentrated flow discharge points, or as directed by the Resident Engineer.

After the grubbing activity all areas of exposed soils shall be temporarily stabilized with mulching & seeding, erosion matting, as soon as practicable and before any predicted rainfall event. These temporary erosion control measures can be placed in any combination in areas of potential erosion as deemed necessary by the Resident Engineer.

After perimeter controls are in place, and prior to grading operations, construct temporary onsite sediment traps and provide inlet protection where necessary. Grade disturbed areas to drain towards sediment trap where possible.

All material stockpiles, including but not limited to, grubbing material, sand borrow, earth borrow, granular borrow, topsoil, subbase, and any excavated waste piles shall also have silt fence installed around the base of the stockpile. The Contractor is required to obtain clearance by the VTrans Environmental Section prior to commencement of construction.

### PHASE 2 - ESTABLISH CULVERT EROSION CONTROLS

New slopes steeper than 50% (1-2 slope) will be constructed with stone fill for slope stabilization as the embankment construction progresses. All collected sediments should be removed from the settling structures and the ground shaped to its final grade and slope. Dispose of the collected sediments in an upland portion of the project, or in a manner approved by the Resident Engineer that will not result in sediments or pollutants entering the stream. The final design of the Sediment Basin will be provided by the Contractor.

### PHASE 3 - ESTABLISH ROADWAY EROSION CONTROLS

On any partially completed permanent cut and fill slopes, all exposed soils will be stabilized with erosion matting or seeded and mulched.

The subbase material should be placed as soon as the subgrade has reached its final grade and slope. The traveling surface will be graded to promote sheet flow off the surface onto slopes, or flows will be directed to collection areas and shall be transported down the fill slopes to sediment traps or settling basins.

All graded areas shall be permanently stabilized following final grading activities. All areas that are graded outside of the growing season shall be treated with slope stabilization until seeding & mulching can be performed.


### PHASE 4 - FINAL EROSION CONTROLS

Removal of silt fence shall commence only after all upslope areas are stabilized and well established, and the Resident Engineers has approved the removal.

Remove perimeter silt fences, and sediment traps, only after any toe-of-fill ditches have stabilized and vegetation is well established.


Remove all remaining temporary erosion control measures, regrade any areas if necessary, treat all regraded areas with erosion matting and or mulch & seed, and establishment of any final erosion control devices as deemed necessary by the Resident Engineer.

PROJECT NAME:	JAY
PROJECT NUMBER:	ST STP CULV (2)
FILE NAME: 04b140\604b140xc1.dgn	PLOT DATE: 23-OCT-2006
PROJECT LEADER: W. SYMONDS	DRAWN BY: T. FILLBACH
DESIGNED BY: T. FILLBACH	CHECKED BY: C. DIGIAMMARINO
EROSION CONTROL NARRATIVE	SHEET 12 OF 39

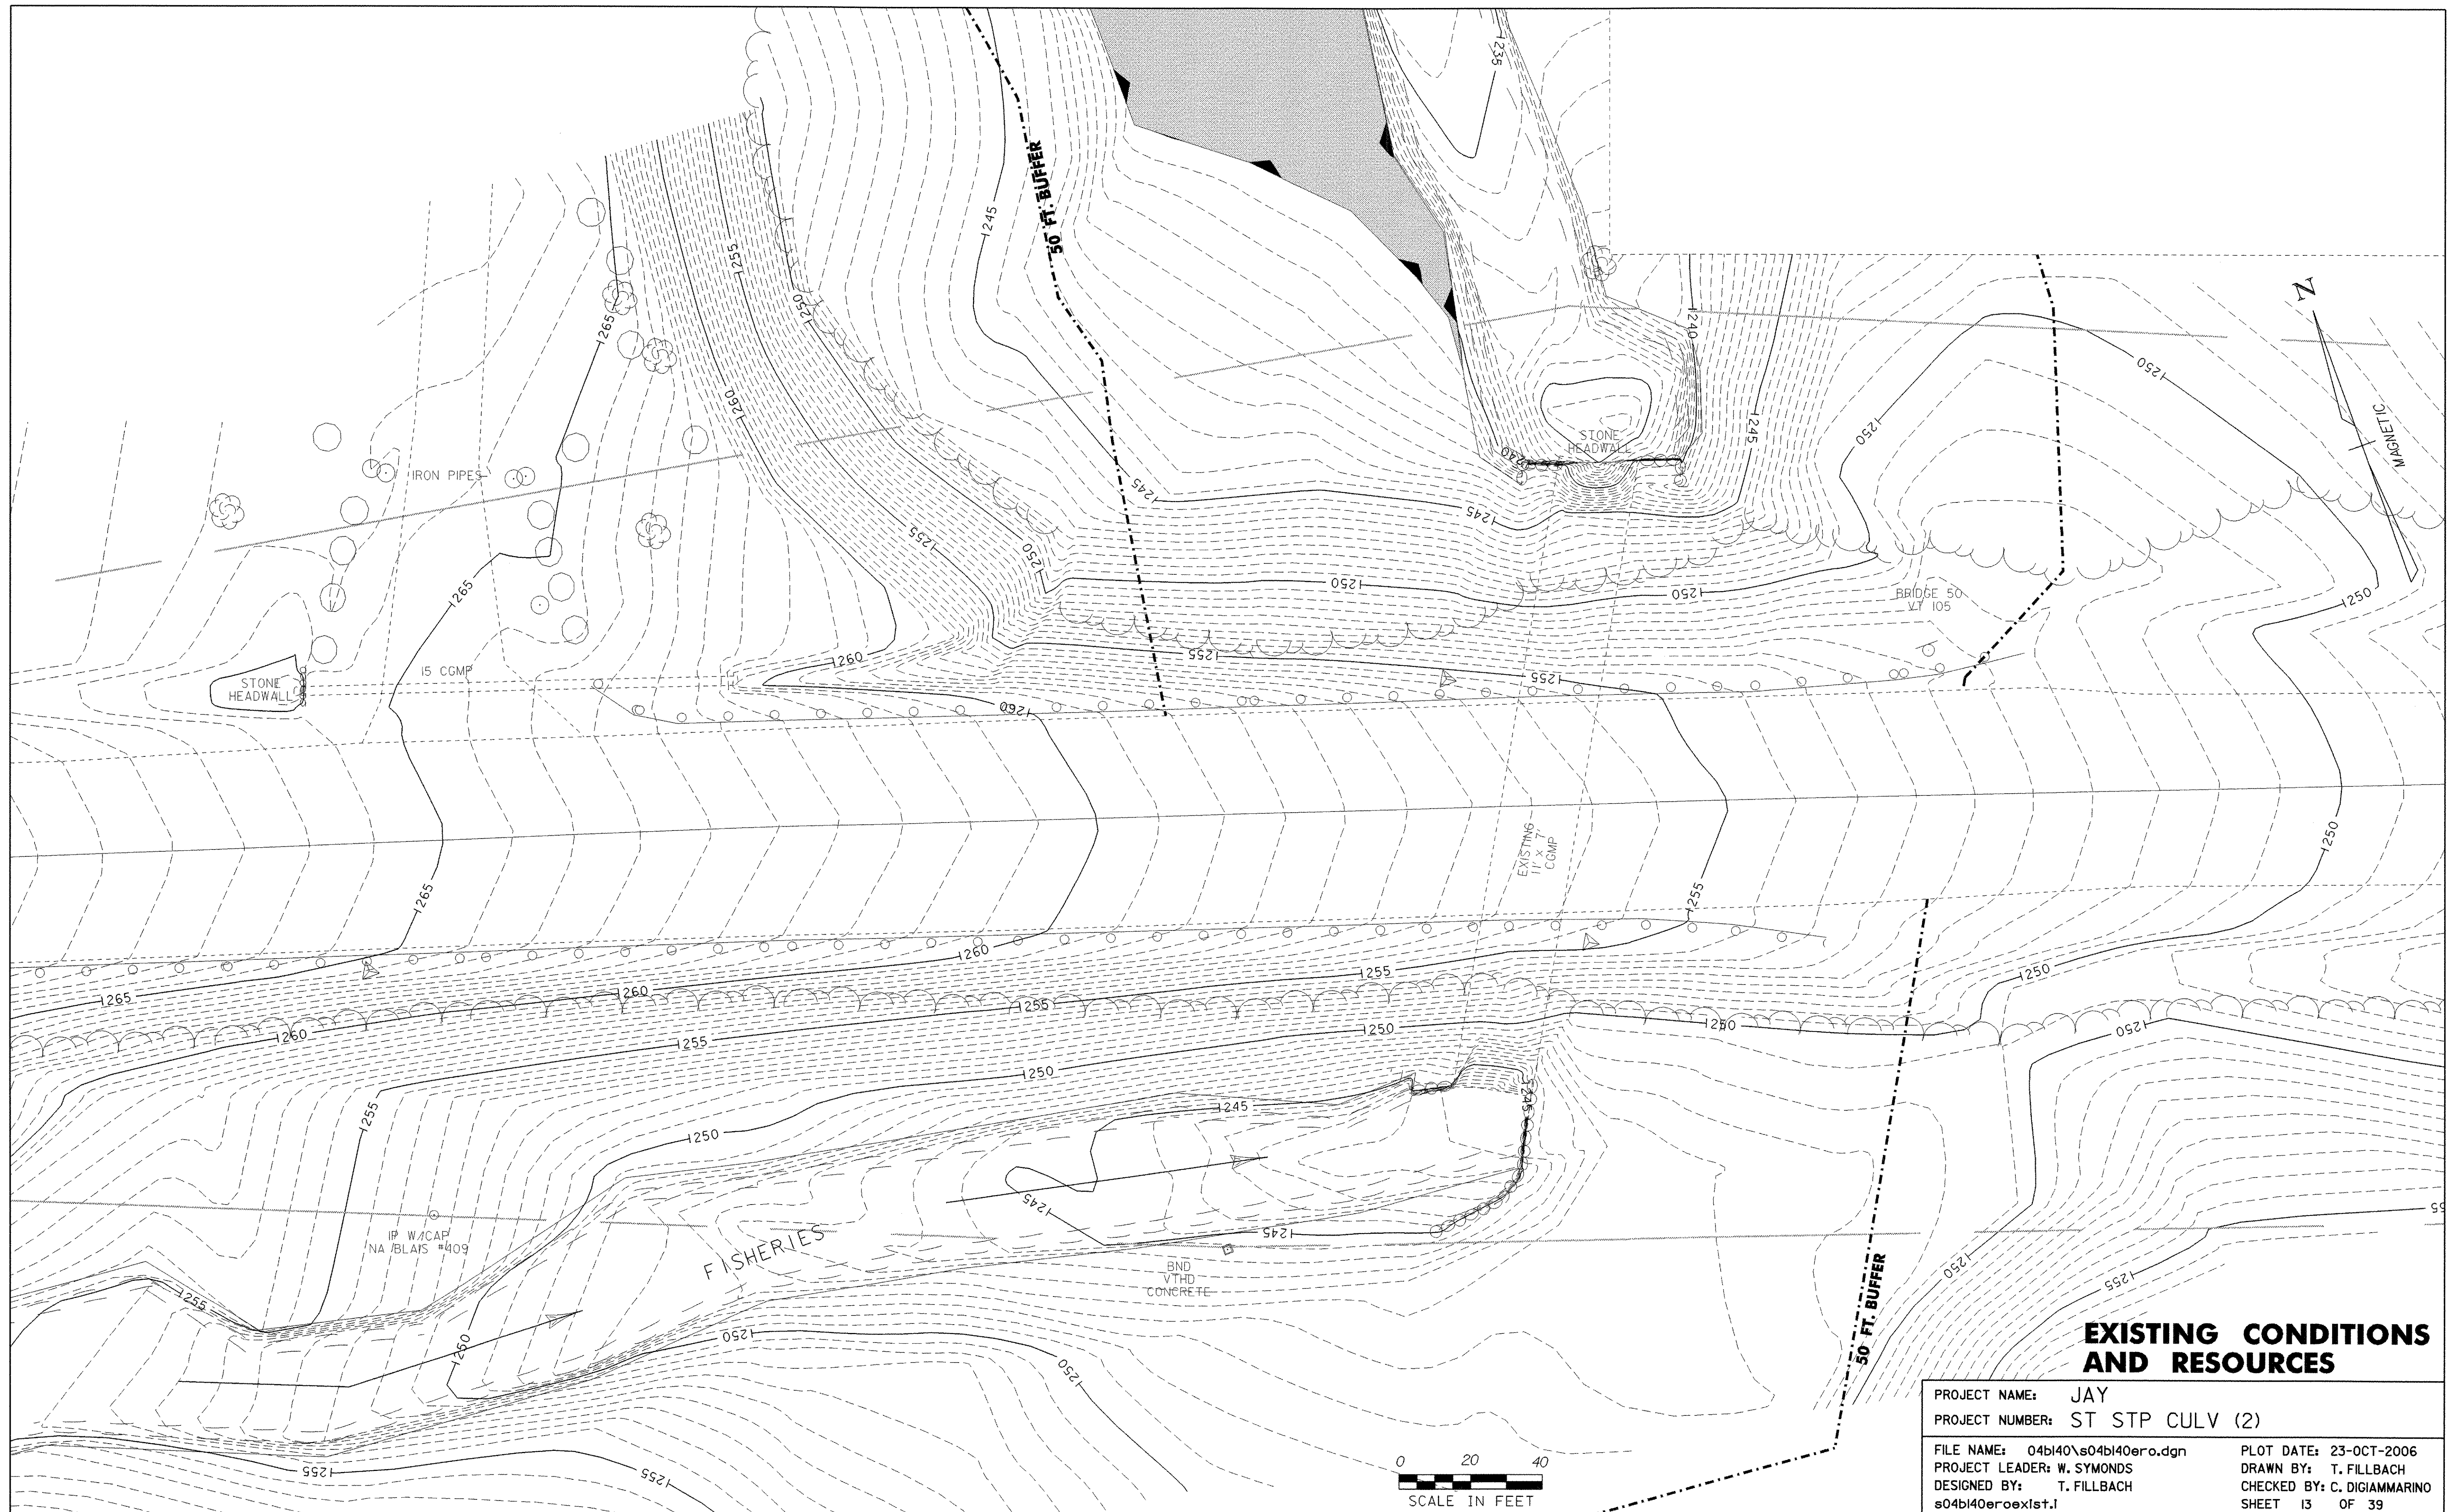

**EXISTING CONDITIONS AND RESOURCES**

PROJECT NAME:	JAY	PLOT DATE:	23-OCT-2006
PROJECT NUMBER:	ST STP CULV (2)	DRAWN BY:	T. FILLBACH
FILE NAME:	04b140\04b140ero.dgn	CHECKED BY:	C. DIGIAMMARINO
PROJECT LEADER:	W. SYMONDS	SHEET	13 OF 39
DESIGNED BY:	T. FILLBACH		
s04b140eroex1st.l			

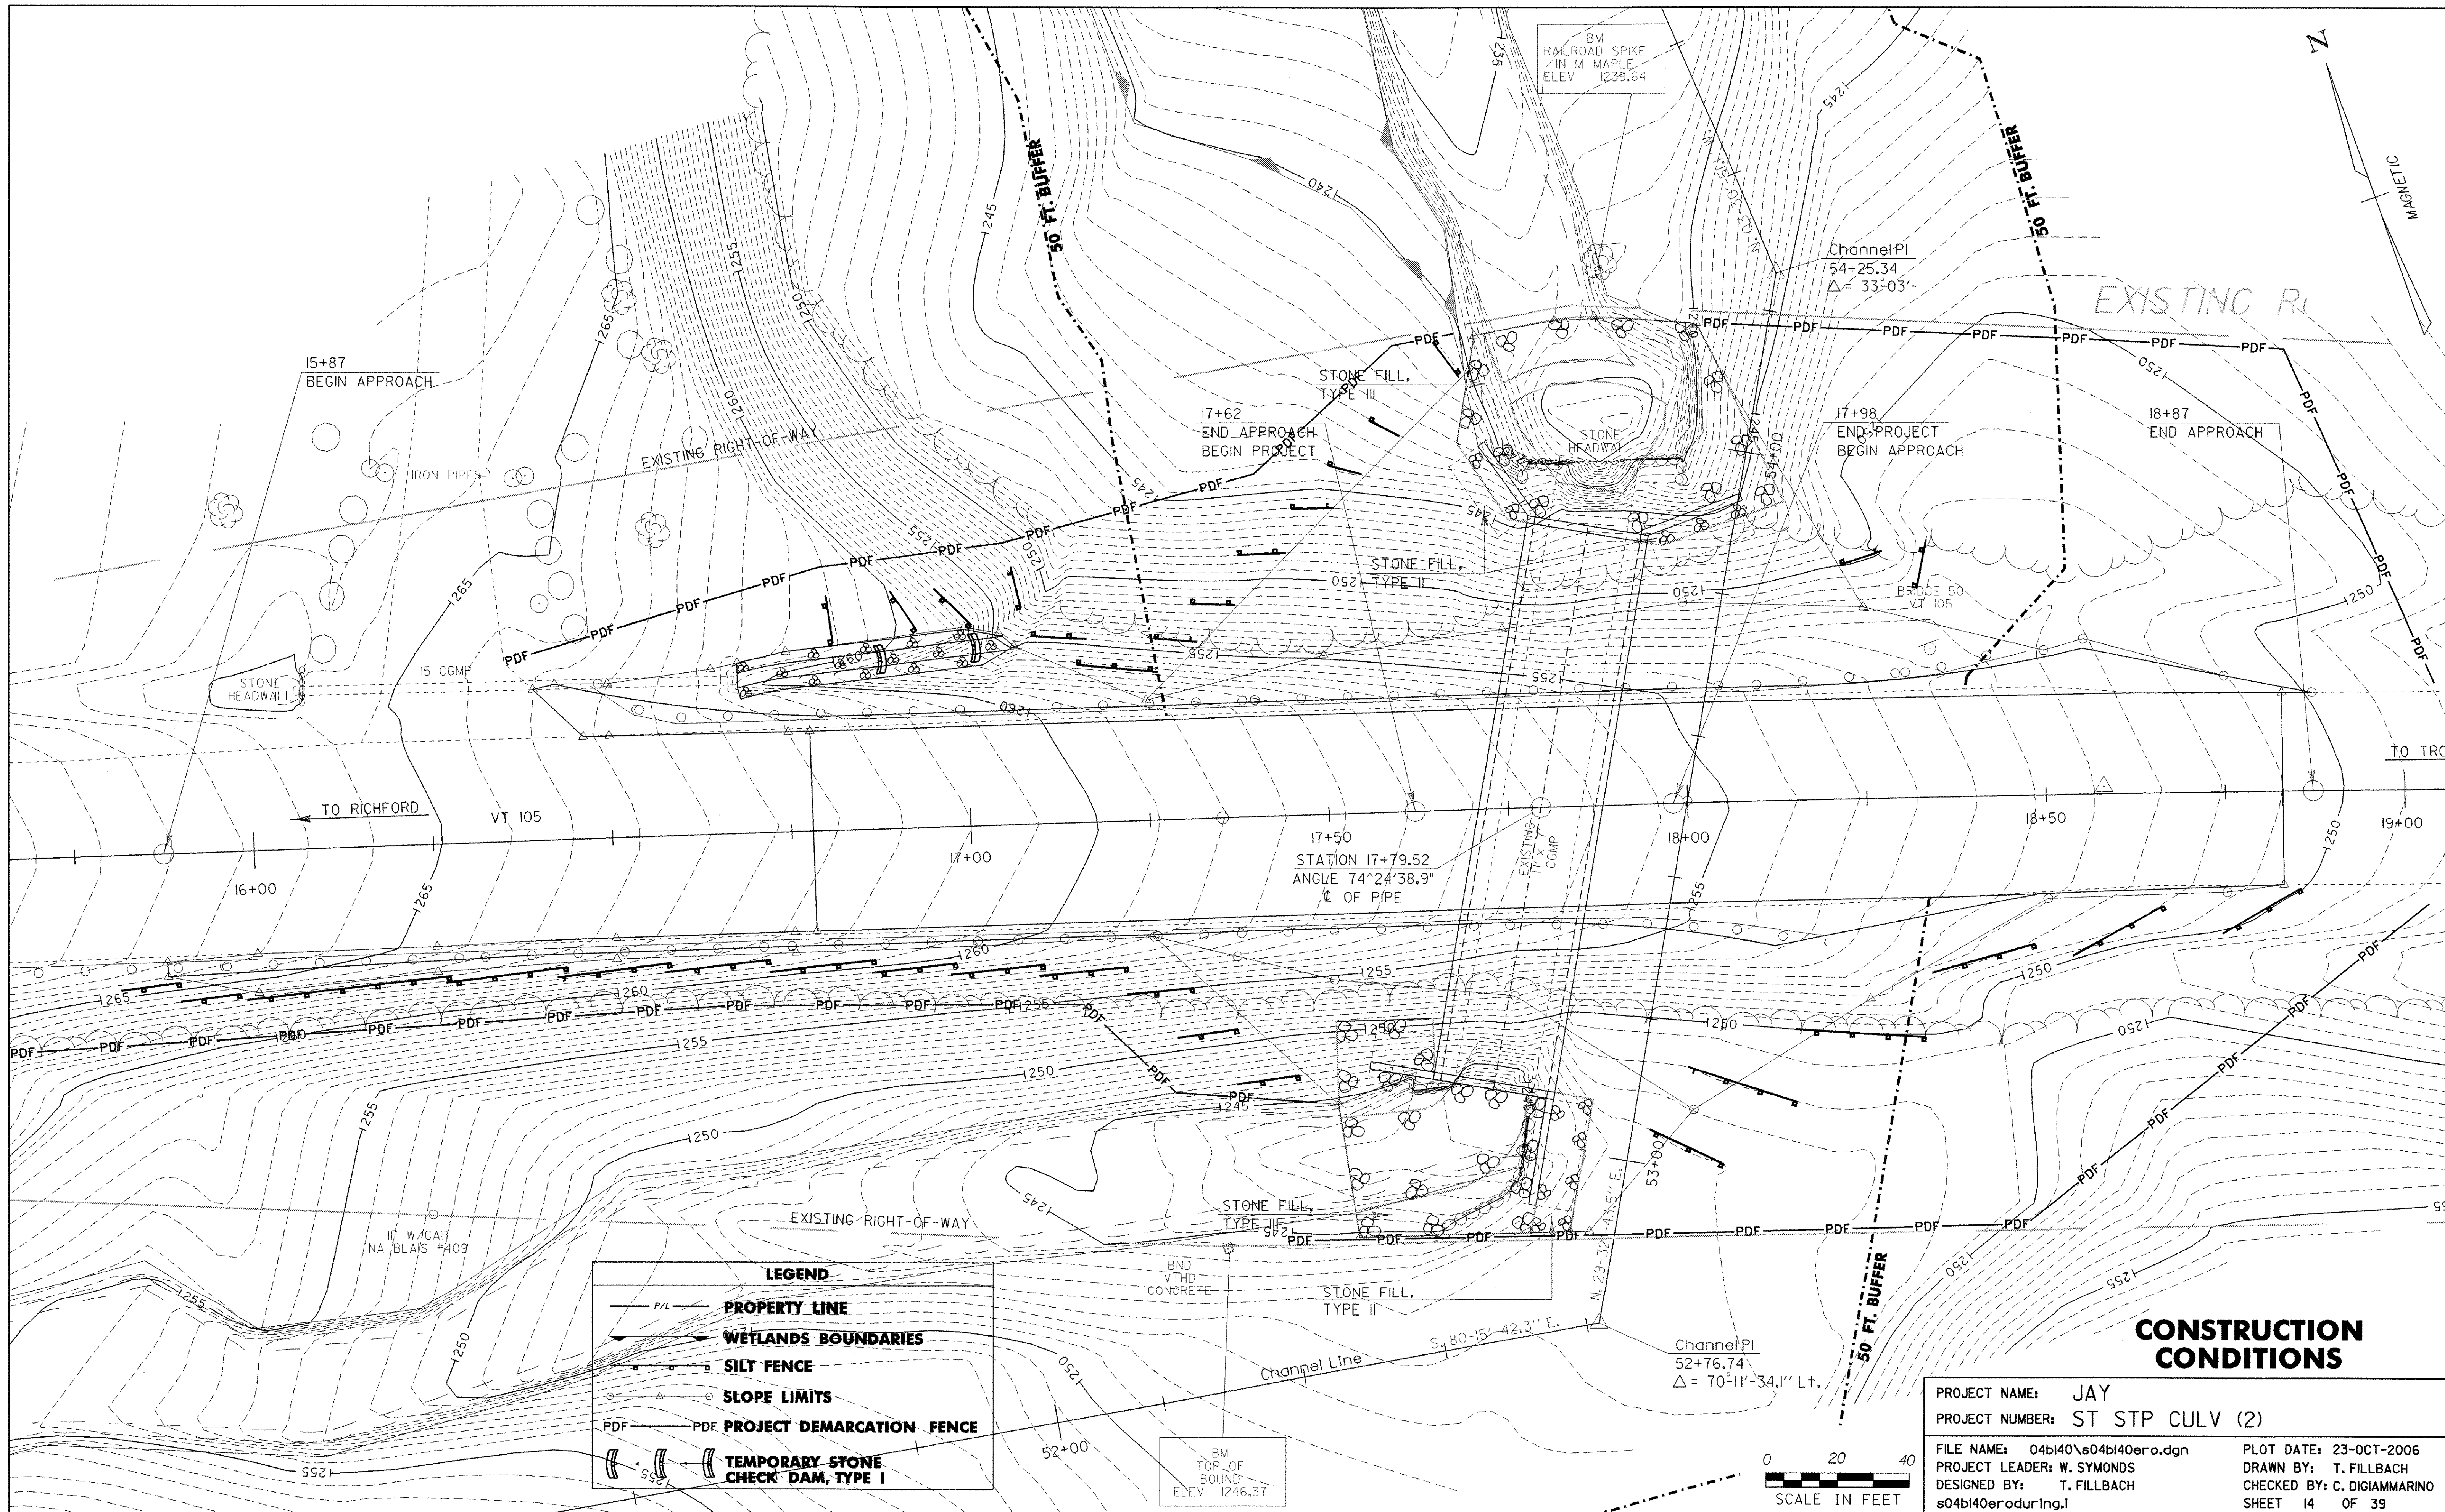

**LEGEND**


	PROPERTY LINE
	WETLANDS BOUNDARIES
	SILT FENCE
	SLOPE LIMITS
	PROJECT DEMARCATION FENCE
	TEMPORARY STONE CHECK DAM, TYPE I

**CONSTRUCTION CONDITIONS**

PROJECT NAME: JAY  
 PROJECT NUMBER: ST STP CULV (2)

FILE NAME: 04b140\s04b140e0.dgn  
 PROJECT LEADER: W. SYMONDS  
 DESIGNED BY: T. FILLBACH  
 s04b140e0durIng.l

PLOT DATE: 23-OCT-2006  
 DRAWN BY: T. FILLBACH  
 CHECKED BY: C. DIGIAMMARINO  
 SHEET 14 OF 39

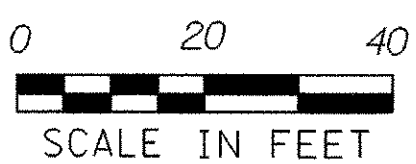


BM  
TOP OF  
BOUND  
ELEV 1246.37

Channel PI  
52+76.74  
Δ = 70°11'34.1" Lt.

17+50  
STATION 17+79.52  
ANGLE 74°24'38.9"  
C OF PIPE

Channel PI  
54+25.34  
Δ = 33°03'

BM  
RAILROAD SPIKE  
IN M MAPLE  
ELEV 1239.64

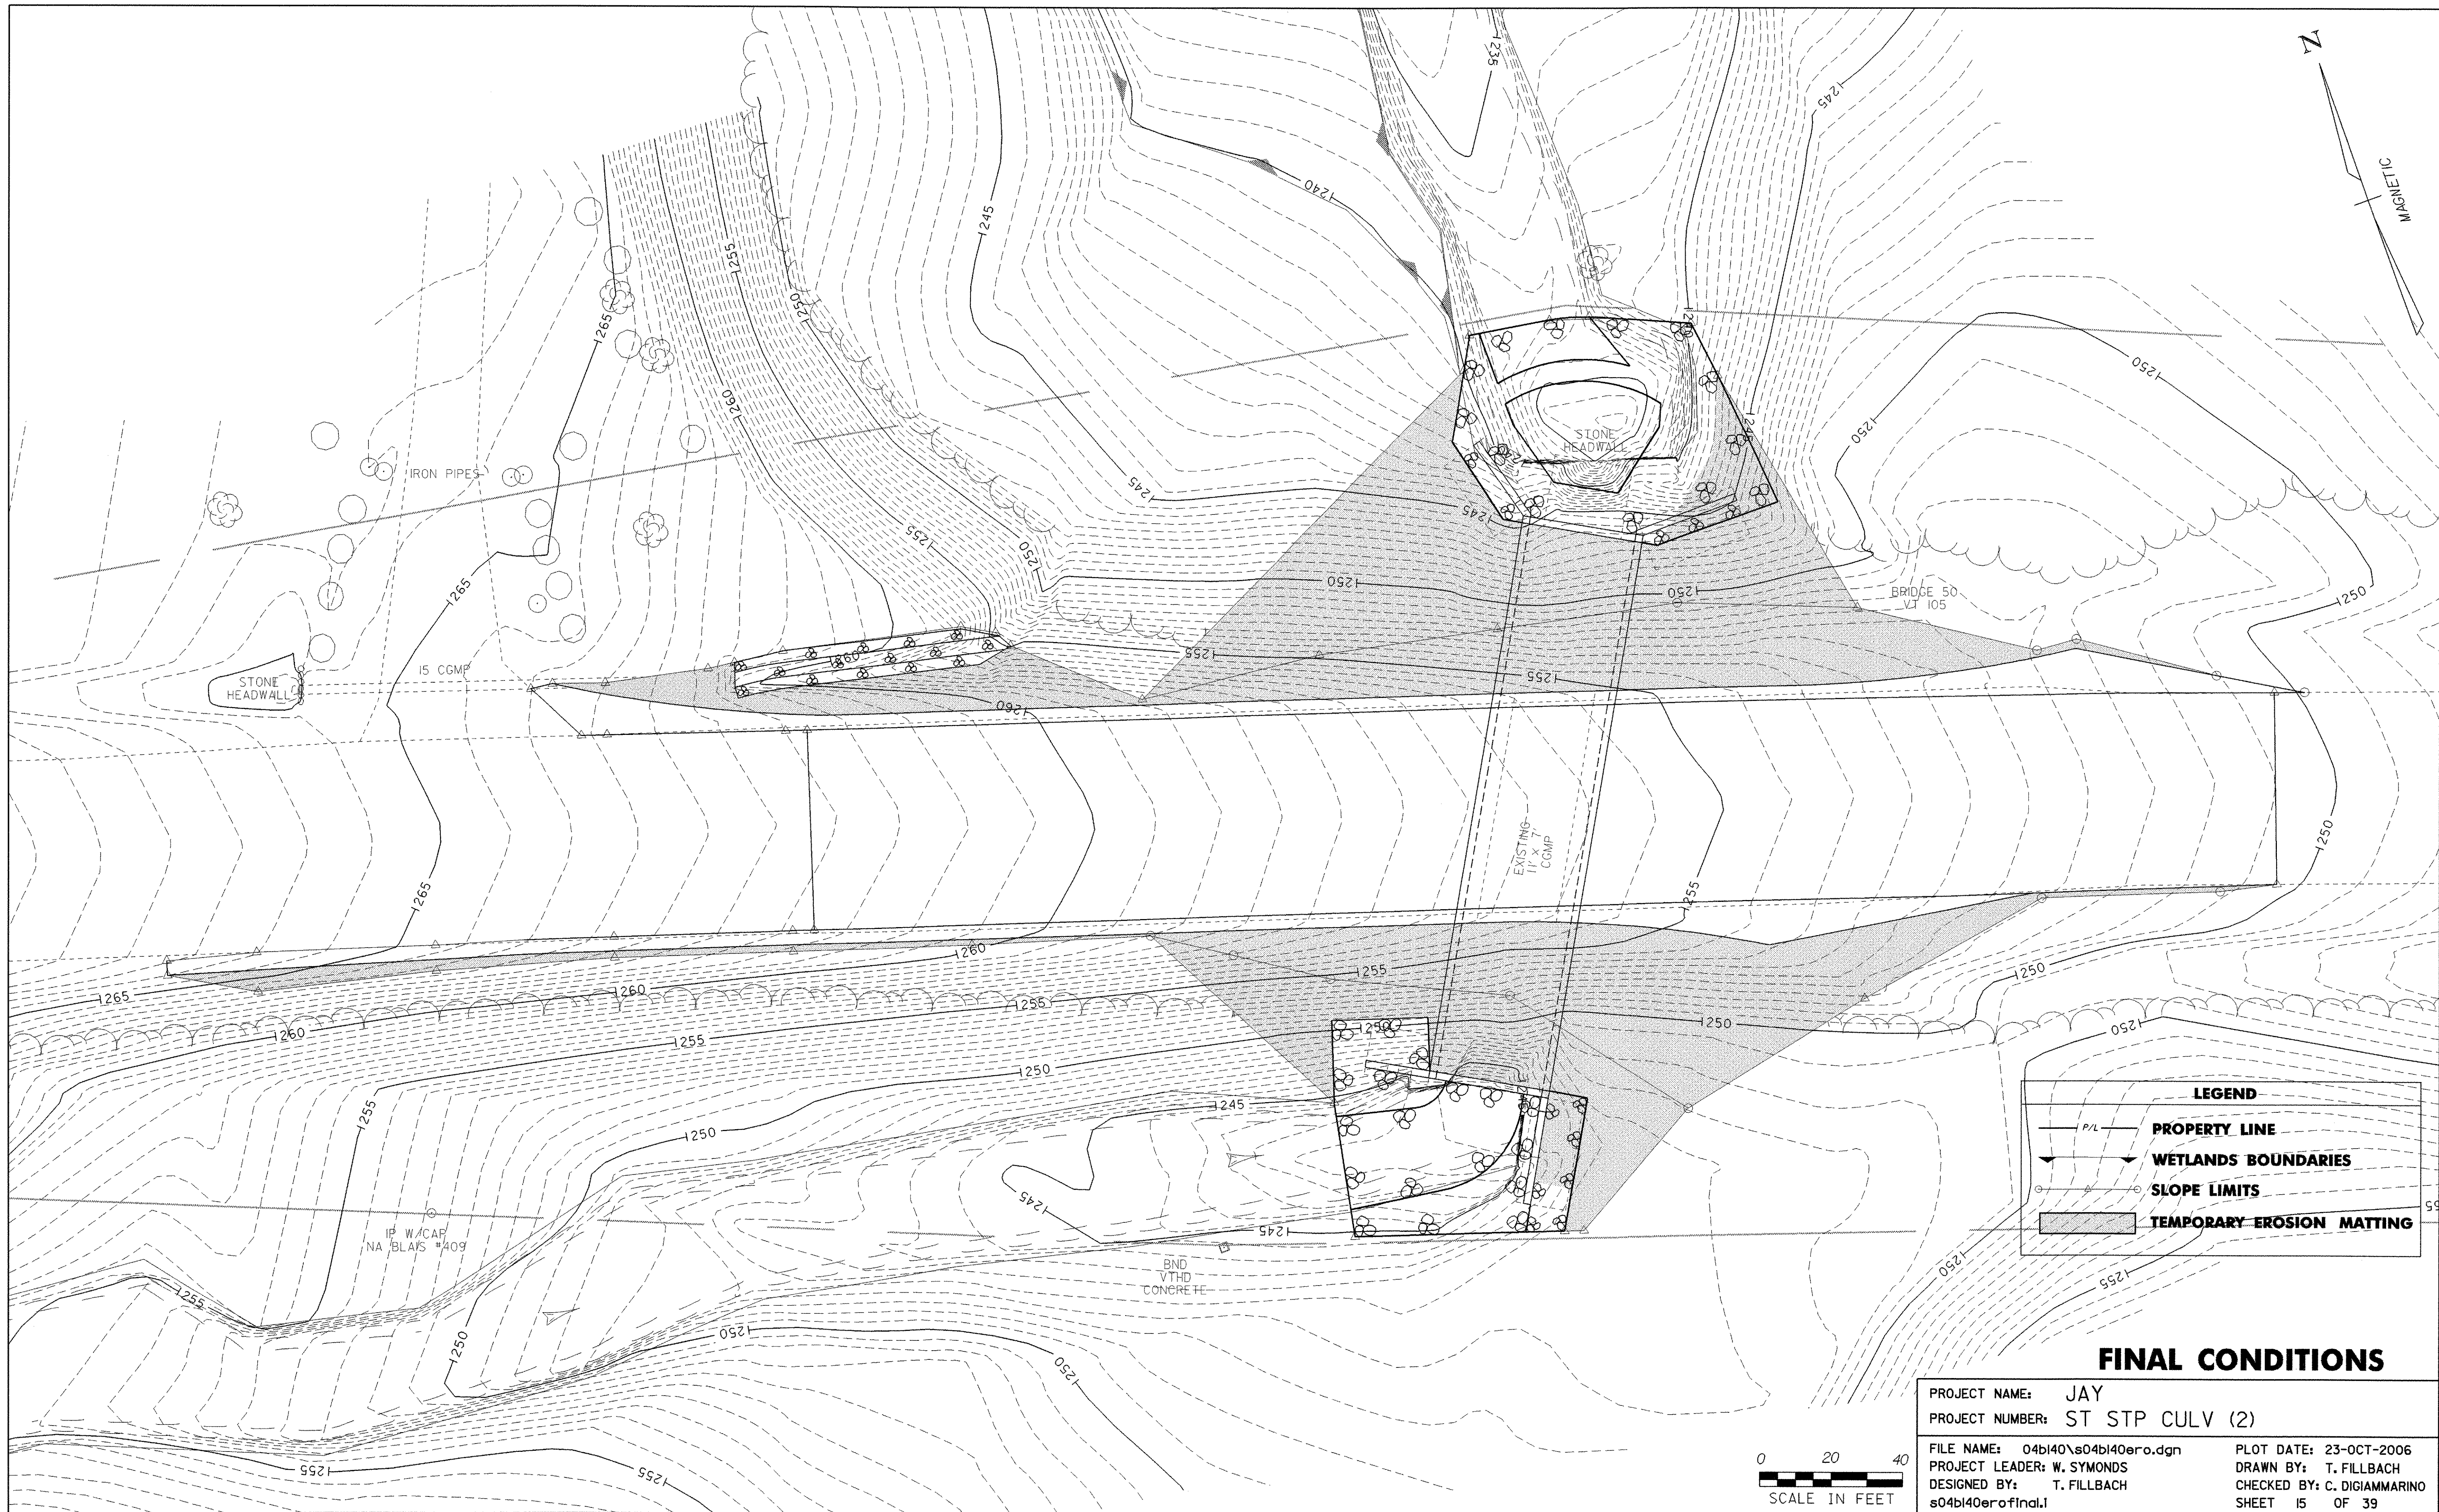



**LEGEND**

- P/L **PROPERTY LINE**
- WETLANDS BOUNDARIES**
- SLOPE LIMITS**
- TEMPORARY EROSION MATTING**

**FINAL CONDITIONS**

PROJECT NAME:	JAY	PLOT DATE:	23-OCT-2006
PROJECT NUMBER:	ST STP CULV (2)	DRAWN BY:	T. FILLBACH
FILE NAME:	04b140\04b140ero.dgn	CHECKED BY:	C. DIGIAMMARINO
PROJECT LEADER:	W. SYMONDS	SHEET	15 OF 39
DESIGNED BY:	T. FILLBACH		
s04b140erofinal.l			

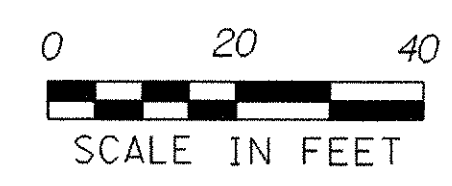

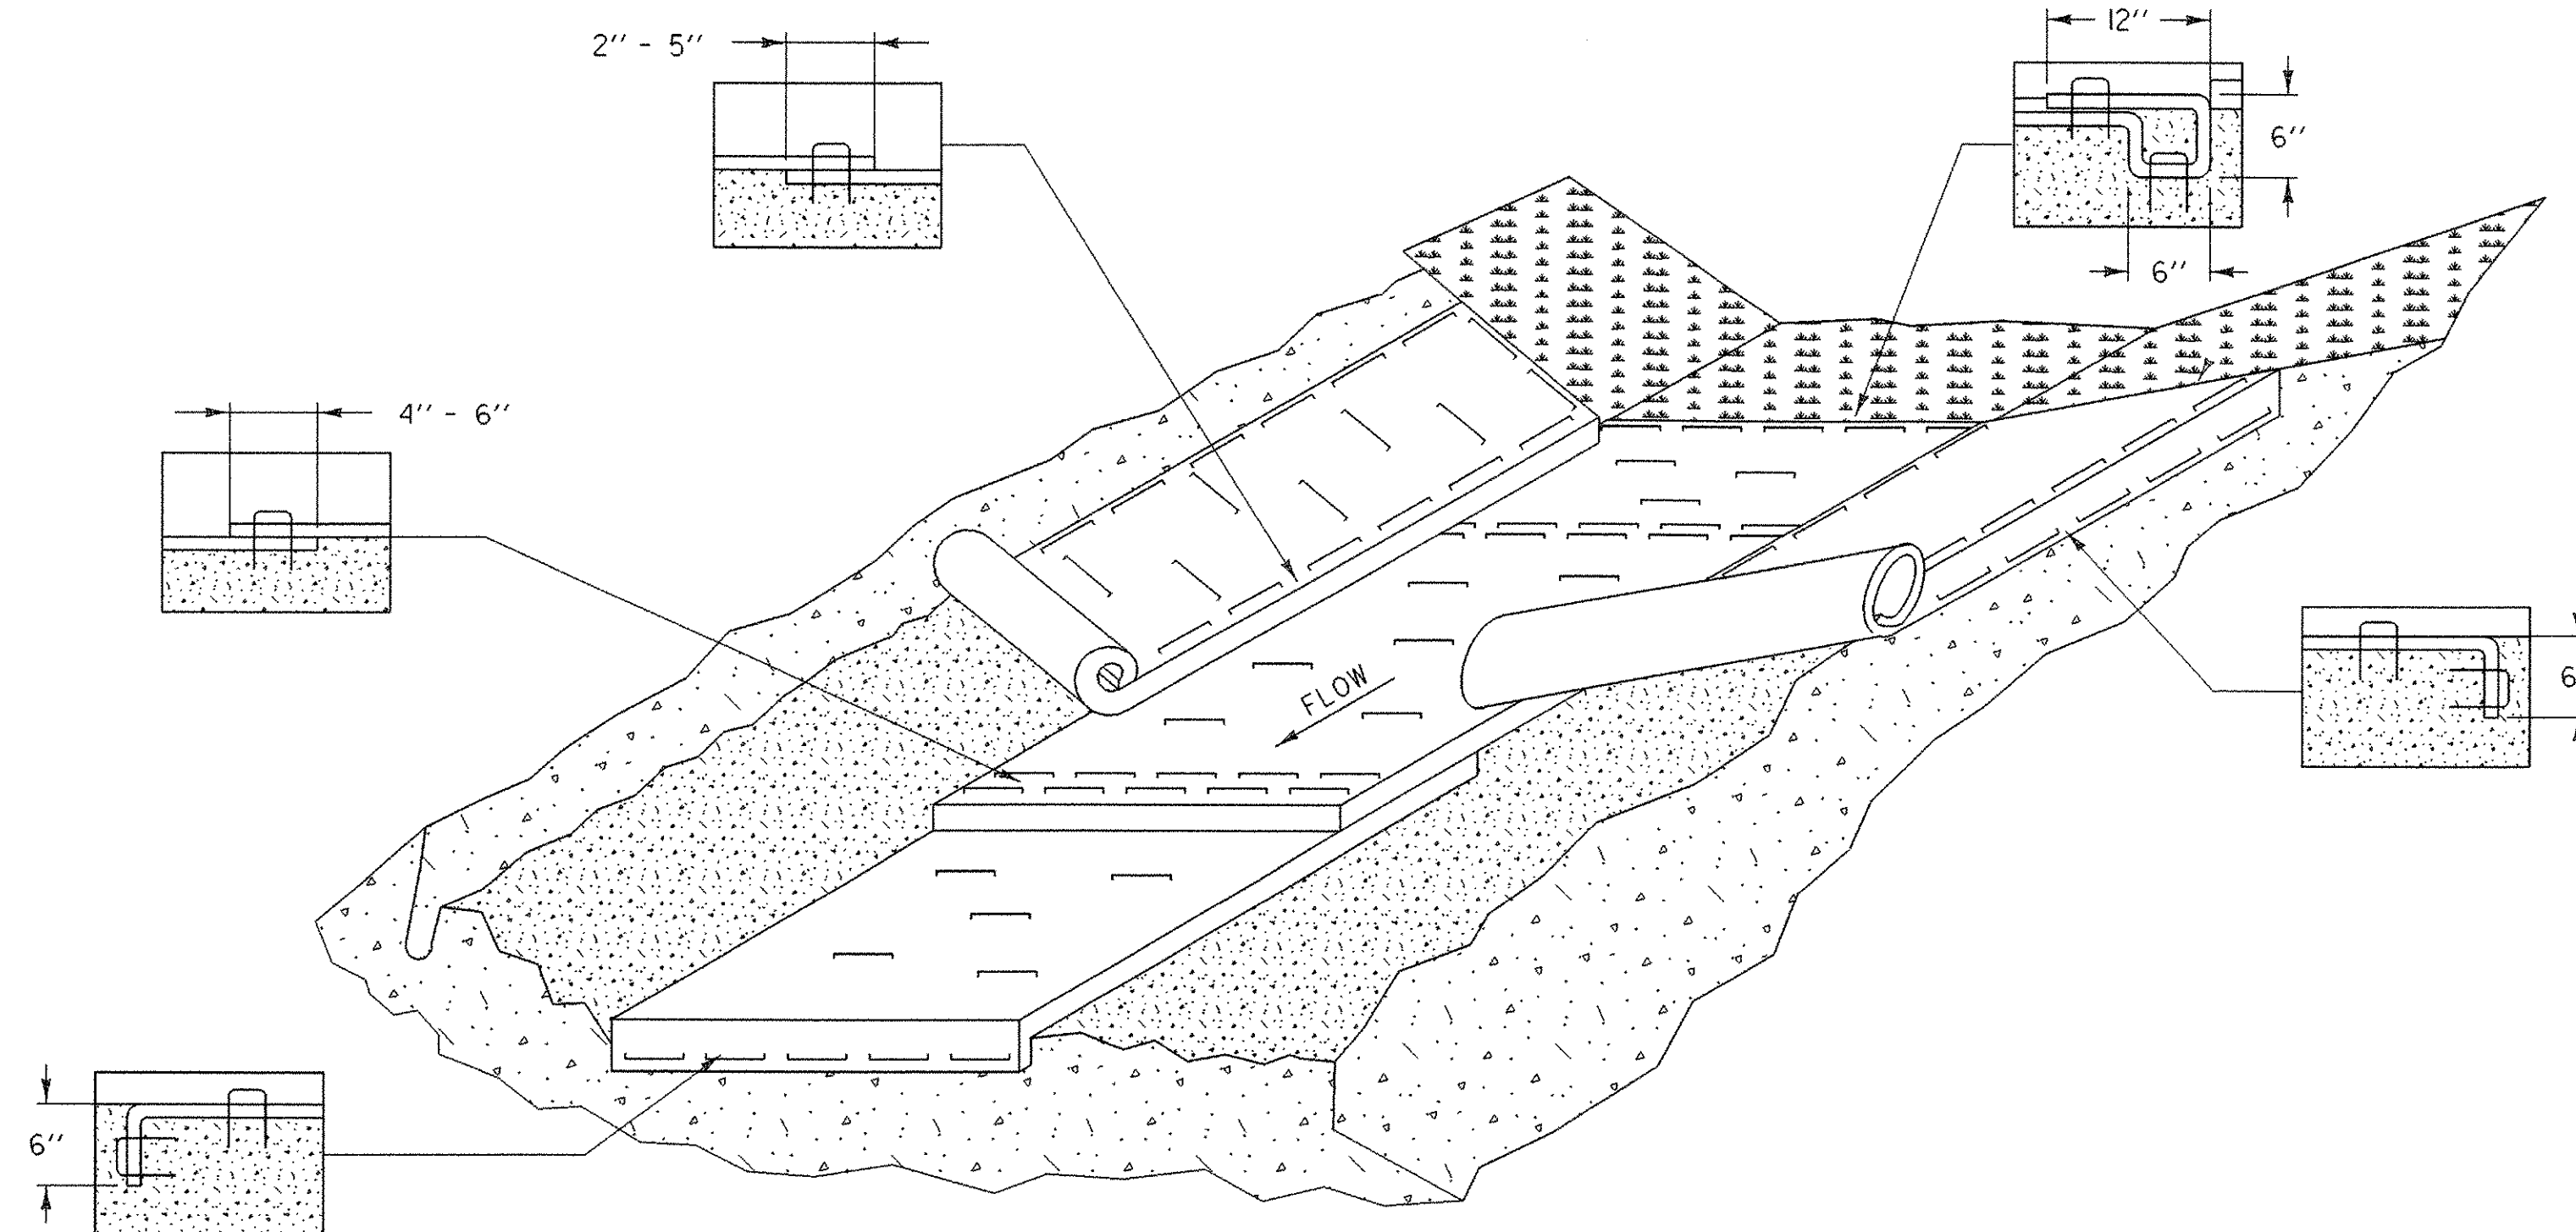


### EROSION MATTING FOR DITCHES

#### APPLICATION NOTES:

- A. THE PURPOSE OF LINING THE DITCH WITH EROSION MATTING IS TO REDUCE EROSION AND AID THE ESTABLISHMENT OF VEGETATION AT LOW VELOCITIES.
- B. TYPE OF EROSION MATTING TO BE USED SHOULD BE BASED ON FACTORS SPECIFIC TO EACH APPLICATION. SEE SPECIFICATIONS AND PRODUCT RECOMMENDATIONS FOR SUITABILITY.

#### GENERAL NOTES:

1. WATER MAY NEED TO BE DIVERTED TO ALLOW PROPER MATTING INSTALLATION.
2. GRADE AND SMOOTH CHANNEL TO PROVIDE GOOD MATTING TO SOIL SURFACE CONTACT.
3. APPLY FERTILIZER, LIME, AND SEED PRIOR TO PLACING MATTING.
4. INSTALL MATTING IN THE CENTER OF THE CHANNEL, IN THE DIRECTION OF THE WATER FLOW.
5. INSTALL MATTING ON THE SIDE SLOPES OF THE CHANNEL, OVERLAPPING THE CENTER MAT.
6. ANCHOR MATTING AS SHOWN, UTILIZING ANCHOR STAPLES. STAPLE PLACEMENT SHALL BE DETERMINED BY THE MANUFACTURER'S INSTALLATION INSTRUCTIONS.
7. EROSION MATTING SHALL BE INSPECTED EVERY SEVEN (7) CALENDAR DAYS AND WITHIN 24 HOURS OF A STORM EVENT GREAT ENOUGH TO CAUSE WATER TO LEAVE THE CONSTRUCTION SITE.
8. EROSION MATTING SHALL BE REPAIRED AND RESTAPLED AS NECESSARY TO ENSURE PROPER FUNCTION.

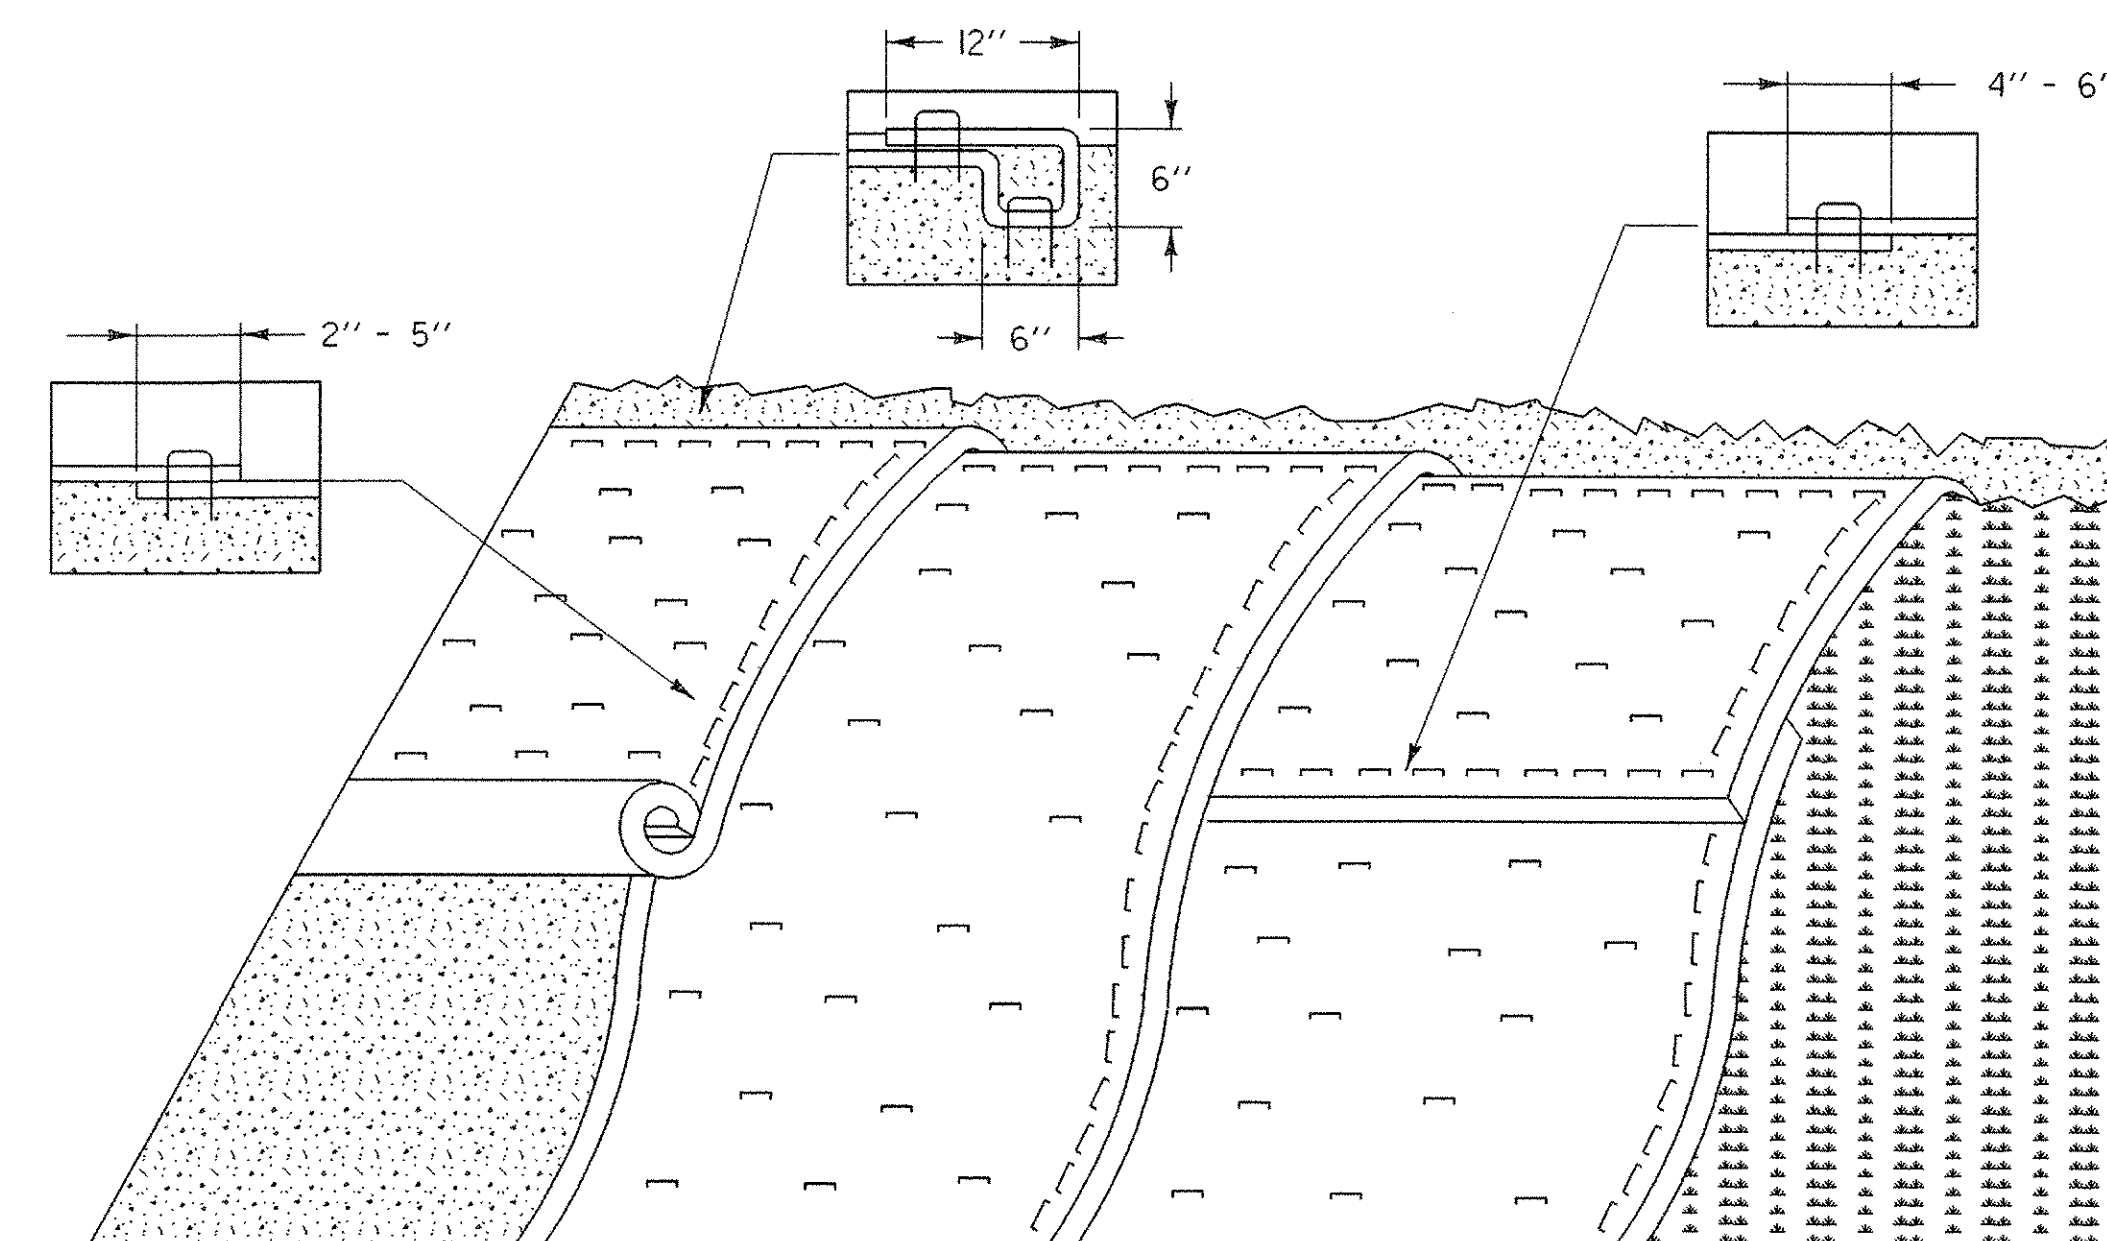

### EROSION MATTING FOR SLOPES

#### APPLICATION NOTES:

- A. THE PURPOSE OF EROSION MATTING ON SLOPES IS TO REDUCE EROSION AND AID THE ESTABLISHMENT OF VEGETATION
- B. EROSION CONTROL MATTING SHALL BE USED FOR THE FOLLOWING REASONS:
  - SLOPES > 3H:1V
  - AREAS WHERE SEED AND MULCH WILL NOT STAY IN PLACE ALONE
  - WHERE SEEDING IS OUTSIDE THE GROWING SEASON.

#### GENERAL NOTES:

1. GRADE AND SMOOTH THE SLOPE TO PROVIDE GOOD MATTING TO SOIL SURFACE CONTACT.
2. APPLY FERTILIZER, LIME, AND SEED PRIOR TO PLACING MATTING.
3. ANCHOR MATTING AS SHOWN, UTILIZING ANCHOR STAPLES. STAPLE PLACEMENT SHALL BE DETERMINED BY THE MANUFACTURER'S INSTALLATION INSTRUCTIONS.
4. UNROLL EROSION MATTING VERTICALLY DOWN SLOPE IN THE DIRECTION OF WATER FLOW.
5. OVERLAP UPPER MATTING OVER LOWER MATTING AS SHOWN.
6. OVERLAP ADJACENT MATTING AS SHOWN.
7. CUT EXCESS MATTING AT END OF SLOPE AND ANCHOR THE END.
8. EROSION MATTING SHALL BE INSPECTED EVERY SEVEN (7) CALENDAR DAYS AND WITHIN 24 HOURS OF A STORM EVENT GREAT ENOUGH TO CAUSE WATER TO LEAVE THE CONSTRUCTION SITE.
9. EROSION MATTING SHALL BE REPAIRED AND RESTAPLED AS NECESSARY TO ENSURE PROPER FUNCTION.

#### REVISIONS AND CORRECTIONS

JULY 15, 2005 N. GARBICK

## EROSION PREVENTION & SEDIMENT CONTROL DETAILS EROSION MATTING FOR DITCHES & SLOPES

PROJECT NAME: JAY  
PROJECT NUMBER: ST STP CULV (2)

FILE NAME: 04b140\epsc.dgn PLOT DATE: 23-OCT-2006  
PROJECT LEADER: W. SYMONDS DRAWN BY: C. SHANGRAW  
DESIGNED BY: T. FILLBACH CHECKED BY: J. LACROIX  
epsc1.i SHEET 16 OF 39


## TEMPORARY CHECK DAMS

### APPLICATION NOTES:


- A. TEMPORARY CHECK DAM TYPE I IS USED FOR CHANNEL FLOW, CHECK DAM TYPE II IS USED FOR FLOW ALONG A CURB.
- B. THE PRIMARY PURPOSE OF A TEMPORARY STONE CHECK DAM (TYPE I) IS TO REDUCE EROSION IN A CHANNEL BY REDUCING FLOW VELOCITY.
- C. THE PRIMARY PURPOSE OF A TEMPORARY STONE CHECK DAM (TYPE II) IS TO LIMIT THE AMOUNT OF SEDIMENT ENTERING A CLOSED DRAINAGE SYSTEM WITH STORMWATER RUNOFF.
- D. TEMPORARY CHECK DAMS WILL CAPTURE SEDIMENT THAT FALLS OUT OF SUSPENSION BEHIND THE CHECK DAMS DUE TO DECREASED VELOCITY. CHECK DAMS ARE NOT INTENDED TO FILTER SEDIMENT FROM STORMWATER.
- E. DETAILS SHOWN SHALL BE USED FOR TEMPORARY INSTALLATION ONLY.
- F. USE OF PREFABRICATED TEMPORARY CHECK DAMS SHALL BE AS APPROVED IN THE EPSCP.

### GENERAL NOTES:


1. GEOTEXTILE SHALL BE INSTALLED UNDER TEMPORARY STONE CHECK DAMS TYPE I. IT SHALL BE KEYED IN ON THE UPHILL END AND SHALL EXTEND 2 FEET BEYOND THE STONE ON THE DOWNHILL END.
2. STONE FOR TEMPORARY STONE CHECK DAMS SHALL MEET THE GRADATION REQUIREMENTS SPECIFIED IN THE CONTRACT DOCUMENTS.
3. PREFABRICATED TEMPORARY CHECK DAMS SHALL BE INSTALLED PER MANUFACTURERS RECOMMENDATIONS.
4. TEMPORARY CHECK DAMS SHALL BE INSPECTED EVERY SEVEN (7) CALENDAR DAYS AND WITHIN 24 HOURS OF A STORM EVENT GREAT ENOUGH TO CAUSE WATER TO LEAVE THE CONSTRUCTION SITE.
5. TEMPORARY CHECK DAMS SHALL BE CLEANED AND REPAIRED AS NEEDED. SEDIMENT SHALL BE REMOVED WHEN ACCUMULATION REACHES ONE-HALF OF THE HEIGHT OR AS RECOMMENDED BY THE MANUFACTURER. SEDIMENT SHALL BE DISPOSED OF AT AN APPROVED WASTE SITE.
6. AT TIME OF REMOVAL OF THE TEMPORARY CHECK DAM, THE DISTURBED AREA SHALL BE REPAIRED AND STABILIZED.

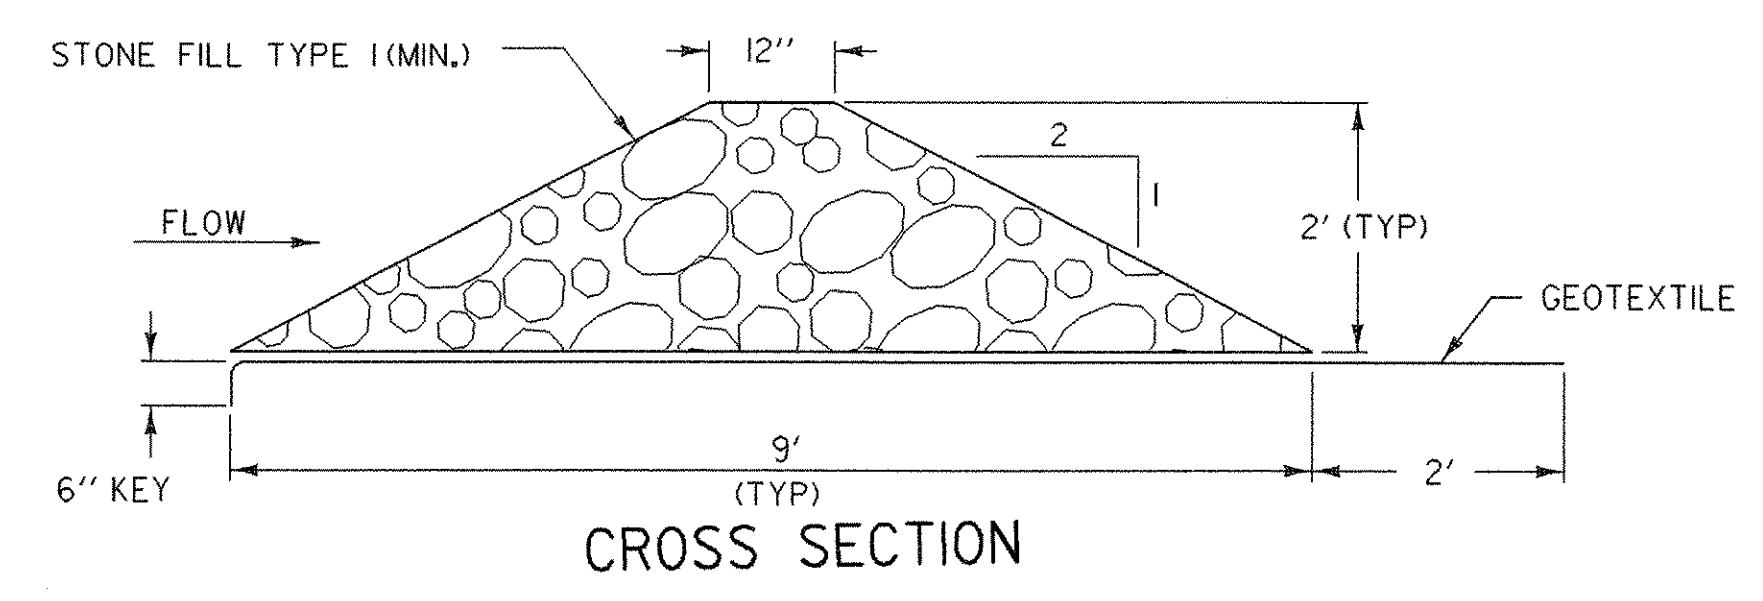


CROSS SECTION

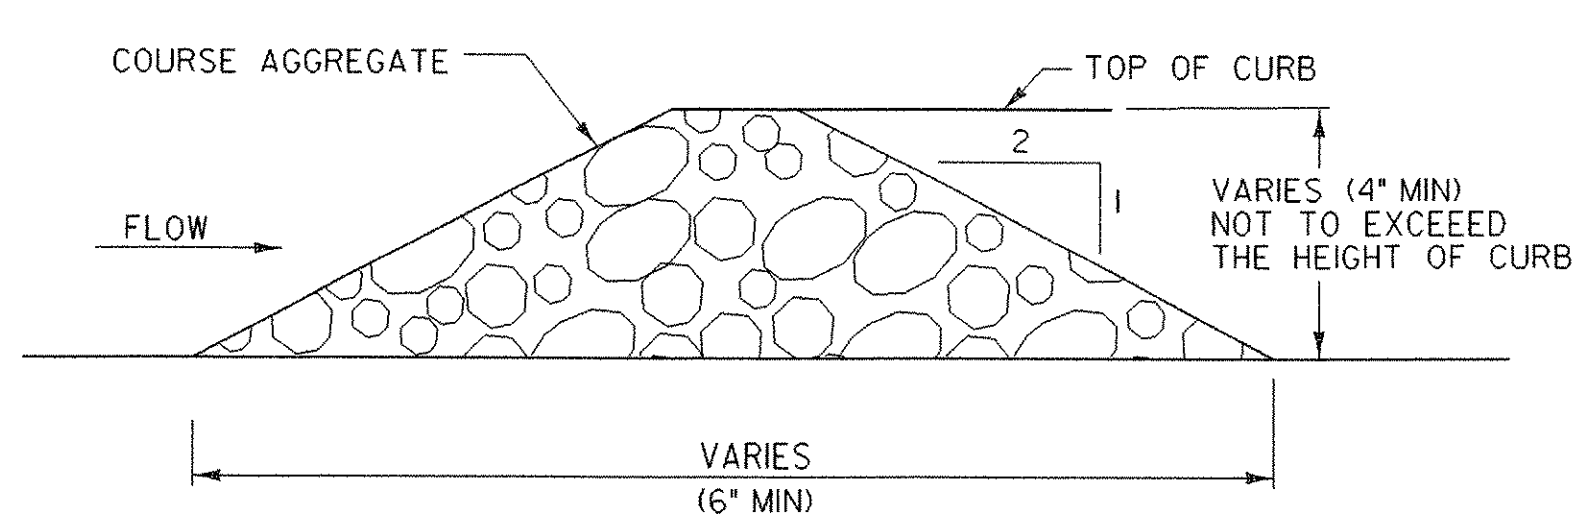


CROSS SECTION

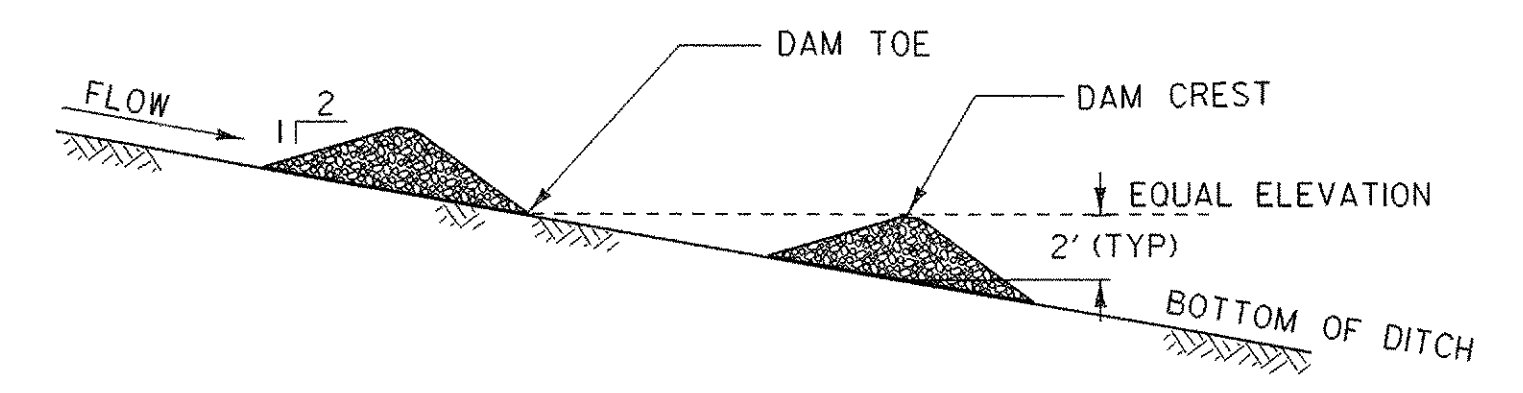


PROFILE

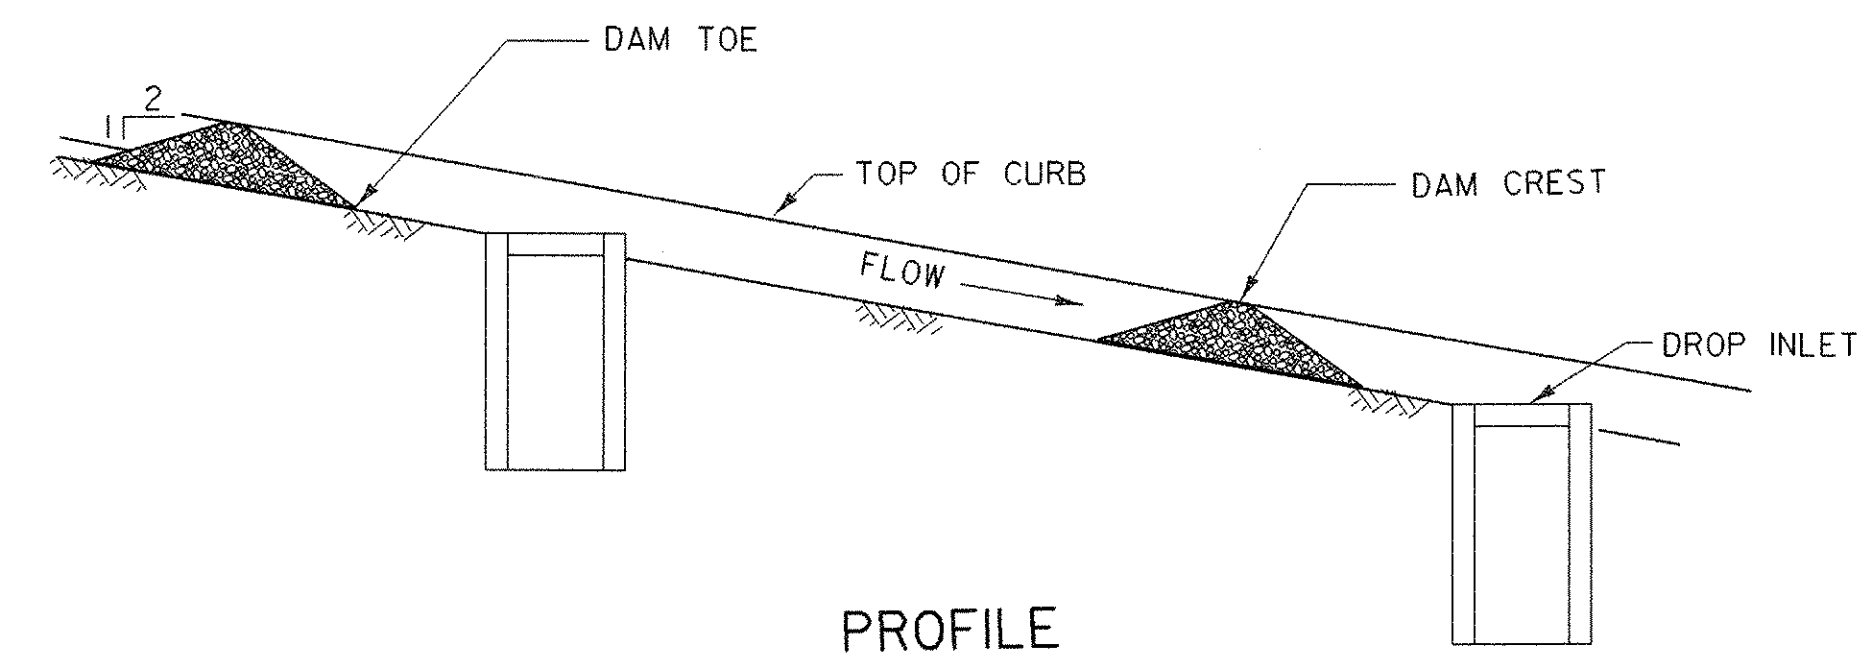


PROFILE

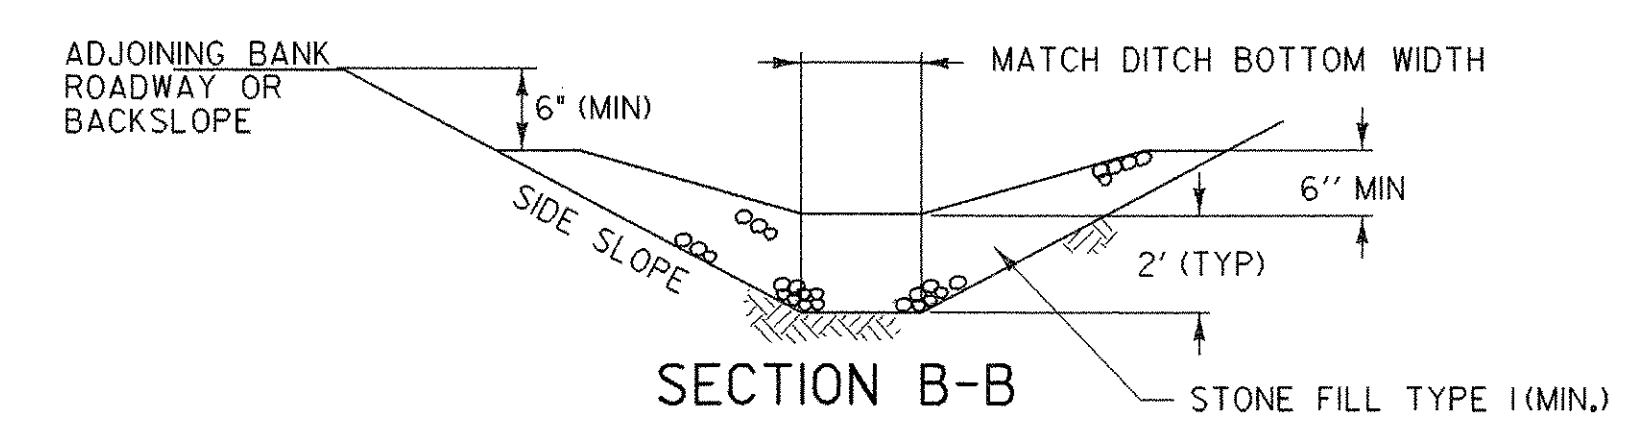

SECTION B-B

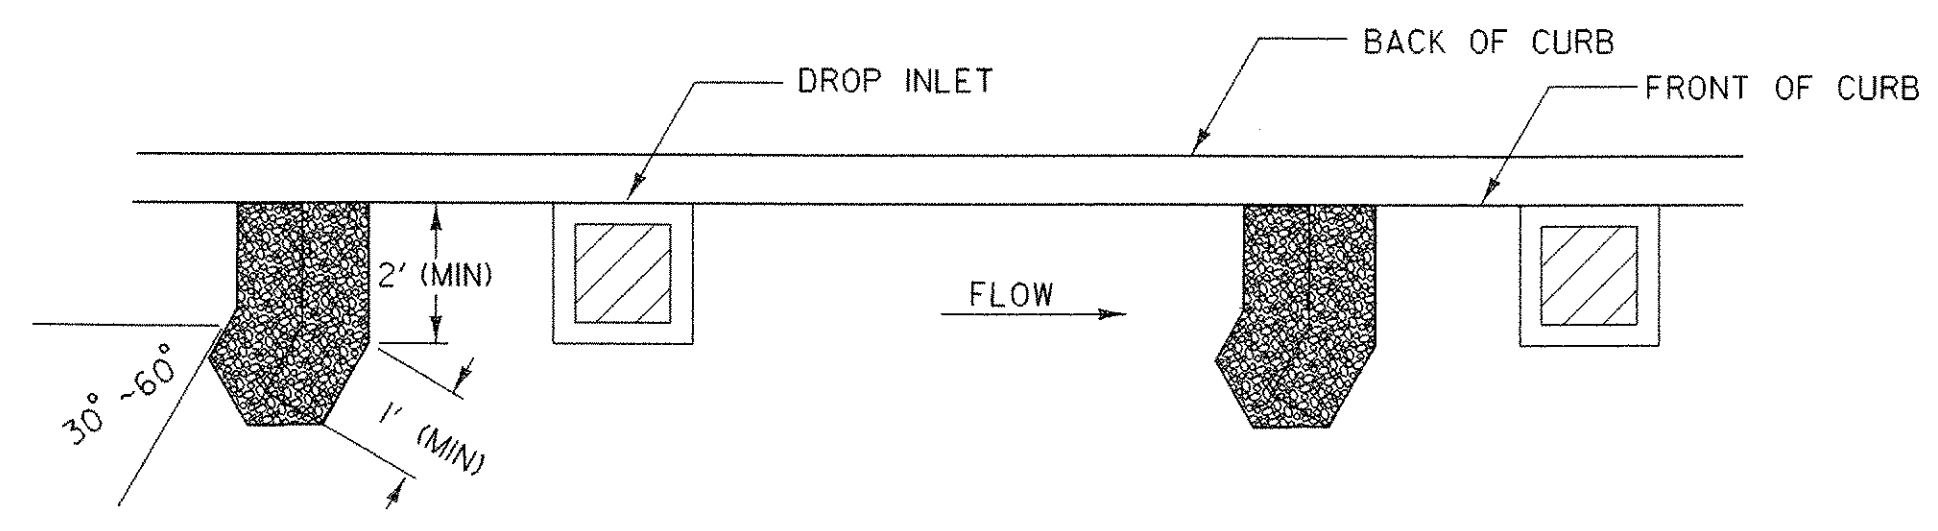

PLAN

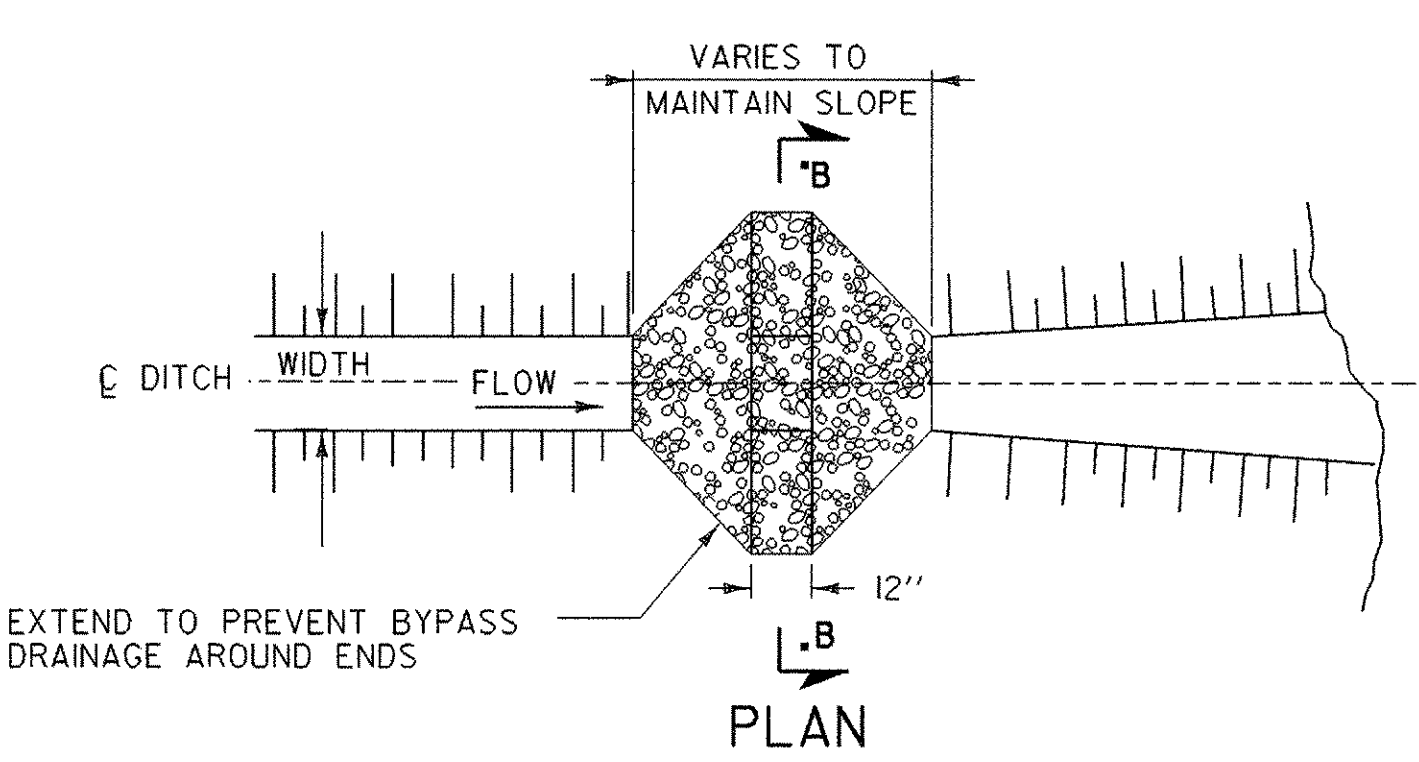

PLAN

TEMPORARY STONE CHECK DAM  
TYPE I

NOT TO SCALE

TEMPORARY STONE CHECK DAM  
TYPE II

NOT TO SCALE

STONE CHECK DAM PLACEMENT INTERVAL	
DITCH SLOPE	PLACEMENT INTERVAL **
1 %	200 FT
2 %	100 FT
3 %	65 FT
4 %	50 FT
5 %	40 FT
6 %	30 FT
8 %	25 FT
10 %	20 FT

\*\* BASED ON 2' TYPICAL HEIGHT

REVISIONS AND CORRECTIONS  
JULY 15, 2005      N. GARBACK

## EROSION PREVENTION & SEDIMENT CONTROL DETAILS TEMPORARY CHECK DAMS

PROJECT NAME:	JAY
PROJECT NUMBER:	ST STP CULV (2)
FILE NAME:	04b140\epsc.dgn
PROJECT LEADER:	W. SYMONDS
DESIGNED BY:	T. FILLBACH
epsc2.i	PLOT DATE: 23-OCT-2006
	DRAWN BY: J. REED
	CHECKED BY: J. LACROIX
	SHEET 17 OF 39

## SILT FENCE

### APPLICATION NOTES:



- THE PRIMARY PURPOSE OF SILT FENCE IS TO REDUCE RUNOFF VELOCITY AND TRAP SEDIMENT. VELOCITY IS REDUCED, WATER IS IMPOUNDED BEHIND THE MEASURE, AND SEDIMENT FALLS OUT OF SUSPENSION.
- SILT FENCE SHALL NOT BE USED ACROSS CONCENTRATED FLOW.

### GENERAL NOTES:


- SILT FENCE SHALL GENERALLY BE PLACED A MINIMUM OF 5 FEET BEYOND TOE OF SLOPE, 10 FEET PREFERRED, TO PROVIDE ADEQUATE AREA FOR SEDIMENT STORAGE AND FACILITATE MAINTENANCE OF SEDIMENT CONTAINMENT AREA.
- SILT FENCE SHALL BE INSTALLED ON A LINE OF EQUAL ELEVATION (CONTOUR). IT MAY BE INSTALLED AT INTERMEDIATE POINTS UP SLOPES AS WELL AS AT THE BOTTOM, AS SHOWN IN THE DETAIL.
- ALL ENDS SHALL BE "J" HOOKED TO TRAP SEDIMENT.
- IN AREAS WITH TWO SLOPES, SILT FENCE SHALL BE USED TO ERECT A DAM AND TRAP SEDIMENT AT THE BASE OF THE STEEPER SLOPE.
- THE BOTTOM EDGE OF SILT FENCE SHALL BE BURIED A MINIMUM OF 6 INCHES BELOW GROUND, AND KEYED IN 4 INCHES. THE FENCE SHALL BE INSTALLED WITH THE POSTS ON THE DOWNSTREAM SIDE OF THE FABRIC.
- MAXIMUM DRAINAGE AREA TRIBUTARY TO 100 FEET OF SILT FENCE SHALL BE 0.25 ACRES.
- THE FOLLOWING ARE MAXIMUM LENGTHS FOR SILT FENCE INSTALLATIONS:

CONSTRUCTED SLOPE	SLOPE LENGTH (LS) FT	HORIZONTAL LENGTH (LH) FT
3H : 4V	80	75
4H : 4V	130	125
5H : 4V	200	200
> 5H : 4V	250	250

- WHERE ELONGATION IS >50%, POST SPACING SHALL NOT EXCEED 4 FEET. WHERE ELONGATION IS <50%, POST SPACING SHALL NOT EXCEED 6 FEET.
- SILT FENCE SHALL BE INSPECTED EVERY SEVEN (7) CALENDAR DAYS AND WITHIN 24 HOURS OF A STORM EVENT GREAT ENOUGH TO CAUSE WATER TO LEAVE THE CONSTRUCTION SITE.
- SILT FENCE SHALL BE CLEANED AND REPAIRED AS NEEDED. SEDIMENT SHALL BE REMOVED WHEN ACCUMULATION REACHES ONE-HALF OF THE MEASURE HEIGHT. SEDIMENT SHALL BE DISPOSED OF AT AN APPROVED WASTE SITE.
- SILT FENCE SHALL BE REMOVED WHEN THE AREA HAS BEEN STABILIZED. AT TIME OF REMOVAL OF THE SILT FENCE, THE DISTURBED AREA SHALL BE REPAIRED AND STABILIZED.

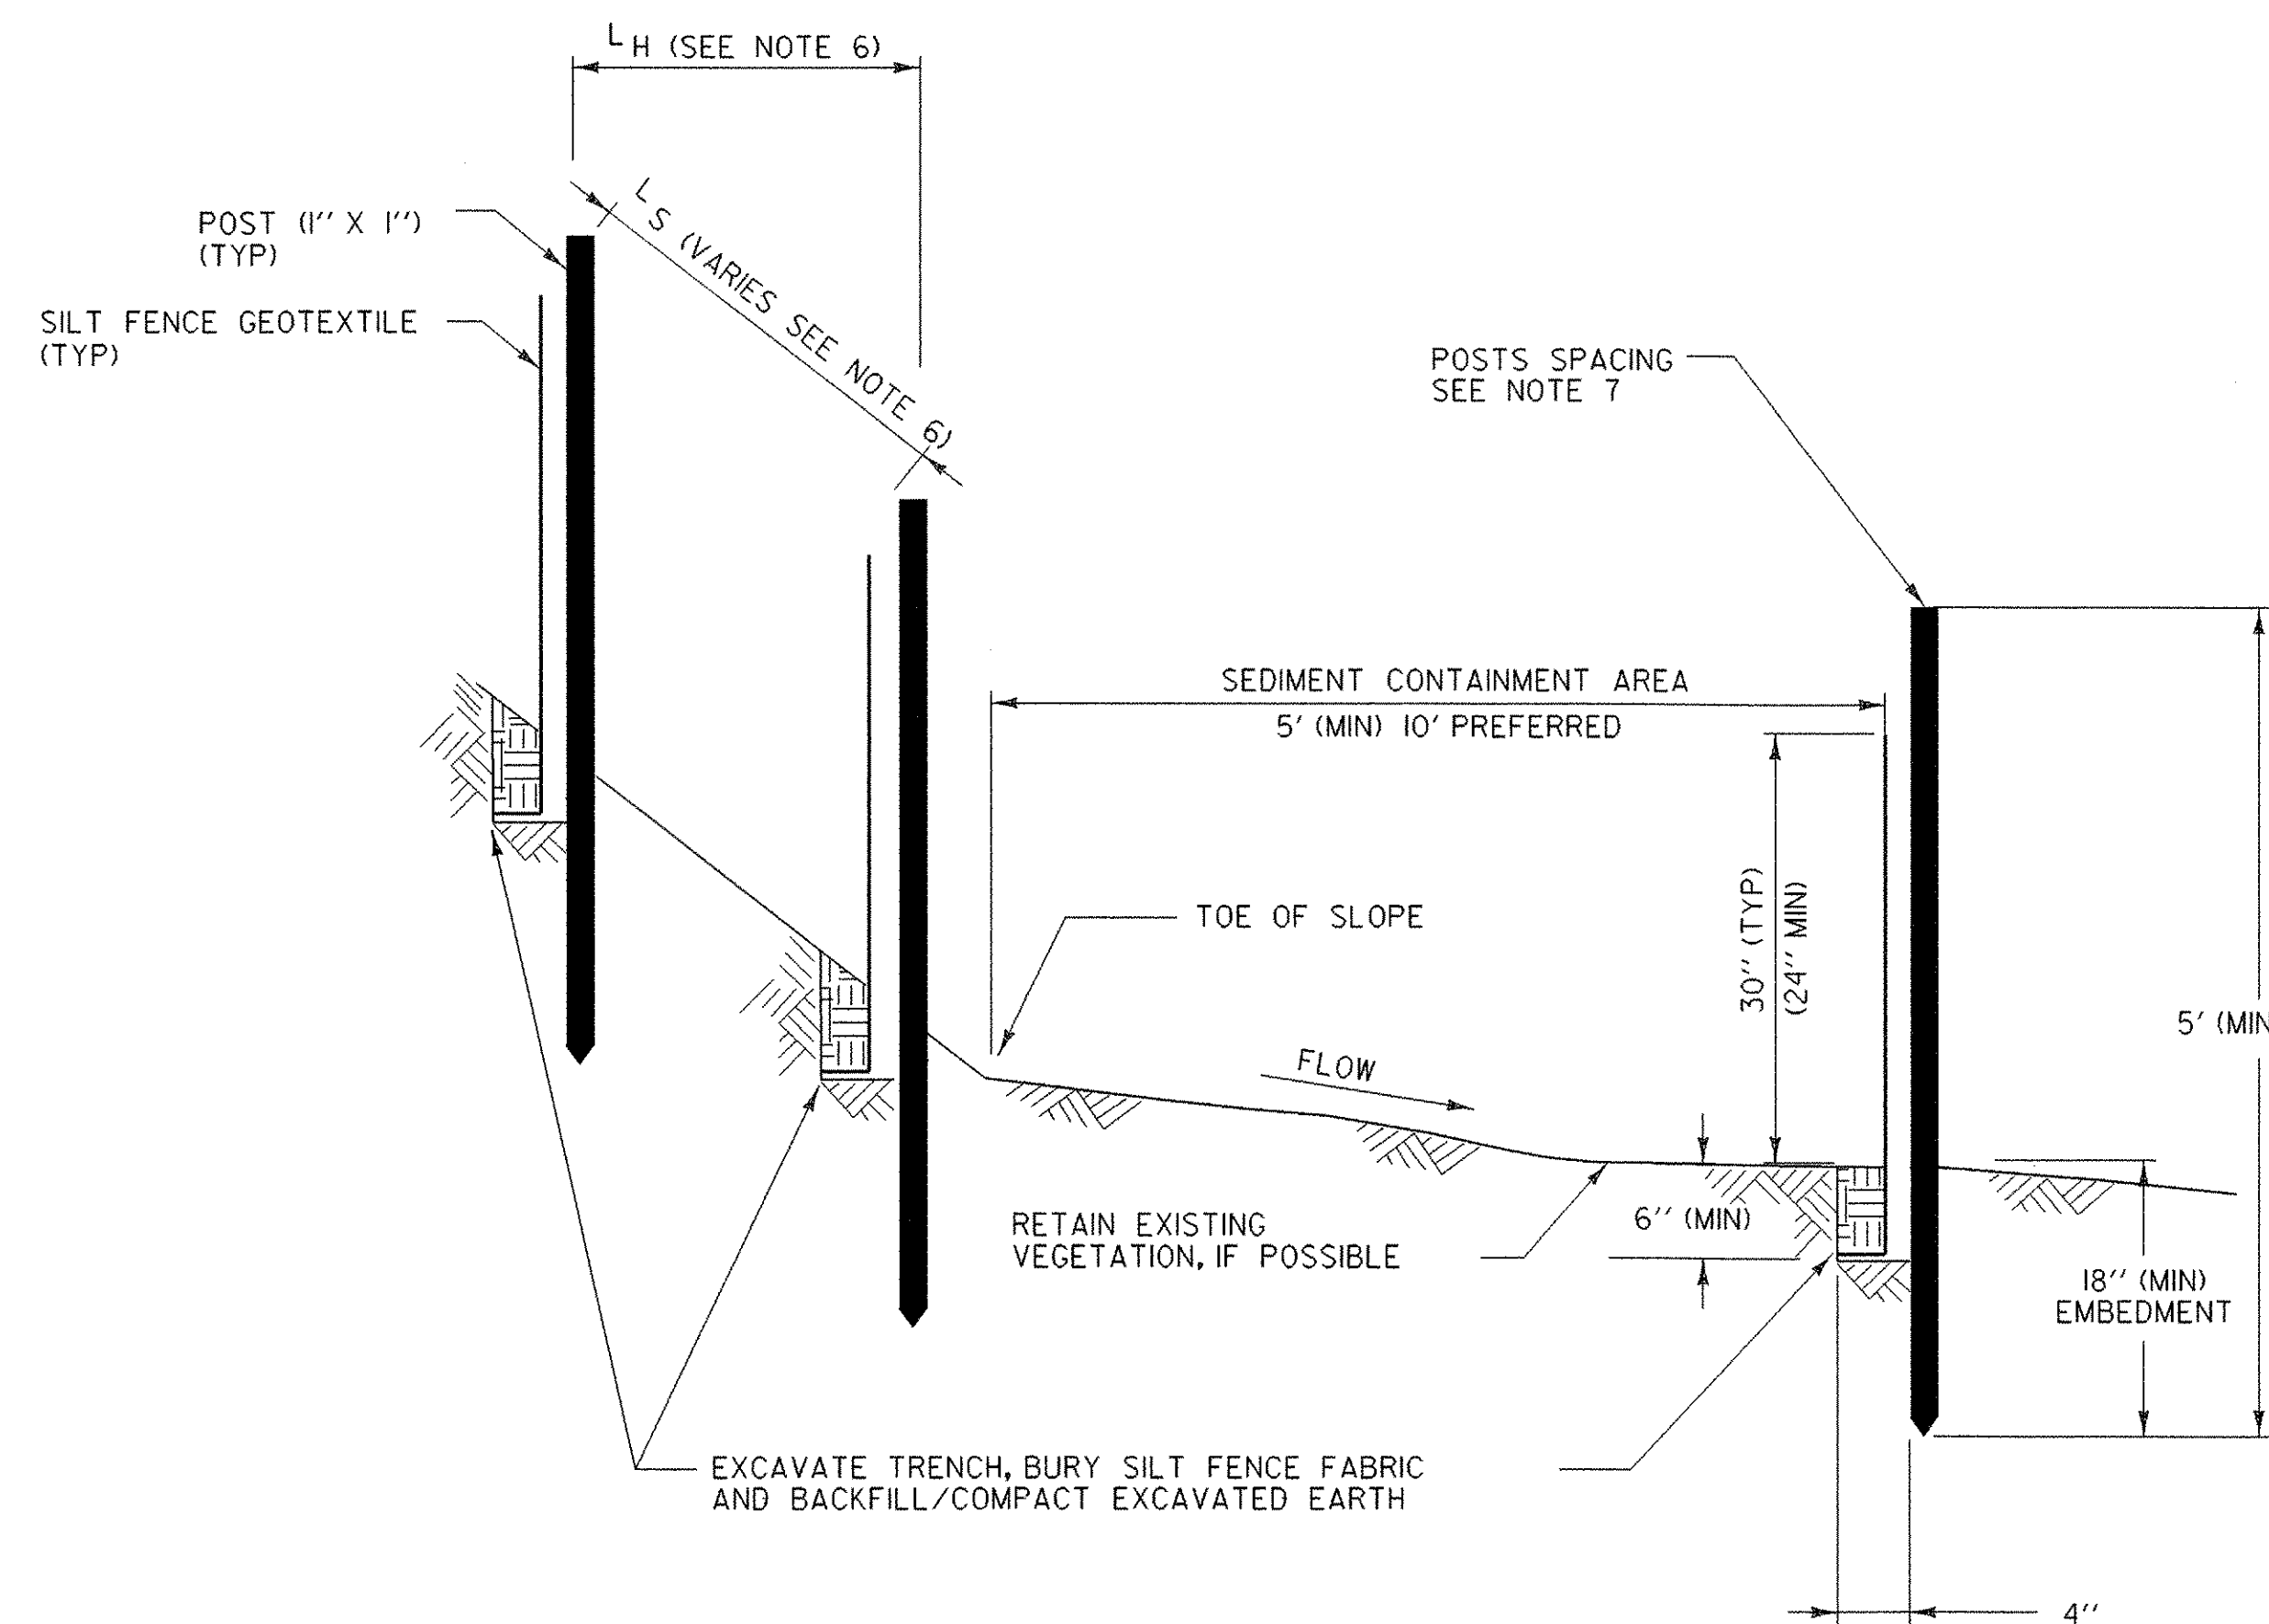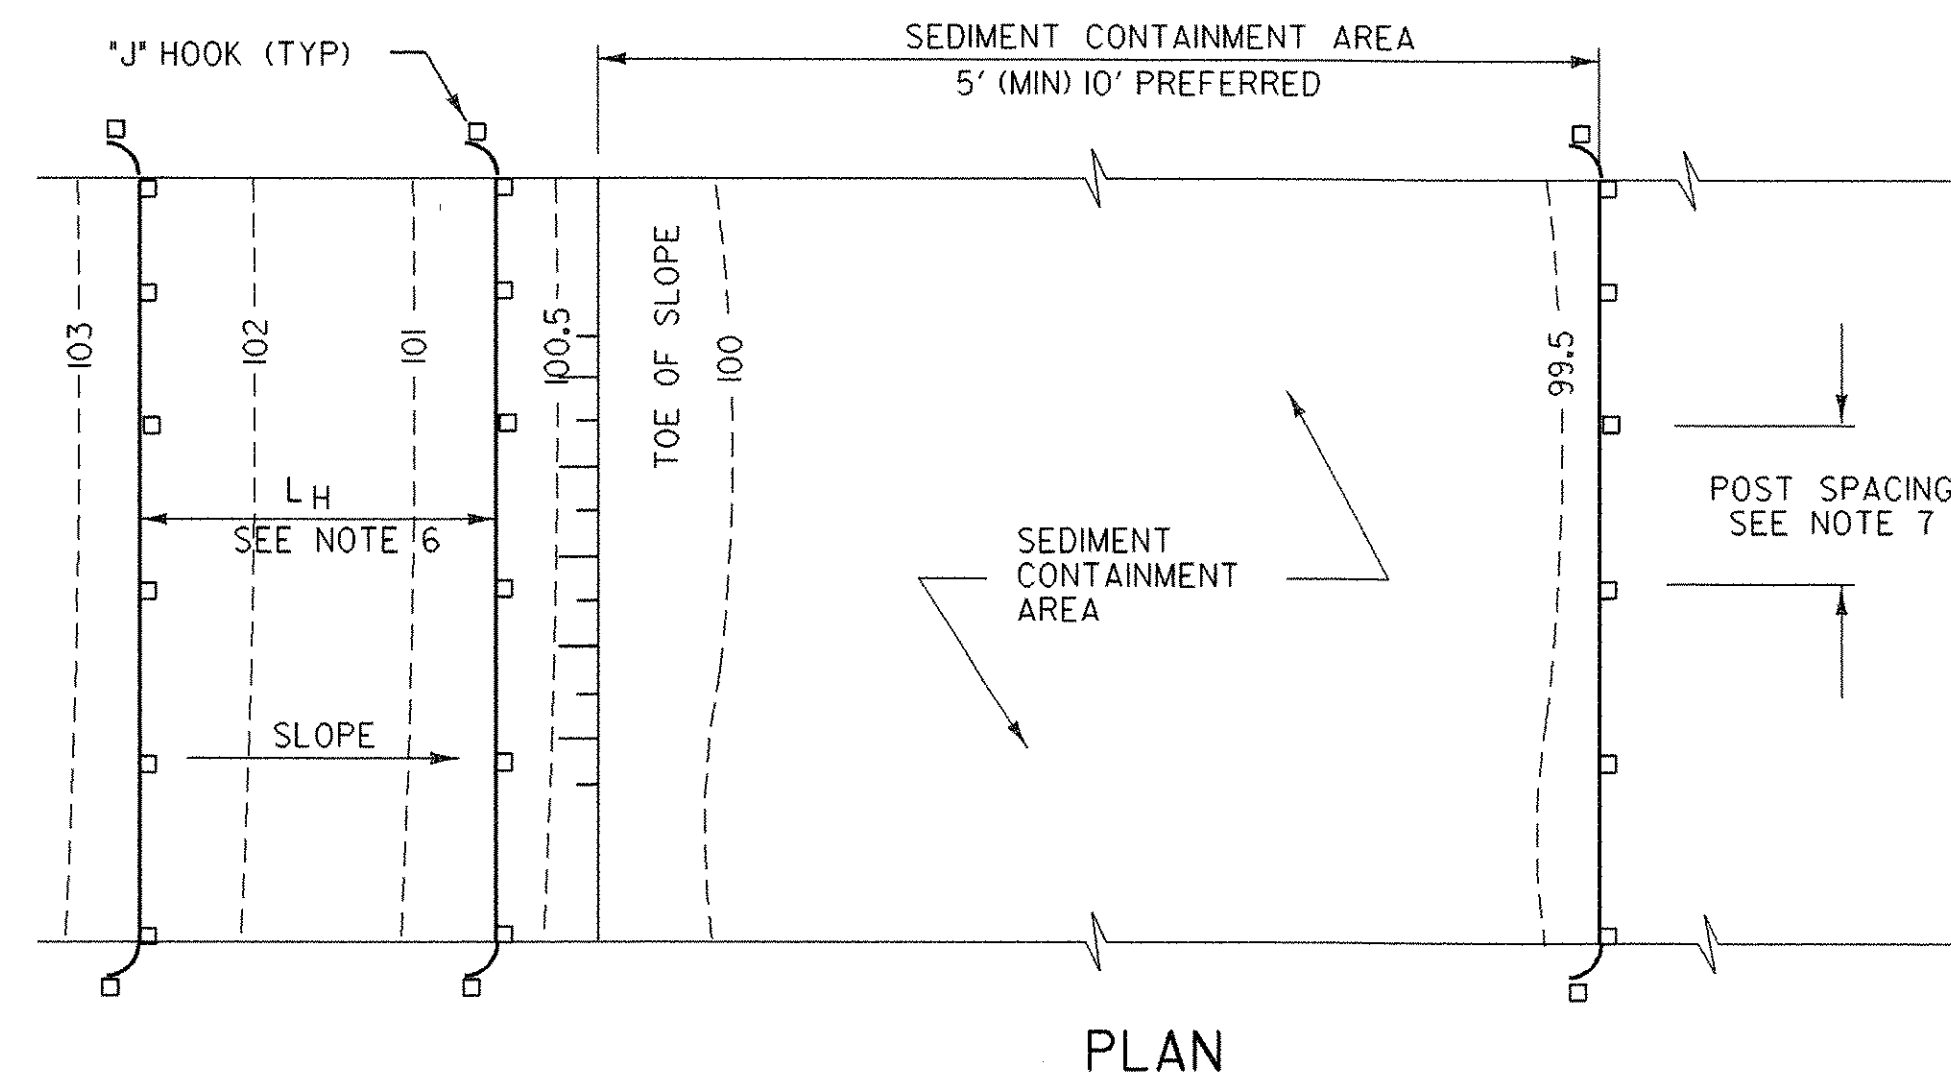

SECTION  
SILT FENCE - TEMPORARY  
NOT TO SCALE

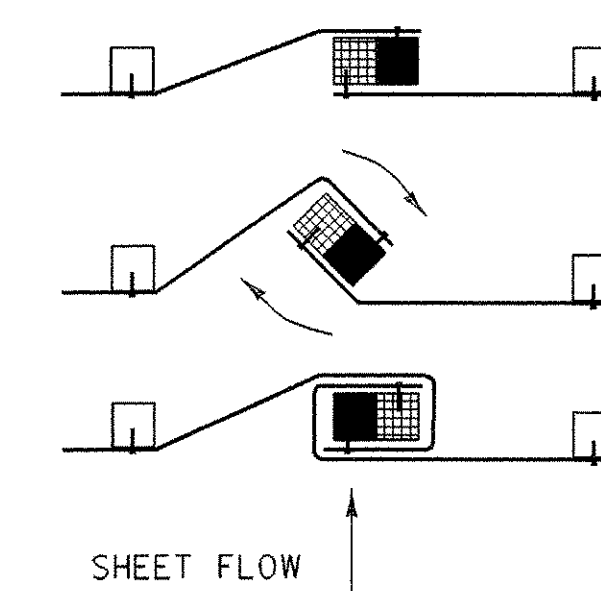

- PLACE THE END POST OF ONE FENCE INSIDE THE END POST OF THE OTHER FENCE.
- ROTATE BOTH POSTS AT LEAST 180 DEGREES IN A CLOCKWISE DIRECTION TO CREATE A TIGHT SEAL WITH THE FABRIC MATERIAL.
- DRIVE BOTH POSTS 18 INCHES INTO THE GROUND AND BURY THE FLAP IN THE TRENCH.

SPlicing DETAIL  
NOT TO SCALE

#### REVISIONS AND CORRECTIONS

JULY 15, 2005 N. GARBACK




## EROSION PREVENTION & SEDIMENT CONTROL DETAILS SILT FENCE

PROJECT NAME: JAY  
PROJECT NUMBER: ST STP CULV (2)

FILE NAME: 04b140\epsc.dgn PLOT DATE: 23-OCT-2006  
PROJECT LEADER: W. SYMONDS DRAWN BY: G. SHANGRAW  
DESIGNED BY: T. FILLBACH CHECKED BY: J. LACROIX  
epsc3.i SHEET 18 OF 39



THIS PROJECT WILL REQUIRE TWO (2) PORTABLE CHANGABLE MESSAGE SIGNS.  
 THE TWO PORTABLE CHANGABLE MESSAGE SIGNS SHALL BE FULLY OPERATIONAL  
 A MINIMUM OF TWO WEEKS PRIOR TO THE CLOSURE OF VT.105. SEE DETOUR  
 SHEET #1 FOR PLACEMENT DETAILS AND THE PROPOSED MESSAGE.

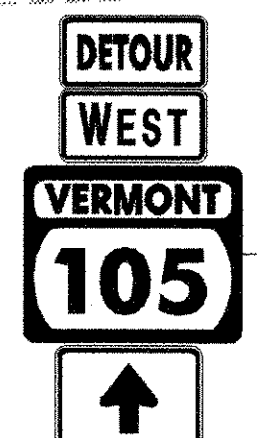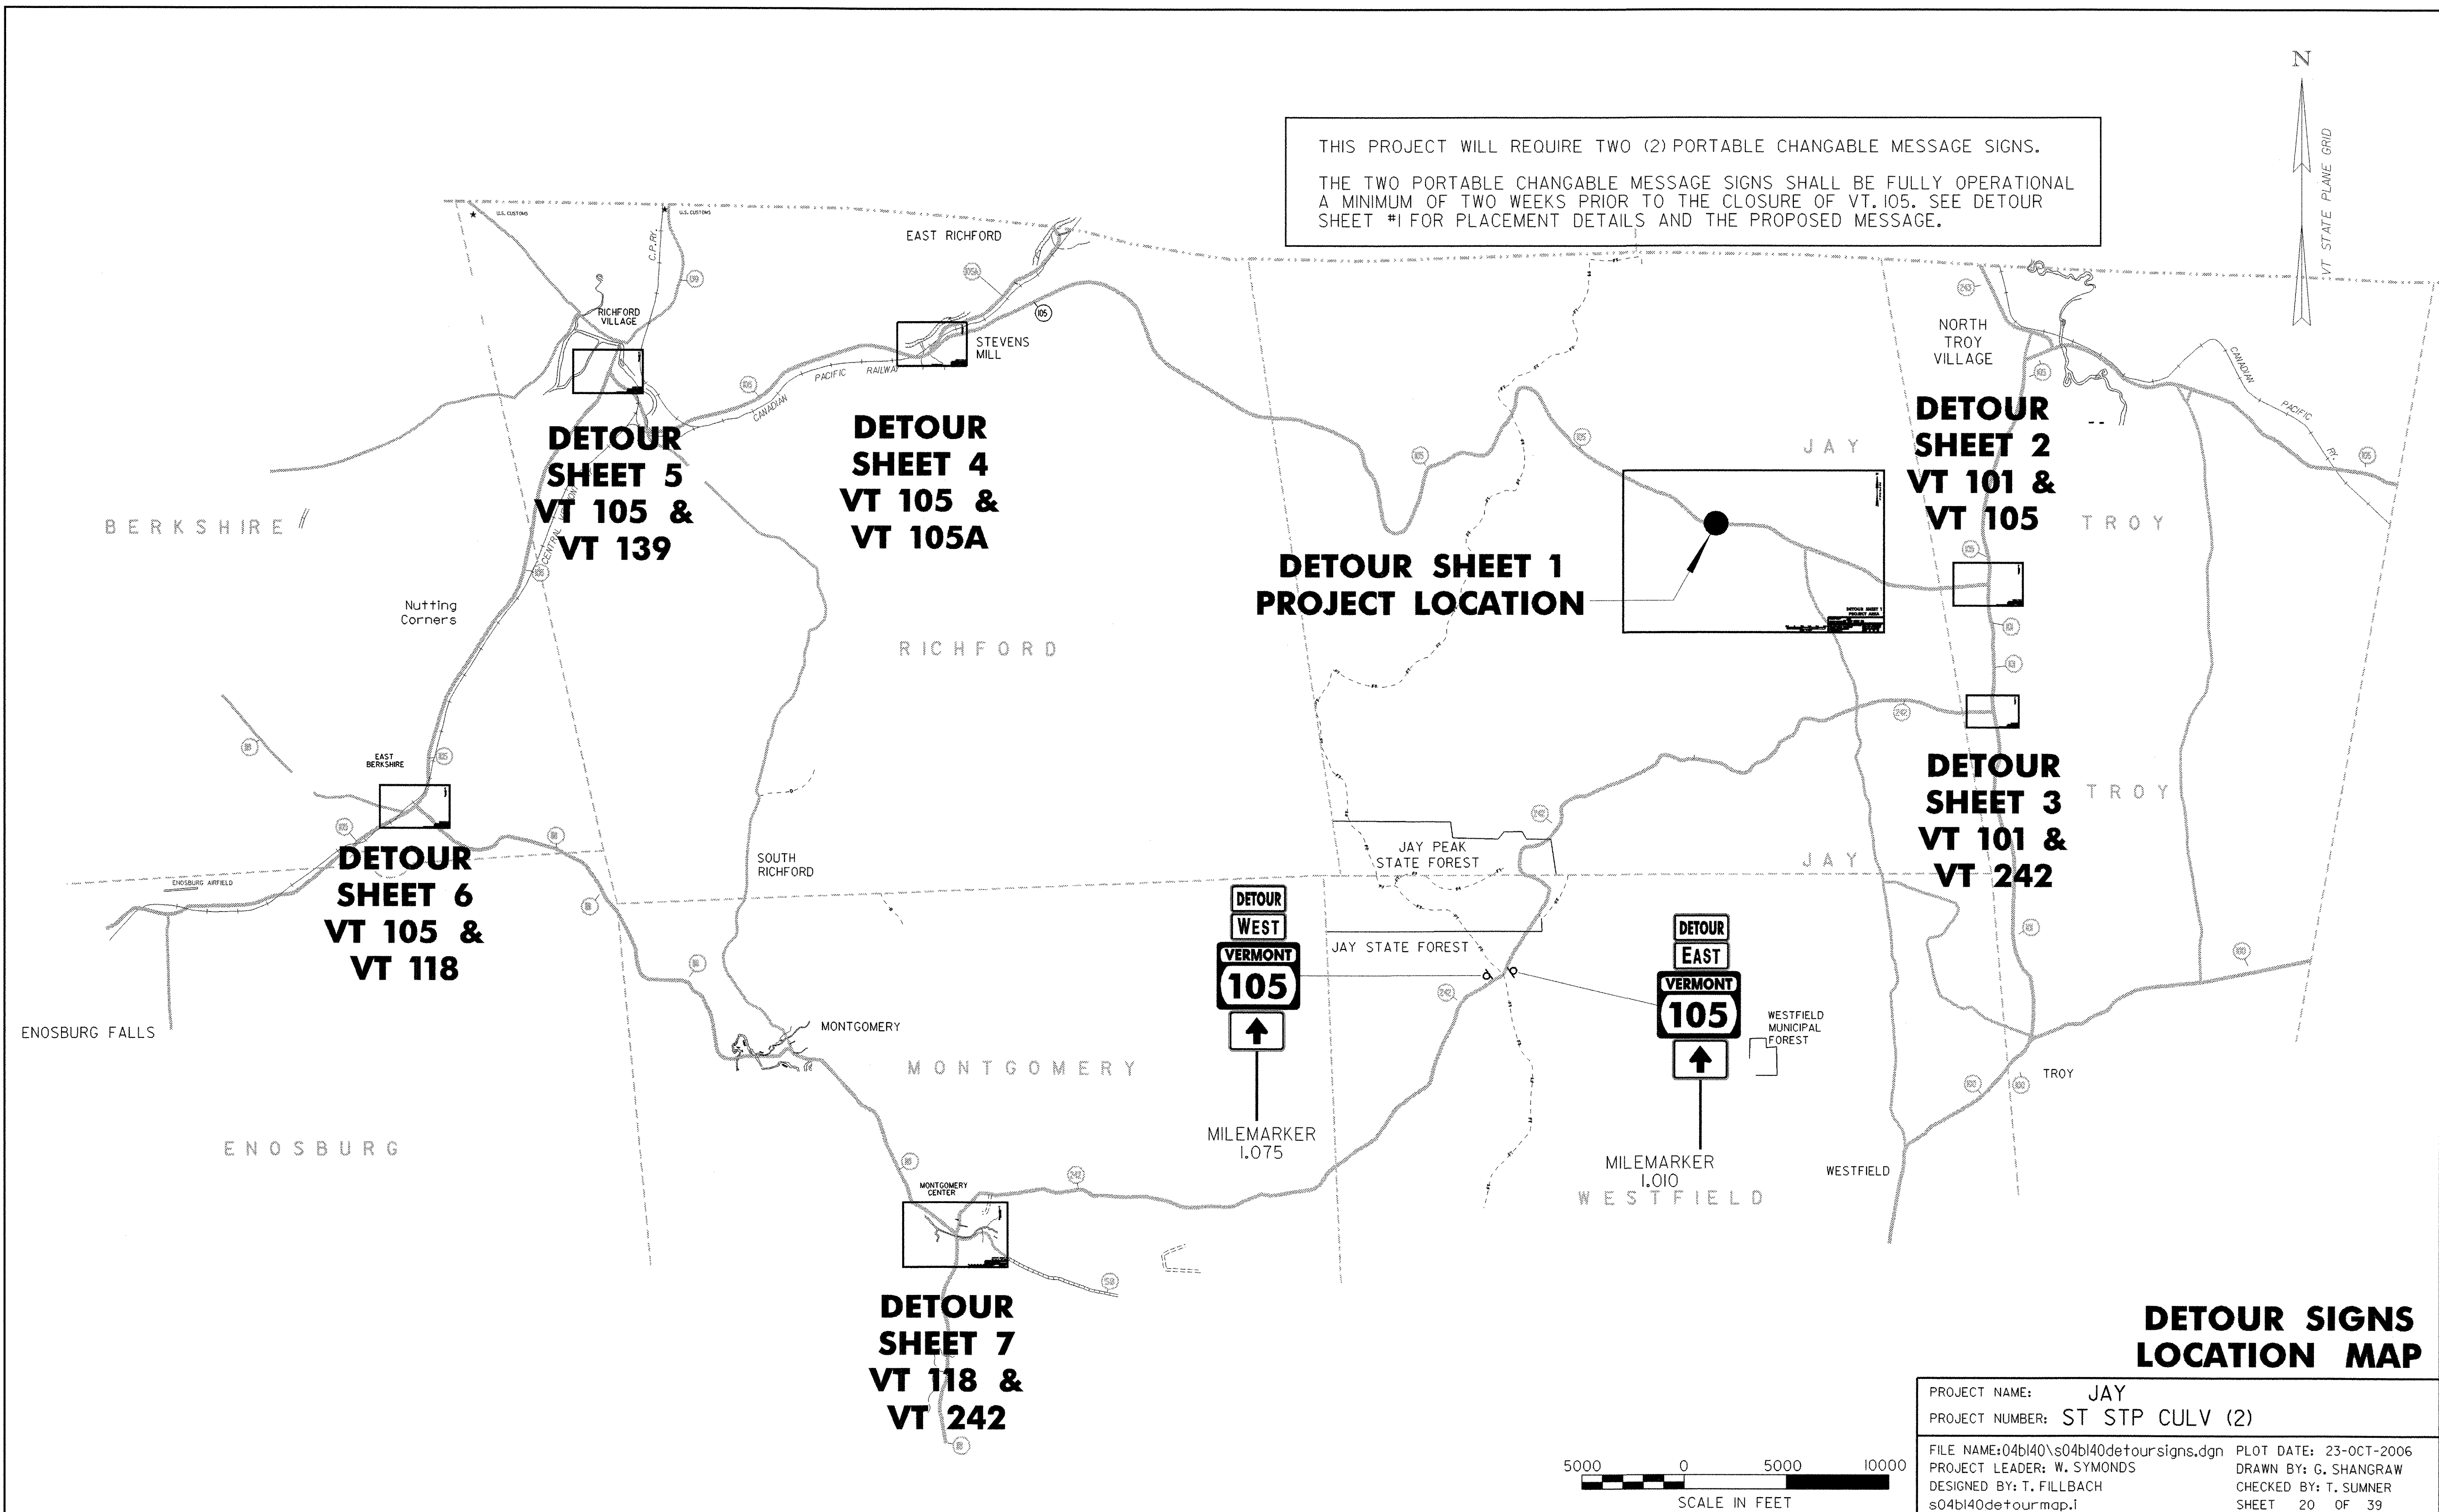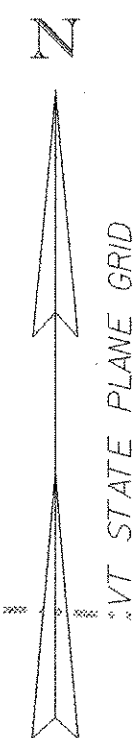


MILEMARKER 1.075




MILEMARKER 1.010  
WESTFIELD

**DETOUR SIGNS  
LOCATION MAP**

PROJECT NAME: JAY	PLOT DATE: 23-OCT-2006
PROJECT NUMBER: ST STP CULV (2)	DRAWN BY: G. SHANGRAW
FILE NAME: 04b140\04b140detoursigns.dgn	DESIGNED BY: T. SUMNER
PROJECT LEADER: W. SYMONDS	CHECKED BY: T. SUMNER
DESIGNED BY: T. FILLBACH	SHEET 20 OF 39
s04b140detourmap.i	

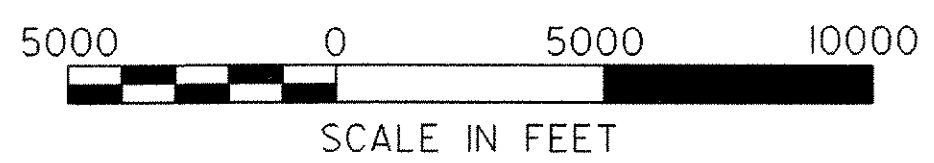

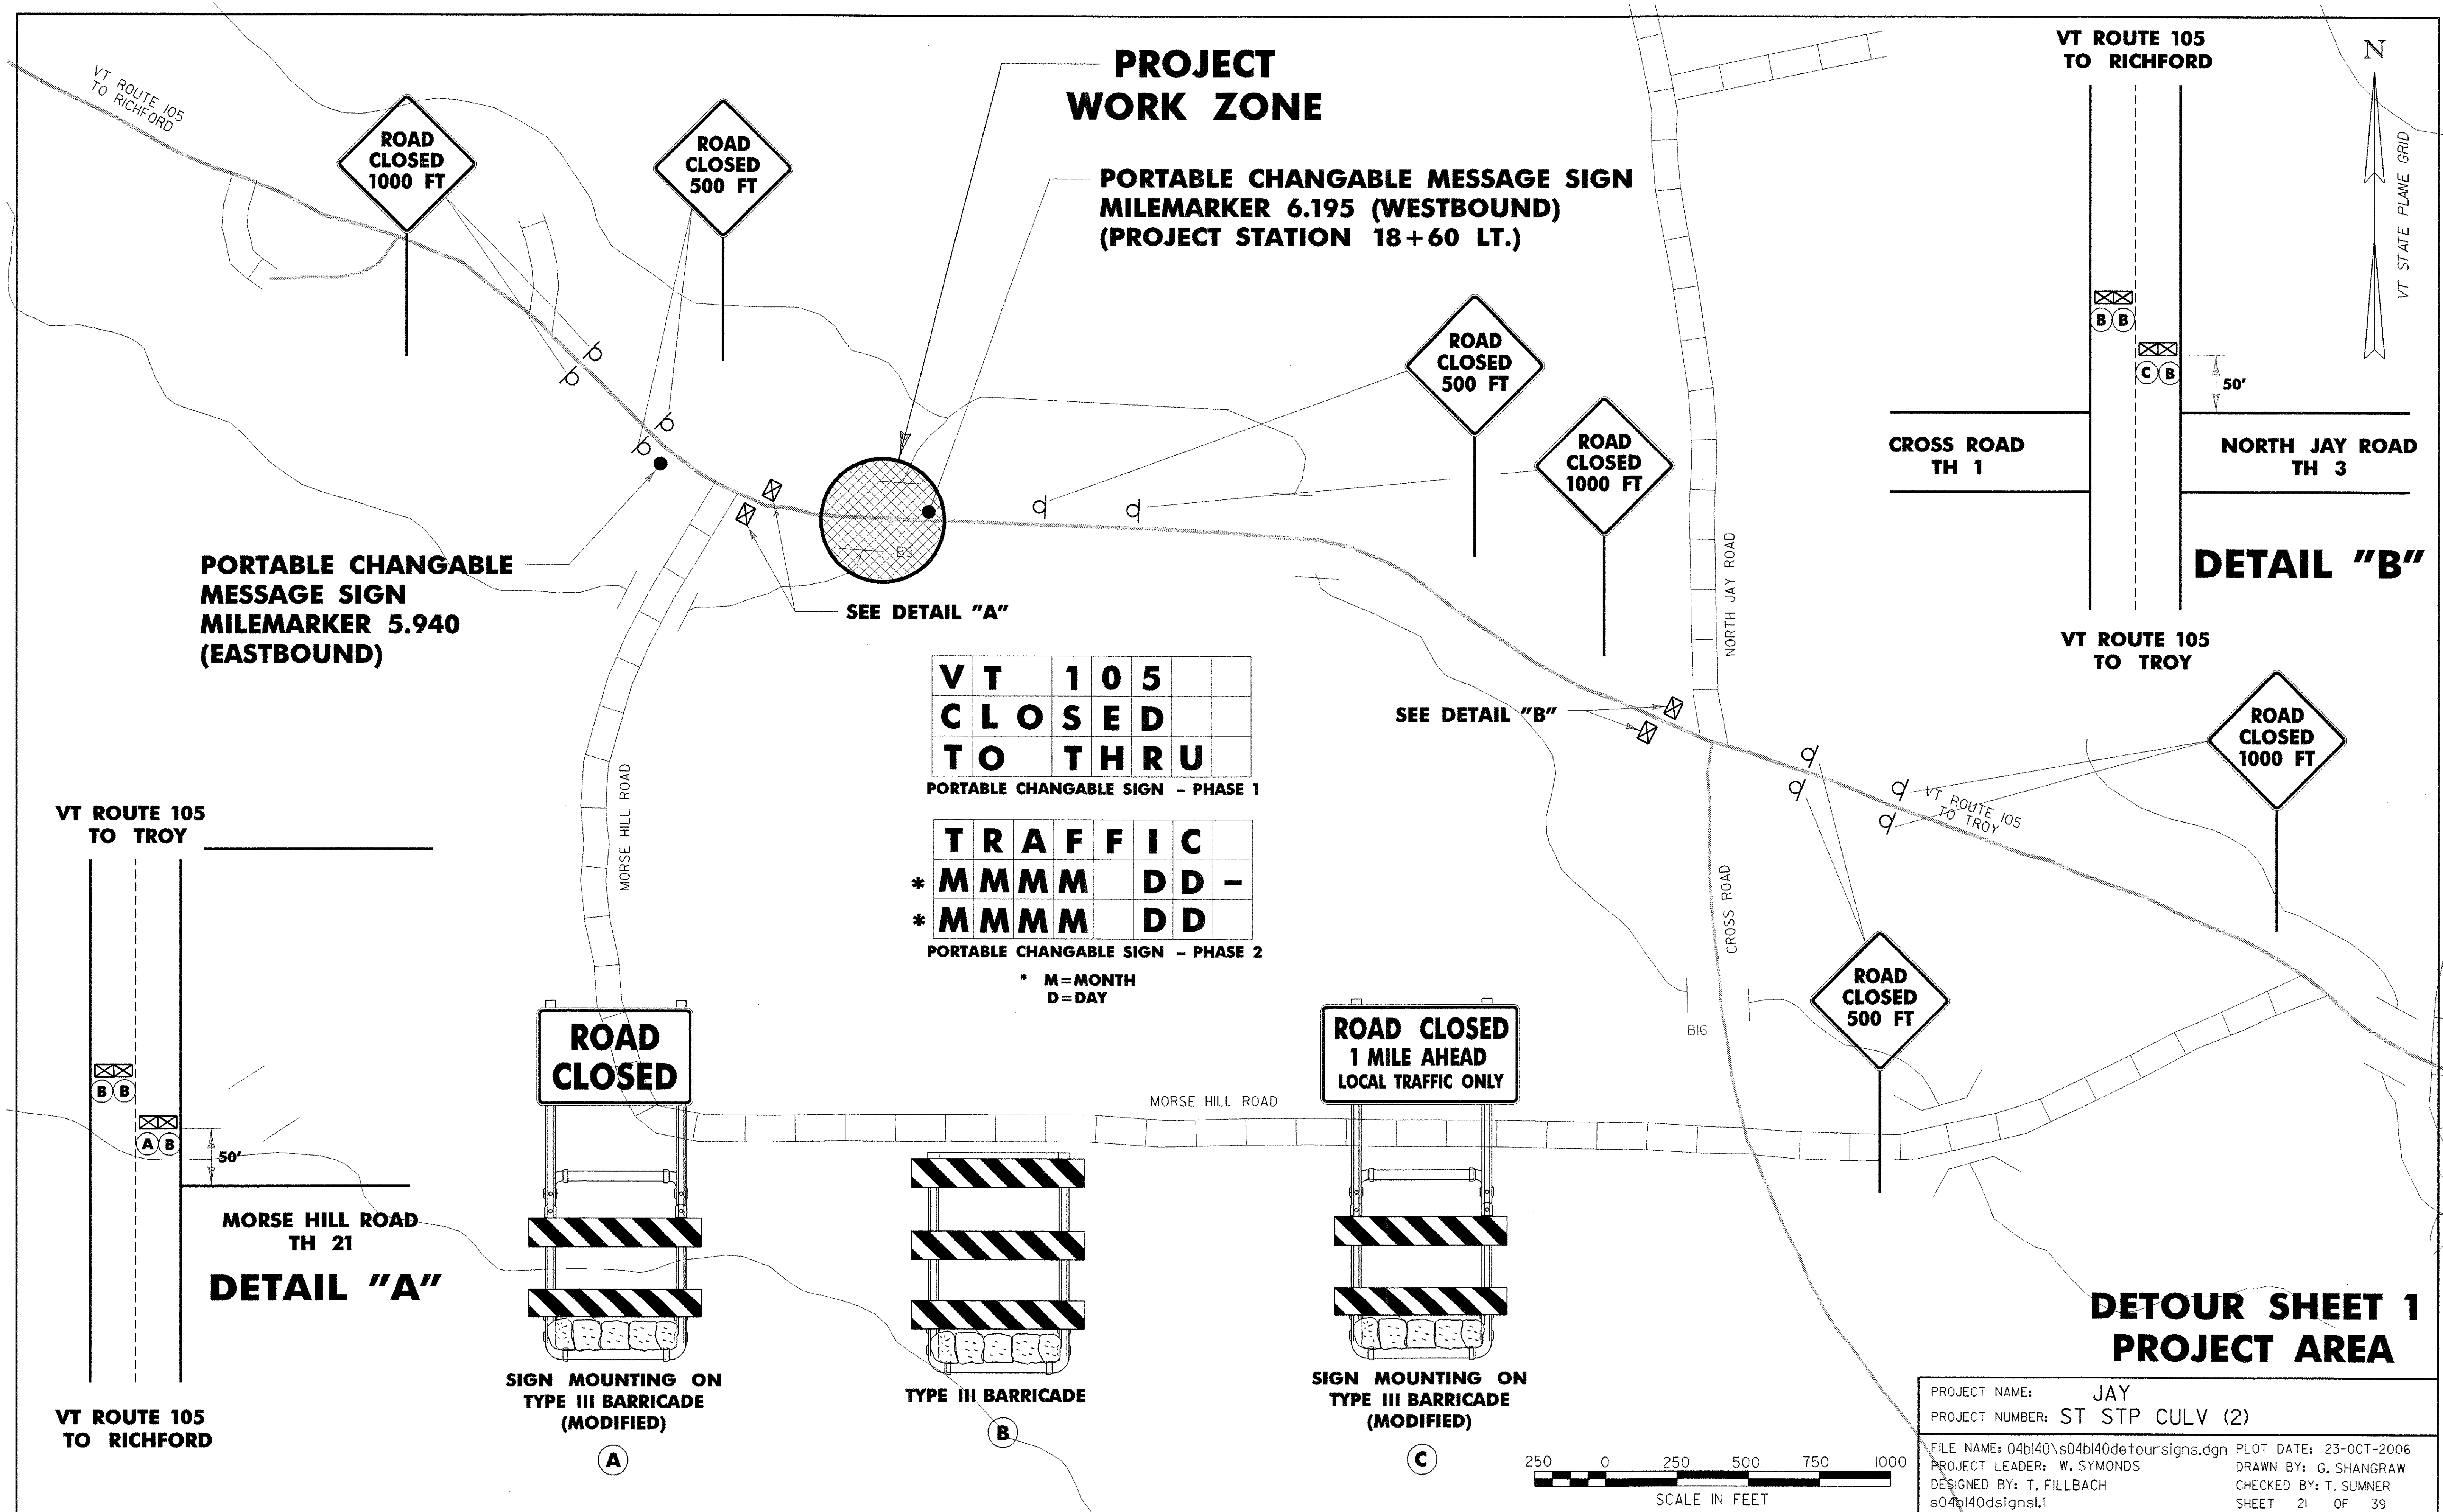

**PROJECT WORK ZONE**

PORTABLE CHANGABLE MESSAGE SIGN  
MILEMARKER 6.195 (WESTBOUND)  
(PROJECT STATION 18+60 LT.)

PORTABLE CHANGABLE MESSAGE SIGN  
MILEMARKER 5.940 (EASTBOUND)

V	T	1	0	5		
C	L	O	S	E	D	
T	O	T	H	R	U	

PORTABLE CHANGABLE SIGN - PHASE 1

T	R	A	F	F	I	C
*	M	M	M	D	D	-
*	M	M	M	D	D	

PORTABLE CHANGABLE SIGN - PHASE 2

\* M=MONTH  
D=DAY

VT ROUTE 105 TO RICHFORD

VT ROUTE 105 TO TROY

VT ROUTE 105 TO TROY

VT ROUTE 105 TO RICHFORD

CROSS ROAD TH 1

NORTH JAY ROAD TH 3

MORSE HILL ROAD TH 21

**DETOUR SHEET 1 PROJECT AREA**

**DETAIL "A"**

**DETAIL "B"**

SIGN MOUNTING ON TYPE III BARRICADE (MODIFIED)


TYPE III BARRICADE

SIGN MOUNTING ON TYPE III BARRICADE (MODIFIED)






PROJECT NAME: JAY  
PROJECT NUMBER: ST STP CULV (2)

FILE NAME: 04b140\04b140detour\signs.dgn  
PROJECT LEADER: W. SYMONDS  
DESIGNED BY: T. FILLBACH  
s04b140dsigns.l




PLOT DATE: 23-OCT-2006  
DRAWN BY: G. SHANGRAW  
CHECKED BY: T. SUMNER  
SHEET 21 OF 39

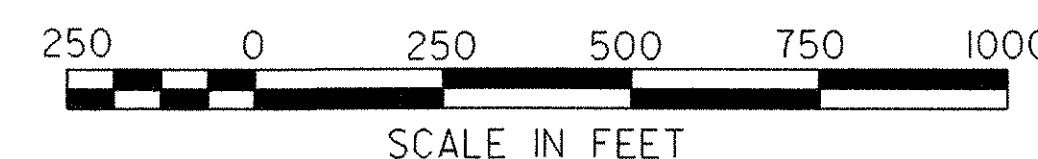


VT 105  
TO N. TROY

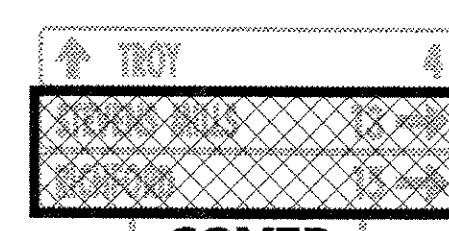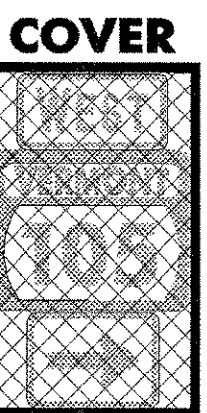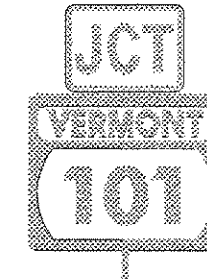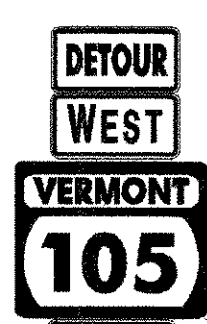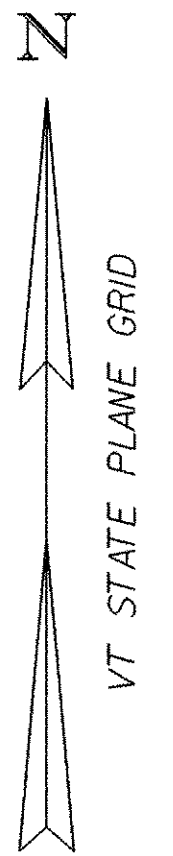

ROAD CLOSED  
2 MILES AHEAD  
LOCAL TRAFFIC ONLY

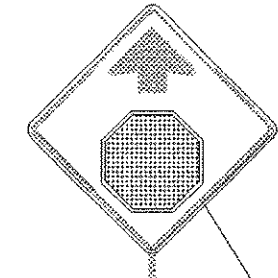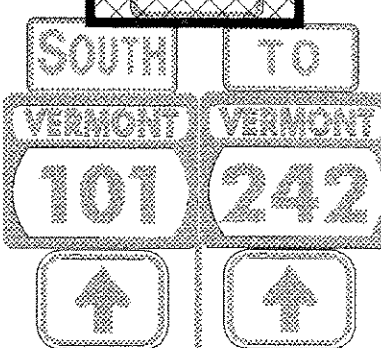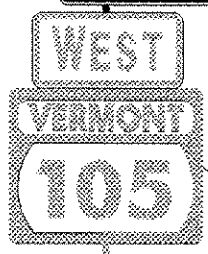


↑ STEVENS MILLS 13  
↑ RICHFORD 15

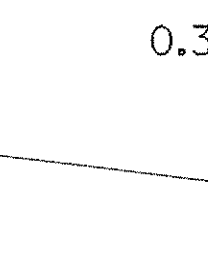


↑ NORTH TROY 2



↑ TROY 4  
RICHFORD 15

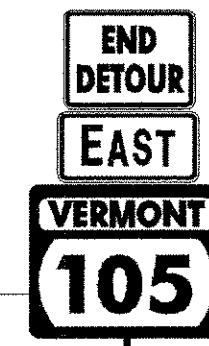

↑ NORTH TROY 2


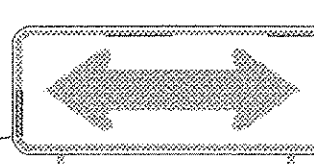


0.460





VT 105 MM 0.430=  
VT 101 MM 4.330

4.330

VT 105  
TO RICHFORD

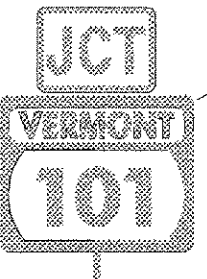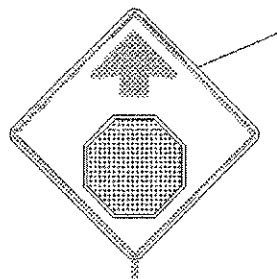

← NORTH TROY 2  
TROY 4 →  
NEWPORT 14 →

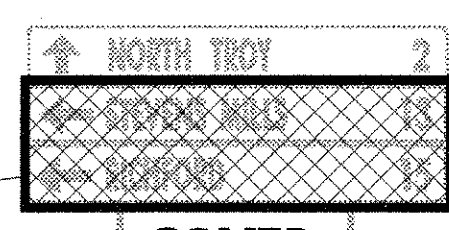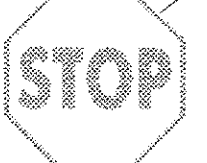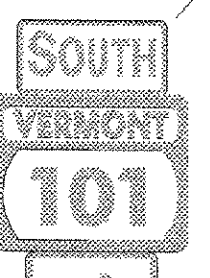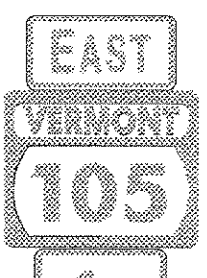

0.235

0.295


0.335

0.420

4.237

4.276



TH 12  
LACHANCE ROAD

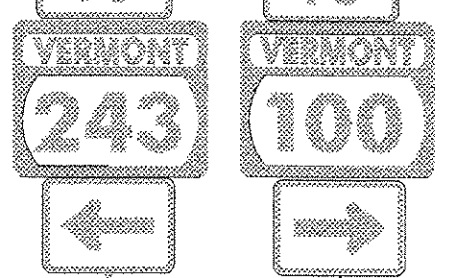

0.375


TROY 4  
NEWPORT 14

4.275

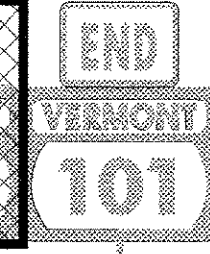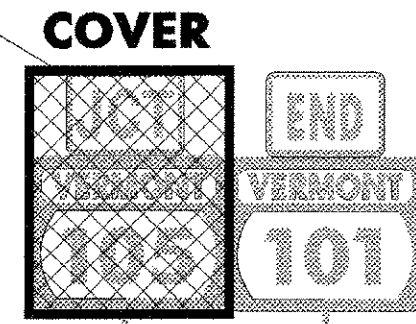

4.235

VT.101  
TO TROY

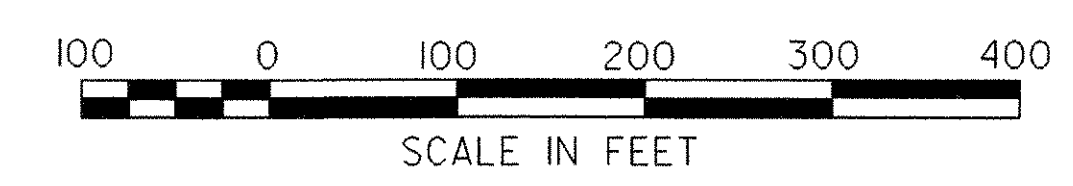


# DETOUR SHEET 2 VT 101 & VT 105

PROJECT NAME:	JAY	PLLOT DATE:	23-OCT-2006
PROJECT NUMBER:	ST STP CULV (2)	DRAWN BY:	G. SHANGRAW
FILE NAME:	04b140\04b140detour\signs.dgn	DESIGNED BY:	T. FILLBACH
PROJECT LEADER:	W. SYMONDS	CHECKED BY:	T. SUMNER
s04b140dsigns2.1		SHEET 22 OF 39	




VT 105A  
TO E. RICHFORD

VT 105  
TO N. TROY

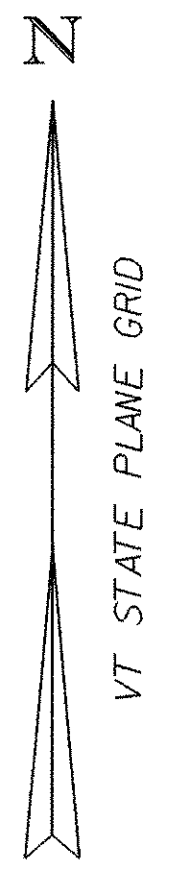




VT 105  
TO RICHFORD

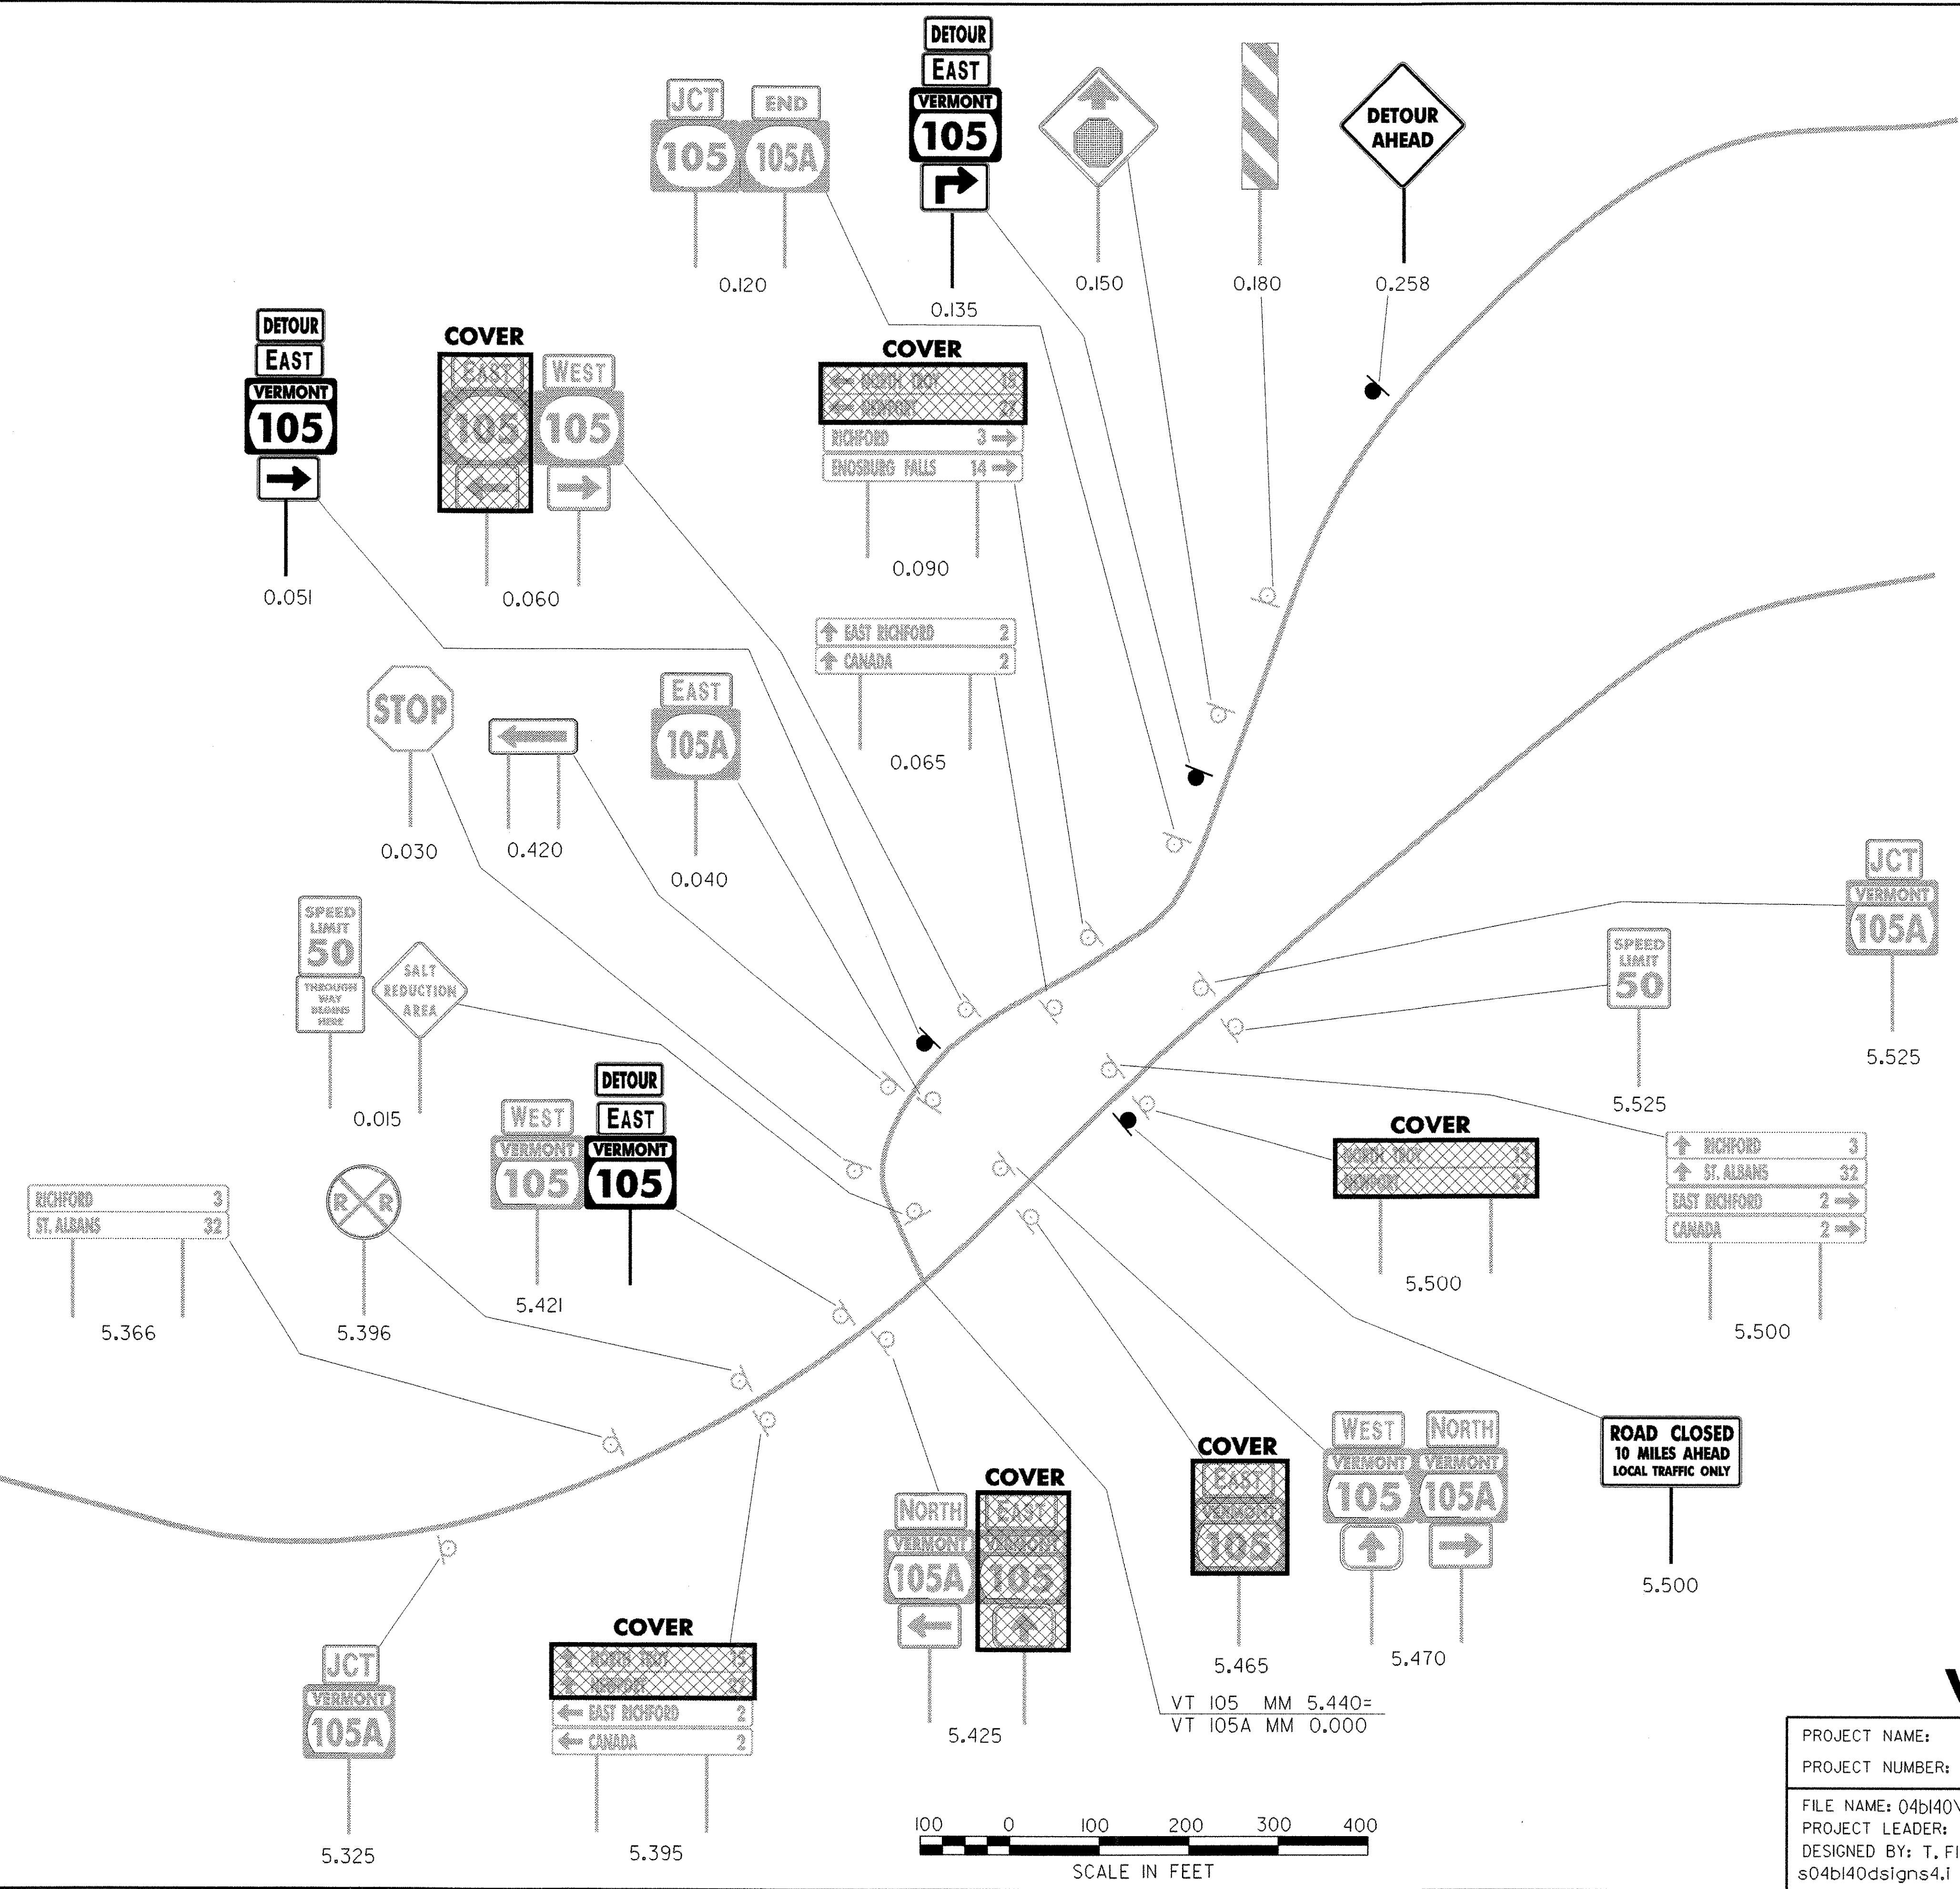

## DETOUR SHEET 4 VT 105 & VT 105A


PROJECT NAME:	JAY	PLLOT DATE:	23-OCT-2006
PROJECT NUMBER:	ST STP CULV (2)	DRAWN BY:	G. SHANGRAW
FILE NAME:	04b140\s04b140detoursigns.dgn	DESIGNED BY:	T. FILLBACH
		CHECKED BY:	T. SUMNER
			SHEET 24 OF 39

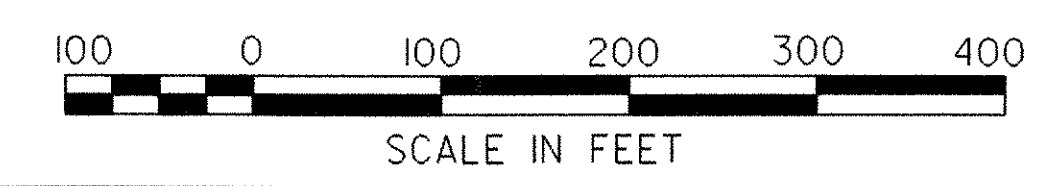

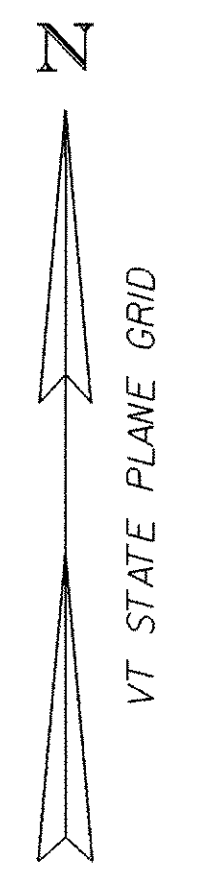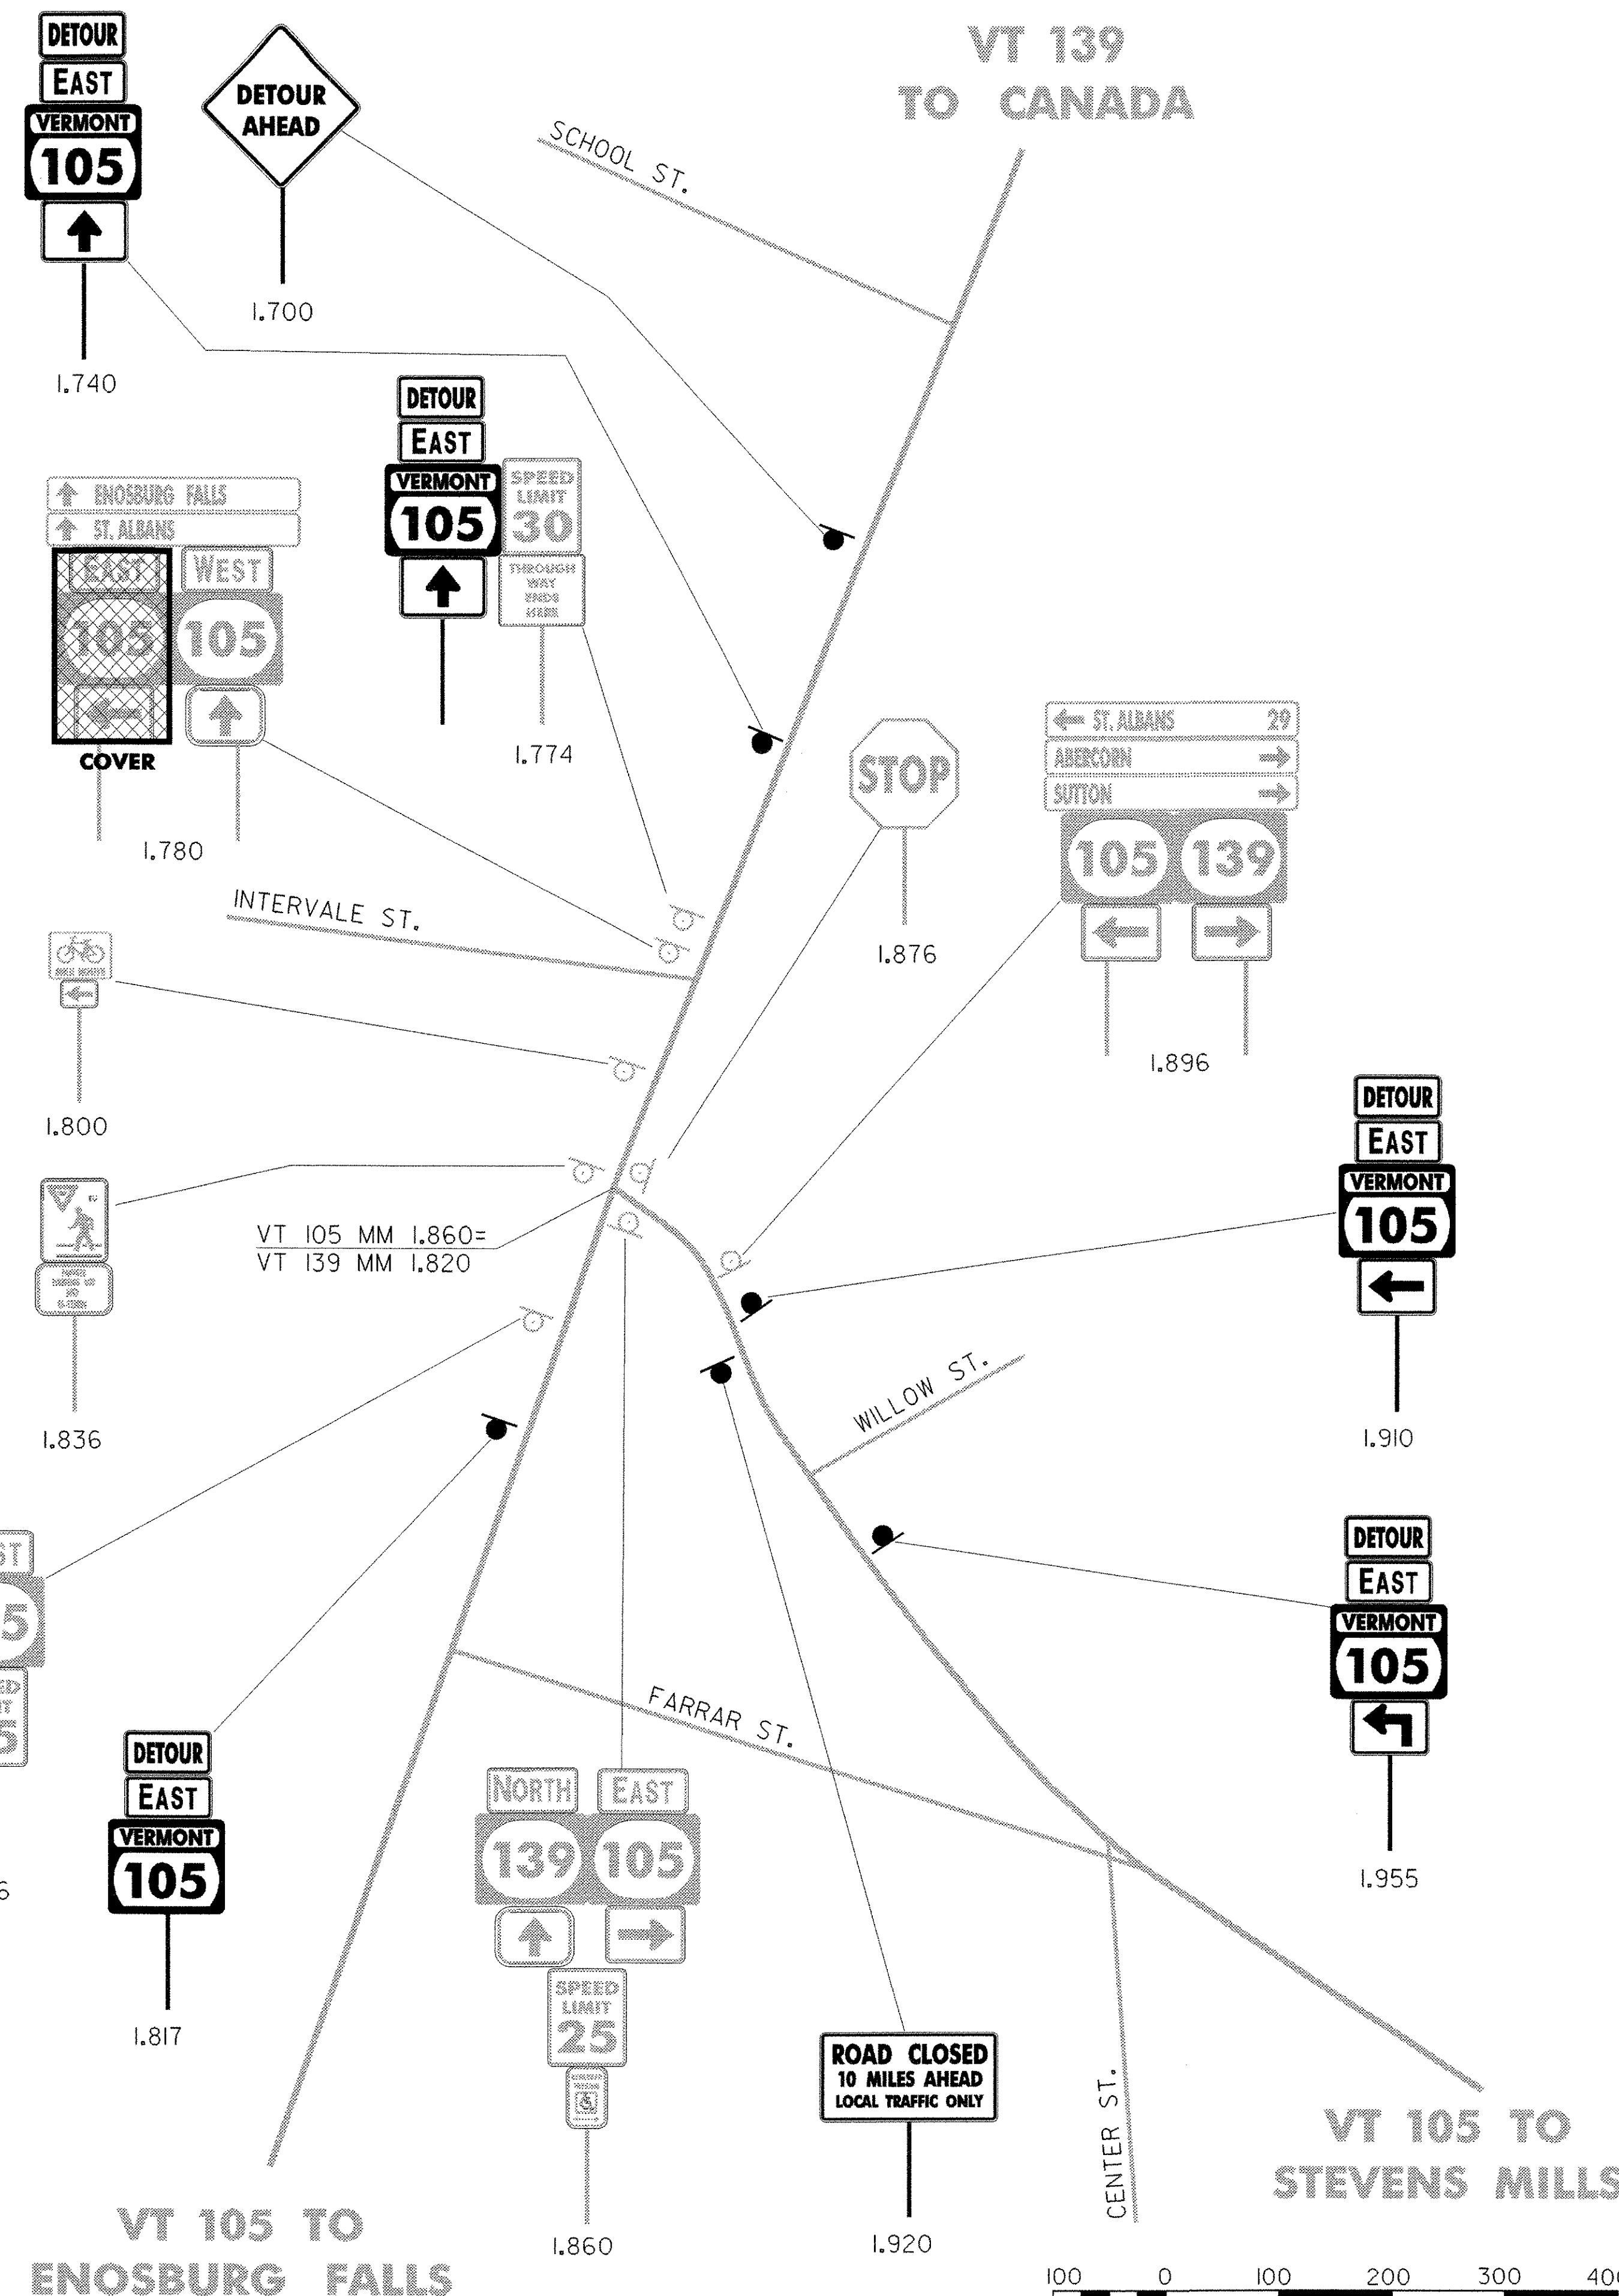

## DETOUR SHEET 5 VT 105 & VT 139

PROJECT NAME:	JAY	PLOT DATE:	23-OCT-2006
PROJECT NUMBER:	ST STP CULV (2)	DRAWN BY:	G. SHANGRAW
FILE NAME:	04b140\s04b140detour\signs.dgn	DESIGNED BY:	T. FILLBACH
PROJECT LEADER:	W. SYMONDS	CHECKED BY:	T. SUMNER
			SHEET 25 OF 39

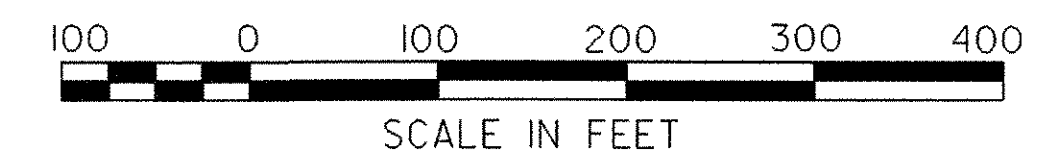

VT 105 TO  
ENOSBURG FALLS

VT 105 TO  
STEVENS MILLS

ROAD CLOSED  
10 MILES AHEAD  
LOCAL TRAFFIC ONLY

VT 105 MM 1.860=  
VT 139 MM 1.820

WILLOW ST.

FARRAR ST.

CENTER ST.

INTERVALE ST.

SCHOOL ST.

VT 139  
TO CANADA



VT 118 TO  
E. BERKSHIRE

SPEED  
LIMIT  
30  
DETOUR  
WEST  
VERMONT  
105


← MONTGOMERY 2  
← EAST BERKSHIRE 9  
← JAY PEAK SKI AREA 11  
← JAY 13  
← NORTH VERMONT 118  
← EAST VERMONT 242  
DETOUR  
EAST  
VERMONT  
105

DETOUR  
WEST  
VERMONT  
105

JCT  
VERMONT  
118  
END  
VERMONT  
242

EMERGENCY  
VEHICLES

VT 242  
TO JAY

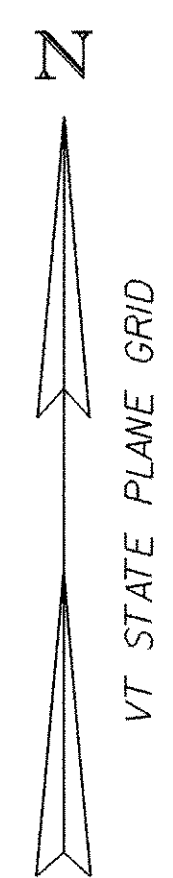

5.755

3.690

3.670

3.655

3.630

5.615

STOP

THROUGH  
WAY  
ENDS  
HERE

HIDDEN  
DRIVE  
RIGHT

DETOUR  
EAST  
VERMONT  
105

EMERGENCY  
VEHICLES

SPEED  
LIMIT  
30

EAST  
VERMONT  
242

DETOUR  
EAST  
VERMONT  
105

20 MILES  
PER HOUR

5.710

3.785

3.750

3.685

3.740

3.770

3.650

3.620

DETOUR  
EAST  
VERMONT  
105

5.690

VT 118 MM 5.625=  
VT 242 MM 3.790

STOP

DETOUR  
EAST  
VERMONT  
105

EAST  
VERMONT  
58

SOUTH  
VERMONT  
118

GRANNY GRUNTS ROAD

STOP

VT 58  
TO LOWELL

4.735

SOUTH  
VERMONT  
118

NORTH  
VERMONT  
118

TO  
EAST  
VERMONT  
242

← JAY PEAK SKI AREA 11  
← JAY 13  
← EDEN 15 →  
← EAST VERMONT 242  
← SOUTH VERMONT 118  
← TO VERMONT 58

5.670

← MONTGOMERY 2 →  
← EAST BERKSHIRE 9 →  
← EDEN 15 →  
← HYDE PARK 24 →  
← SOUTH VERMONT 118  
← EAST VERMONT 58  
← NORTH VERMONT 118  
DETOUR  
WEST  
VERMONT  
105

EAST  
VERMONT  
58

5.585

VT 118 MM 5.579=  
VT 58 MM 4.740

← MONTGOMERY 2  
← EAST BERKSHIRE 9  
← JAY PEAK SKI AREA 11  
← JAY 13  
← LOWELL 9 →

5.475

← NORTH VERMONT 118  
← EAST VERMONT 58  
← TO VERMONT 242  
← EAST VERMONT 58

DETOUR  
EAST  
VERMONT  
105

5.553

LEGAL LOAD  
LIMIT  
24,000  
POUNDS

4.720

4.720

SALT  
REDUCTION  
AREA  
NEXT  
15 MILES

5.515

SOUTH  
VERMONT  
118

5.500

SPEED  
LIMIT  
40

5.485

VT 118 TO  
BELVIDERE  
CORNERS

4.720

DETOUR  
AHEAD


5.410

REDUCED  
SPEED  
AHEAD

5.530

JCT  
VERMONT  
58  
JCT  
VERMONT  
242

4.720

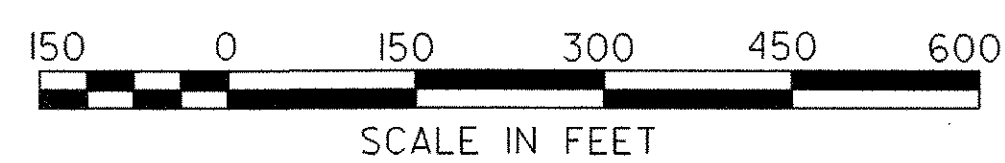

# DETOUR SHEET 7 VT 118 & VT 242

PROJECT NAME: JAY  
PROJECT NUMBER: ST STP CULV (2)  
FILE NAME: 04b140\s04b140detoursigns.dgn PLOT DATE: 23-OCT-2006  
PROJECT LEADER: W. SYMONDS DRAWN BY: G. SHANGRAW  
DESIGNED BY: T. FILLBACH CHECKED BY: T. SUMNER  
S04b140dsigns7.l SHEET 27 OF 39

**SOIL CLASSIFICATION**

AASHTO

A1	Gravel and Sand
A3	Fine Sand
A2	Silty or Clayey Gravel and Sand
A4	Silty Soil - Low Compressibility
A5	Silty Soil - Highly Compressible
A6	Clayey Soil - Low Compressibility
A7	Clayey Soil - Highly Compressible

**ROCK QUALITY DESIGNATION**

R.Q.D. (%)	ROCK DESCRIPTION
<25	Very Poor
25 to 50	Poor
51 to 75	Fair
76 to 90	Good
>90	Excellent

**SHEAR STRENGTH**

UNDRAINED SHEAR STRENGTH IN P.S.F.	CONSISTENCY
<250	Very Soft
250-500	Soft
500-1000	Med. Stiff
1000-2000	Stiff
2000-4000	Very Stiff
>4000	Hard

**CORRELATION GUIDE OF "N" TO DENSITY/CONSISTENCY**

DENSITY (GRANULAR SOILS)		CONSISTENCY (COHESIVE SOILS)	
N	DESCRIPTIVE TERM	N	DESCRIPTIVE TERM
<5	Very Loose	<2	Very Soft
5-10	Loose	2-4	Soft
11-24	Med. Dense	5-8	Med. Stiff
25-50	Dense	9-15	Stiff
>50	Very Dense	16-30	Very Stiff
		31-60	Hard
		>60	Very Hard

**COMMONLY USED SYMBOLS**

- ▼ Water Elevation
- ⊕ Standard Penetration Boring
- ⊗ Auger Boring
- ⊙ Rod Sounding
- S Sample
- N Standard Penetration Test
- Blow Count Per Foot For:
- 2" O.D. Sampler
- 1 3/8" I.D. Sampler
- Hammer Weight Of 140 Lbs.
- Hammer Fall Of 30"
- VS Field Vane Shear Test
- US Undisturbed Soil Sample
- B Blast
- DC Diamond Core
- MD Mud Drill
- WA Wash Ahead
- HSA Hollow Stem Auger
- AX Core Size 1 1/2"
- BX Core Size 1 3/8"
- NX Core Size 2 1/8"
- M Double Tube Core Barrel Used
- LL Liquid Limit
- PL Plastic Limit
- PI Plasticity Index
- NP Non Plastic
- w Moisture Content (Dry Wgt. Basis)
- D Dry
- M Moist
- MTW Moist To Wet
- W Wet
- Sat Saturated
- Bo Boulder
- Gr Gravel
- Sa Sand
- Si Silt
- Cl Clay
- HP Hardpan
- Le Ledge
- NLTD No Ledge To Depth
- CNPF Can Not Penetrate Further
- TLOB To Ledge Or Boulder
- NR No Recovery
- Rec. Recovery
- 1/2 Rec. Percent Recovery
- ROD Rock Quality Designation
- CBR California Bearing Ratio
- < Less Than
- > Greater Than
- R Refusal (N > 100)

COLOR			
blk	Black	pnk	Pink
bl	Blue	pu	Purple
brn	Brown	rd	Red
dk	Dark	tn	Tan
gry	Gray	wh	White
gn	Green	yel	Yellow
lt	Light	mlc	Multicolored
or	Orange		

**DEFINITIONS (AASHTO)**


- BEDROCK (LEDGE)** - Rock in its native location of indefinite thickness.
- BOULDER** - A rock fragment with an average dimension > 12 inches.
- COBBLE** - Rock fragments with an average dimension between 3 and 12 inches.
- GRAVEL** - Rounded particles of rock < 3" and > 0.075" (#10 sieve).
- SAND** - Particles of rock < 0.075" (#10 sieve) and > 0.0029" (#200 sieve).
- SILT** - Soil < 0.0029" (#200 sieve), non or slightly plastic and exhibits no strength when air-dried.
- CLAY** - Fine grained soil, exhibits plasticity when moist and considerable strength when air-dried.
- VARVED** - Alternate layers of silt and clay.
- HARDPAN** - Extremely dense soil, cemented layer, not softened when wet.
- MUCK** - Soft organic soil (containing > 10% organic material).
- MOISTURE CONTENT** - Weight of water divided by dry weight of soil.
- FLOWING SAND** - Granular soil so saturated (loose) that it flows into drill casing during extraction of wash rod.
- STRIKE** - Angle from magnetic north to line of intersection of bed with a horizontal plane.
- DIP** - Inclination of bed with a horizontal plane.

**GENERAL NOTES**

- The subsurface explorations shown herein were made between 6/30/05 and 7/14/05 by the Agency.
- Soil and rock classifications, properties and descriptions are based on engineering interpretation from available subsurface information by the Agency and may not necessarily reflect actual variations in subsurface conditions that may be encountered between individual boring or sample locations.
- Observed water levels and/or conditions indicated are as recorded at the time of exploration and may vary according to the prevailing rainfall, methods of exploration and other factors.
- Engineering judgement was exercised in preparing the subsurface information presented herein. Analysis and interpretation of subsurface data was performed and interpreted for Agency design and estimating purposes. Presentation of the information in the Contract is intended to provide the Contractor access to the same data available to the Agency. The subsurface information is presented in good faith and is not intended as a substitute for personal investigation, independent interpretation, independent analysis or judgement by the Contractor.
- Pictorial structure details shown on the boring plan layout or soils profile are for illustrative purposes only and may not accurately portray final contract details.
- Terminology used on boring logs to describe the hardness, degree of weathering, and spacing of fractures, joints and other discontinuities in the bedrock is defined in the AASHTO Manual on Subsurface Investigations, 1988.

**BORING CHART**

HOLE NUMBER	STATION	OFFSET	GROUND ELEVATION
#1	17+79.00	40.25 RT	1246.4
#2	17+94.37	37.00 LT	1247.81

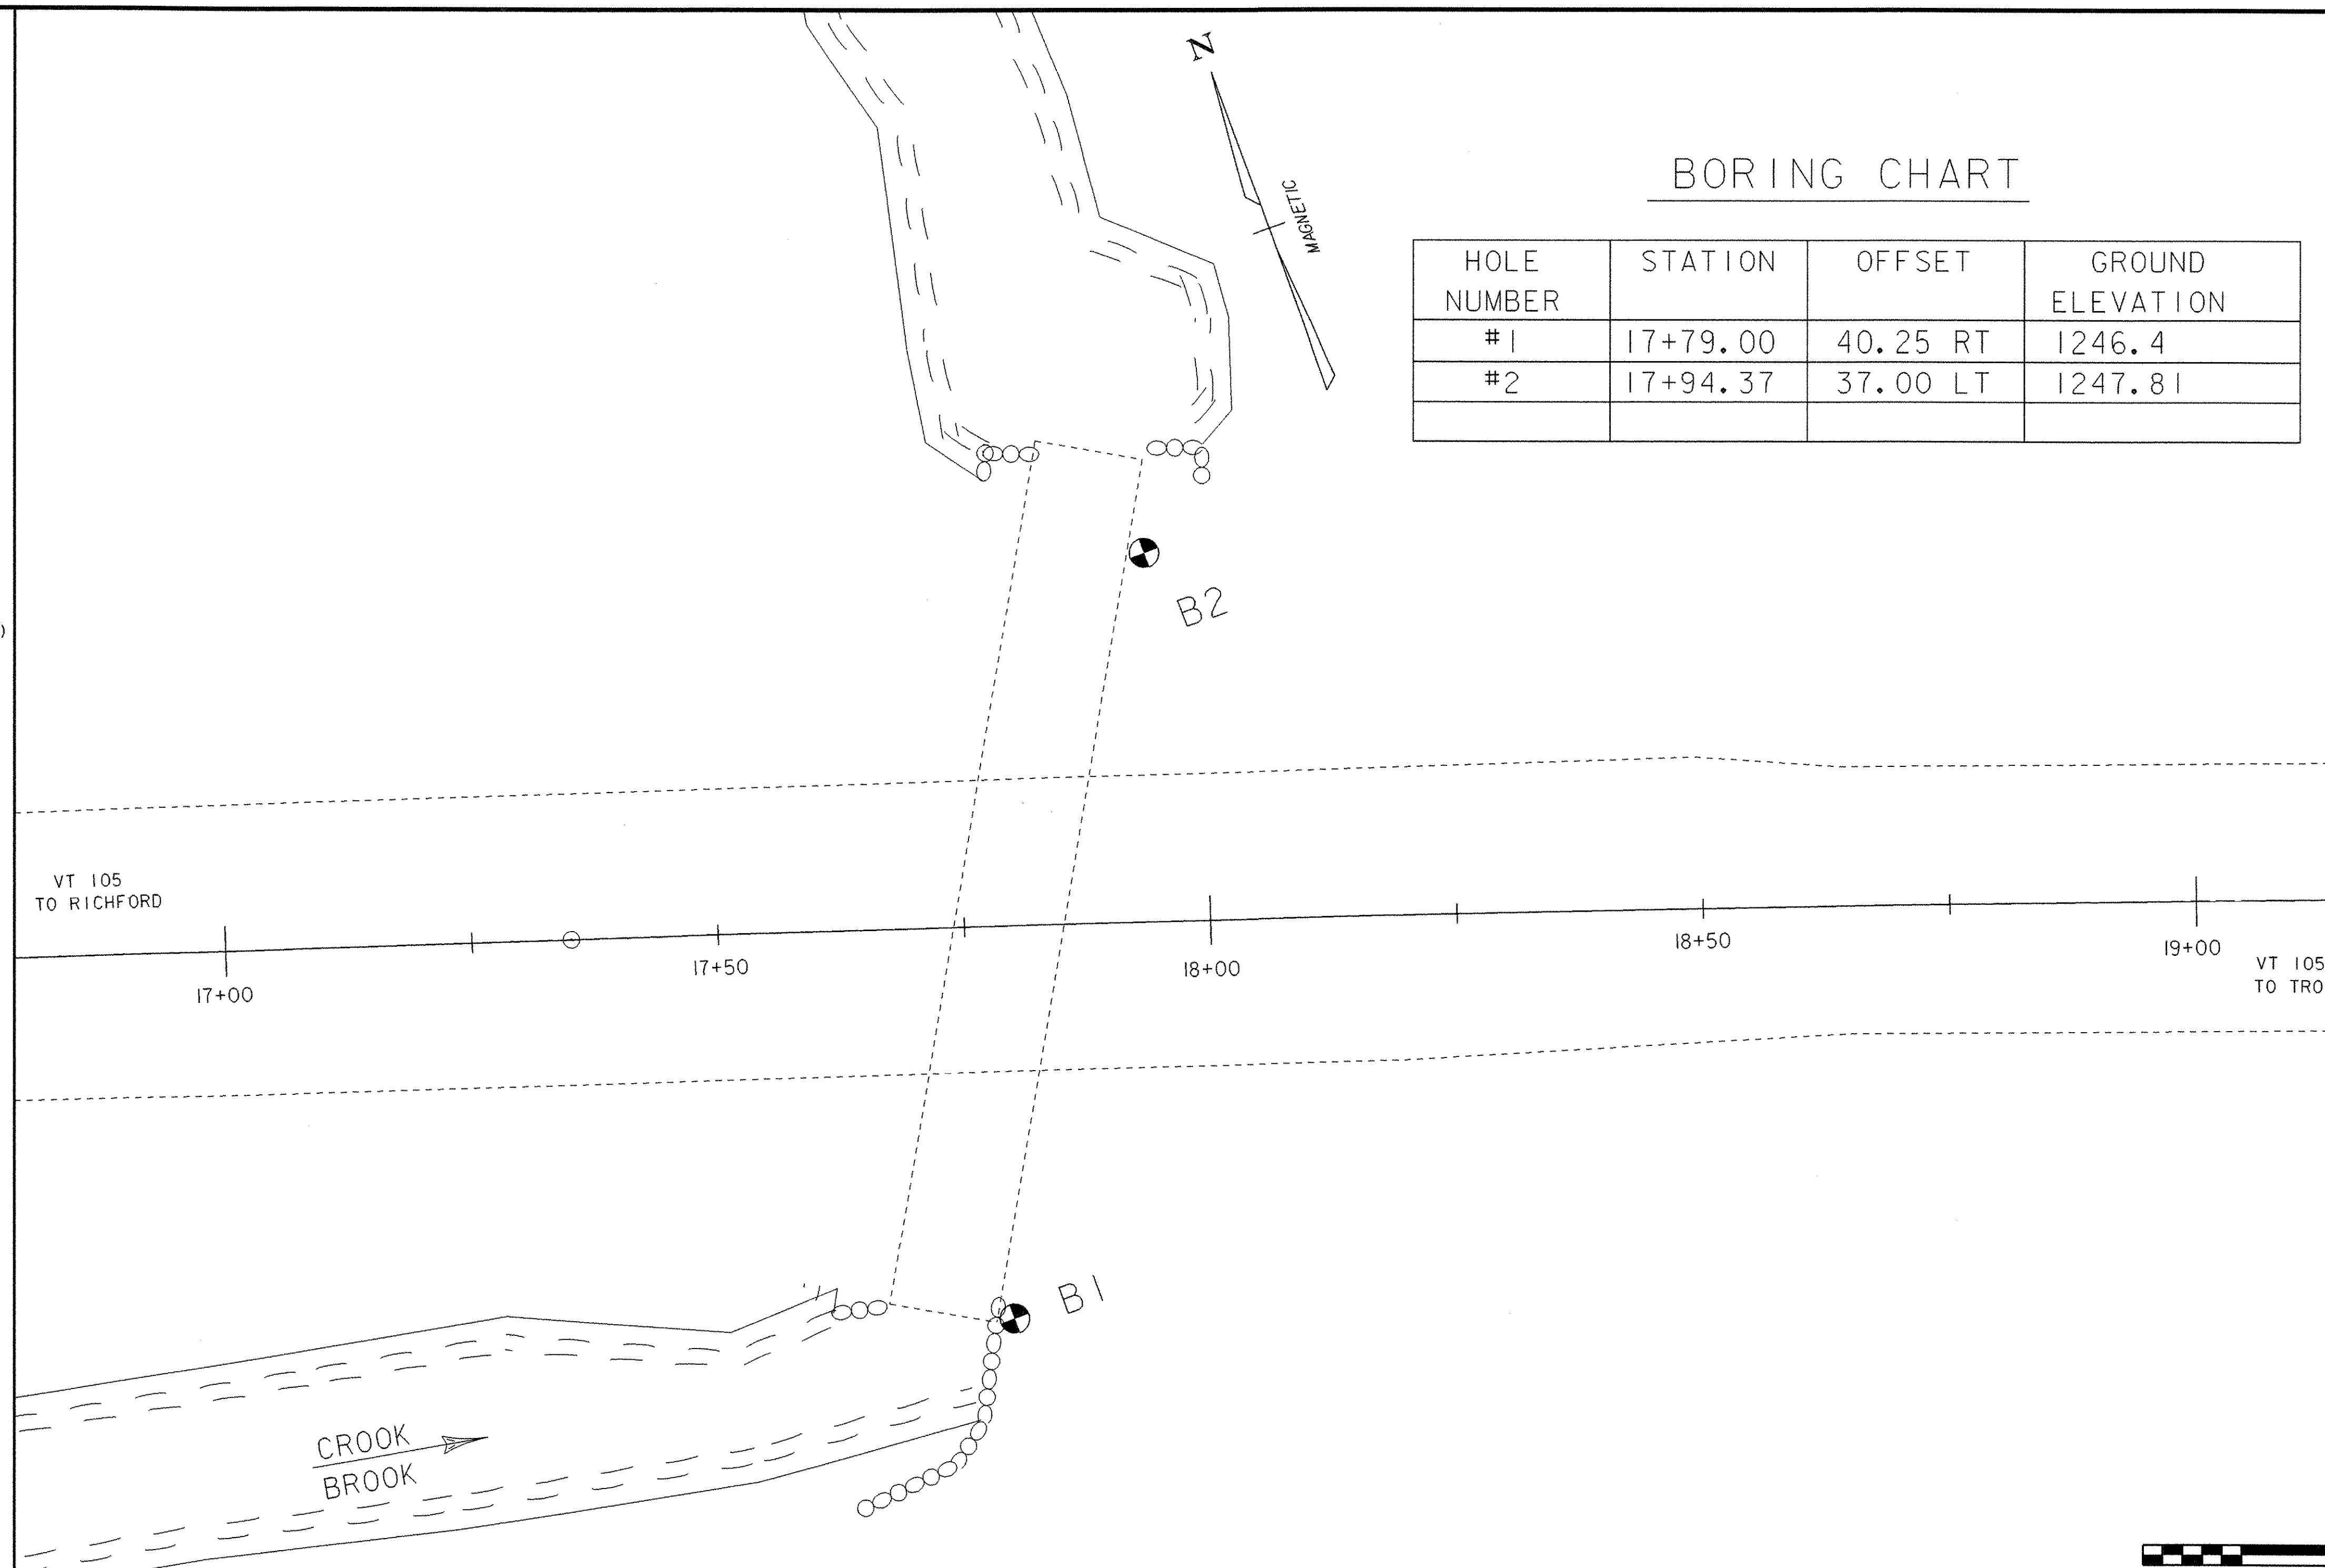

0 10 20  
SCALE IN FEET

**STATE OF VERMONT  
AGENCY OF TRANSPORTATION**

Town Of	JAY	Bridge No.	50
Highway No.	VT 105	Log Sta.	
		Surv. Sta.	



**BORING INFORMATION SHEET**

Designed By	T. FILLBACH	Drawn By	G. SHANGRAW
Checked By	T. SUMNER	Bridge Design Supervisor	W. SYMONDS
		Date	

PROJECT	JAY	PROJECT NO.	ST STP CULV (2)
---------	-----	-------------	-----------------

I.G.C. Info.		Bridge Sheet No.	Sheet 28 of 39
--------------	--	------------------	----------------

s04b140bor. i

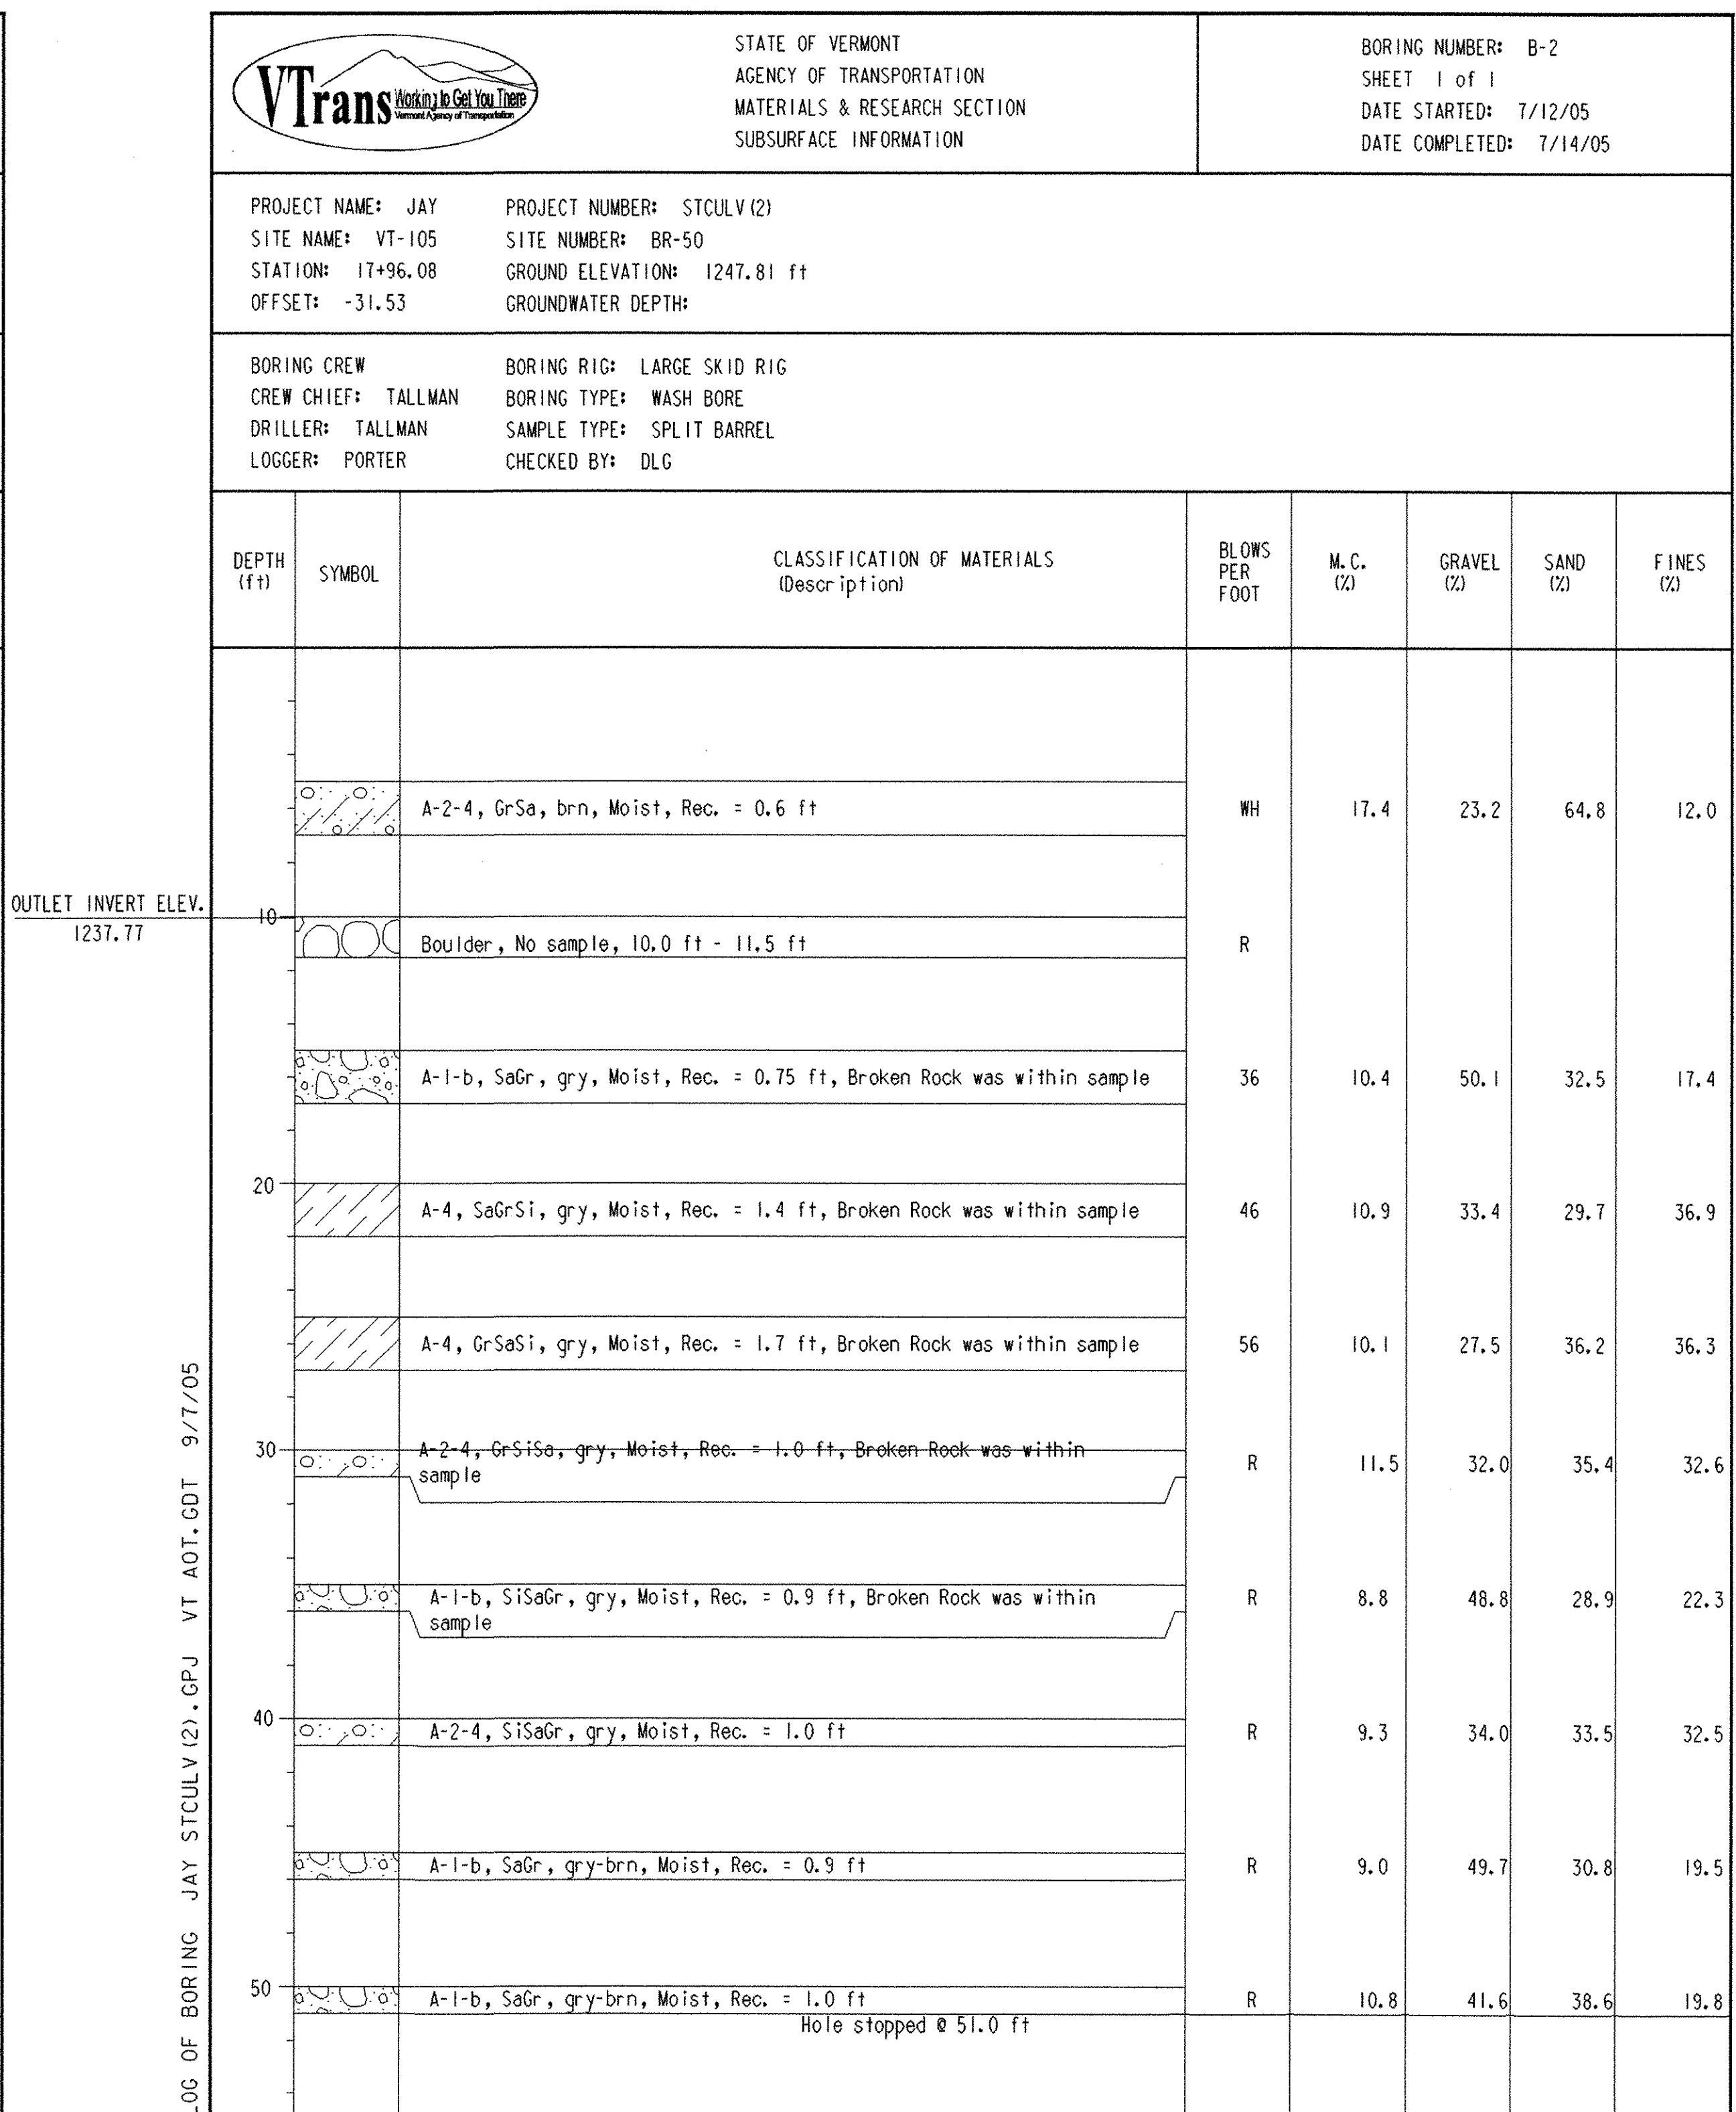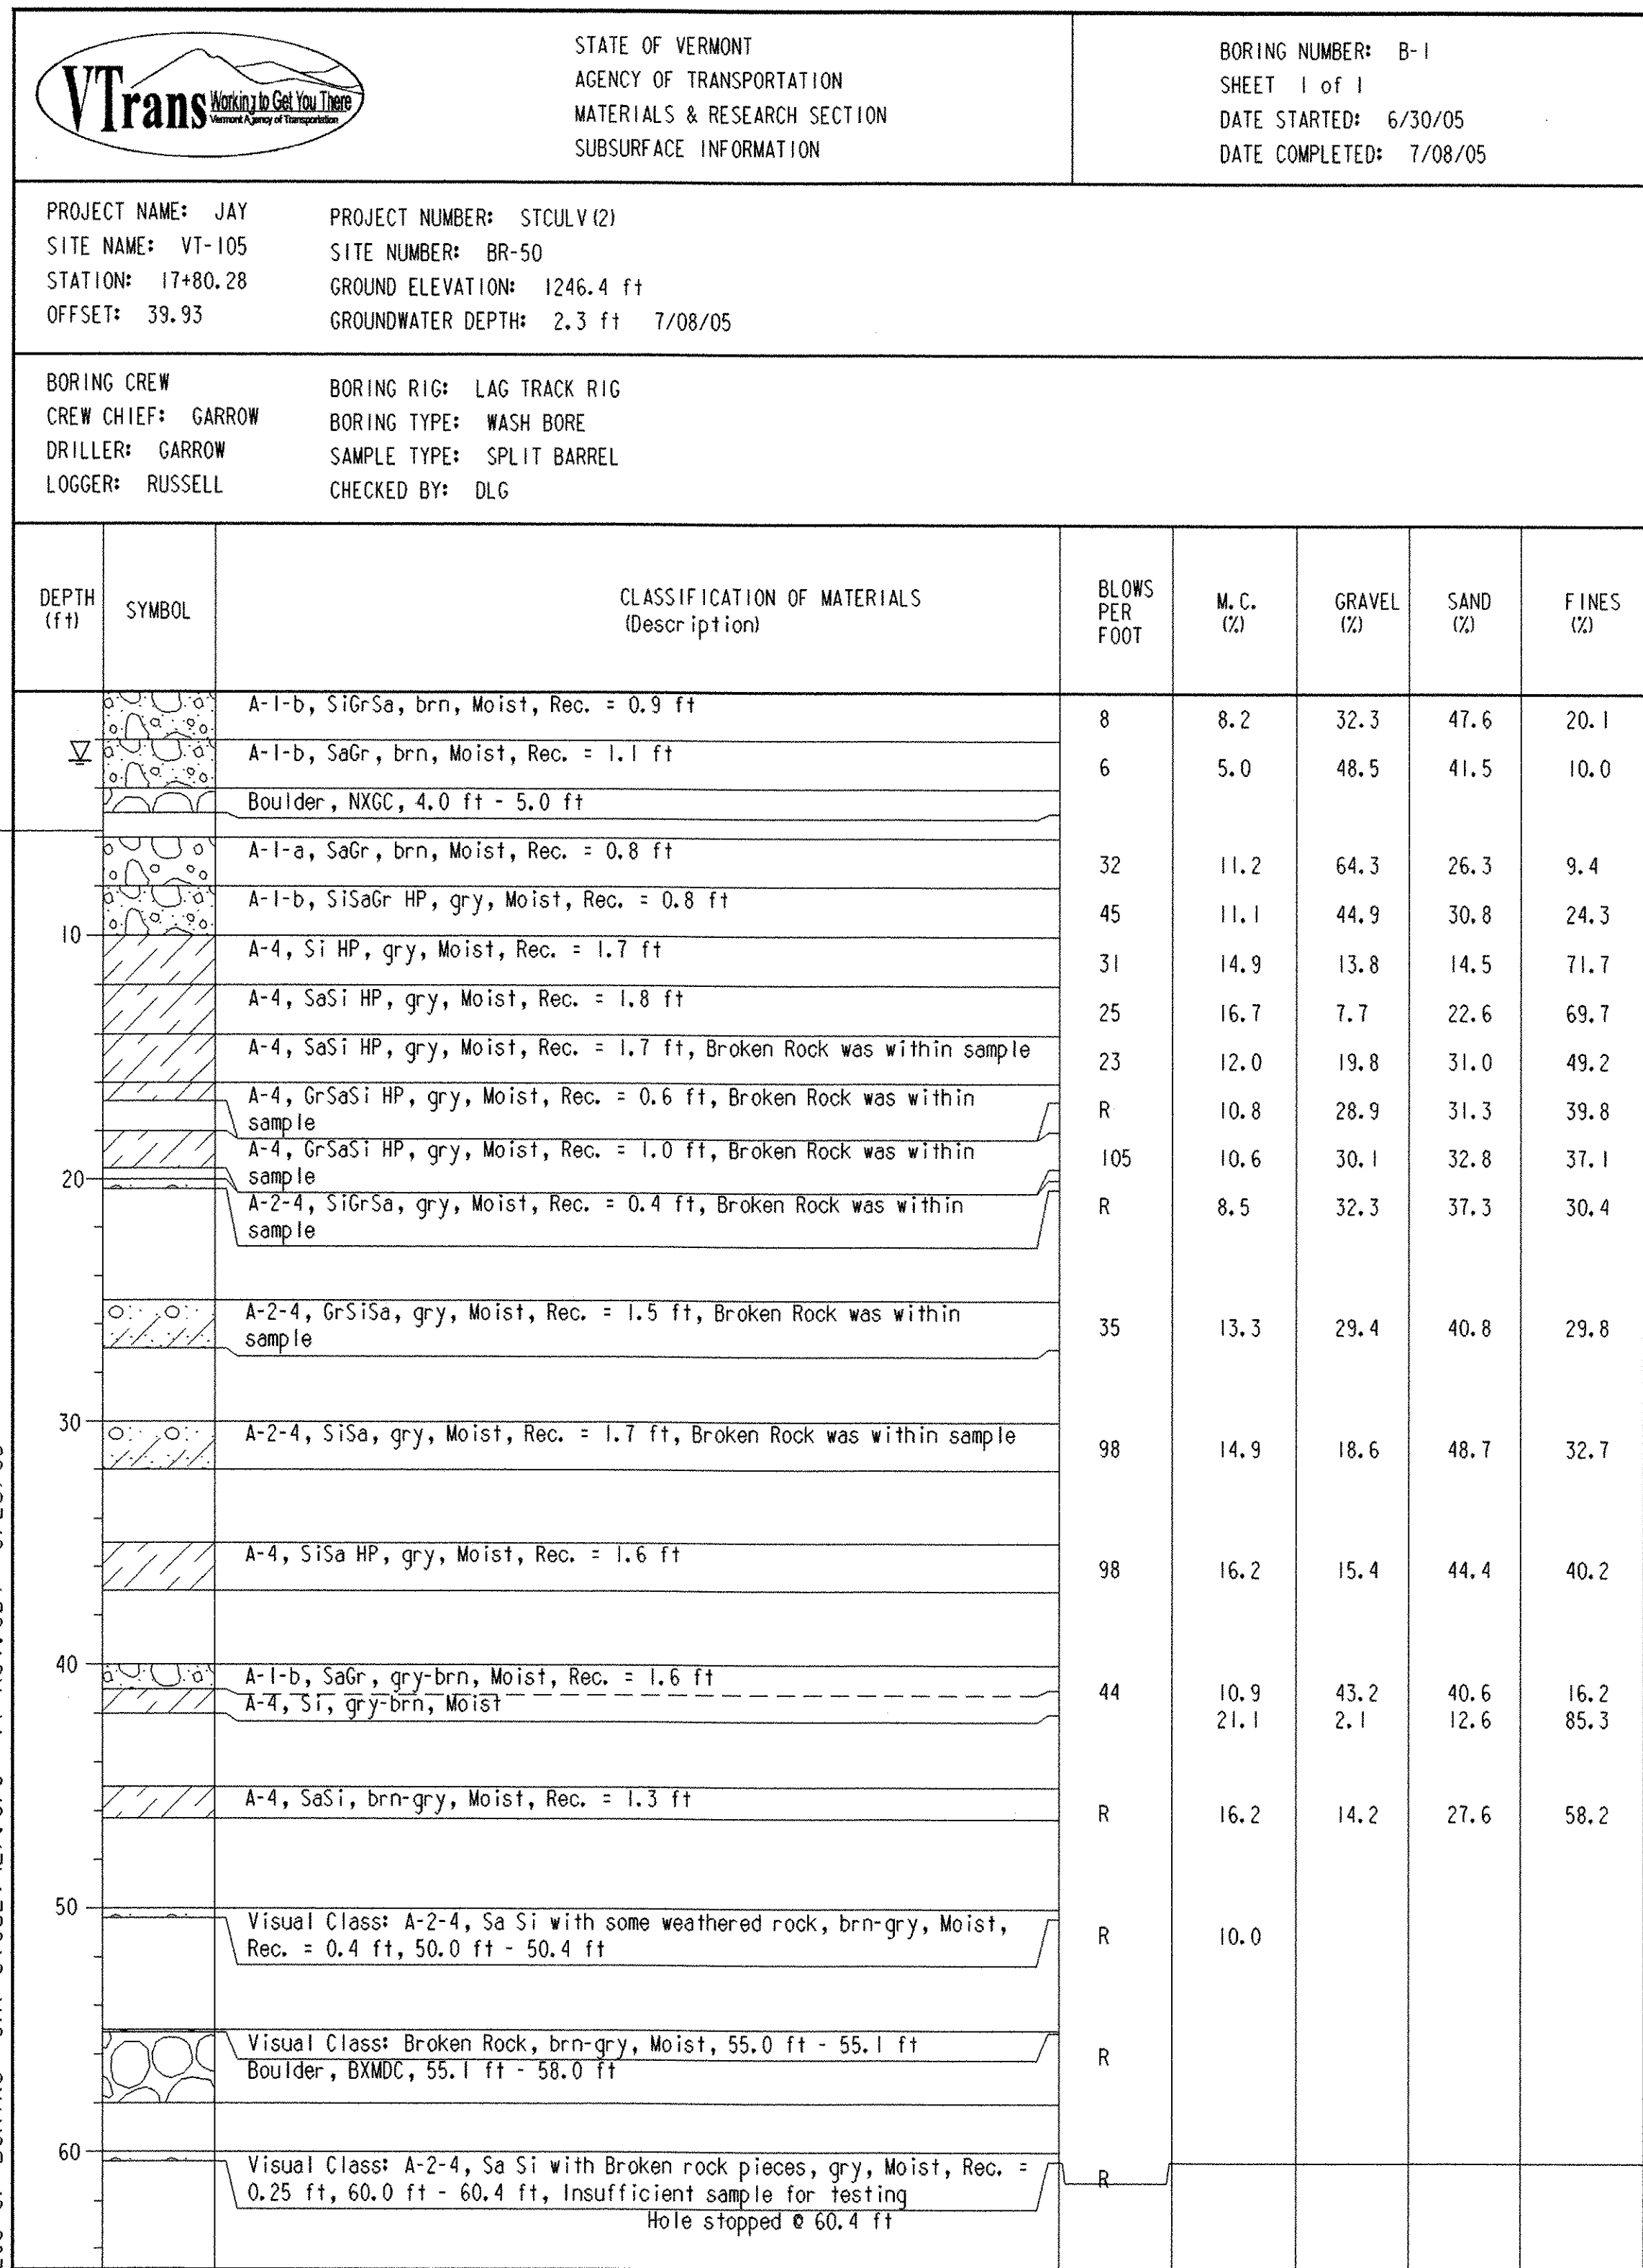

## BORING LOGS

PROJECT NAME: JAY	
PROJECT NUMBER: ST STP CULV (2)	
FILE NAME: 04b140/s04b140bor.dgn	PLOT DATE: 23-OCT-2006
PROJECT LEADER: W. SYMONDS	DRAWN BY: G. SHANGRAW
DESIGNED BY: T. FILLBACH	CHECKED BY: T. SUMNER
s04b140borlogs.i	SHEET 29 OF 39

# GENERAL NOTES

## GENERAL

1. ALL MATERIALS AND CONSTRUCTION SHALL CONFORM TO THE AGENCY OF TRANSPORTATION'S STANDARD SPECIFICATIONS FOR CONSTRUCTION, DATED 2006, AND ITS LATEST REVISIONS, AND THE AASHTO STANDARD SPECIFICATIONS FOR HIGHWAY BRIDGES, SEVENTEENTH (17<sup>TH</sup>) EDITION, AND ITS LATEST REVISIONS.
2. IN-STREAM CONSTRUCTION SHALL BE RESTRICTED TO JUNE 1 TO OCTOBER 1 UNLESS THE CONTRACTOR OBTAINS WRITTEN PERMISSION FROM THE AGENCY OF NATURAL RESOURCES TO DO WORK OUTSIDE OF THAT TIME FRAME.
3. ALL DIMENSIONS ARE HORIZONTAL OR VERTICAL AND ARE GIVEN AT 68 DEGREES F UNLESS OTHERWISE NOTED.
4. ITEM 404.65 EMULSIFIED ASPHALT IS TO BE APPLIED AT A RATE OF .015 GAL/SY BETWEEN SUCCESSIVE COURSES OF PAYMENT OR AS DIRECTED BY THE ENGINEER.
5. ITEM 900.625 SPECIAL PROVISION (WATER REPELLENT, SILANE) SHALL BE APPLIED TO ALL EXPOSED SURFACES OF THE WINGWALLS AND HEADWALLS. WATER REPELLENT, SILANE SHALL BE APPLIED TO THE EXPOSED INSIDE SURFACE OF THE BOX STARTING AT THE OPENING AT EACH END AND EXTENDING 3 FEET INTO THE BOX, INCLUDING THE TOP SURFACE OF THE BOTTOM SLAB AND THE BOTTOM SURFACE OF THE TOP SLAB.
6. ITEM 529.15 "REMOVAL OF STRUCTURE" SHALL BE USED FOR REMOVAL OF THE PIPE AND ANY PORTIONS OF THE HEADWALLS AND WINGWALLS NOT REMOVED UNDER THE ITEMS "STRUCTURE EXCAVATION" OR "UNCLASSIFIED CHANNEL EXCAVATION".
7. REINFORCING STEEL PLACEMENT TOLERANCES SHALL BE AS FOLLOWS:  
  
SPACING +/- 1"  
CLEARANCE +/- 1/4"
8. ALL EXPOSED EDGES OF CONCRETE SHALL BE CHAMFERED 1" X 1".
9. W150 x 13.5 STEEL POSTS AND OFFEST BLOCKS SHALL BE USED WITH HEAVY DUTY STEEL GUARDRAIL.

## TRAFFIC CONTROL


10. THE CONTRACTOR SHALL BE RESPONSIBLE FOR THE REGIONAL DETOUR PACKAGE AS SHOWN IN THE PLANS.
11. THE CONTRACTOR SHALL BE RESPONSIBLE FOR SUPPLYING THE LOCAL TRAFFIC CONTROL PACKAGE IDENTIFYING THE CONSTRUCTION PROJECT BEFORE, DURING, AND AFTER THE BRIDGE CLOSURE PERIOD. THE CONTRACTOR SHALL SUBMIT A DETAILED TRAFFIC CONTROL PLAN TO THE RESIDENT ENGINEER FOR ALL STAGES OF CONSTRUCTION. ALL COSTS SHALL BE INCLUDED IN ITEM 641.10, TRAFFIC CONTROL.
12. ACCESS TO ALL EXISTING DRIVES SHALL BE MAINTAINED AT ALL TIMES DURING ALL PHASES OF CONSTRUCTION.
13. INSTALLATION OF DETOUR SIGNS SHALL NOT BLOCK ANY EXISTING TRAFFIC CONTROL SIGN ASSEMBLIES. THE CONTRACTOR SHALL TRY TO MAINTAIN AT LEAST 200 FEET BETWEEN SIGN ASSEMBLIES.
14. THE CONTRACTOR SHALL CONTACT DIG SAFE AT 1-888-344-7233 PRIOR TO BREAKING GROUND TO INSTALL ANY SIGN POSTS.
15. ALL SIGNS THAT ARE 36" x 36" OR LARGER SHALL BE ON TWO POSTS.

## PRECAST CONCRETE NOTES

16. DESIGN CRITERIA:
  - A. SOIL UNIT WEIGHT = 140 PCF
  - B. DESIGN LIVE LOAD = HS-25-44
  - C. MAX. WINGWALL FOOTING PRESSURE = 4 KSF
  - D. FACTOR OF SAFETY FOR SLIDING >= 2.0
  - E. FACTOR OF SAFETY FOR OVERTURNING >= 1.5
  - F. DESIGN FILL OVER BOX = 11 FEET
17. ALL CONCRETE SHALL BE PRECAST. ITEM 540.10 PRECAST CONCRETE STRUCTURE INCLUDES ALL BOX SEGMENTS, HEADWALLS, AND WINGWALLS. ALL CONNECTIONS SHALL BE DESIGNED BY THE FABRICATOR AND SHALL BE CONSIDERED INCIDENTAL TO ITEM 540.10. ALL CONNECTIONS MUST BE SUBMITTED TO THE PROJECT MANAGER FOR APPROVAL.
18. THE PRECAST BOX SECTIONS ARE SHOWN FOR REFERENCE ONLY. THE ACTUAL DIMENSIONS AND SHAPE WILL BE DEPENDENT ON THE FABRICATOR. ALL UNITS EXCEPT THE FIRST AND LAST WILL BE THE SAME SHAPE AND THE SAME LENGTH. THE MINIMUM INSIDE DIMENSIONS SHALL BE 9'-0" IN HEIGHT AND 15'-0" IN WIDTH. THE OVERALL LENGTH OF THE BOX SHALL BE 80'-0" ALONG THE STREAMBED GRADE. THE EXPOSED ENDS OF THE FIRST AND LAST UNITS SHALL BE VERTICAL.
19. THE EXTERIOR (TOP AND SIDES) OF ALL CONCRETE BOX JOINTS ALONG WITH ALL LIFTING HOLES SHALL BE FILLED WITH MORTAR TYPE IV AFTER BEING SET IN THEIR FINAL POSITION. THIS WORK SHALL BE CONSIDERED INCIDENTAL TO ITEM 540.10.
20. A TWO (2) FOOT WIDE STRIP OF MEMBRANE WATERPROOFING SHALL BE APPLIED AT EACH BOX JOINT (TOP AND SIDES). MEMBRANE SHALL BE CENTERED ON THE JOINT AND COVER THE FULL WIDTH OF THE TOP AND FULL HEIGHT OF THE SIDES. THE SIDES SHALL BE COVERED FIRST AND THE TOP WILL FOLLOW. ANY OVERLAPPING OF MEMBRANE SHALL BE DONE IN A SHINGLE TYPE STYLE TO SHED WATER AND SHALL OVERLAP A MINIMUM OF ONE FOOT. PAYMENT FOR MEMBRANE SHALL BE UNDER ITEM 519.21 SHEET MEMBRANE WATERPROOFING, PREFORMED SHEET.
21. THE STRUCTURE WILL BE AT A 4.33% GRADE SIMULATING THAT OF THE STREAM.

## GENERAL NOTES

PROJECT NAME:	JAY
PROJECT NUMBER:	ST STP CULV (2)
FILE NAME: 04b140\04b140xc1.dgn	PLOT DATE: 23-OCT-2006
PROJECT LEADER: W. SYMONDS	DRAWN BY: T. FILLBACH
DESIGNED BY: T. FILLBACH	CHECKED BY: T. SUMNER
GENERAL NOTES SHEET	SHEET 30 OF 39

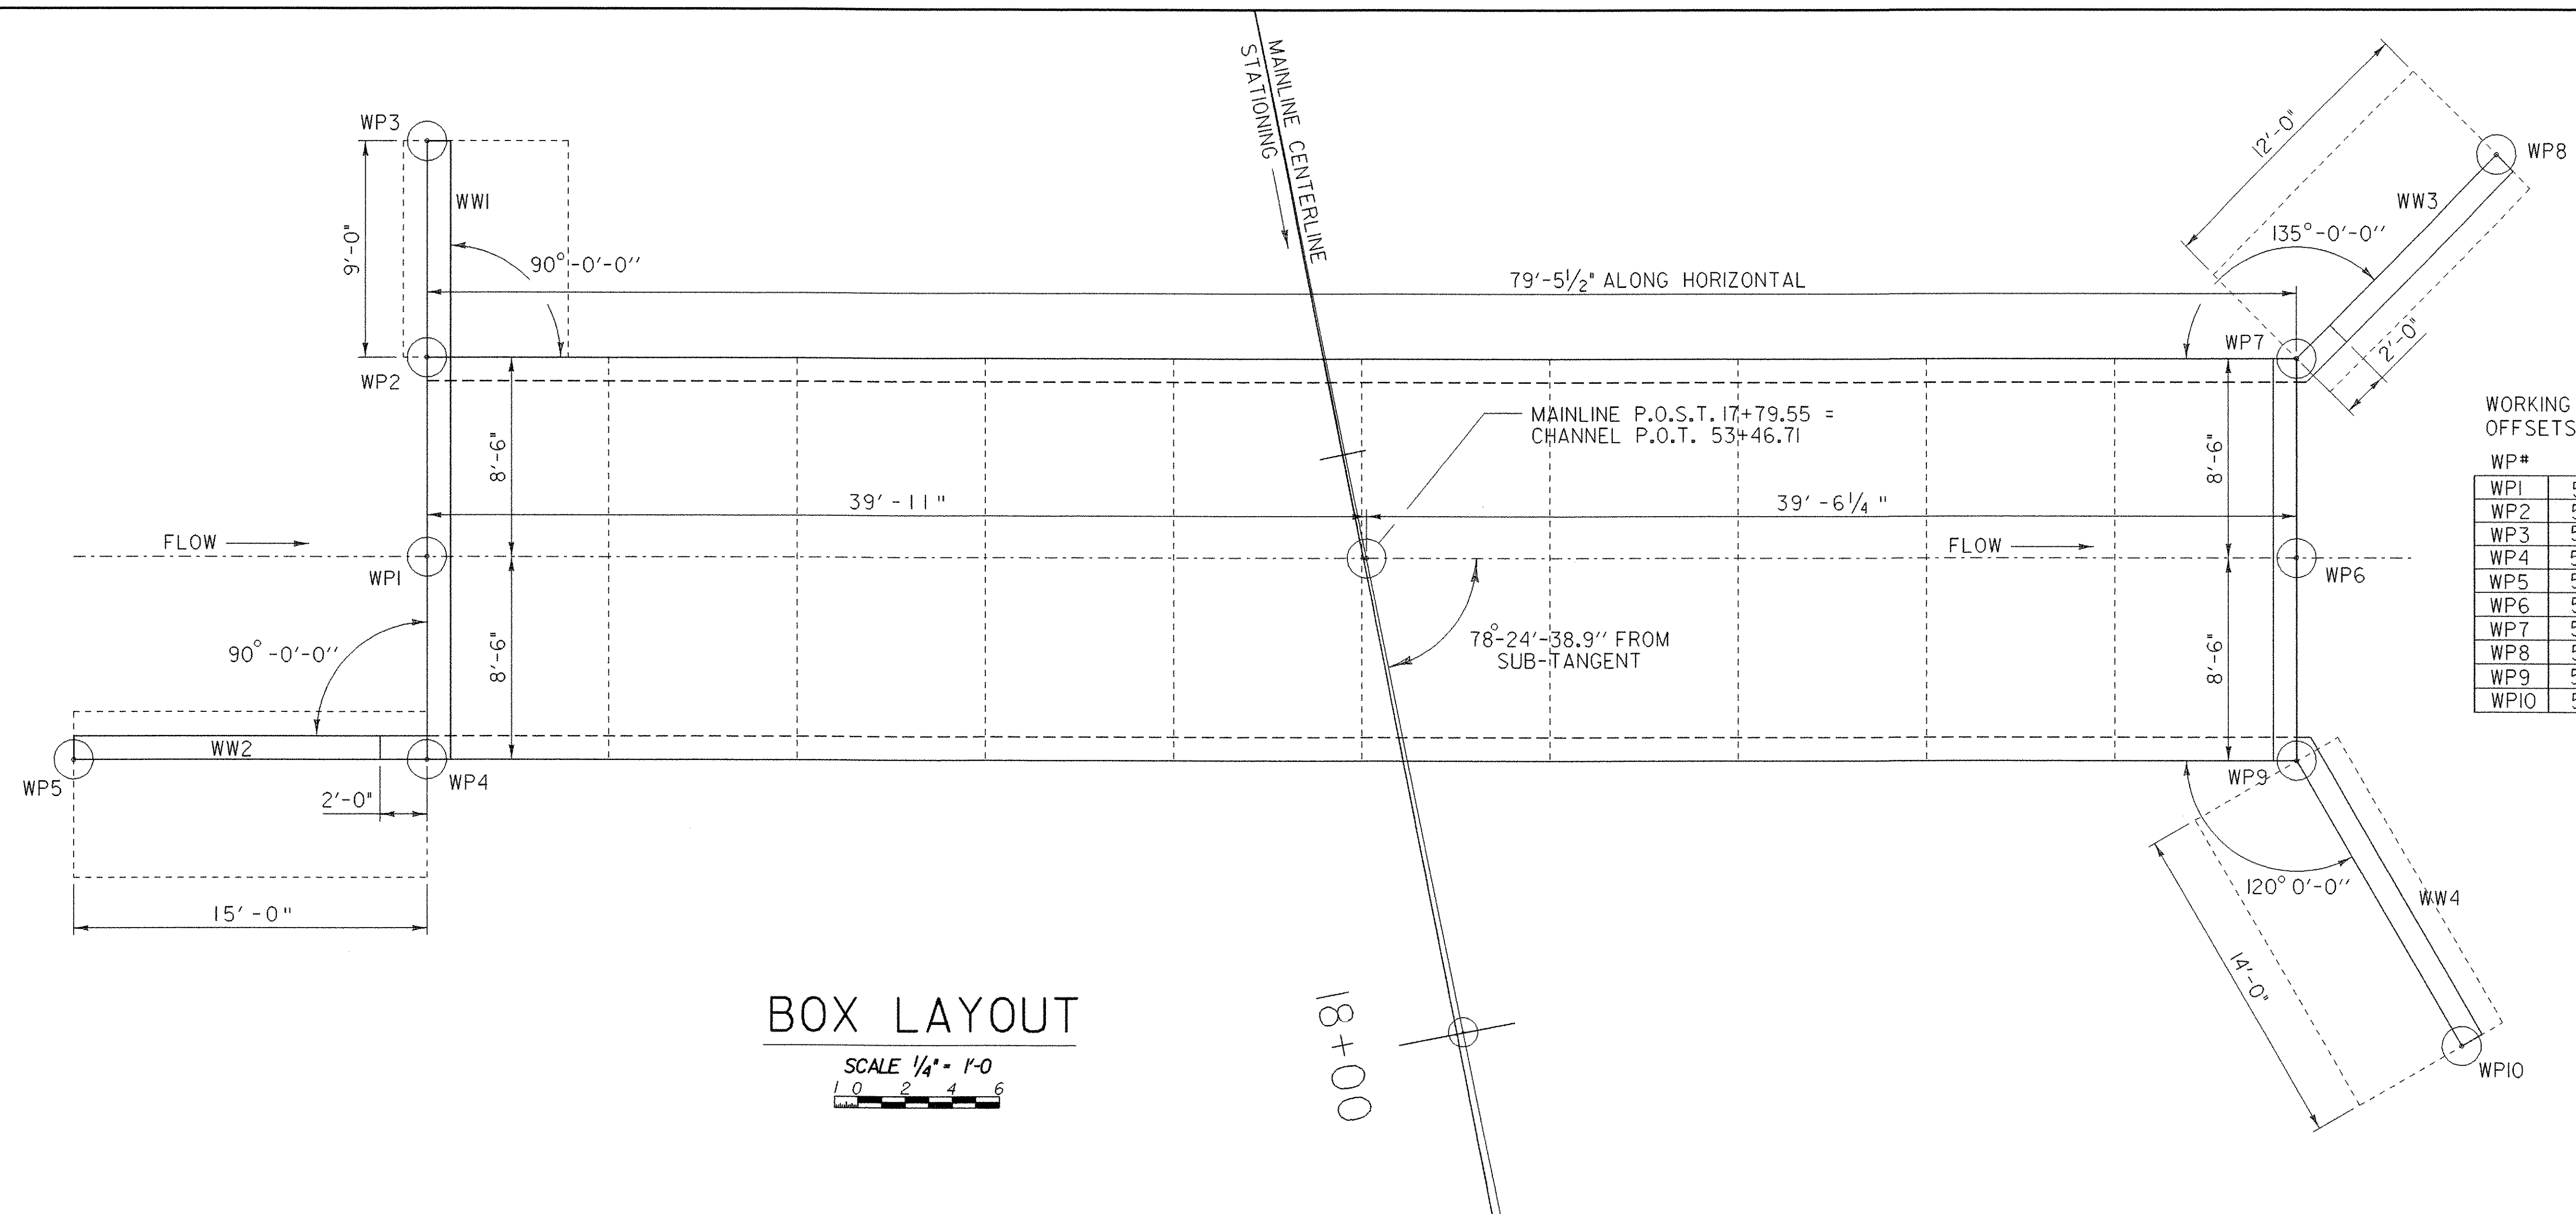


WORKING POINTS STATIONS & OFFSETS FROM CHANNEL LINE

WP#	STATION	OFFSET
WP1	53+06.78	20.02 LT.
WP2	53+06.78	28.52 LT.
WP3	53+06.78	37.52 LT.
WP4	53+06.78	11.52 LT.
WP5	52+91.78	11.52 LT.
WP6	53+86.23	20.02 LT.
WP7	53+86.23	28.52 LT.
WP8	53+94.71	37.00 LT.
WP9	53+86.23	11.52 LT.
WP10	53+93.23	0.61 RT.


**BOX LAYOUT**

SCALE 1/4" = 1'-0"

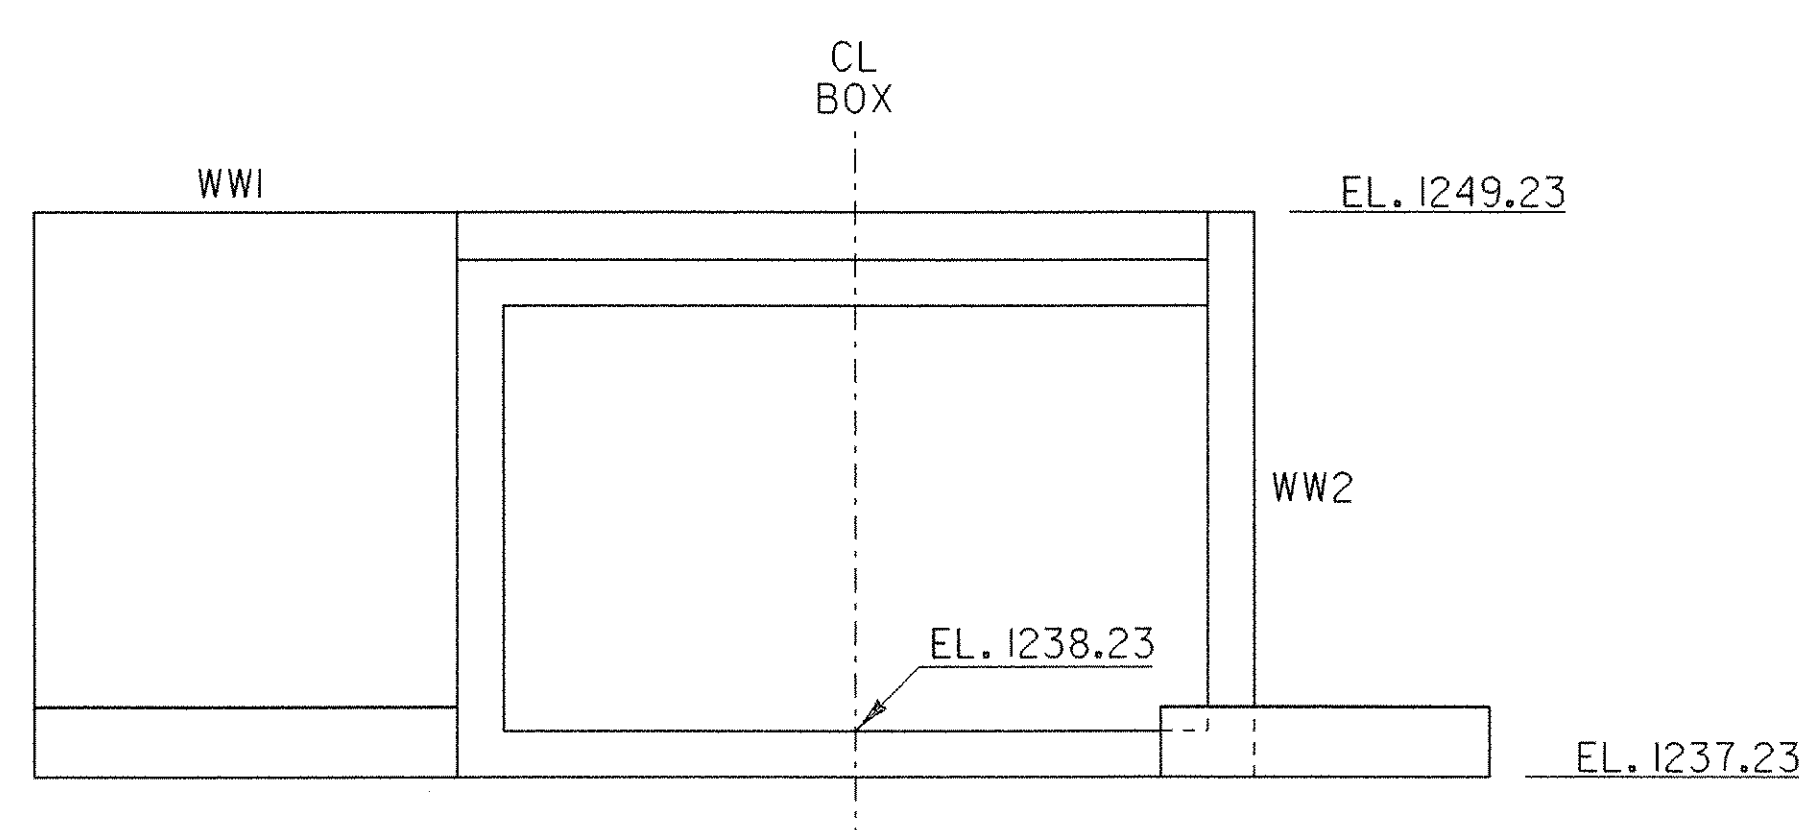

**INLET ELEVATION**

SCALE 1/4" = 1'-0"

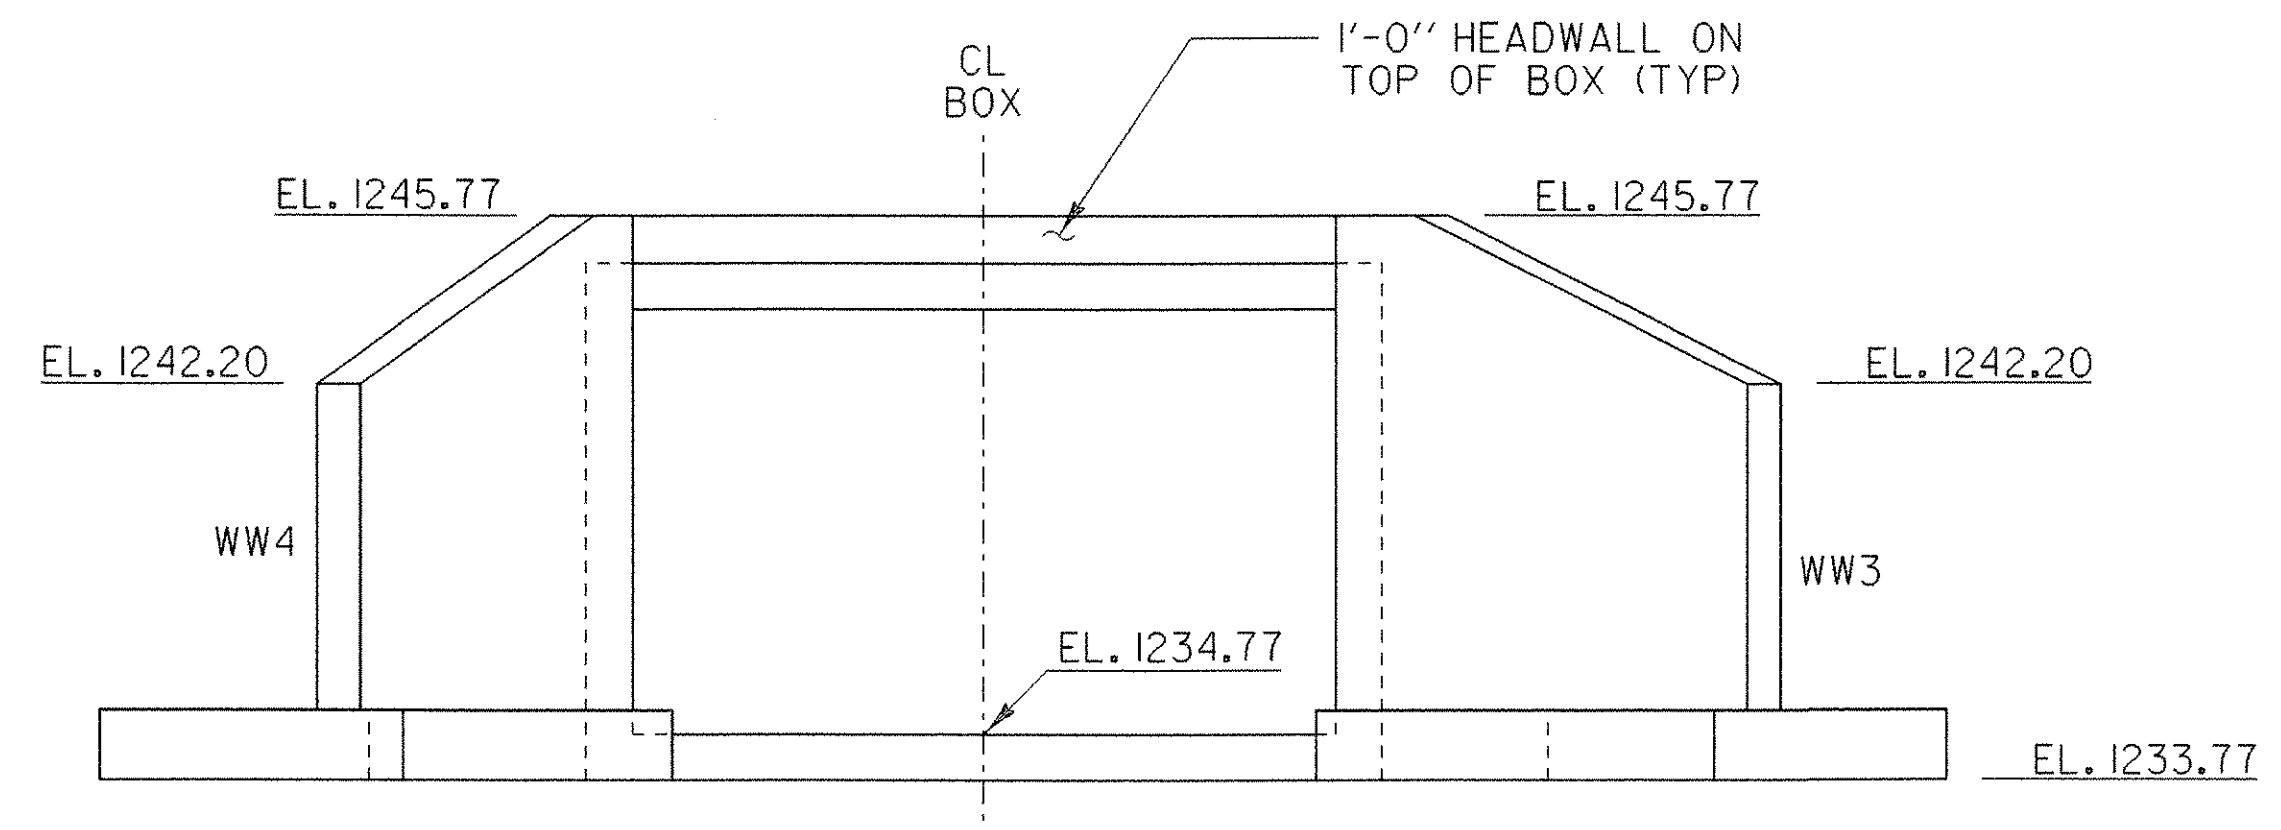

**OUTLET ELEVATION**


SCALE 1/4" = 1'-0"

NOTE: DIMENSIONS SHOWN ARE BASED ON AN ASSUMED WALL THICKNESS OF 1'-0".


**BOX LAYOUT**

PROJECT NAME: JAY  
 PROJECT NUMBER: ST STP CULV (2)  
 FILE NAME: Structures/s04b140boxplan.dgn PLOT DATE: 23-OCT-2006  
 PROJECT LEADER: W. SYMONDS DRAWN BY: G. SHANGRAW  
 DESIGNED BY: T. FILLBACH CHECKED BY: T. SUMNER  
 s04b140boxplan.i SHEET 31 OF 39




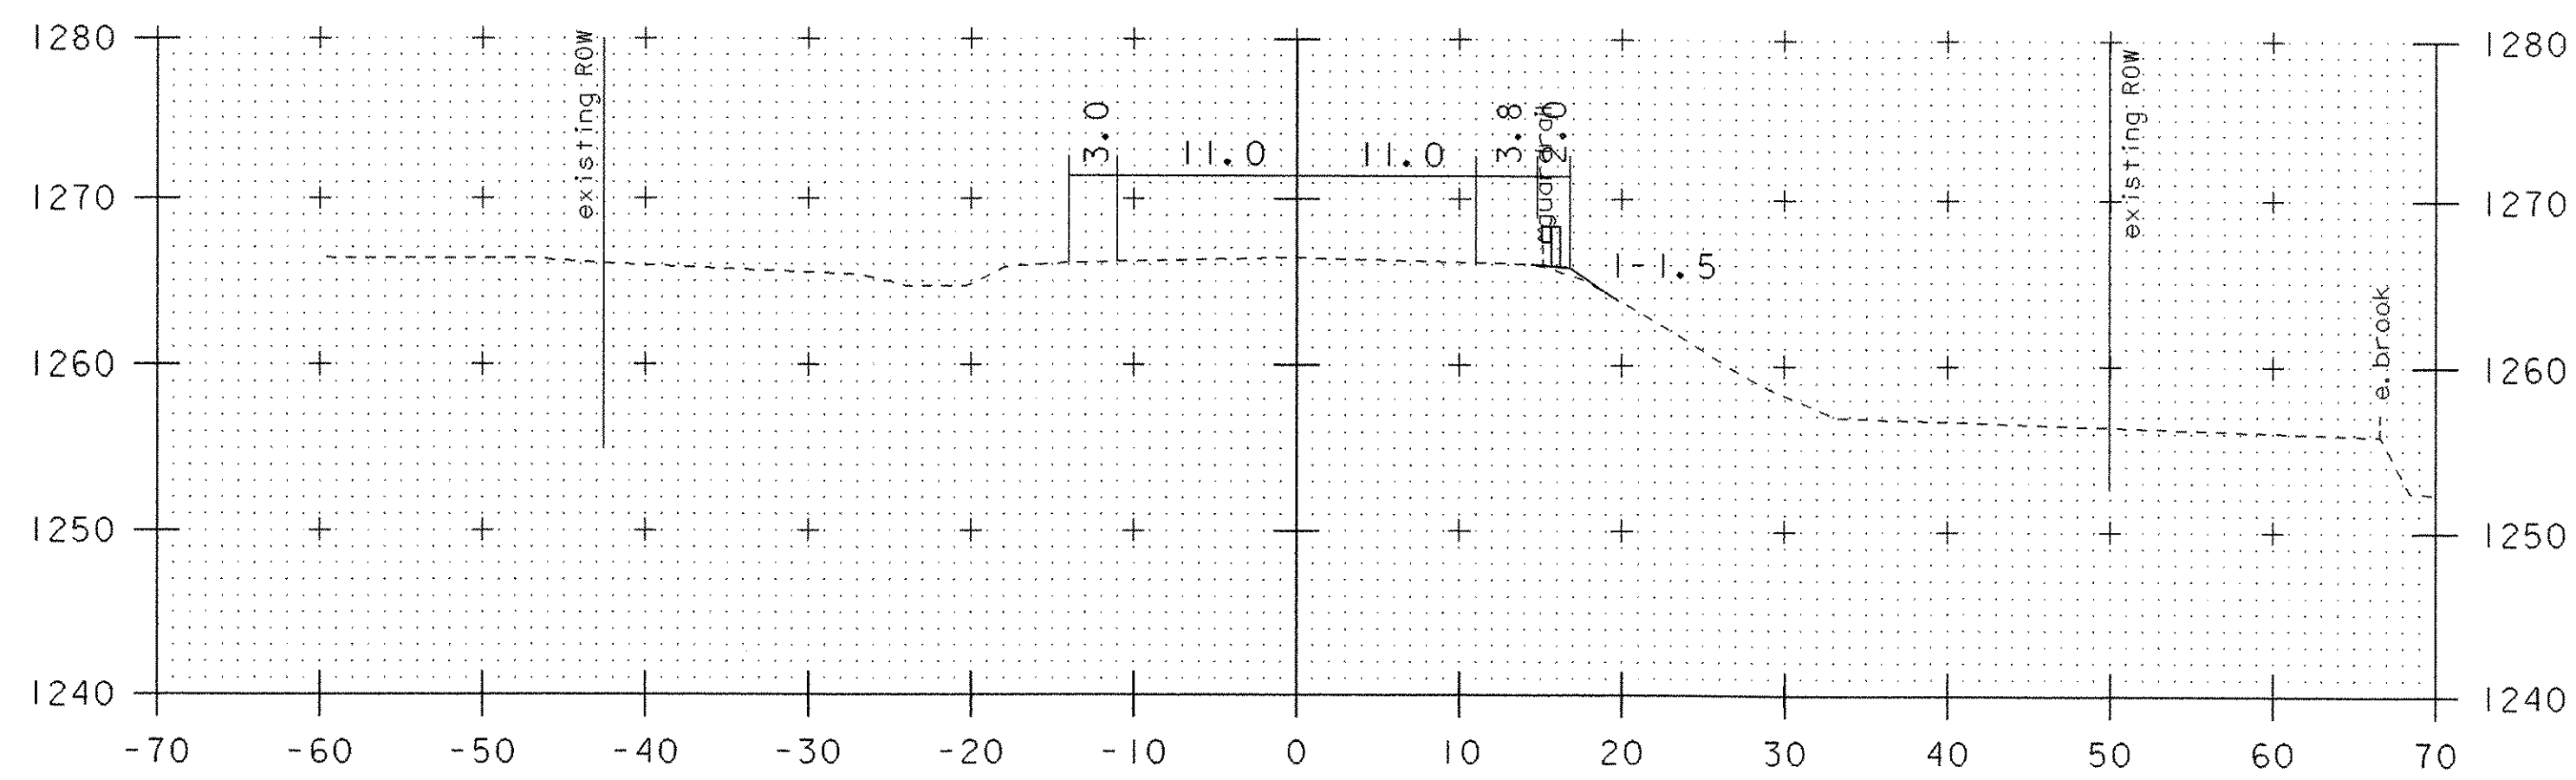


BEGIN APPROACH STA 15+87 16+00

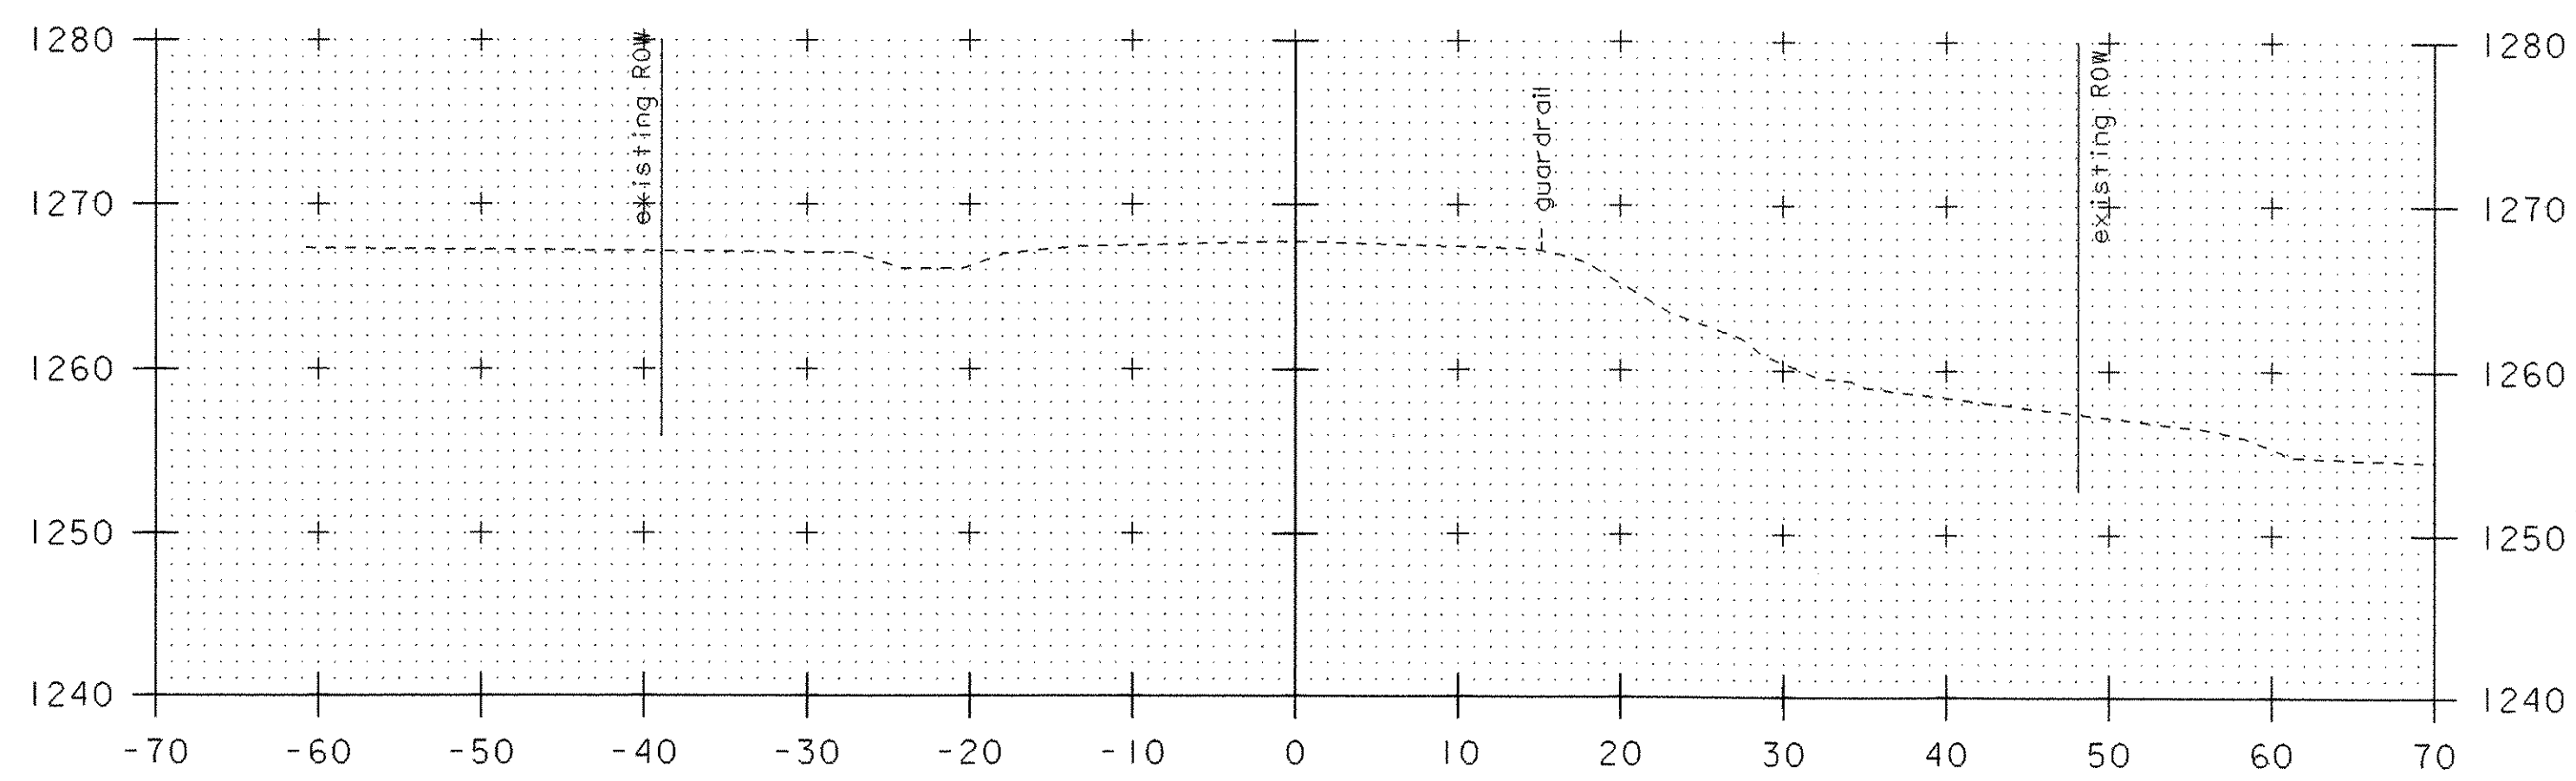


15+75

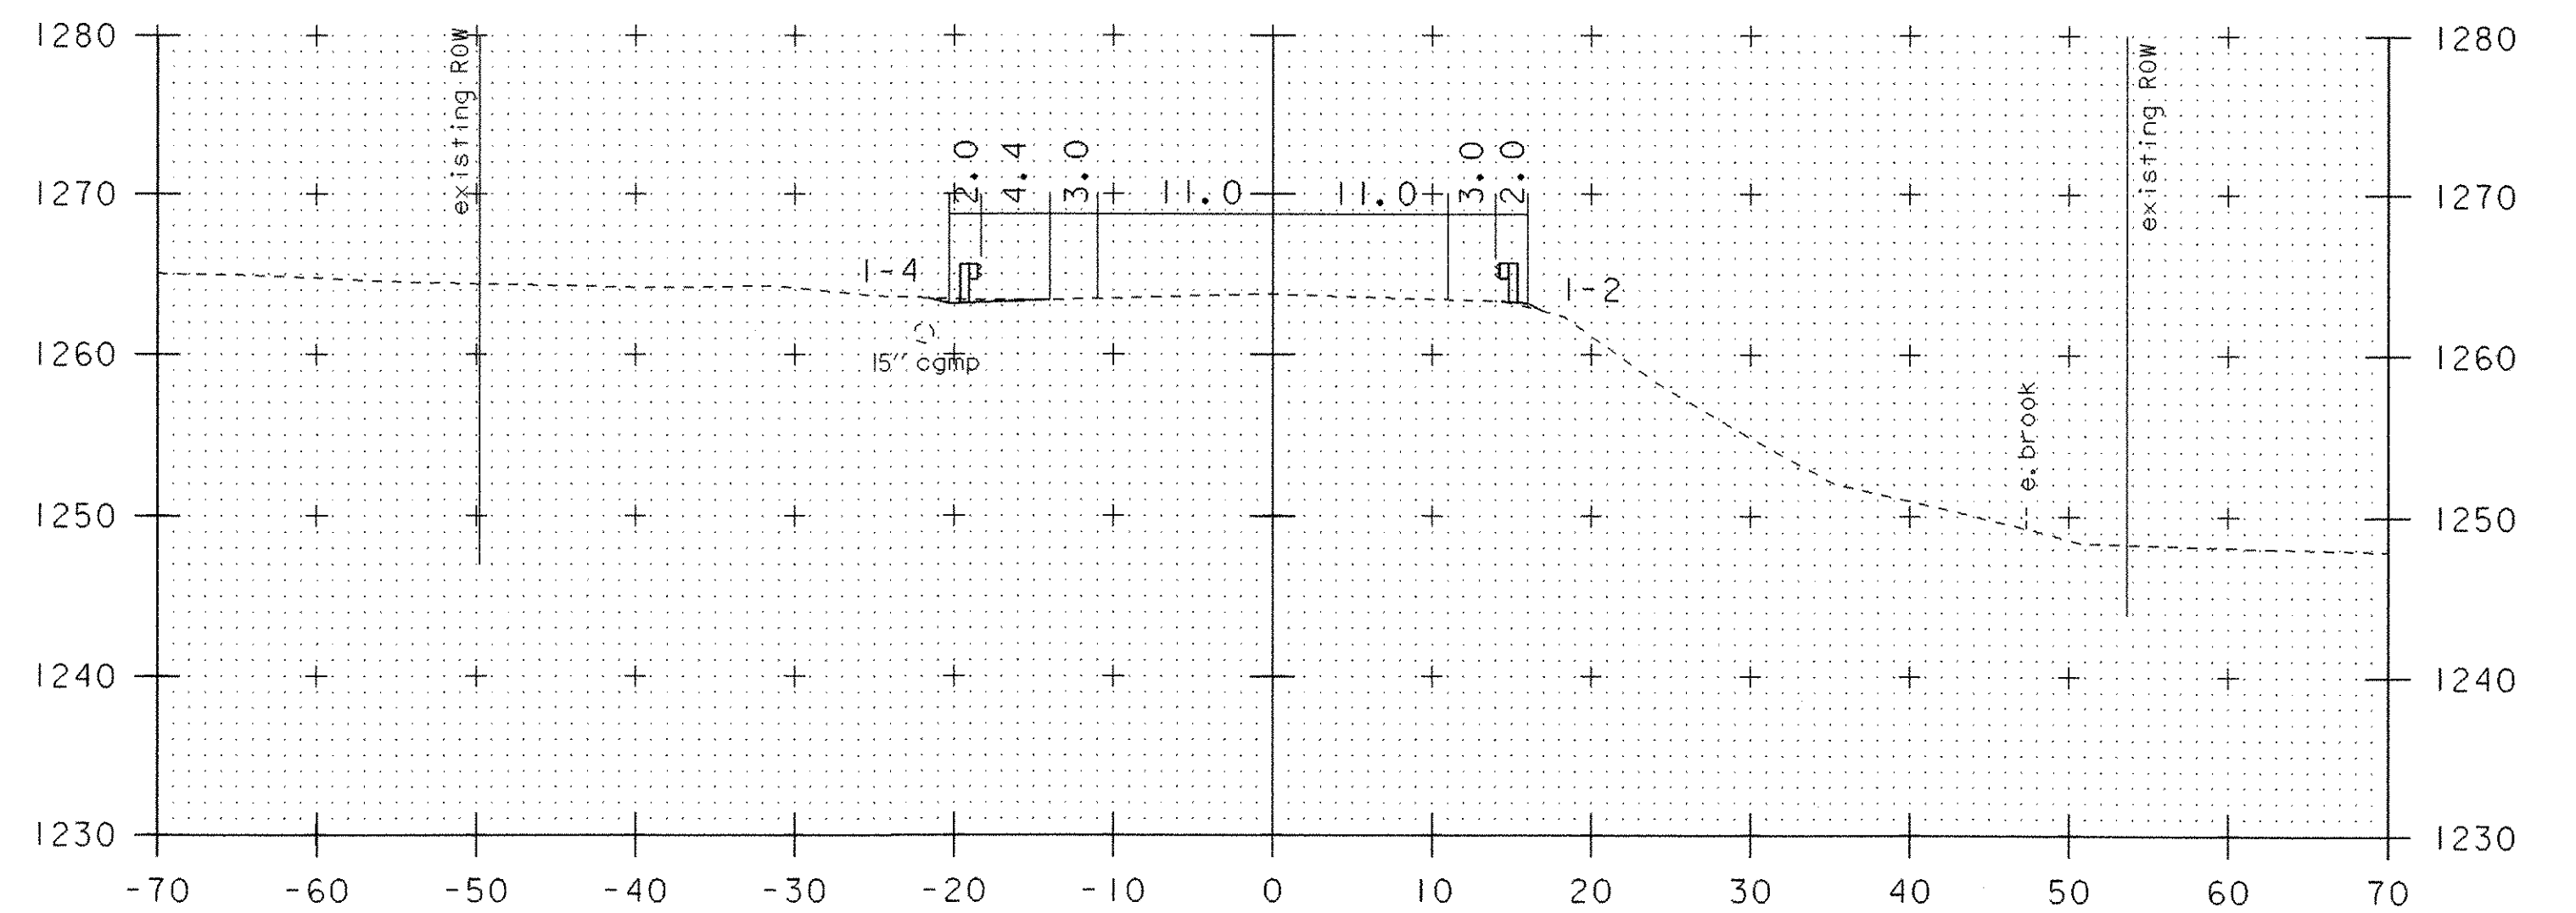

16+50

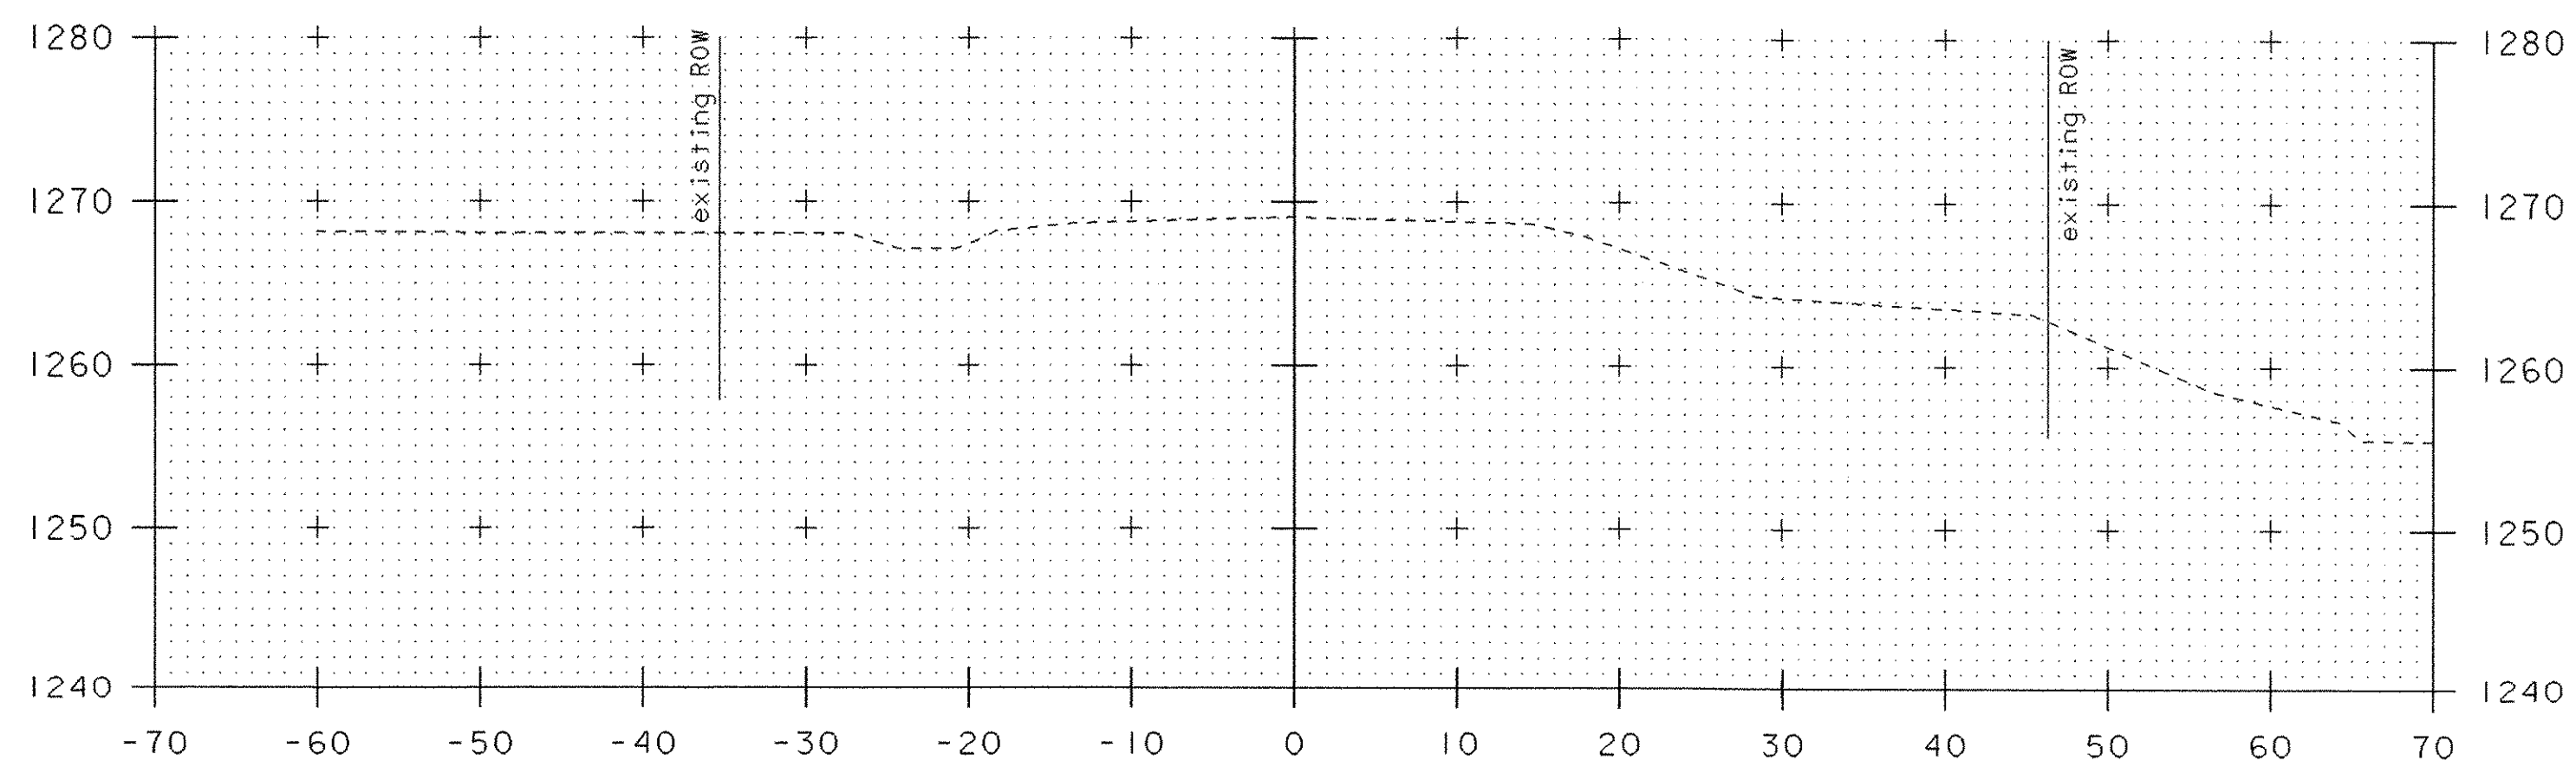


15+50

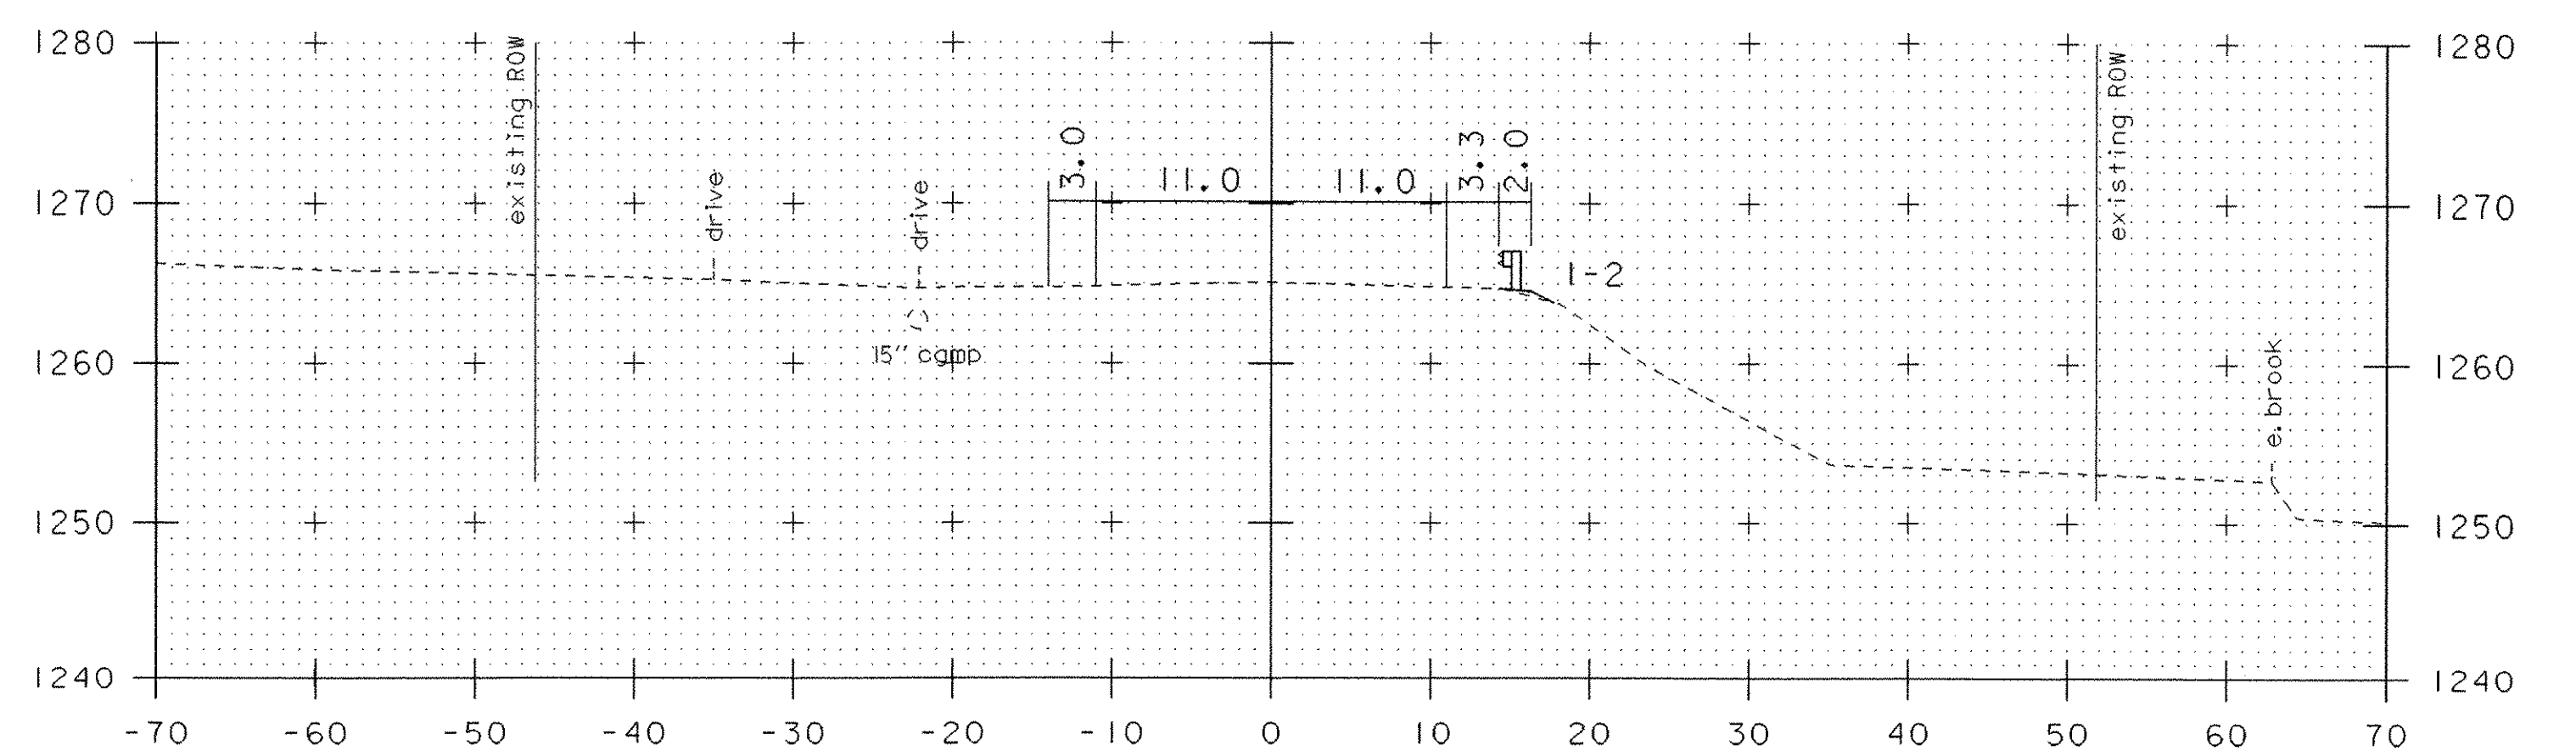


16+25

**MAINLINE CROSS SECTIONS**


PROJECT NAME:	JAY	PLOT DATE:	23-OCT-2006
PROJECT NUMBER:	ST STP CULV (2)	DRAWN BY:	G. SHANGRAW
FILE NAME:	04b140\s04b140bdr.dgn	CHECKED BY:	J. LACROIX
PROJECT LEADER:	W. SYMONDS	SHEET	33 OF 39
DESIGNED BY:	T. SUMNER		
	04b140xsl.l		

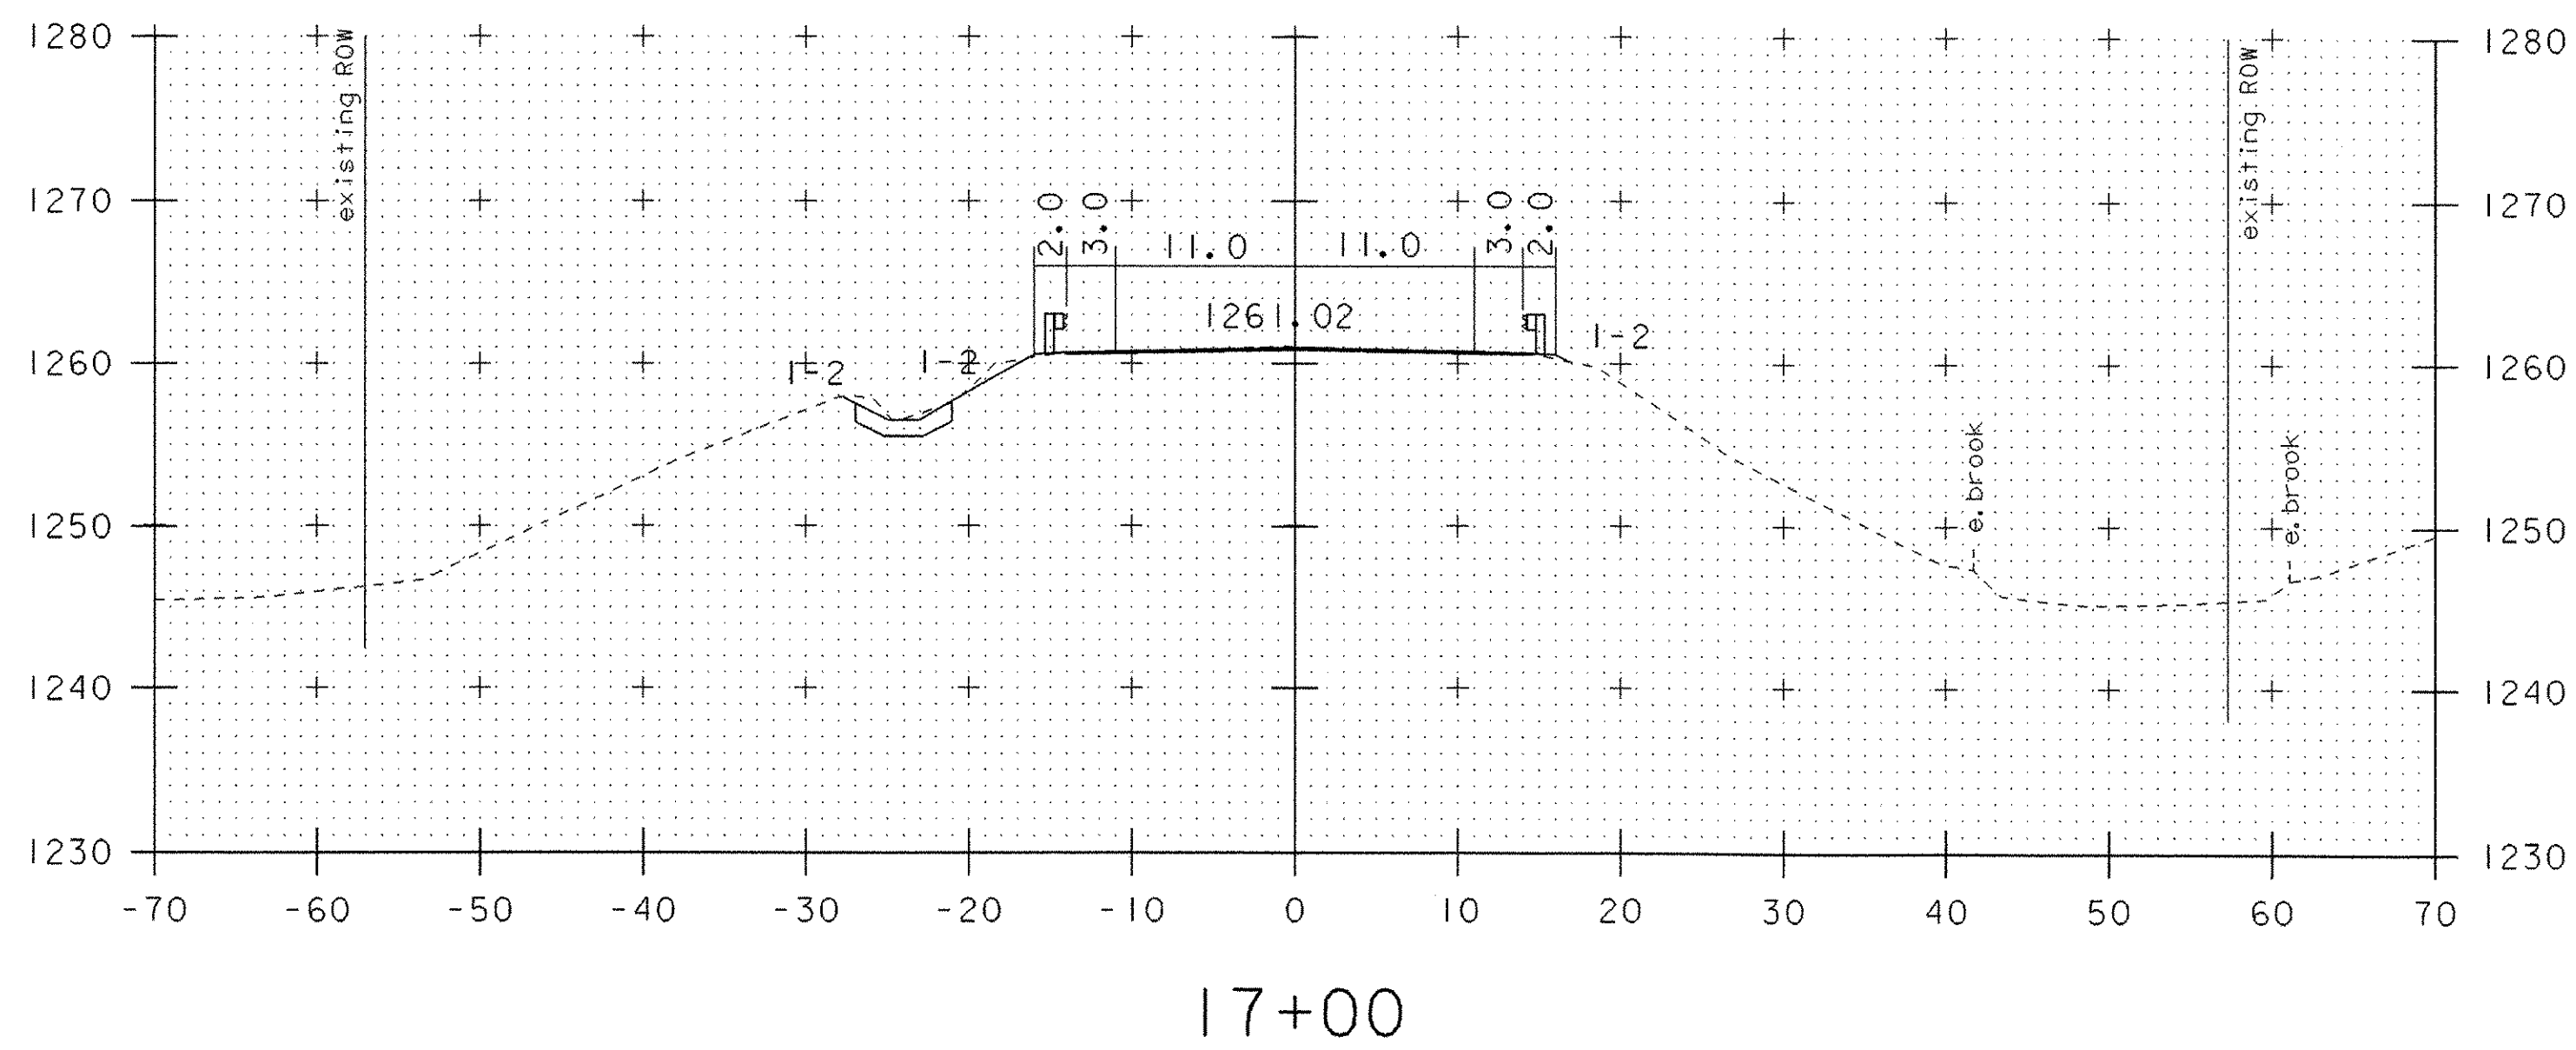


17+00

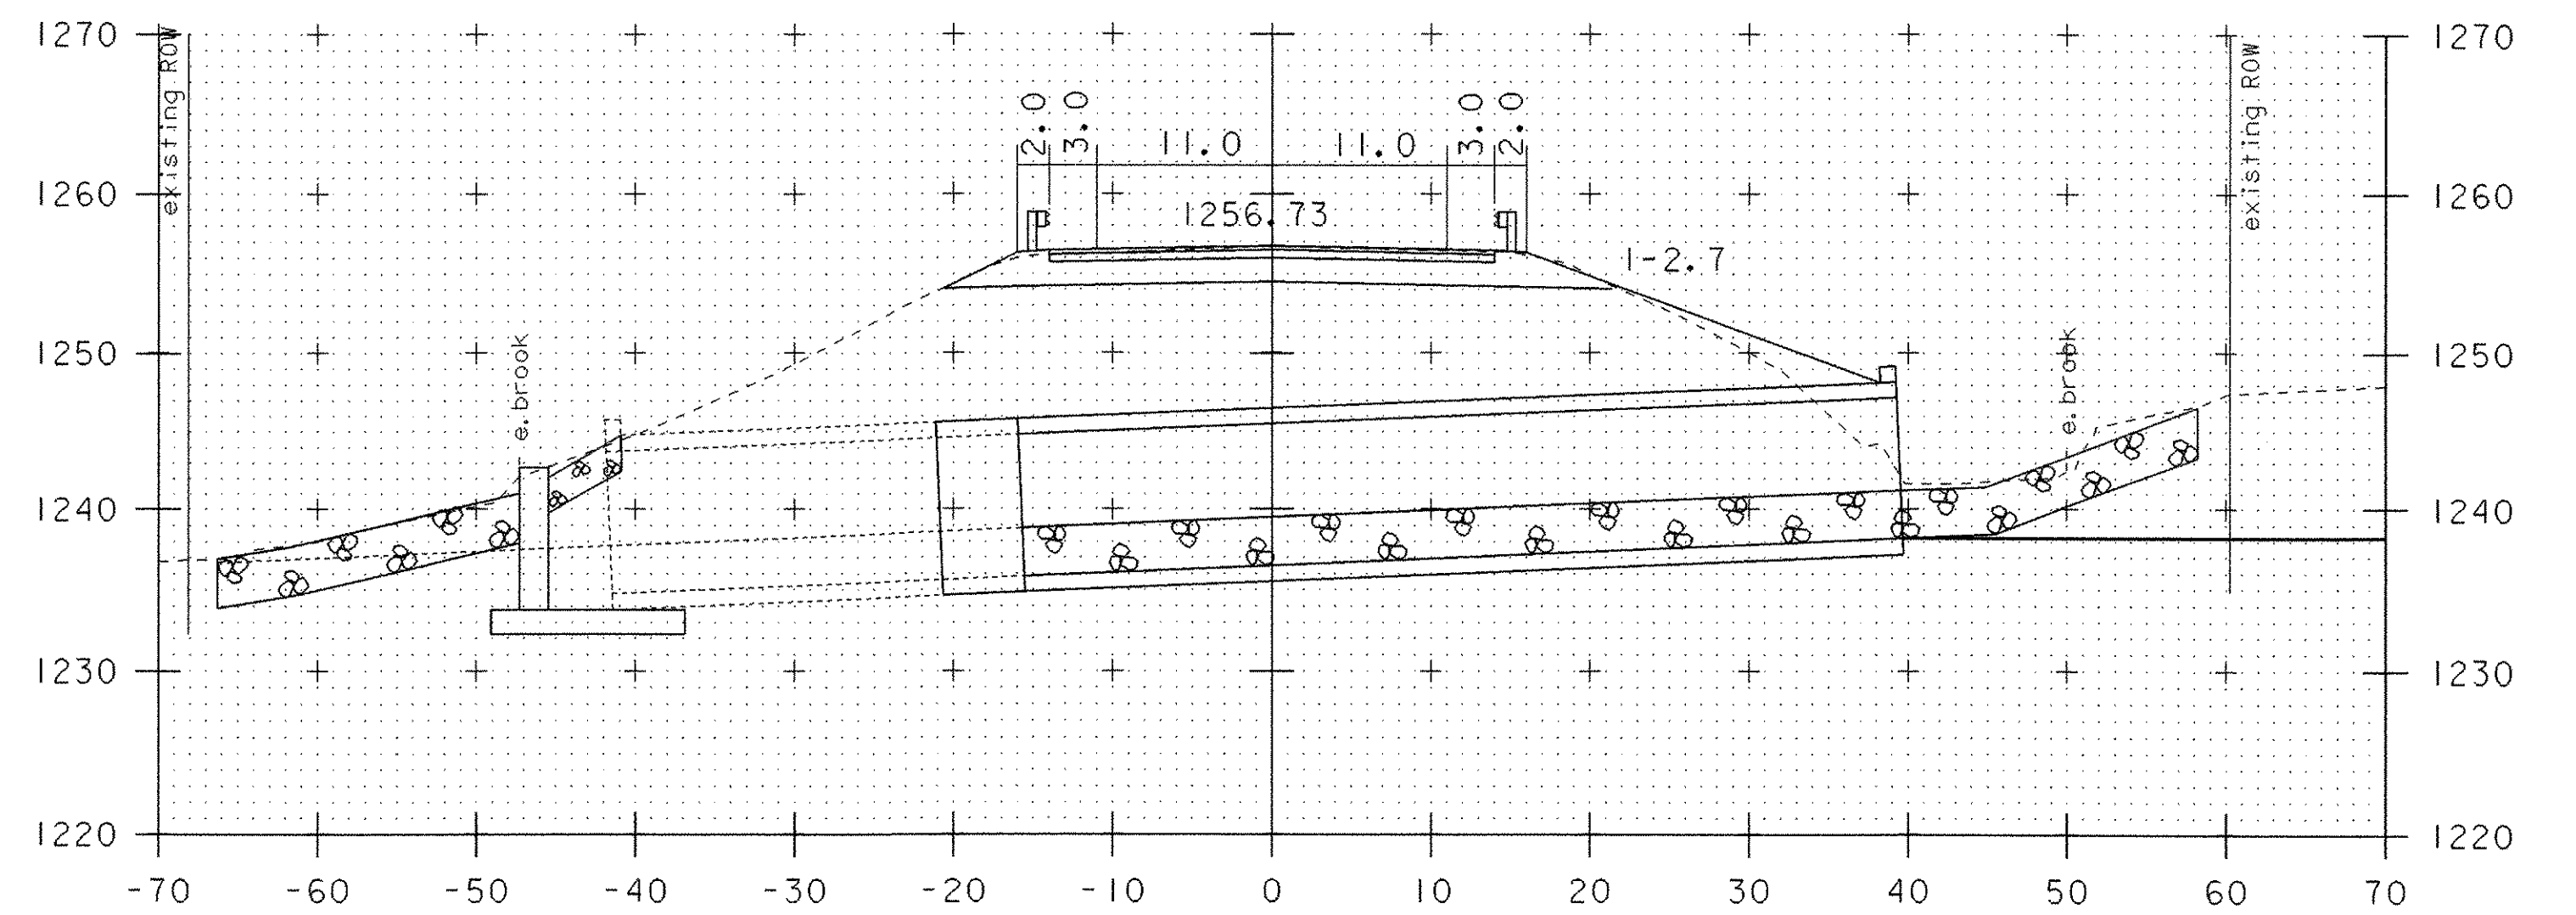


17+75

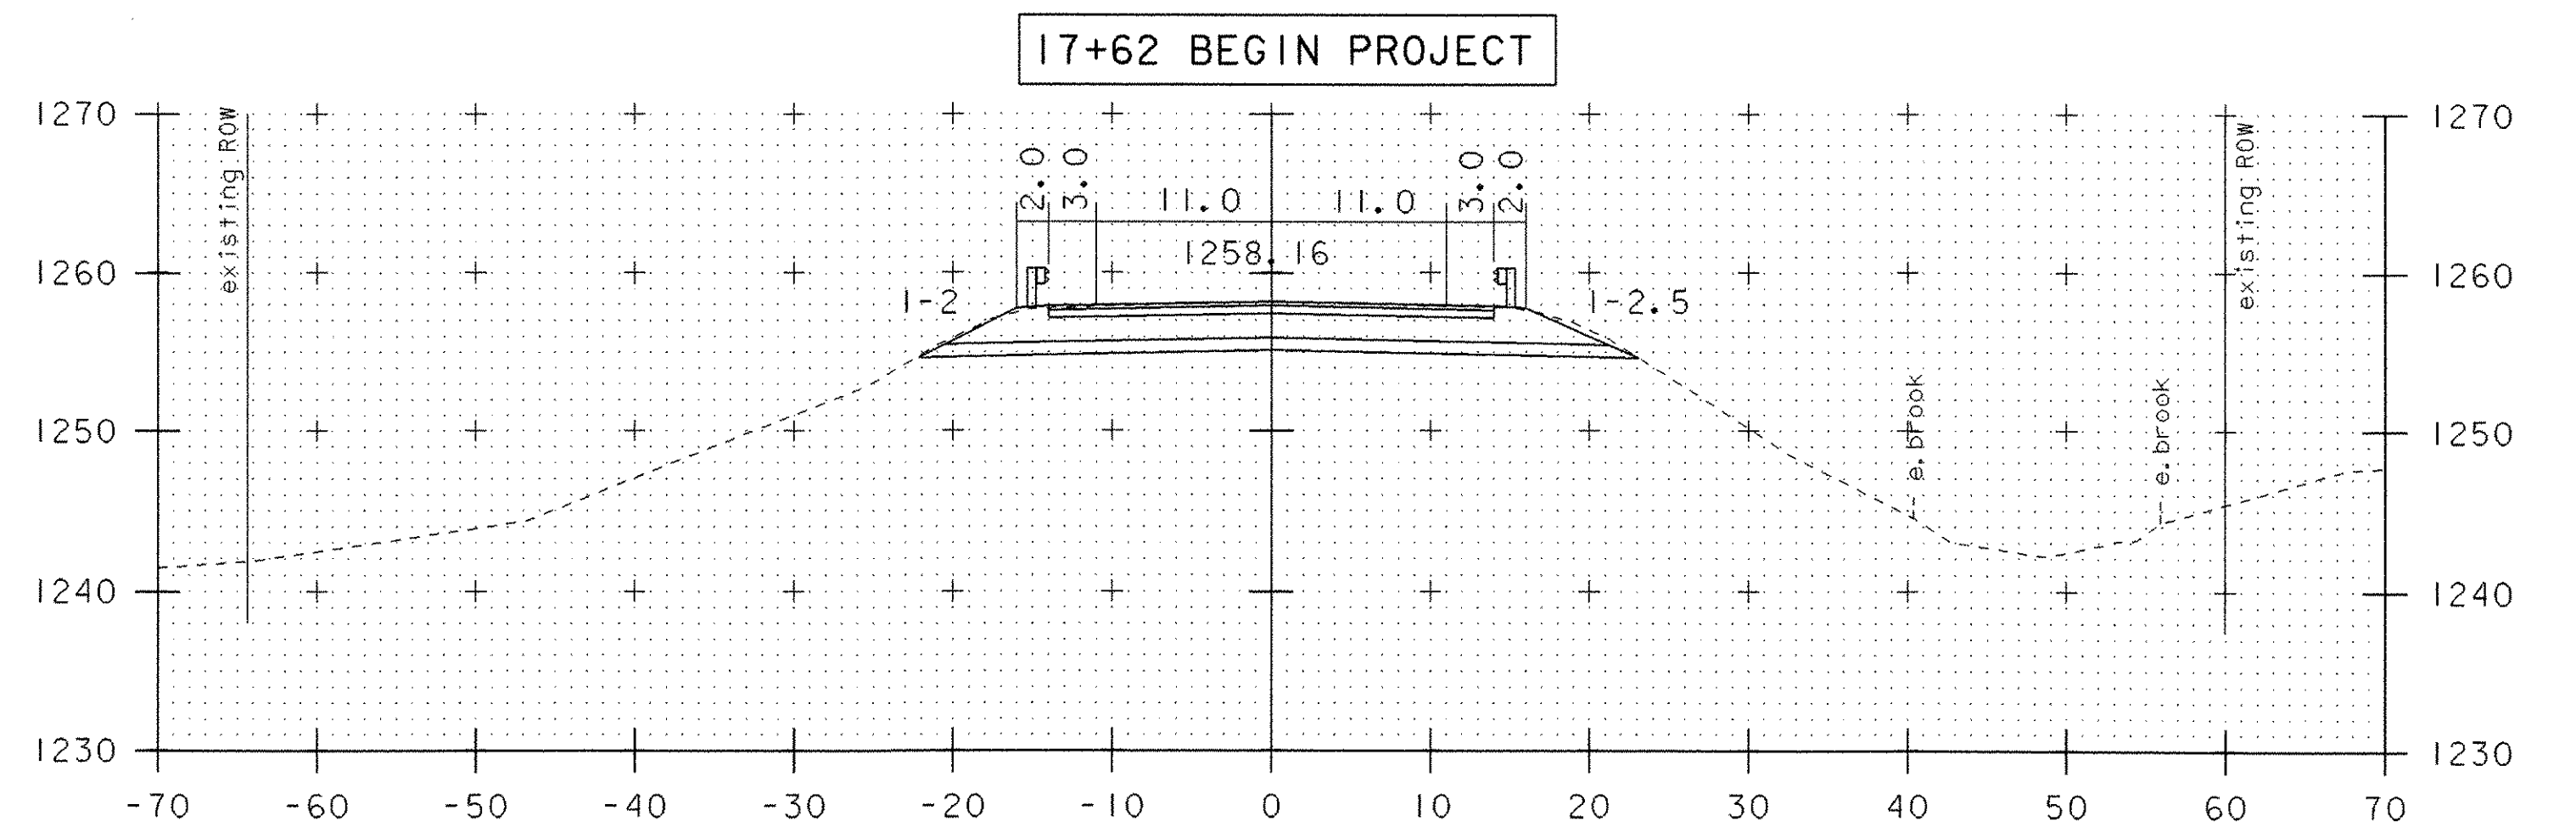

17+50

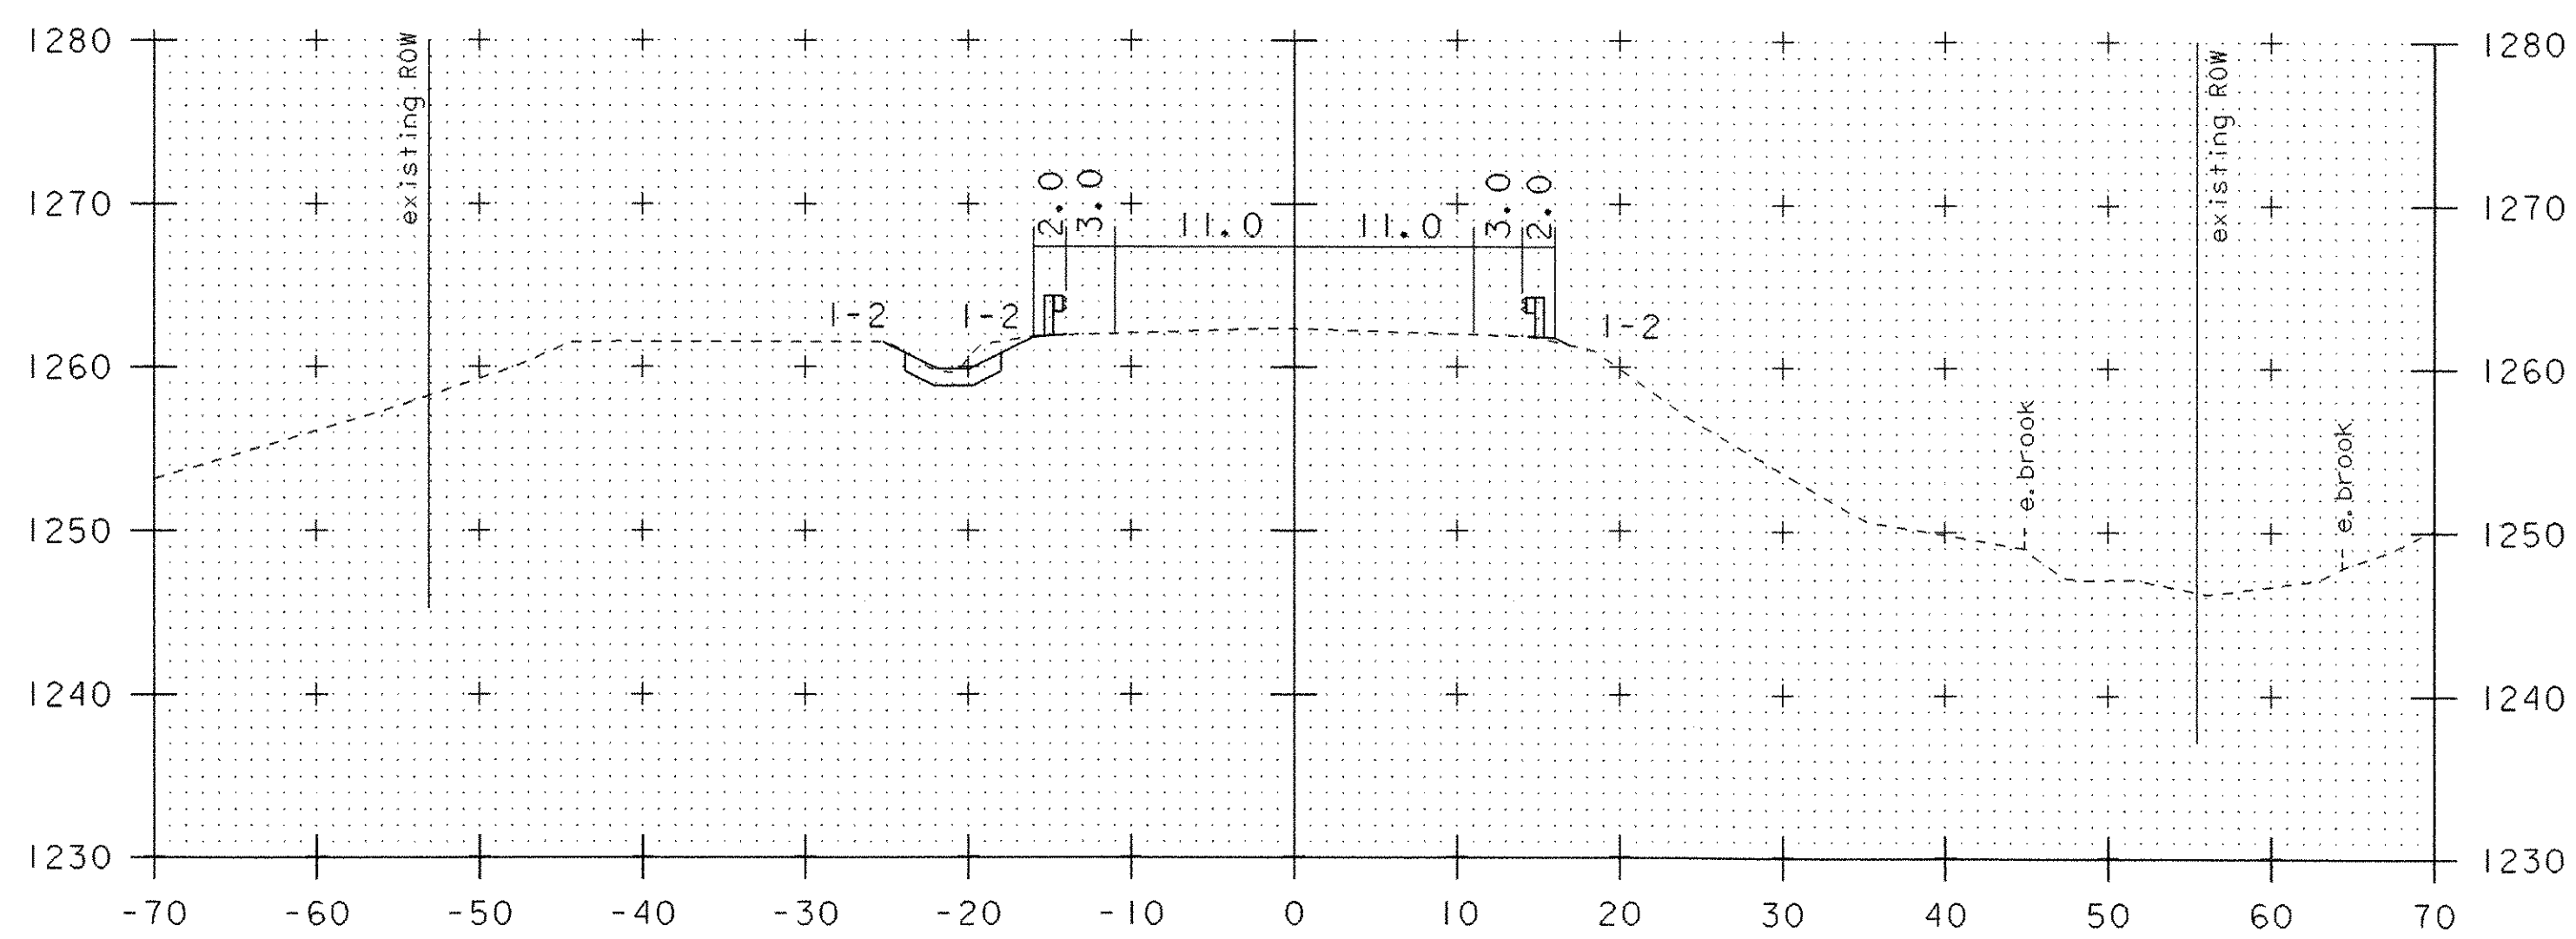


16+75

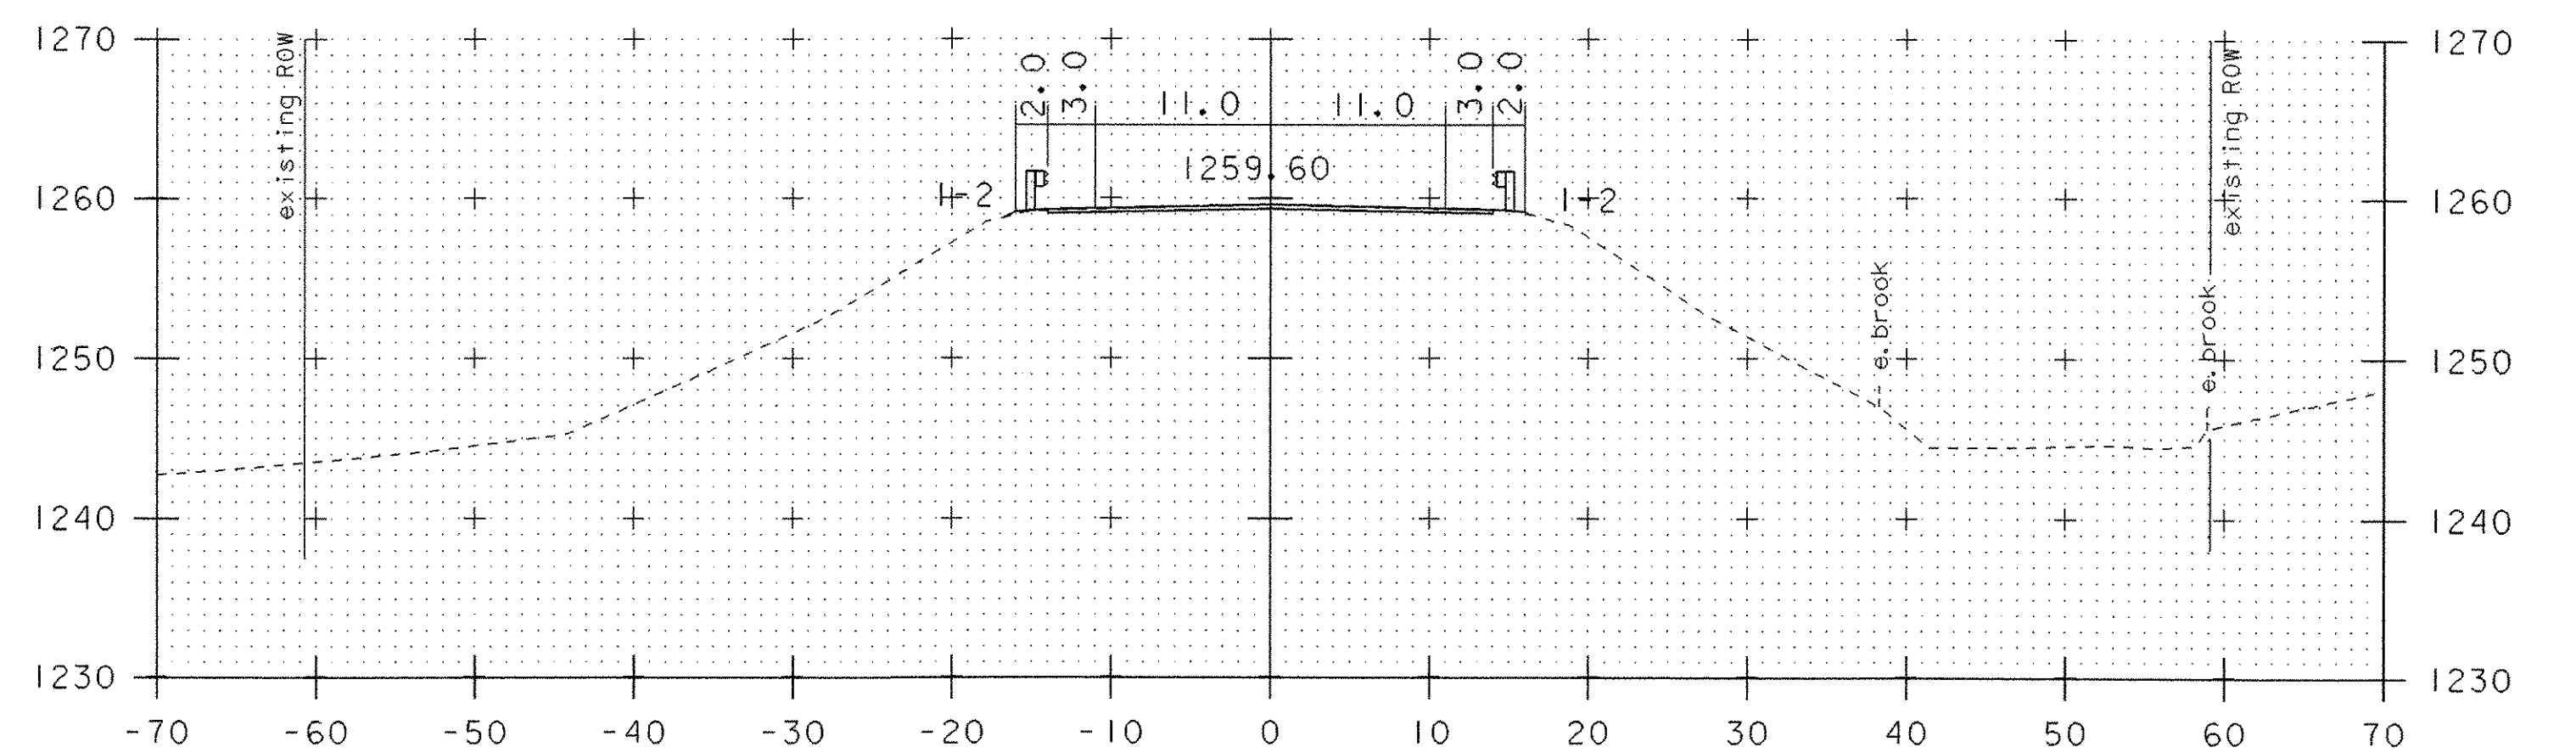


17+25

**MAINLINE CROSS SECTIONS**


PROJECT NAME:	JAY	PLOT DATE:	23-OCT-2006
PROJECT NUMBER:	ST STP CULV (2)	DRAWN BY:	G. SHANGRAW
FILE NAME:	04b140\s04b140bdr.dgn	DESIGNED BY:	T. SUMNER
PROJECT LEADER:	W. SYMONDS	CHECKED BY:	J. LACROIX
04b140xs2.1			SHEET 34 OF 39

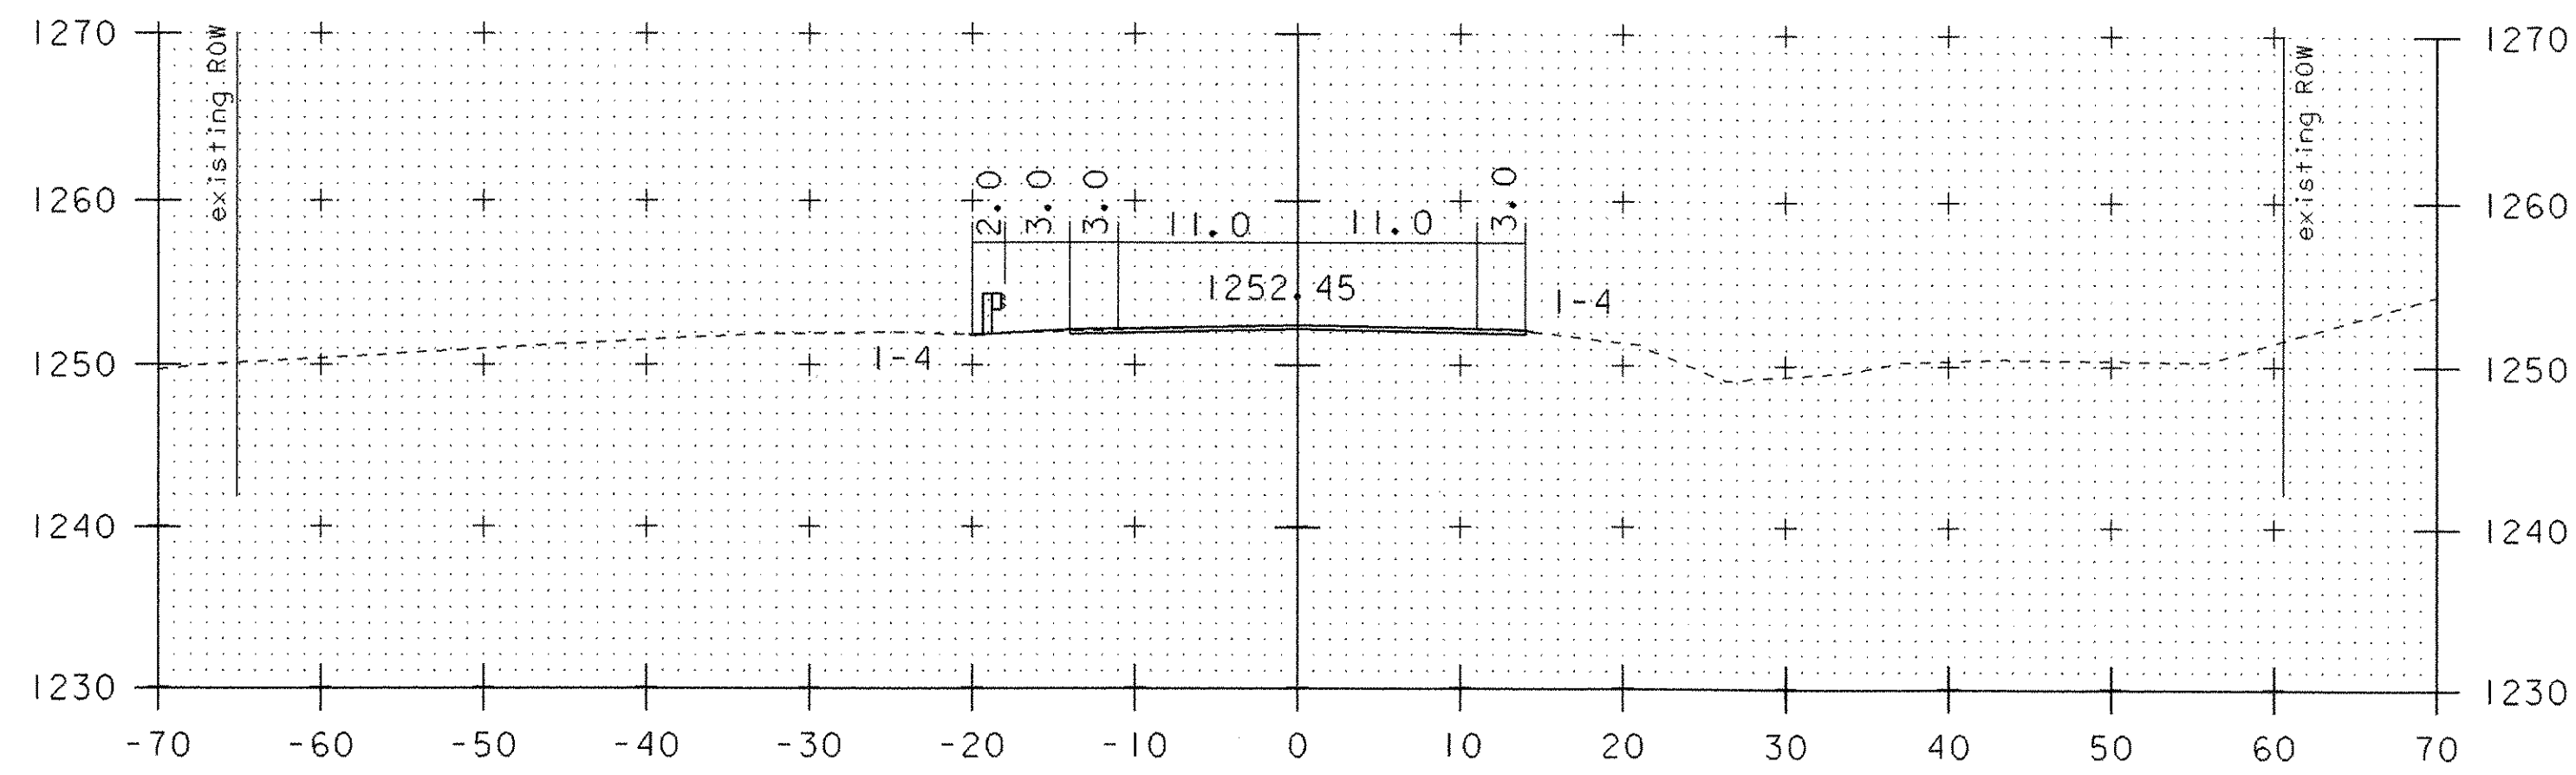


18+50

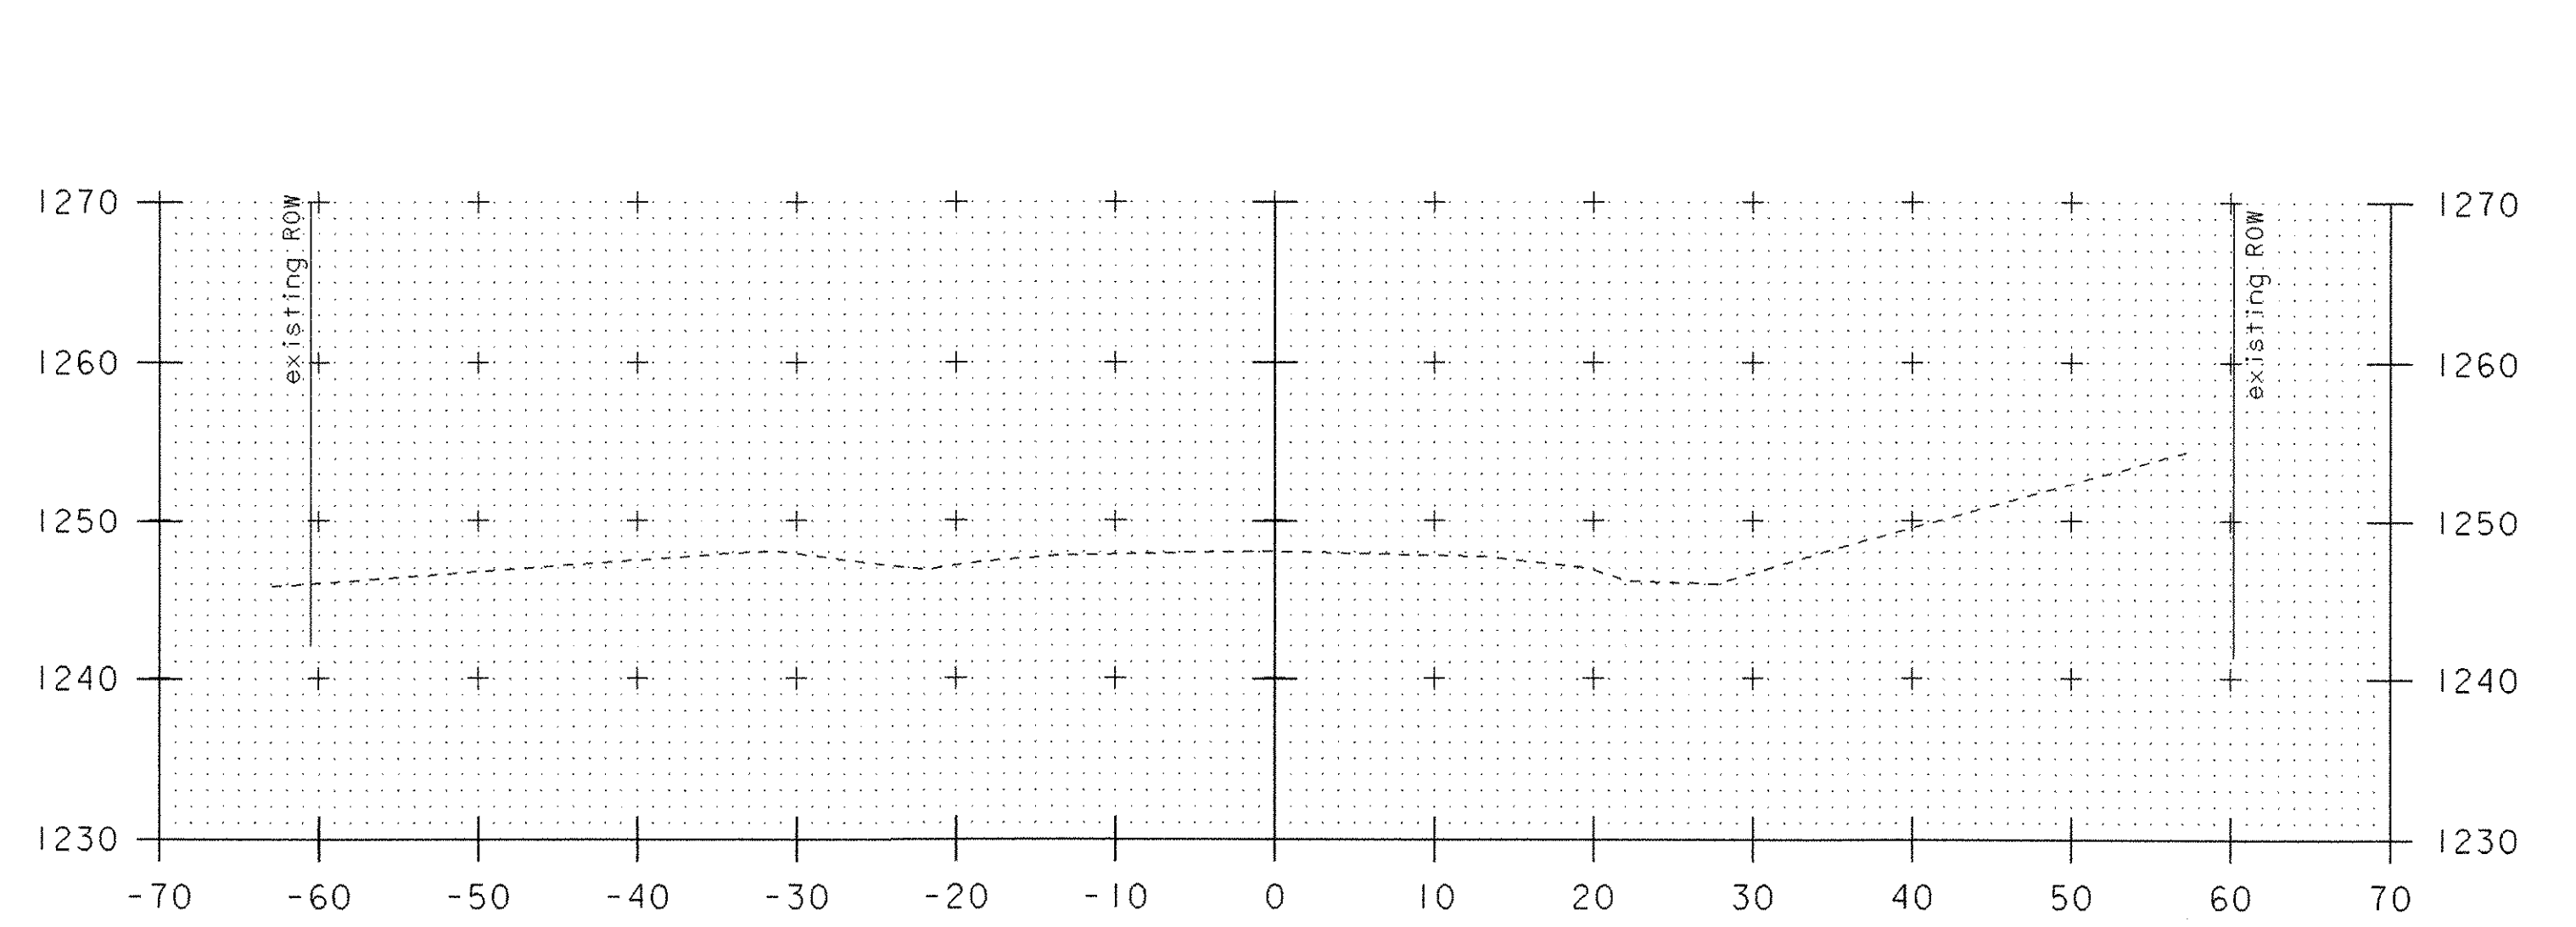

19+25

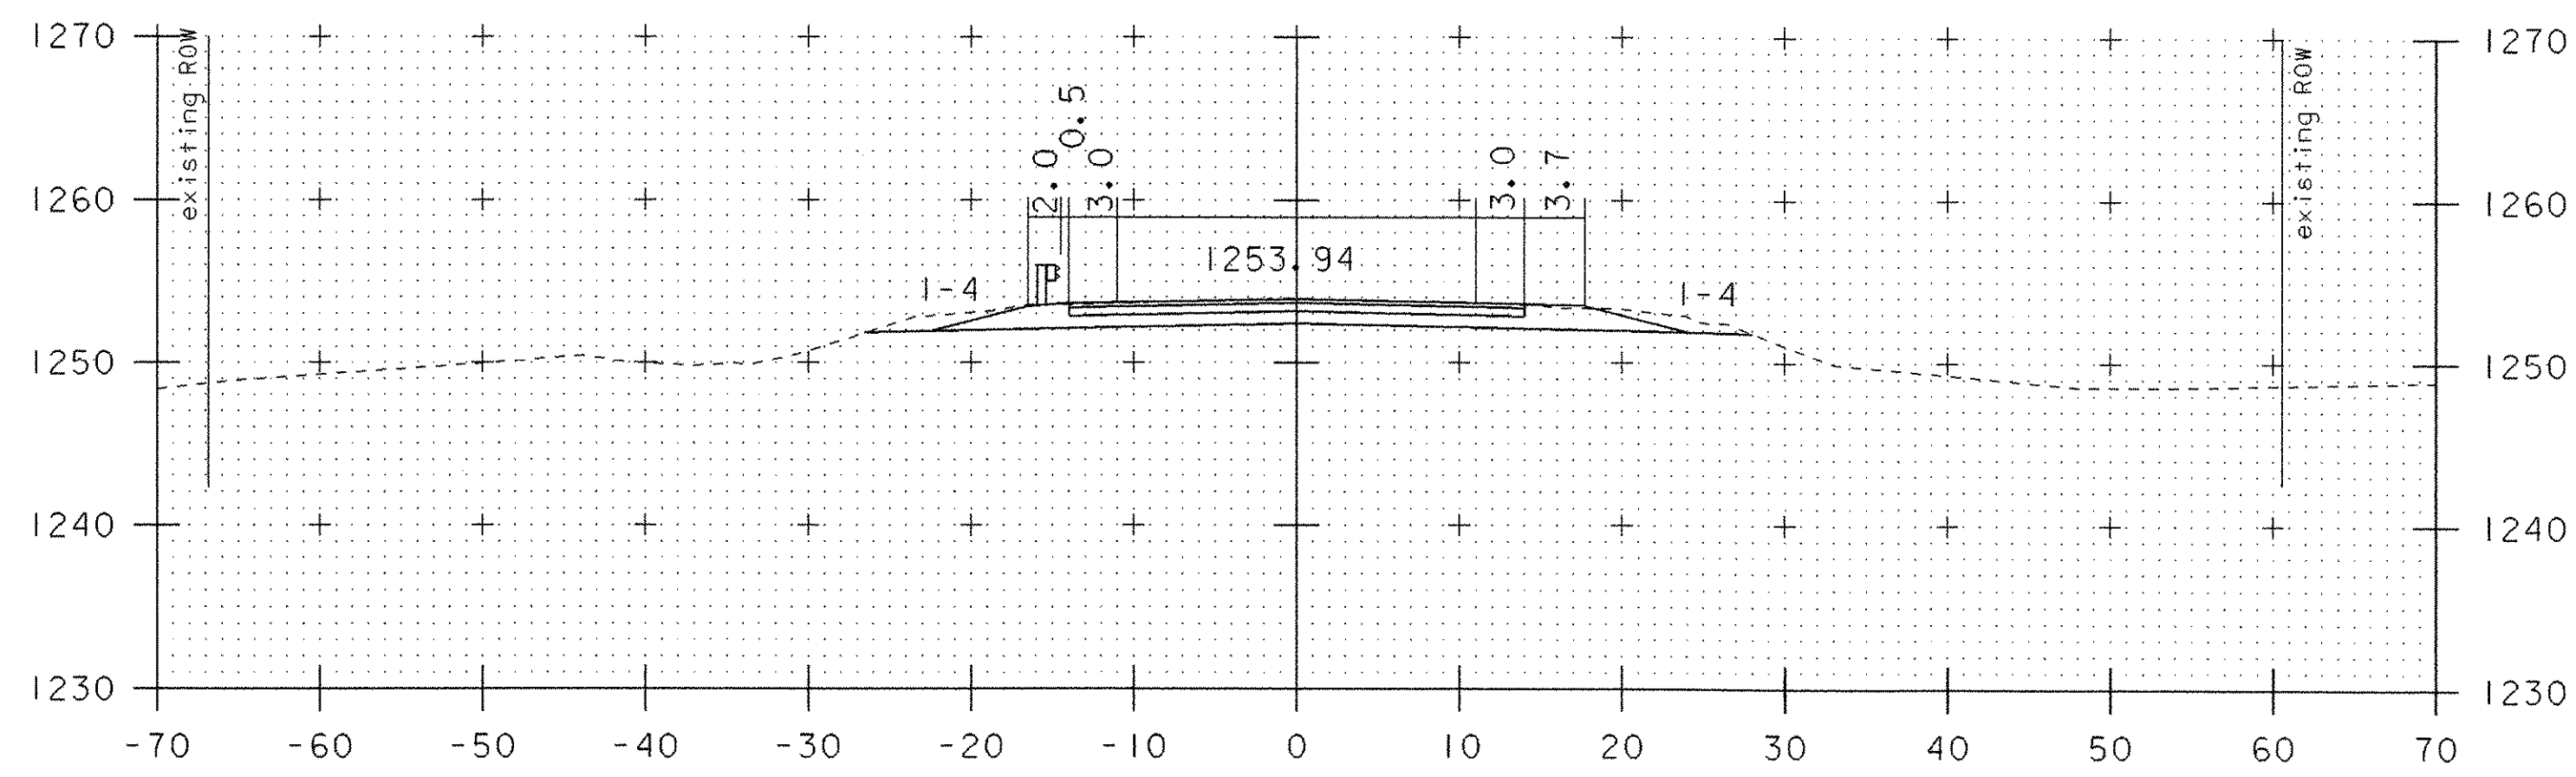


18+25

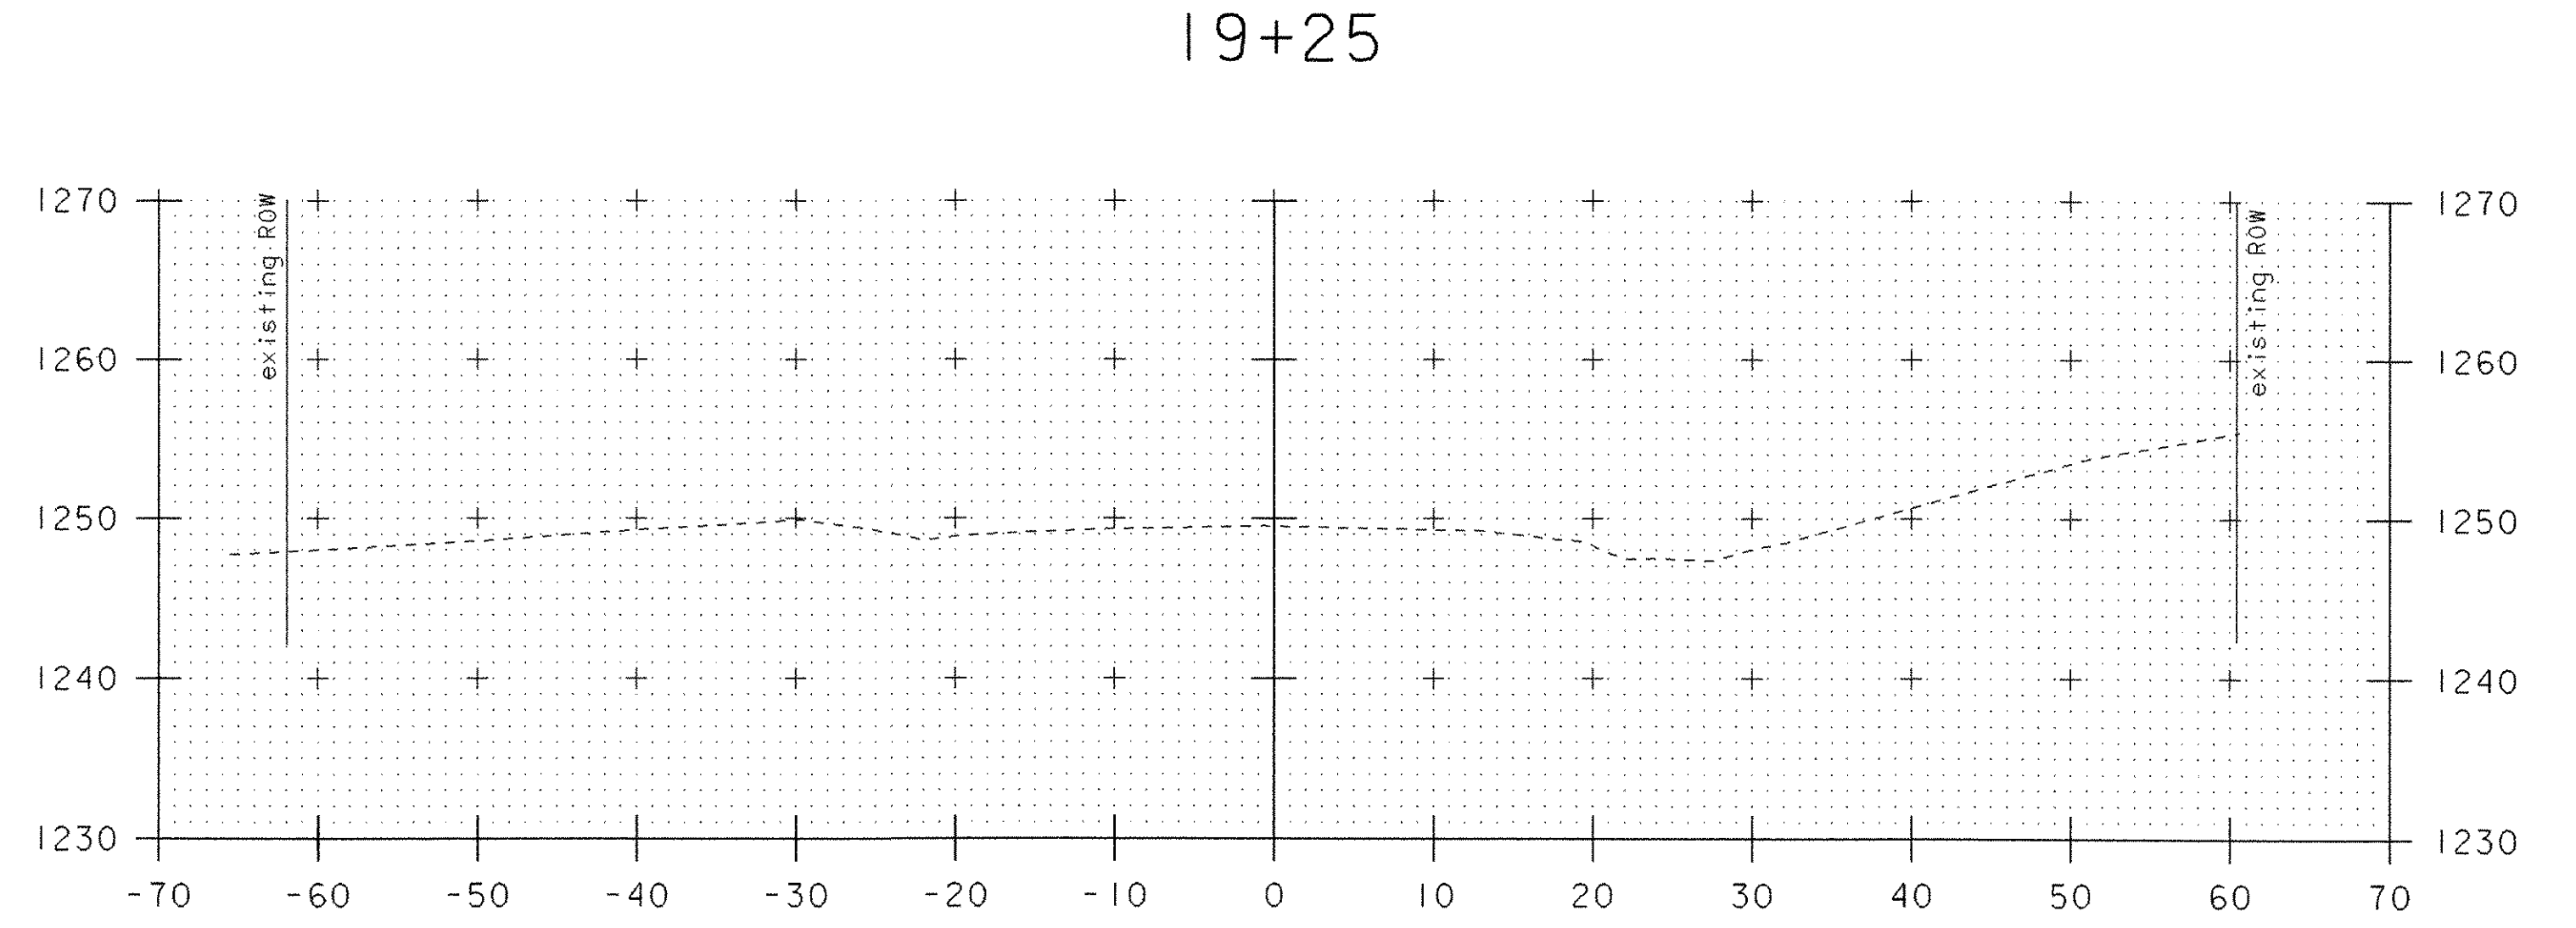


19+00

END APPROACH STA 18+87

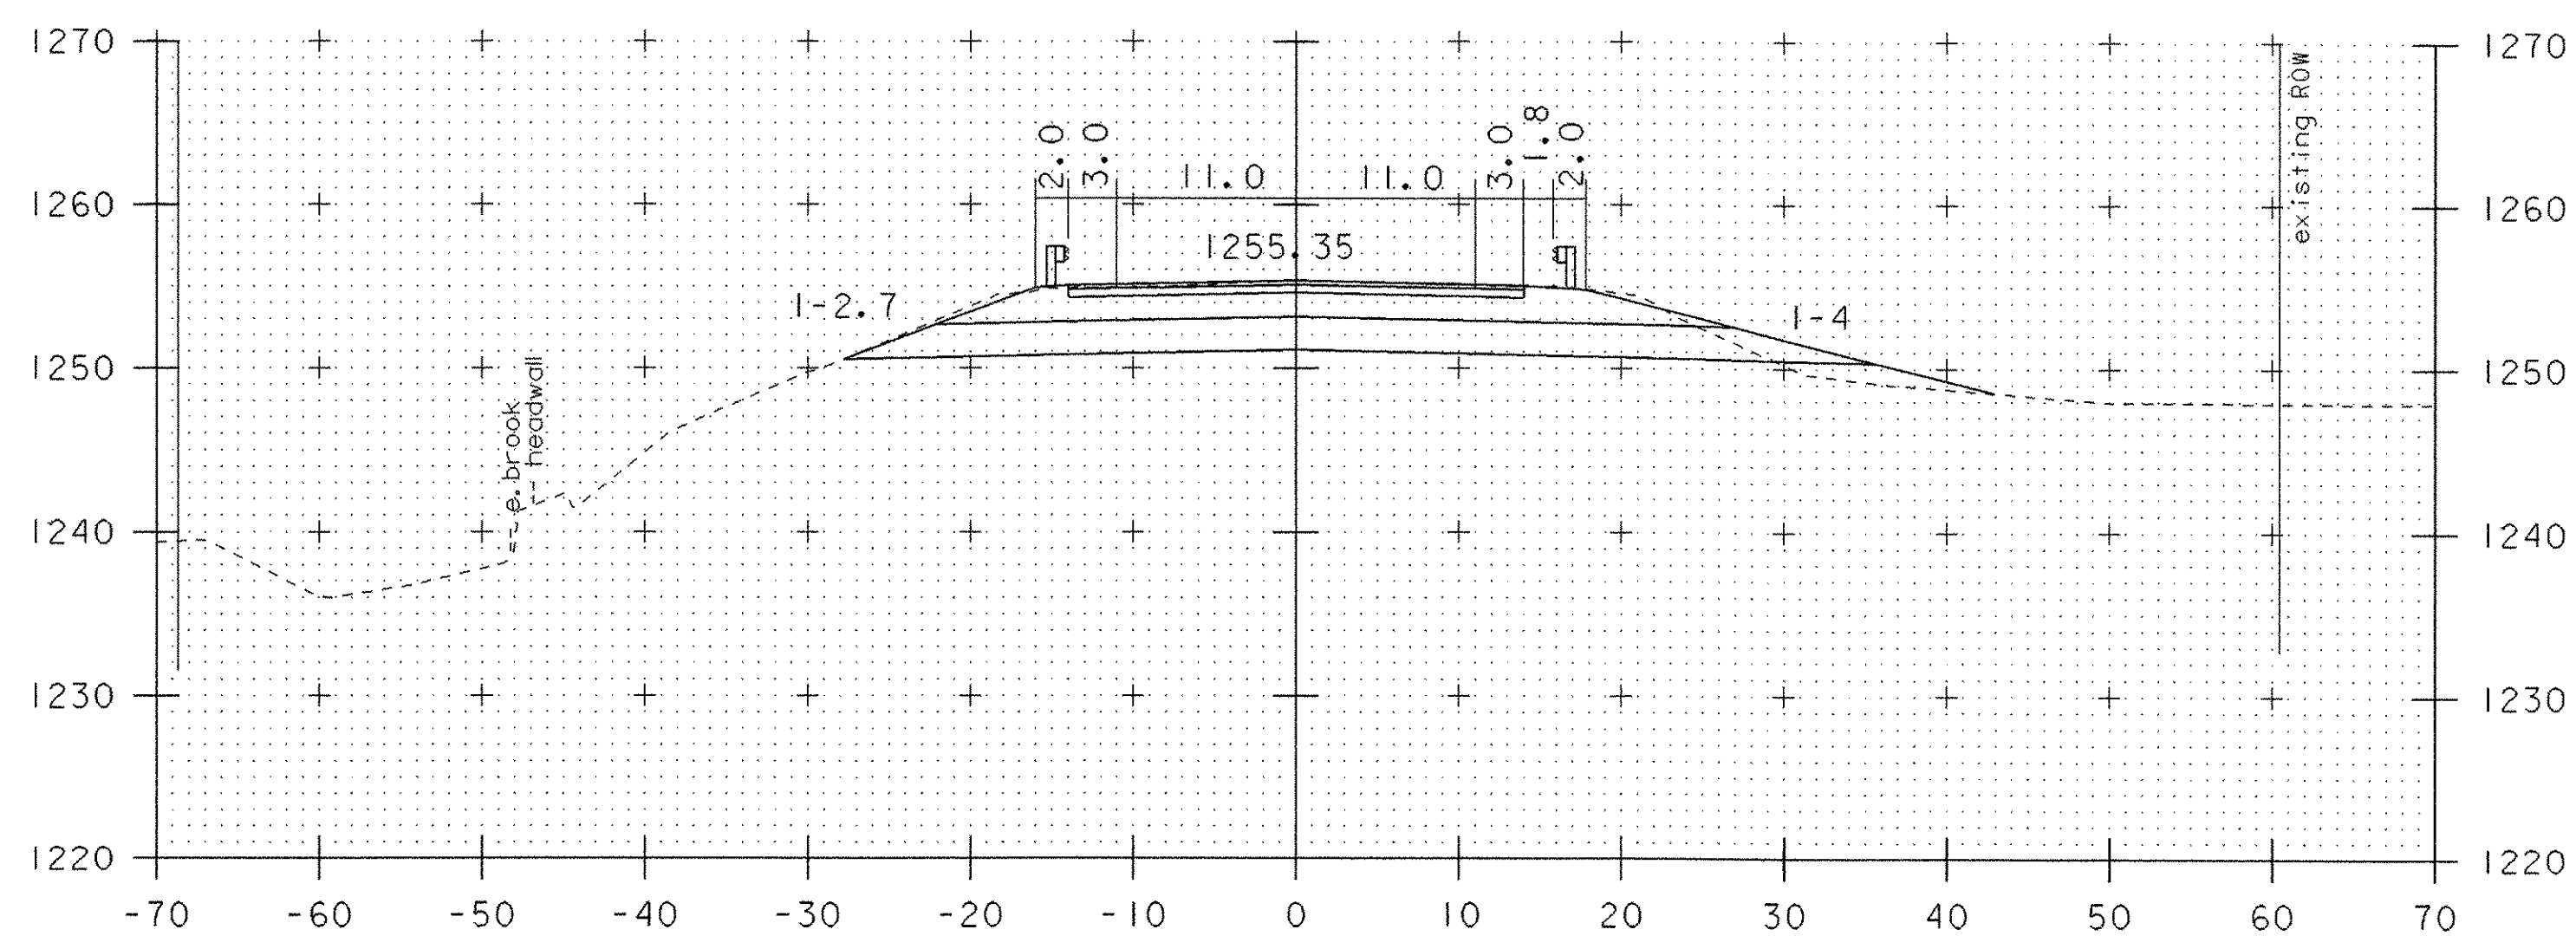

18+00


17+98 END PROJECT

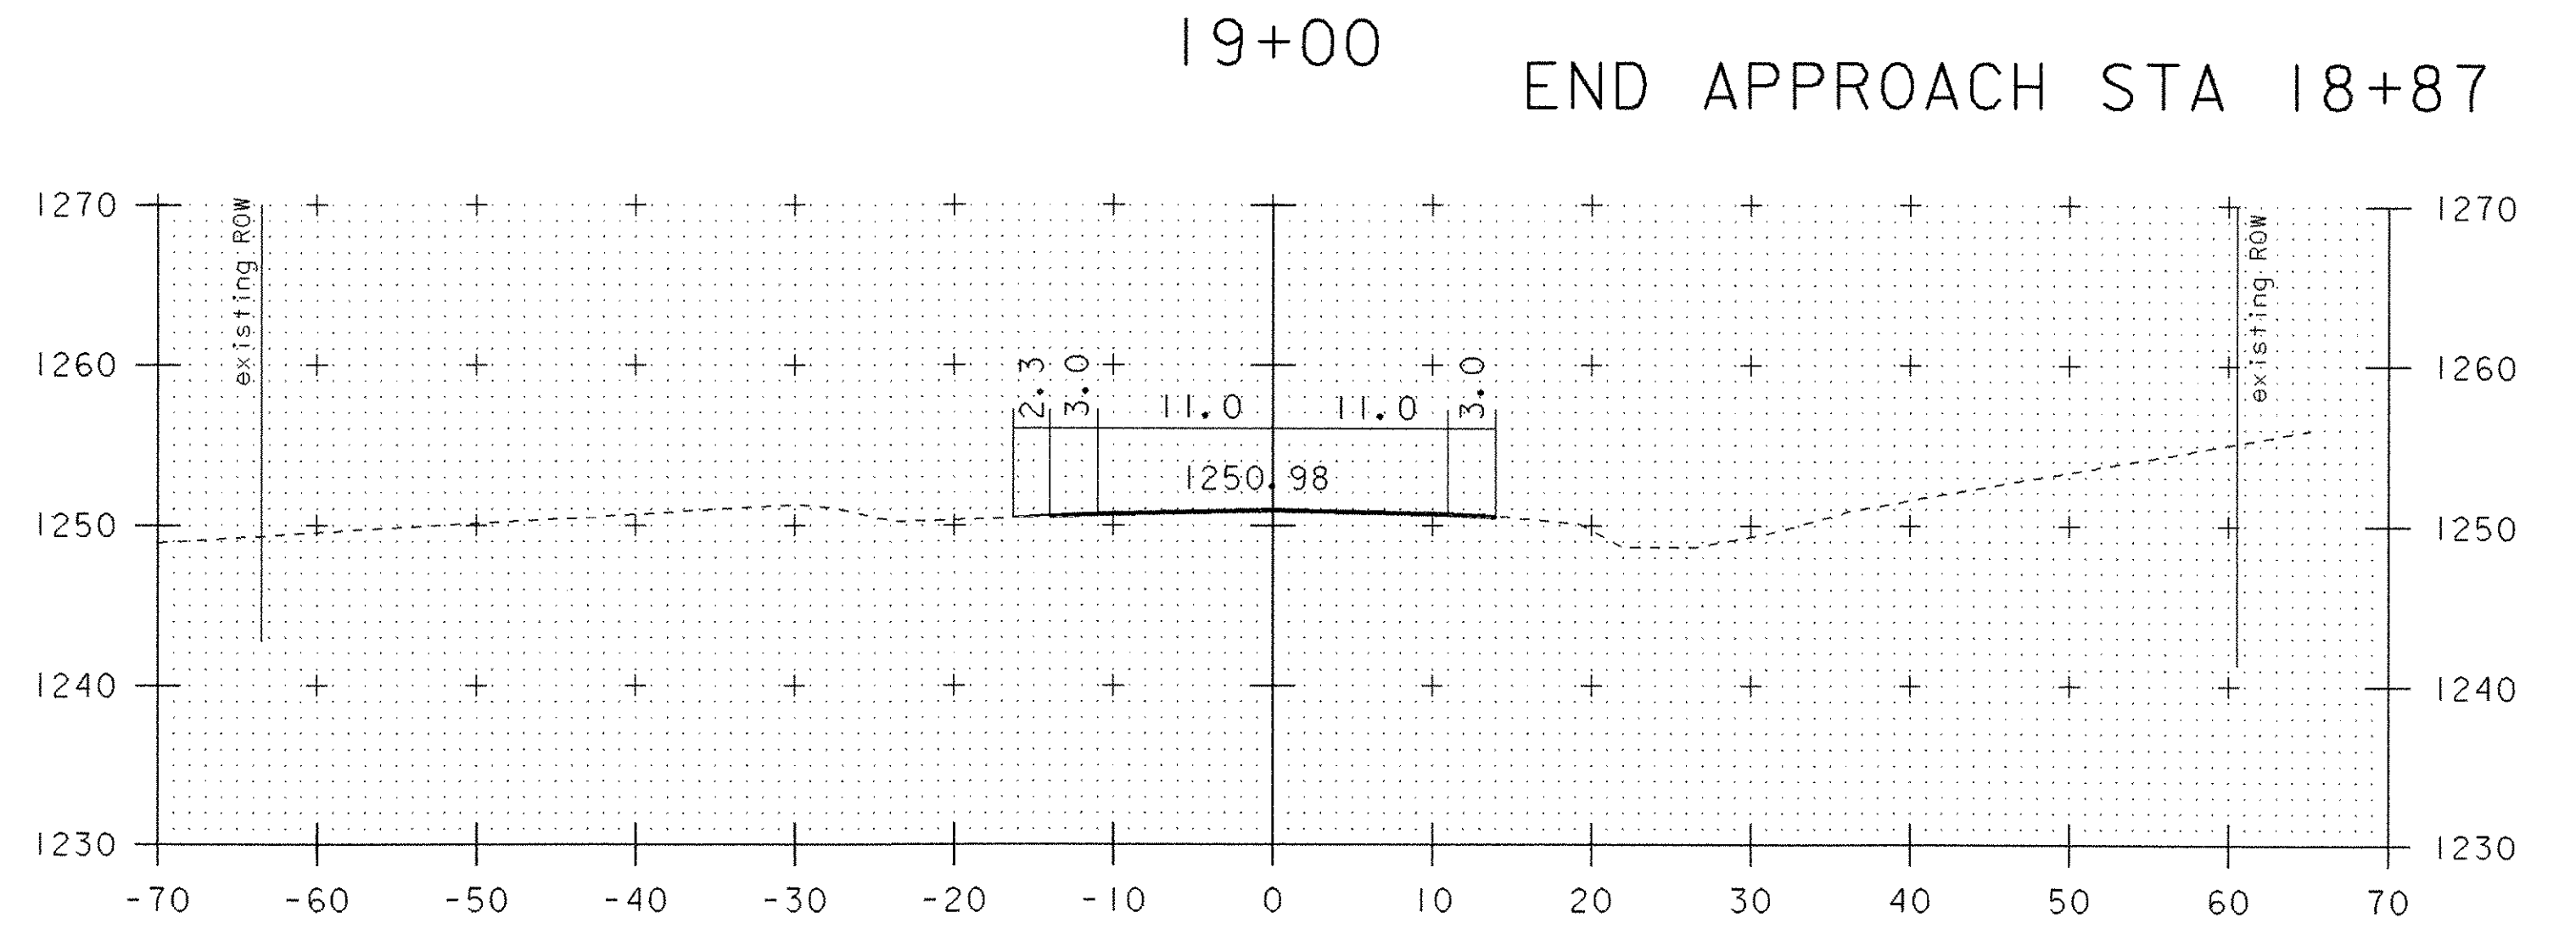


18+75

**MAINLINE CROSS SECTIONS**


PROJECT NAME:	JAY
PROJECT NUMBER:	ST STP CULV (2)
FILE NAME:	04b140\s04b140bdr.dgn
PROJECT LEADER:	W. SYMONDS
DESIGNED BY:	T. SUMNER
PLOT DATE:	23-OCT-2006
DRAWN BY:	G. SHANGRAW
CHECKED BY:	J. LACROIX
04b140xs3.i	SHEET 35 OF 39

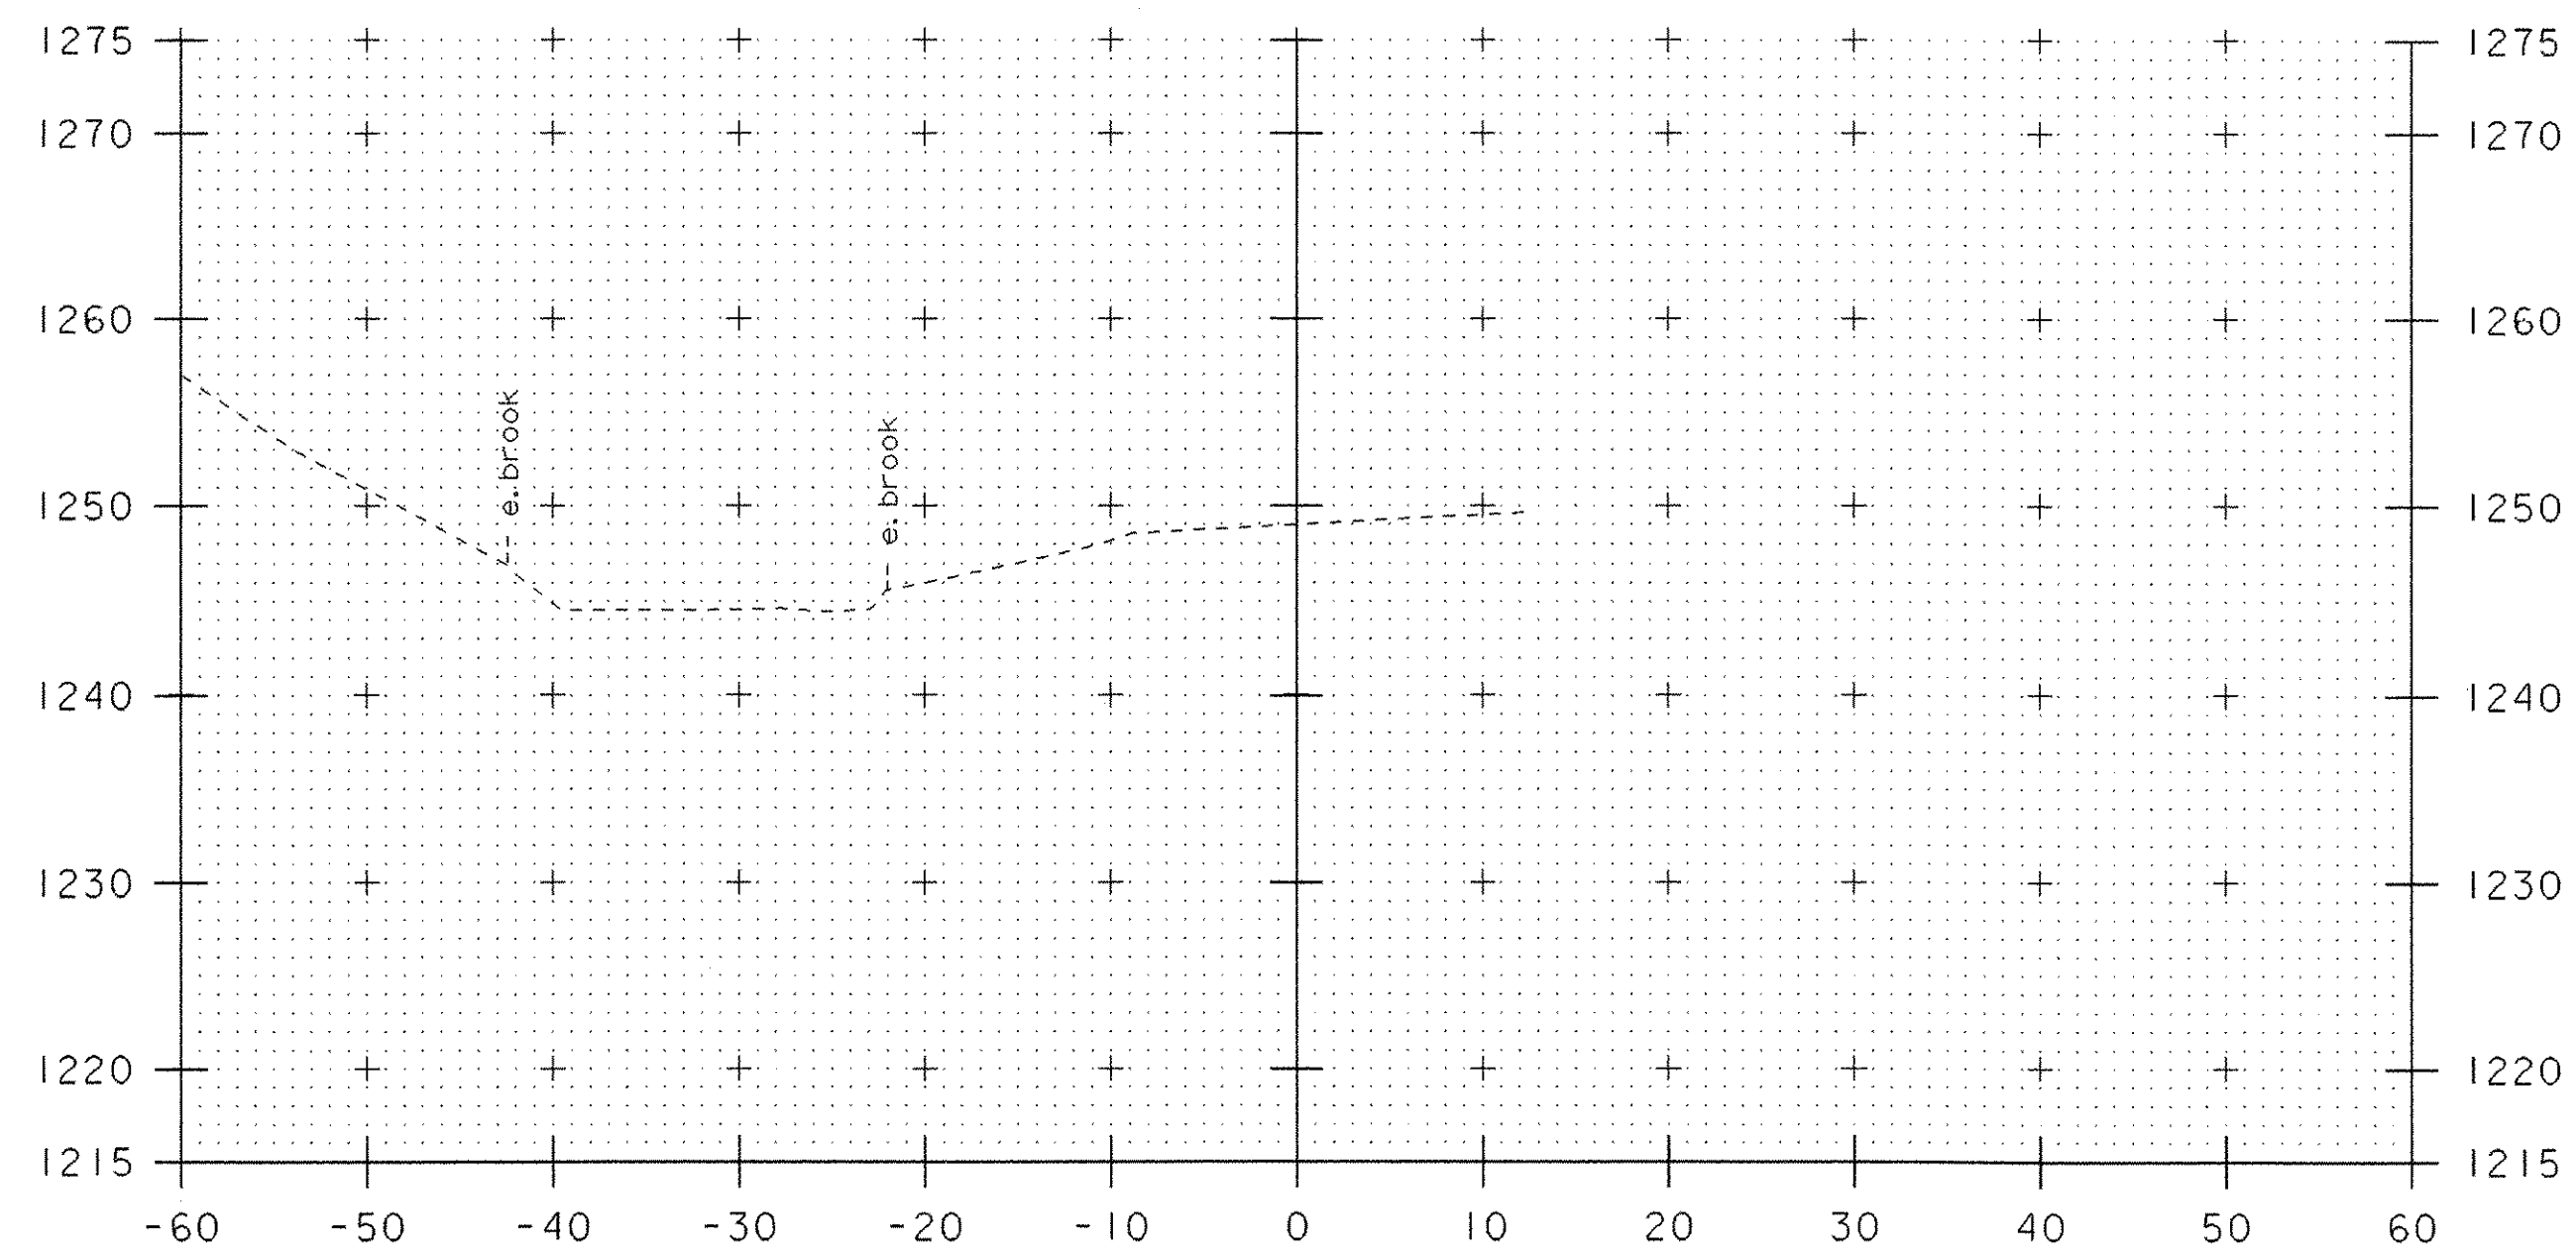


52+20

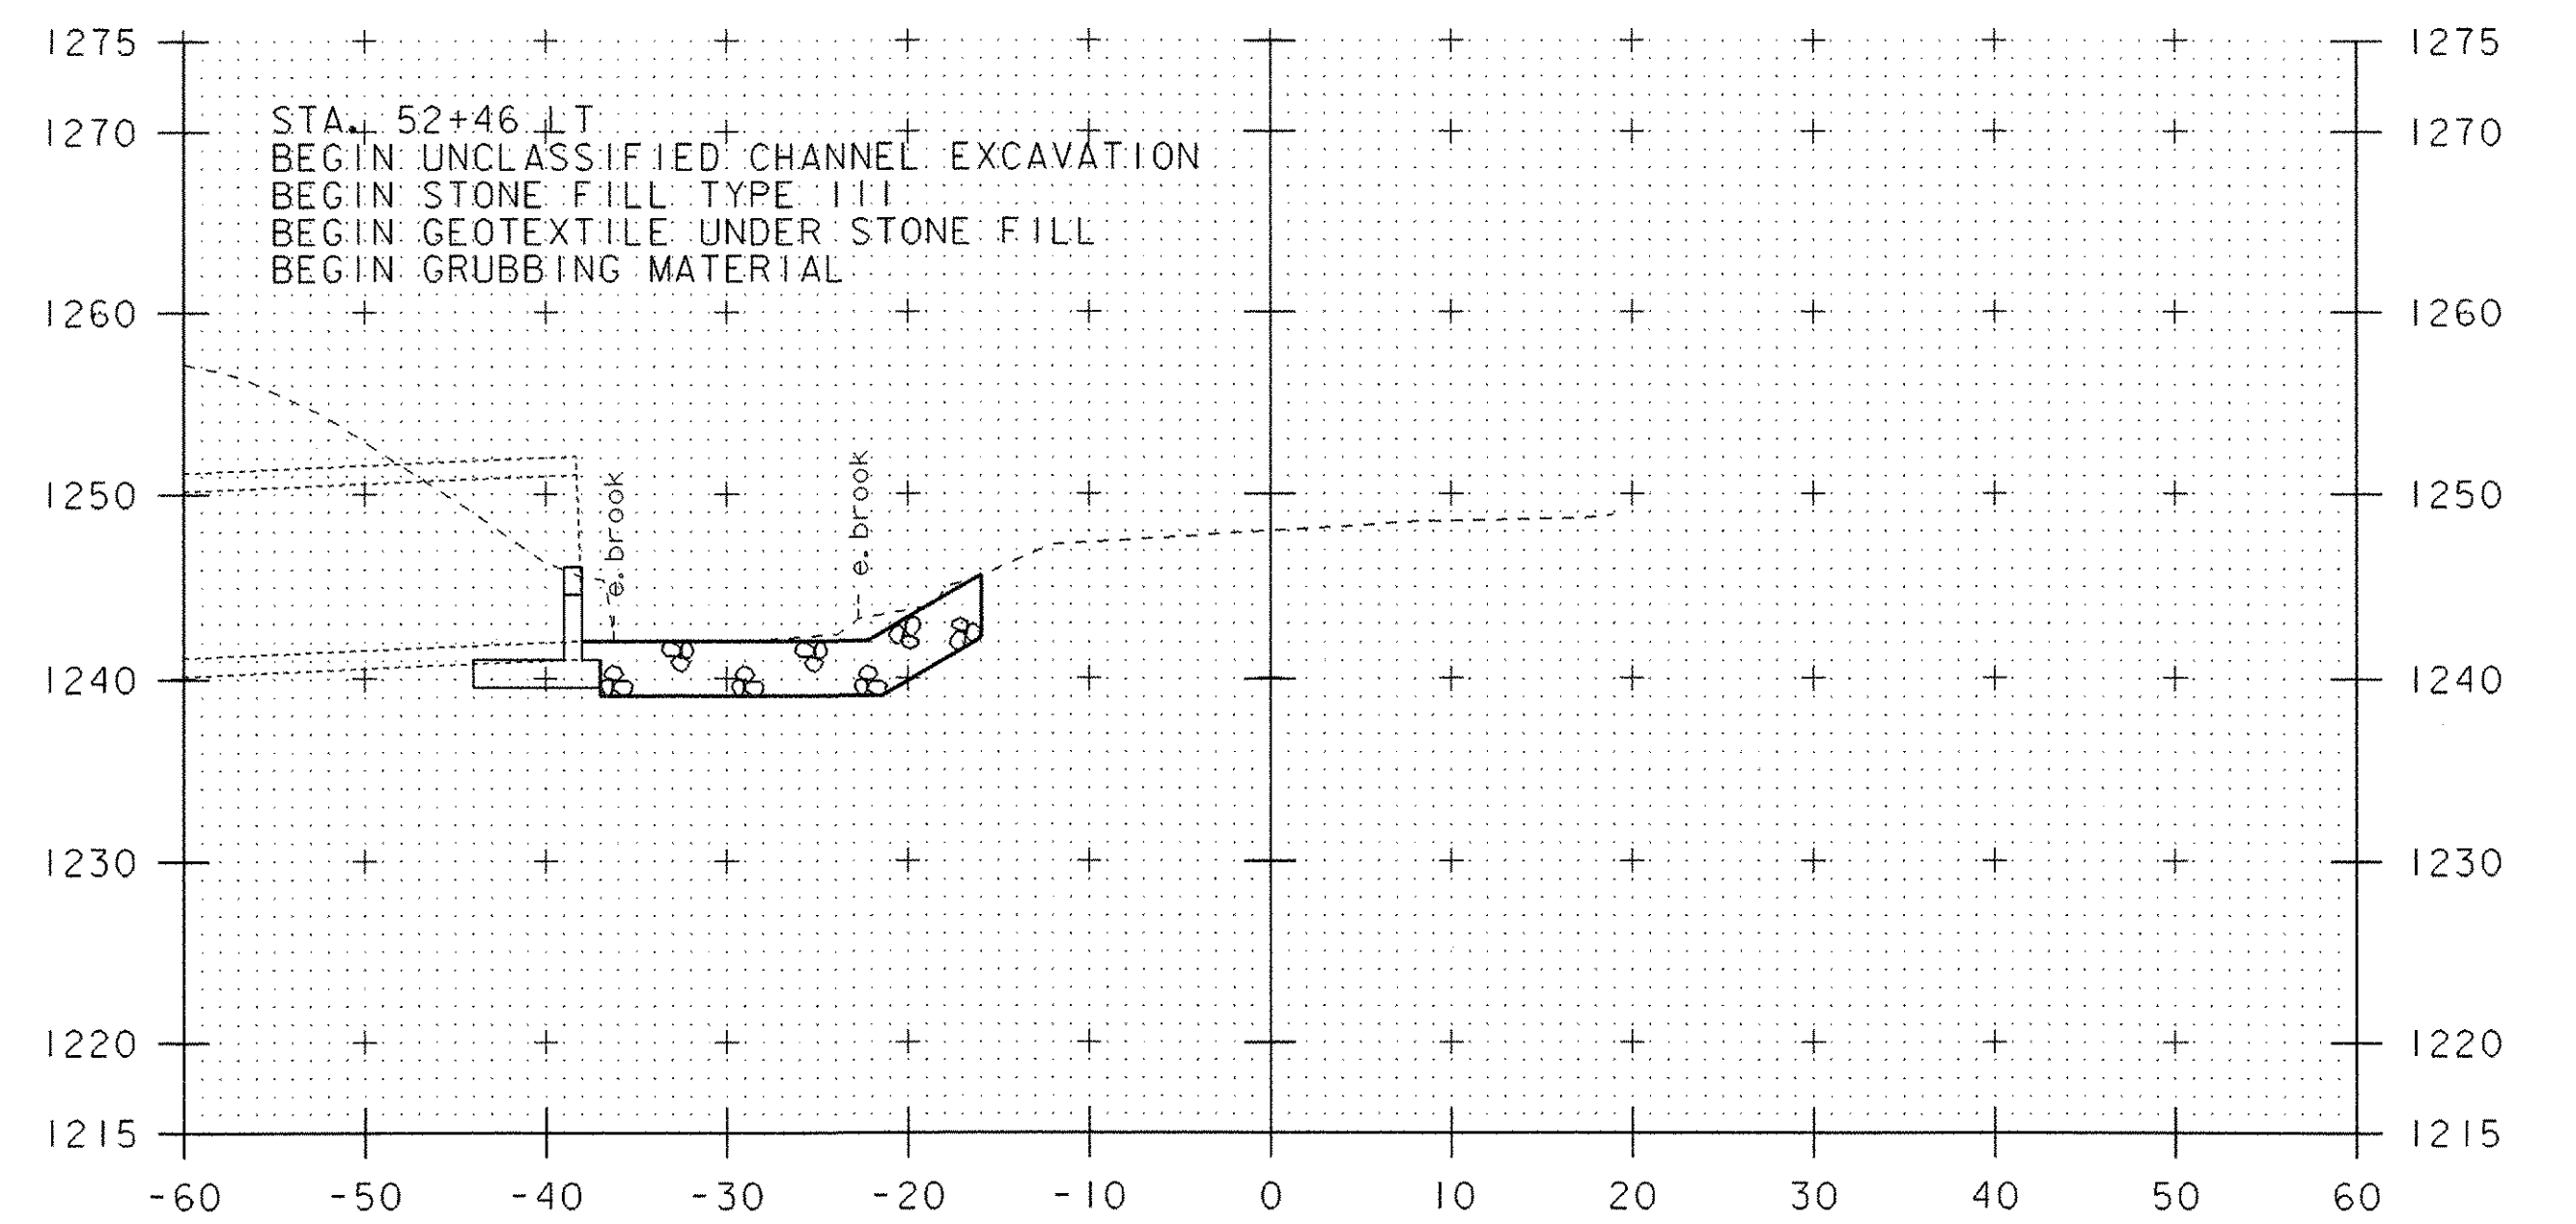

52+60

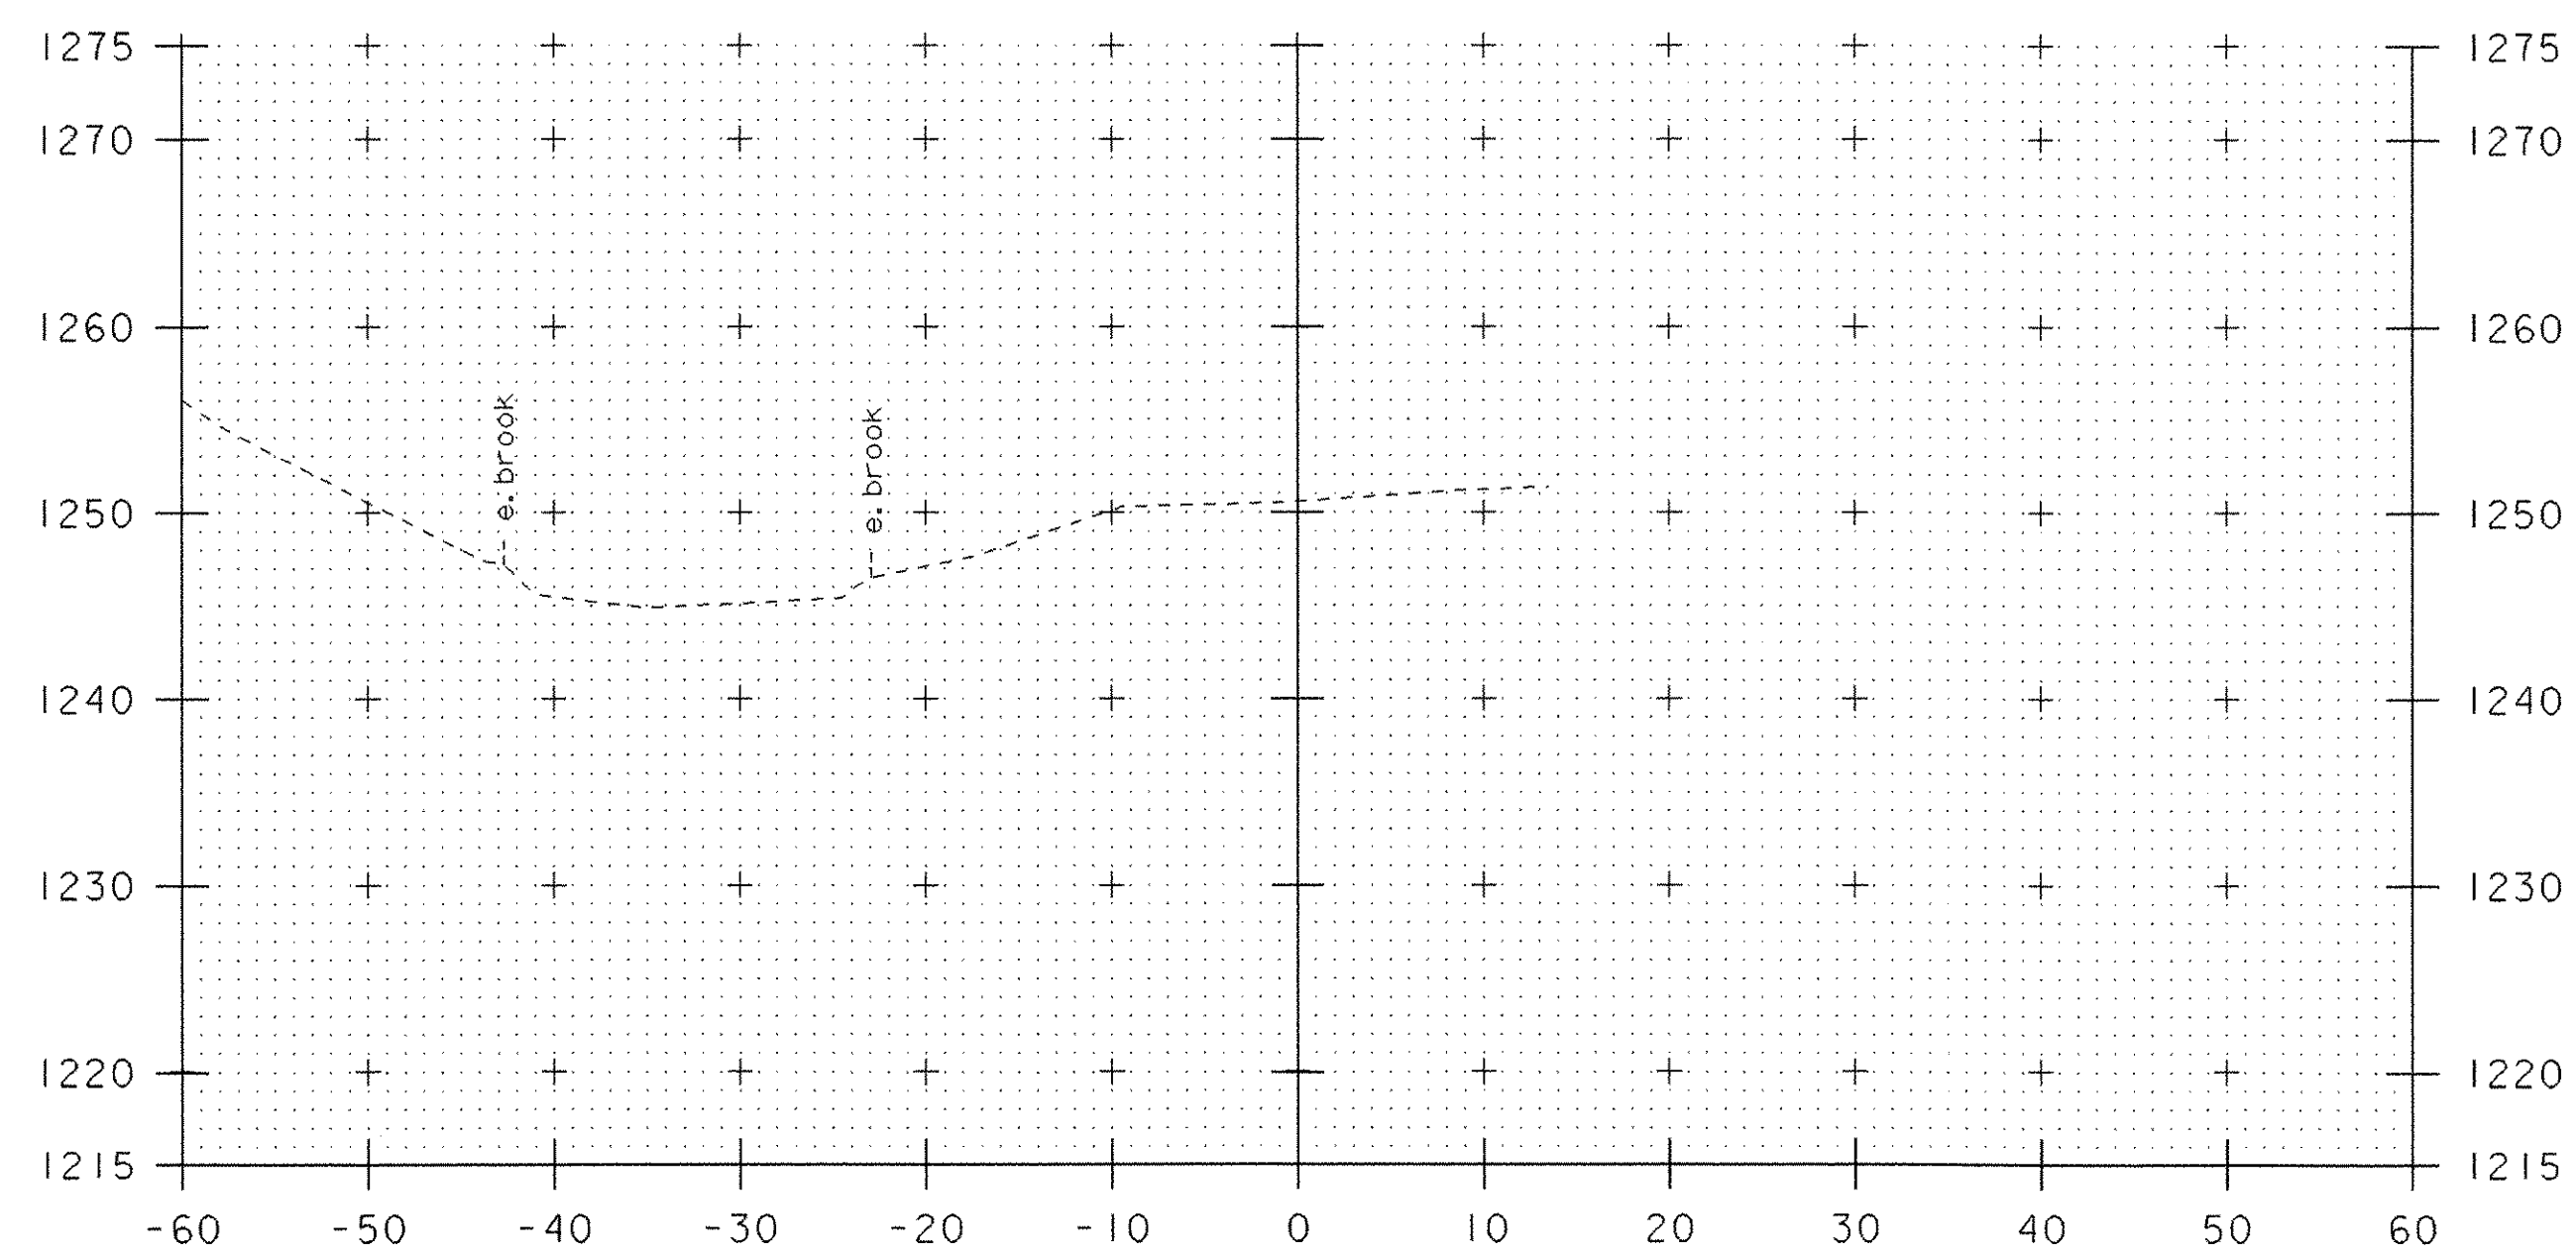


52+00

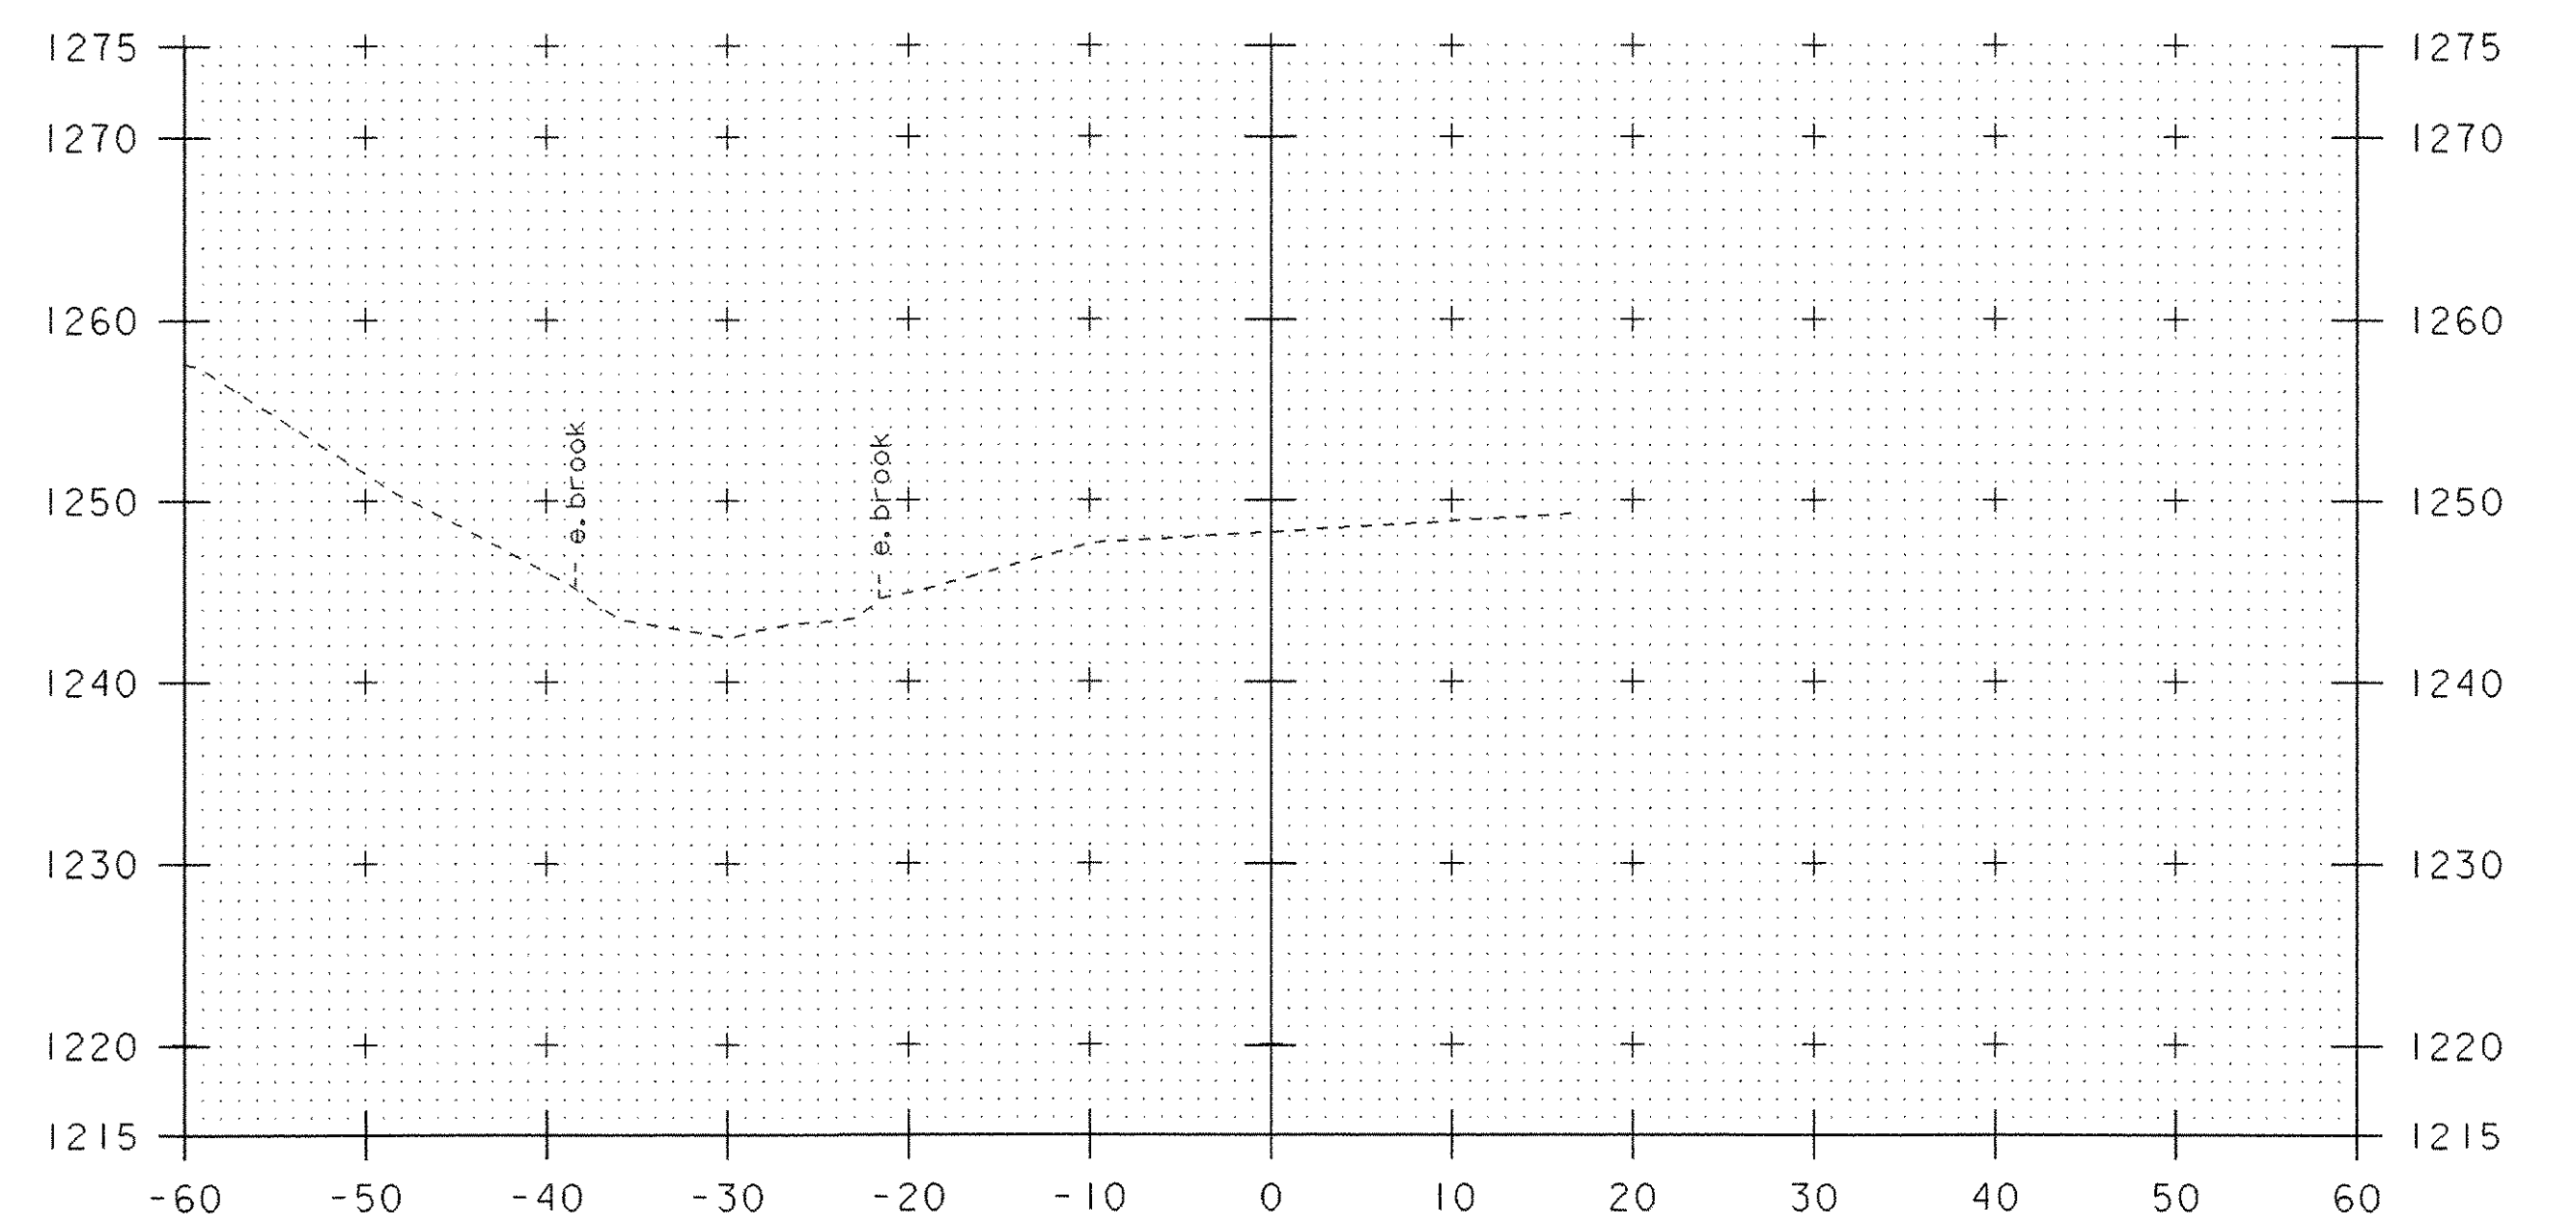


52+40

**CHANNEL CROSS SECTIONS**


PROJECT NAME:	JAY
PROJECT NUMBER:	ST STP CULV (2)
FILE NAME:	04bl40\s04bl40bdr.dgn
PROJECT LEADER:	W. SYMONDS
DESIGNED BY:	T. SUMNER
04bl40chxsl.i	
PLOT DATE:	23-OCT-2006
DRAWN BY:	G. SHANGRAW
CHECKED BY:	J. LACROIX
SHEET	36 OF 39

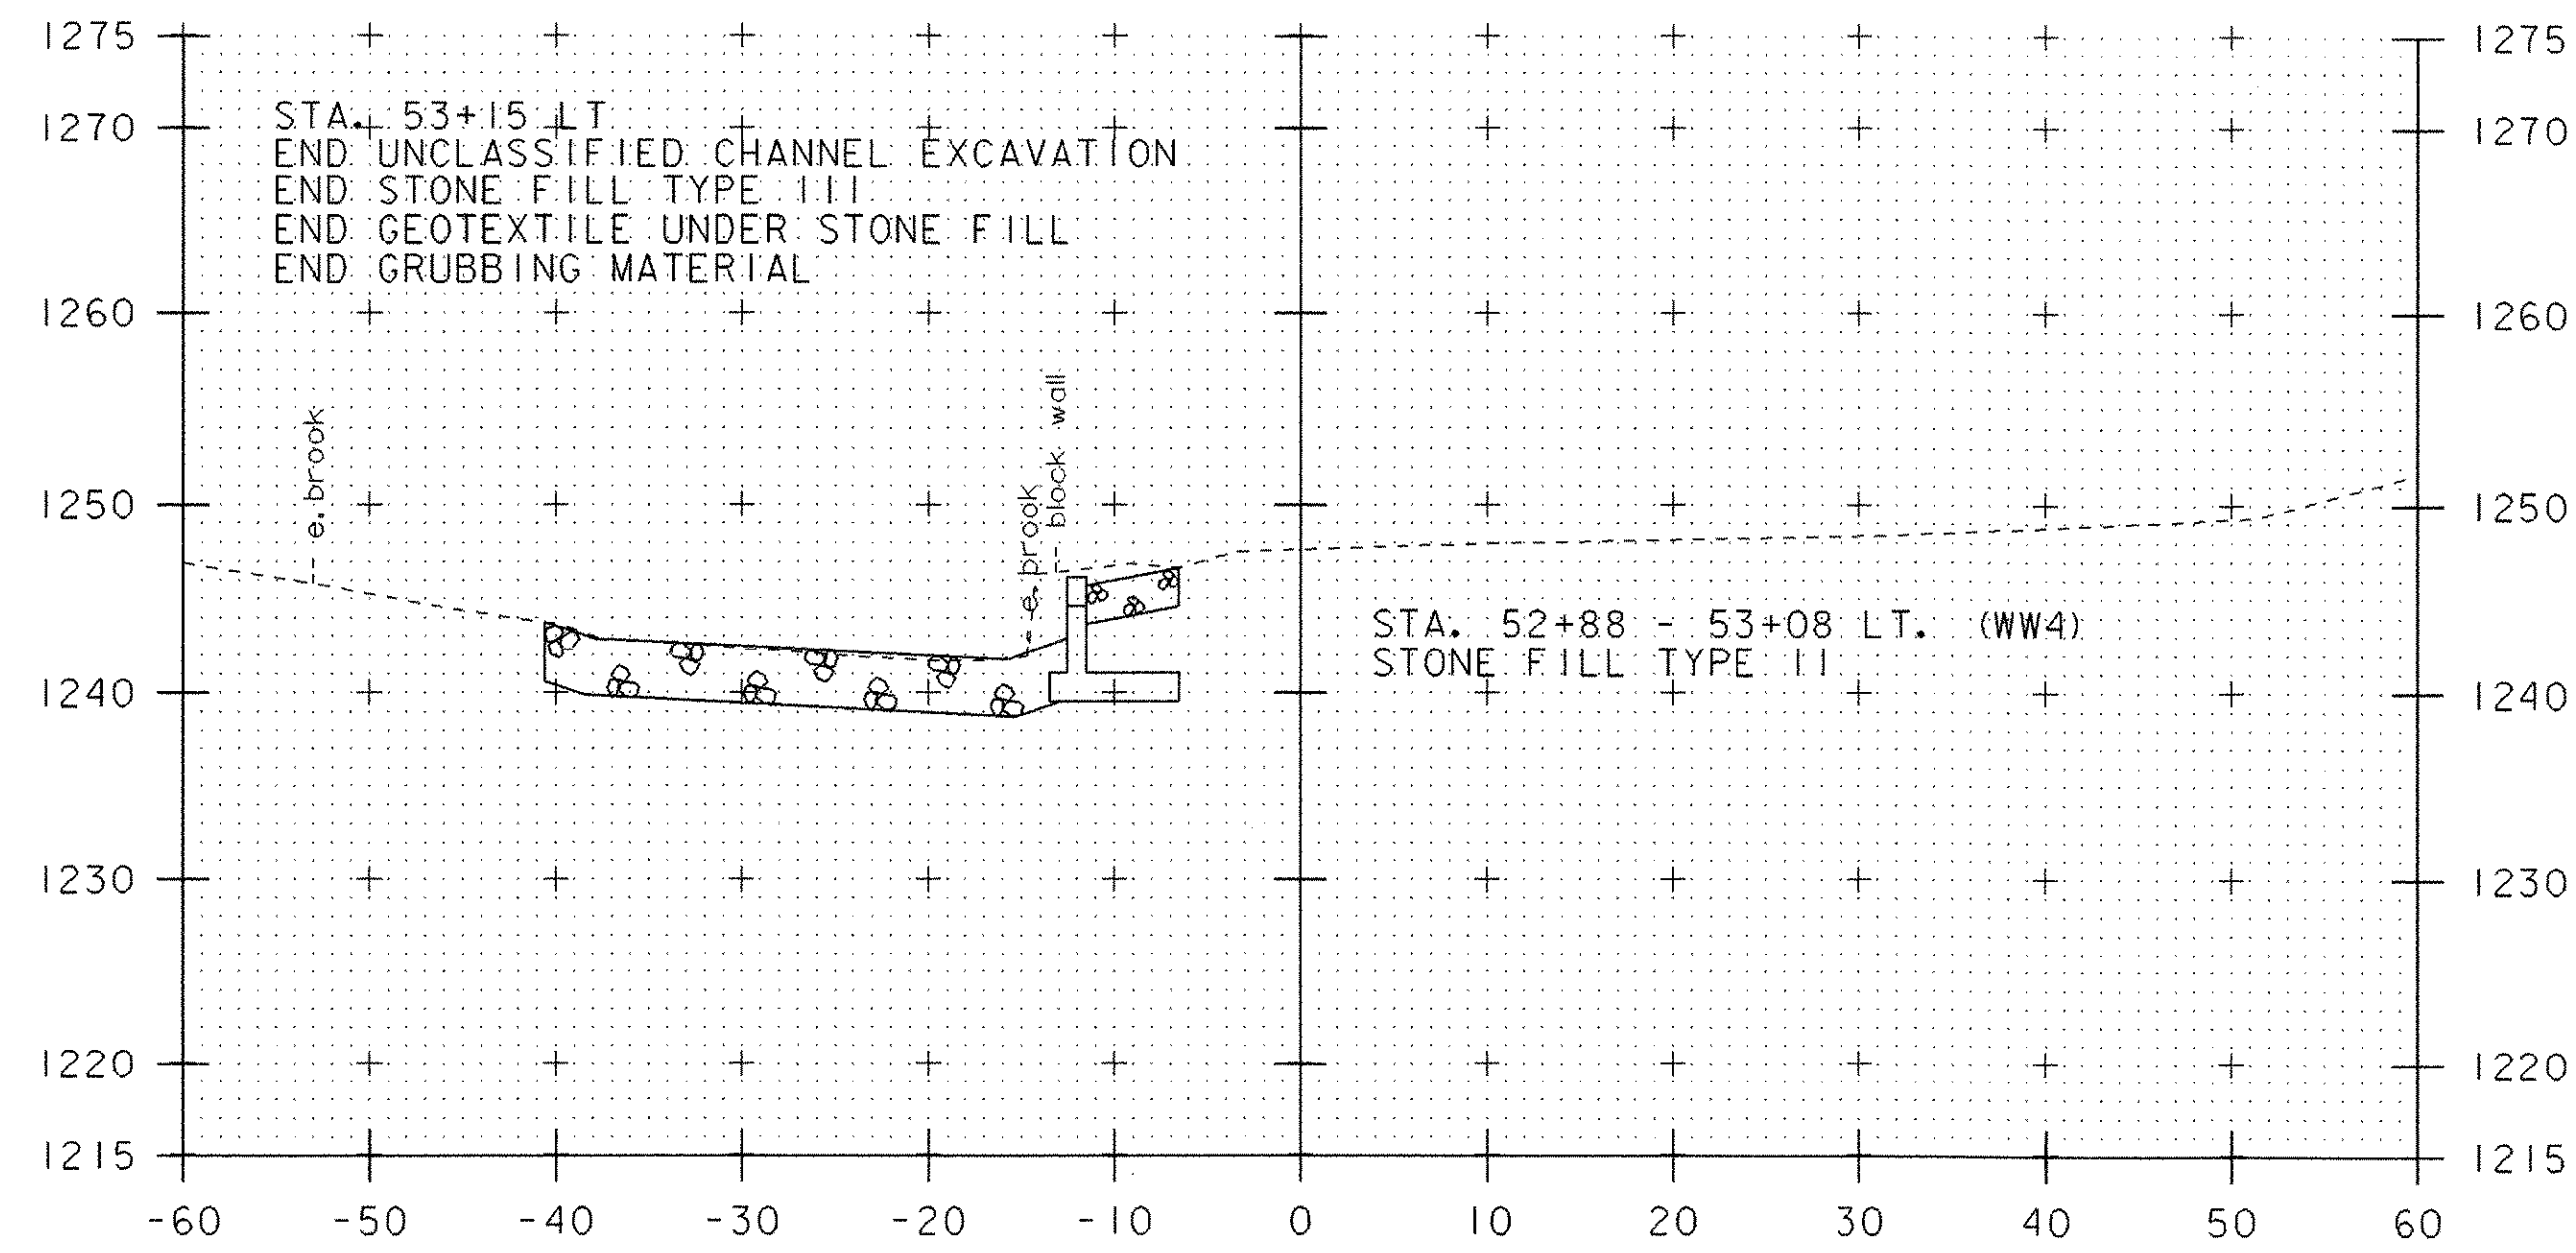


53+00

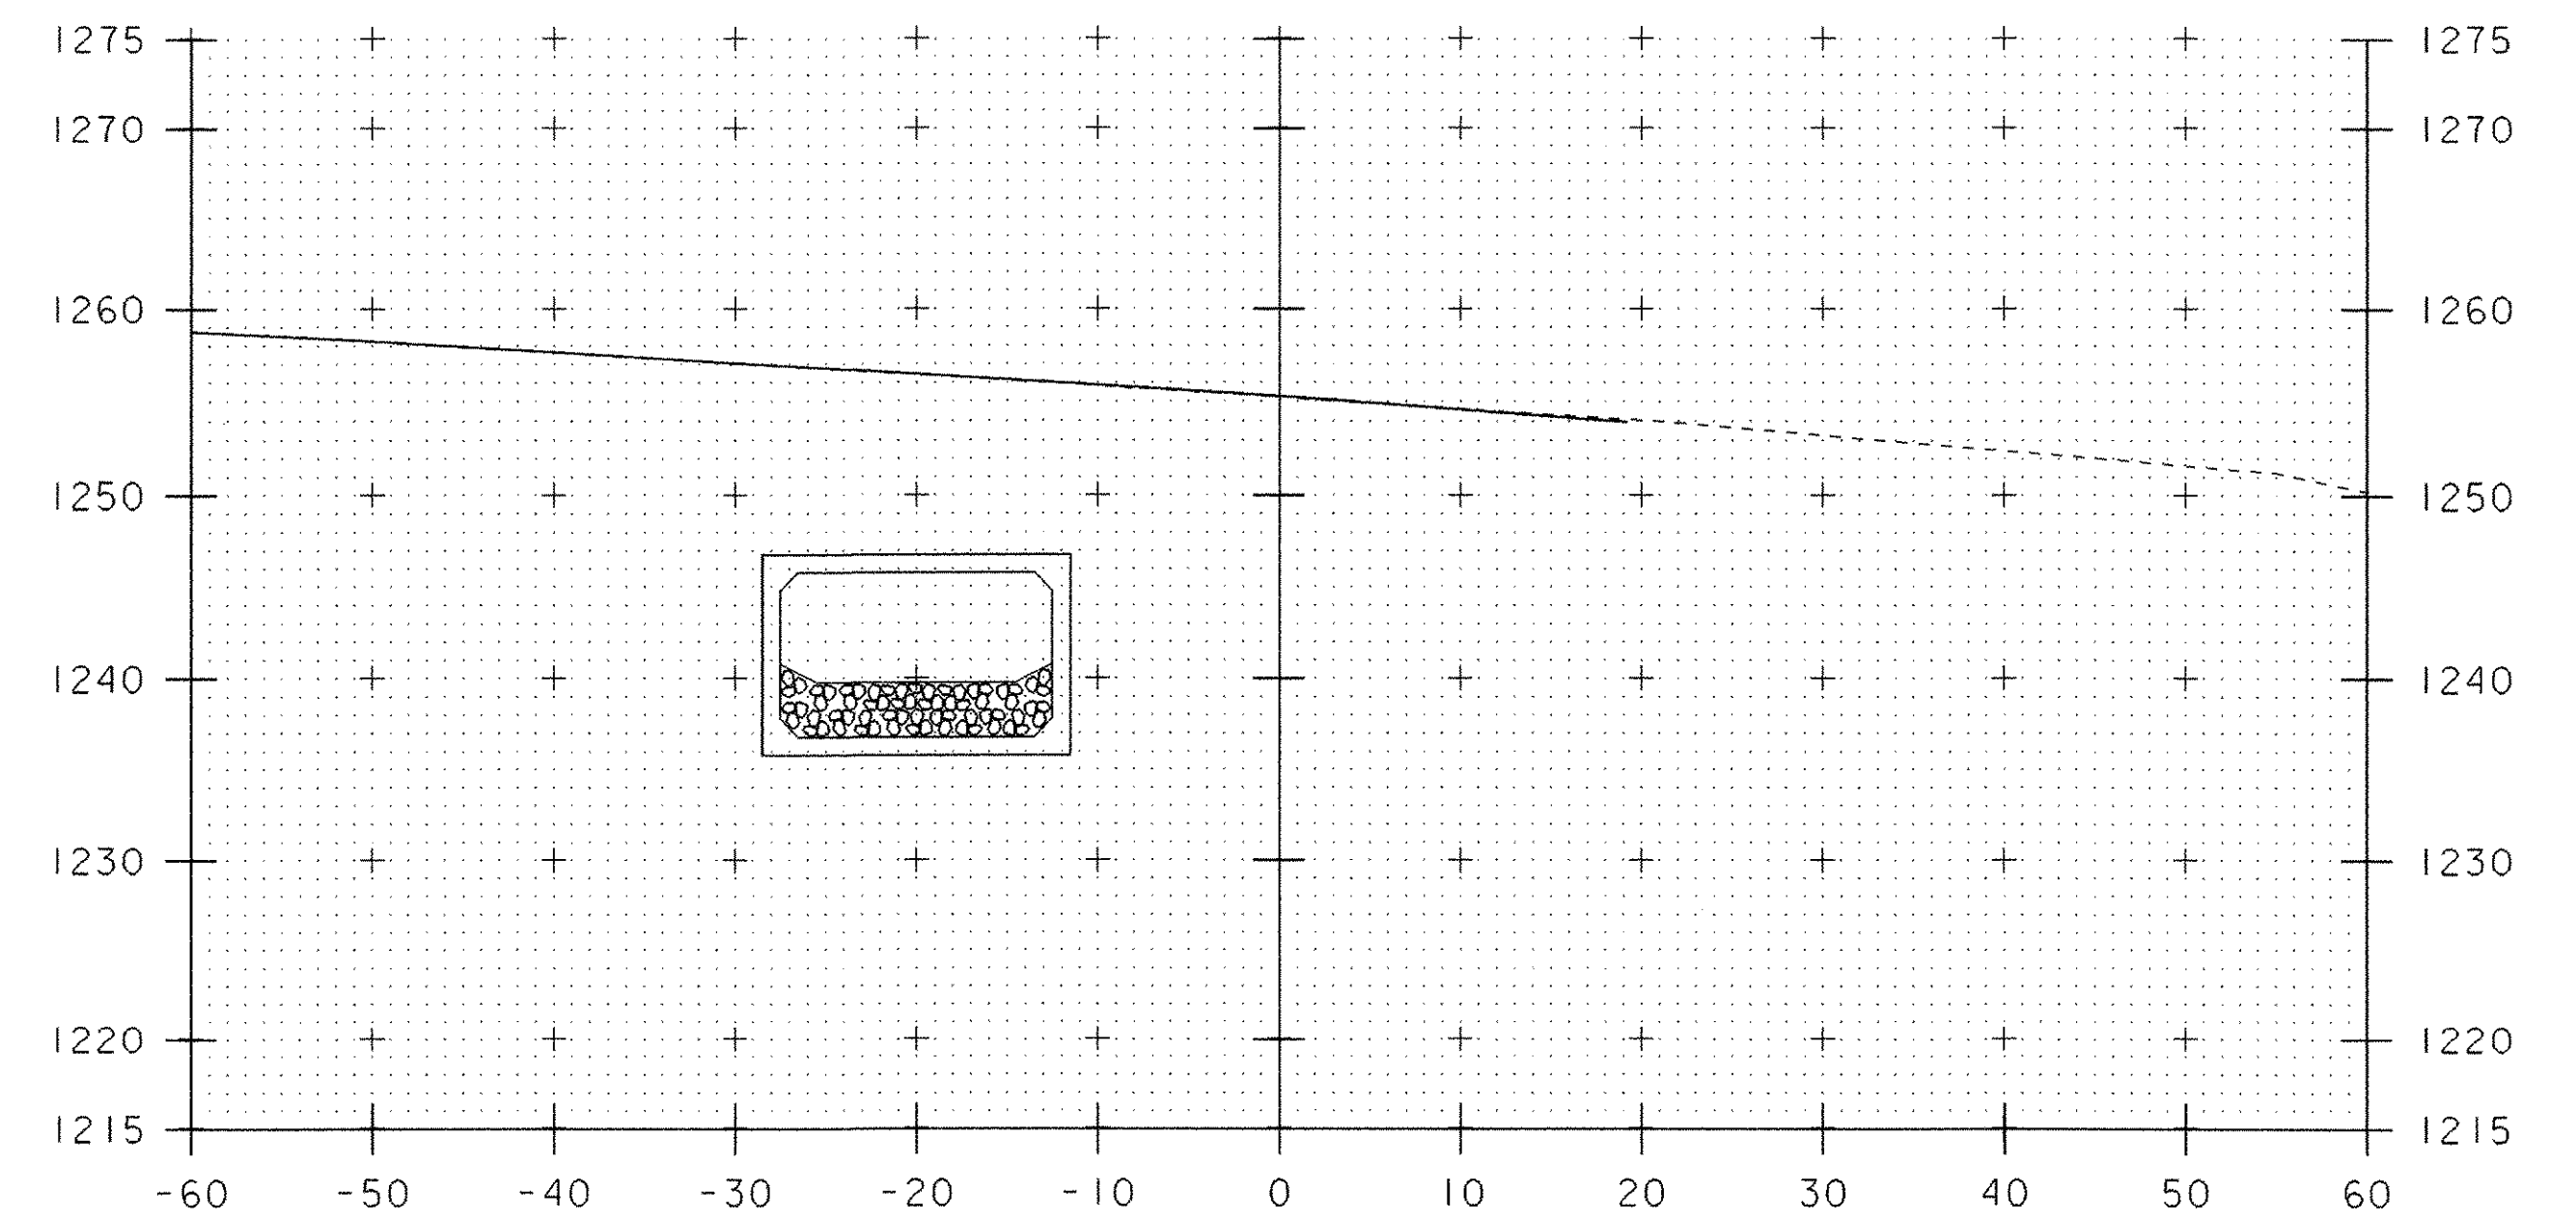

53+40

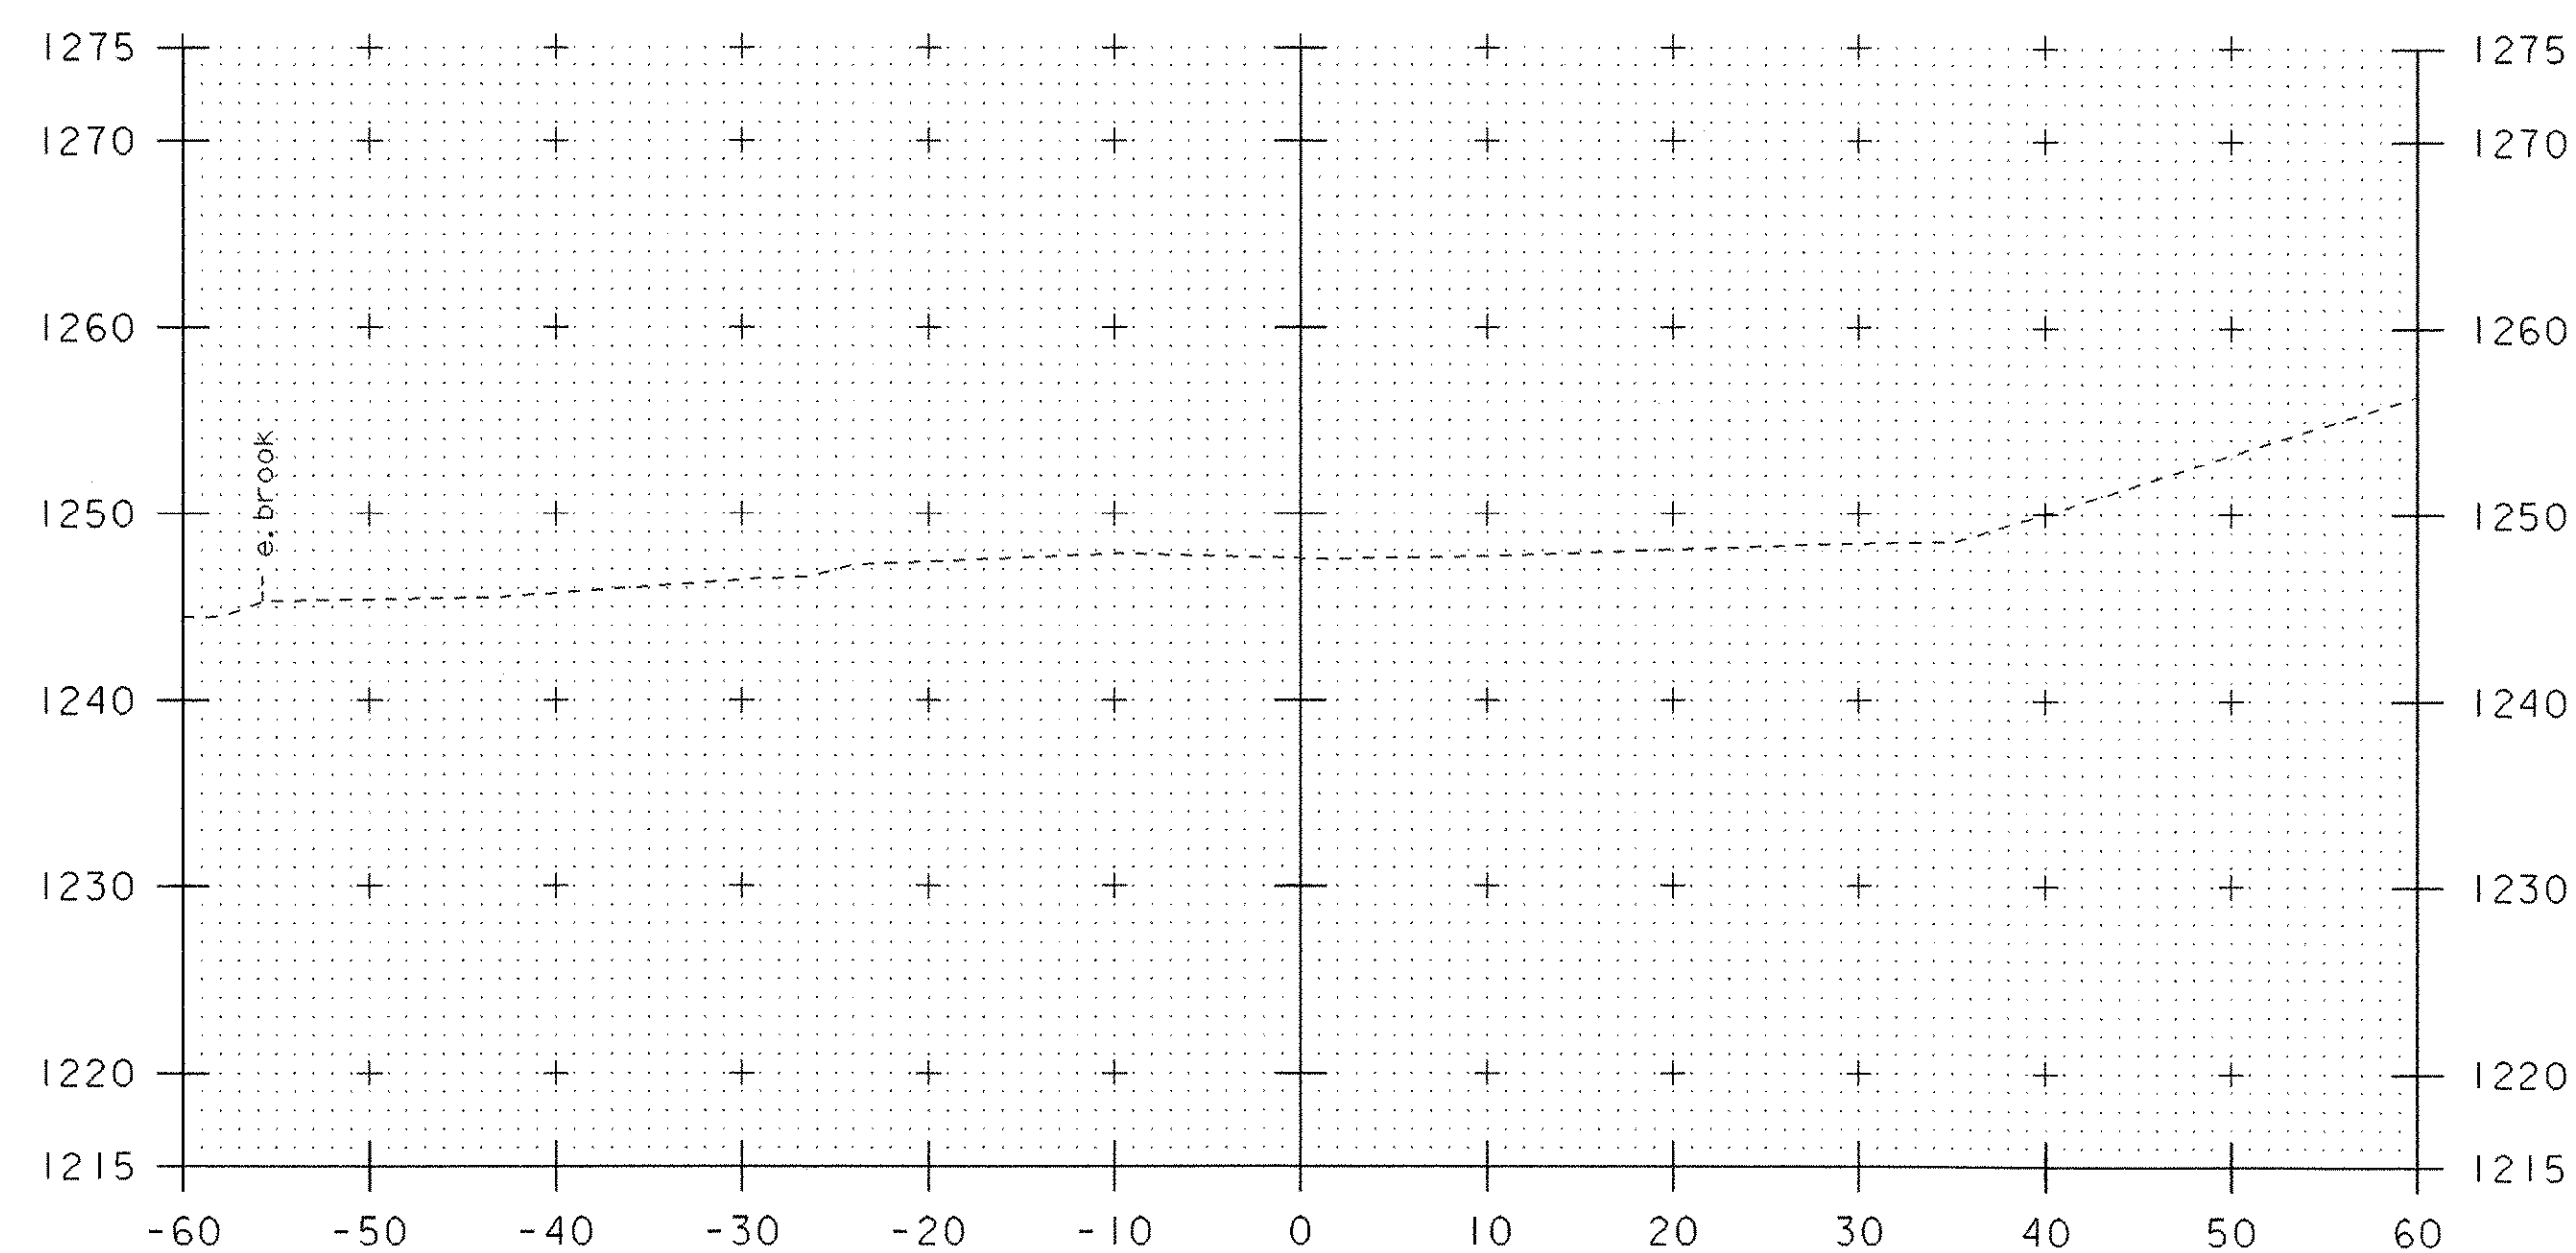

52+80

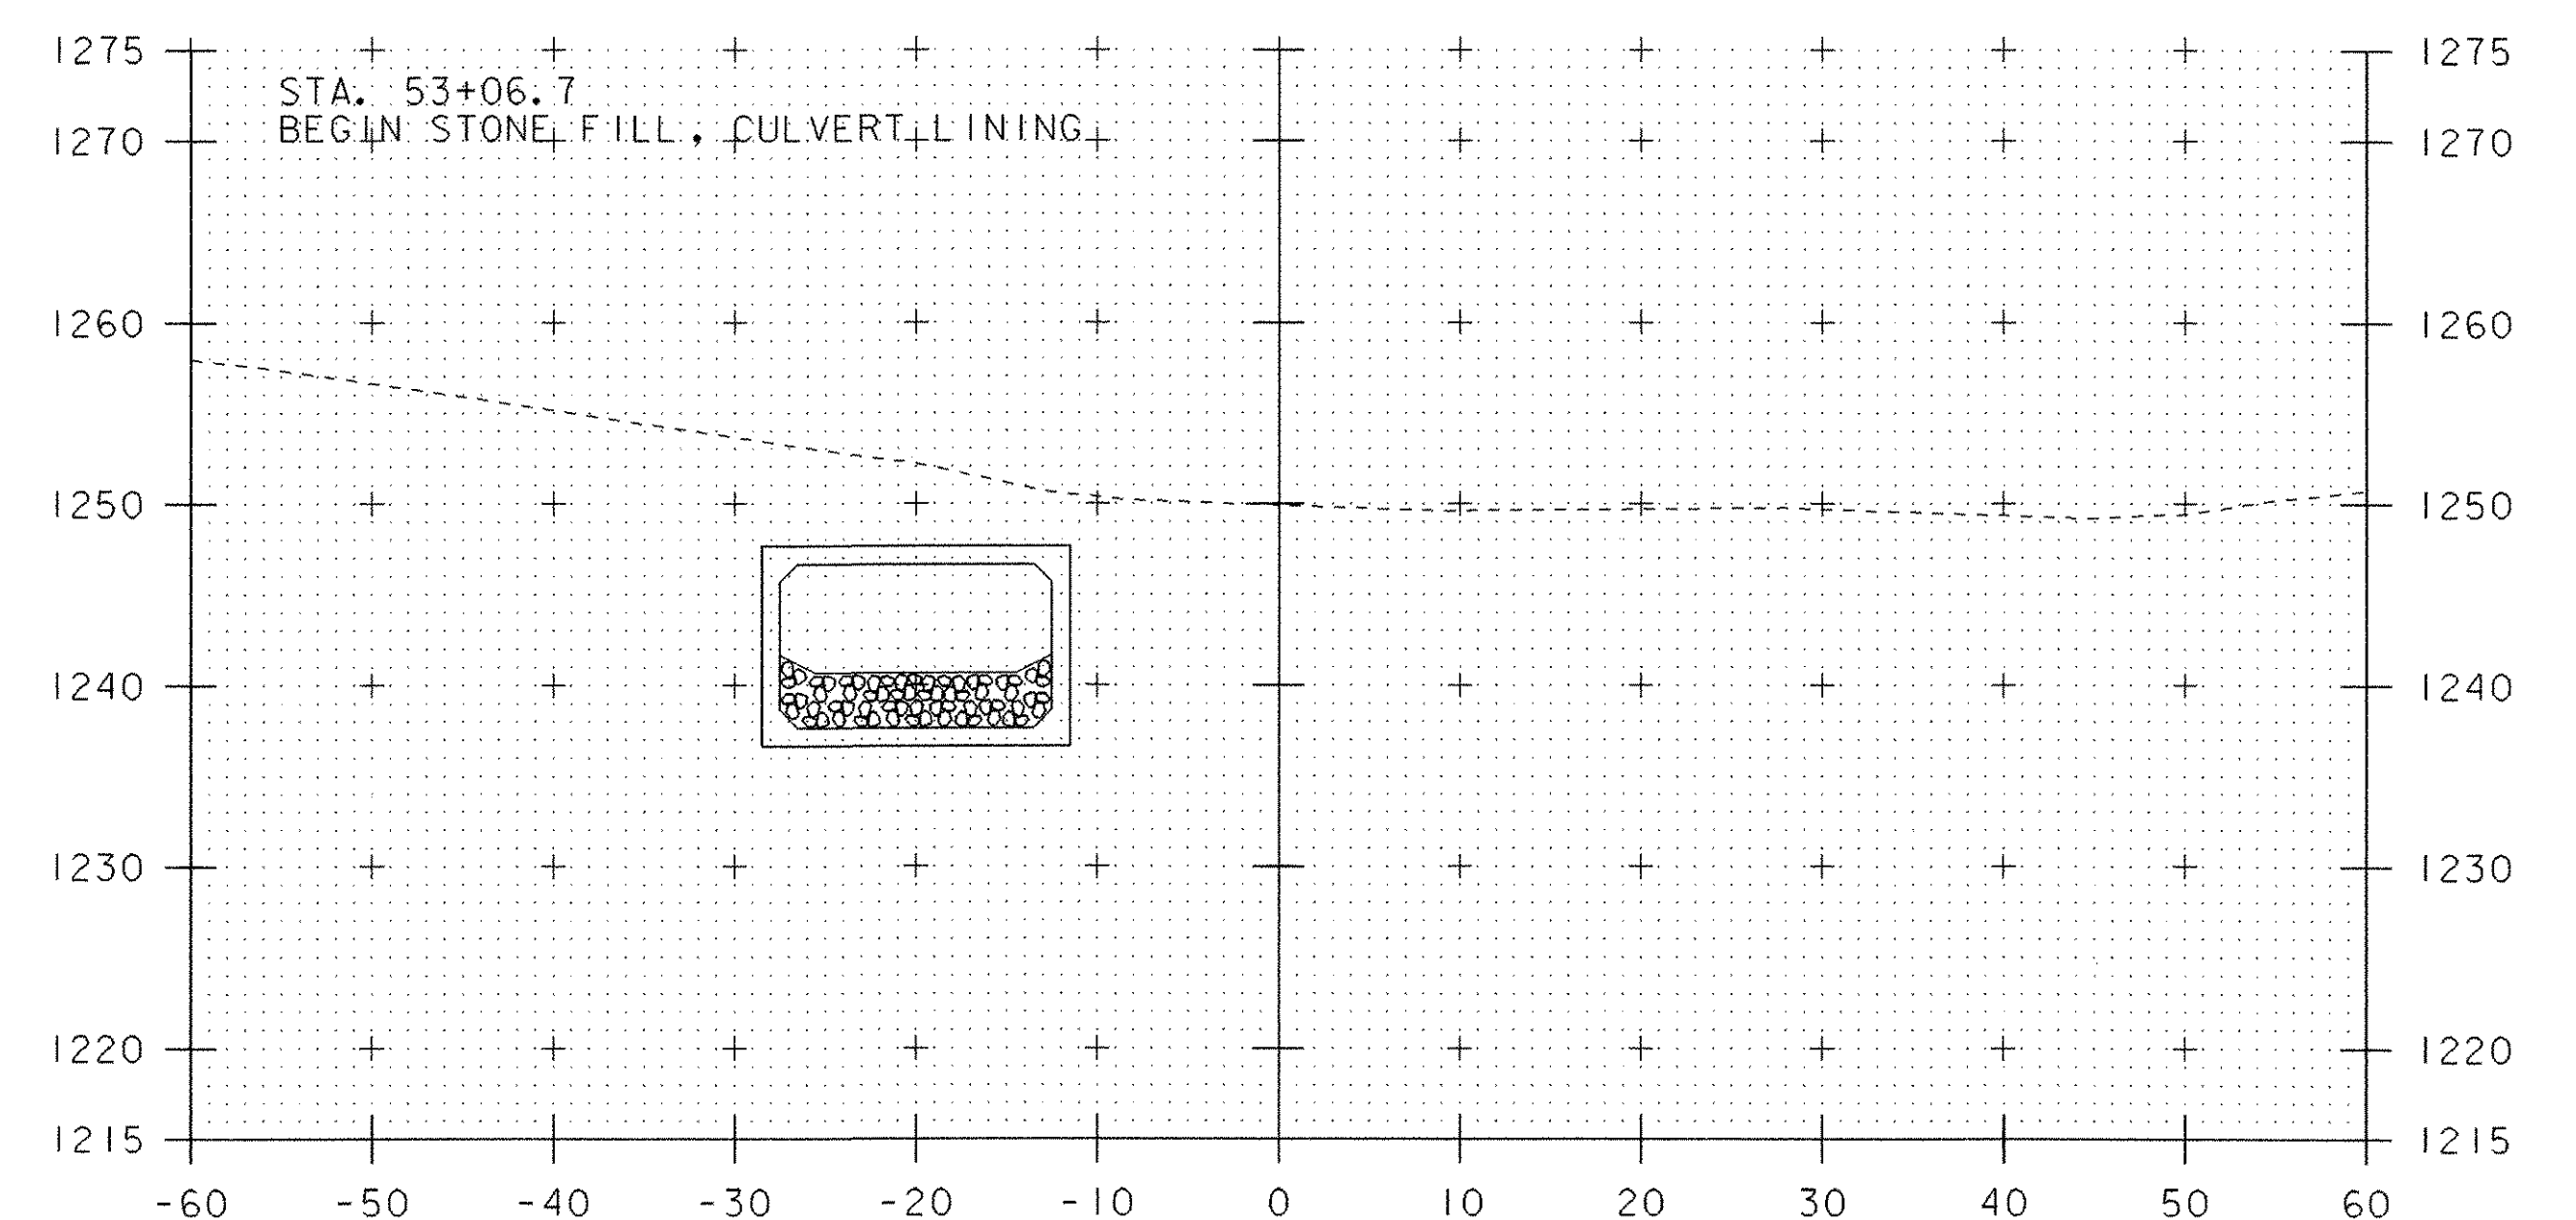


53+20

53+06.7  
BEGIN BOX


**CHANNEL CROSS SECTIONS**

PROJECT NAME:	JAY	FILE NAME:	04b140\s04b140bdr.dgn	PLOT DATE:	23-OCT-2006
PROJECT NUMBER:	ST STP CULV (2)	PROJECT LEADER:	W. SYMONDS	DRAWN BY:	G. SHANGRAW
		DESIGNED BY:	T. SUMNER	CHECKED BY:	J. LACROIX
			04b140chxs2.i		SHEET 37 OF 39


53+86.2  
END BOX

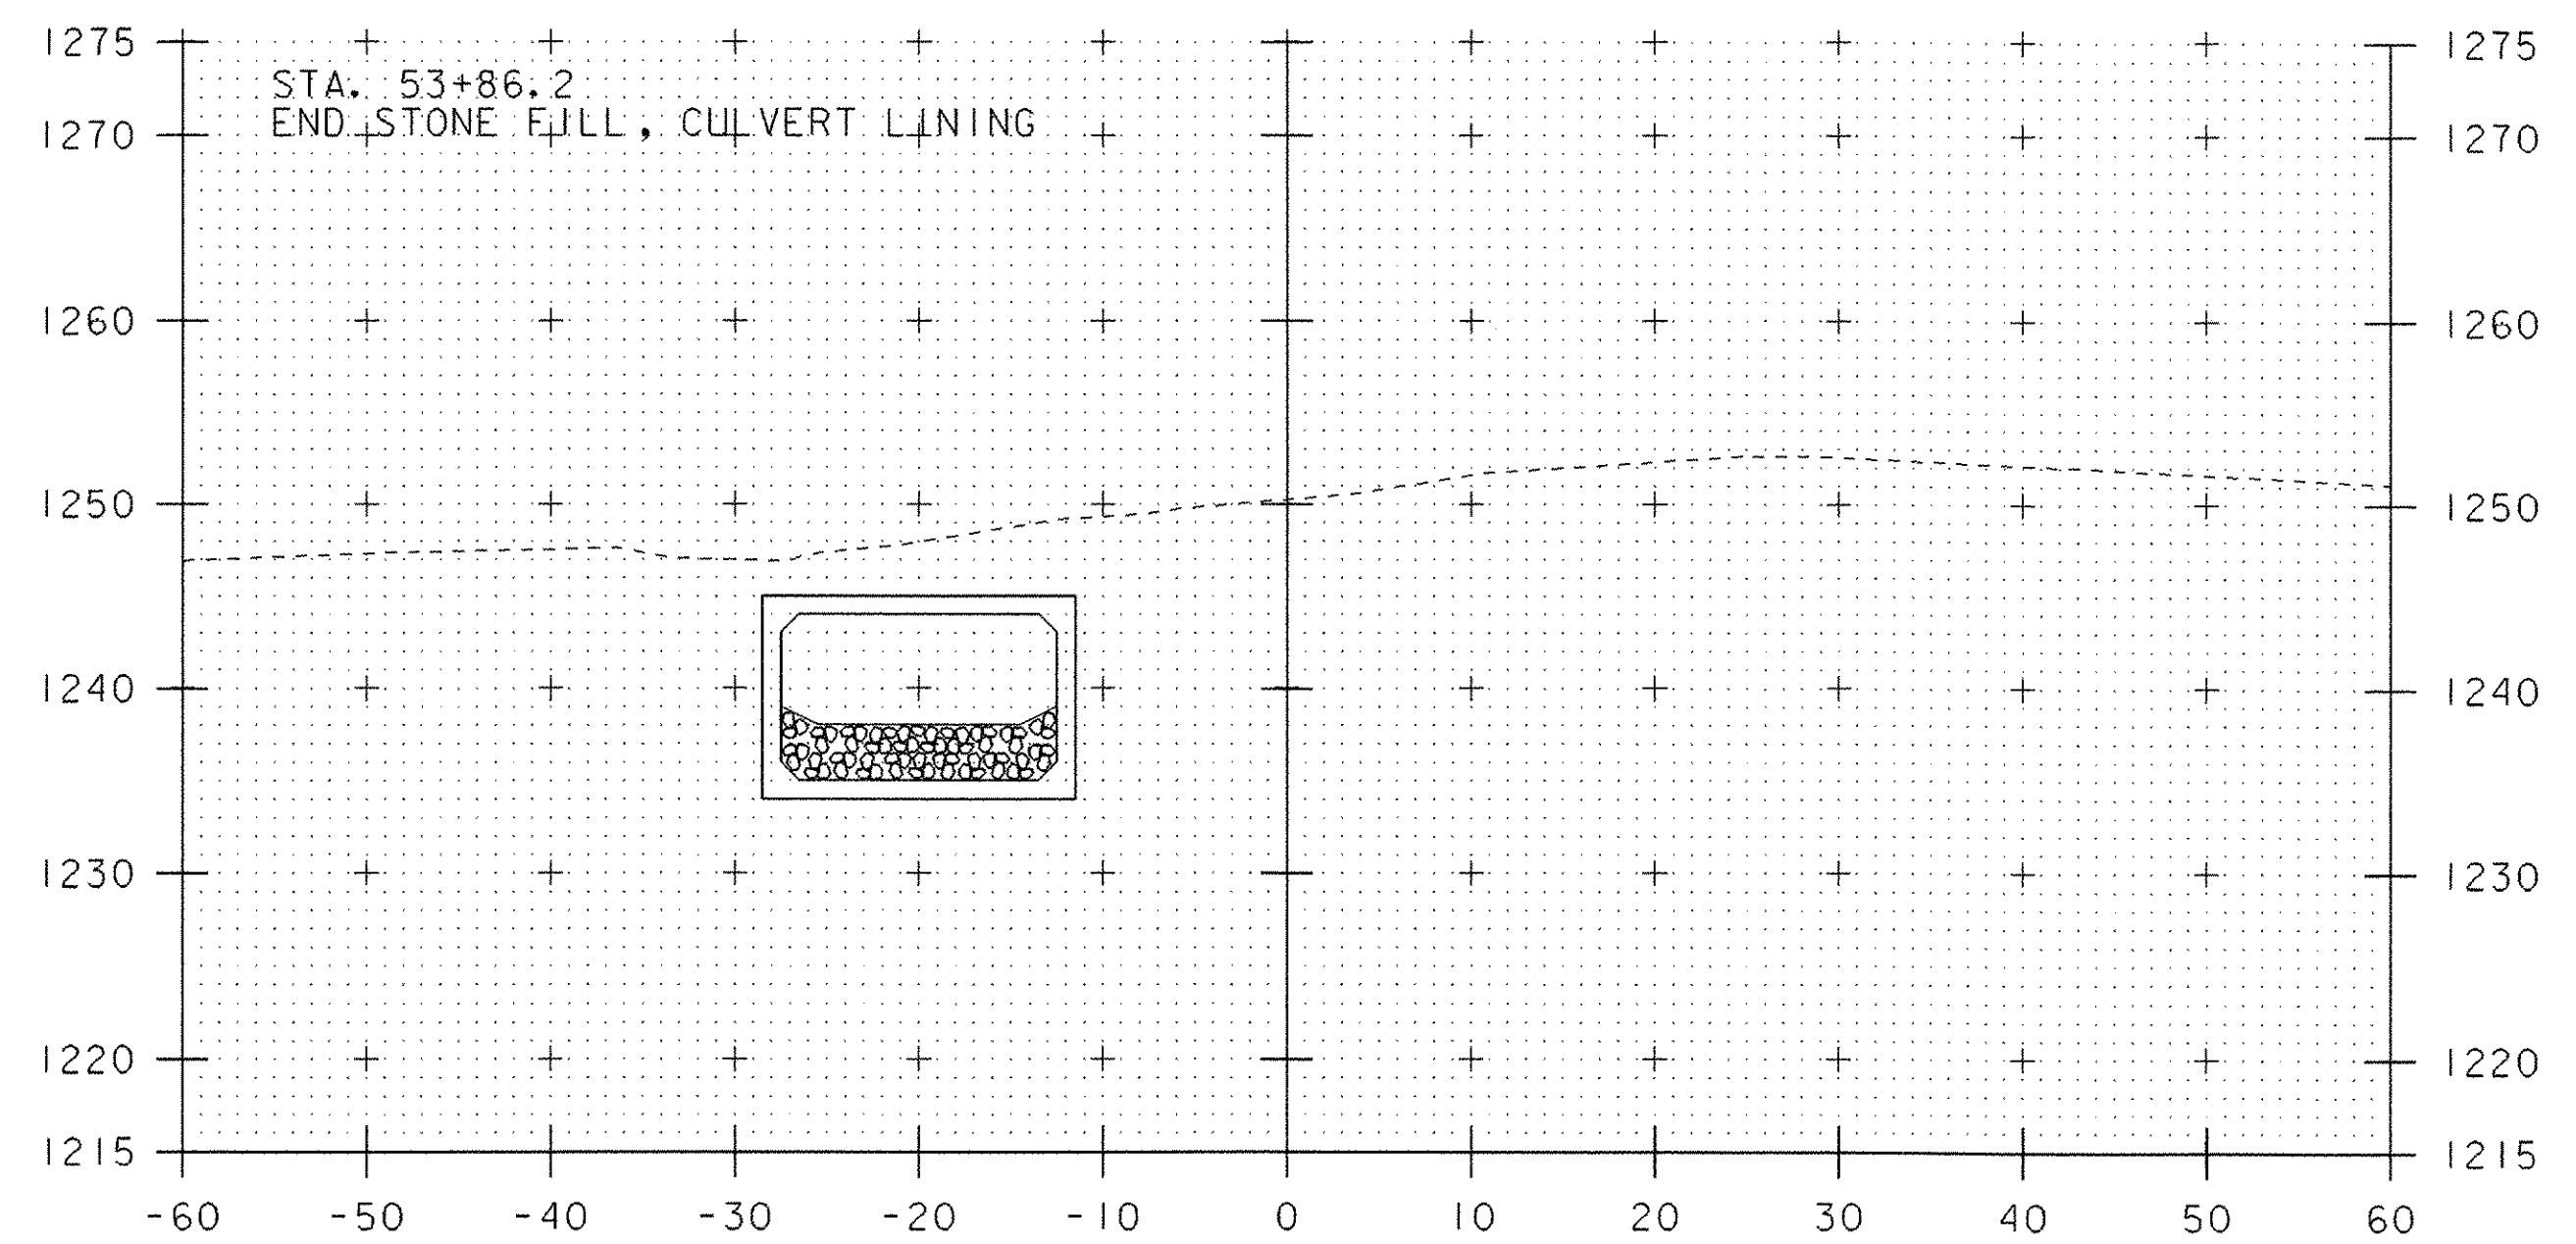


53+80

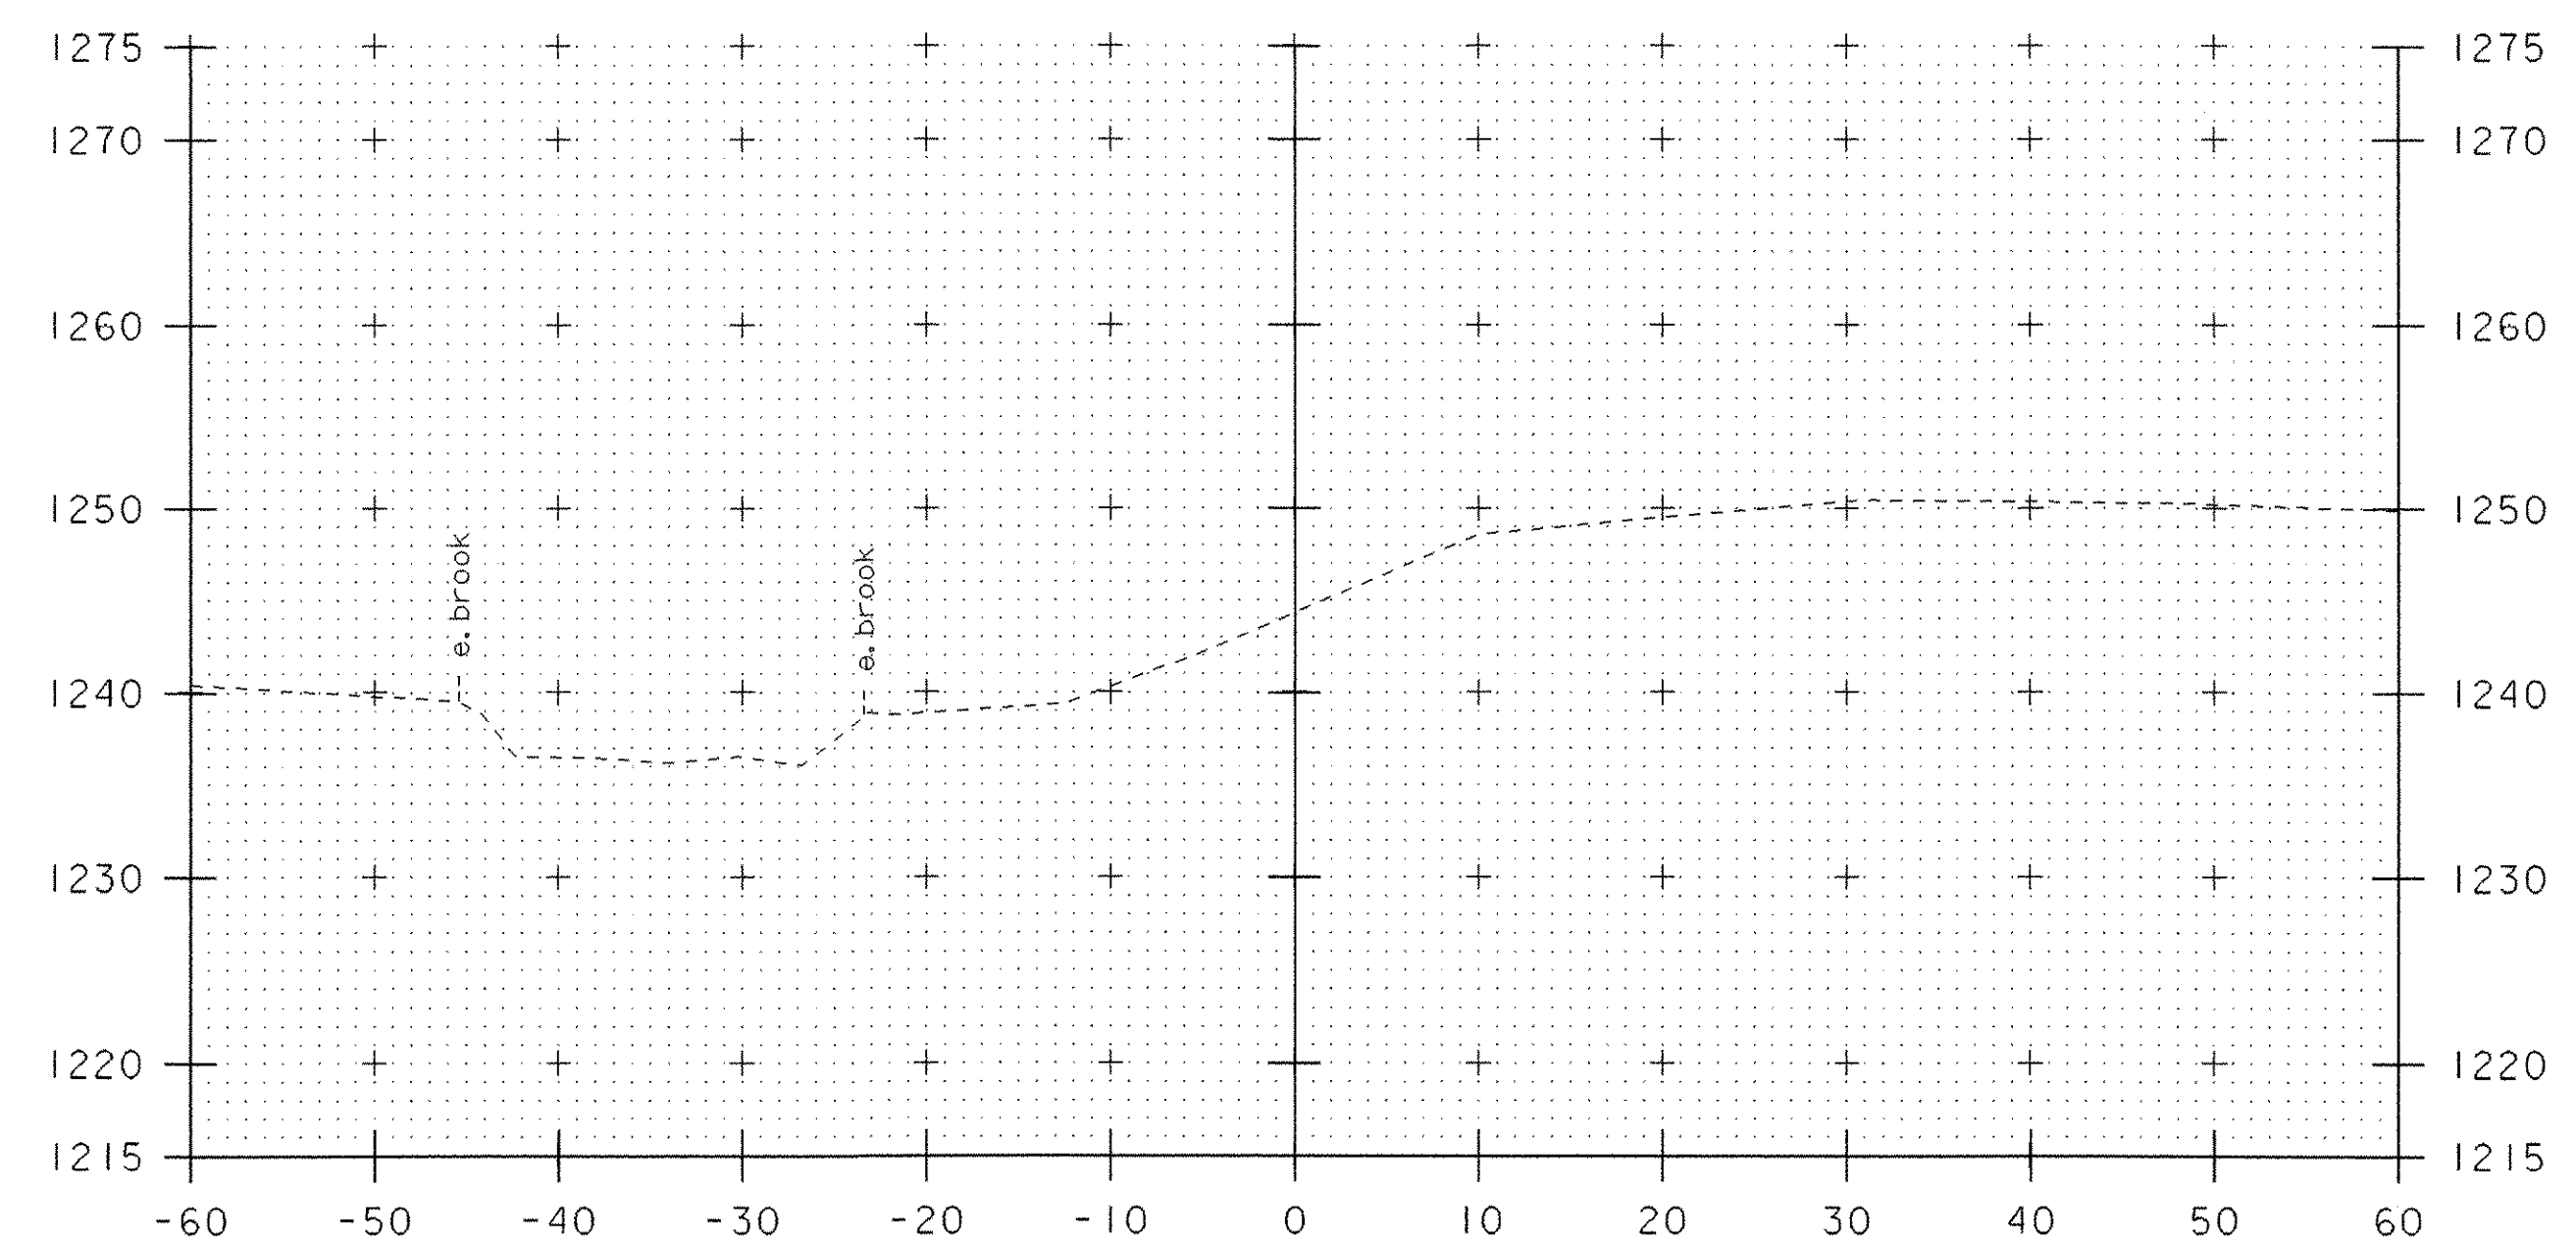

54+20

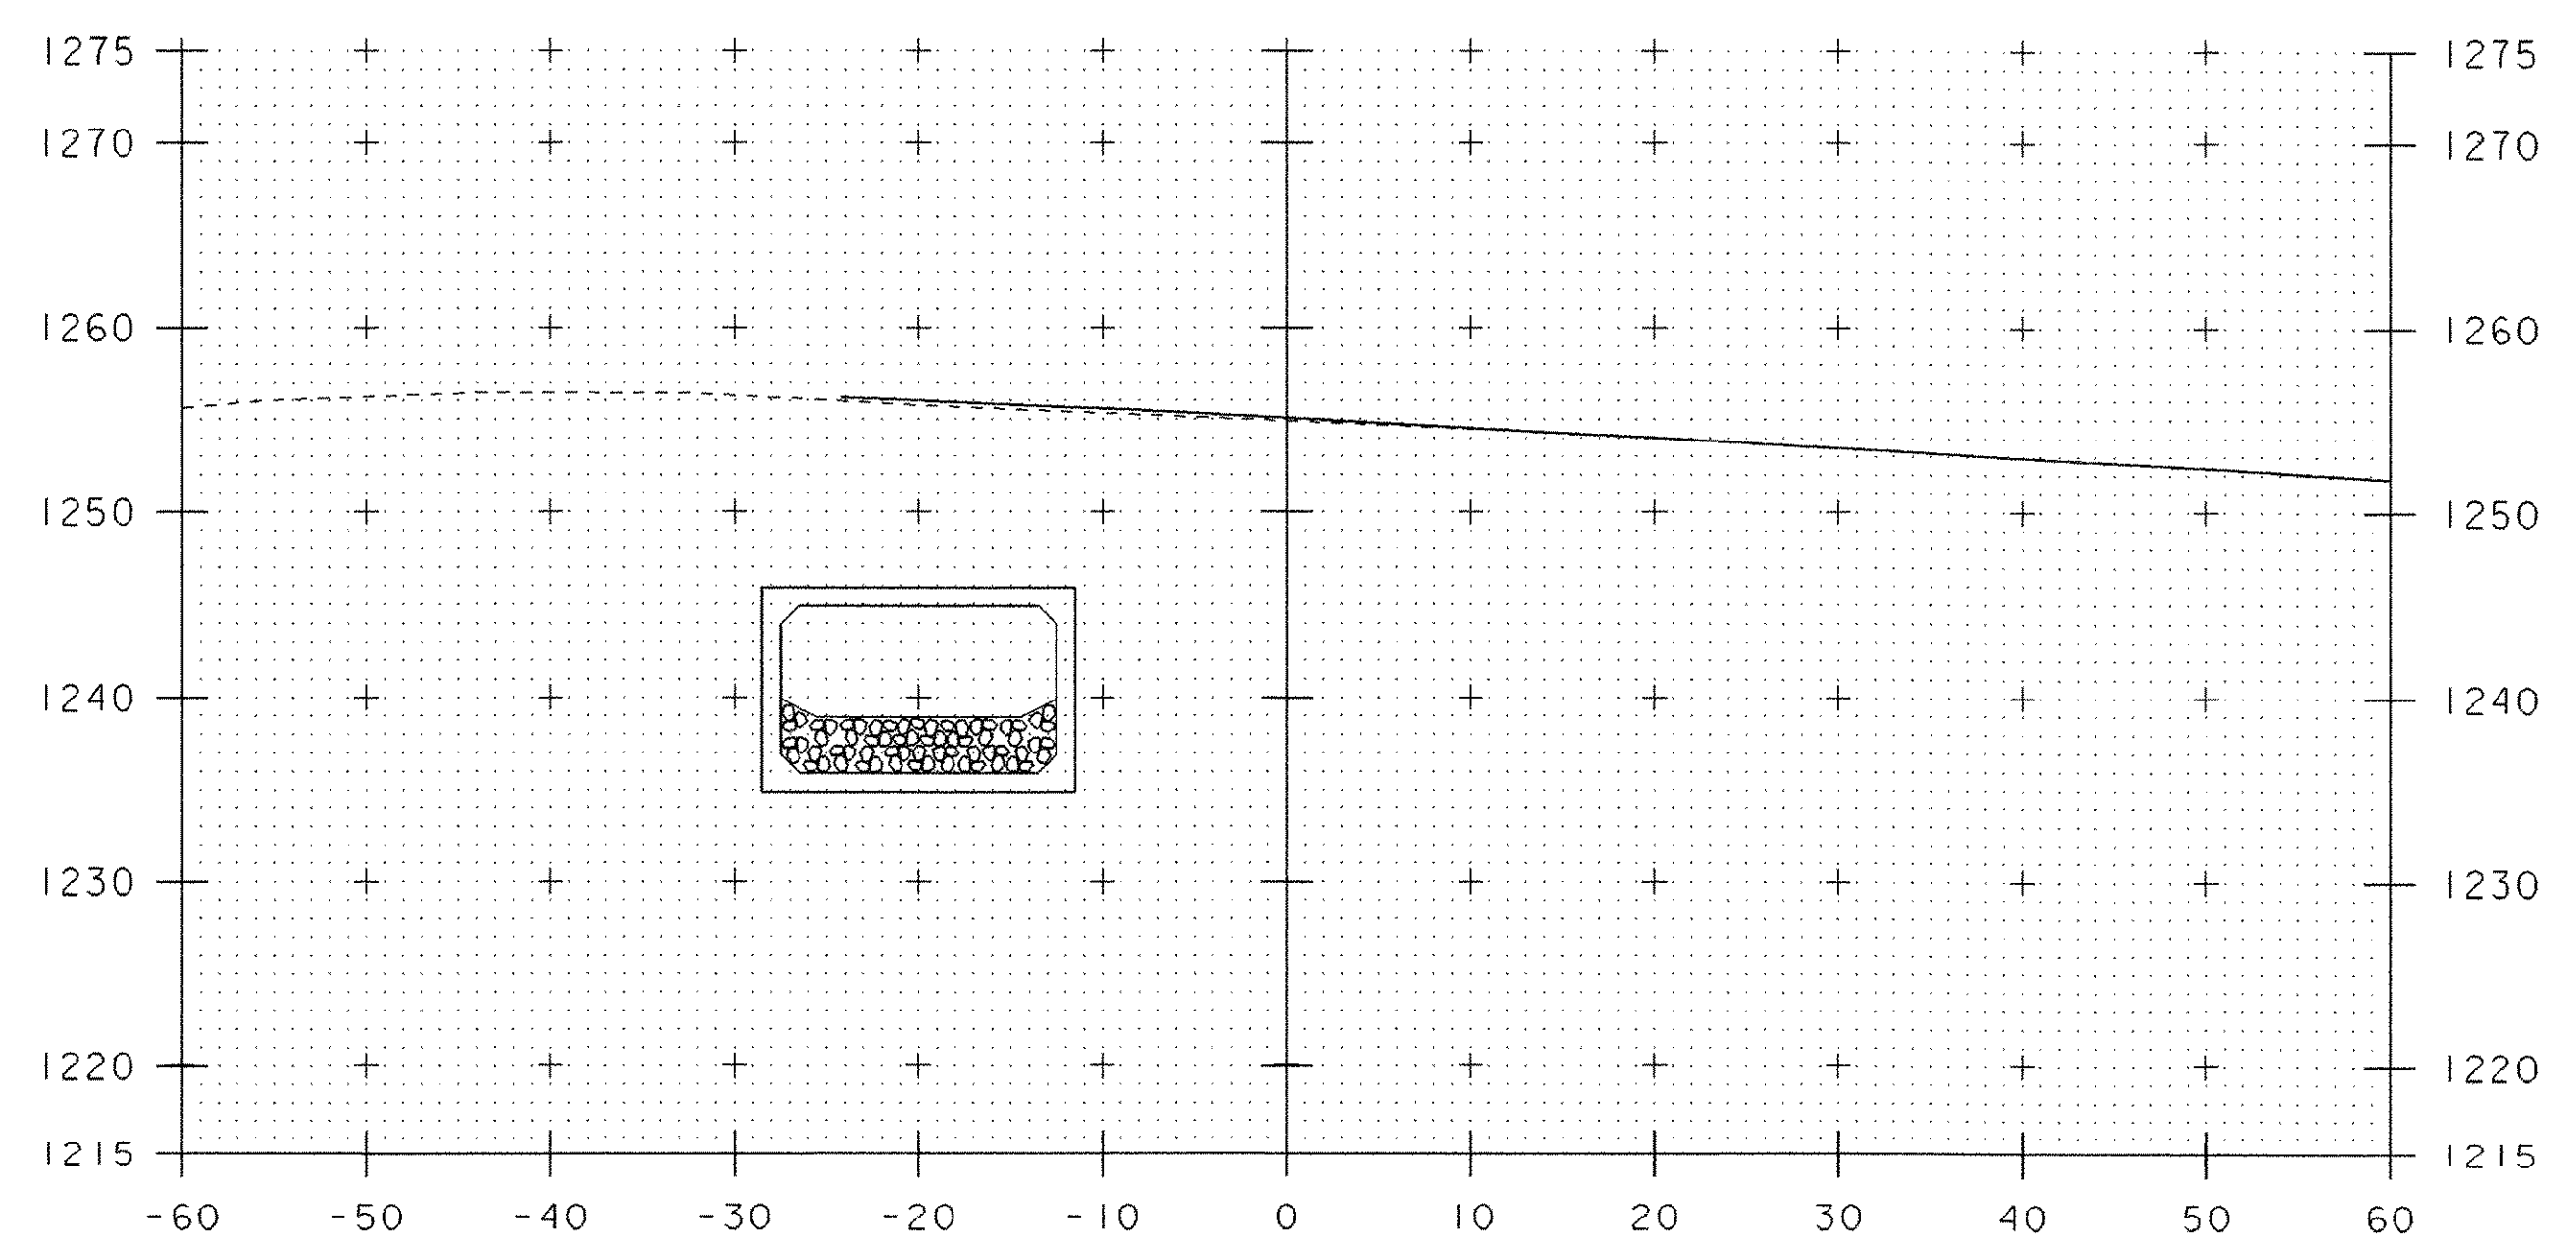


53+60

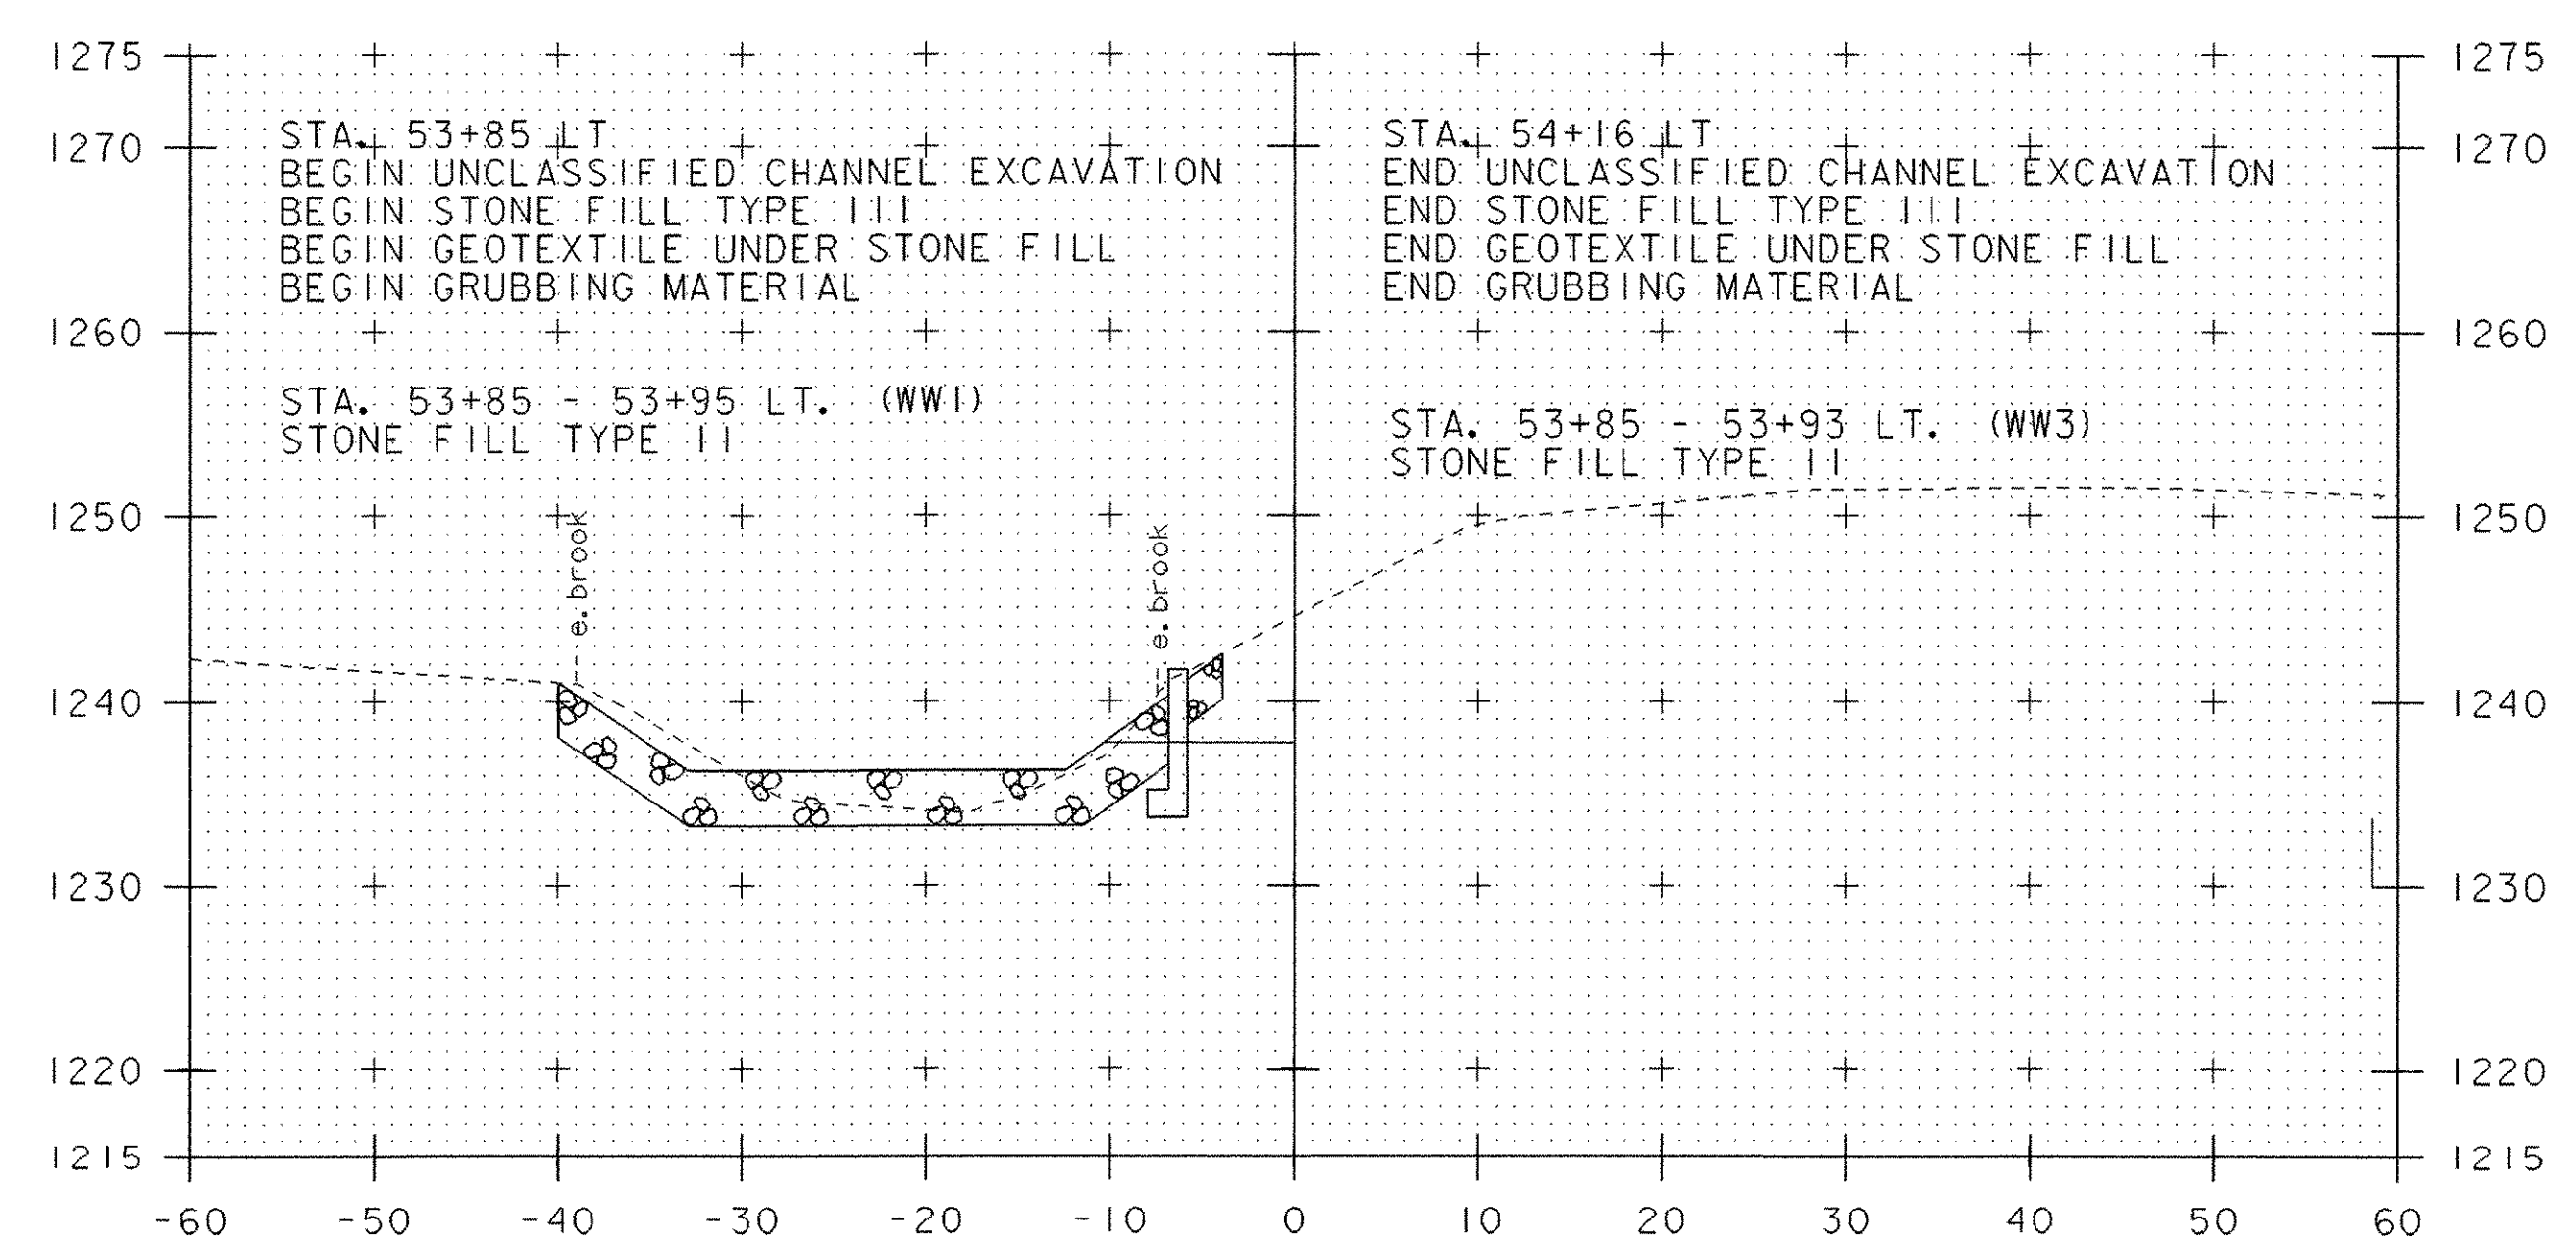


54+00

**CHANNEL CROSS SECTIONS**


PROJECT NAME:	JAY
PROJECT NUMBER:	ST STP CULV (2)
FILE NAME:	04b140\s04b140bdr.dgn
PROJECT LEADER:	W. SYMONDS
DESIGNED BY:	T. SUMNER
04b140chs3.i	
PLOT DATE:	23-OCT-2006
DRAWN BY:	G. SHANGRAW
CHECKED BY:	J. LACROIX
SHEET	38 OF 39

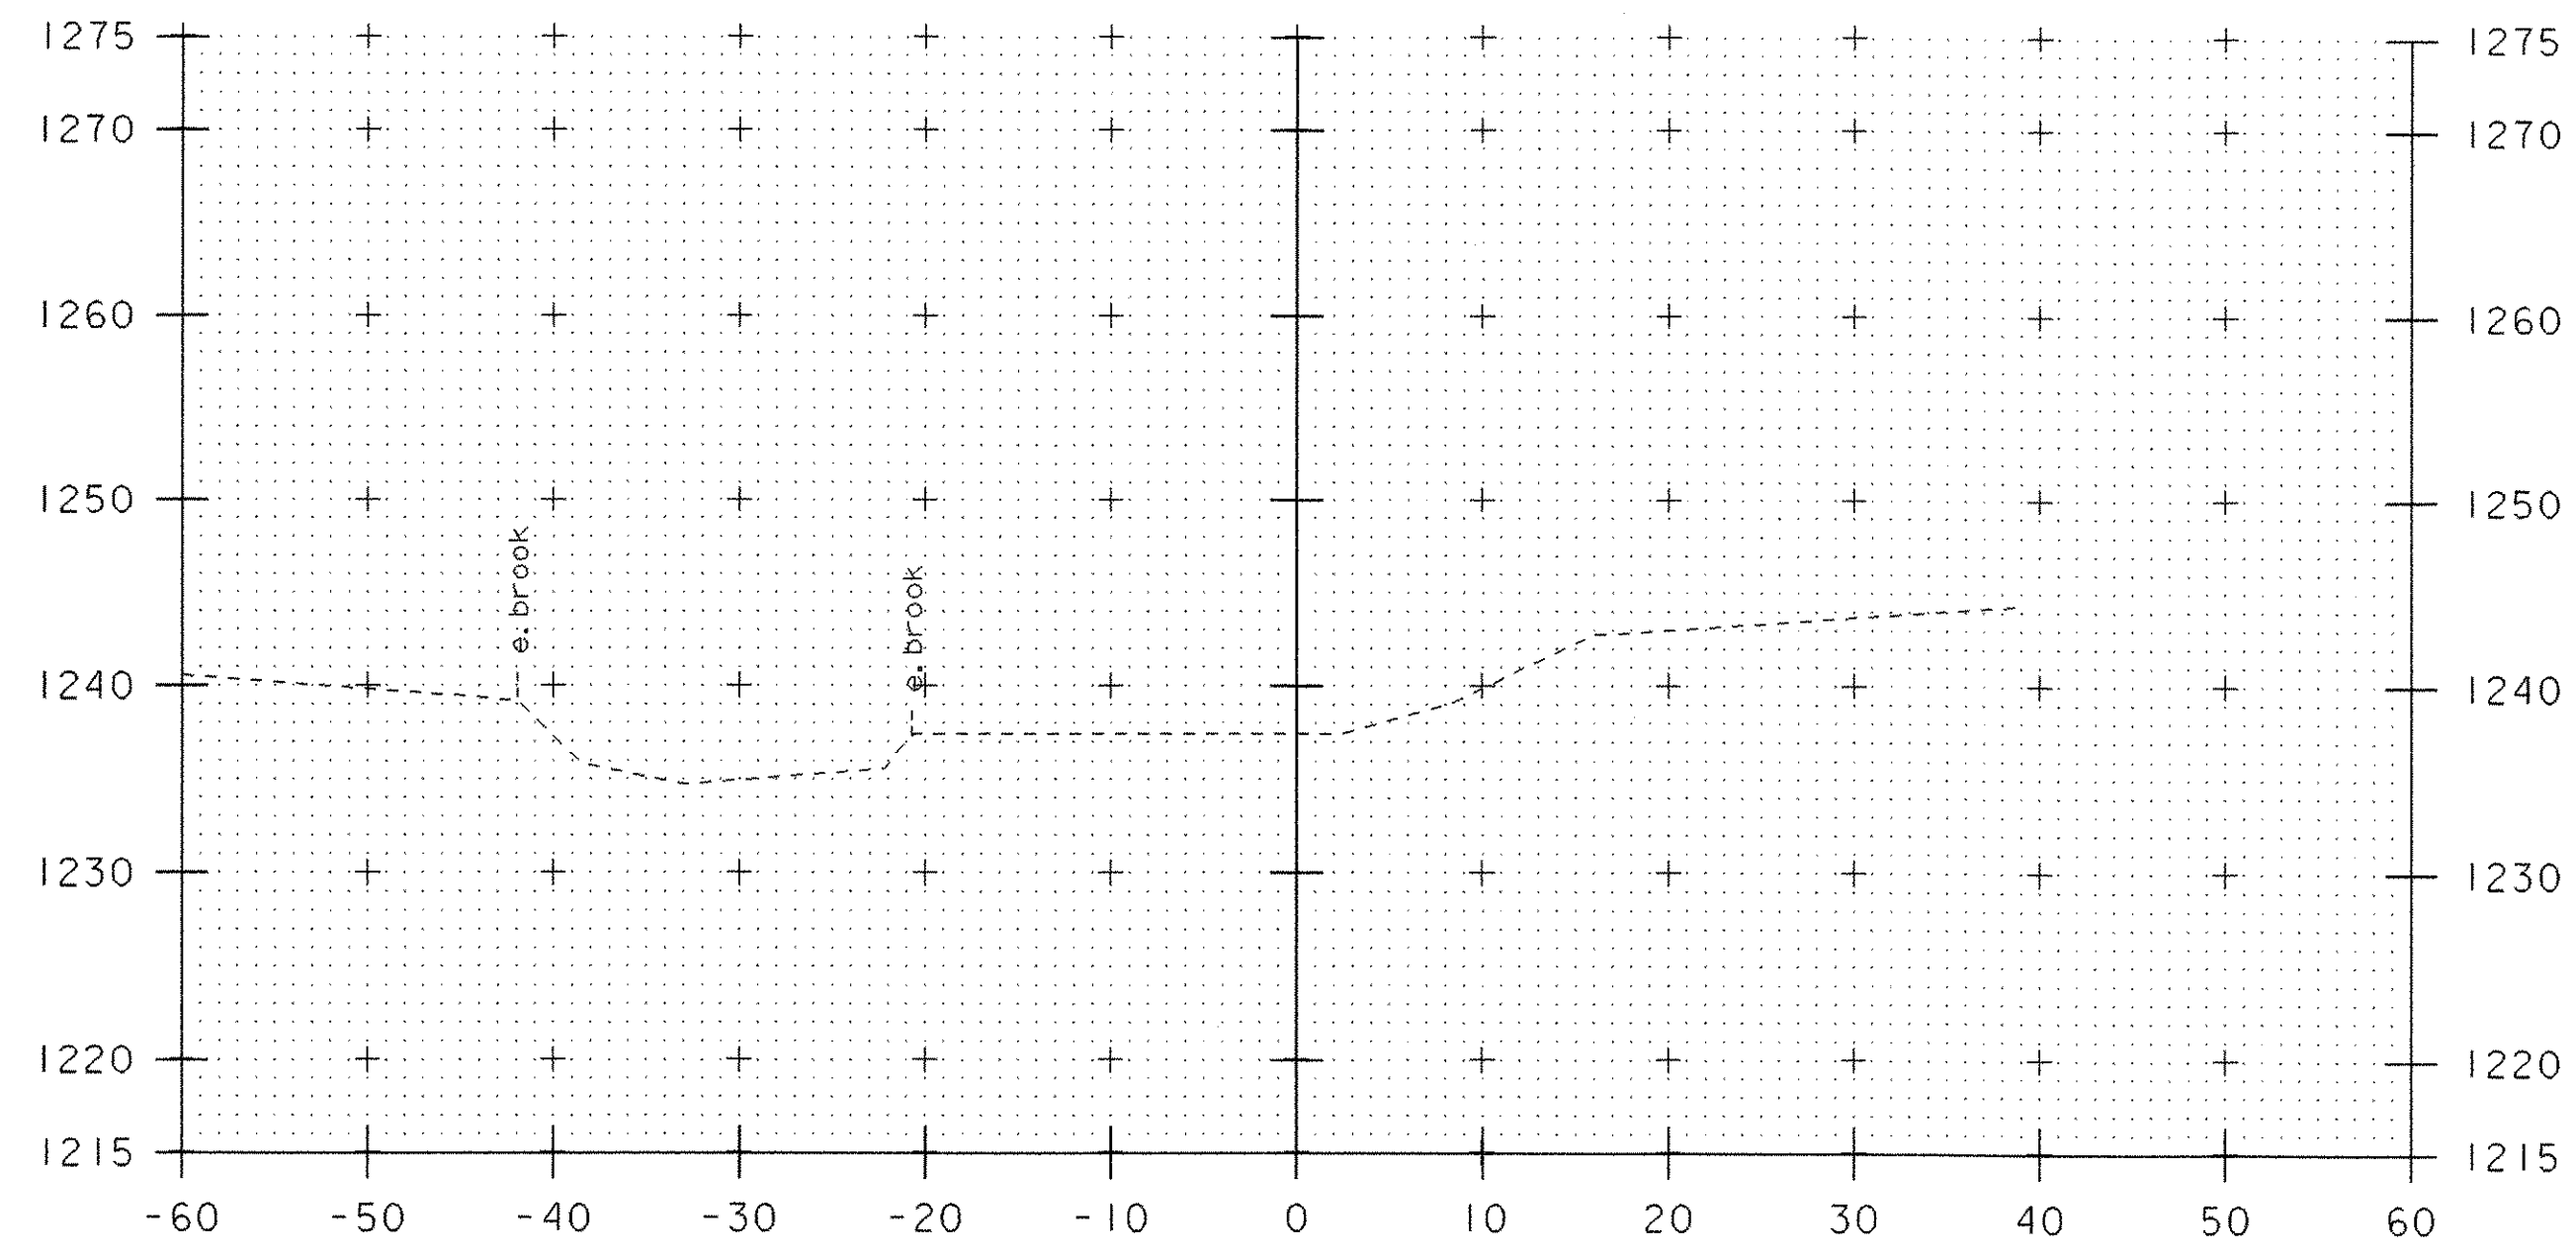


54+60

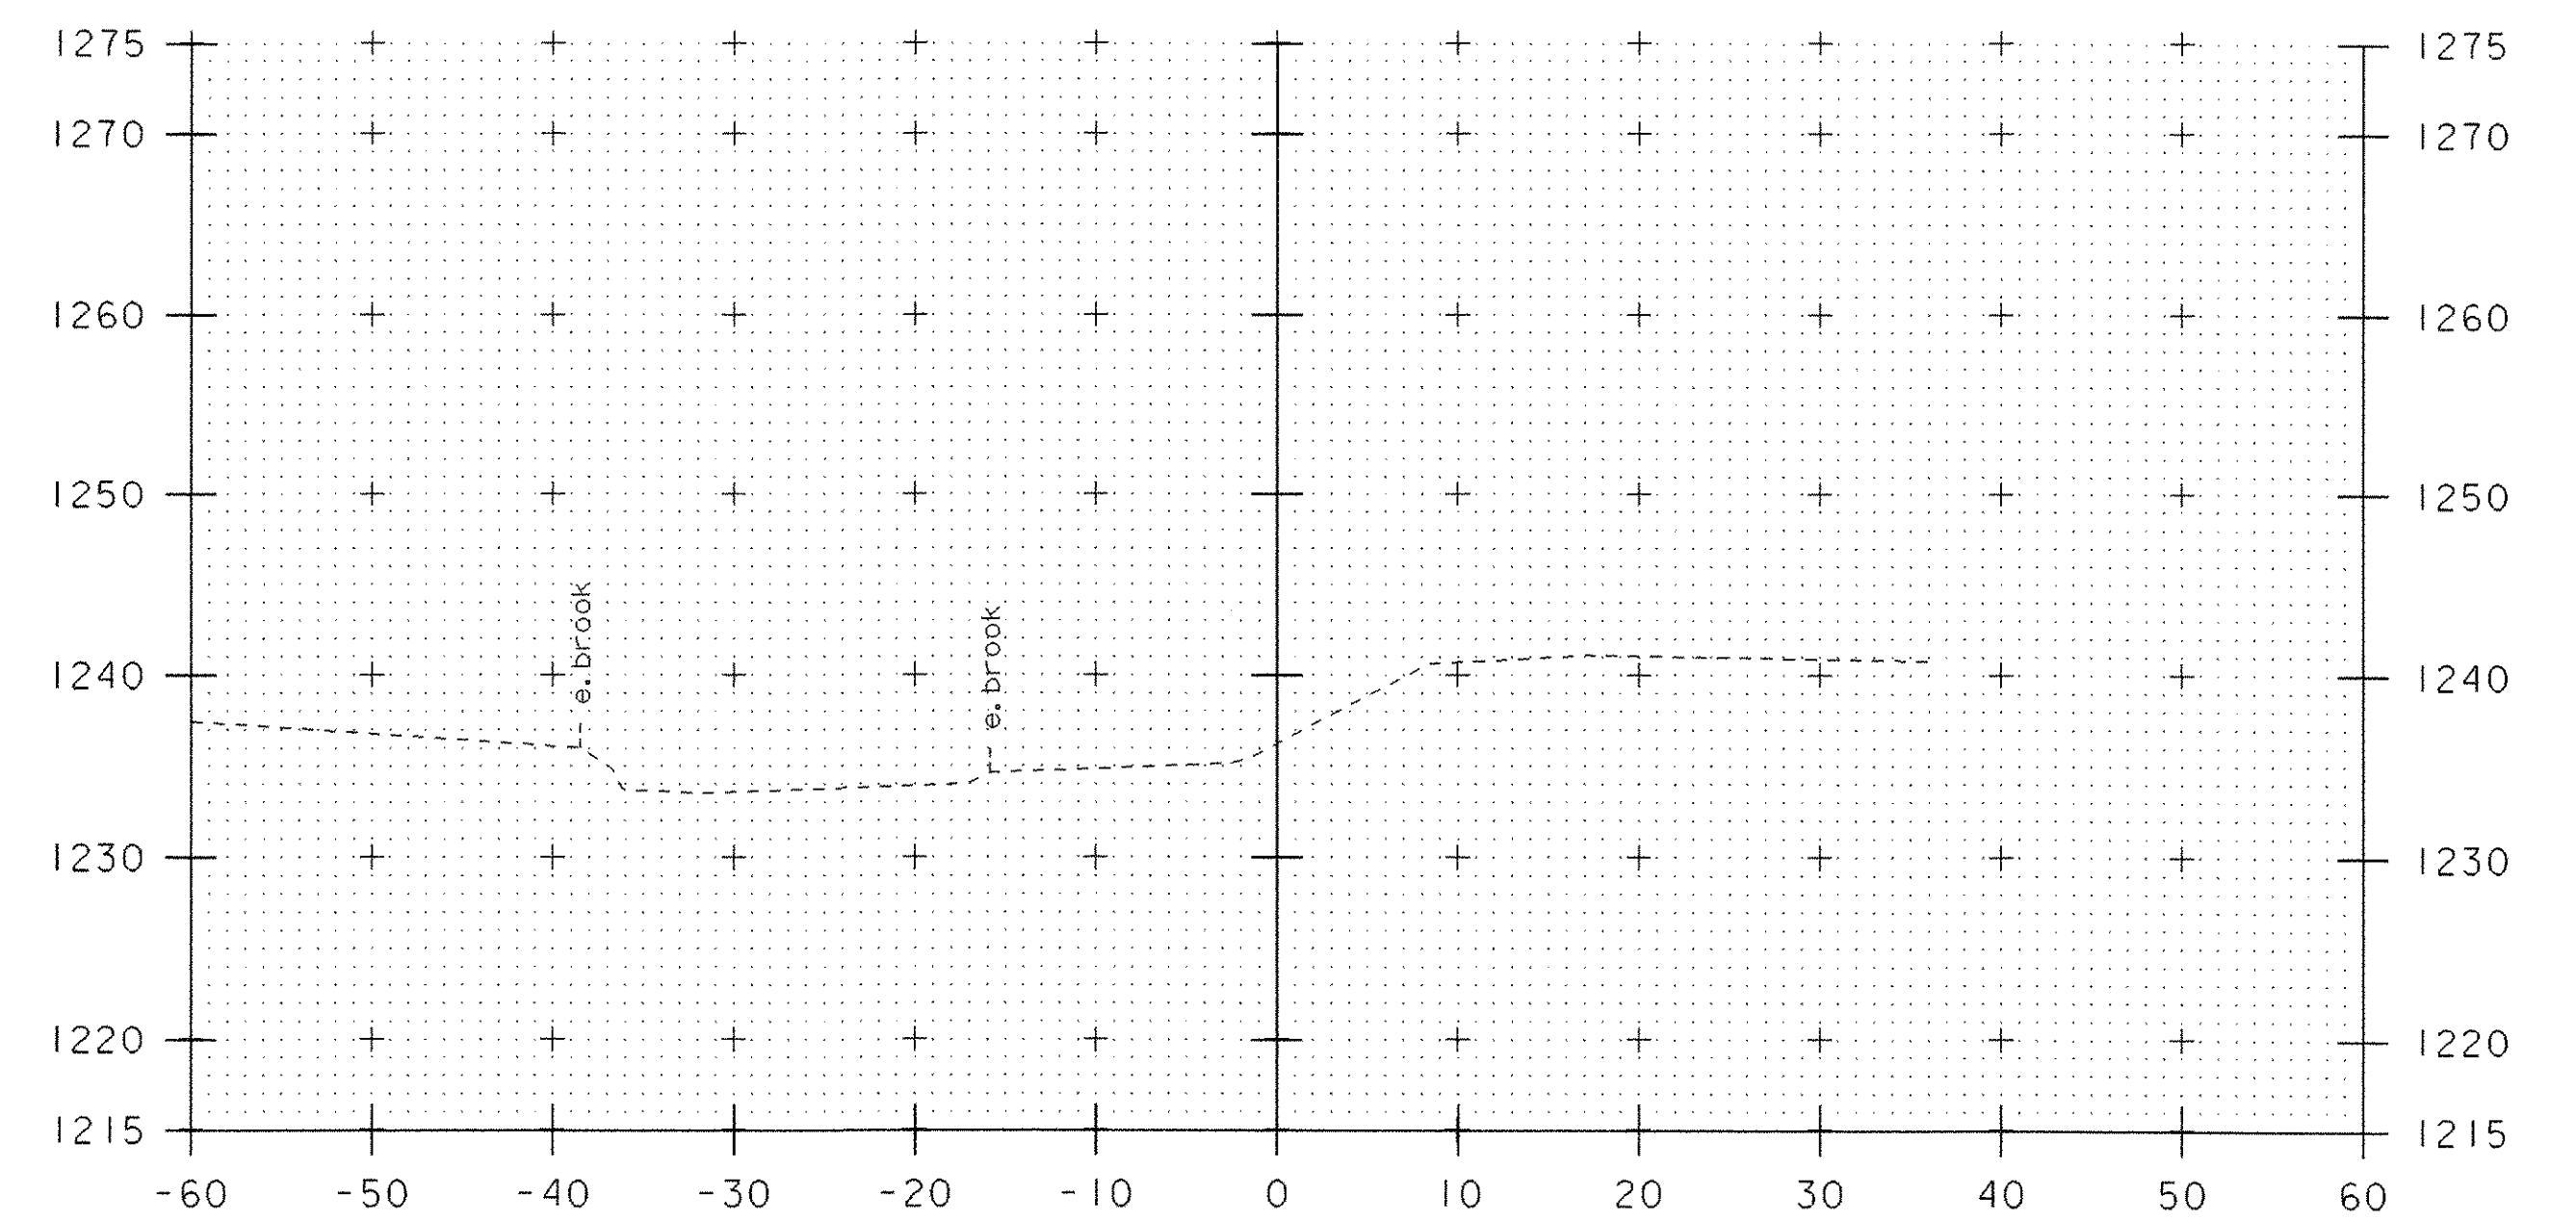

55+00

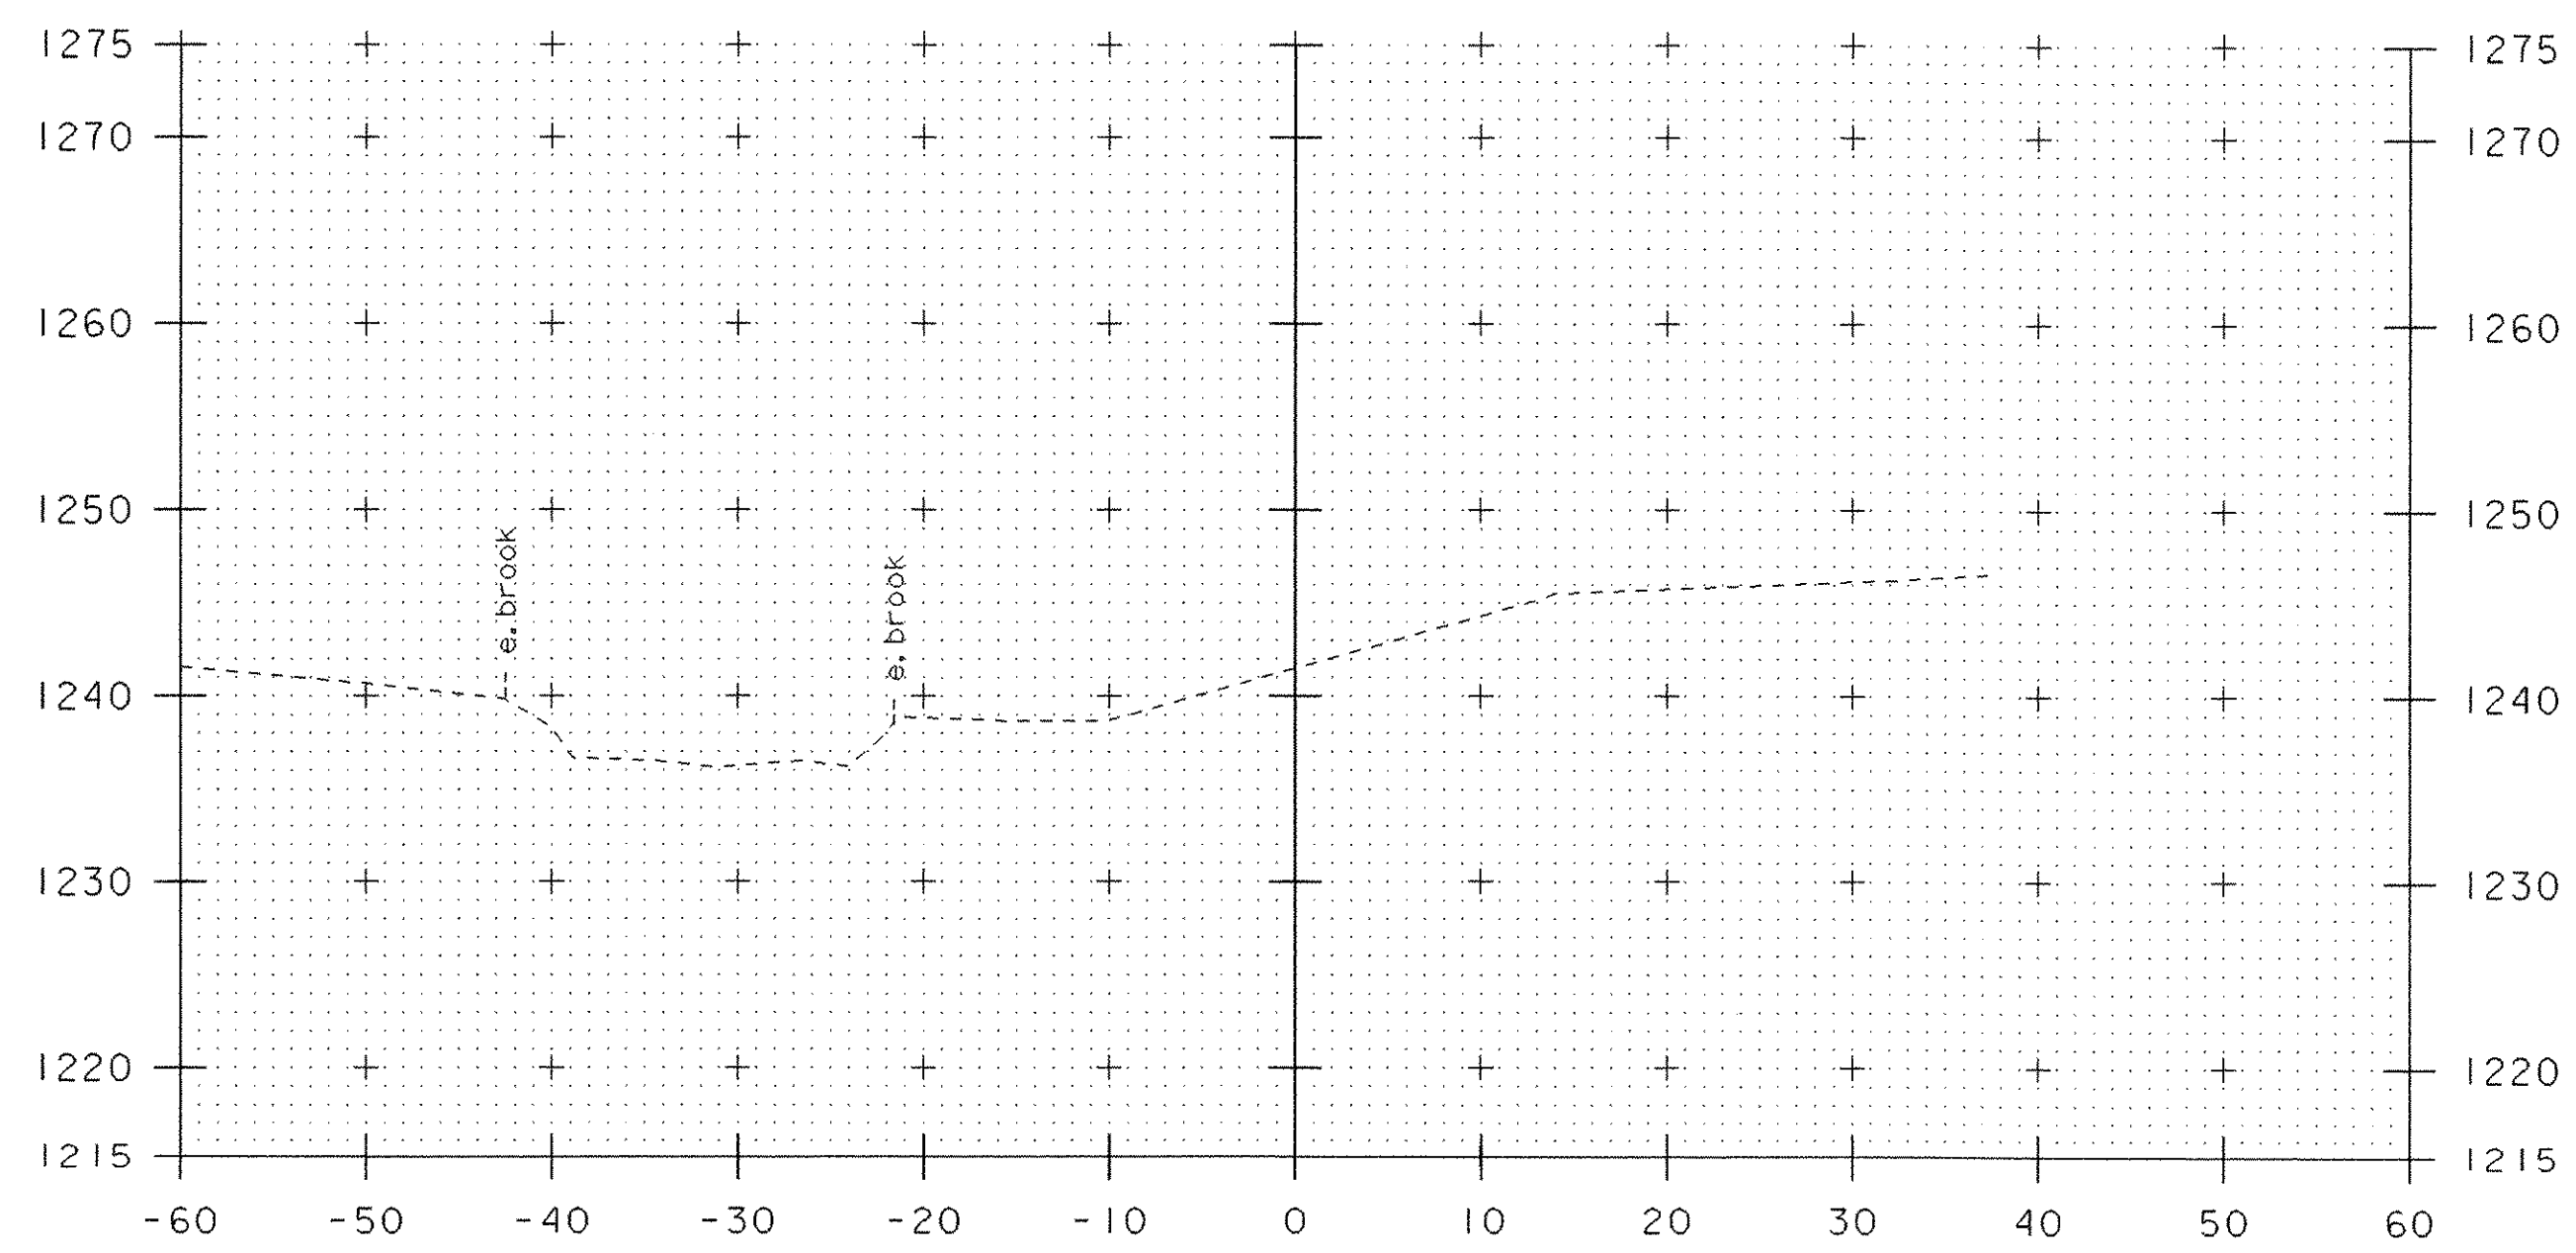

54+40

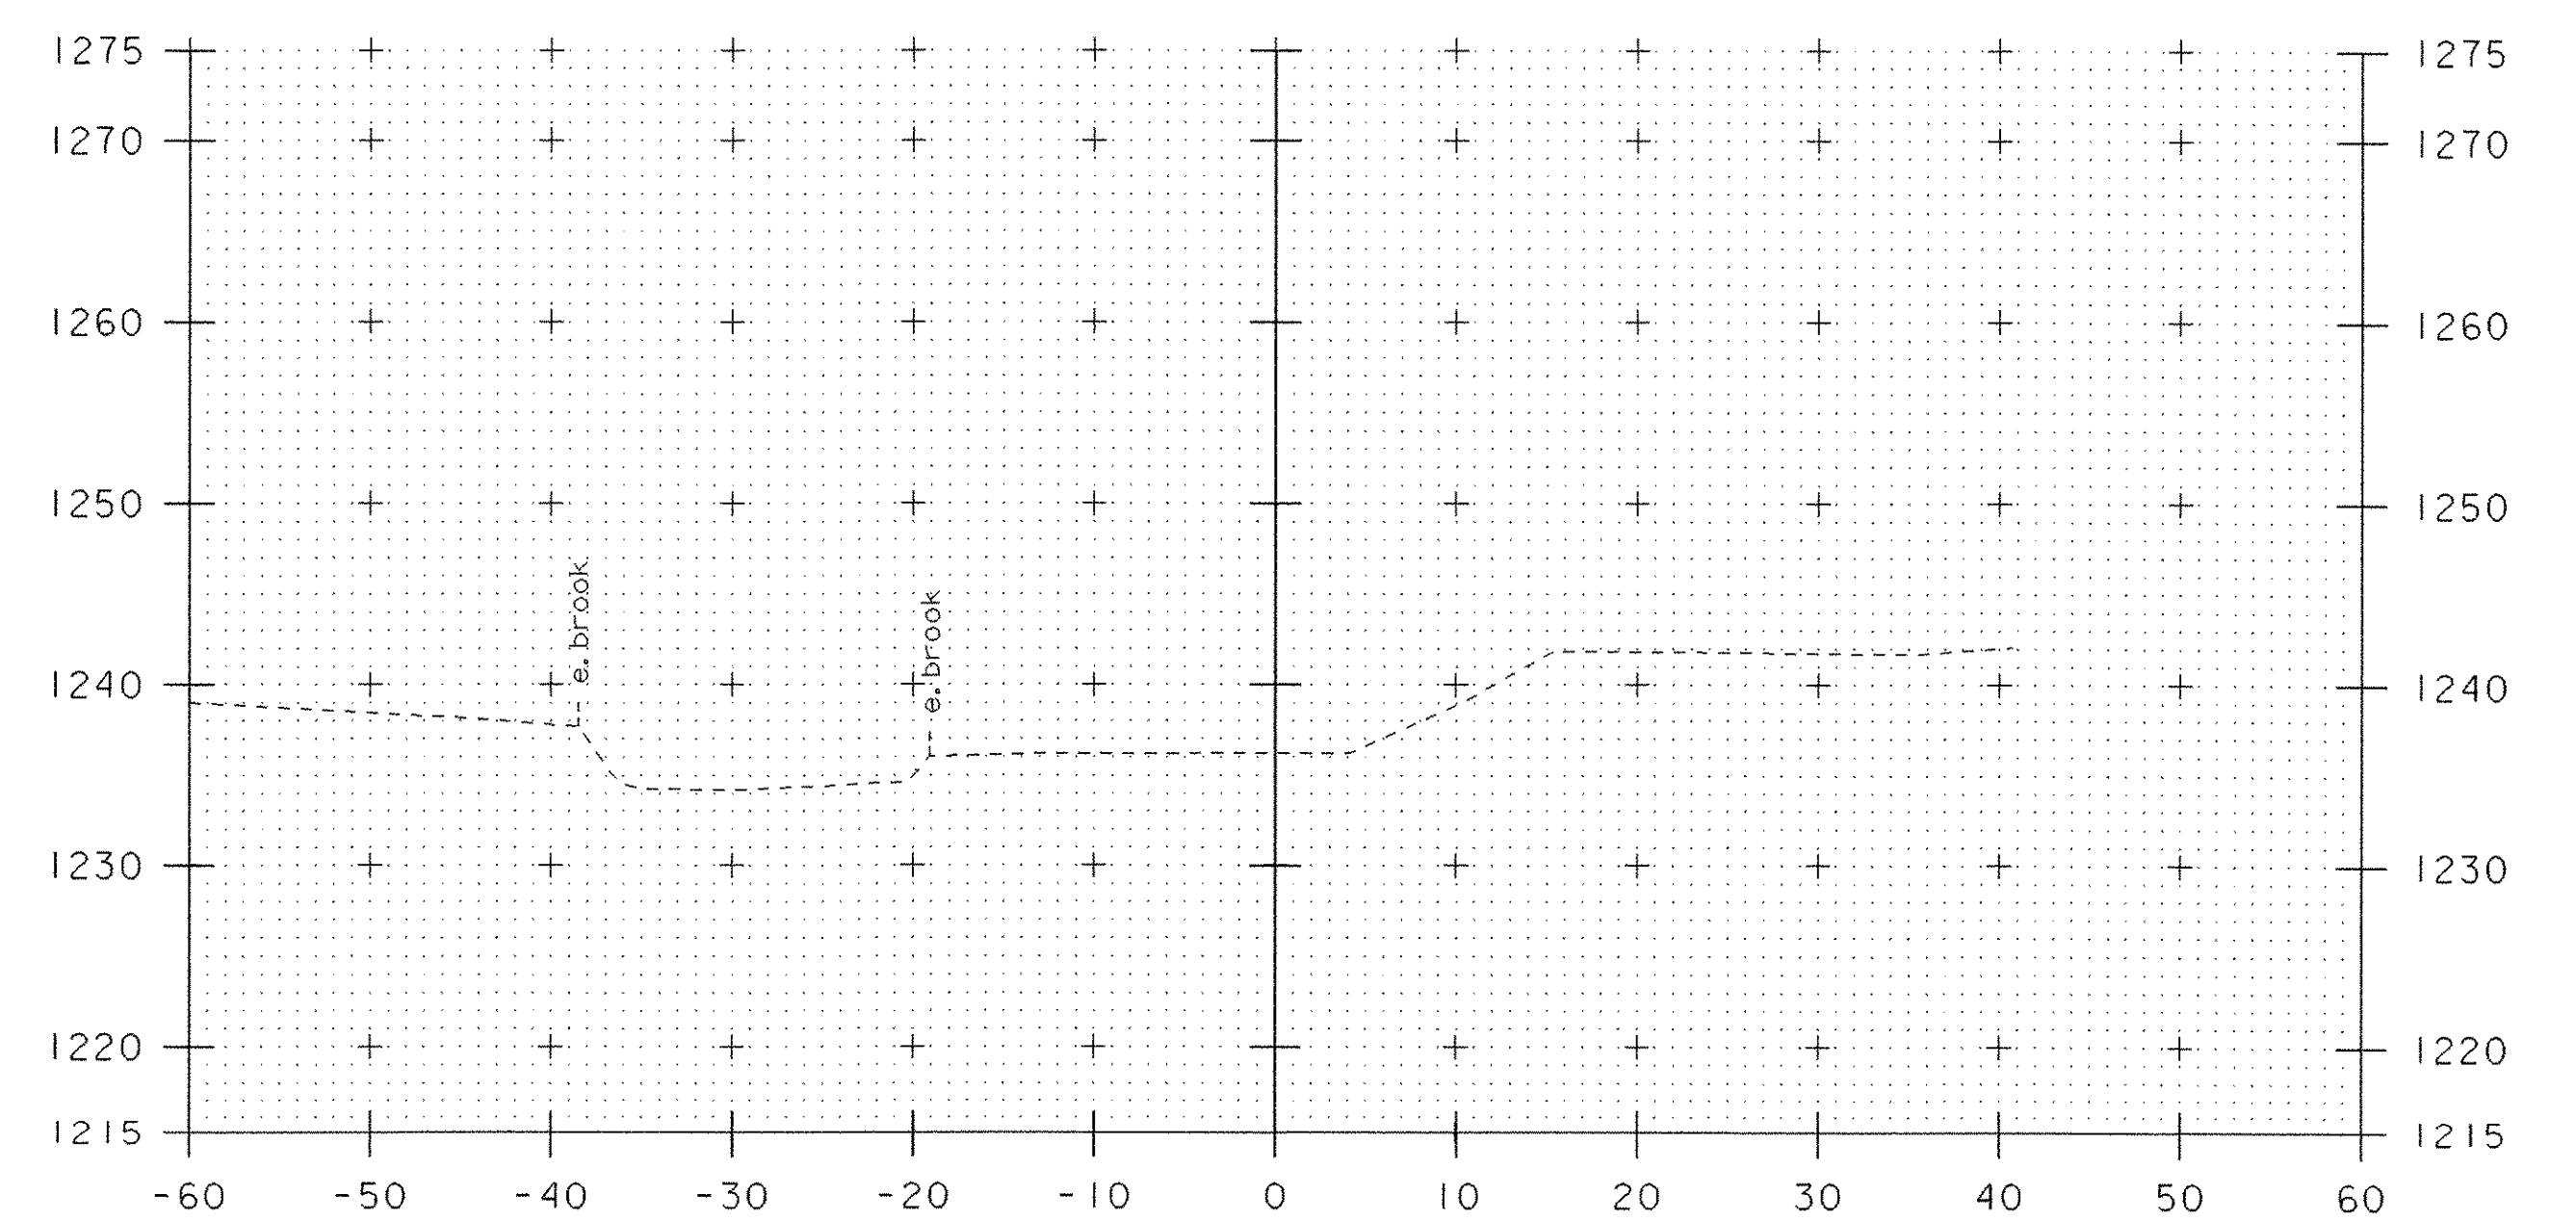

54+80

**CHANNEL CROSS SECTIONS**

PROJECT NAME:	JAY	FILE NAME:	04b140\s04b140bdr.dgn	PLOT DATE:	23-OCT-2006
PROJECT NUMBER:	ST STP CULV (2)	PROJECT LEADER:	W. SYMONDS	DRAWN BY:	G. SHANGRAW
		DESIGNED BY:	T. SUMNER	CHECKED BY:	J. LACROIX
			04b140chxs4.i	SHEET	39 OF 39

RECEIVED

CK'D BY JEL OK'D BY \_\_\_\_\_

MAY 25 2007

RESUBMIT \_\_\_\_\_ APPROVED 5/29/07

BY \_\_\_\_\_ DATE \_\_\_\_\_

Project Number: 2007.004.002  
Page 1 of 11

DESIGN COMPUTATIONS FOR

**VT 105, Bridge #50  
15'-0" x 9'-0" Box Culvert  
Jay, Vermont  
County of Orleans  
(Wingwalls Revised 5/24/07)**


PREPARED FOR:

**Camp Precast Concrete Products  
78 Precast Road  
Milton, Vermont 05468**

PREPARED BY:



184 Court Street, Binghamton, New York 13901  
TEL: 607-231-6600 FAX: 607-231-6650  
EMAIL: precast@deltaengineers.com  
INTERNET: www.deltaengineers.com

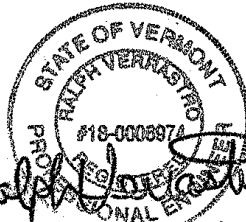

5-24-07

BOXCAR

Version 2.00 for Windows  
12 May 2000

VSDG  
5/16/07

A Computer Program for the Structural  
Design of Reinforced Concrete Box  
Culverts

Developed by

Simpson Gumpertz & Heger Inc.  
Arlington Massachusetts  
in cooperation with

The Federal Highway Administration  
and  
The American Concrete Pipe Association

The successful application and use of this software product  
is dependent on the application of skilled engineering  
judgment and is the responsibility of the user. The user  
must select input values suitable to his specific  
installation. The information presented in the computer  
output is for review, interpretation, application and  
approval by a qualified engineer.

\*\*\*\*\*

ANY IMPLIED OR EXPRESS WARRANTIES COVERING THE  
SOFTWARE PROGRAM OR PROGRAM USER MANUAL INCLUDING  
ANY WARRANTIES OF MERCHANTABILITY OR FITNESS FOR A  
PARTICULAR PURPOSE ARE EXPRESSLY EXCLUDED. SIMPSON  
GUMPERTZ & HEGER INC., THE AMERICAN CONCRETE PIPE  
ASSOCIATION, AND THE FEDERAL HIGHWAY ADMINISTRATION  
SHALL NOT BE LIABLE FOR SPECIAL, INCIDENTAL, CONSEQUENTIAL  
INDIRECT OR OTHER SIMILAR DAMAGES ARISING FROM BREACH  
OF WARRANTY, BREACH OF CONTRACT OR OTHER LEGAL THEORY  
EVEN IF SUCH PARTIES HAVE BEEN ADVISED OF SUCH DAMAGES.

\*\*\*\*\*

Date: 05-10-2007  
Time: 09:31:23

Filename - 070402

Job Description - 15'x9' Box Culvert

-----  
GEOMETRY

Span	15. ft	Top Slab Thickness	12. in.
Rise	9. ft	Bottom Slab Thickness	12. in.
Min. Depth of Fill	11. ft	Sidewall Thickness	10. in.
Max. Depth of Fill	11. ft	Length of Precast	6.25 ft
Depth Increment	0. ft	Section	

-----  
HAUNCH DIMENSIONS

Top Vertical	8. in.
Top Horizontal	8. in.
Bottom Vertical	8. in.
Bottom Horizontal	8. in.

## CONCRETE COVERS

Top Outside	1.00 in.
Bottom Outside	1.00 in.
Sidewall Outside	1.00 in.
Top Inside	1.00 in.
Bottom Inside	1.00 in.
Sidewall Inside	1.00 in.

-----  
MATERIAL PROPERTIES

Main Reinforcing Yield Stress	60000. psi
Design Concrete Strength	5000. psi
Concrete Density	150. pcf

-----  
DESIGN SPECIFICATION

AASHTO Standard

-----  
LOAD FACTORS

Dead Load: Shear and Moment	1.30
Thrust	1.00
Live Load: Shear and Moment	2.17
Thrust	1.00

-----  
LOAD MODIFIERS

Dead Load: Shear and Moment	1.00
Thrust	1.00
Live Load: Shear and Moment	1.00
Thrust	1.00

-----  
STRENGTH REDUCTION FACTORS

Flexure	0.90
Shear	0.85

-----  
REINFORCING DATA

	DIAMETER	SPACING
Top Slab Outside Face(AS7)	0.5 in.	8 in.
Bottom Slab Outside Face(AS8)	0.5 in.	8 in.
Sidewall Outside Face(AS1)	1 in.	9 in.
Top Slab Inside Face(AS2)	1.128 in.	7 in.
Bottom Slab Inside Face(AS3)	1 in.	6 in.
Sidewall Inside Face(AS4)	0.5 in.	10 in.

The diameters are used to estimate depth to tension reinforcing from compression face. They do not represent required reinforcing diameters.

-----  
SOIL LOAD DATA

Soil Density	140 pcf
Minimum Lateral Pressure Coefficient	0.25
Maximum Lateral Pressure Coefficient	0.50
Installation Type	Embankment/Compacted
Soil-Structure Interaction Factor	1.132

-----  
LIVE LOAD DATA

Live Load	AASHTO HS-Series
Live Load Magnitude	25 US tons
Tire Footprint Length	.0 in.
Tire Footprint Width	.0 in.
Live Load Distribution Factor	1.75
Direction of travel	Parallel to span
Impact Factor	1.00
Lane Load	0.0 psf

-----  
SURCHARGE LOADS

Vertical Pressure	0.0 psf
Horiz. Pressure at Culvert Top	0.0 psf
Horiz. Pressure at Culvert Bottom	0.0 psf
Application Code	Additional Dead Load

-----  
FLUID LOADS

Depth of Fluid	9.0 ft
Fluid Density	62.5 pcf

BOX CULVERT DESIGN SUMMARY SHEET  
15.00 ft Span x 9.00 ft Rise

\*\*\*\*\*  
I N S T A L L A T I O N   D A T A  
-----

Height of Fill Over Culvert, ft	11.00
Soil Unit Weight, pcf	140.
Minimum Lateral Soil Pressure Coefficient	0.250
Maximum Lateral Soil Pressure Coefficient	0.500
Soil-Structure Interaction Factor	1.132
Installation Type	Embankment/Compacted

L O A D I N G   D A T A  
-----

Design Specification	AASHTO Standard
Dead Load Factor - Moment and Shear	1.30
Dead Load Factor - Thrust	1.00
Live Load Factor - Moment and Shear	2.17
Live Load Factor - Thrust	1.00
Dead Load Modifier - Moment and Shear	1.00
Dead Load Modifier - Thrust	1.00
Live Load Modifier - Moment and Shear	1.00
Live Load Modifier - Thrust	1.00
Strength Reduction Factor-Flexure	0.90
Strength Reduction Factor-Diagonal Tension	0.85
Live Load	
Live Load Type	AASHTO HS-Series
Live Load Magnitude, US tons	25.
Tire Footprint Length, in.	1.0
Tire Footprint Width, in.	1.0
Live Load Distribution Factor	1.75
Direction of travel	Parallel to span
Impact Factor	1.00
Lane Load, psf	0.0

M A T E R I A L   P R O P E R T I E S  
-----

Minimum Specified Reinforcing Yield Strength, ksi	60.0
Concrete - Specified Compressive Strength, ksi	5.0

G E O M E T R Y  
-----

Top Slab Thickness, in.	12.0
Side Wall Thickness, in.	10.0
Bottom Slab Thickness, in.	12.0
Top Horizontal Haunch Dimension, in.	8.0
Bottom Horizontal Haunch Dimension, in.	8.0
Top Vertical Haunch Dimension, in.	8.0

GEOMETRY (Continued)

Bottom Vertical Haunch Dimension, in.	8.0
Concrete Cover Over Steel, in.	
Top Slab - Outside Face	1.00
Bottom Slab - Outside Face	1.00
Side Wall - Outside Face	1.00
Top Slab - Inside Face	1.00
Bottom Slab - Inside Face	1.00
Side Wall - Inside Face	1.00


REINFORCING DATA

LOCATION	AREA (in. <sup>2</sup> /ft)	STIRRUPS REQUIRED?
TRANSVERSE		
Side Wall - Outside Face (AS1)	1.012	No
Top Slab - Inside Face (AS2)	1.643	No
Bottom Slab - Inside Face (AS3)	1.574	No
Side Wall - Inside Face (AS4)	0.240	No
Top Slab - Outside Face (AS7)	0.288	No
Bottom Slab - Outside Face (AS8)	0.288	No

Notes:

- 1 Sidewall outside face steel (AS1) is bent at the culvert corners and extended 27 in. from the bend point into the top slab. The top slab outside face steel (AS7) must lap the AS1 steel in accordance with AASHTO provisions for tension lap splices. To obtain the total AS1 extension into the top slab, the tension lap splice length must be calculated and added to the 27 in. extension length.
- 2 Sidewall outside face steel (AS1) is bent at the culvert corners and extended 27 in. from the bend point into the bottom slab. The bottom outside face steel (AS8) must lap the AS1 steel in accordance with AASHTO provisions for tension lap splices. To obtain the total AS1 extension into the bottom slab, the tension lap splice length must be calculated and added to the 27 in. extension length.
- 3 There may be negative moment from the outside corner of the box to 34 in. across the top slab
- 4 There may be negative moment from the outside corner of the box to 37 in. across the bottom slab.
- 5 BOXCAR does not check for differential deflection of the top slab between adjacent box sections for service live load.



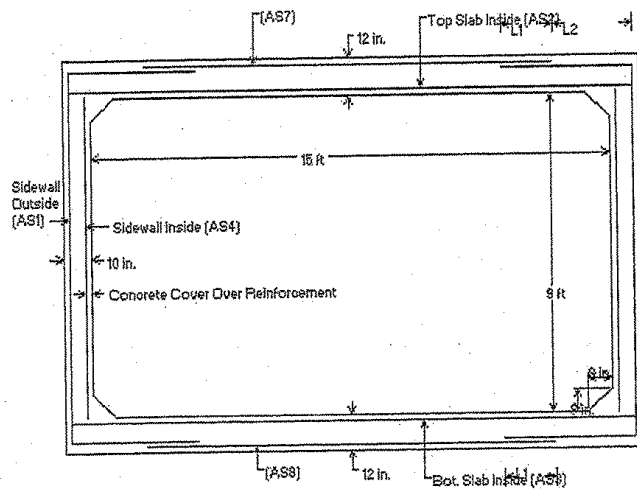

- \* <L1> is Splice Length
- \* <L2> is AS1 Extension
- \* (AS7) is Top Slab Outside
- \* (AS8) is Bottom Slab Outside
- \* See Box Culvert Design Summary Sheet for transverse and distribution reinforcement, as required.
- \* For sidewall thicknesses of 6 in. and above, extend AS2 and AS3 a min. of 4 in. beyond the inside face of the sidewall. For thicknesses less than 6 in., extend AS2 and AS3 at least to within 1-1/2 in. of the outside face of the sidewall.

Notes:

- 1) Other reinforcement schemes that provide the required reinforcement areas at all locations identified in the program output are acceptable.
- 2) Longitudinal reinforcement is not shown for clarity, see AASHTO M259 for longitudinal reinforcement and for additional requirements.

**DESIGN DATA**

**SOIL**

Soil Density= 140 pcf  
 Soil Friction Angle (Phi)= 34 deg.  
 Angle of wall friction (delta)= 22 deg.  
 Back slope angle (beta)= 21 deg.  
 Broken backslope angle (beta')= 21 deg.  
 Slope - Back face of wall= 90 deg.  
 Allowable Bearing Capacity= 4000 psf  
 Ka= 0.3458  
 KaH= 0.3206  
 KaV= 0.1295  
 EP= 48.41  
 EP(H)= 44.88  
 EP(V)= 18.13

**WALL GEOMETRY**

Stem Height hs= 10.50 ft  
 Stem Thickness ts= 10.00 in  
 Base Thickness tb= 18.00 in  
 Toe Width lt= 1.00 ft  
 Heel Width lh= 6.5 ft  
 Surcharge hsc= 0 ft

Wall Height-H= 12.00 ft  
 Total Base Width Lb= 8.33 ft  
 Weight of Wall & Slab = 3188 lbs/ft  
 Bar cover stem = 1.5 in  
 Bar cover toe/heel = 1.5 in  
 Height at back of soil wedge Ht = 14.50 ft

**ACTIVE FORCES**

Pq(H)= 0.00  
 Pa(H)= 4715.31 lb/ft

**RETAINING FORCES**

Stem Wall - w1= 1312.50 lbs  
 Base Slab - w2= 1875.00 lbs  
 Soil above heel - w3= 9555.00 lbs  
 Soil wedge - w4= 1135.28 lbs  
 PaV= 1905.11 lb/ft  
 Total W= 15782.89 lbs

Safety factor against overturning=

Moment Arm 7.25  
 4.83 ft  
 Overturning Mom., Mo= 22782.97 ft-lbs/ft

1.42 ft 1859.38 ft-lbs/ft  
 4.17 ft 7812.50 ft-lbs/ft  
 5.08 ft 48571.25 ft-lbs/ft  
 6.17 ft 7000.88 ft-lbs/ft  
 8.33 ft 15875.89 ft-lbs/ft  
 Resisting Mom., Mr= 81119.90 ft-lbs/ft  
 3.56 OK

**RESULTANT OF WALL FORCES**


Sum of vertical forces Rv= 15783 lbs  
 Resultant location a = 3.70 ft  
 Eccentricity e= 0.47 ft L/6= 1.39  
 Pressure at toe of wall= Resultant in middle third  
 p1 2535.47 psf OK  
 p2 1252.42 psf

**CHECK SLIDING**

Sliding Coeff, = 0.45  
 Safety Factor, Sliding = 1.51 OK

Project: County of Orleans V7105  
 15' x 9' Culvert  
 Client: Camp Precast  
 Job Number: 2007.004.002  
 File Name: Cantwall.xls  
 Entered By: CJB / 5/26  
 Checked By: KE  
 Date: 5/24/2007  
 Sheet: 9 of 11

Denotes input field

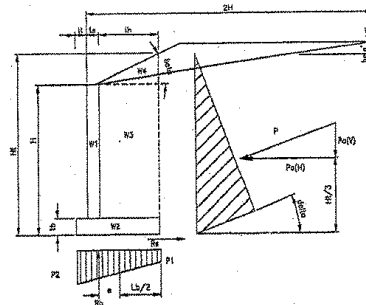

Delta Engineers, PC  
 184 Court Street  
 Binghamton, NY 13901  
 (607)231-6600 Fax (607)231-6650

**REINFORCING DESIGN**

**TECHNICAL DATA**

Concrete Strength	5	ksi
Yield Strength	60	ksi
Unit Weight of Concrete	150	pcf
E	4.03E+06	
n	7.2	
k	0.403	
J	0.866	
K	392	

**Capacity Reduction Factors:**

Phi - Moment	0.9
Phi - Shear	0.85
<b>Load Factors:</b>	
Gamma	1.3
Beta - LL	1.3
Beta - DL	1

**References:**

1. "Specifications for Highway Bridges, 17th Ed." - AASHTO
2. "Design Manual for Segmental Retaining Walls" - Concrete Masonry Association
3. "Building Code Requirements for Structural Concrete" - ACI 318.

Project:	County of Orleans VT105
	15' x 9' Culvert
Client:	Camp Precast
Job Number:	2007.004.002
File Name:	Cantwall.xls
Entered By:	CJB / SDG
Checked By:	RC
Date:	5/24/2007
Sheet:	10 of 11

$b_1 = 0.8 (.85 - .05(fc-4))$

Rho min	0.003333333 (200/Fy)
Rho max	0.025153061 (.75Rho-b)
Zmax	130 Severe Exposure

Delta Engineers, PC  
 184 Court Street  
 Binghamton, NY 13901  
 (607)231-6600 Fax (607)231-6650

**Stem Vert. Moments.**

Design Height, hw= 13.00 ft  
 Force, P1= 3789.89 lbs/ft  
 Cantilever Moment, Ma= 16416.69 '-lbs/ft  
 Mu= 27.74  
 Stem d= 8.125 in

Project: County of Orleans VT105  
 15' x 9' Culvert  
 Client: Camp Precast  
 Job Number: 2007.004.002  
 File Name: Cantwall.xls  
 Entered By: CJB /SDG  
 Checked By: RE  
 Date: 5/24/2007  
 Sheet: 11 of 11

Trial Bar Size and Spacing As= 0.88 in.sq/ft.  
 Rho 0.009062287 Rho\*n= 0.06520425  
 a=As\*Fy/.85\*fc\*b 1.039 in  
 ΦMn 30.24 kip-ft  
 k= 0.302  
 j= 0.899  
 fs= 30.51 ksi  
 dc= 1.875 in  
 A= 22.5 sq.in  
 Z= 108.1 kips/in

> Mu(27.74 kip-ft) ,OK  
 Use # 6 @ 6 in

**Heel Reinf.**

Total Weight= 2044.32 lbs/ft  
 Design Span, s= 6.50 ft.  
 Cantilever Mom., Mdl= 48105.72 ft-lbs/ft  
 Mu= 62.54  
 Heel d= 16.0625 in

Trial Bar Size and Spacing As= 1.20 in.sq/ft.  
 Rho 0.006239382 Rho\*n= 0.04489311  
 a=As\*Fy/.85\*fc\*b 1.415 in  
 ΦMn 83.10 kip-ft  
 k= 0.258  
 j= 0.914  
 fs= 32.70 ksi  
 dc= 1.9375 in  
 A= 23.25 sq.in  
 Z= 116.2 kips/in

> Mu(62.54 kip-ft) ,OK  
 Use # 7 @ 6 in

**Toe Reinf.**

Design Span, s= 1.00 ft.  
 Cantilever Mom., Mdl= 1242.08 ft-lbs/ft  
 Mu= 1.61  
 Toe d= 16.25 in

Trial Bar Size and Spacing As= 0.20 in.sq/ft.  
 Rho 0.001006921 Rho\*n= 0.00724492  
 a=As\*Fy/.85\*fc\*b 0.231 in  
 ΦMn 14.26 kip-ft  
 k= 0.113  
 j= 0.962  
 fs= 4.85 ksi  
 dc= 1.75 in  
 A= 42 sq.in  
 Z= 20.3 kips/in

> Mu(1.61 kip-ft) ,OK  
 Use # 4 @ 12 in

**Check Shear Stresses**

Stem wall Vu= 6404.92 lbs Vn= 11720.29 lbs OK  
 Heel Vu= 19554.49 lbs Vn= 23170.12 lbs OK

RECEIVED

CK'D BY JEL OK'D BY \_\_\_\_\_

MAY 25 2007

RESUBMIT \_\_\_\_\_ APPROVED 5/29/07 (As Noted)  
BY WJW DATE

MANUFACTURED BY:



PRECAST INC.  
78 PRECAST ROAD  
MILTON, VERMONT 05468  
PHONE(802)893-2401 FAX(802)893-1542

PROJECT:

VT 105, BRIDGE #50  
15'-0" X 9'-0" BOX CULVERT  
JAY, VT  
COUNTY OF ORLEANS

PREPARED BY:



184 COURT STREET, BINGHAMTON, NY 13901  
PHONE(607)231-6600 FAX(607)231-6650

ENGINEER OF RECORD:

STATE OF VERMONT  
AGENCY OF TRANSPORTATION

DESIGN NOTES

- AS PROVIDED BY EOR:
1. DESIGN PER AASHTO 17TH EDITION WITH HS-25 LOADING.
  2. UNIT WEIGHT OF SOIL = 140 PCF
  3. ALLOWABLE BEARING PRESSURE = 4000 PSF
  4. DESIGN EARTH COVER = 11'


- ASSUMPTIONS (TO BE VERIFIED BY EOR):
1.  $f_c$  @ 28 DAYS = 5000 PSI
  2. REINFORCEMENT = BAR PER ASTM A615, GRADE 60
  3. COEFFICIENT OF SLIDING = 0.45
  4. MATERIALS AND MANUFACTURING PER ASTM C1435.


GENERAL NOTES:

1. ALL EXPOSED EDGES OF CONCRETE & TOP SLAB EXTERIOR EDGES SHALL BE CHAMFERED 1"x1"
2. REINFORCING STEEL PLACEMENT TOLERANCE  
A) SPACING:  $\pm 1"$   
B) CLEARANCE:  $\pm \frac{1}{2}"$


DRAWING SCHEDULE

SHEET NO.	DESCRIPTION	REVISIONS	
		REV. NO.	DATE
1	COVER SHEET	1	5/21/07
2	PLAN VIEW, & ELEVATION VIEW	2	5/24/07
3	END VIEWS & WINGWALL SECTION	2	5/24/07
4	REINFORCING & CONNECTION DETAILS	1	5/21/07
5	WINGWALL DETAILS	2	5/24/07
6	WINGWALL DETAILS	2	5/24/07

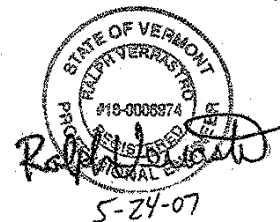

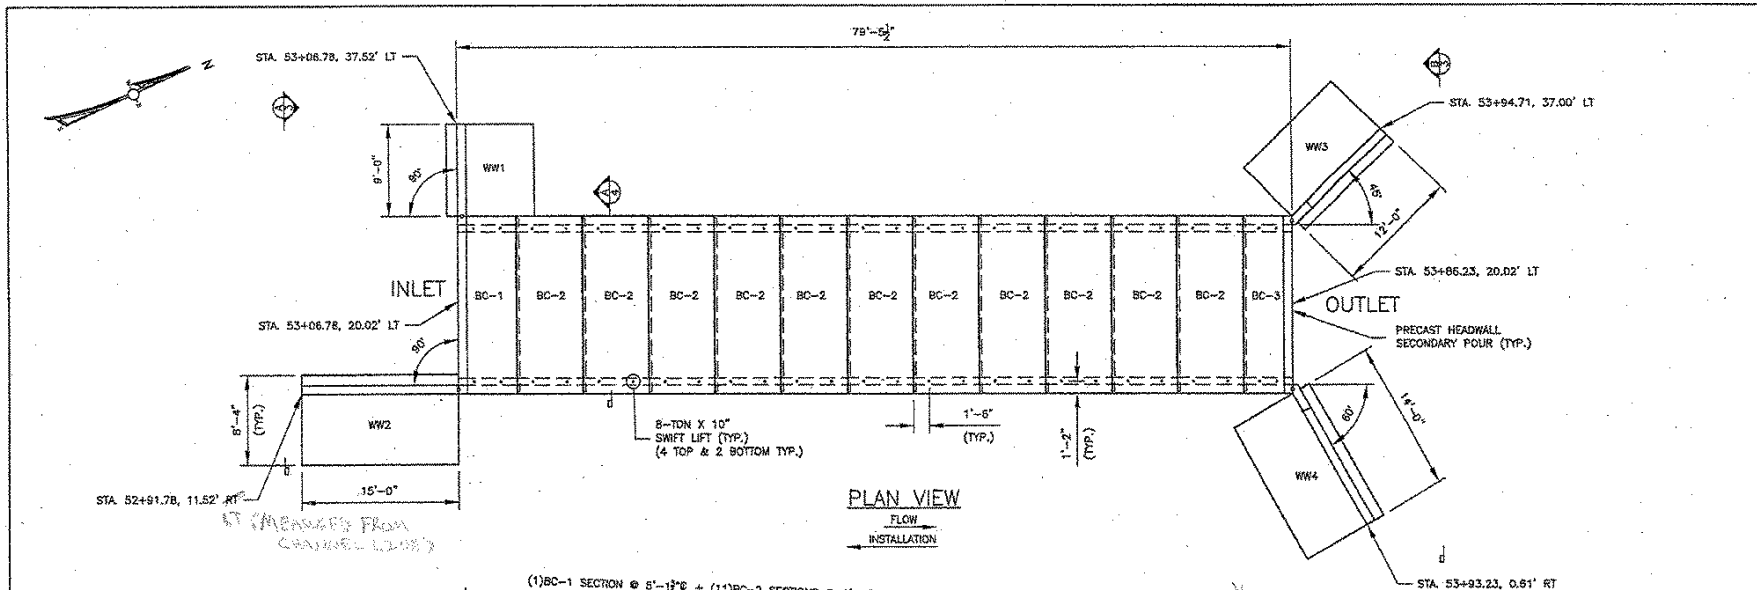

PLAN VIEW  
FLOW  
INSTALLATION

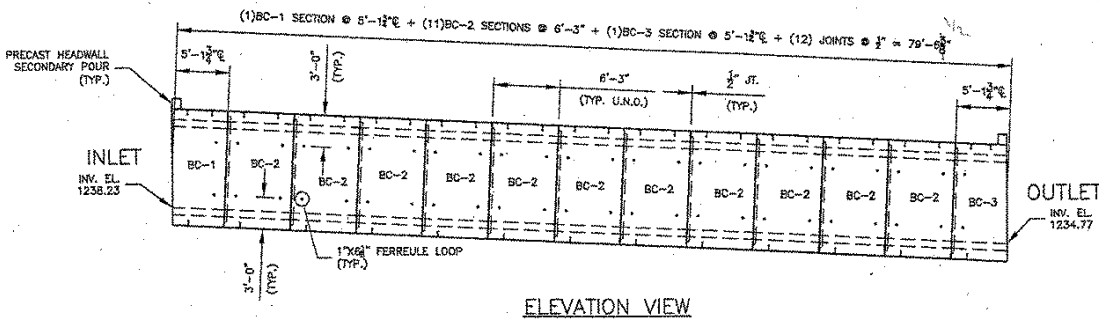


ELEVATION VIEW  
(PRECAST WINGWALLS NOT SHOWN IN THIS VIEW FOR CLARITY)

TABLE OF UNITS				
MARK	QTY	LENGTH	VOL. (CY)	WEIGHT (LBS)
BC-1	1	5'-1 1/2"	9.94	40,250
BC-2	11	6'-3"	11.39	46,150
BC-3	1	5'-1 1/2"	9.94	40,250
WW1	1	9'-0"	5.83	27,660
WW2	1	15'-0"	11.38	45,130
WW3	1	12'-0"	9.11	36,800
WW4	1	14'-0"	10.63	43,050

NOTE: CULVERT WEIGHTS INCLUDE HEADWALLS


RECEIVED  
 CK'D BY JEL OK'D BY \_\_\_\_\_  
 MAY 25 2007  
 RESUBMIT \_\_\_\_\_ APPROVED Starts 7/07  
 BY W4 SY DATE \_\_\_\_\_

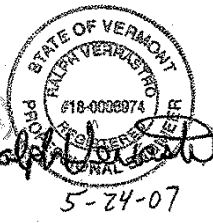


PREPARED BY: **DELTA ENGINEERS**  
 184 COURT STREET, BINGHAMTON, NY 13901  
 TEL: (607) 231-6900 FAX: (607) 231-6650

PREPARED FOR: **CAMP**  
 PRECAST INC.  
 78 PRECAST ROAD  
 MILTON, VERMONT 05468  
 PHONE (802) 893-2401 FAX (802) 893-1542


DATE: 5/15/07 SAFETY FIELD: PLAN VIEW & ELEVATION VIEW DRAWN BY: CJB  
 REVISION: N.T.S. CHECK BY: SY  
 PROJECT: VT 105, BRIDGE #50  
 15'-0" X 9'-0" BOX CULVERT  
 JAY, VT  
 CONTRACTOR: \_\_\_\_\_ DATE: \_\_\_\_\_ SHEET NO.: SD-01  
 DRAWING NO.: 2007.004.002 SHEET NO.: 2 OF 8

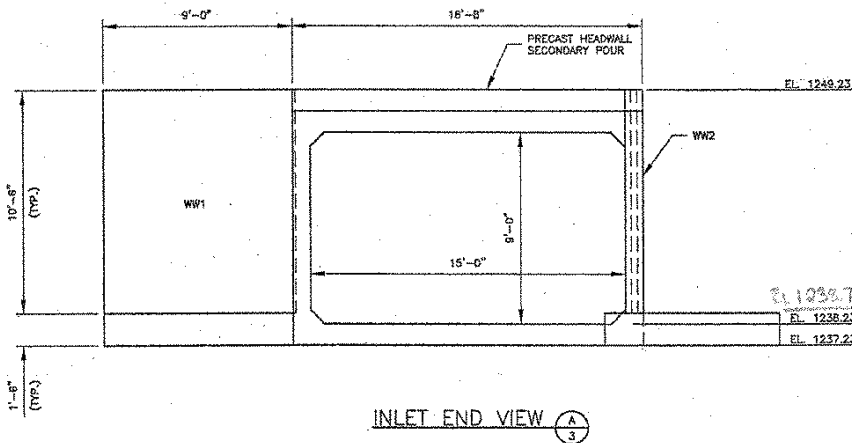

INLET END VIEW (A)

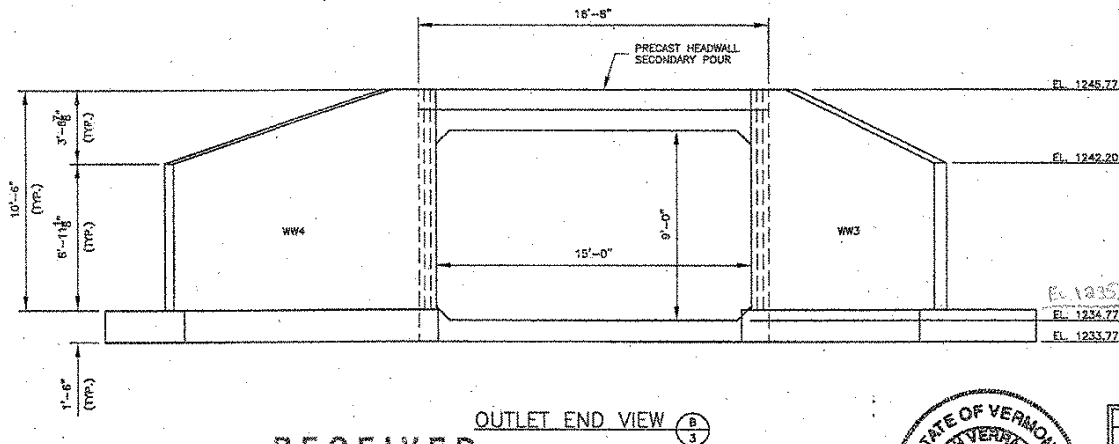

OUTLET END VIEW (B)

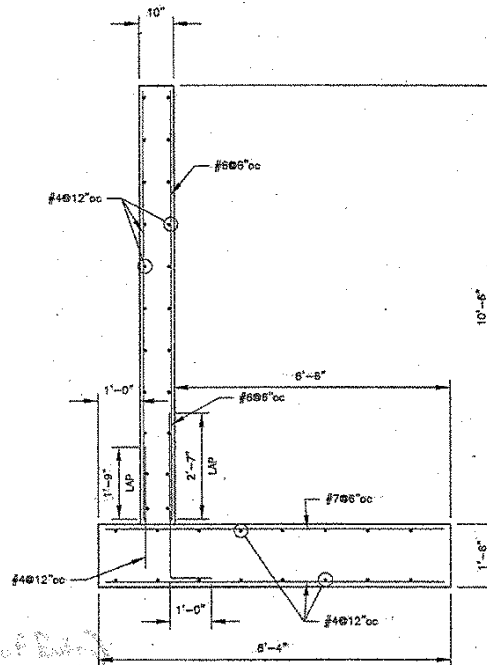

WINGWALL REINFORCING SECTION  
(ALL COVER 1 1/2")

RECEIVED

OK'D BY JEL OK'D BY \_\_\_\_\_

MAY 25 2007

RESUBMIT \_\_\_\_\_ APPROVED \_\_\_\_\_

BY WJ DATE \_\_\_\_\_

5/29/07 (As noted)



*Ralph Verastro*  
5-24-07

REV. NO.	DATE	REVISION
2	5/24/07	REVISED WINGWALLS
1	5/21/07	REVISED WINGWALL DETAIL


PREPARED BY: **DELTA ENGINEERS**  
 184 COURT STREET, BINGHAMTON, NY 13901  
 TEL: (607) 231-6800 FAX: (607) 231-6650

PREPARED FOR: **PRECAST INC.**  
 78 PRECAST ROAD  
 MILTON, VERMONT 05468  
 PHONE (802) 883-2401 FAX (802) 883-1542

DATE: 5/15/07 SHEET TITLE: END VIEWS & WINGWALL SECTION DRAWN BY: CJB  
 SCALE: N.T.S. CVD BY: JLL

PROJECT: VT 105, BRIDGE #50  
 15'-0" X 9'-0" BOX CULVERT  
 JAY, VT


CONTRACTOR: SD-01  
 DRAWING NO.: 2007.004.002 SHEET NO.: 3 OF 6

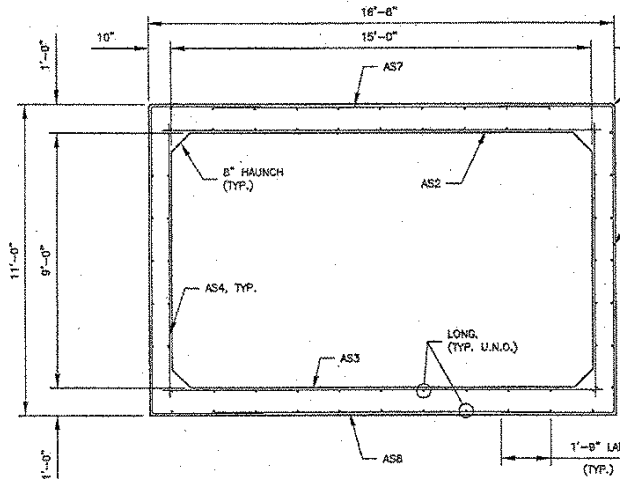


TYPICAL SECTION  
(1' CLR. TYP.)

BAR LIST							
MARK	SIZE	SPA	TYPE	LENGTH	A	B	C
AS1	8	9"	"U"	18'-10"	4'-0"	10'-10"	4'-0"
AS2	9	7"	STR.	15'-8"	---	---	---
AS3	8	6"	STR.	15'-8"	---	---	---
AS4	4	10"	STR.	9'-8"	---	---	---
AS7	4	8"	STR.	12'-0"	---	---	---
AS8	4	8"	STR.	12'-0"	---	---	---
LONG.	4	12"	STR.	6'-1"	---	---	---


NOTE: BAR LIST FOR STANDARD 6'-3" SECTIONS. ADJUST QTY'S & LENGTHS AS REQ'D FOR END SECTIONS

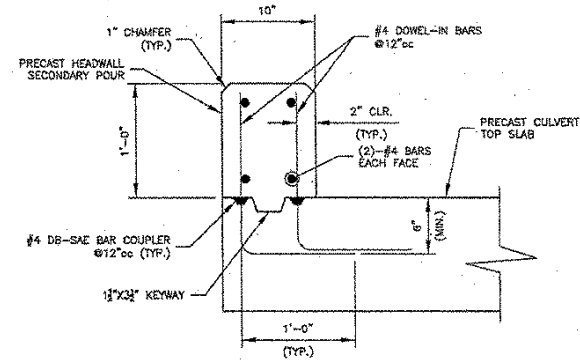


TYPICAL HEADWALL DETAIL

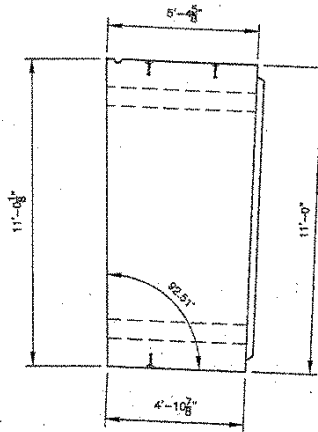


PIECEMARK BC-1  
ELEVATION VIEW  
(HEADWALL NOT SHOWN)

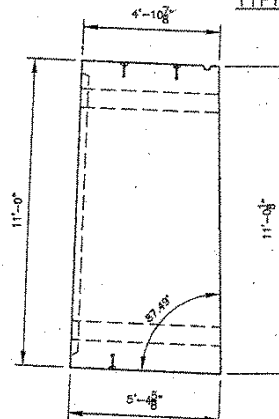

PIECEMARK BC-3  
ELEVATION VIEW  
(HEADWALL NOT SHOWN)

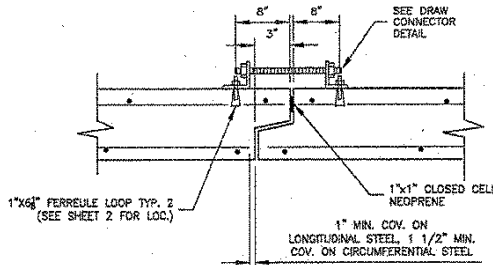

JOINT DETAIL

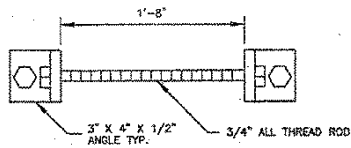

DRAW CONNECTOR DETAIL  
(DRAW CONNECTORS TO BE REMOVED AFTER INSTALLATION)

RECEIVED

CK'D BY *JEL* OK'D BY \_\_\_\_\_


MAY 25 2007

RESUBMIT \_\_\_\_\_ APPROVED *Slavin*


BY *WY* DATE \_\_\_\_\_




PREPARED FOR:		<b>CAMP</b>	
PRECAST INC. 78 PRECAST ROAD MILTON, VERMONT 05488 PHONE (802) 893-2401 FAX (802) 893-1542		DRAWN BY: CJB	
DATE: 5/15/07	SCALE: N.T.S.	DESIGNED BY: <i>Slavin</i>	PROJECT: VT 105, BRIDGE #50
REV. NO. 1	DATE 5/21/07	REVISION: REVISED PER COMMENTS	15'-0" X 9'-0" BOX CULVERT
PREPARED BY: <b>DELTA ENGINEERS</b>		JAY, VT	
194 COURSE STREET, BINGHAMTON, NY 13901 TEL: (607) 831-8600 FAX: (607) 831-8850		SHEET NO. 4 OF 8	

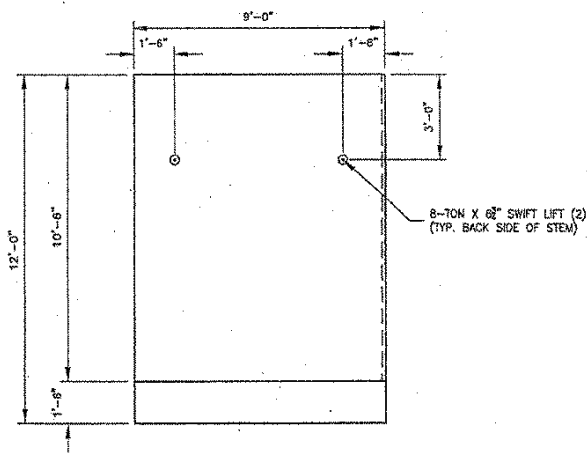


ELEVATION VIEW WW1

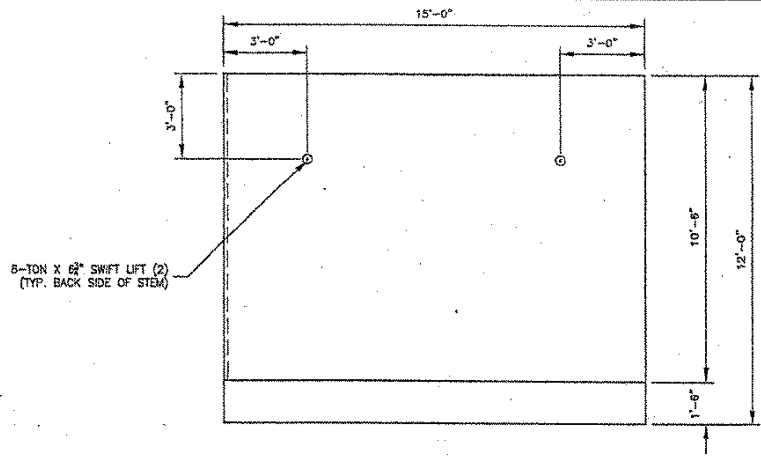

ELEVATION VIEW WW2

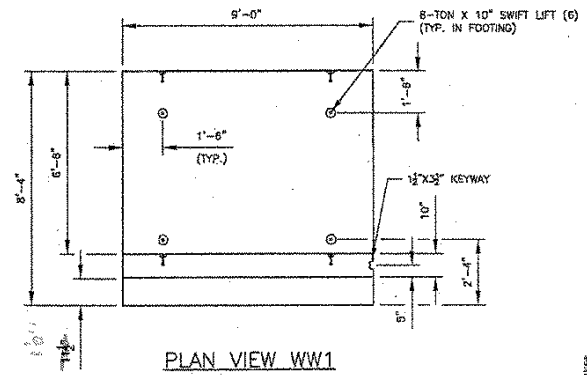


PLAN VIEW WW1

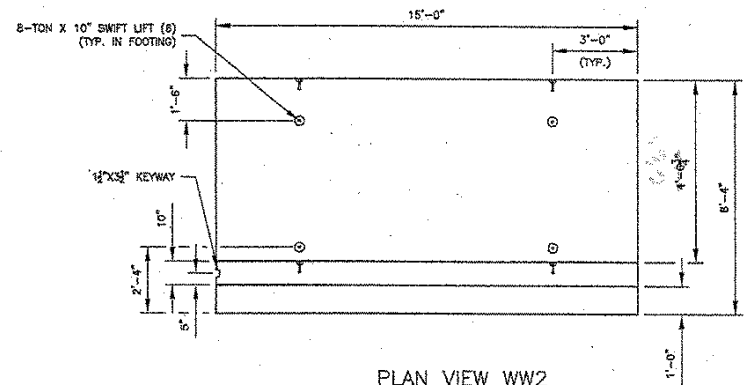

PLAN VIEW WW2

6# - 10,000 @ 3500 PSI    10# - 16,000 @ 3500 PSI (MAX)  
 - 13,000 @ 5000 PSI  
 \*NOTE: EXTRA LIFT INSERTS FOR MANUFACTURING PURPOSES


RECEIVED  
 CK'D BY JEL OK'D BY \_\_\_\_\_  
 MAY 25 2007  
 RESUBMIT \_\_\_\_\_ APPROVED [Signature]  
 BY WY DATE 5-24-07

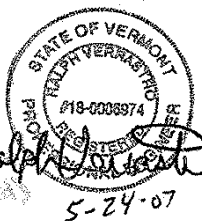


REV. NO.	DATE	REVISION
2	5/24/07	REVISED WINGWALLS
1	5/21/07	REVISED PER COMMENTS

PREPARED BY: **DELTA ENGINEERS**  
 184 COURT STREET, BINGHAMTON, NY 13901  
 TEL: (607) 281-8660 FAX: (607) 281-8650


PREPARED FOR:	
<b>CAMP</b>	
PRECAST INC. 78 PRECAST ROAD MILTON, VERMONT 05468 PHONE (802) 883-2401 FAX (802) 893-1542	
DATE: 5/15/07	SHEET TITLE: WINGWALL DETAILS
SCALE: N.T.S.	DESIGNER: CJB
PROJECT: VT 105, BRIDGE #50	DRAWN BY: <u>SJZ</u>
15'-0" X 9'-0" BOX CULVERT JAY, VT	
ENGINEER:	CHK. NO. SD-01
DATA PROJ. NO: 2007.004.002	SPR. NO. 5 OF 6

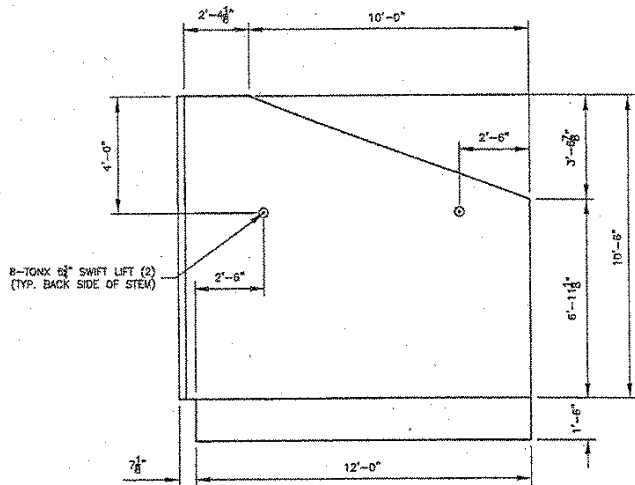


ELEVATION VIEW WW3

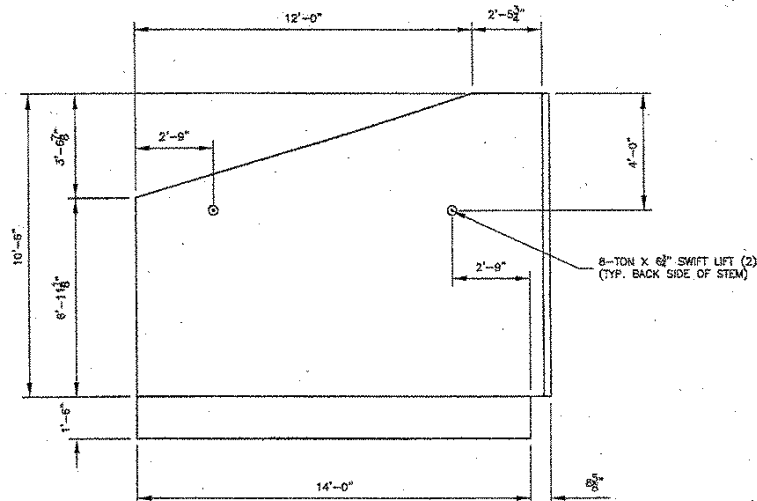

ELEVATION VIEW WW4

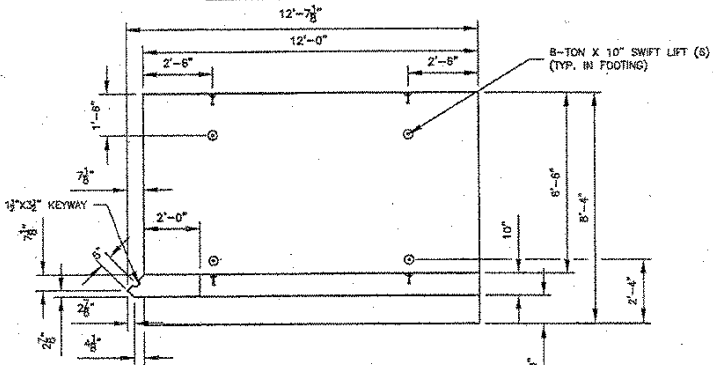

PLAN VIEW WW3

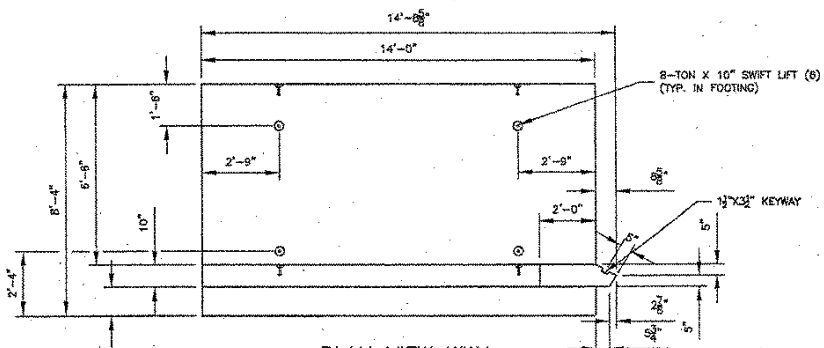

PLAN VIEW WW4


RECEIVED

CK'D BY JEL OK'D BY \_\_\_\_\_

MAY 25 2007

RESUBMIT \_\_\_\_\_ APPROVED slay107

BY WY DATE \_\_\_\_\_

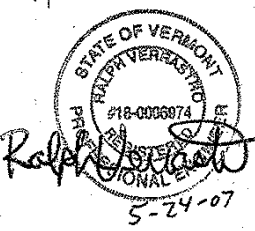

REV. NO.	DATE	REVISION
2	5/24/07	REVISED WINGWALLS
1	5/21/07	REVISED PER COMMENTS
PREPARED BY: <b>DELTA ENGINEERS</b>		
184 COURT STREET, BINGHAMTON, NY 13901 TEL: (807) 231-6600 FAX: (807) 231-6600		

PREPARED FOR:	
 PRECAST INC. 78 PRECAST ROAD MILTON, VERMONT 05468 PHONE (802) 893-2401 FAX (802) 893-1542	
DATE: 5/15/07	ENGINE TITLE: WINGWALL DETAILS
SCALE: N.T.S.	DRW' NO: 502
PROJECT: VT 105, BRIDGE #50 15'-0" X 9'-0" BOX CULVERT JAY, VT	
CONTRACTOR:	DWG. NO: SD-01
DESIGN PROJ. NO.: 2007.004.002	SHEET NO: 5 OF 6