


SEE SCHEMATIC SIGN LAYOUT PLAN FOR CONTINUATION OF SIGNING ALONG US ROUTE 302

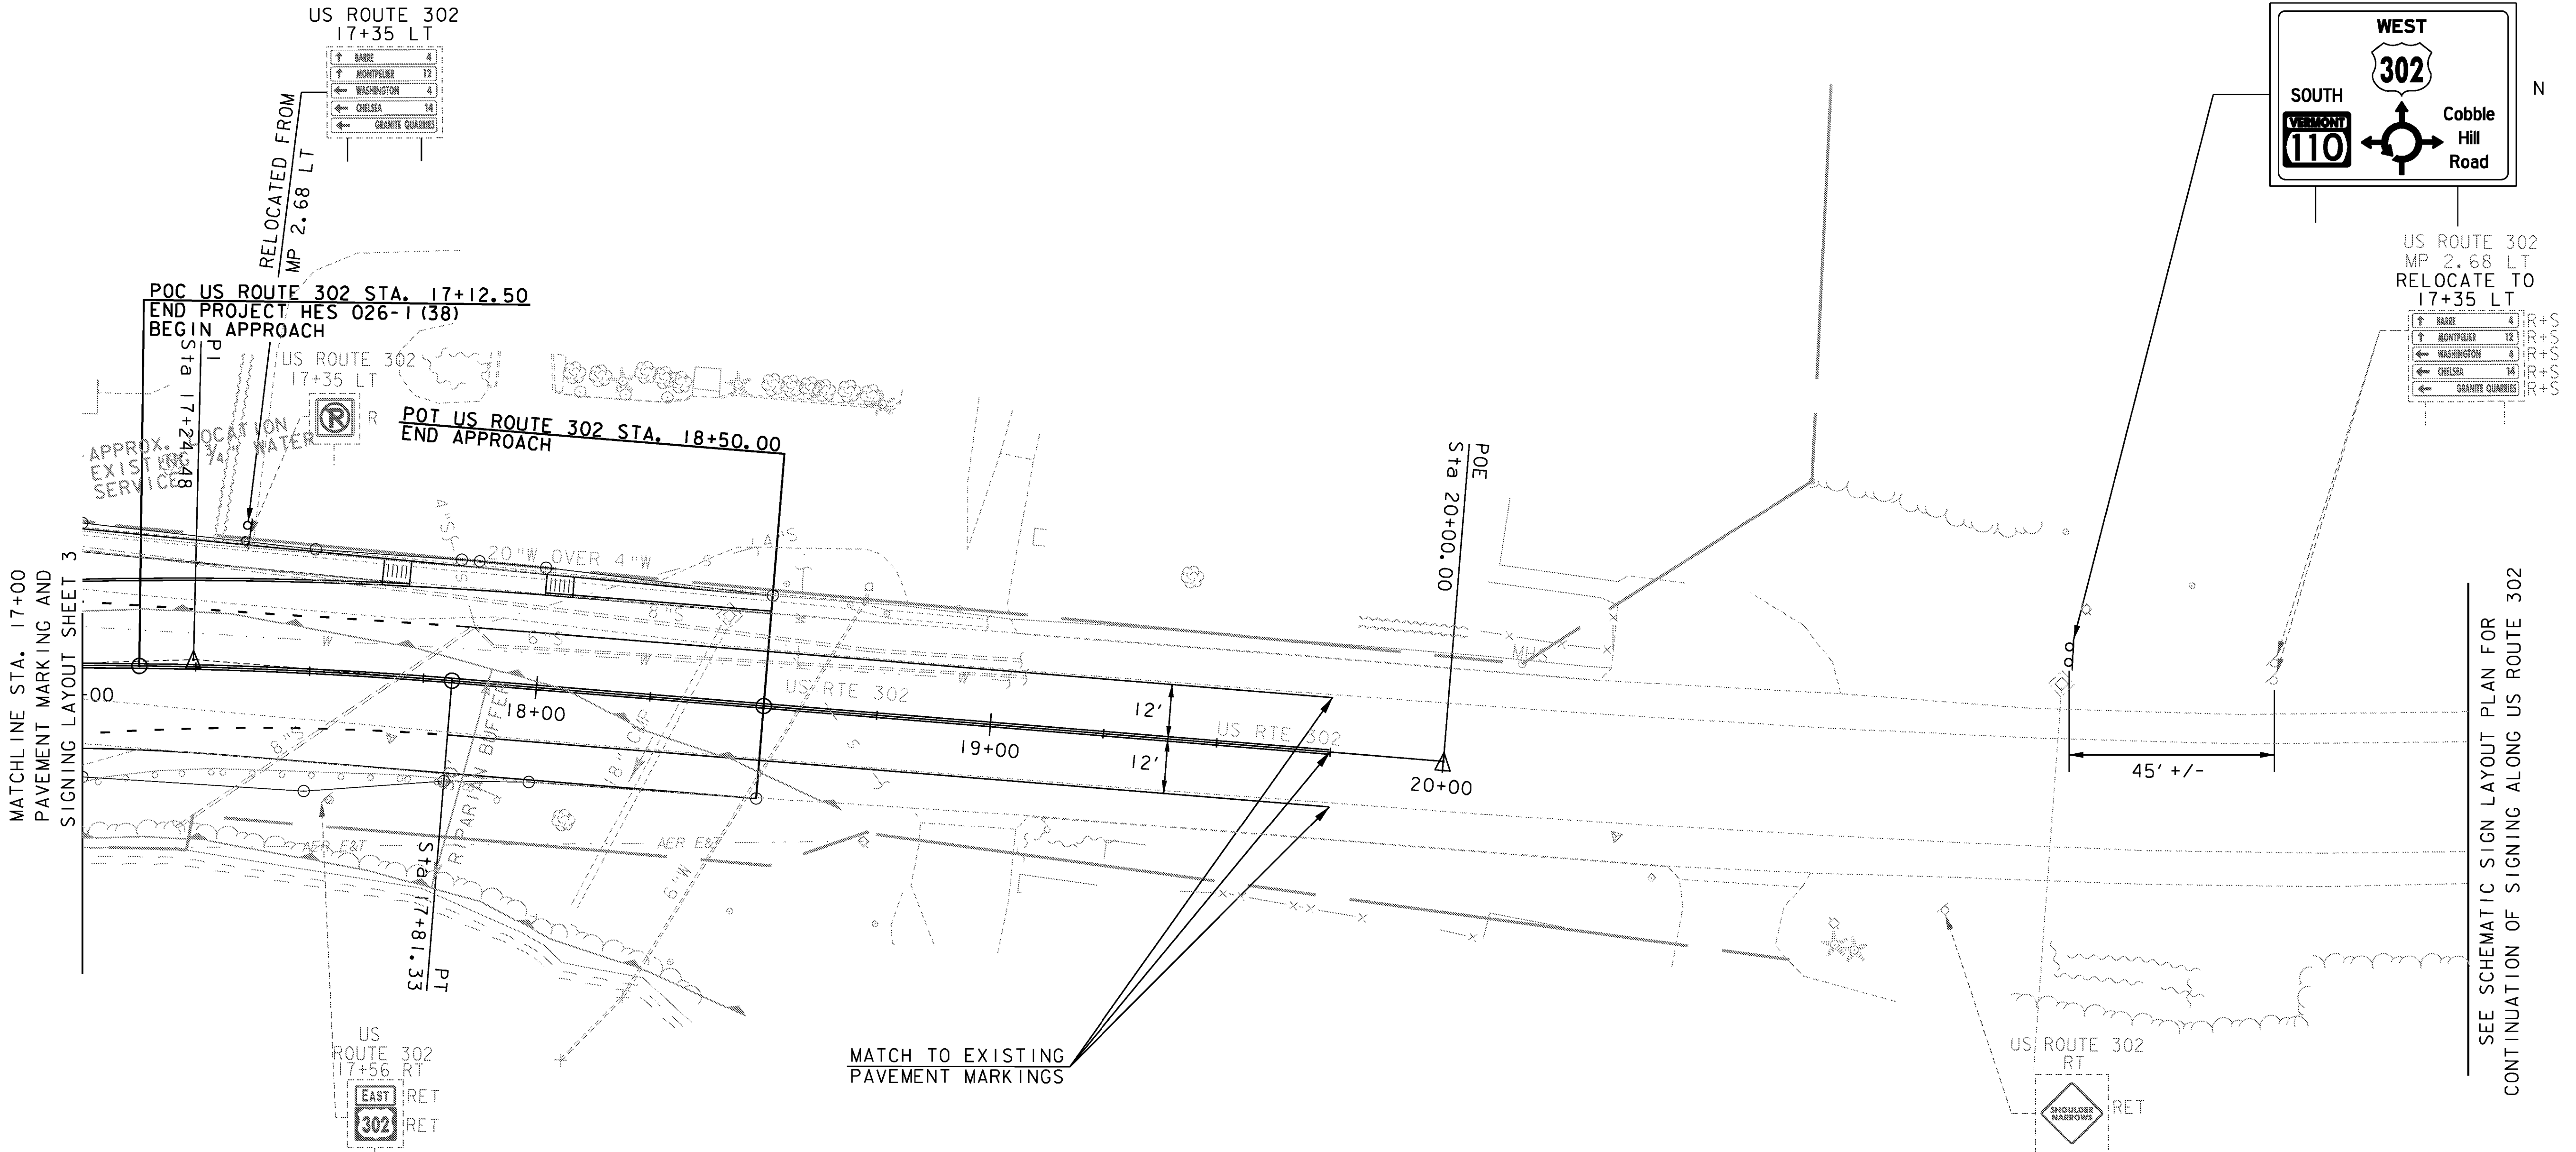


- DURABLE 4 INCH WHITE LINE**
US ROUTE 302 17+81 ~ 19+75, LT 194' LF
US ROUTE 302 17+81 ~ 19+75, RT 194' LF
- DURABLE 4 INCH YELLOW LINE**
US ROUTE 302 17+00 ~ 19+75, 2 X 275' = 550' LF
- DURABLE 8 INCH WHITE LINE**
US ROUTE 302 17+00 ~ 17+81, LT 2 X 13' = 26' LF
US ROUTE 302 17+00 ~ 17+81, RT, R = 550', 2 X 13' = 26' LF

- REMOVAL OF EXISTING PAVEMENT MARKINGS**
US ROUTE 302 18+50 LT ~ 19+75 LT
US ROUTE 302 18+50 RT ~ 19+75 RT
- REMOVE SIGNS**
17 EACH
- ERECTING SALVAGED SIGNS**
8 EACH



DATUM
VERTICAL NAVD 88
HORIZONTAL NAD 83 (1996)

SIGN LEGEND	
	= EXISTING SIGN AND POST
	= NEW SIGN W/ NEW POST
R	= REMOVE EXISTING SIGN AND POST
R+S	= SALVAGE SIGN AND RELOCATE TO NOTED LOCATION WITH NEW SIGN POST. REMOVE AND DISPOSE EXISTING SIGN POST
N	= NEW
RET	= RETAIN AT EXISTING LOCATION
B-B	= BACK TO BACK

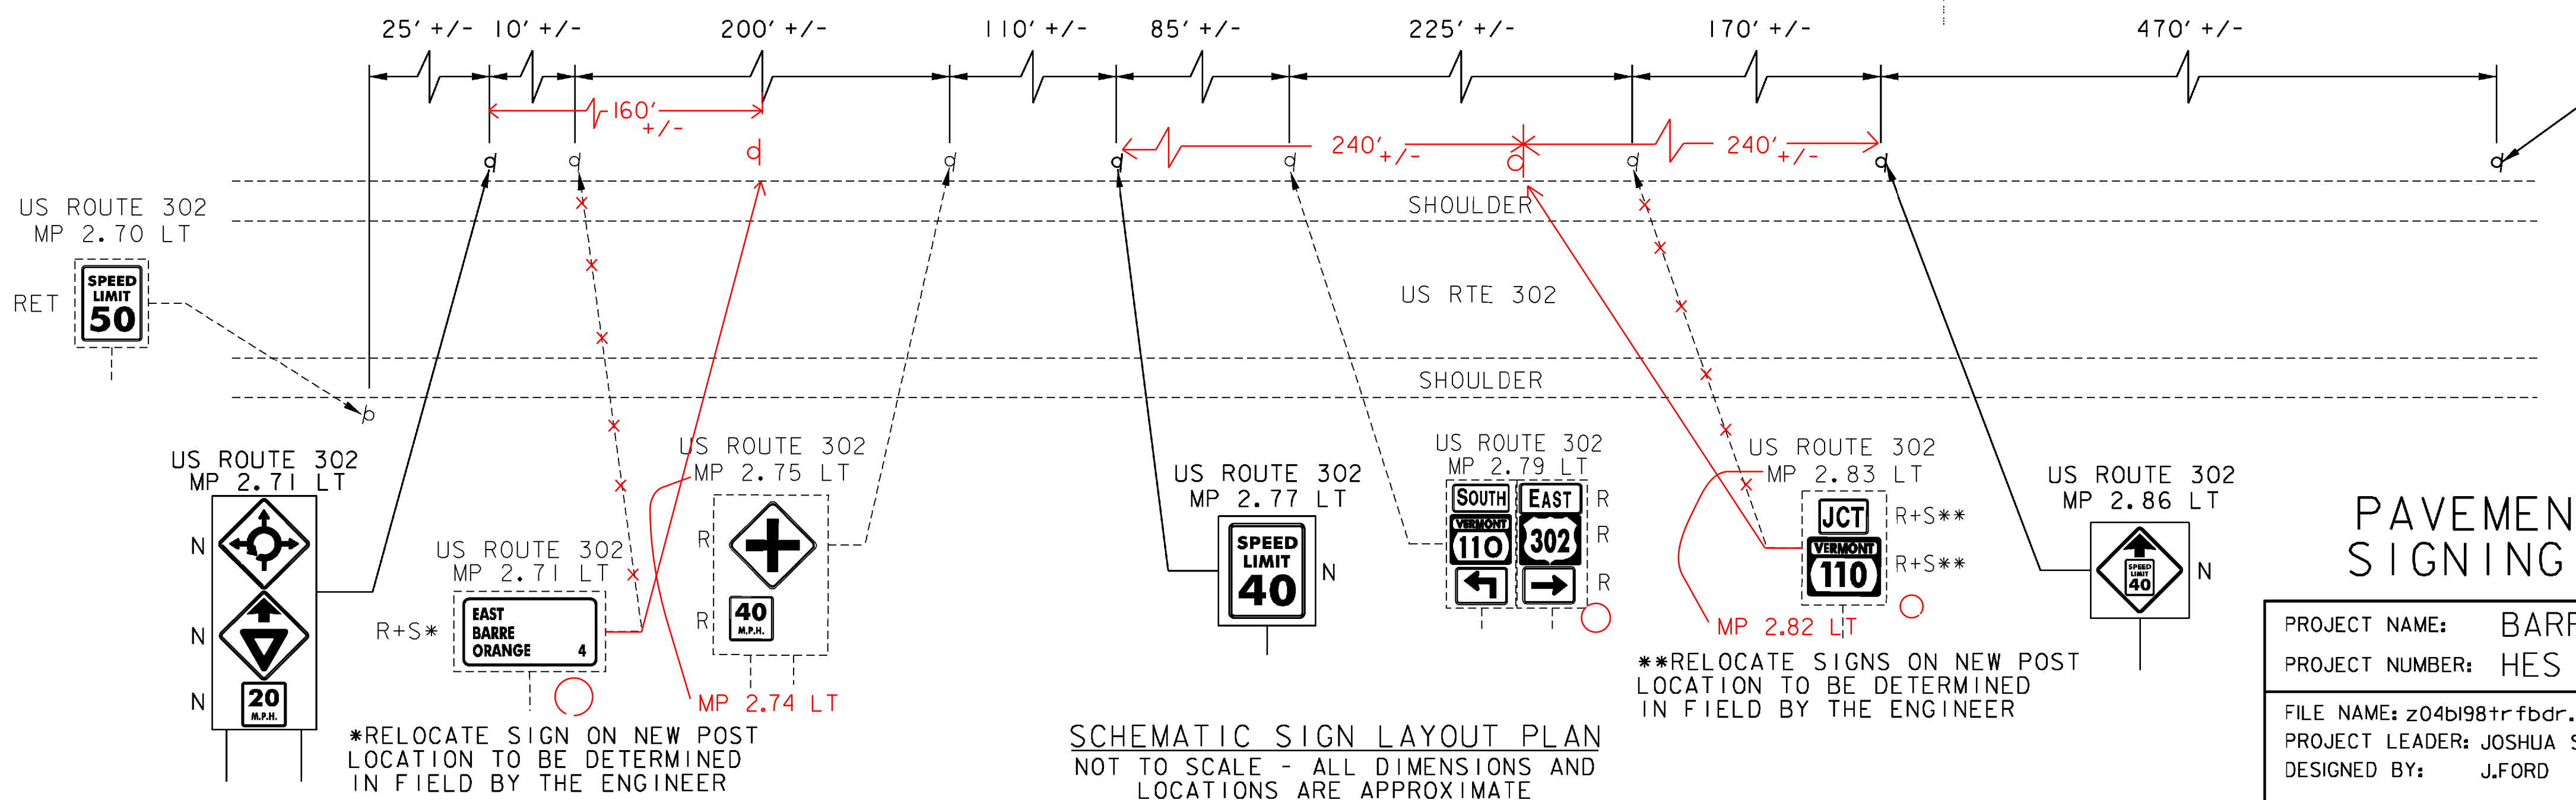

NOTES:
THE EXACT LOCATION OF THE PROPOSED SIGNS TO BE DETERMINED IN THE FIELD BY THE ENGINEER.

PAVEMENT MARKING AND SIGNING LAYOUT SHEET 5

PROJECT NAME: BARRE TOWN	PLOT DATE: 1/30/2008
PROJECT NUMBER: HES 026-1(38)	DRAWN BY: V.KACOYANNAKIS
FILE NAME: z04b198tr f bdr.dgn	CHECKED BY: J.FORD
PROJECT LEADER: JOSHUA SCHULTZ	SHEET 39 OF 64
DESIGNED BY: J.FORD	

SCHEMATIC SIGN LAYOUT PLAN
NOT TO SCALE - ALL DIMENSIONS AND LOCATIONS ARE APPROXIMATE