

NOTES:

1. DRILL HOLE TO ACCEPT SPECIFIED CHAIN AND BOLT AT BOTH ENDS ON POST BARRIER.
2. CHAIN SHALL BE INSTALLED THE ENTIRE LENGTH OF THE GRANITE POST BARRIER. CHAIN SHALL BE SUFFICIENTLY LONG ENOUGH TO ALLOW 6 INCH SAG FROM DRILLED HOLE BETWEEN POSTS.


**SPECIAL PROVISION
(GRANITE POST AND CHAIN FENCE DETAIL)**

SCALE: NOT TO SCALE

PLACE TREE IN THE HOLE SO THAT MAIN ORDER ROOTS ARE AT OR SLIGHTLY ABOVE FINISHED GRADE. REMOVE ALL EXCESS SOIL ON TOP OF THE ROOT FLARE AND ABOVE MAIN ORDER ROOTS. AVOID PLANTING TOO DEEP. ONCE IN THE PLANTING HOLE, REMOVE TWINE AND BURLAP FROM TOP 1/2 OF BALL; IF SYNTHETIC- REMOVE COMPLETELY. CUT WIRE BASKETS AND REMOVE ENTIRE SIDES.

GENERAL LANDSCAPE NOTES:

1. SEE ROADWAY TYPICAL SECTION SHEETS FOR SEEDING FORMULAS, FERTILIZER APPLICATION RATES, MULCH REQUIREMENTS ETC...
2. LANDSCAPE BACKFILL, TRUCK MEASUREMENT
BACKFILL WITH PLANTING MIX OF 1/2 SCREENED TOPSOIL, 1/4 COMPOST AND 1/4 NATIVE MATERIAL AS APPROVED BY THE ENGINEER. UNSUITABLE NATIVE MATERIAL SHALL BE REPLACED WITH IMPORTED APPROVED TOPSOIL AS DIRECTED BY ENGINEER.
3. WATERING
SHRUBS TO RECEIVE A MINIMUM OF 5 GALLONS AT EACH WATERING, TWICE WEEKLY DURING ESTABLISHMENT PERIOD. TREES TO RECEIVE A MINIMUM OF 10 GALLONS AT EACH WATERING, TWICE WEEKLY DURING ESTABLISHMENT PERIOD. CONTRACTORS SHALL MAINTAIN AND PROVIDE A LOG TO THE RESIDENT ENGINEER SHOWING AMOUNTS AND DATES OF WATERING AND NOTING NATURAL RAINFALL EVENTS. WATERING SCHEDULE MAY BE ADJUSTED AS APPROVED BY THE RESIDENT ENGINEER.
4. TREE PIT WIDTH
FOR TREES WITHIN PROJECT CONSTRUCTION LIMIT, THE DIMENSIONS OF BACKFILL PLANTING MIX ARE NOTED ON EACH PLAN SHEET. FOR ALL TREES TO BE PLANTED OUTSIDE PROJECT CONSTRUCTION LIMIT, THE PLANTING PIT SHALL BE THREE TIMES THE WIDTH OF THE ROOTBALL.
5. BARK MULCH SHALL BE CEDAR AND PROVIDED IN ACCORDANCE WITH SUBSECTION 755.10 (C).

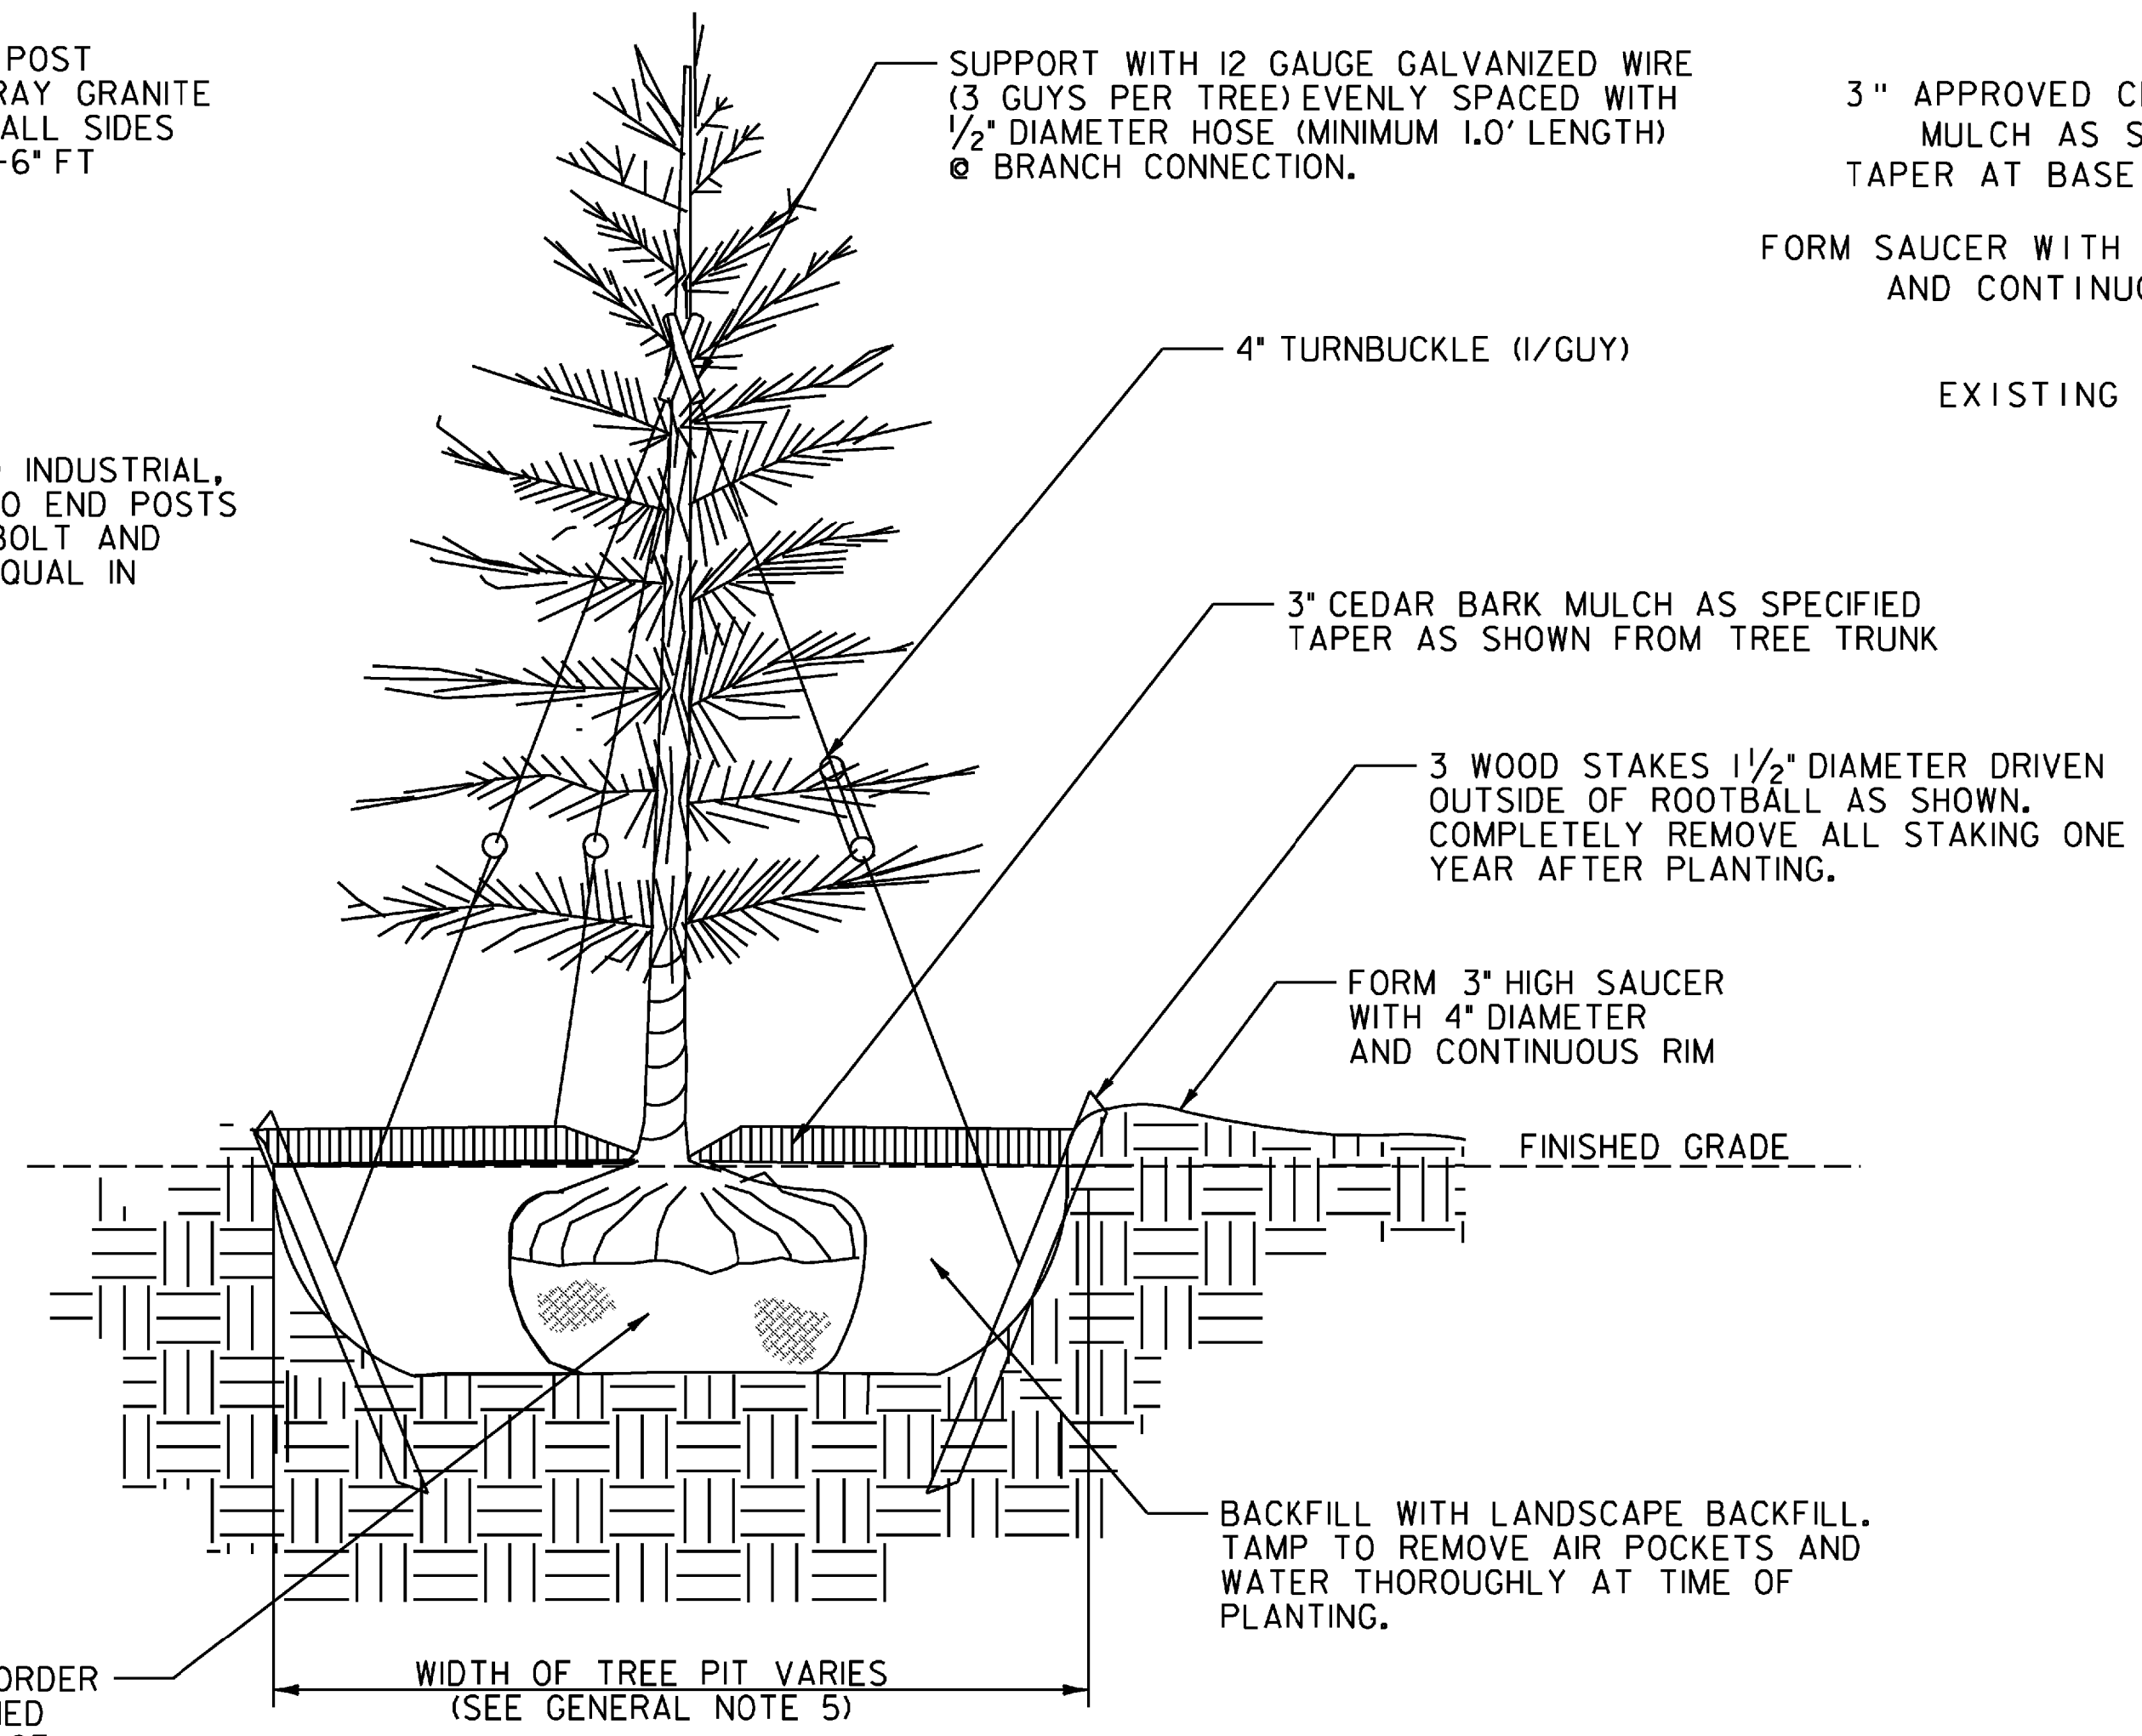

EVERGREEN TREE PLANTING DETAIL


SCALE: NOT TO SCALE

NOTES:


1. ANTI-DESICCANT SPRAY IS TO BE APPLIED TO ALL EVERGREENS PER MANUFACTURER SPECIFICATIONS.
2. COMPLETELY REMOVE ALL GUY-WIRES AND TURNBUCKLE ONE YEAR AFTER PLANTING.

3" CEDAR BARK MULCH TAPER AS SHOWN FROM TREE TRUNK NO MULCH SHALL BE PLACED WITHIN 2" OF TREE TRUNK

FORM 3" HIGH, FIRM, CONTINUOUS SAUCER WITH 4" DIAMETER AND CONTINUOUS RIM FIRMLY PACK SAUCER TO RETAIN IT'S SHAPE FOR REPEATED WATERING.

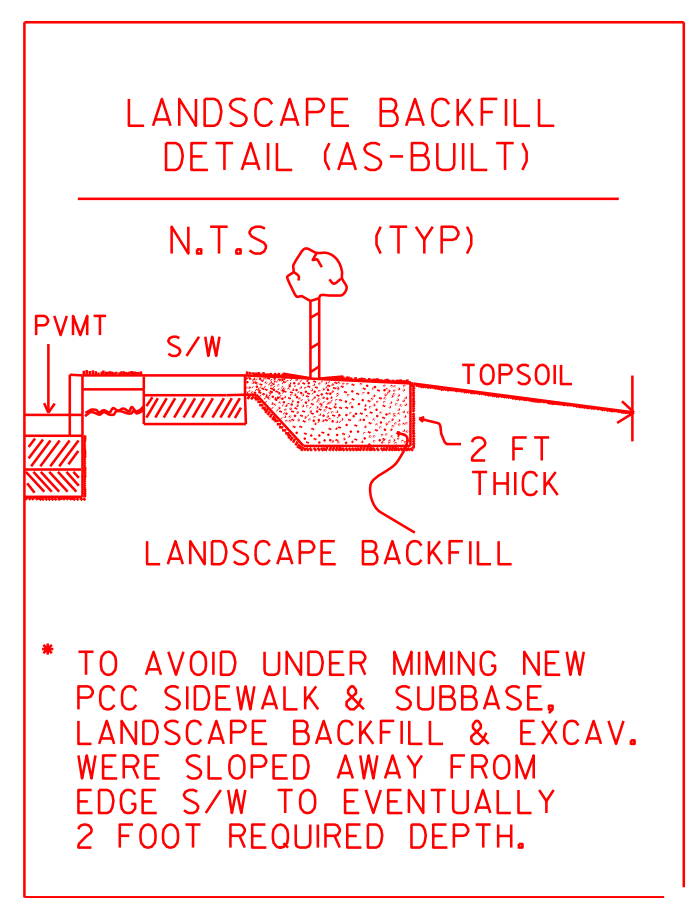


TO AVOID UNDER MIMING NEW PCC SIDEWALK & SUBBASE, LANDSCAPE BACKFILL & EXCAV. WERE SLOPED AWAY FROM EDGE S/W TO EVENTUALLY 2 FOOT REQUIRED DEPTH.

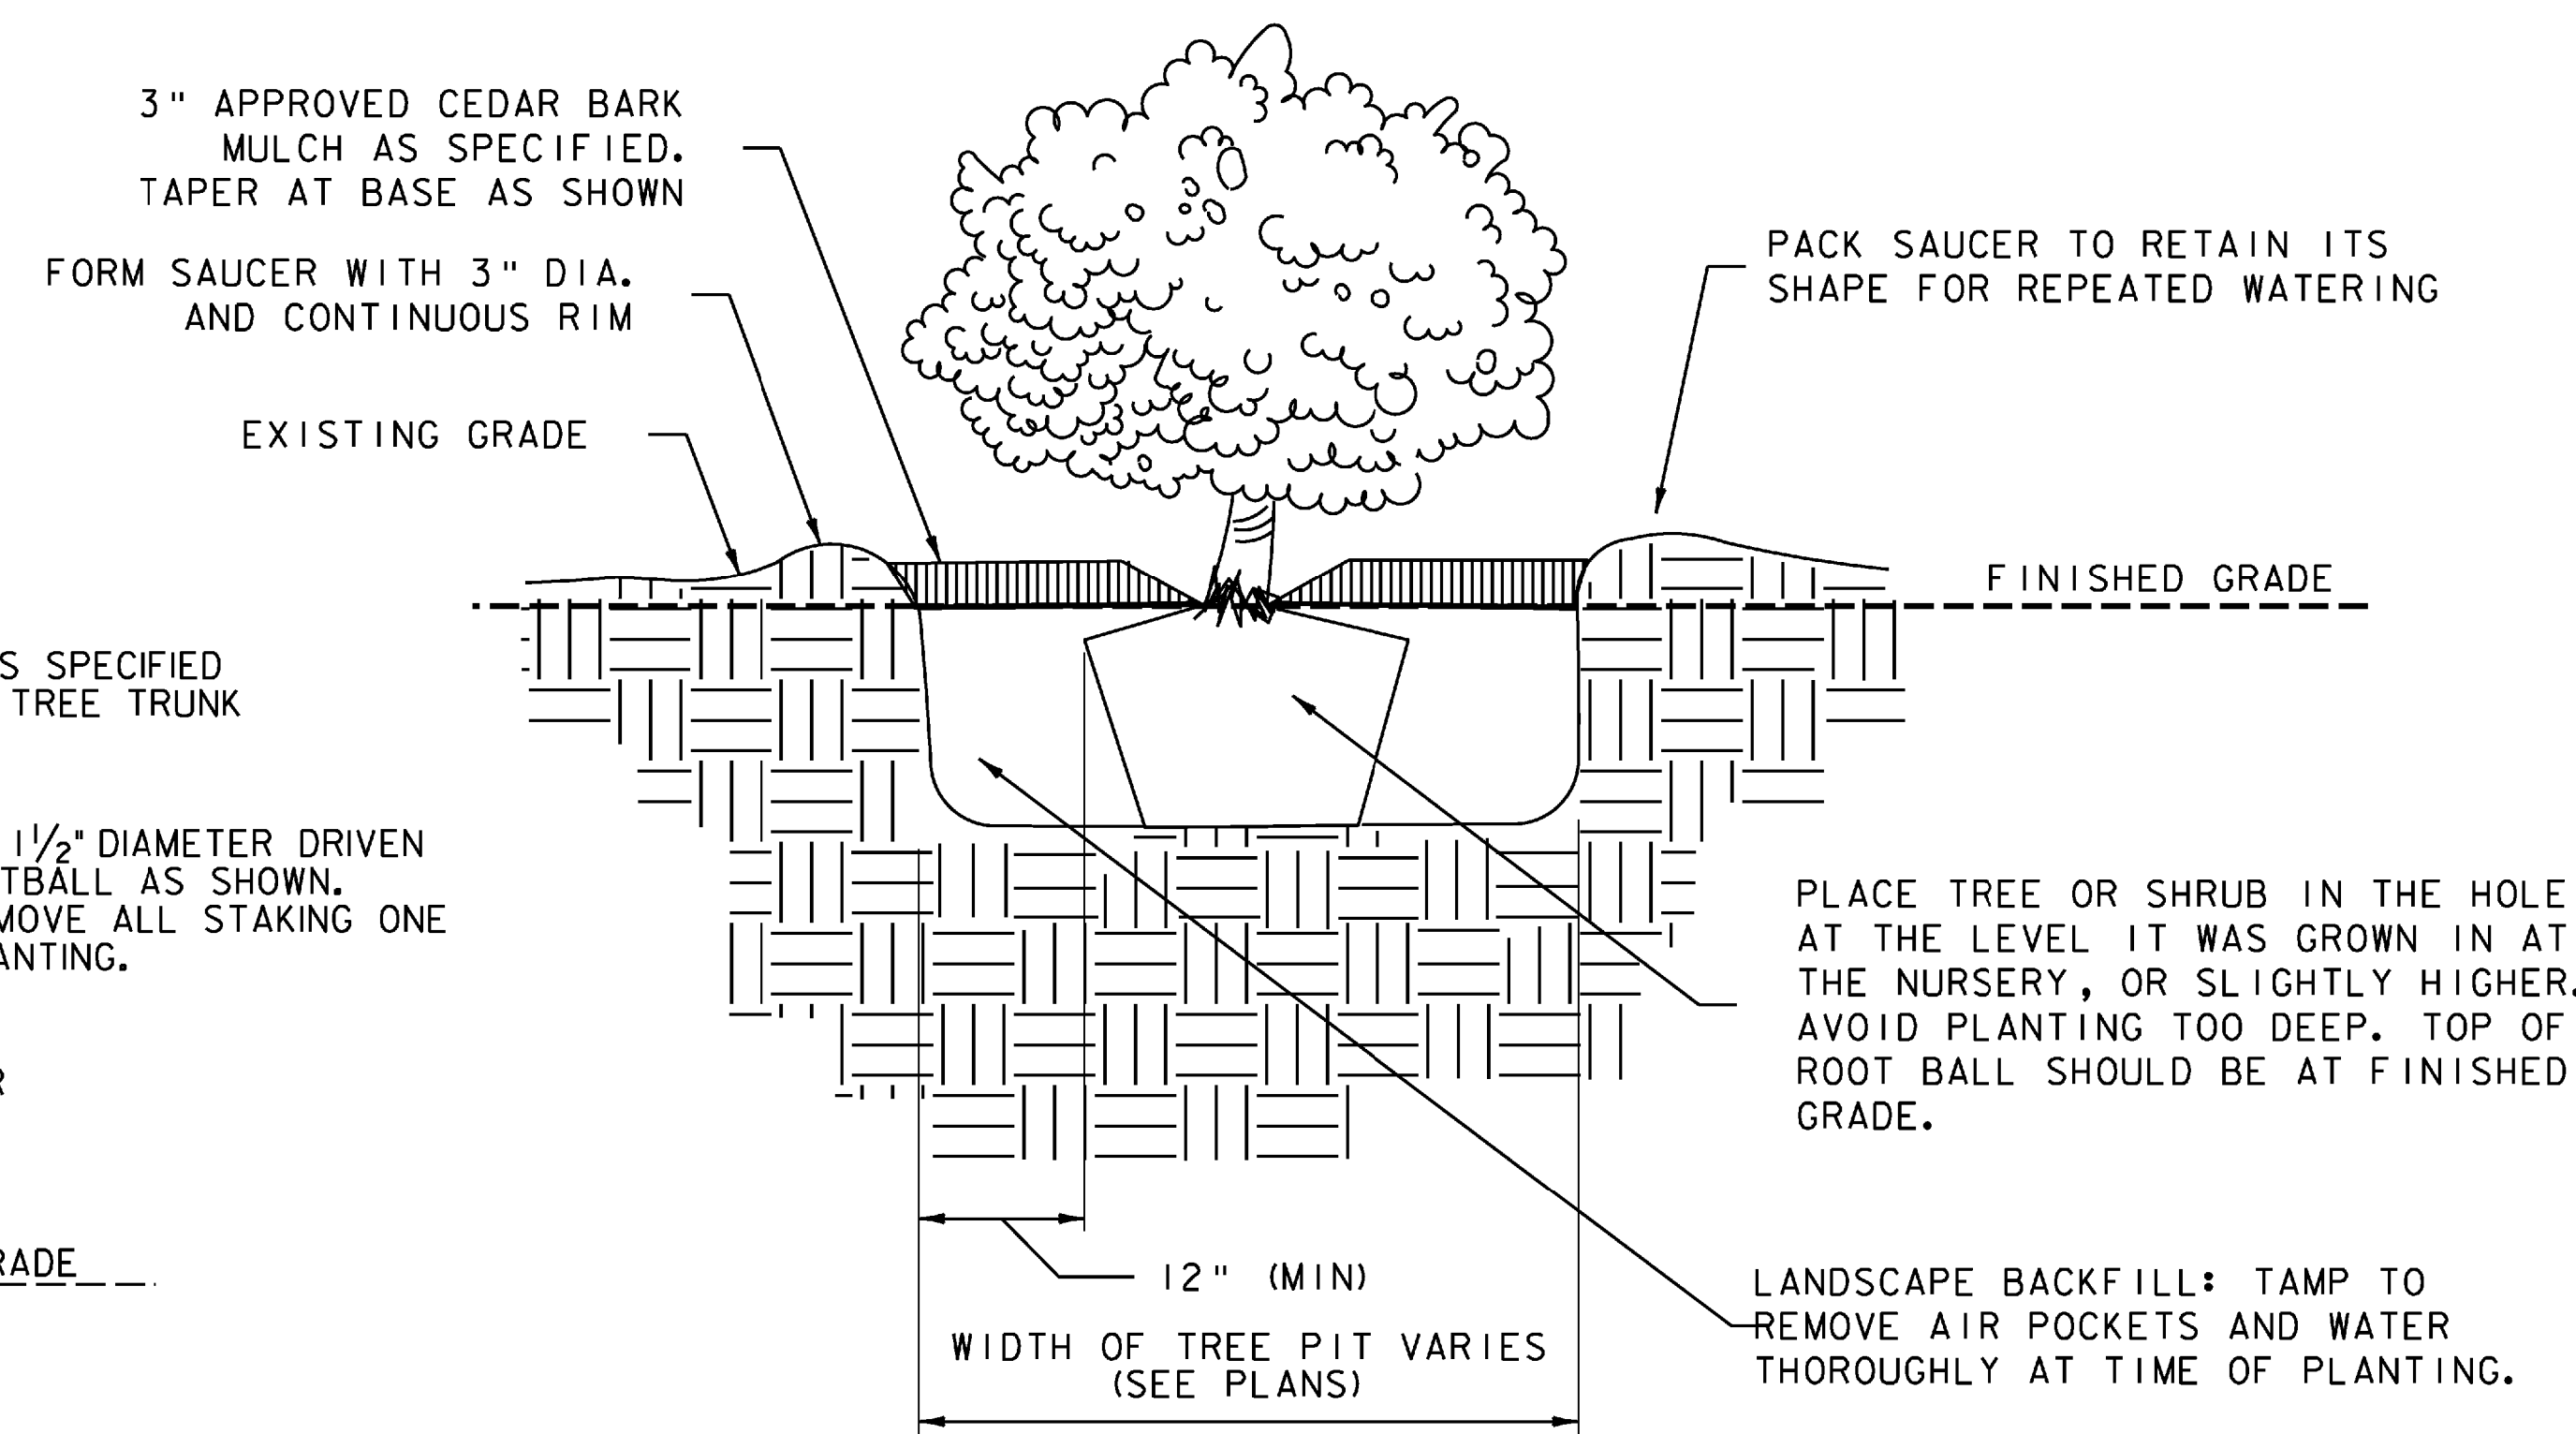

SHRUB PLANTING DETAIL

SCALE: NOT TO SCALE

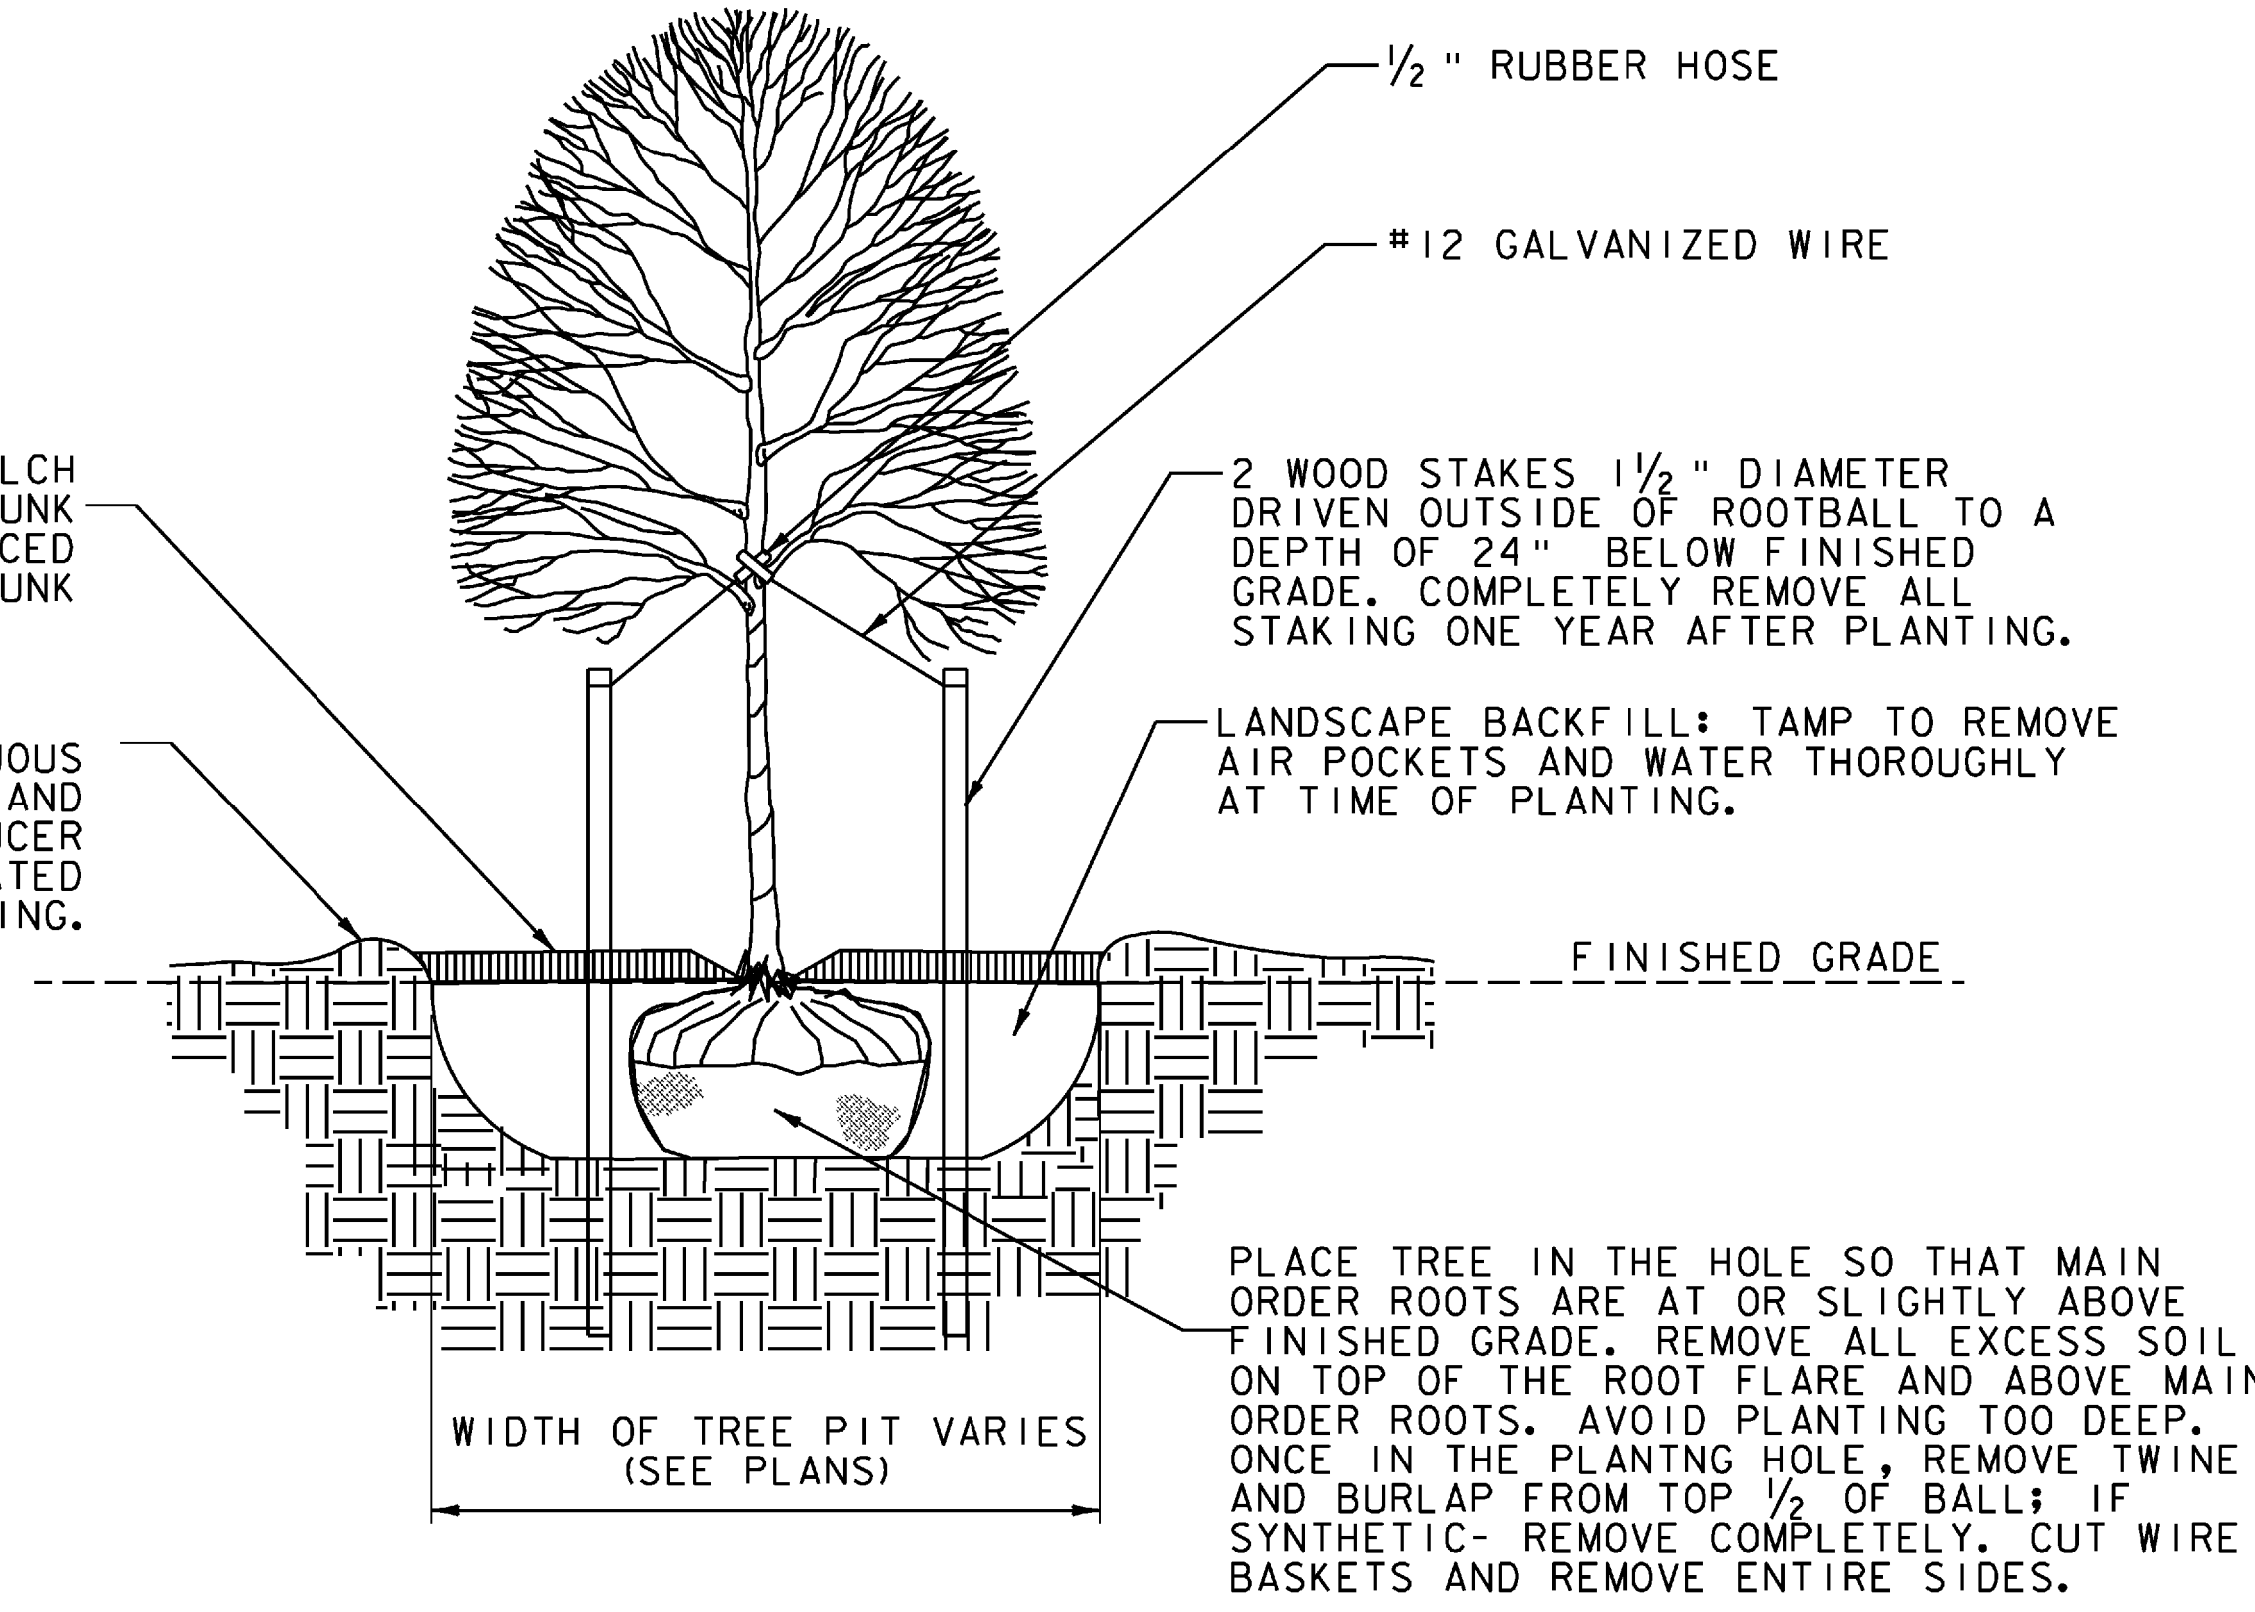

TYPICAL DECIDUOUS TREE PLANTING DETAIL

SCALE: NOT TO SCALE

PROJECT NAME:	BARRE TOWN	PLOT DATE:	1/29/2008
PROJECT NUMBER:	HES 026-1(38)	DRAWN BY:	W.WONG
FILE NAME:	z04b198landdet.dgn	DESIGNED BY:	K.RYAN/J.BROWN
LANDSCAPE DETAIL SHEET		CHECKED BY:	K.JSHIKURA
		SHEET	49 OF 64

DATUM	
VERTICAL	NAVD 88
HORIZONTAL	NAD 83 (1996)