



FINAL SURVEY SURVEYED, PLOTTED, NOTE BOOK, TEMPLATE NO. DATE BY


ORIGINAL SURVEY SURVEYED, PLOTTED, NOTE BOOK, TEMPLATE NO. DATE BY

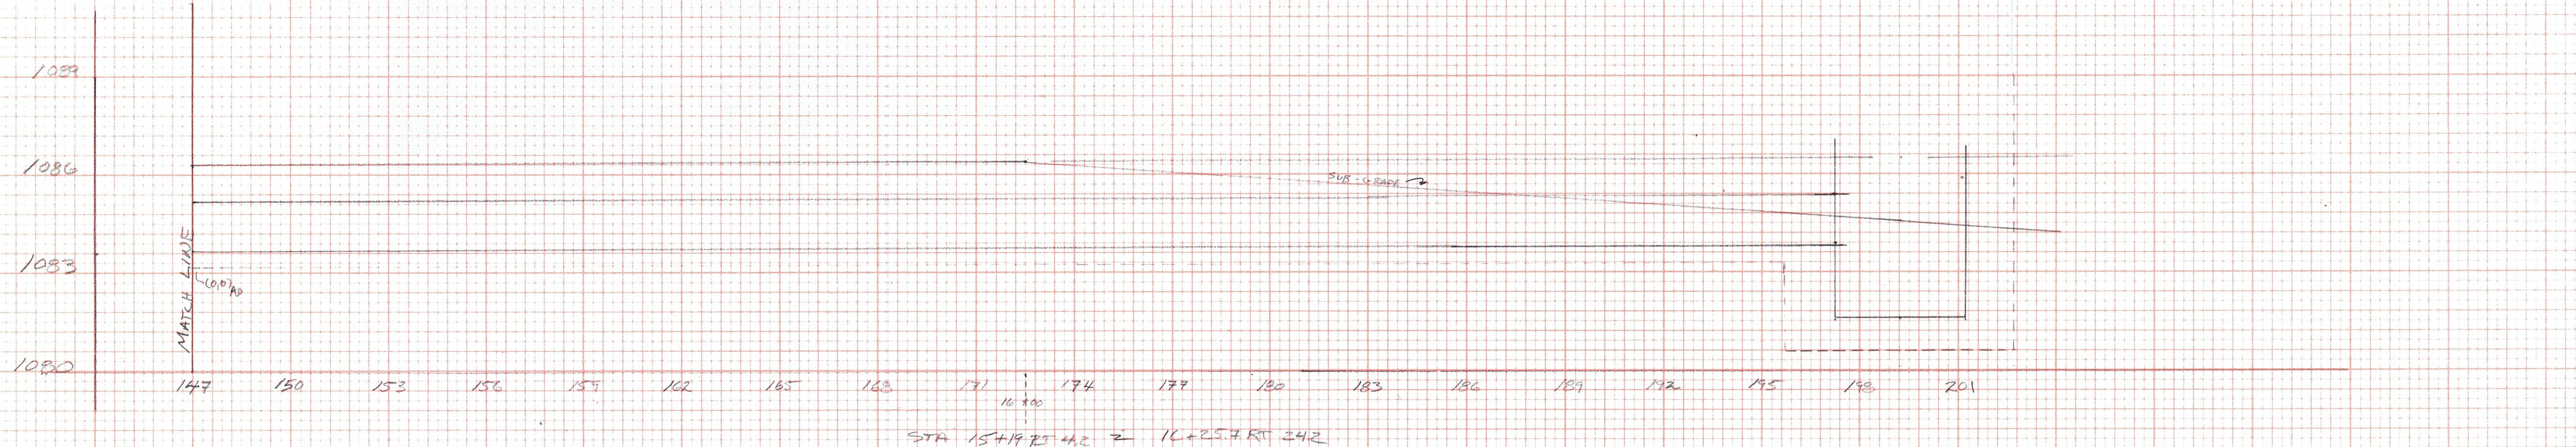

STA 15+19.5 RT 4.2 - 16+25.7 RT 24.2

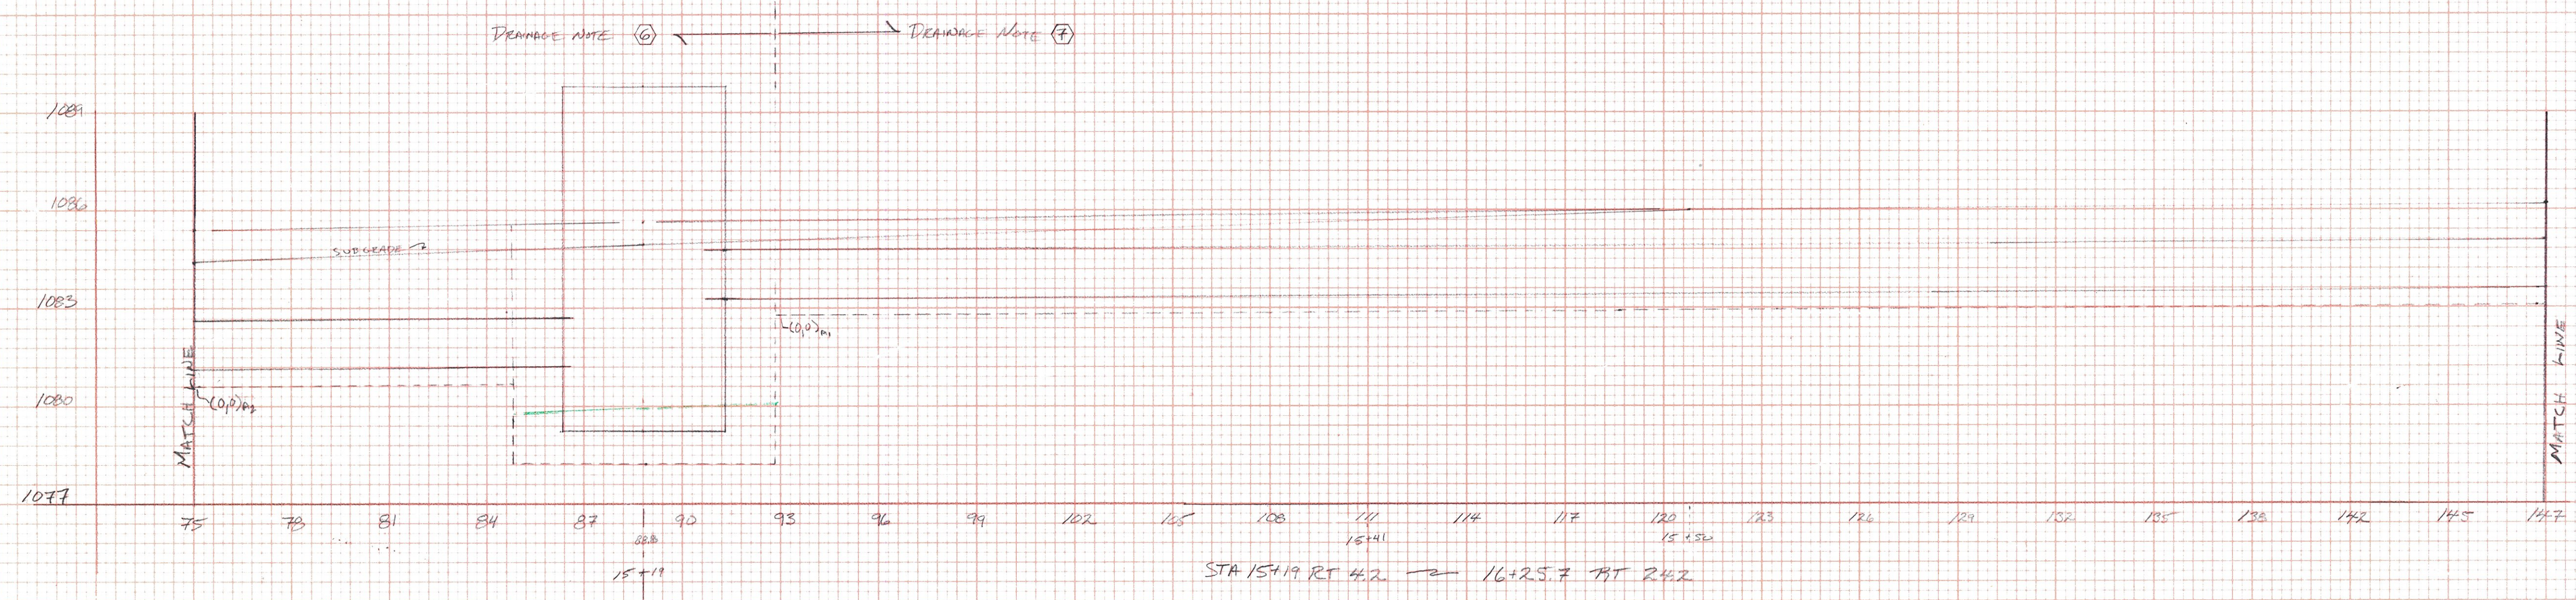

STA 15+19 RT 4.2 - 16+25.7 RT 24.2

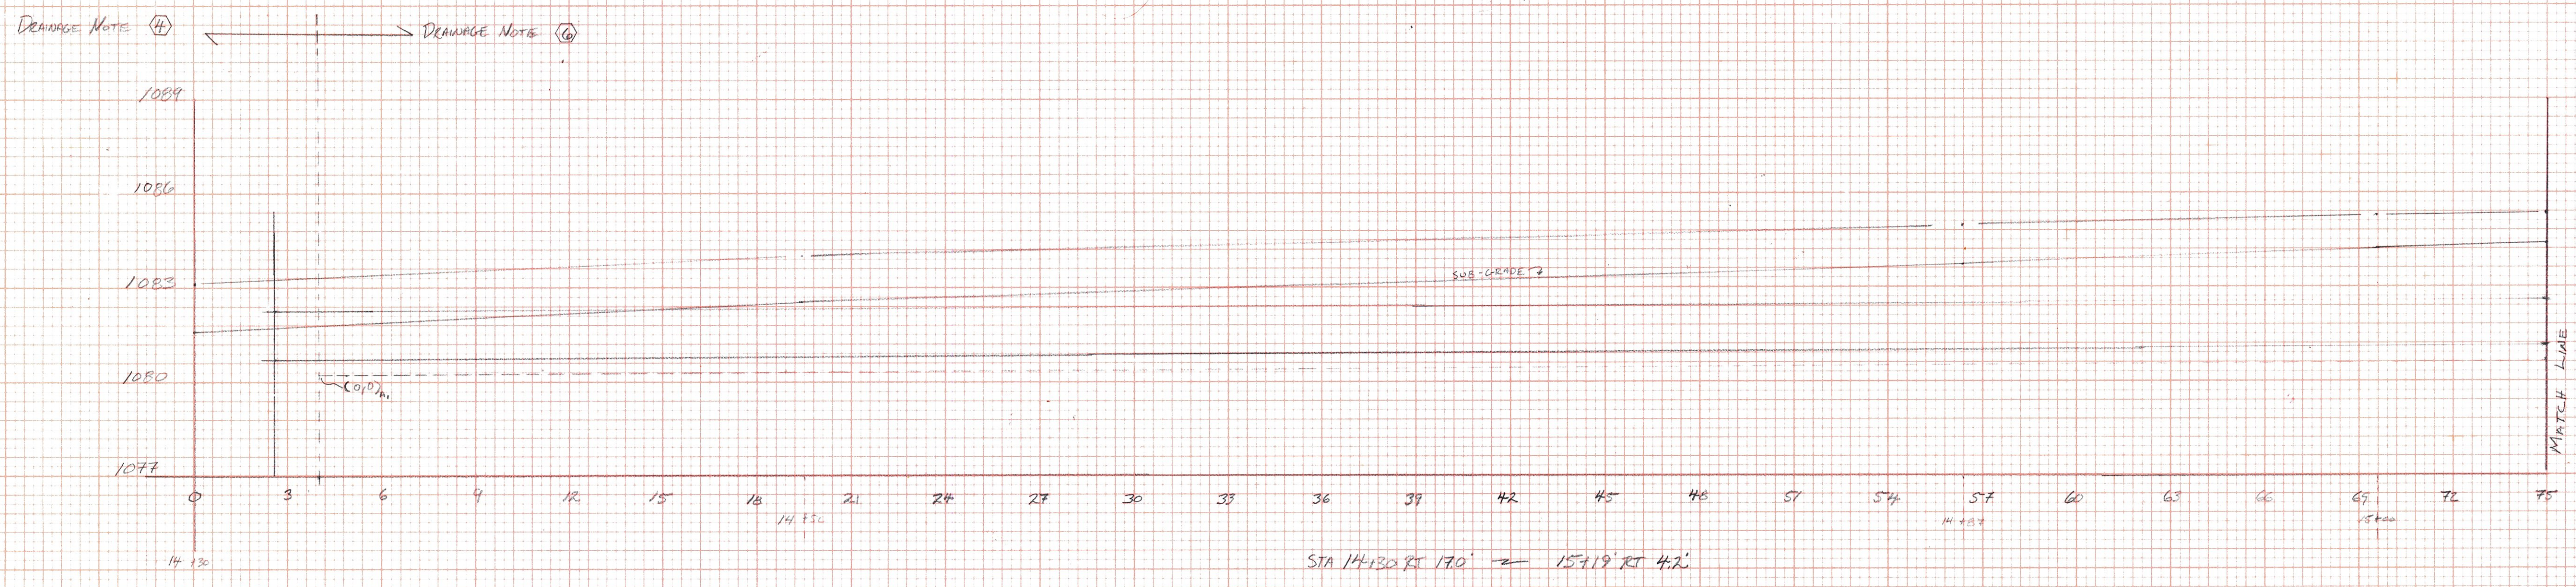

STA 14+30 RT 17.0 - 15+19 RT 4.2

BARRE TOWN HES ORG-1 (38)  
DRAINAGE SECTION  
SCALE: 1"=3'  
DWG: JMR DATE: 12/08/2008  
CAD: DATE:  
SHEET: 2 OF 6