
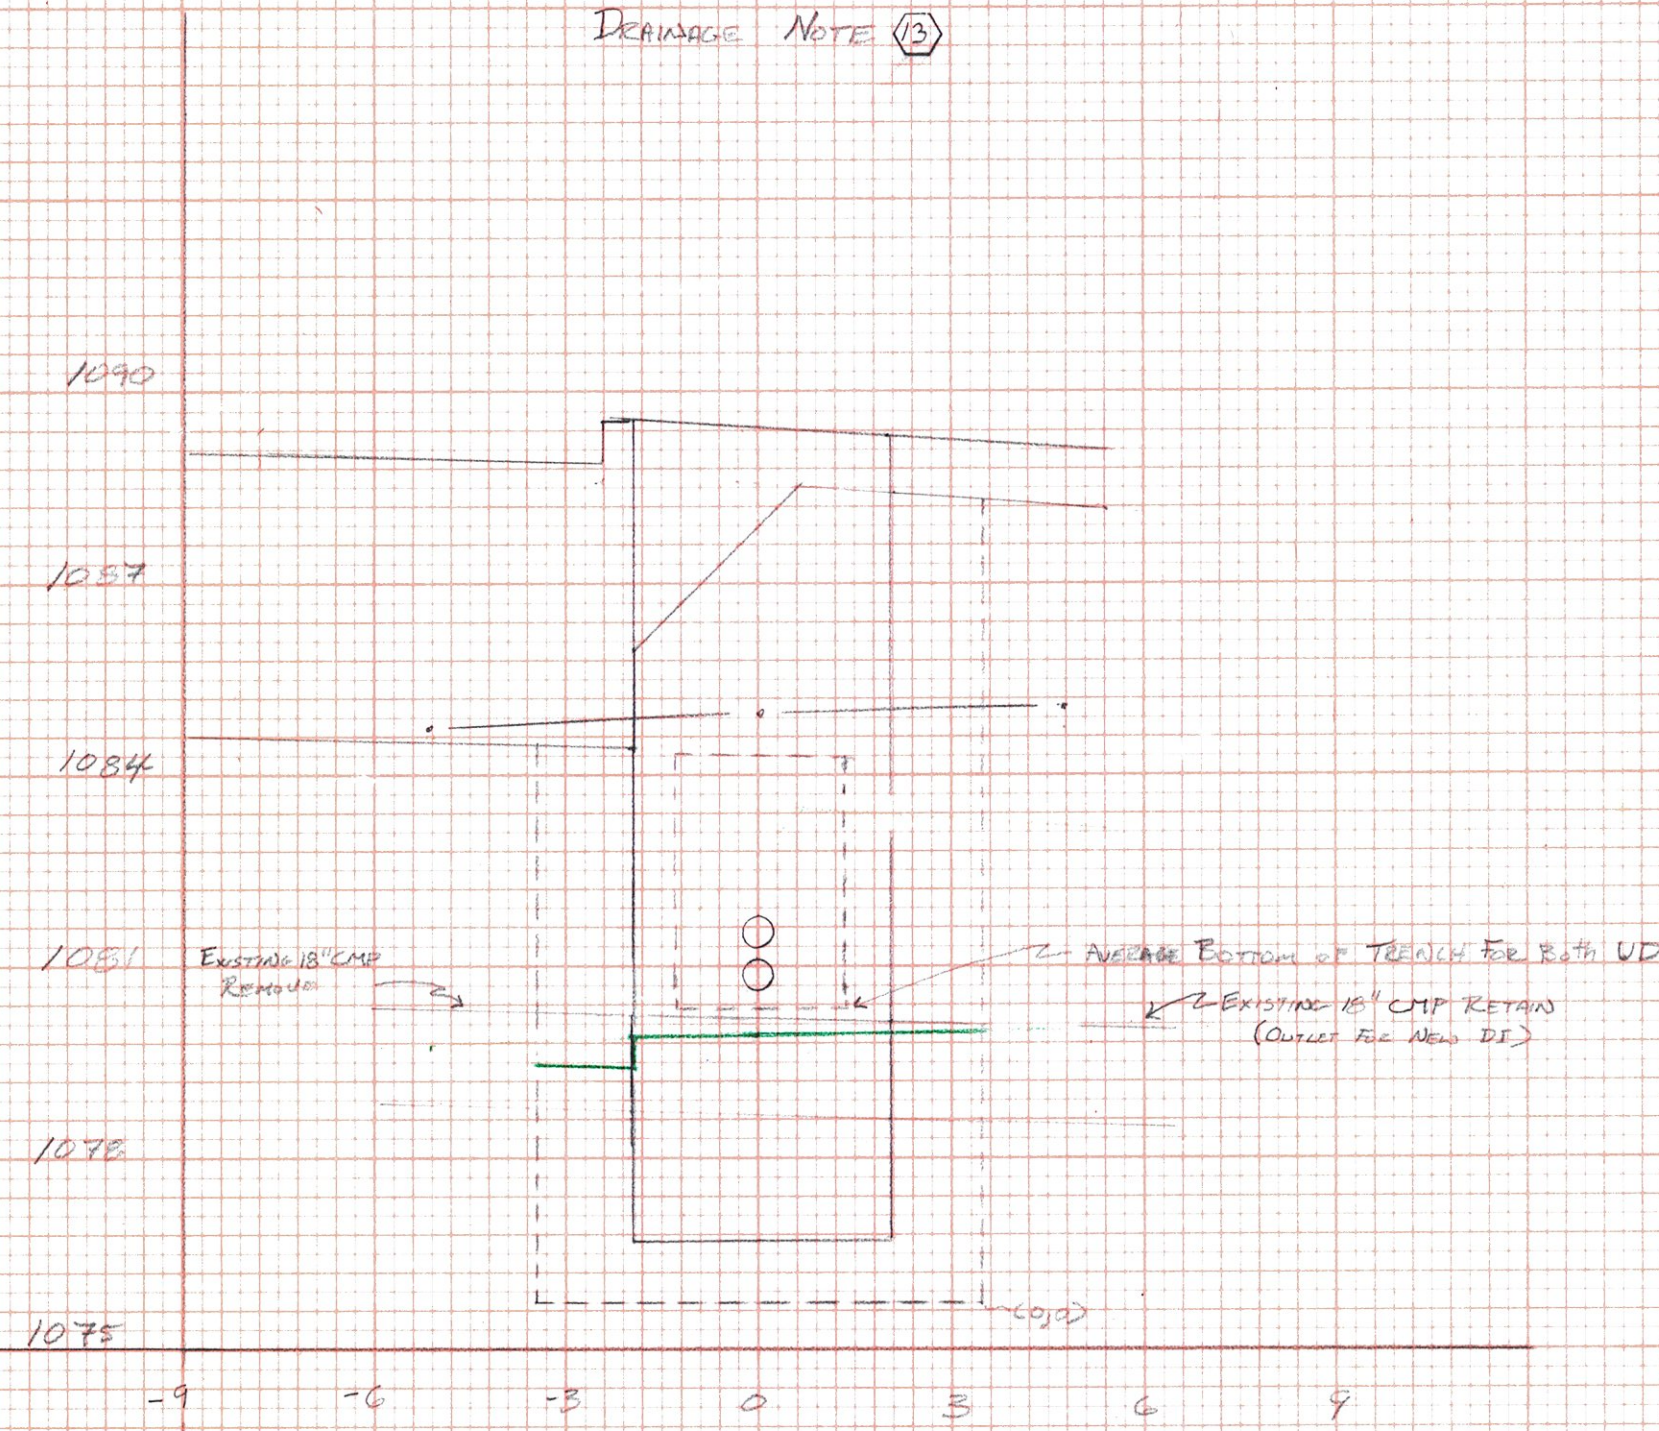
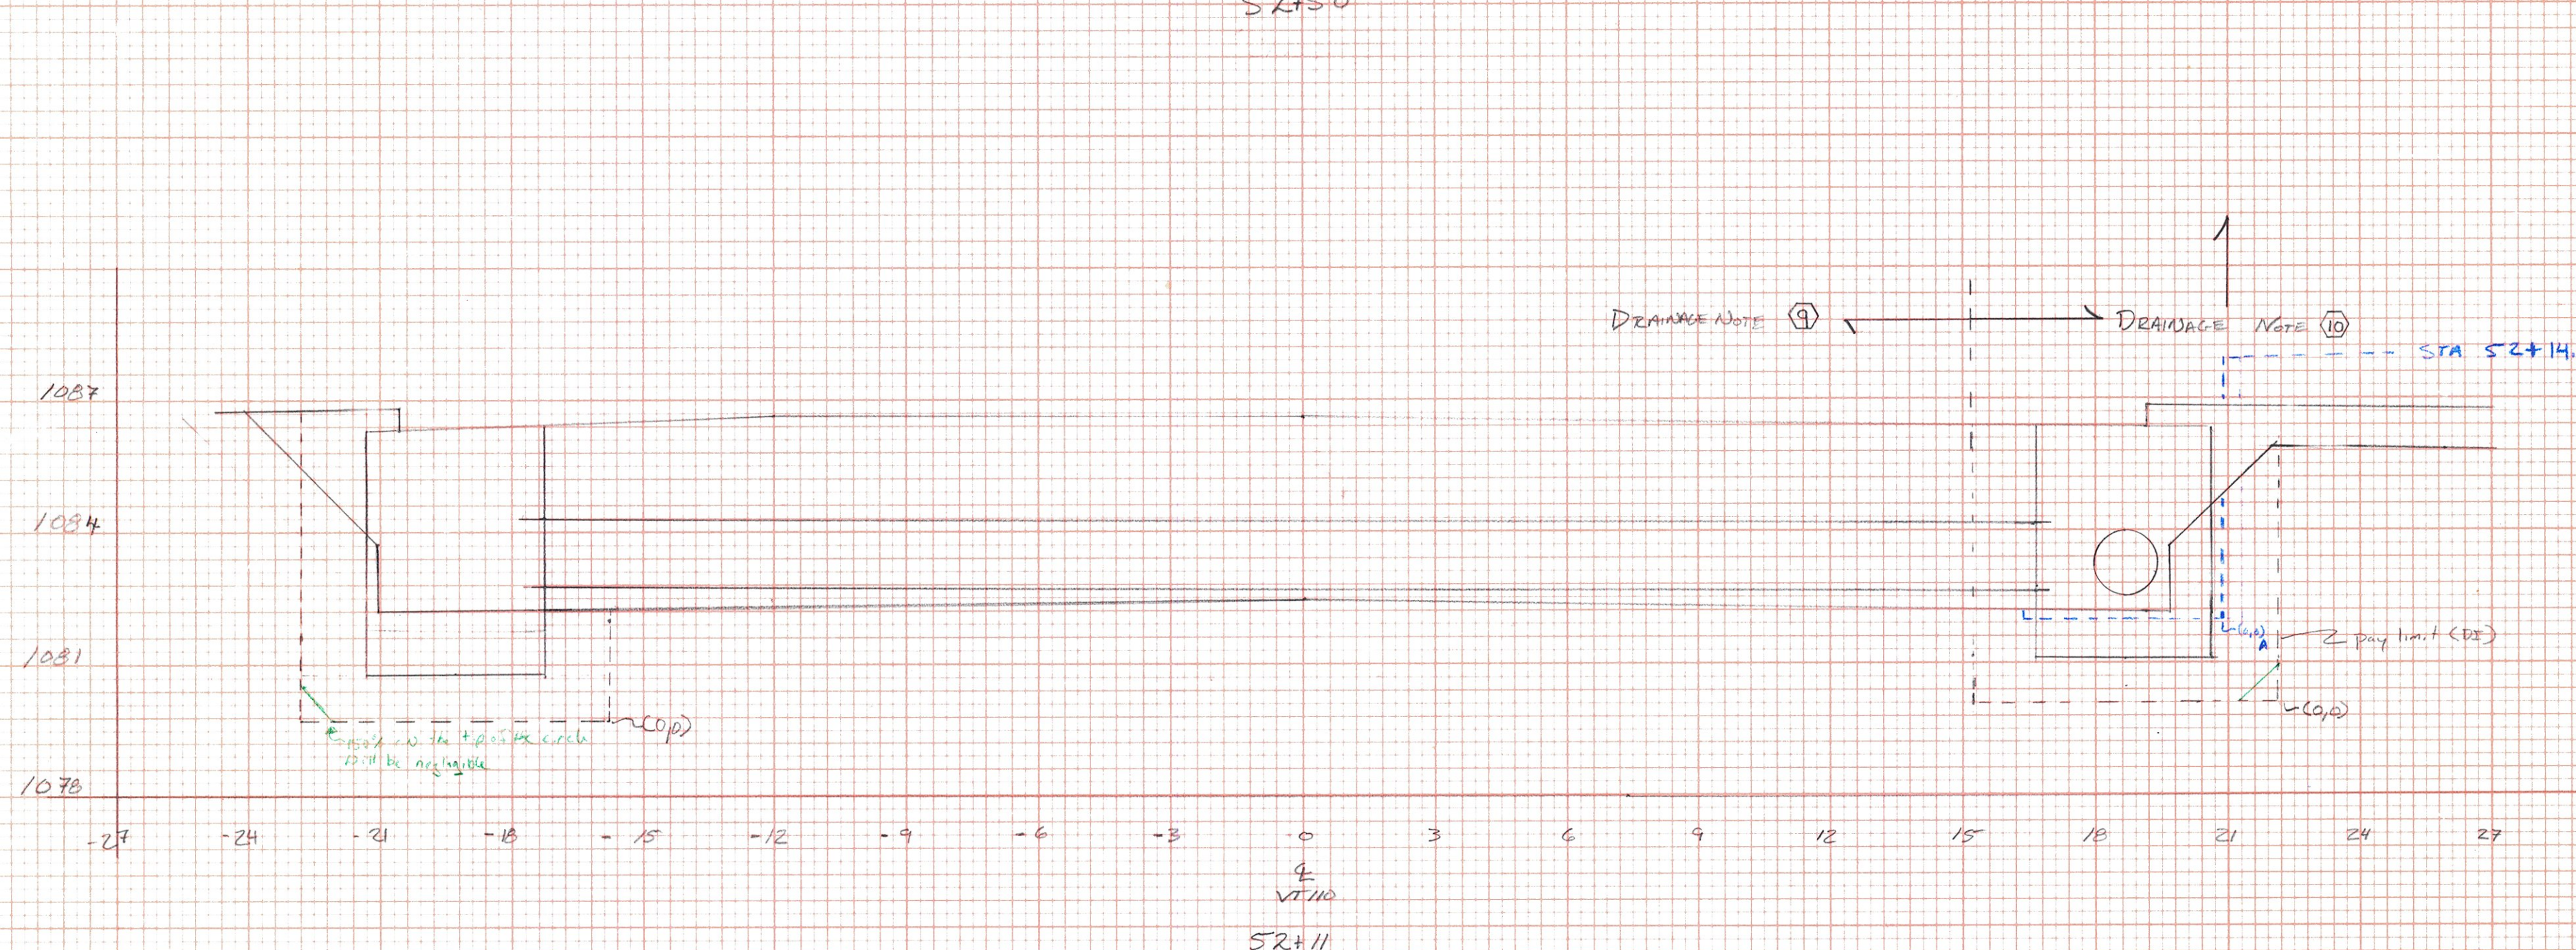
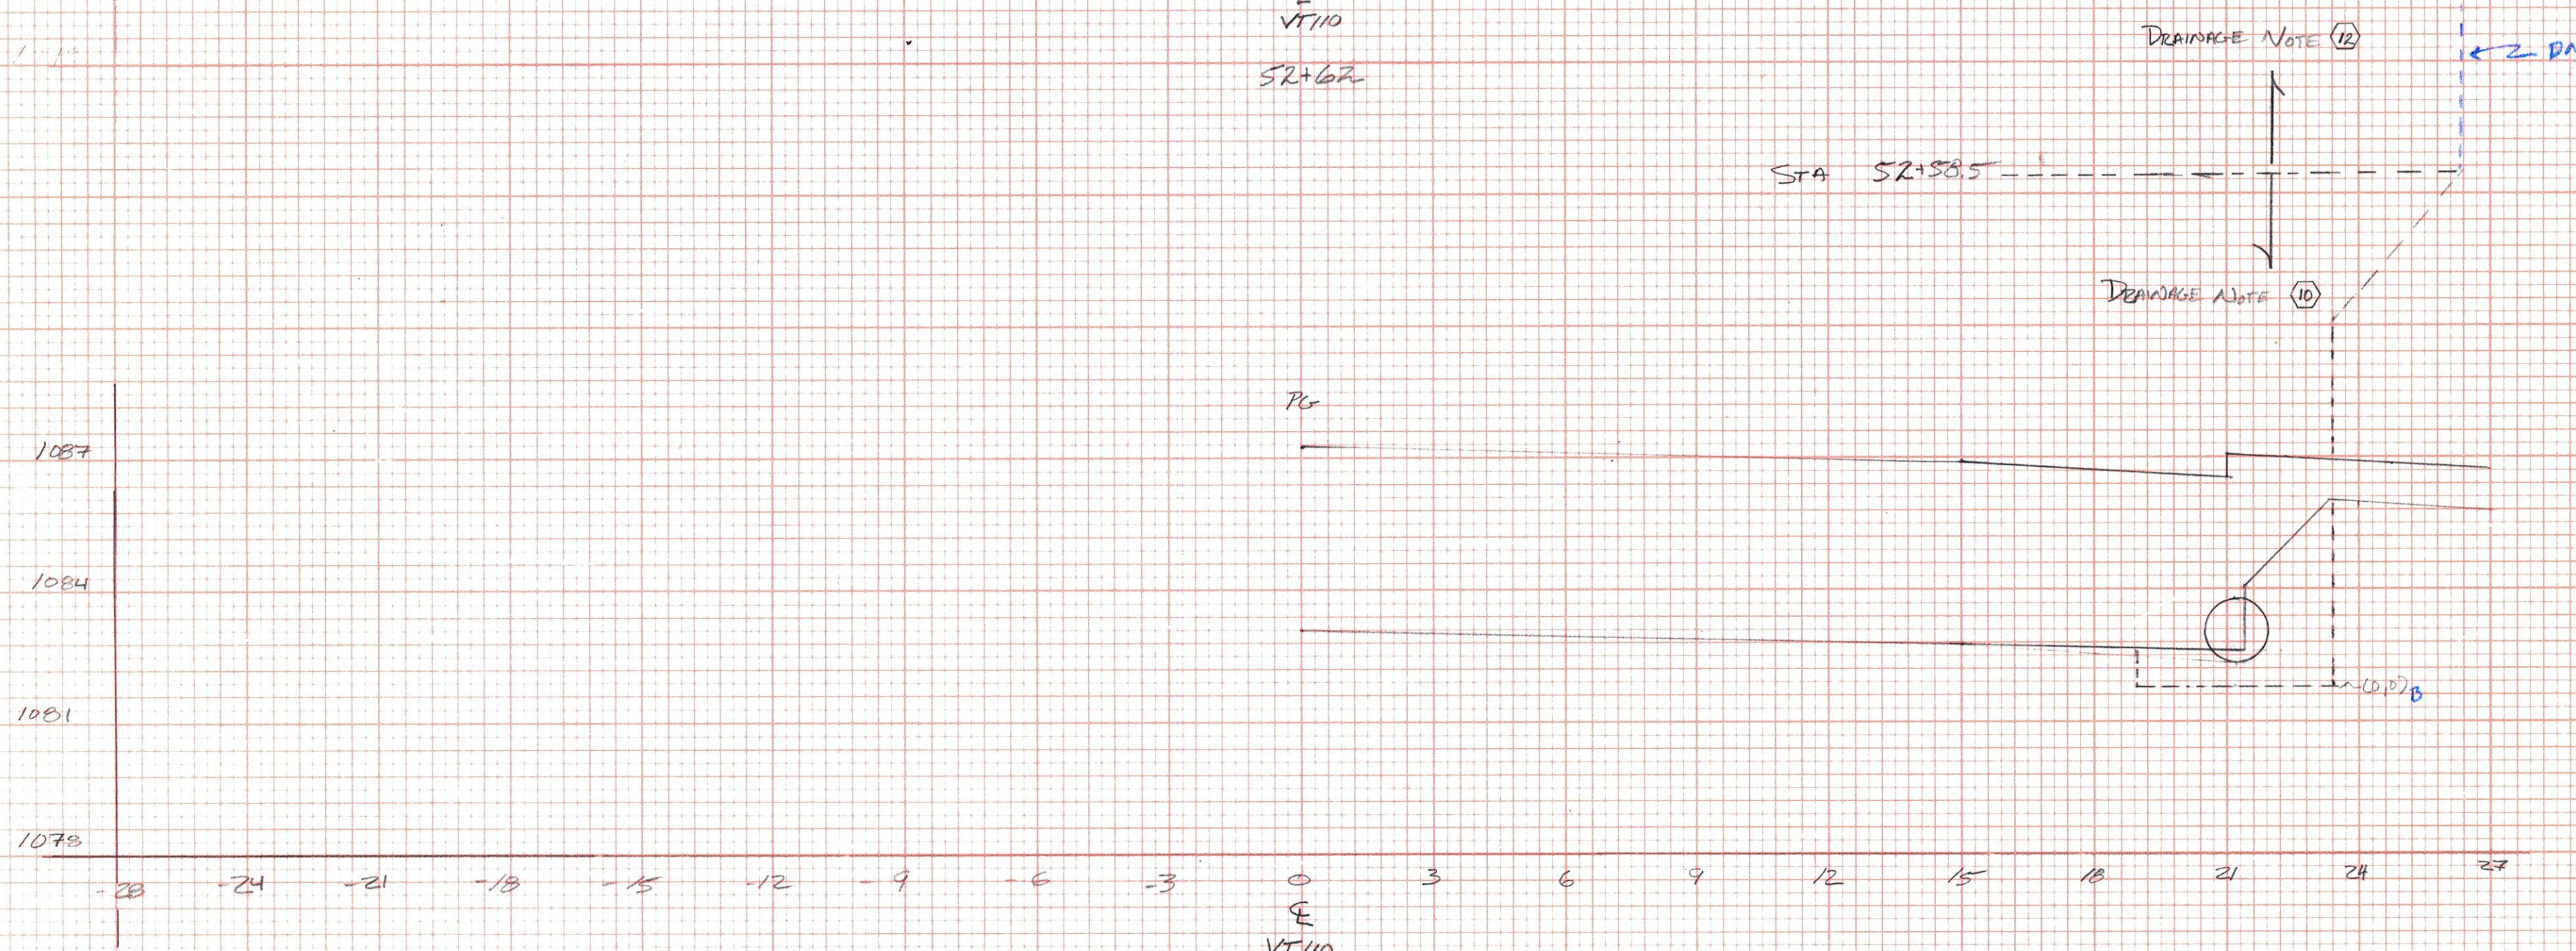


FINAL SURVEY  
 SURVEYED  
 PLOTTED  
 NOTE BOOK TEMPLATE  
 NO. AREA CHECKED

ORIGINAL SURVEY  
 SURVEYED  
 PLOTTED  
 NOTE BOOK TEMPLATE  
 NO. AREA CHECKED

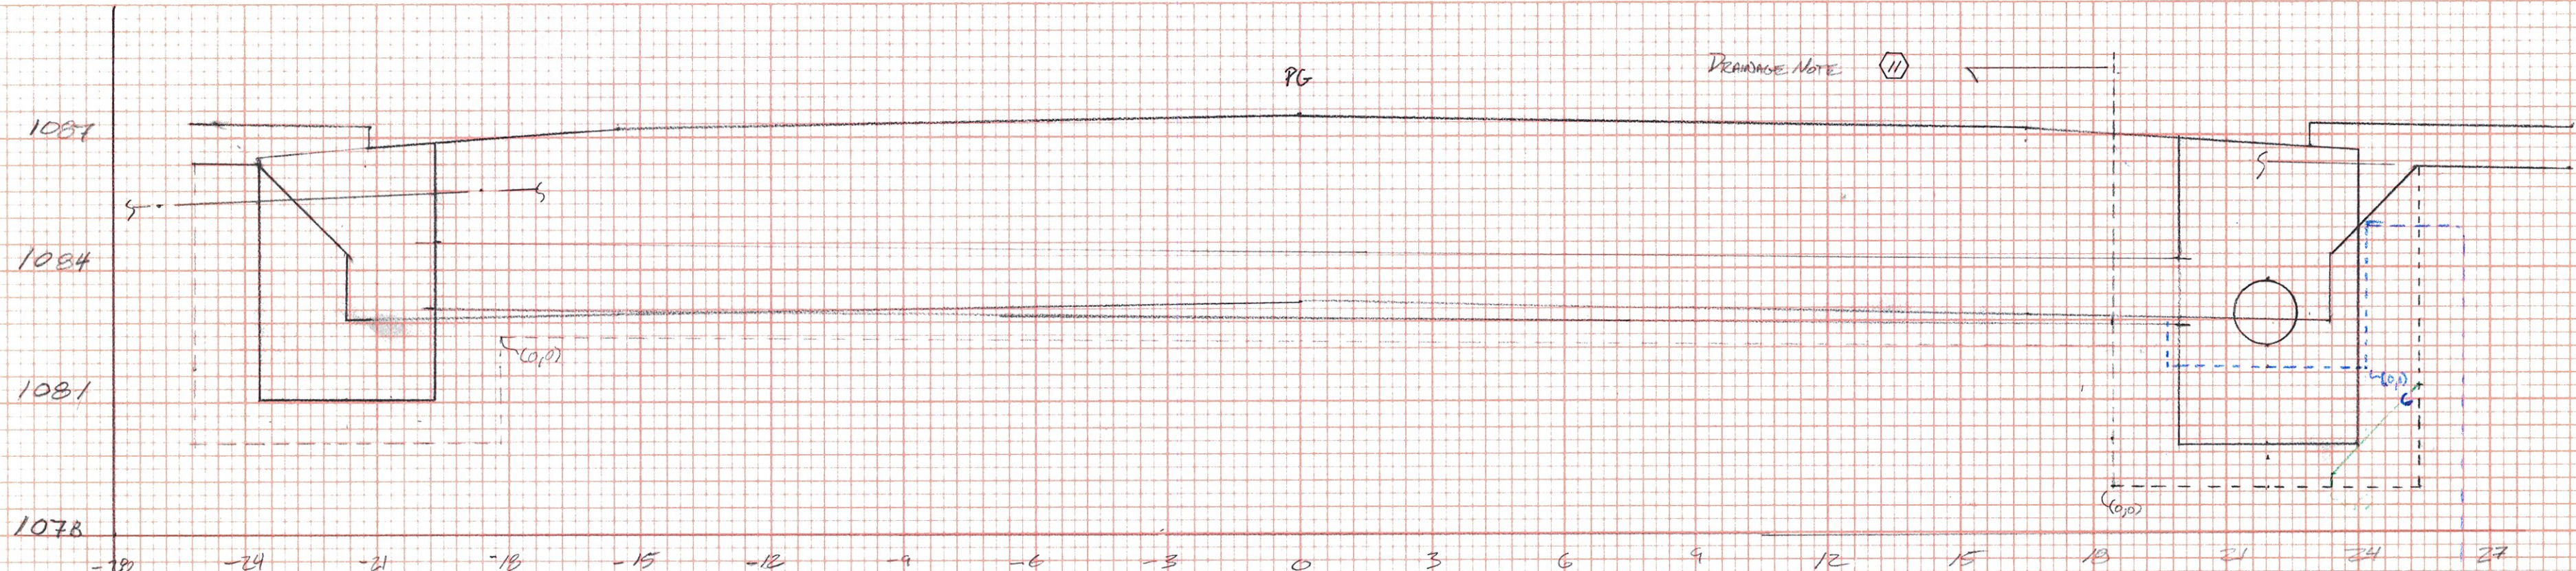

THREE TOWNS H&S 026-1 (CAD)  
 DRAINAGE SECTIONS  
 SCALE: 1"=3'  
 DRAWN: JMK  
 CHECKED: JMK  
 DATE: 12/1/2010  
 SHEET 3 OF 6