
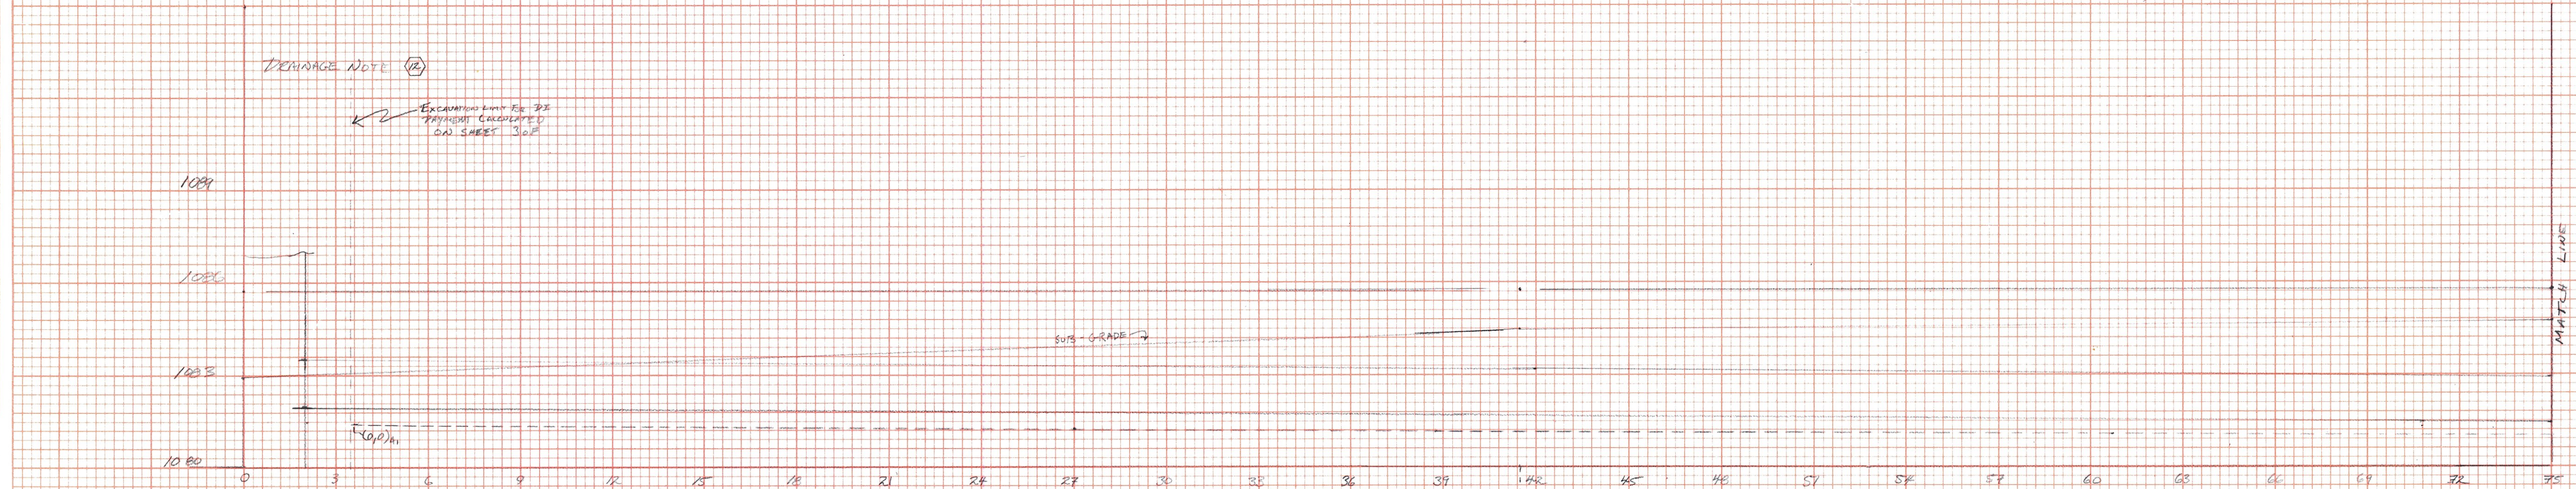
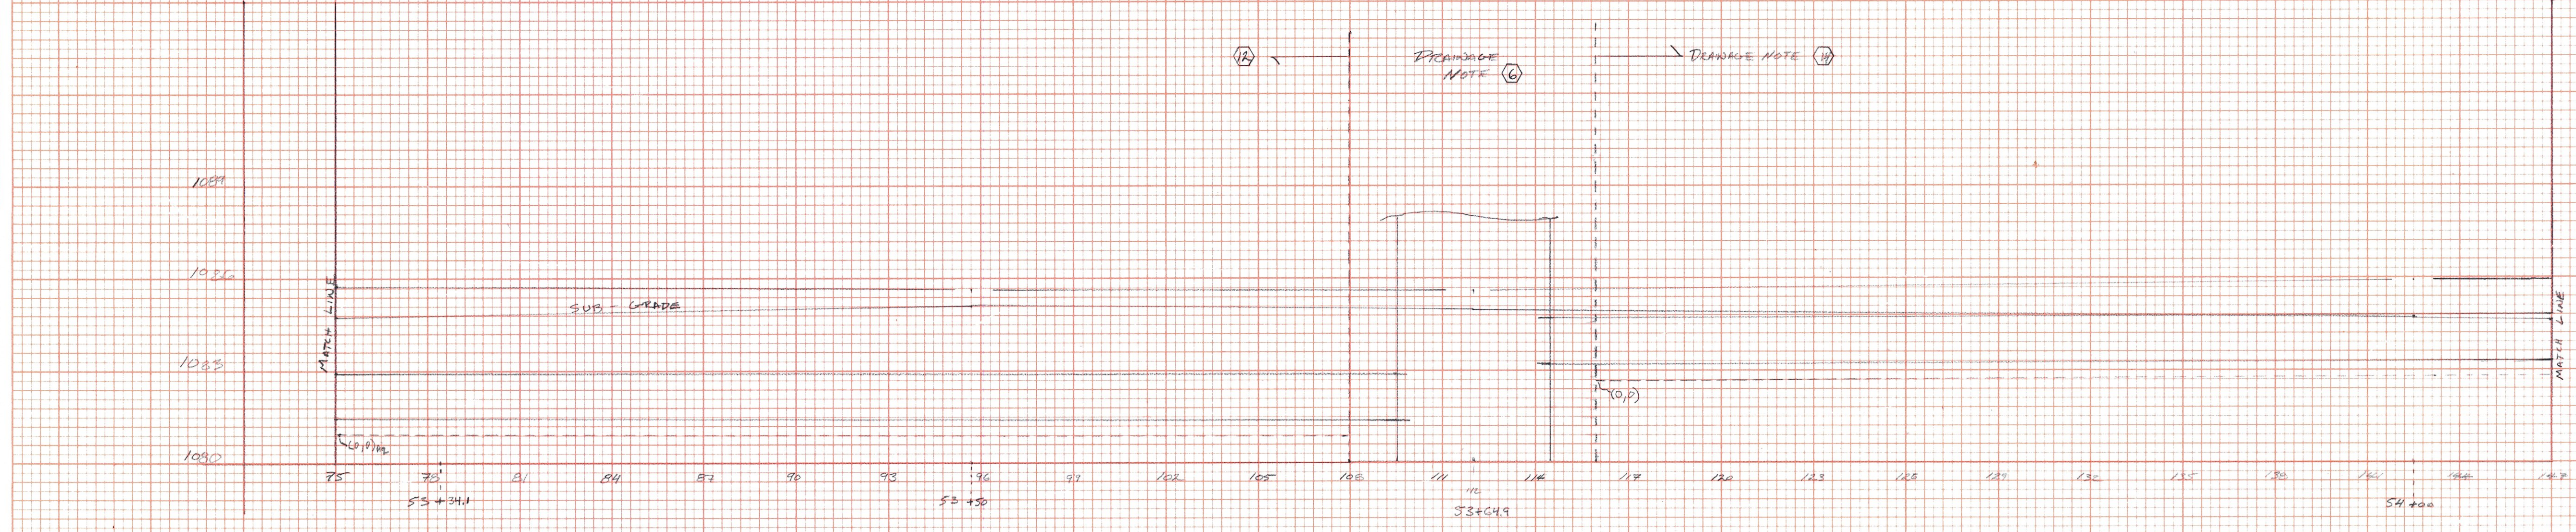


FINAL SURVEY
 SURVEYED
 PLOTTED
 AREAS
 CHECKED

ORIGINAL SURVEY
 SURVEYED
 PLOTTED
 AREAS
 CHECKED

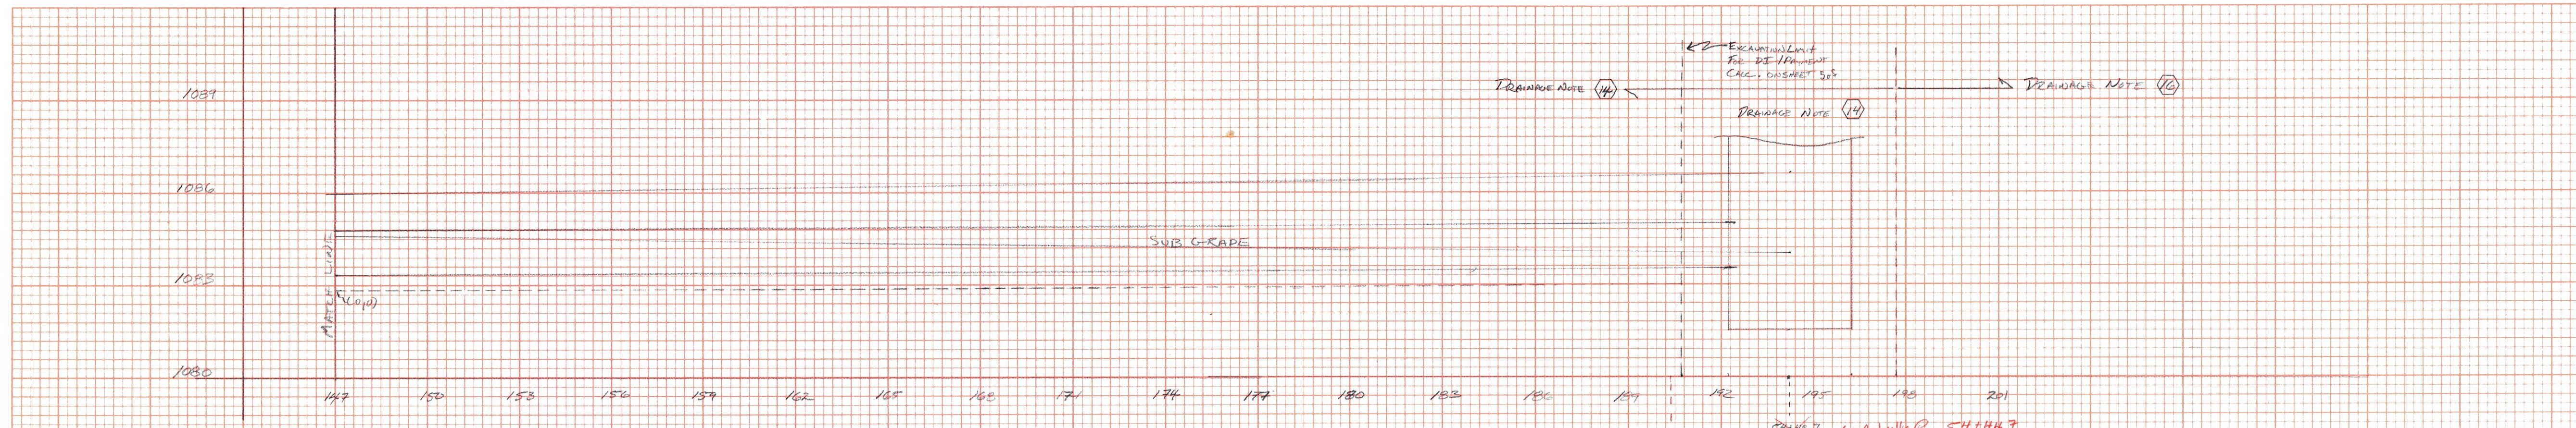

BREEZE TOWN HES ORG-1 (10)
 DRAINAGE SECTIONS
 SCALE 1" = 3'
 DRAWN JMR DATE 12/10/2008
 CRO TBE
 SHEET 4 OF 6