
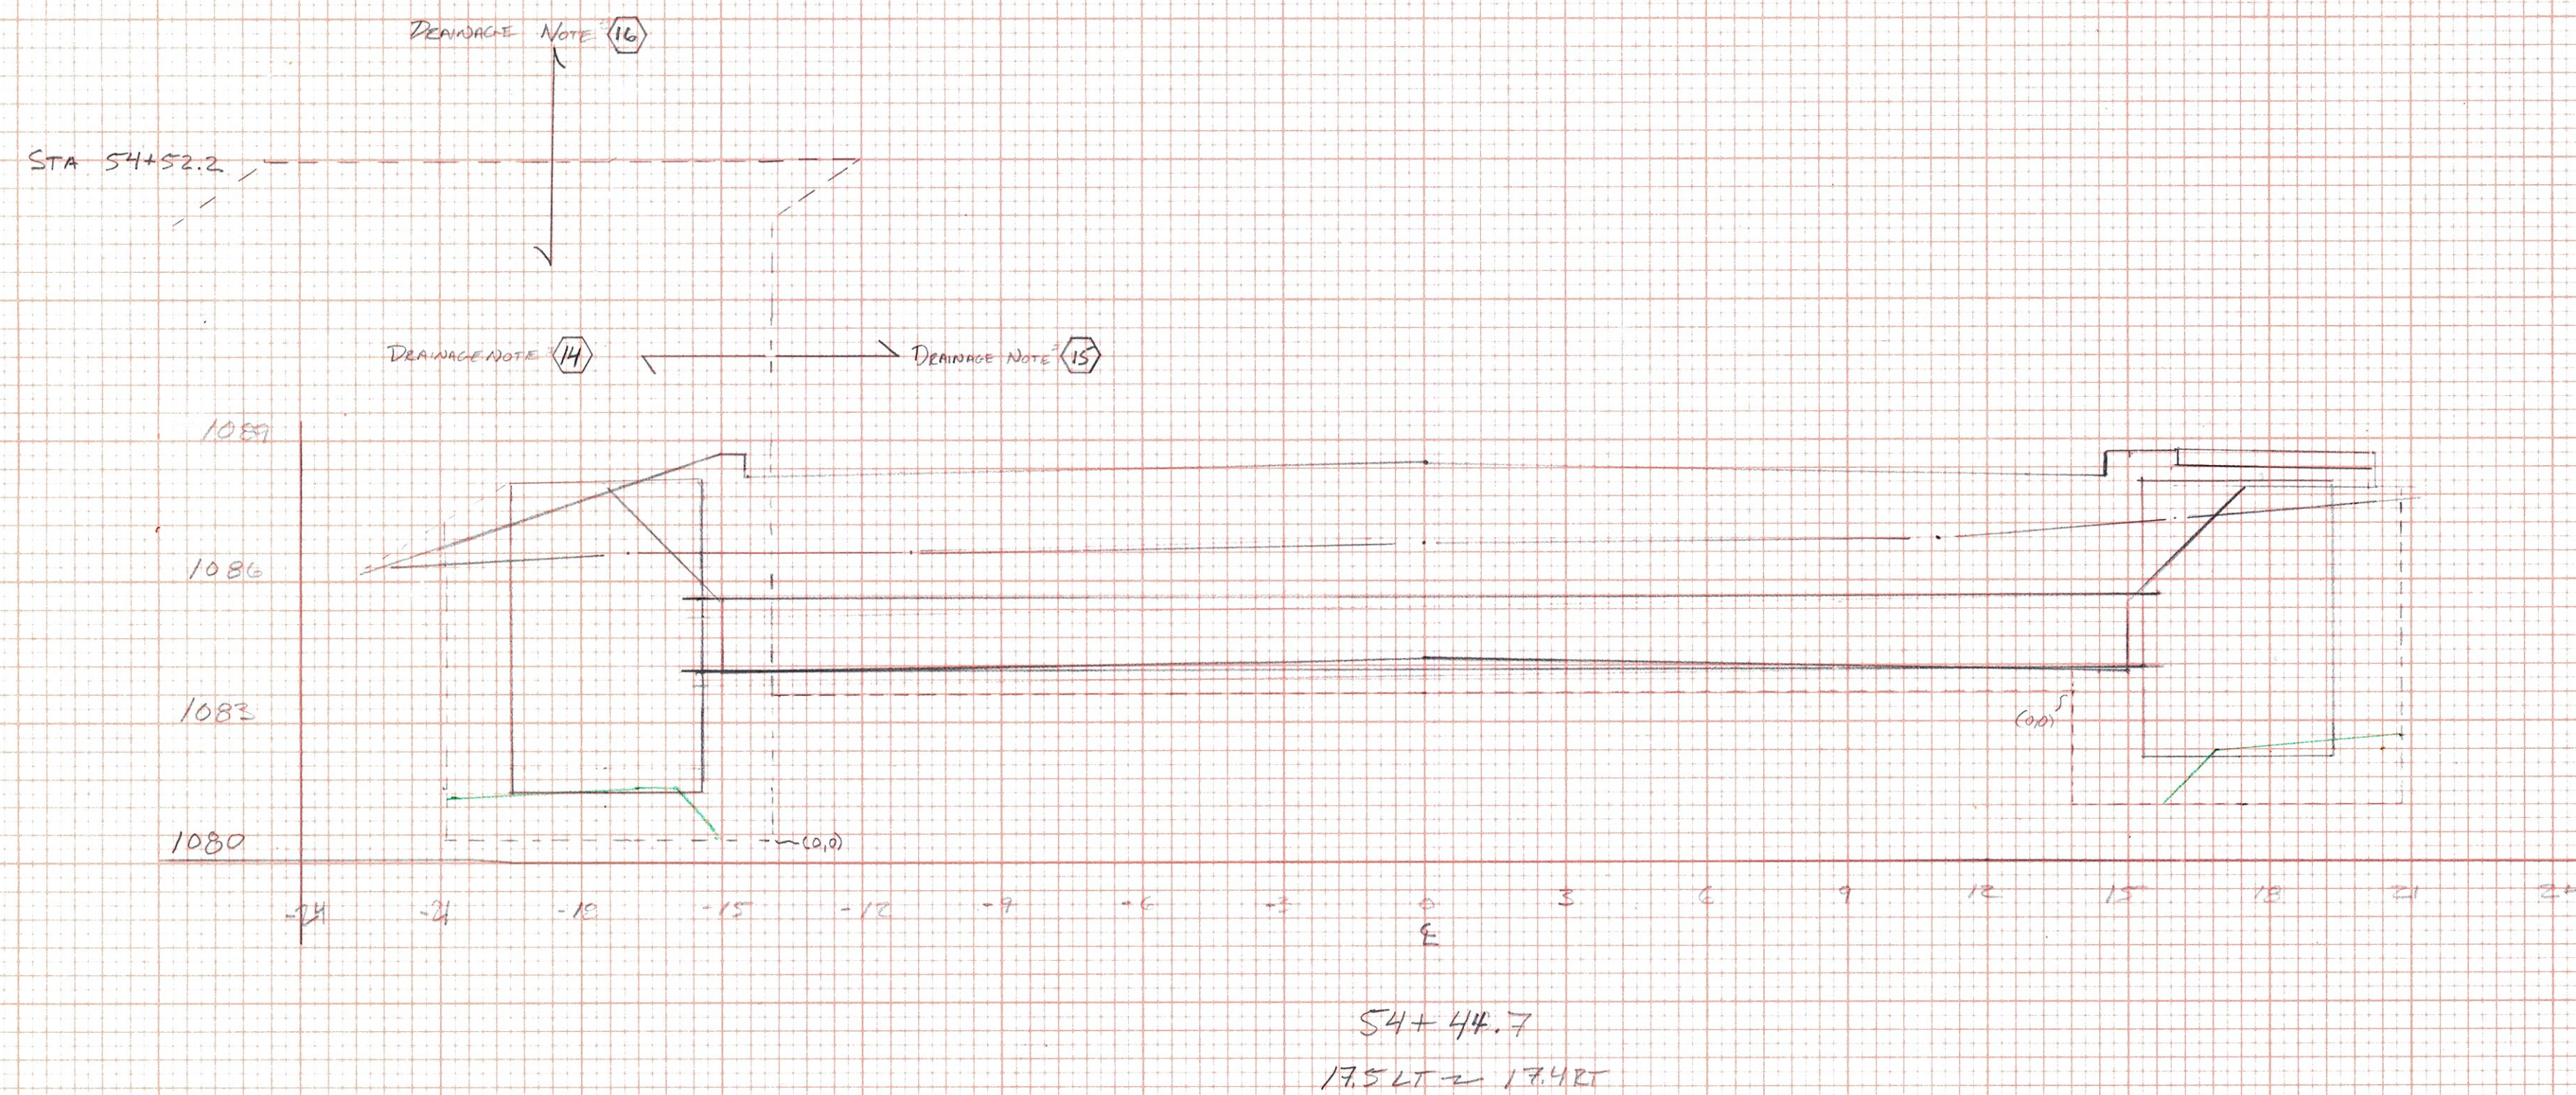
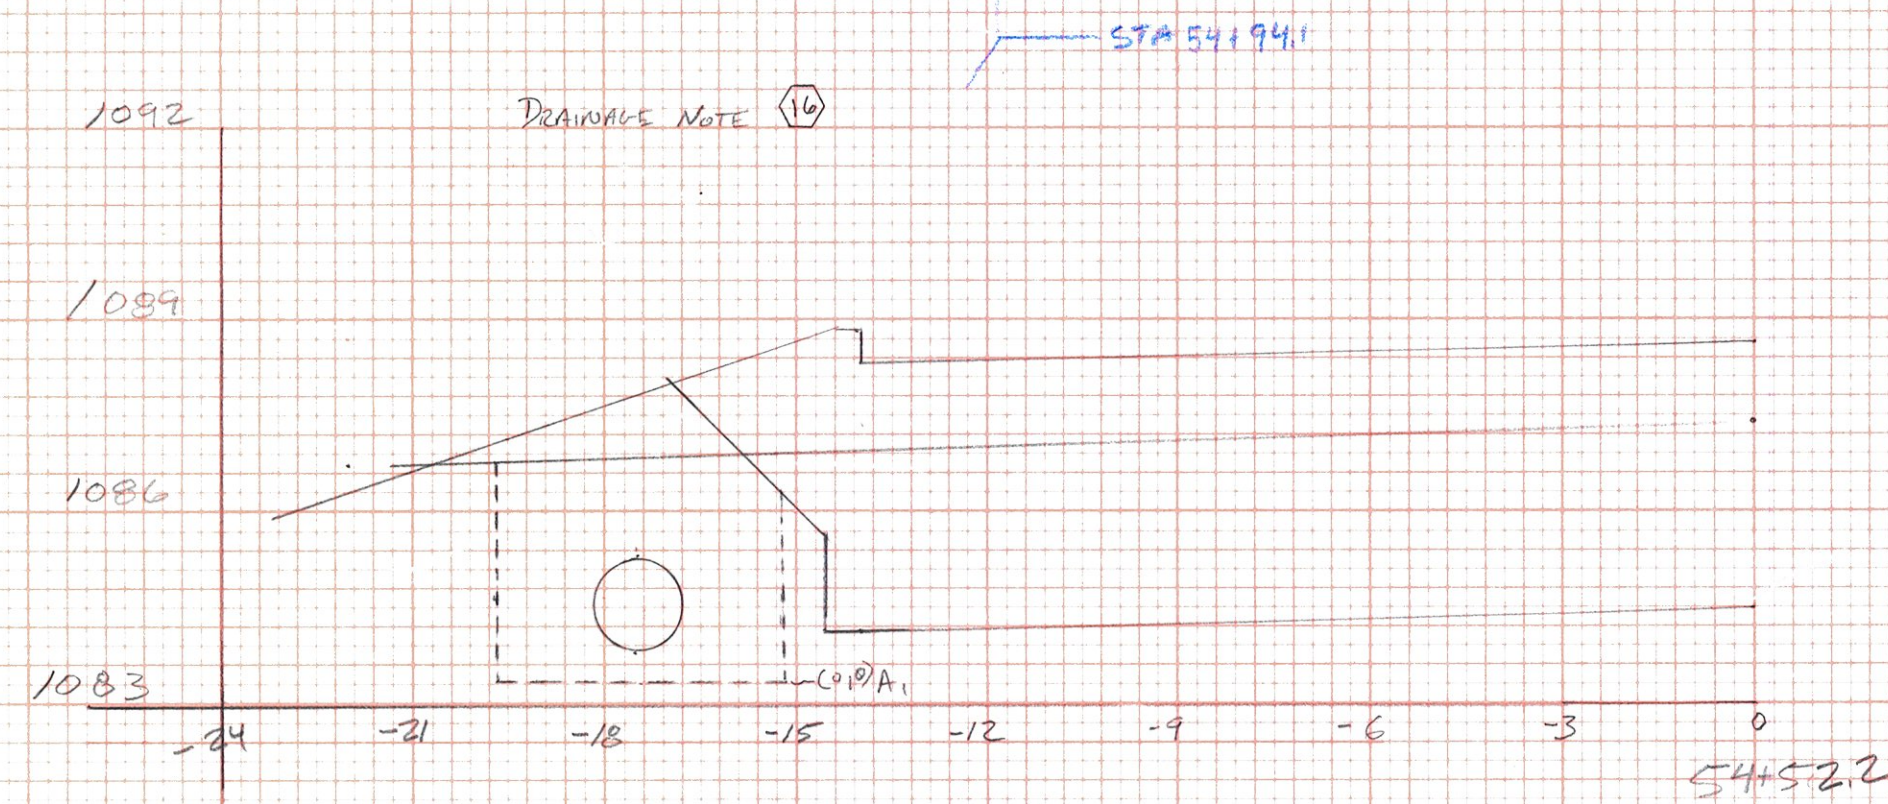


FINAL	SURVEYED	DATE
SURVEY	PLOTTED	BY
NOTE BOOK	DATE	
NO.	AREAS CHECKED	

ORIGINAL	SURVEYED	DATE
SURVEY	PLOTTED	BY
NOTE BOOK	DATE	
NO.	AREAS CHECKED	

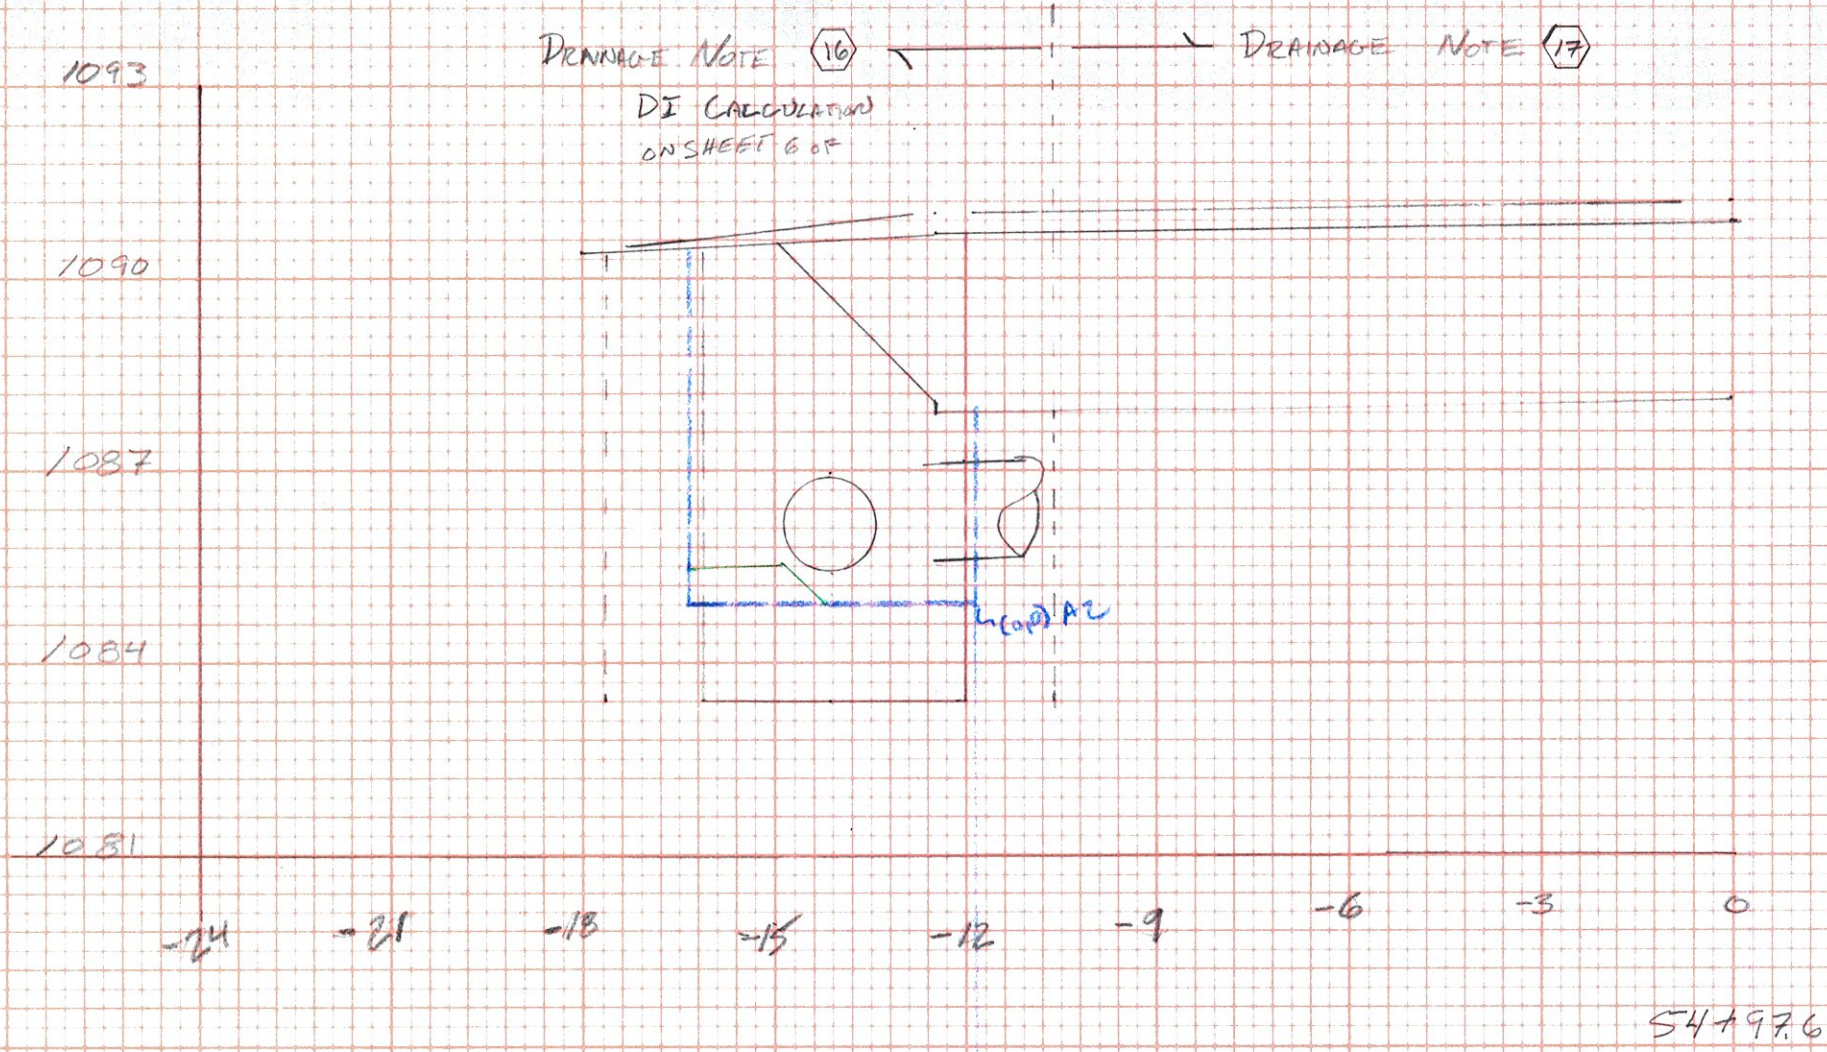

PAGE TWO HES-ORG-1(13)
DRAINAGE SECTIONS

SCALE:
DRAWN: JAR
CHKD:
DATE: 12/10/2010
DATE:
SHEET: 5 OF 6