

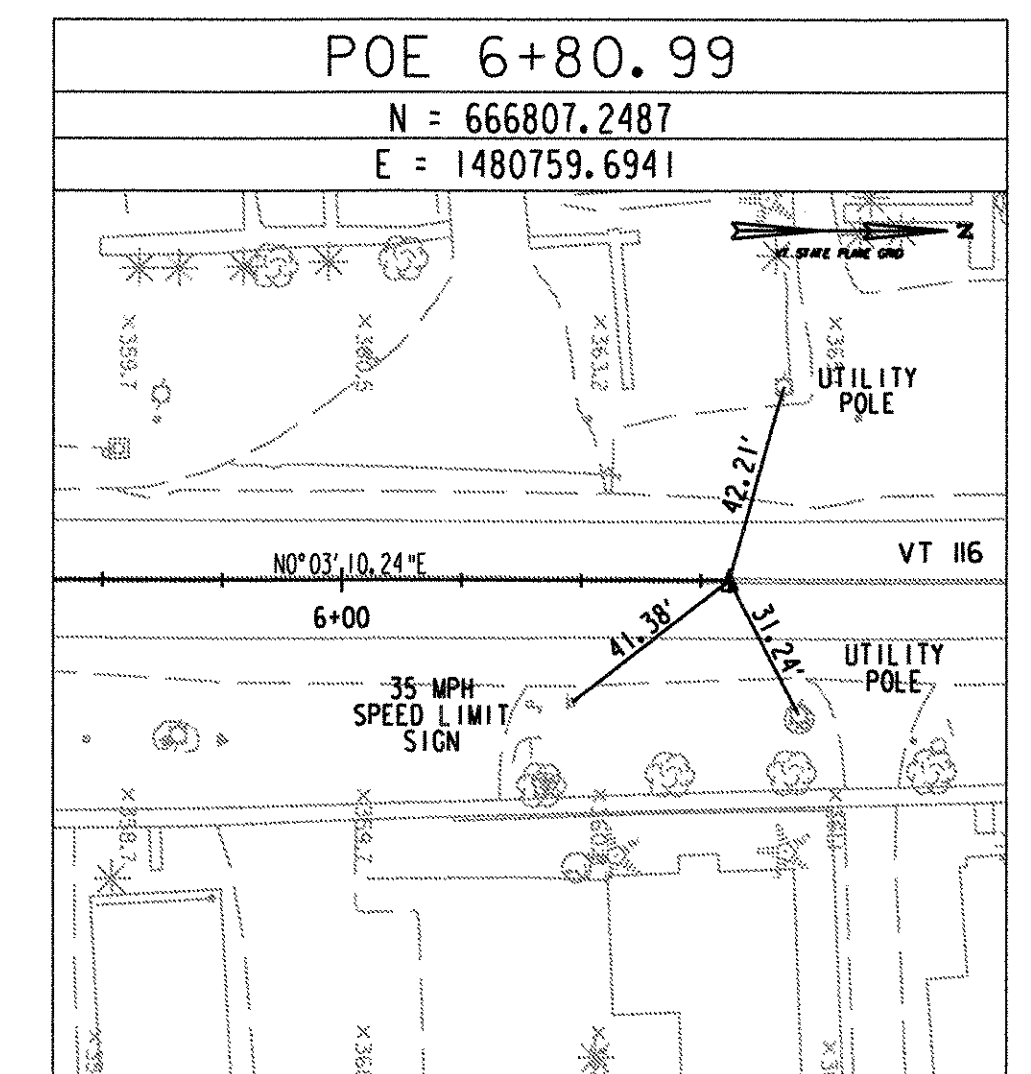
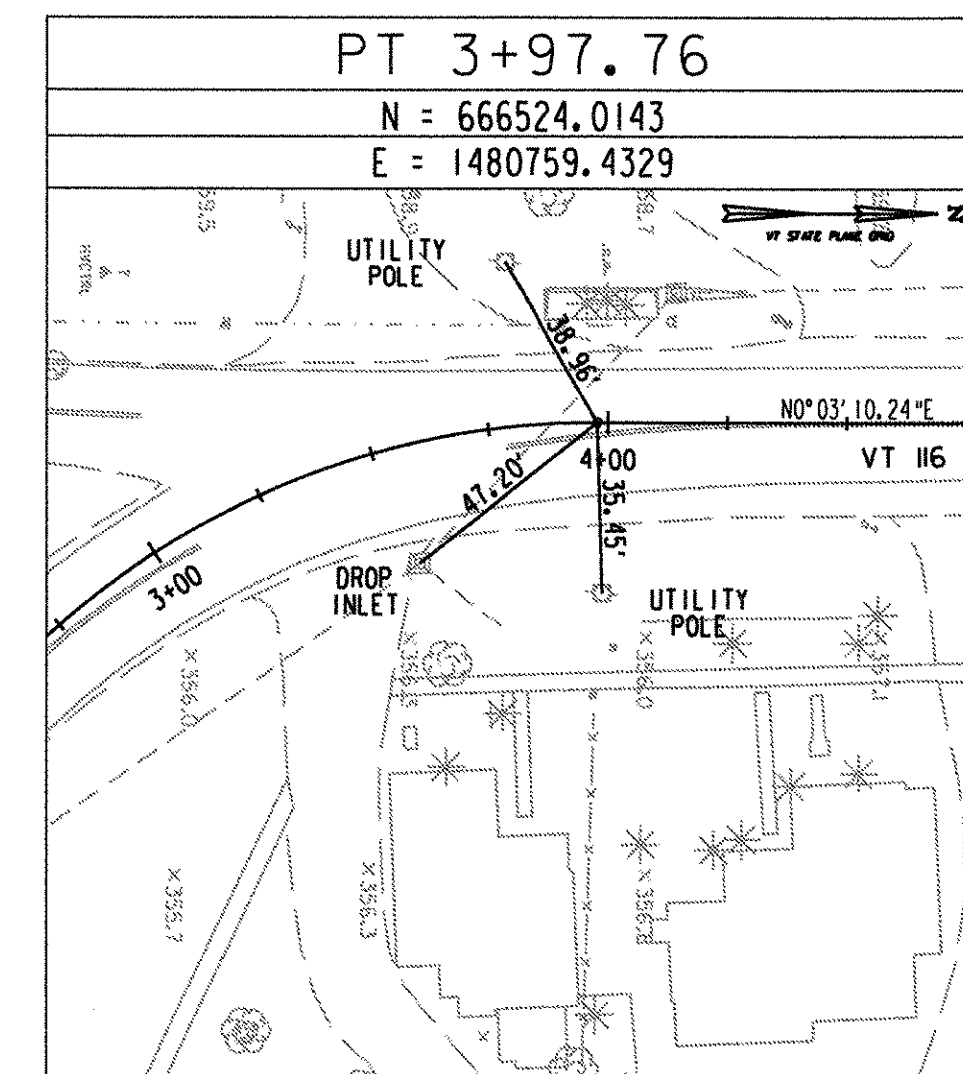
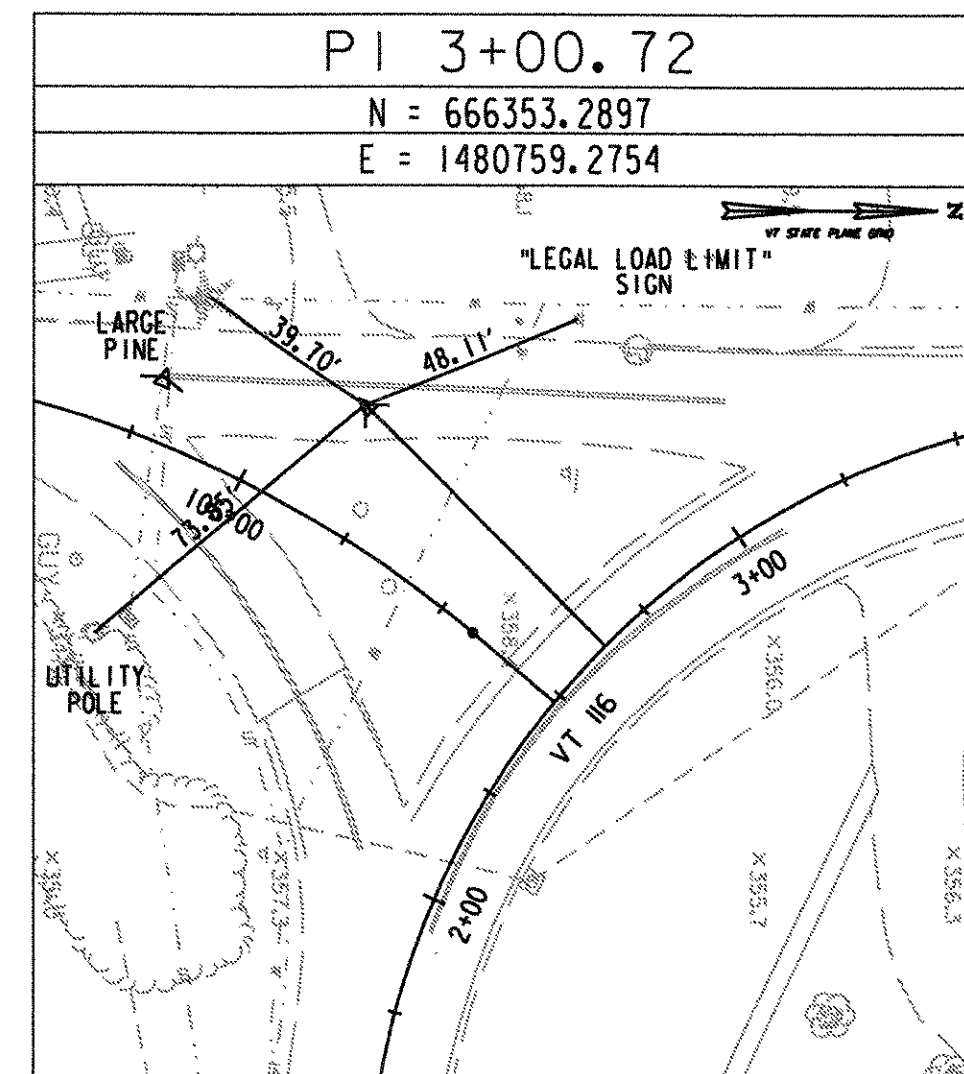
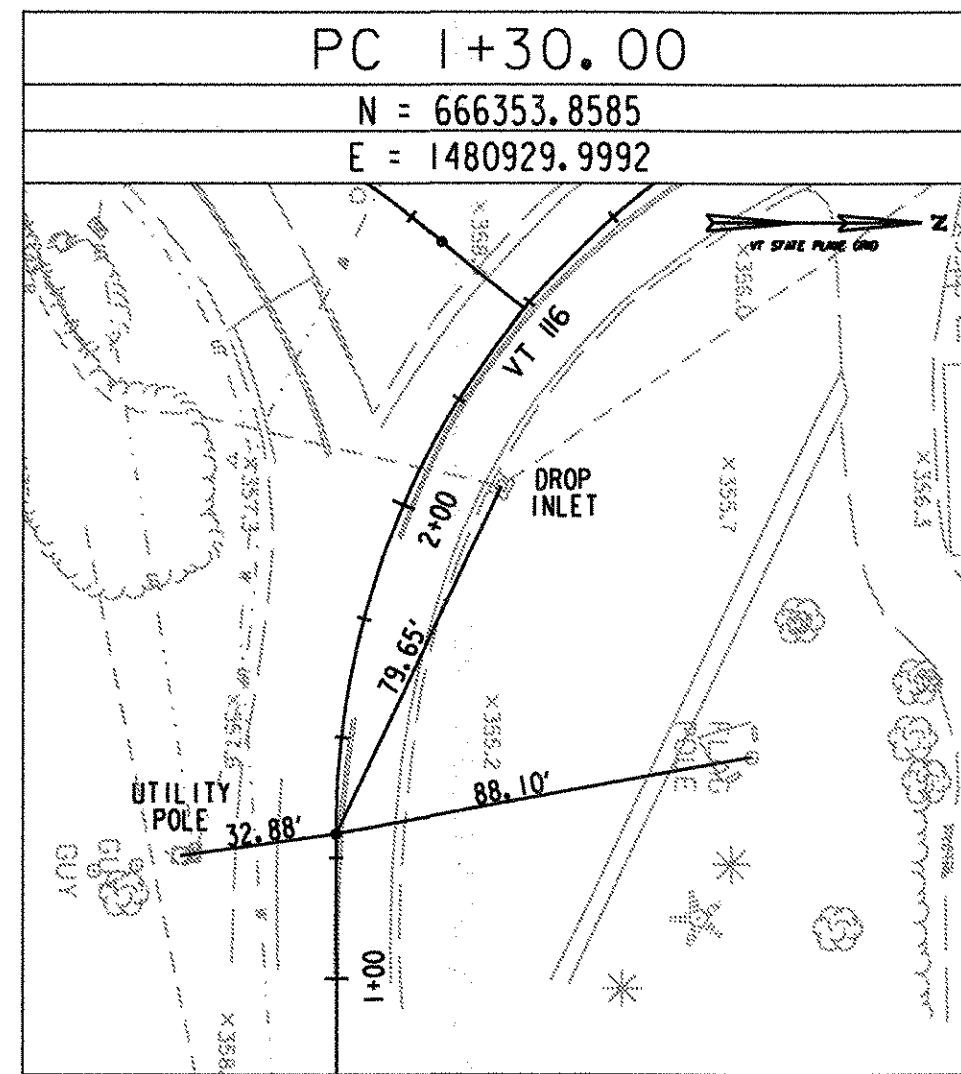
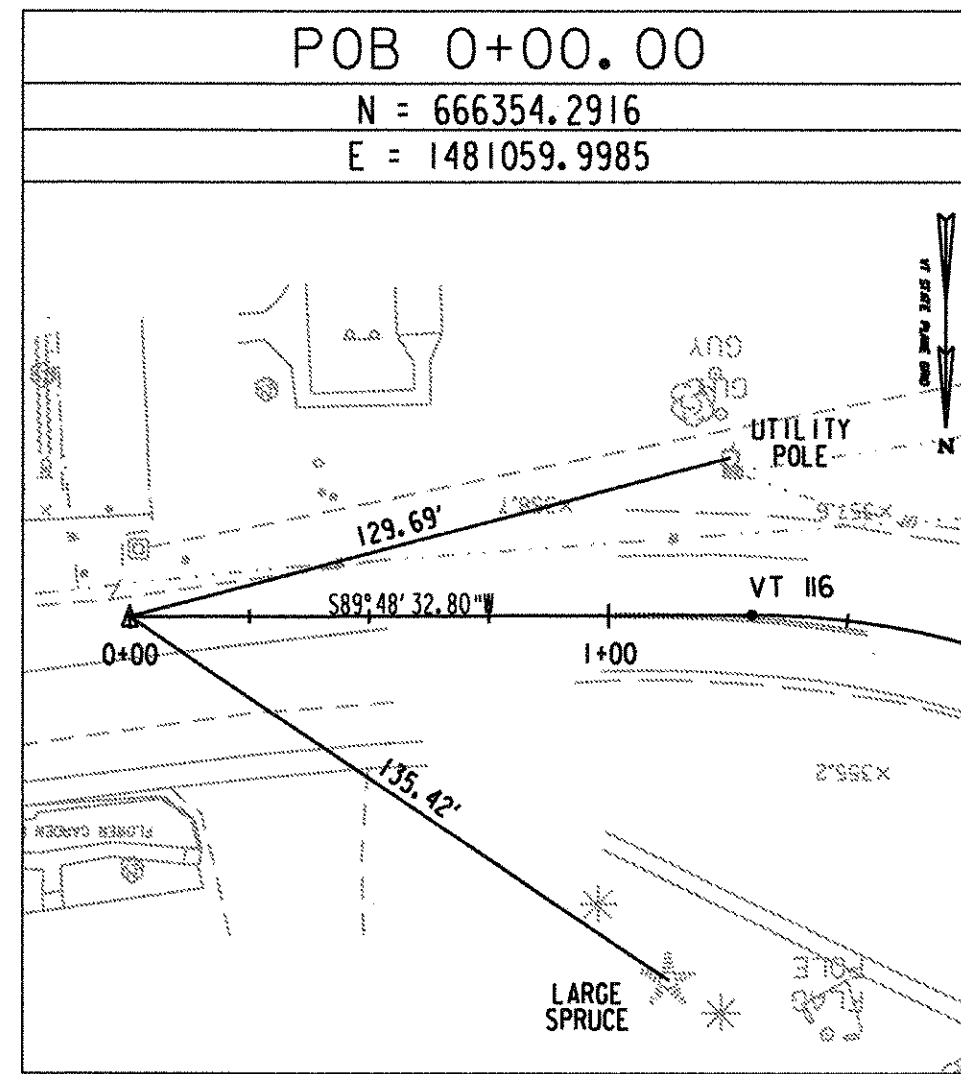
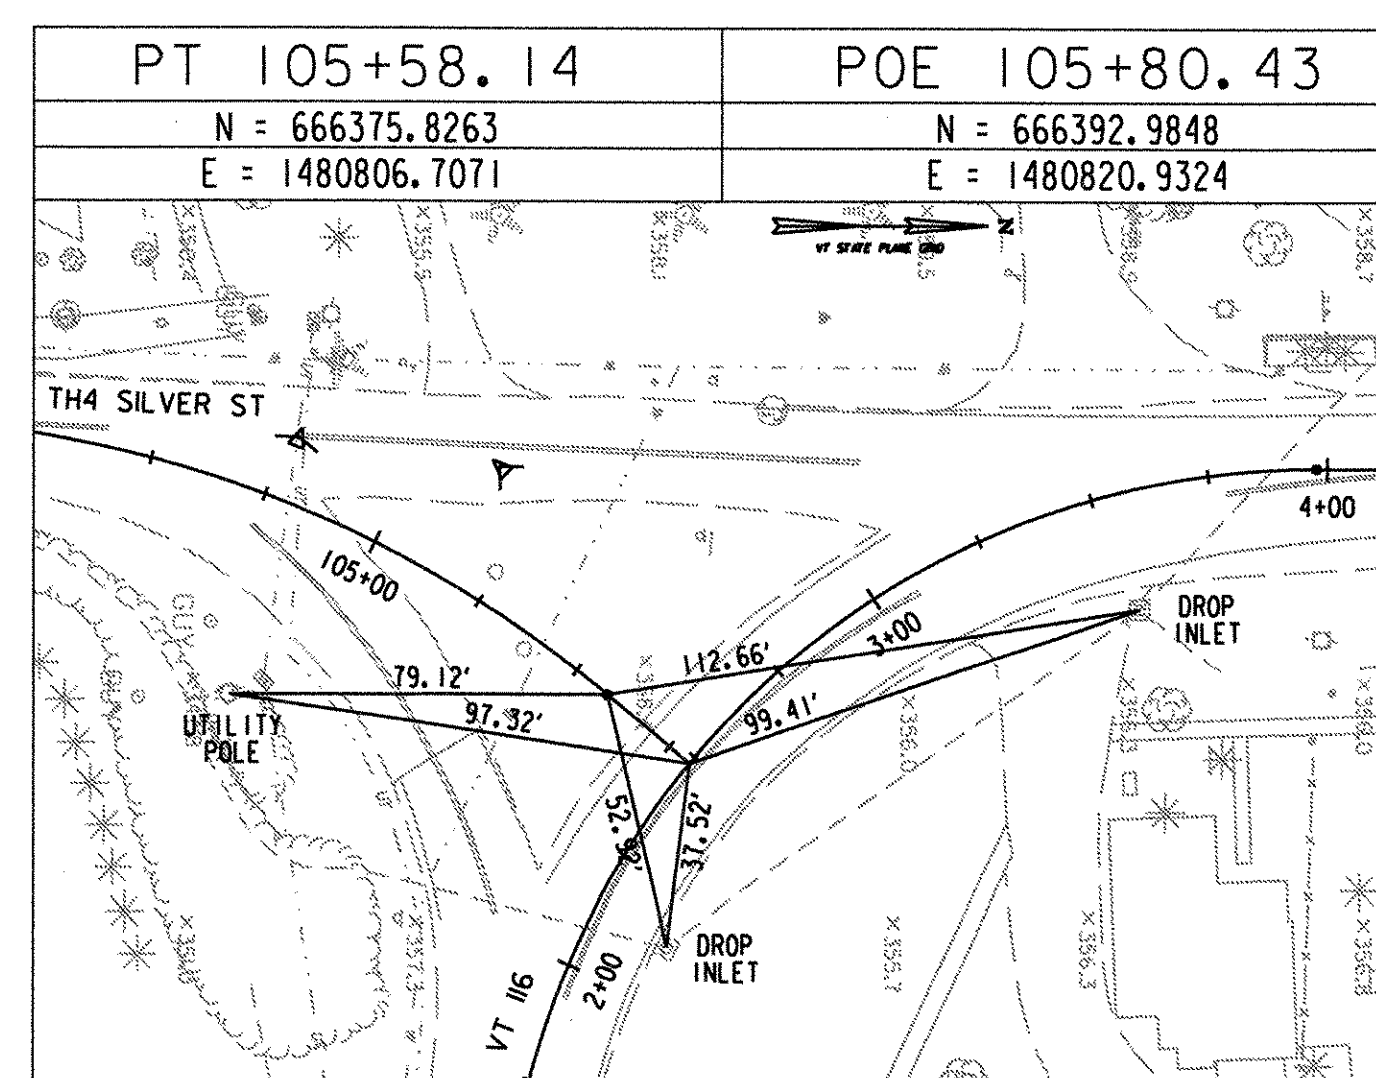
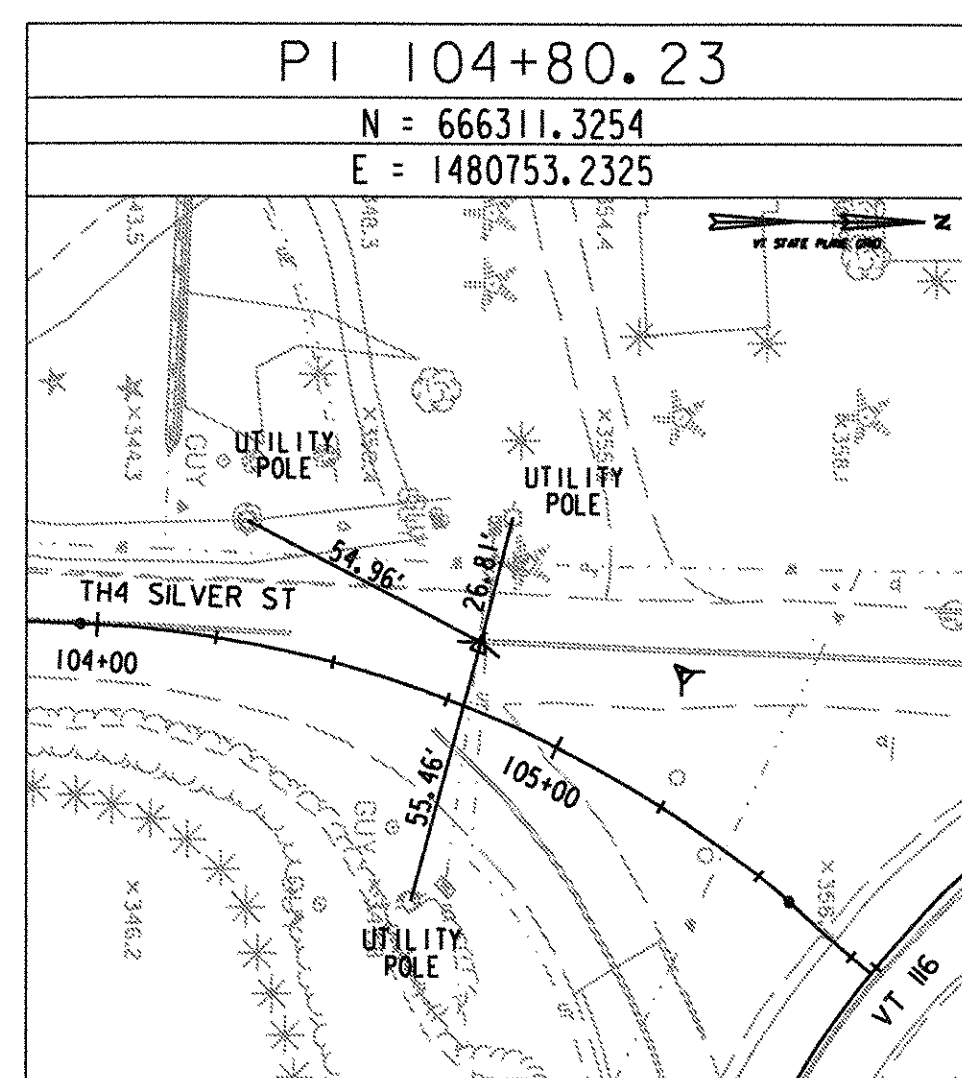
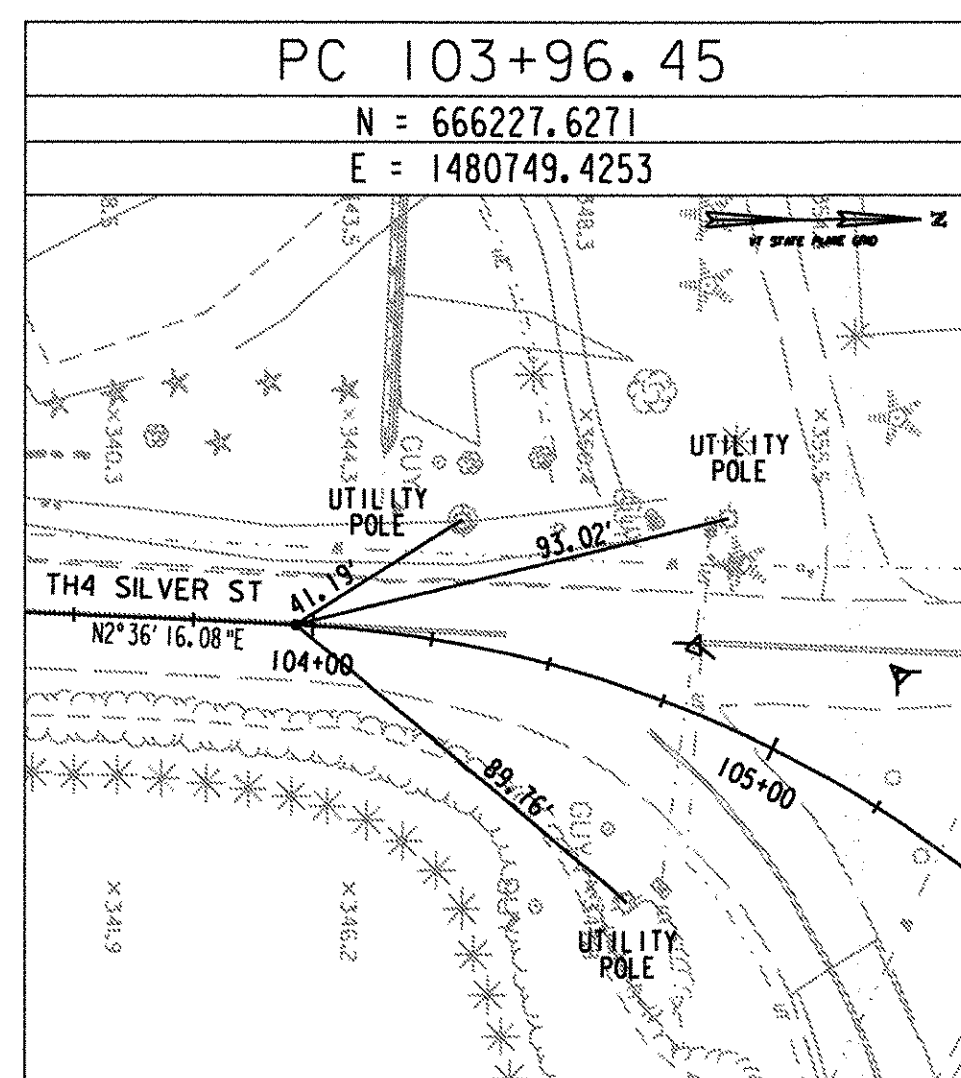
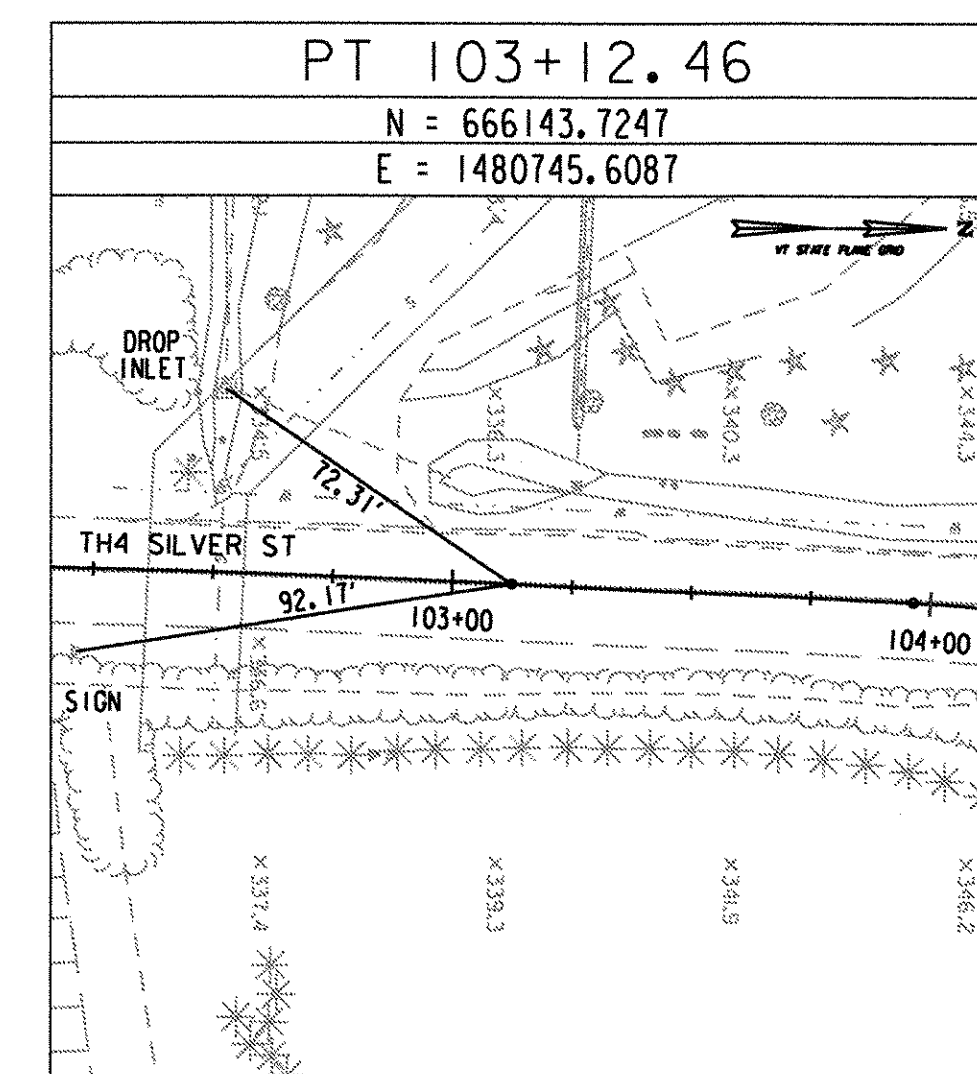
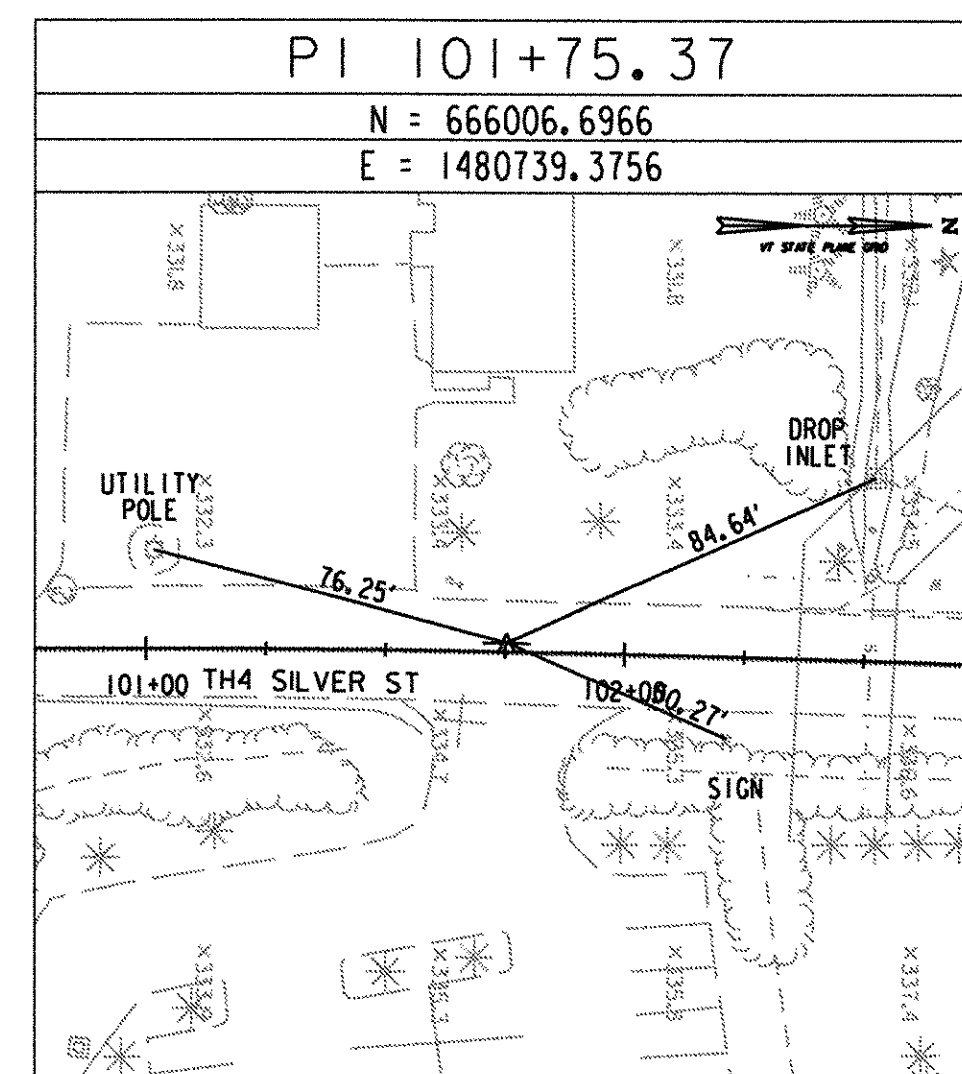


VT ROUTE 116

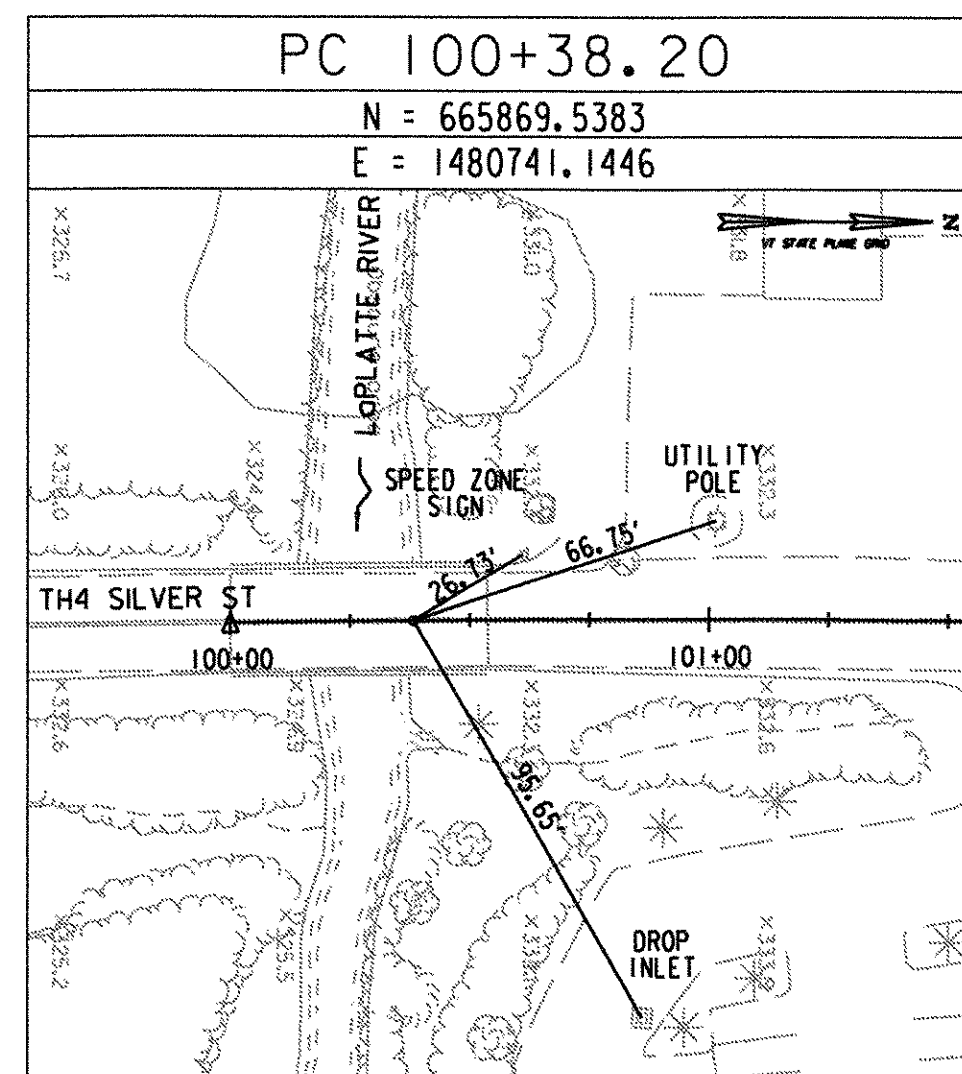

TH4 SILVER STREET

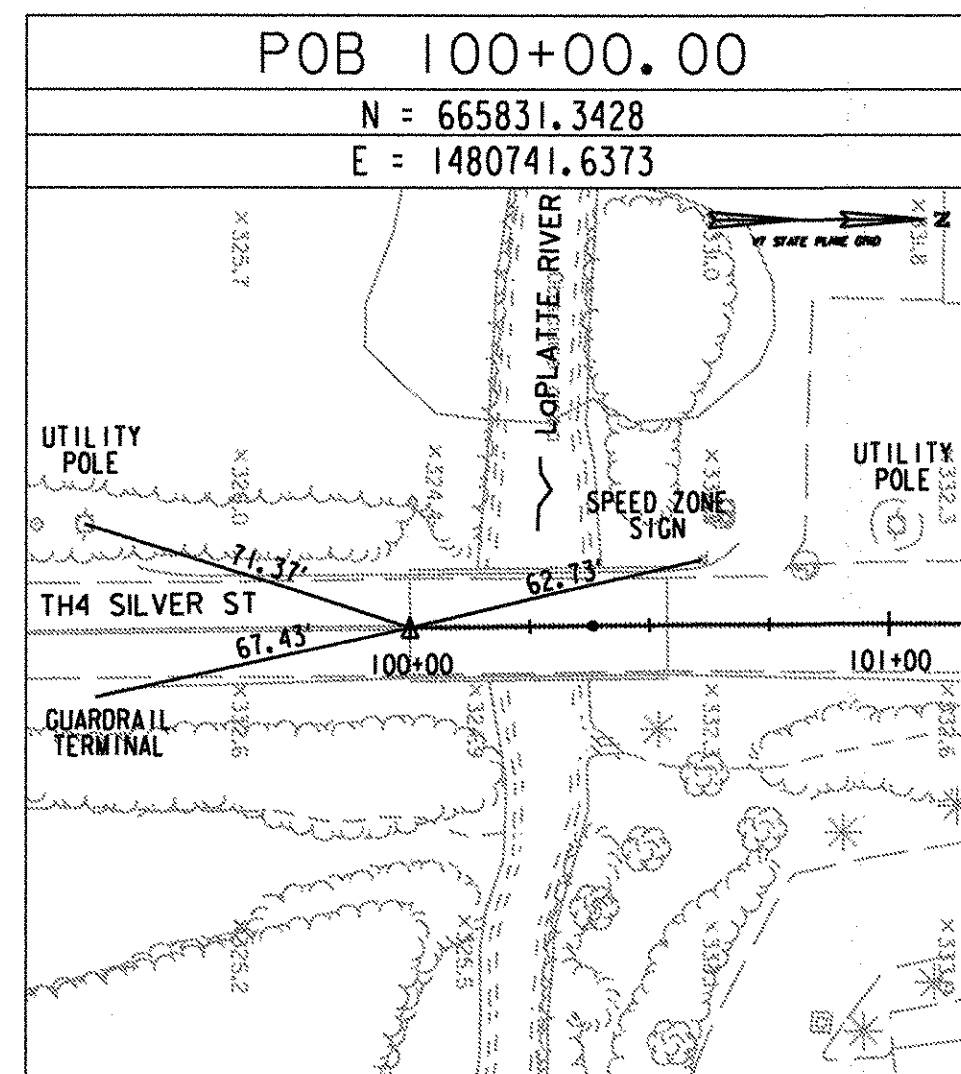


TIE SHEET

AERIAL SURVEY BY: COL-EAST, INC.
SURVEYED DATE: 2004

DATUM

VERTICAL NAVD 88
HORIZONTAL NAD 83

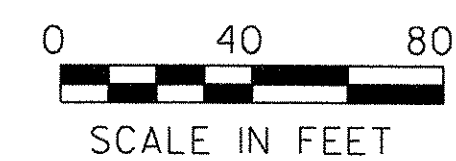

VHB Vanasse Hangen Brustlin, Inc.

PROJECT NAME: HINESBURG
PROJECT NUMBER: HES 021-K(20)

FILE NAME: z04b206+1e.dgn
PROJECT LEADER: G. BAKOS
DESIGNED BY: D. PECK
TIE SHEET

PLOT DATE: 2/18/2009
DRAWN BY: D. PECK
CHECKED BY: G. BAKOS
SHEET II OF 25