



PROFILE VT ROUTE 116

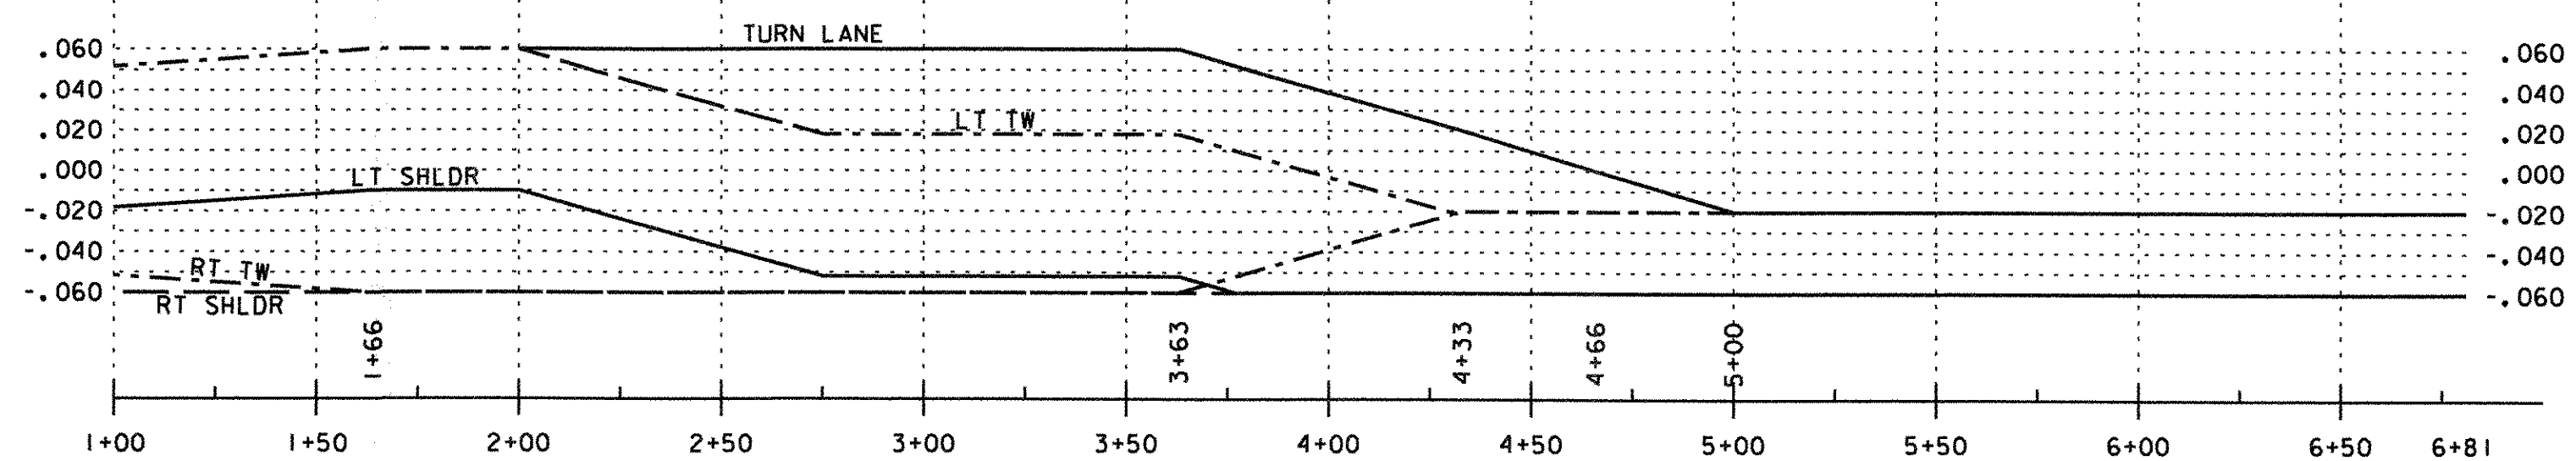


VT ROUTE 116 BANKING PROFILE

NOTE:  
GRADES ARE SHOWN ALONG PROPOSED CENTERLINE.  
GRADES SHOWN TO 0.1 FT ARE EXISTING GROUND.  
GRADES SHOWN TO 0.10 FT ARE FINISH GRADE.

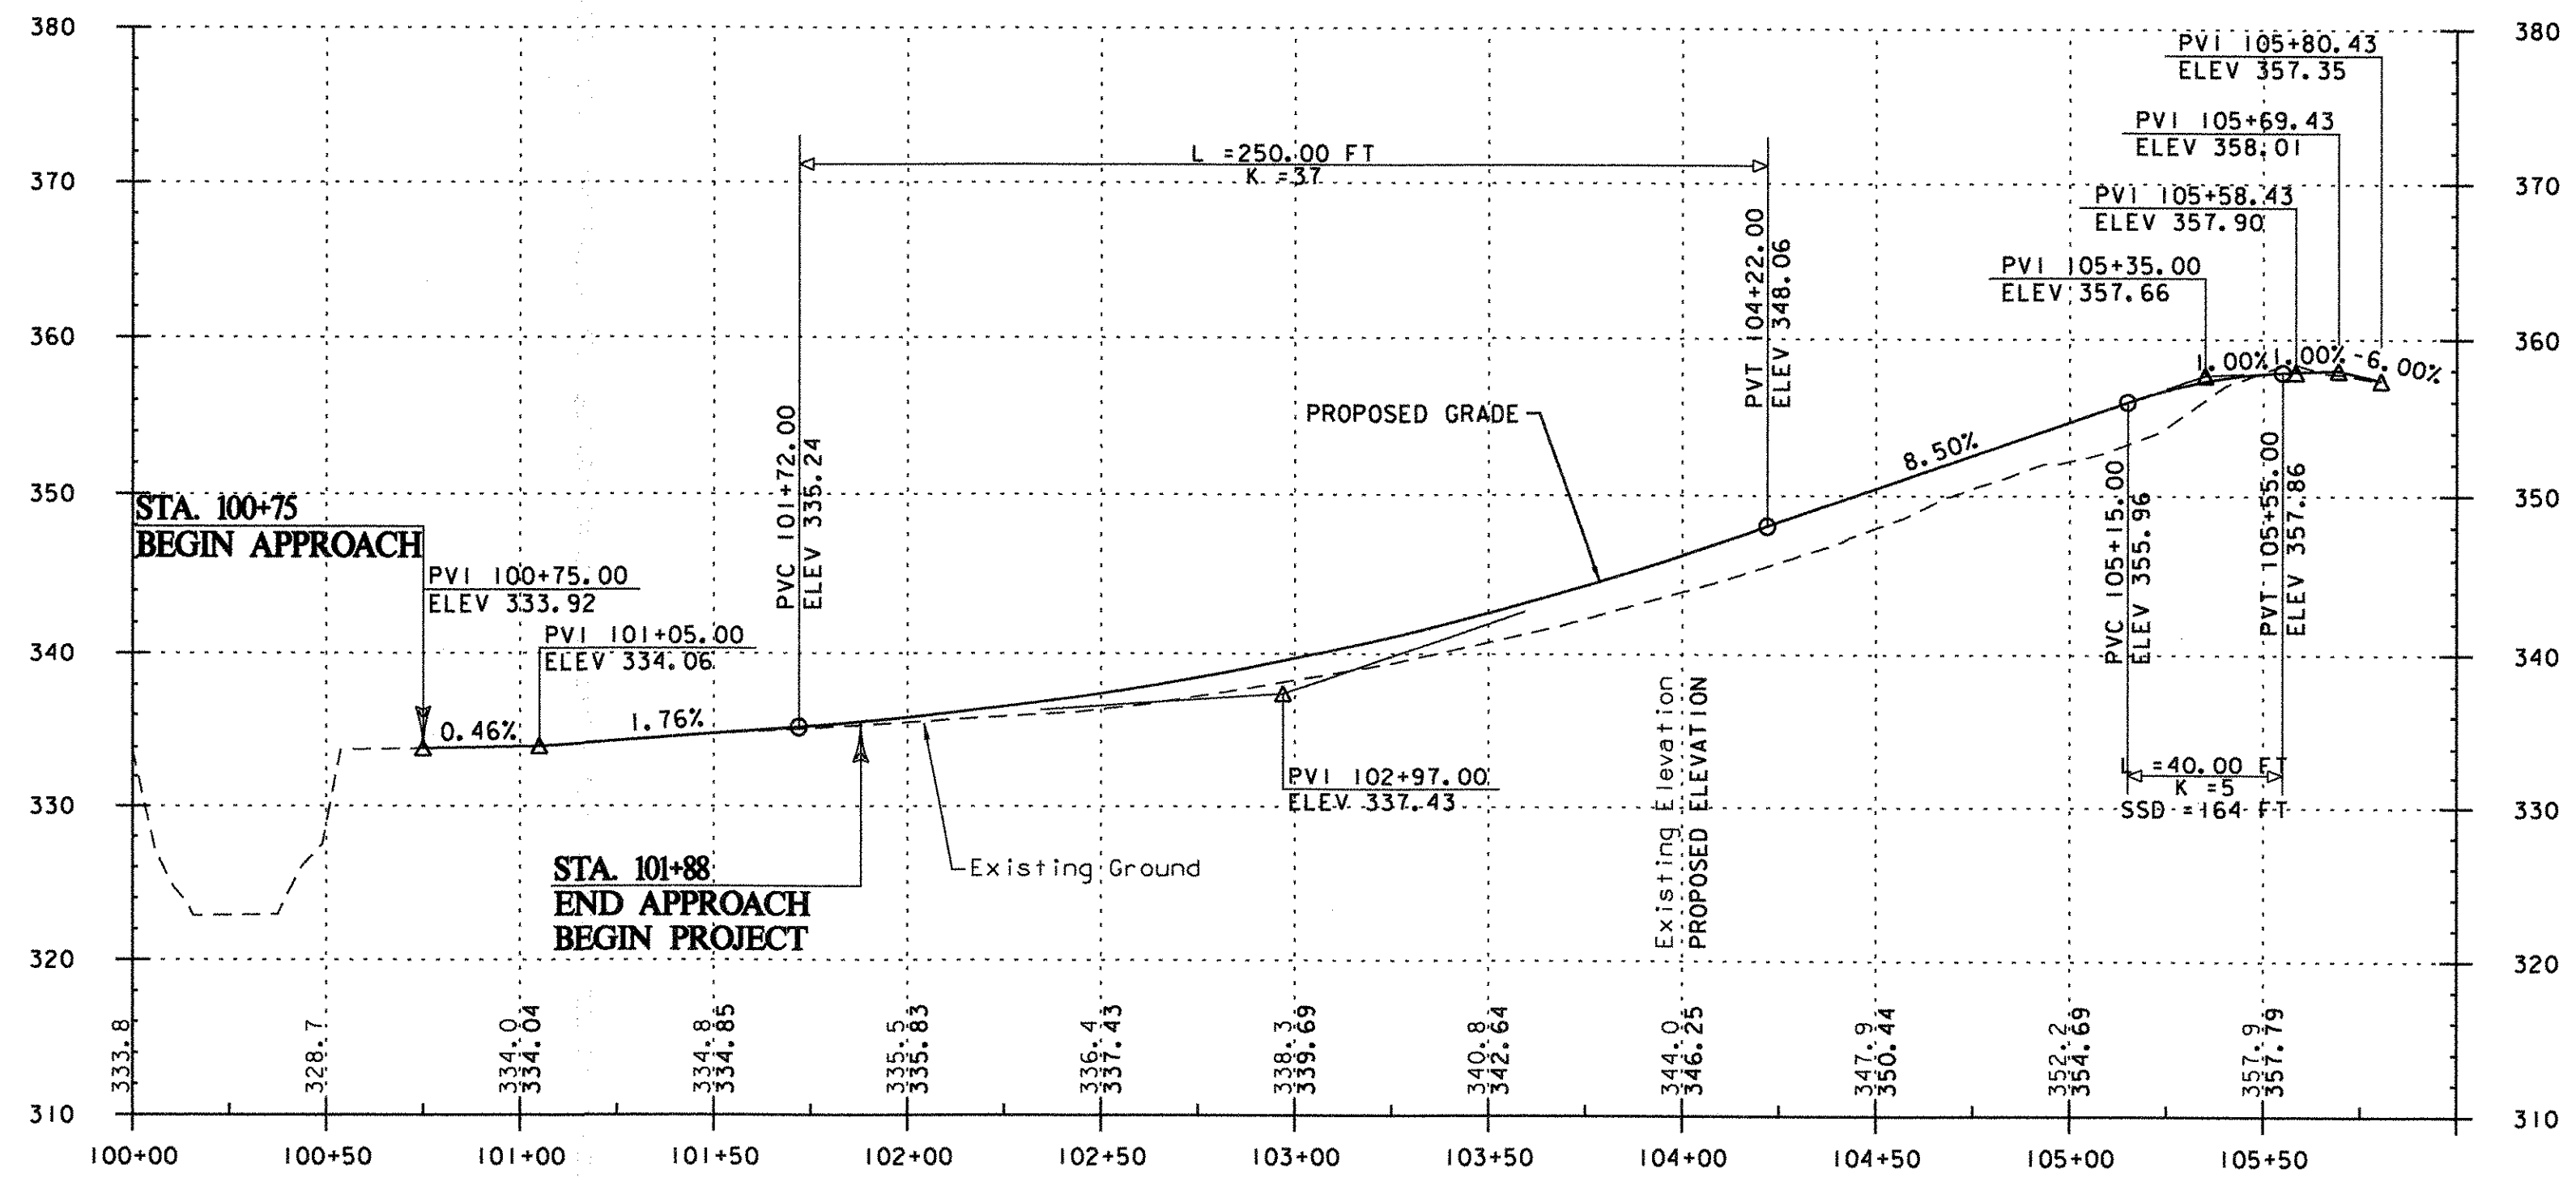

PROFILE SILVER ST

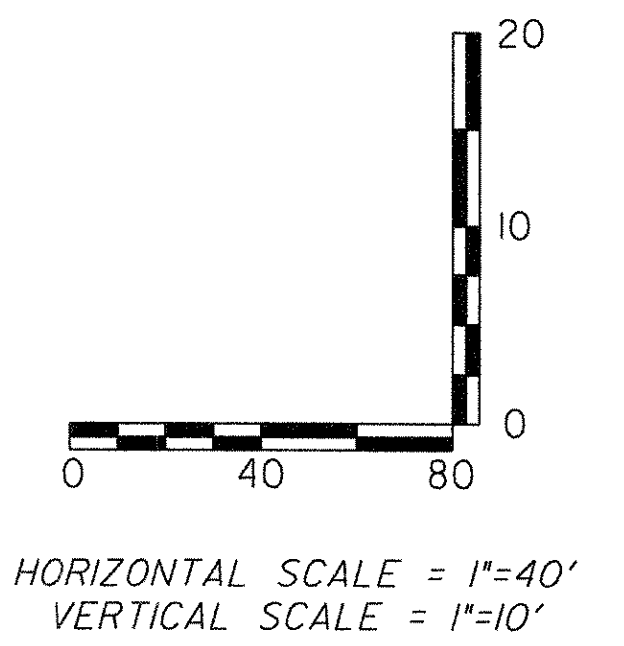

PROJECT NAME: HINESBURG  
PROJECT NUMBER: HES 021-1(20)

FILE NAME: z04b206pro.dgn  
PROJECT LEADER: G. BAKOS  
DESIGNED BY: D. PECK  
PROFILES

PLOT DATE: 2/18/2009  
DRAWN BY: D. PECK  
CHECKED BY: G. BAKOS  
SHEET 18 OF 25

