

**DURABLE 4 INCH WHITE LINE, THERMOPLASTIC**

SL STA. 102+03 - STA. 105+46, RT.  
 SL STA. 101+75, LT. - STA. 6+81, LT.  
 SL STA. 103+68 - SL STA. 105+46, RT.  
 STA. 1+00 - STA. 2+07, LT.  
 STA. 1+00 - STA. 6+81, RT.  
 STA. 2+76 - STA. 4+66, LT.

**DURABLE 4-INCH YELLOW LINE, THERMOPLASTIC**

SL STA. 100+75 - SL STA. 105+48  
 STA. 1+00 - STA. 2+37  
 STA. 2+76 - STA. 6+81

**DURABLE 24-INCH STOP BAR, THERMOPLASTIC**

SL STA. 105+46, RT.

**DURABLE LETTER OR SYMBOL, THERMOPLASTIC**

SL STA. 103+69, RT. (LEFT TURN ARROW)  
 SL STA. 103+69, RT. (RIGHT TURN ARROW)  
 SL STA. 104+09, RT. ("ONLY")  
 SL STA. 104+09, RT. ("ONLY")  
 SL STA. 104+50, RT. (LEFT TURN ARROW)  
 SL STA. 104+50, RT. (RIGHT TURN ARROW)  
 SL STA. 104+91, RT. ("ONLY")  
 SL STA. 104+91, RT. ("ONLY")  
 SL STA. 105+32, RT. (LEFT TURN ARROW)  
 SL STA. 105+32, RT. (RIGHT TURN ARROW)  
 STA. 2+98, LT. (RIGHT TURN ARROW)  
 STA. 3+40, LT. ("ONLY")  
 STA. 3+82, LT. (RIGHT TURN ARROW)  
 STA. 4+24, LT. ("ONLY")  
 STA. 4+66, LT. (RIGHT TURN ARROW)

**TEMPORARY 4 INCH YELLOW LINE**

SL STA. 100+75 - SL STA. 105+48  
 STA. 1+00 - STA. 2+37  
 STA. 2+76 - STA. 6+81

**TEMPORARY 4 INCH WHITE LINE**

STA. 2+76 - STA. 4+66, LT.  
 SL STA. 103+68 - SL STA. 104+46, RT.

**TEMPORARY 24 INCH STOP BAR**

SL STA. 105+46, RT.

**TEMPORARY LETTER OR SYMBOL**

STA. 2+98, LT. (RIGHT TURN ARROW)  
 STA. 3+82, LT. ("ONLY")  
 STA. 4+66, LT. (RIGHT TURN ARROW)

**REMOVING SIGNS**

SL STA. 102+21, RT.  
 SL STA. 105+25, LT.  
 SL STA. 105+38, RT.  
 STA. 1+95, LT.  
 STA. 2+80, LT.  
 STA. 2+97, LT. (2 SIGNS)  
 STA. 4+14, LT. (3 SIGNS)  
 STA. 7+94, LT. (2 SIGNS)

**ERECTING SALVAGED SIGNS**


SL STA. 104+66, LT.

**SPECIAL PROVISION (RELOCATE SIGN, COMMERCIAL/LIGHTED)**

STA. 4+00, LT. (3 SIGNS)


**SPECIAL PROVISION (RELOCATE FLASHING BEACON, GROUND MOUNTED)**

STA. 5+51, LT.

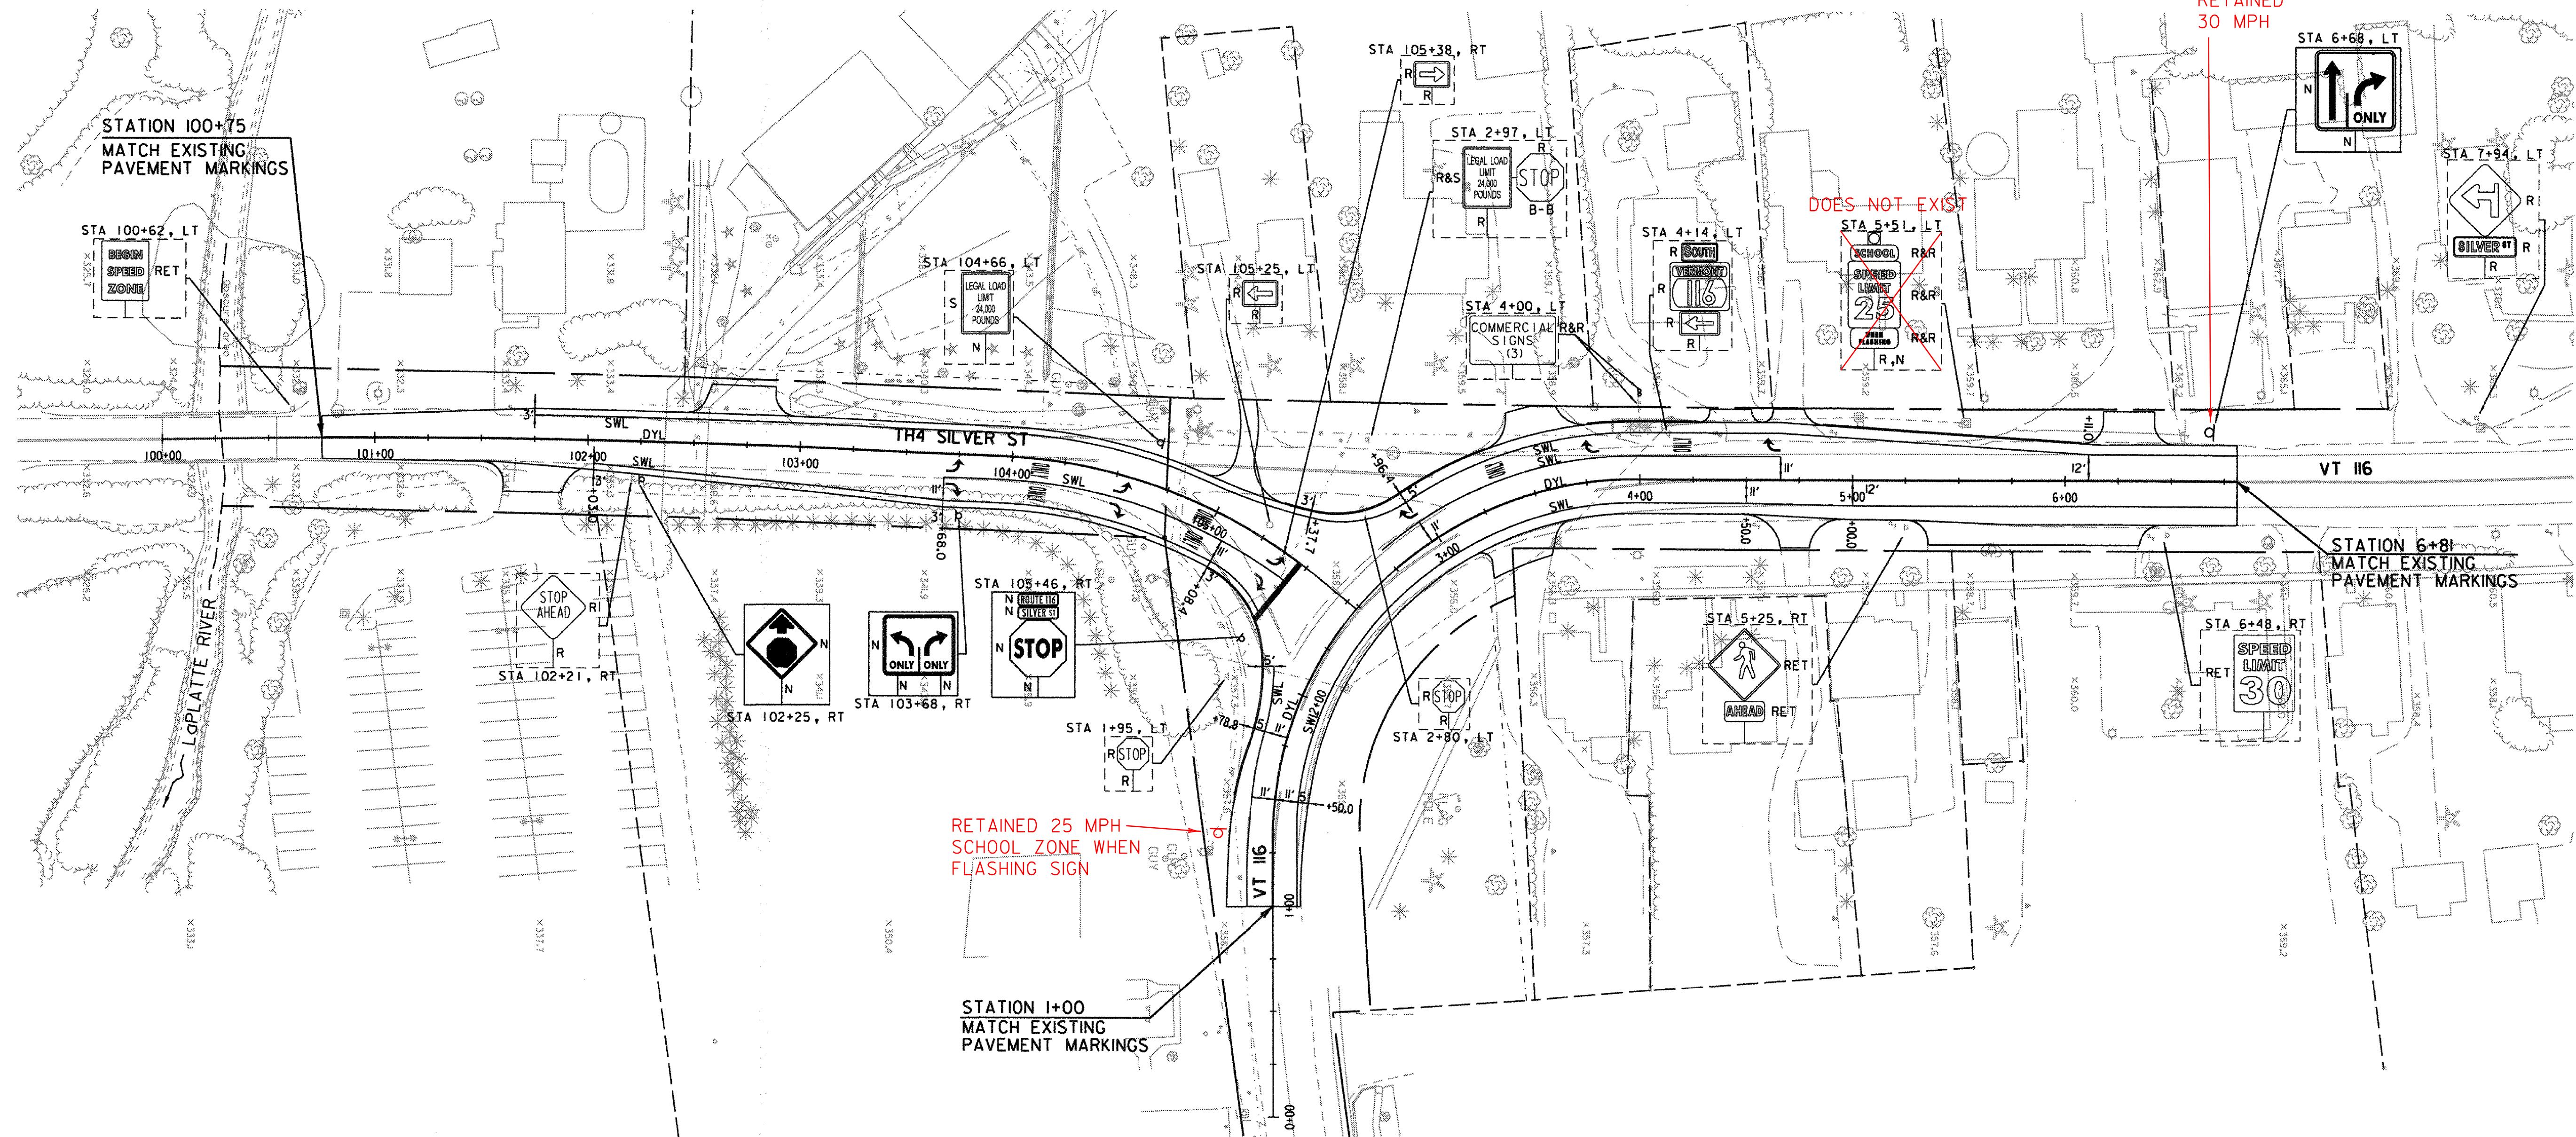

| SIGN LEGEND |                         |
|-------------|-------------------------|
| N           | = NEW                   |
| R           | = REMOVE                |
| S           | = SALVAGED SIGN         |
| B-B         | = BACK TO BACK          |
| RET         | = RETAIN                |
| R&R         | = REMOVE & RESET        |
| R&S         | = REMOVE & SALVAGE SIGN |

| STRIPING LEGEND |                      |
|-----------------|----------------------|
| SWL             | = SINGLE WHITE LINE  |
| DYL             | = DOUBLE YELLOW LINE |

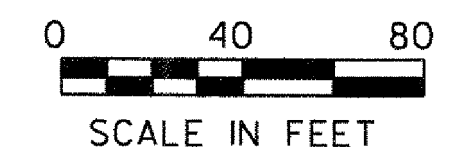

NOTE:  
 ALL SIGNS REMOVED AND NOT REUSED ON THE PROJECT WILL BE RETURNED TO THE DISTRICT 5 OFFICES, COLCHESTER, VT FOR REUSE.

|                           |                      |
|---------------------------|----------------------|
| PROJECT NAME:             | HINESBURG            |
| PROJECT NUMBER:           | HES 021-1(20)        |
| FILE NAME:                | z04b206 BDR Sign.dgn |
| PROJECT LEADER:           | G. BAKOS             |
| DESIGNED BY:              | D. PECK              |
| SIGNING AND STRIPING PLAN |                      |
| PLOT DATE:                | 2/18/2009            |
| DRAWN BY:                 | D. PECK              |
| CHECKED BY:               | G. BAKOS             |
| SHEET                     | 19 OF 25             |

