


TH4 SILVER STREET

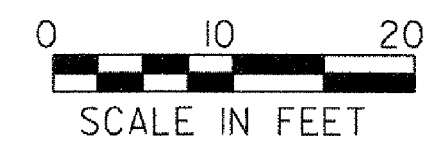

PROJECT NAME:	HINESBURG	PLOT DATE:	2/18/2009
PROJECT NUMBER:	HES 021-1(20)	DRAWN BY:	D. PECK
FILE NAME:	z04b206xsec.dgn	DESIGNED BY:	D. PECK
PROJECT LEADER:	G. BAKOS	CHECKED BY:	G. BAKOS
CROSS SECTIONS:	3	SHEET:	24 OF 25