

STATE OF VERMONT AGENCY OF TRANSPORTATION




PROPOSED IMPROVEMENT TOWN OF HINESBURG COUNTY OF CHITTENDEN VT 116 (MINOR ARTERIAL) AT SILVER STREET (MAJOR T.H. COLLECTOR)

BEGINNING ON VT 116 EAST OF THE SILVER ST. INTERSECTION (MM 4.36) AND EXTENDING NORTHERLY ALONG VT 116 FOR APPROXIMATELY 580 FT (0.110 MILES).


LENGTH OF ROADWAY: 773 FT = 0.146 MILES
LENGTH OF PROJECT: 773 FT = 0.146 MILES

WORK TO BE PERFORMED UNDER THIS PROJECT INCLUDES RECONSTRUCTION OF VT 116 AND SILVER ST. WITH NEW PAVEMENT, SUBBASE, CURBING, AND DRAINAGE.

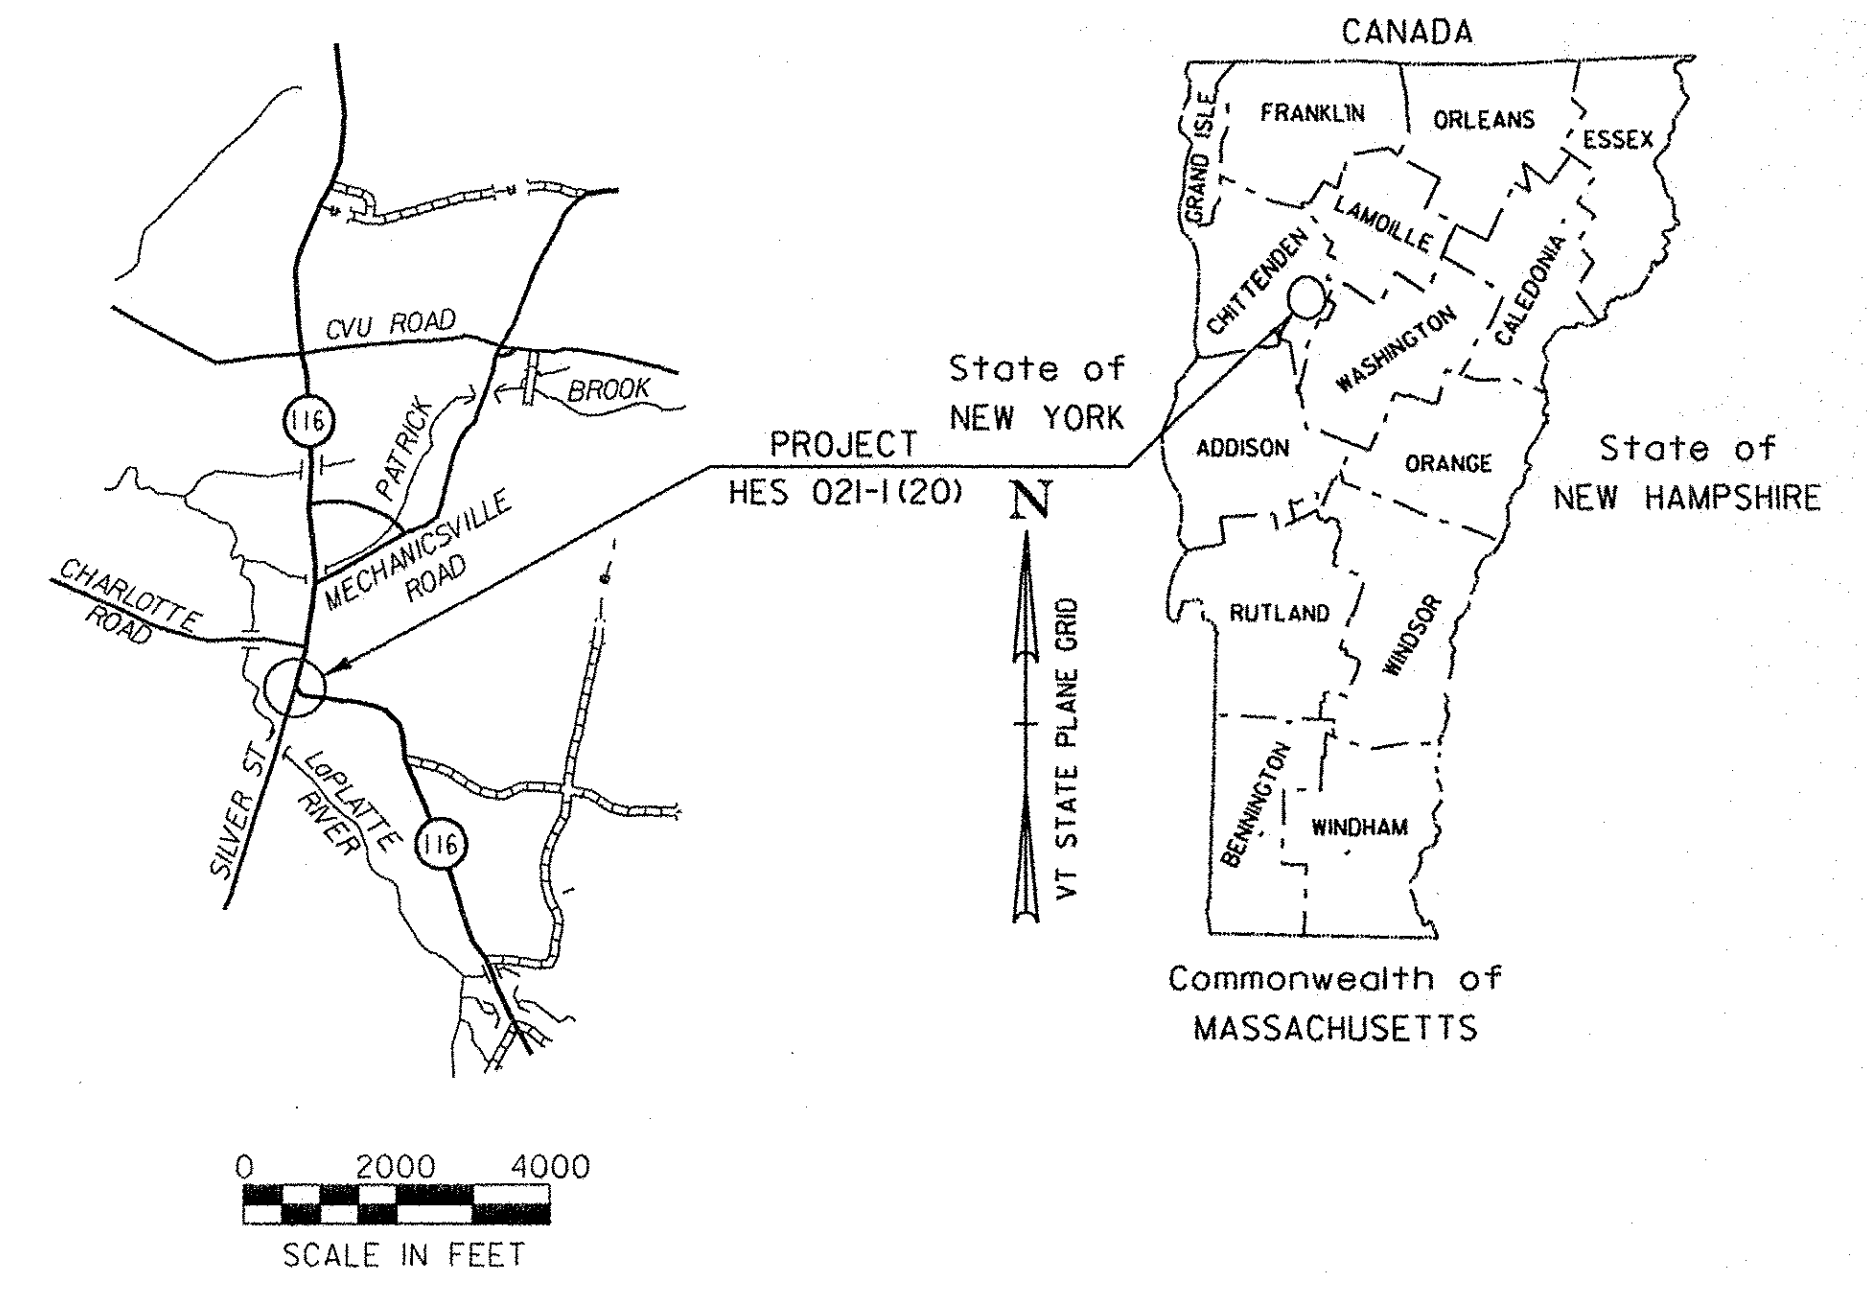

RECORD PLANS	
CONTRACTOR:	DON WESTON EXCAVATING, INC. - WILLISTON, VT
RESIDENT ENGINEER:	DALE NORTON
CONSTRUCTION BEGAN:	JULY 17, 2009
CONSTRUCTION COMPLETE:	SEPTEMBER 20, 2010
RECORD PLANS BY:	DALE NORTON & JENNA HYDE
I HEREBY CERTIFY THAT ALL THE CONSTRUCTION REQUIRED BY THIS SET OF DRAWINGS HAS BEEN ACCOMPLISHED AS INDICATED HEREIN.	
BY:	<i>Dale R. Norton</i> RESIDENT ENGINEER
DATE:	Aug 03, 2012
NOTE: Any further information concerning final quantities, amounts or other details relative to this project may be found at Central Files in the electronic archives.	

TRAFFIC DATA			
VT 116 (NORTH LEG)		VT 116 (SOUTH LEG)	
ADT 2007 = 11,700	ADT 2027 = 14,700	ADT 2007 = 5,000	ADT 2027 = 6,300
2007 DHV = 1,200	2027 DHV = 1,500	2007 DHV = 560	2027 DHV = 710
2007 ADTT = 950	2027 ADTT = 1,900	2007 ADTT = 230	2027 ADTT = 470
2007 %D = 71	2027 %D = 71	2007 %D = 71	2027 %D = 71
2007 %T = 6.5	2027 %T = 10.4	2007 %T = 3.8	2027 %T = 6.3
DESIGN SPEED = 25 MPH POSTED SPEED = 30 MPH		DESIGN SPEED = 25 MPH POSTED SPEED = 30 MPH	
2007-2027 ESAL'S = 6,742,000 2007-2047 ESAL'S = 17,961,000		2007-2027 ESAL'S = 885,000 2007-2047 ESAL'S = 2,269,000	
TH4			
ADT 2007 = 6,800	ADT 2027 = 8,500		
2007 DHV = 710	2027 DHV = 880		
2007 ADTT = 650	2027 ADTT = 1,300		
2007 %D = 74	2027 %D = 74		
2007 %T = 11.2	2027 %T = 18.1		
DESIGN SPEED = 40 MPH POSTED SPEED = 30 MPH			
2007-2027 ESAL'S = 4,106,000 2007-2047 ESAL'S = 10,179,000			

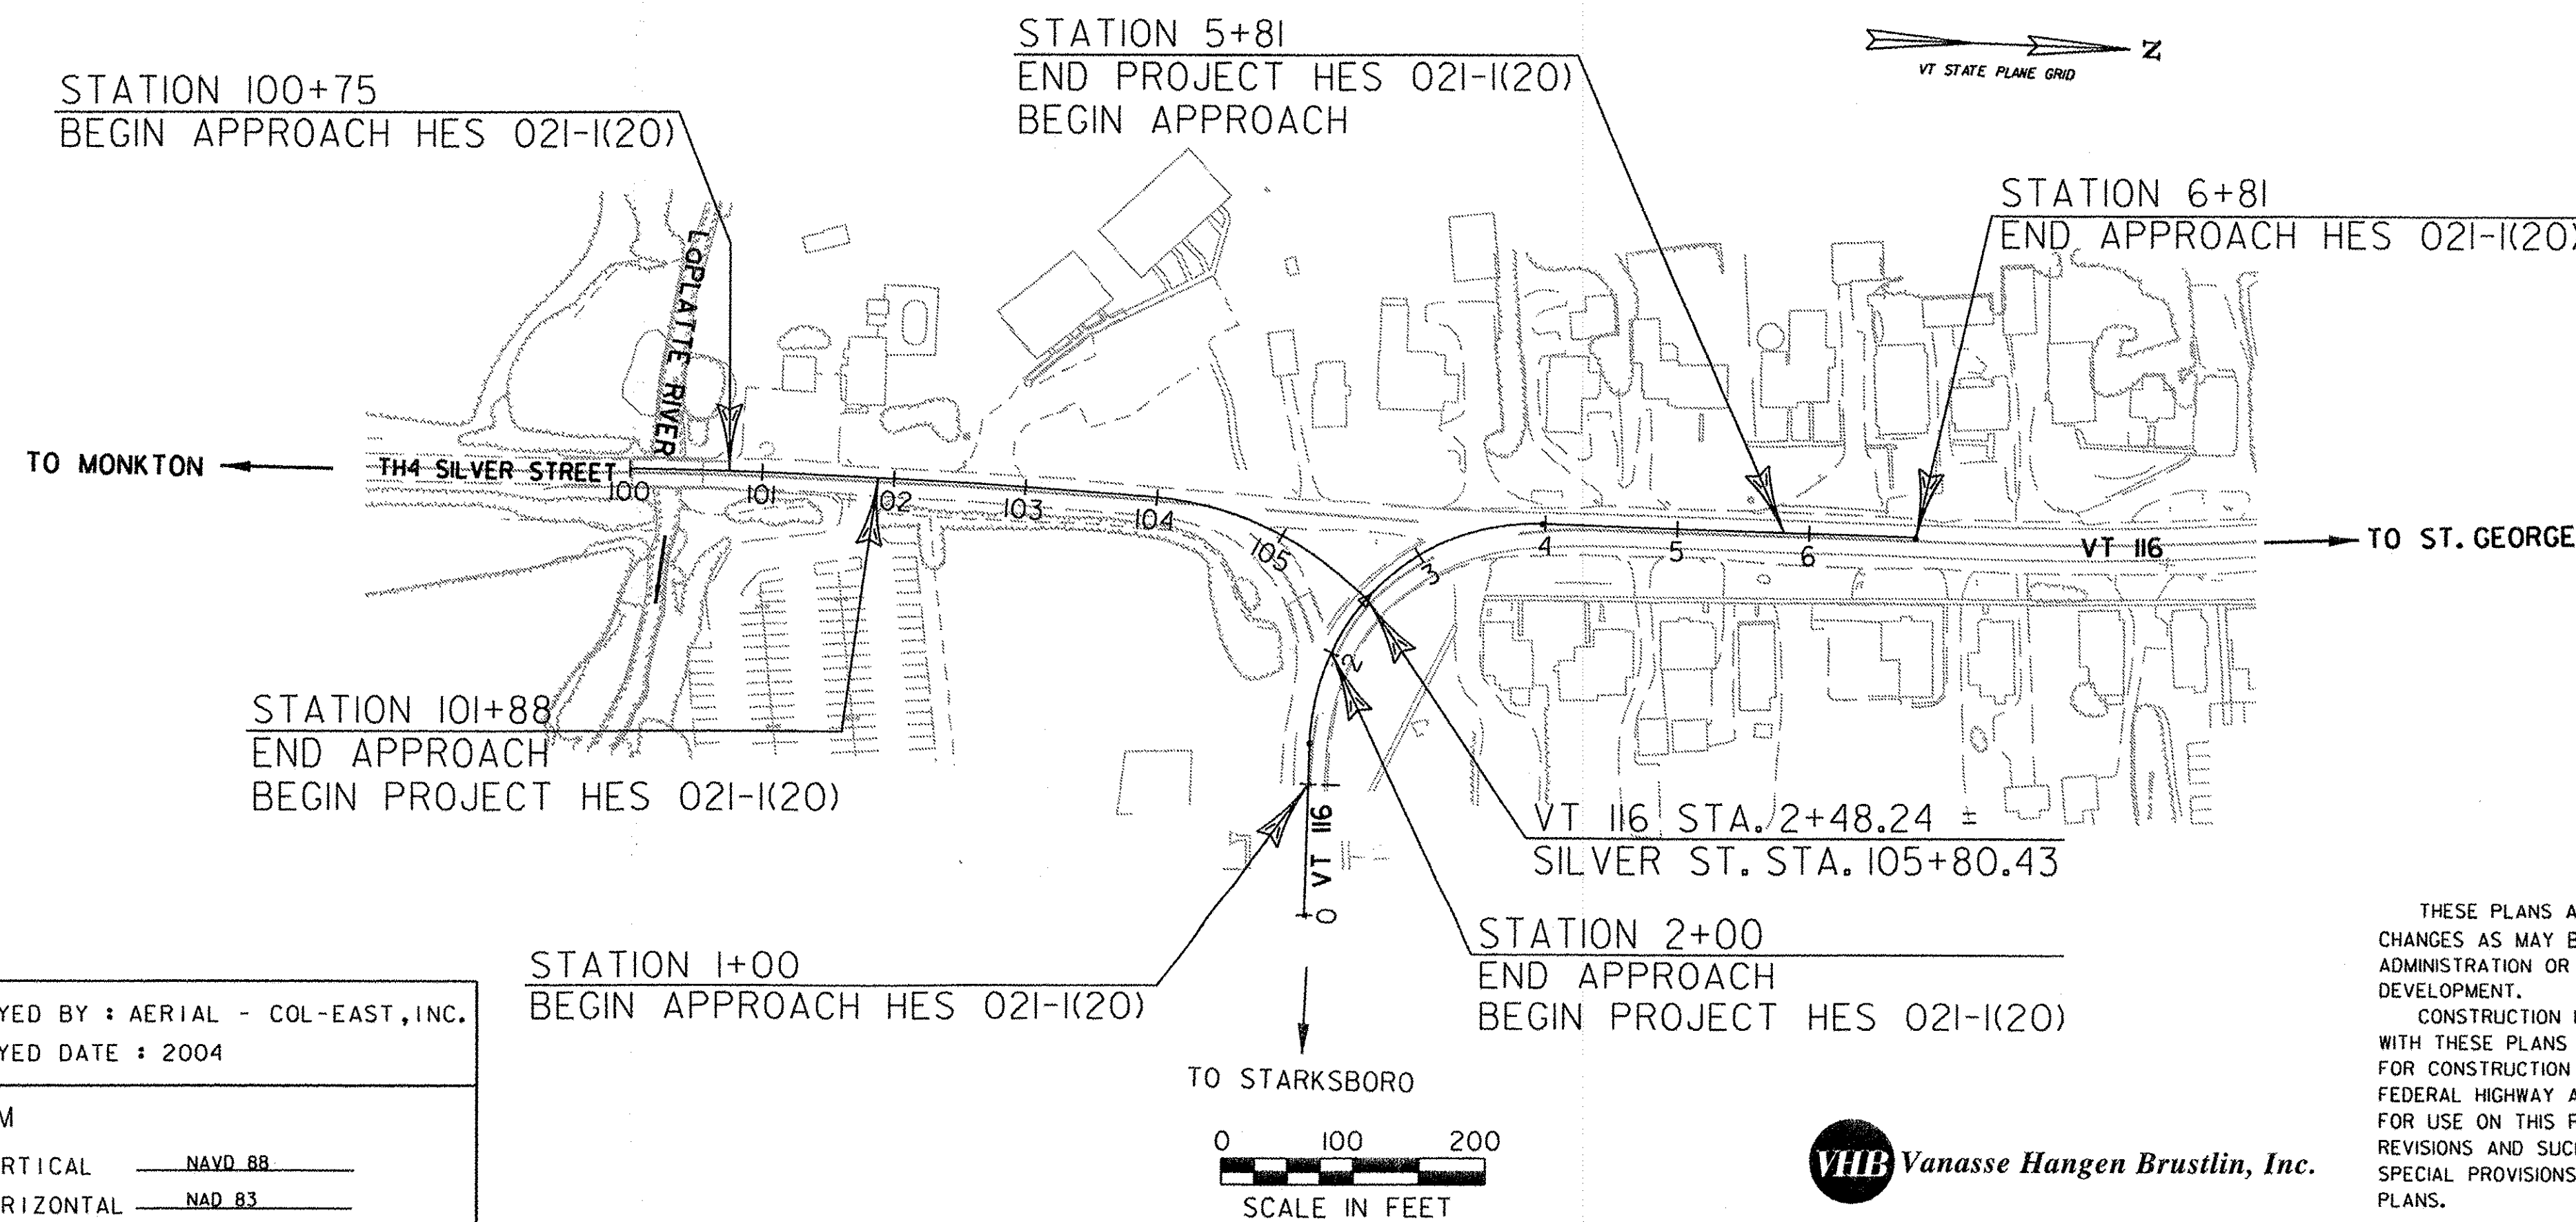

CONVENTIONAL SYMBOLS	
COUNTY LINE	
TOWN LINE	
LIMITS OF ACCESS	
POINT OF ACCESS	
FENCE LINE	
STONE WALL	
TRAVELED WAY	
GUARD RAIL	
RAILROAD	
SURVEY LINE	
CULVERT	
POWER POLE	
TELEPHONE POLE	
TREES	
CONTROL OF ACCESS	
PROPERTY LINE	
R.O.W. TAKING LINE	
SLOPE RIGHTS	
TOP OF CUT	
TOE OF SLOPE	

SURVEYED BY: AERIAL - COL-EAST, INC.
SURVEYED DATE: 2004

DATUM
VERTICAL: NAVD 88
HORIZONTAL: NAD 83

THESE PLANS ARE SUBJECT TO SUCH ENGINEERING CHANGES AS MAY BE REQUIRED BY THE FEDERAL HIGHWAY ADMINISTRATION OR THE DIRECTOR OF PROGRAM DEVELOPMENT.

CONSTRUCTION IS TO BE CARRIED ON IN ACCORDANCE WITH THESE PLANS AND THE STANDARD SPECIFICATIONS FOR CONSTRUCTION DATED 2006, AS APPROVED BY THE FEDERAL HIGHWAY ADMINISTRATION ON JUNE 15, 2006 FOR USE ON THIS PROJECT, INCLUDING ALL SUBSEQUENT REVISIONS AND SUCH REVISED SPECIFICATIONS AND SPECIAL PROVISIONS AS ARE INCORPORATED IN THESE PLANS.

DIRECTOR OF PROGRAM DEVELOPMENT
APPROVED: *[Signature]* DATE: 2/20/09
PROJECT MANAGER: KENNETH A. ROBIE, P.E.

PROJECT NAME: HINESBURG
PROJECT NUMBER: HES 021-I(20)

SHEET 1 OF 25 SHEETS



INDEX OF SHEETS

1	TITLE SHEET
2	INDEX OF SHEETS
3	TYPICAL SECTIONS
4	DETAILS SHEET
5-6	LANDSCAPING DETAILS
7-8	QUANTITY SHEETS
9	DRAINAGE DETAIL SHEET
10	EARTHWORK SUMMARY SHEET
11	TIE SHEET
12-13	RIGHT-OF-WAY DETAIL SHEETS
14	RIGHT-OF-WAY PLAN SHEET
15-16	EPSC DETAILS SHEETS
17	GENERAL PLAN
18	PROFILES
19	SIGNING AND STRIPING PLAN
20	TRAFFIC SIGN SUMMARY SHEET
21	CONSTRUCTION APPROACH SIGNING
22-25	CROSS SECTIONS

STANDARD SHEETS

A-76	STANDARD FOR DEVELOPMENT ROADS	3/3/03
B-1	BANKING TABLES	6/1/94
B-5	SLOPE GRADING, EMBANKMENTS, MUCK	6/1/94
B-71	RESIDENTIAL AND COMMERCIAL DRIVES	7/8/05
C-10	CURBING	2/11/08
D-3	TREATED GUTTERS	6/1/94
D-4	FLUSHING BASINS, END SECTIONS, ELBOWS TYPICAL WATERFALL FOR CULVERTS UP TO AND INCLUDING 48" DIA EXTENSION SERVICE BOX AND CURB STOP CORRUGATED PIPE ELBOW GRANULAR BORROW AT CULVERT LOCATIONS UNDERDRAIN FLUSHING BASINS CORRUGATED STEEL PIPE END SECTION CORRUGATED STEEL PIPE ARCH END SECTION	8/13/07
D-6	REINF. CONCRETE DROP INLET W/ GRATE (DITCHES)	6/1/94
D-8	REINFORCED CONCRETE DROP INLET WITH PRECAST COVER & GRATE (BOTTOM SECTION) SEE SHEETS D-9, 10, 11 FOR TOP SECTION	1/3/00
D-11	GRATES & COVERS (TYPE A)	6/1/94
D-15	PRECAST REINF. CONC. MANHOLE GRATES (BICYCLE SAFE) CAST IRON GRATE WITH FRAME, TYPE D CAST IRON GRATE WITH FRAME, TYPE E	6/1/94
E-100	CONSTRUCTION APPROACH SIGNS	1/2/04
E-100A	SIDE ROAD CONSTRUCTION - APPROACH SIGNS	1/2/04
E-101	CONSTRUCTION SIGN DETAILS	5/30/03
E-102	CONSTRUCTION SIGN DETAILS	6/30/03
E-102A	CONSTRUCTION SIGN DETAILS	5/1/04
E-106	TRAFFIC CONTROL - MISCELLANEOUS DETAILS	3/1/04
E-107	DELINEATION, BARRICADES AND DETOURS FOR CONSTRUCTION AREAS	6/30/03
E-107A	BREAKAWAY BARRICADE DETAILS	8/8/95
E-108	CONSTRUCTION ZONE LONGITUDINAL DROP OFFS	12/8/08
E-108A	CONSTRUCTION ZONE LONGITUDINAL DROP OFFS FOR PAVING	12/8/08
E-110	MAJOR MAINTENANCE OPERATIONAL LANE CLOSURE	8/8/95
E-111	MINOR MAINTENANCE OPERATION	3/11/97
E-119	UTILITY WORK ZONE	3/1/04
E-121	STANDARD SIGN PLACEMENT CONVENTIONAL ROAD	8/8/95
E-123	GUIDE SIGN PLACEMENT MISCELLANEOUS DETAILS	3/16/04
E-141	REGULATORY SIGN DETAILS	9/20/95
E-142	REGULATORY SIGN DETAILS	9/20/95
E-143	REGULATORY SIGN DETAILS	6/15/04
E-145A	REGULATORY SIGN DETAILS LANE USE CONTROL SIGNS TWO AND FOUR LANE APPROACHES	12/23/94
E-150	WARNING SIGN DETAILS	5/1/04
E-153	WARNING SIGN DETAILS	5/1/04
E-164	SQUARE STEEL SIGN POST	5/20/99
E-191	PAVEMENT MARKING DETAILS	2/1/99
E-192	PAVEMENT MARKING DETAILS	10/12/00
E-193	PAVEMENT MARKING DETAILS	8/18/95
G-18	PRECAST CONCRETE TEMPORARY TRAFFIC BARRIER	6/1/94
J-3	MAILBOX SUPPORT DETAIL (SINGLE AND MULTIPLE SUPPORT)	8/7/95

NOTE: TOWN HALL STAIRS TOP STEP SOUTH SIDE CH. SO. 350.365 PER T.O.M.

PROJECT NAME: HINESBURG	PLOT DATE: 2/18/2009
PROJECT NUMBER: HES 021-1(20)	DRAWN BY: D. PECK
FILE NAME: z04b206ind.dgn	CHECKED BY: G. BAKOS
PROJECT LEADER: G. BAKOS	SHEET 2 OF 25
DESIGNED BY: D. PECK	
INDEX OF SHEETS	



MATERIAL TOLERANCES

MATERIAL ITEM	THICKNESS TOLERANCE
PAVEMENT (TOTAL DEPTH)	3/4"
SUBBASE	1"
SAND	1"

TYPICAL SECTIONS

1/2" SPECIAL PROVISION (BITUMINOUS CONCRETE PAVEMENT, SMALL QUANTITY) (TYPE IVS WEARING COURSE)
 3" SPECIAL PROVISION (BITUMINOUS CONCRETE PAVEMENT, SMALL QUANTITY) (TYPE IIS BINDER COURSE)
 3" SPECIAL PROVISION (BITUMINOUS CONCRETE PAVEMENT, SMALL QUANTITY) (TYPE IIS BASE COURSE)
 24" SUBBASE OF DENSE GRADED CRUSHED STONE
 6" OF SAND BORROW (SILVER ST. WHERE SHOWN)

**SEEDING FORMULA
URBAN AREAS**


% WT.	LBS./A.	NAME	PUR %	GERM %
42.5	34.0	CREeping RED FESCUE	98	85
10.0	8.0	PERENNIAL RYE GRASS	95	90
42.5	34.0	KENTUCKY BLUE GRASS	85	85
5.0	4.0	ANNUAL RYE GRASS	95	85
100.00	80.0			

GENERAL NOTES

- SEED MIXTURE: SHALL NOT HAVE A WEED CONTENT EXCEEDING 0.40% BY WEIGHT AND SHALL BE FREE OF ALL NOXIOUS SEED.
- SEEDS: TO BE APPLIED PER SEEDING FORMULAS OR AS DIRECTED BY THE ENGINEER.
- FERTILIZER: FORMULA 10-20-10, TO BE USED WITH SEED, APPLIED AT THE RATE OF 500 LBS./ACRE. (HYDRO SEEDERS MAY USE 19-19-19 FORMULA).
- AGRICULTURAL LIMESTONE: TO BE APPLIED AT THE RATE OF 2 TONS/ACRE, OR AS DIRECTED BY THE ENGINEER.
- HAY MULCH: TO BE PLACED ON EARTH SLOPES AT THE RATE OF 2 TONS/ACRE, OR AS DIRECTED BY THE ENGINEER.
- TOPSOIL: TO BE USED WITH SEED AS INDICATED ON THE PLANS, OR AS DIRECTED BY THE ENGINEER.

NOTES

- IT IS THE CONTRACTOR'S RESPONSIBILITY TO FOLLOW THE COMPACTION METHODS PER SUBSECTION 301.06
- PROPOSED DRIVE APRONS SHALL INCLUDE 1/2" COLD PLANED PAVEMENT.
- TACK COAT: EMULSIFIED ASPHALT IS TO BE APPLIED AT THE RATE OF 0.025 GAL/SQ BETWEEN SUCCESSIVE COURSES OF PAVEMENT AS DIRECTED BY THE ENGINEER.
- SLOPE ROUNDING: ALL CUT SLOPES TO BE ROUNDED IN ACCORDANCE WITH STANDARD SHEET B - 5.
- MARKER POSTS: TO BE PLACED AS INDICATED OR AS DIRECTED BY THE ENGINEER.

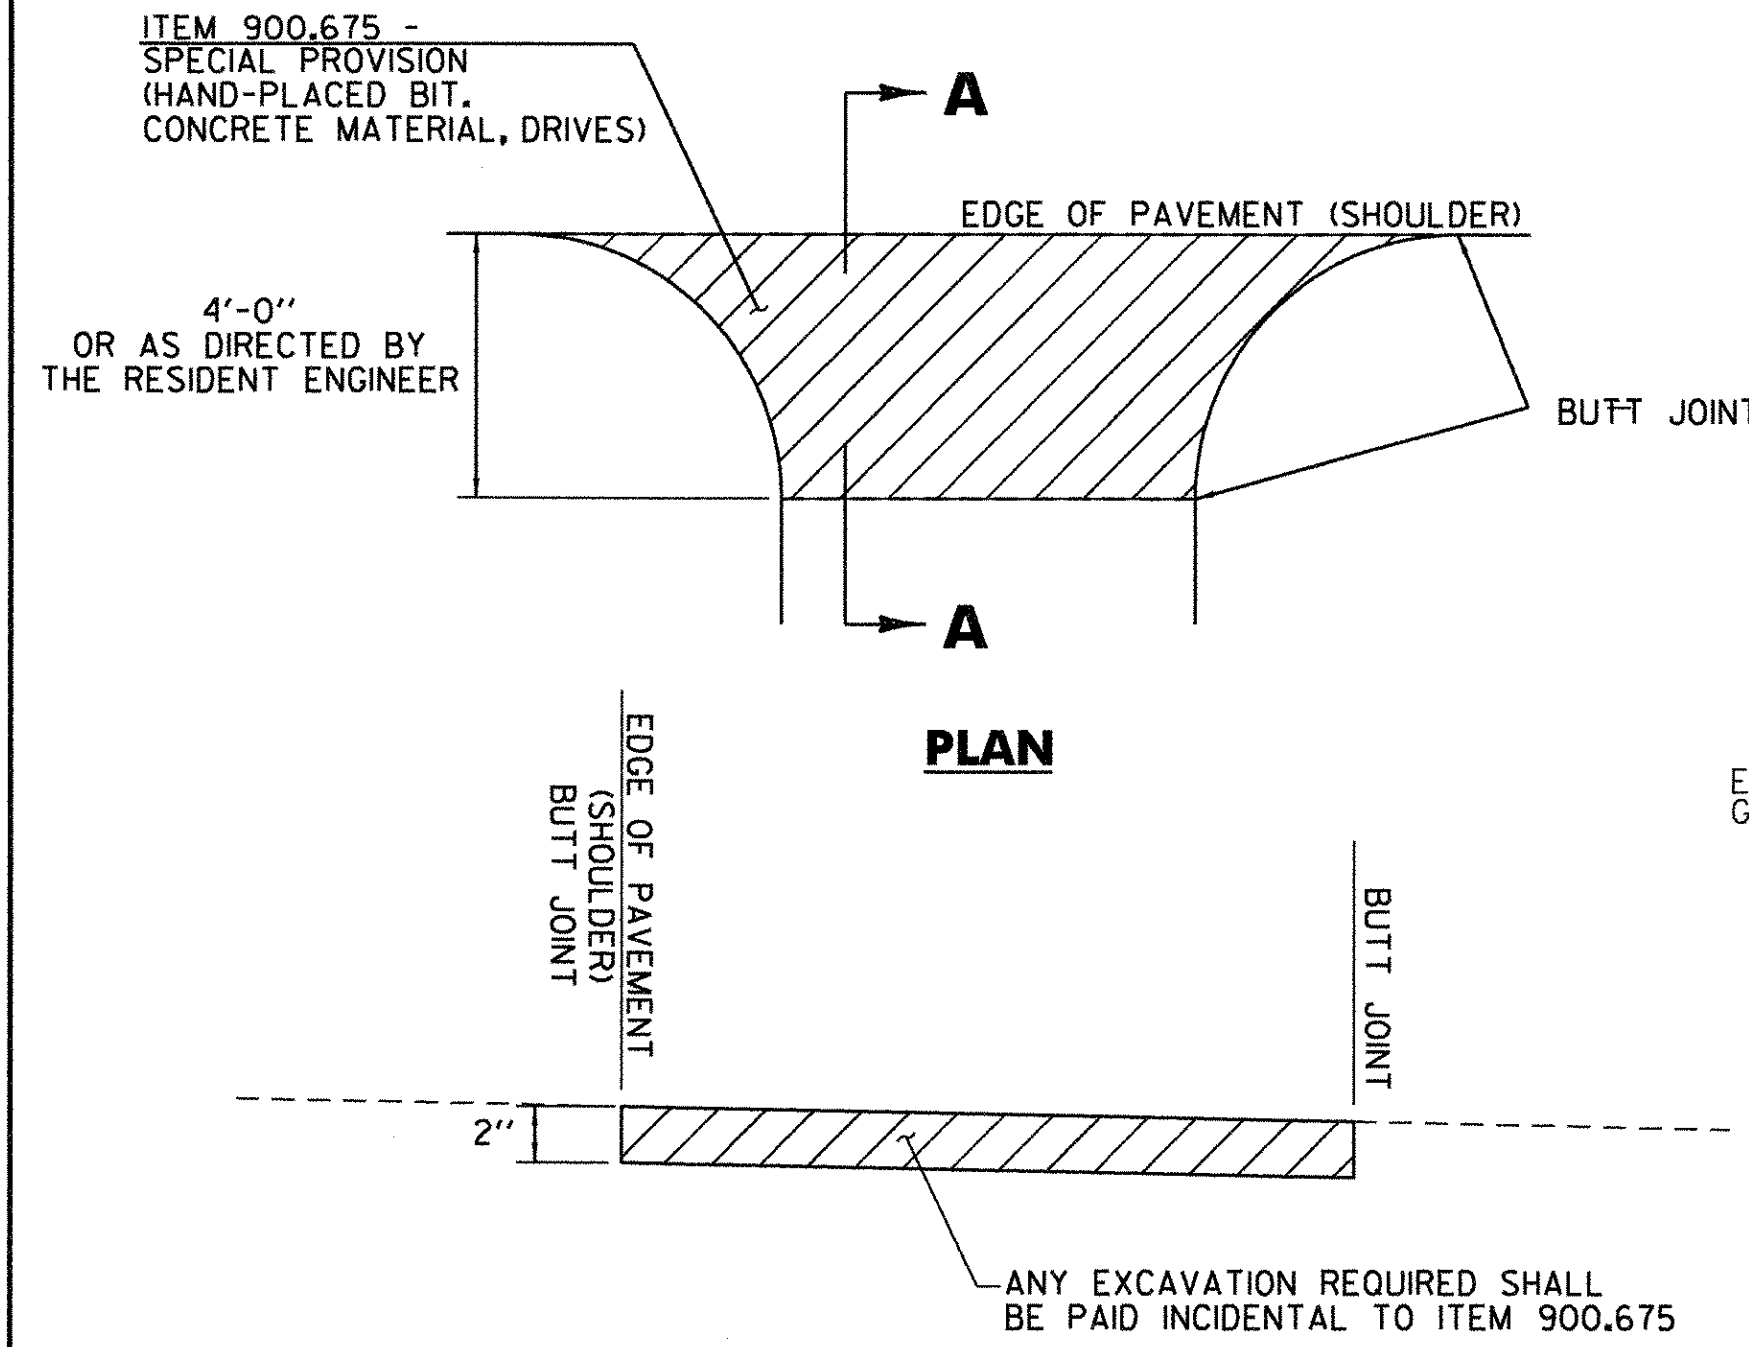


SECTION A-A

HANDWORK DETAILS FOR PAVED DRIVES


STATION	POSITION	QUANTITY* (SY)
SL 101+75	RT	92
SL 102+73	LT	106
SL 105+01	LT	102
3+35	RT	102
3+57	LT	82
4+43	LT	28
4+70	LT	26
4+73	RT	68
5+85	RT	226
6+30	LT	94

* QUANTITY INCLUDES MATERIAL FOR TEMPORARY AND PERMANENT INSTALLATIONS.

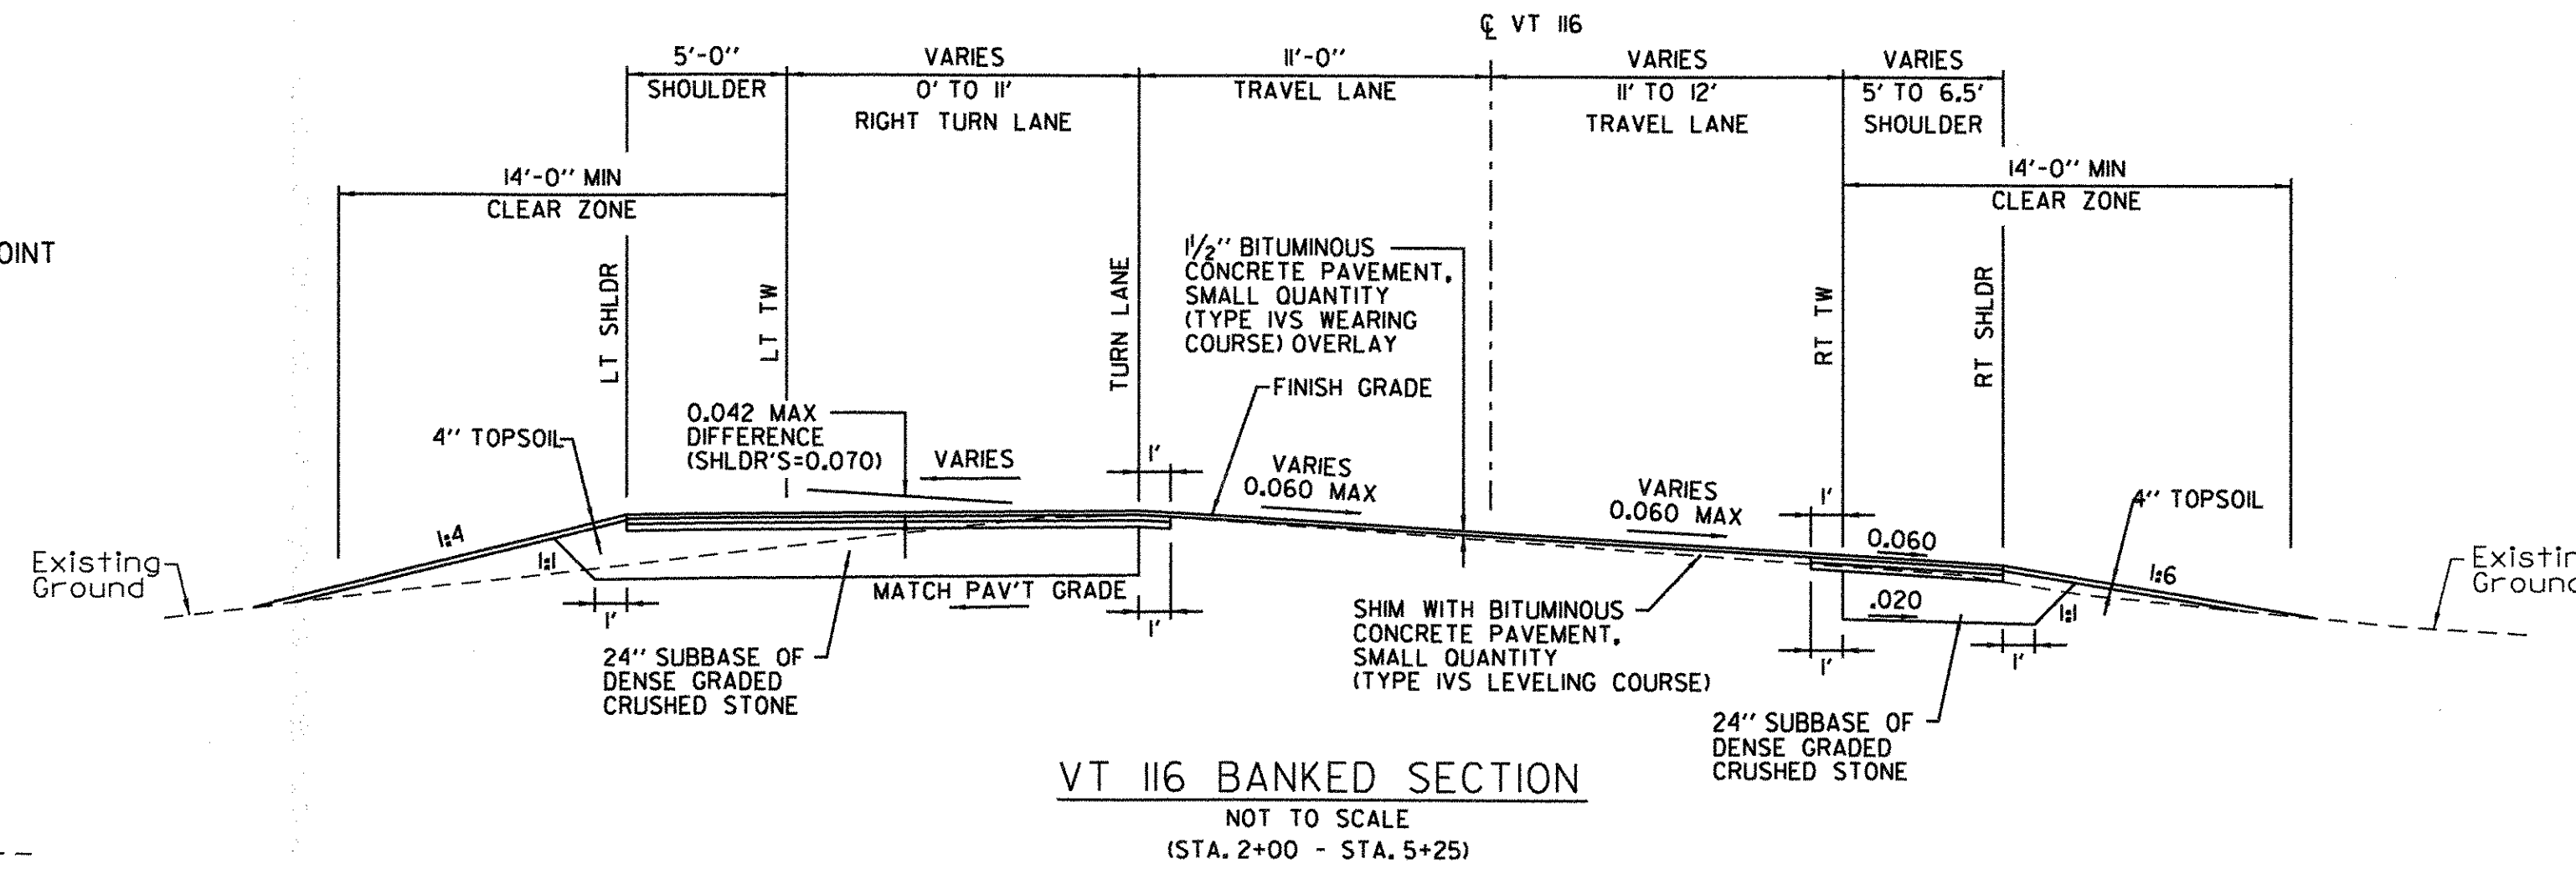


VT 116 BANKED SECTION

NOT TO SCALE
(STA. 2+00 - STA. 5+25)

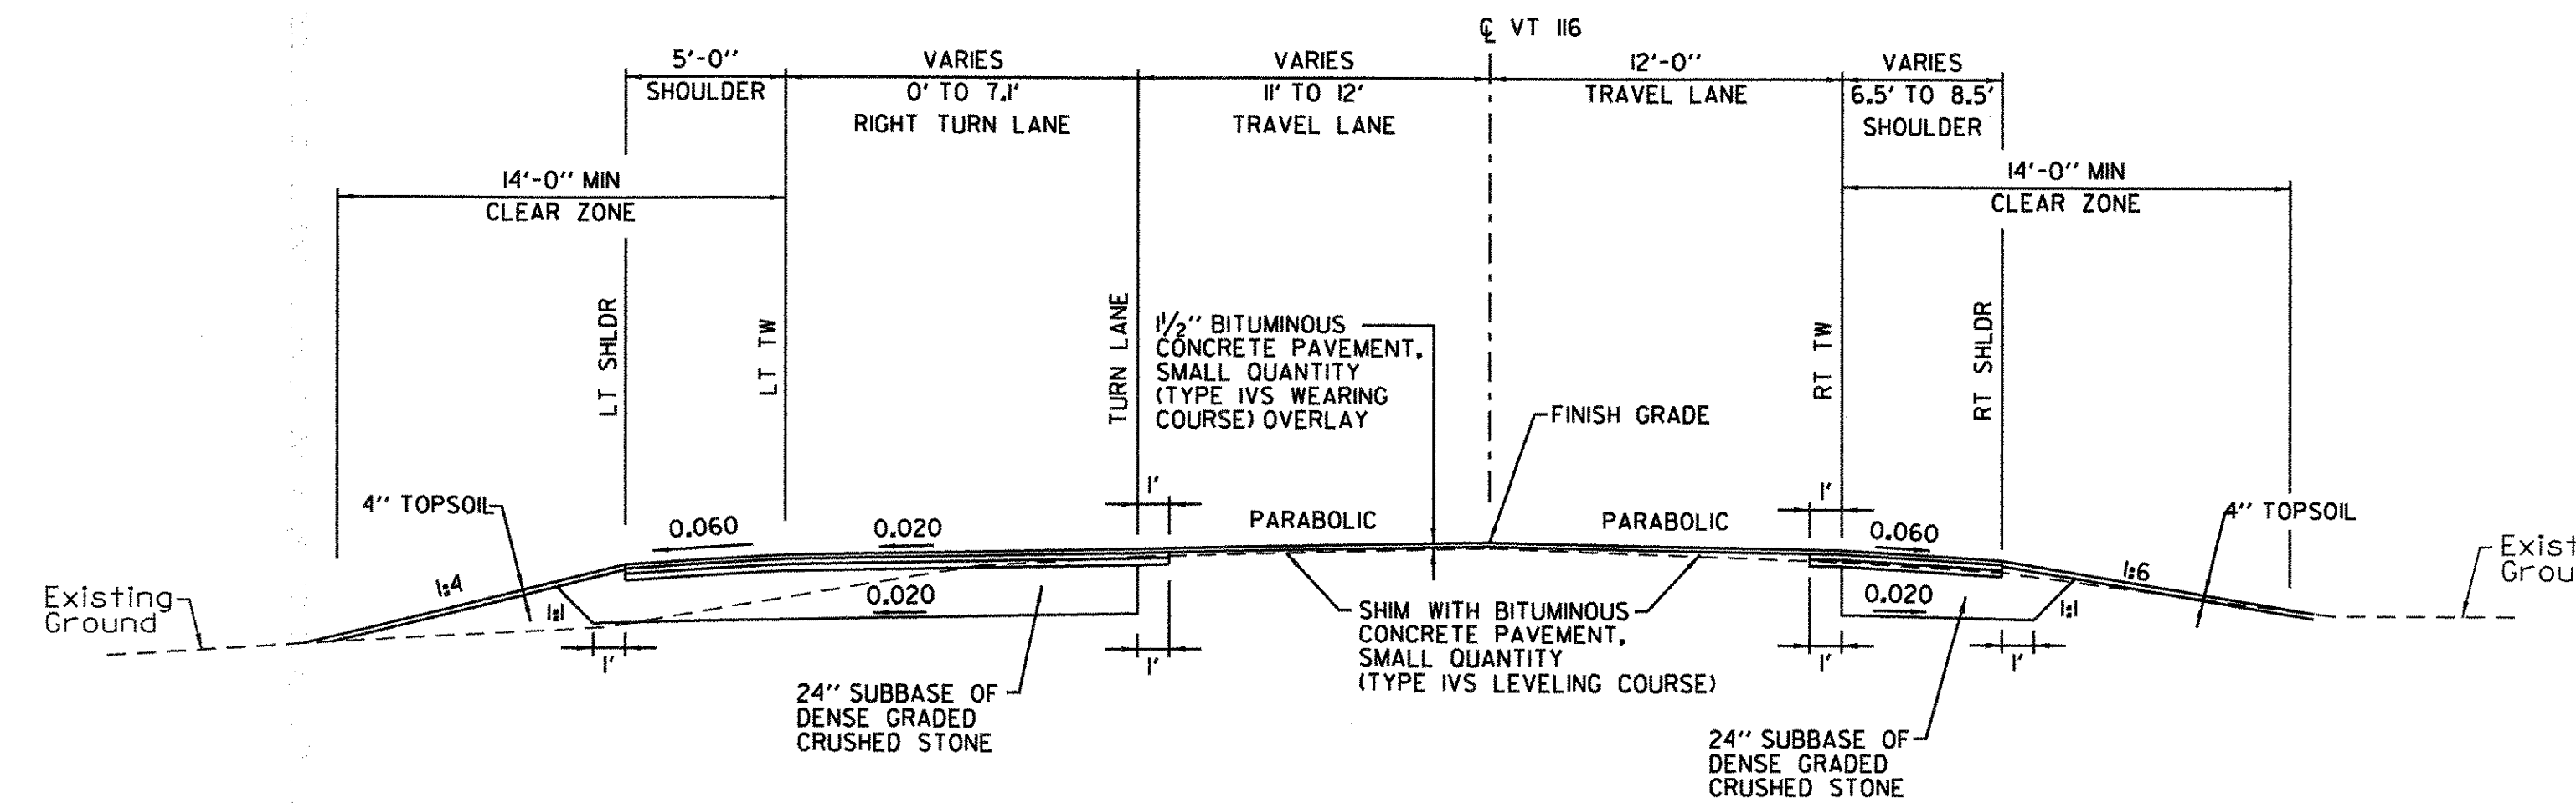


VT 116 NORMAL SECTION

NOT TO SCALE
(STA. 5+25 - STA. 5+81)

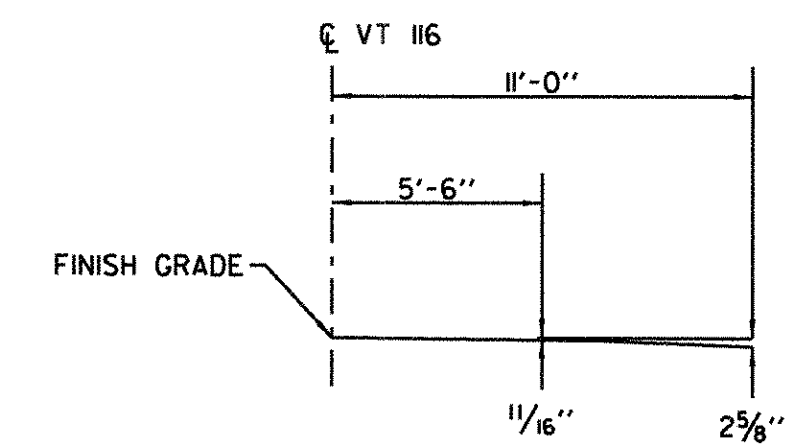


PARABOLIC DETAIL
(NOT TO SCALE)

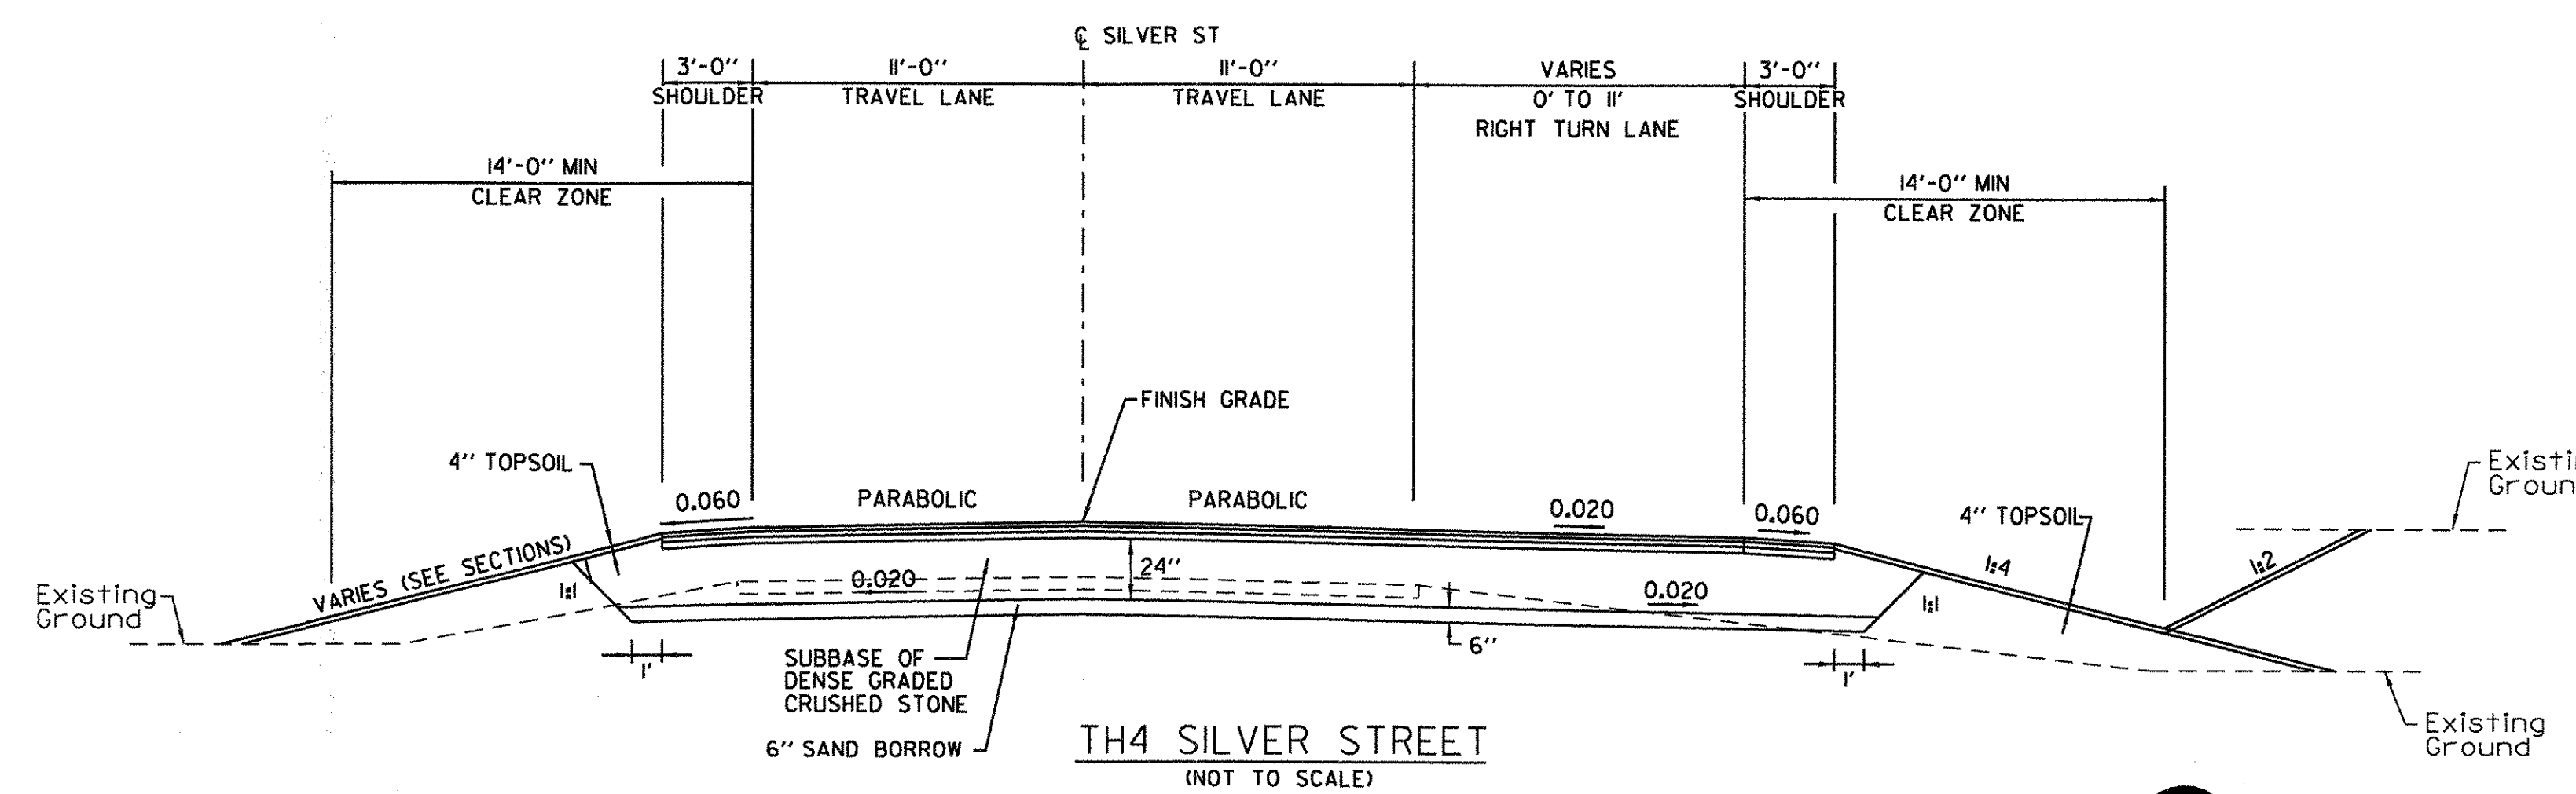

TH4 SILVER STREET

(NOT TO SCALE)

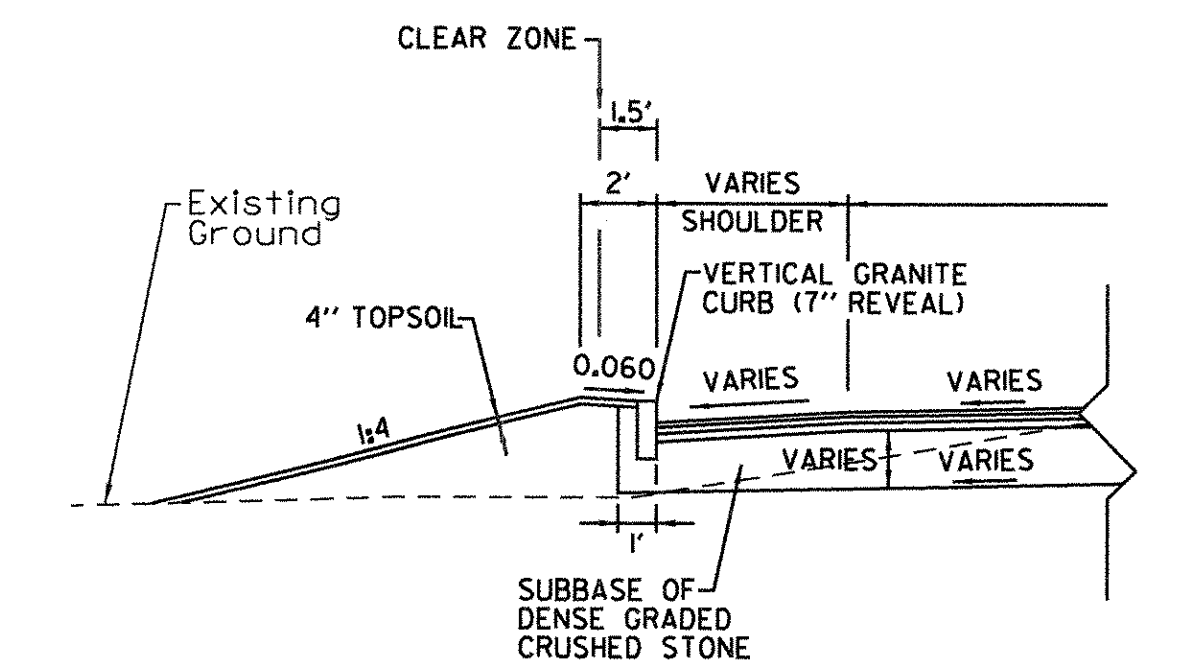


VERTICAL GRANITE CURB INSTALLATION


STA. 1+50, LT. - SL STA. 105+08, RT.
 SL STA. 105+25, LT. - STA. 3+35, LT.
 STA. 3+78, LT. - STA. 4+28, LT.
 STA. 4+86, LT. - STA. 6+07, LT.
 (NOT TO SCALE)

PROJECT NAME: HINESBURG
 PROJECT NUMBER: HES 021-(K20)


FILE NAME: z04b206+yp.dgn PLOT DATE: 2/18/2009
 PROJECT LEADER: G. BAKOS DRAWN BY: D. PECK
 DESIGNED BY: D. PECK CHECKED BY: G. BAKOS
 TYPICAL SECTIONS SHEET 3 OF 25

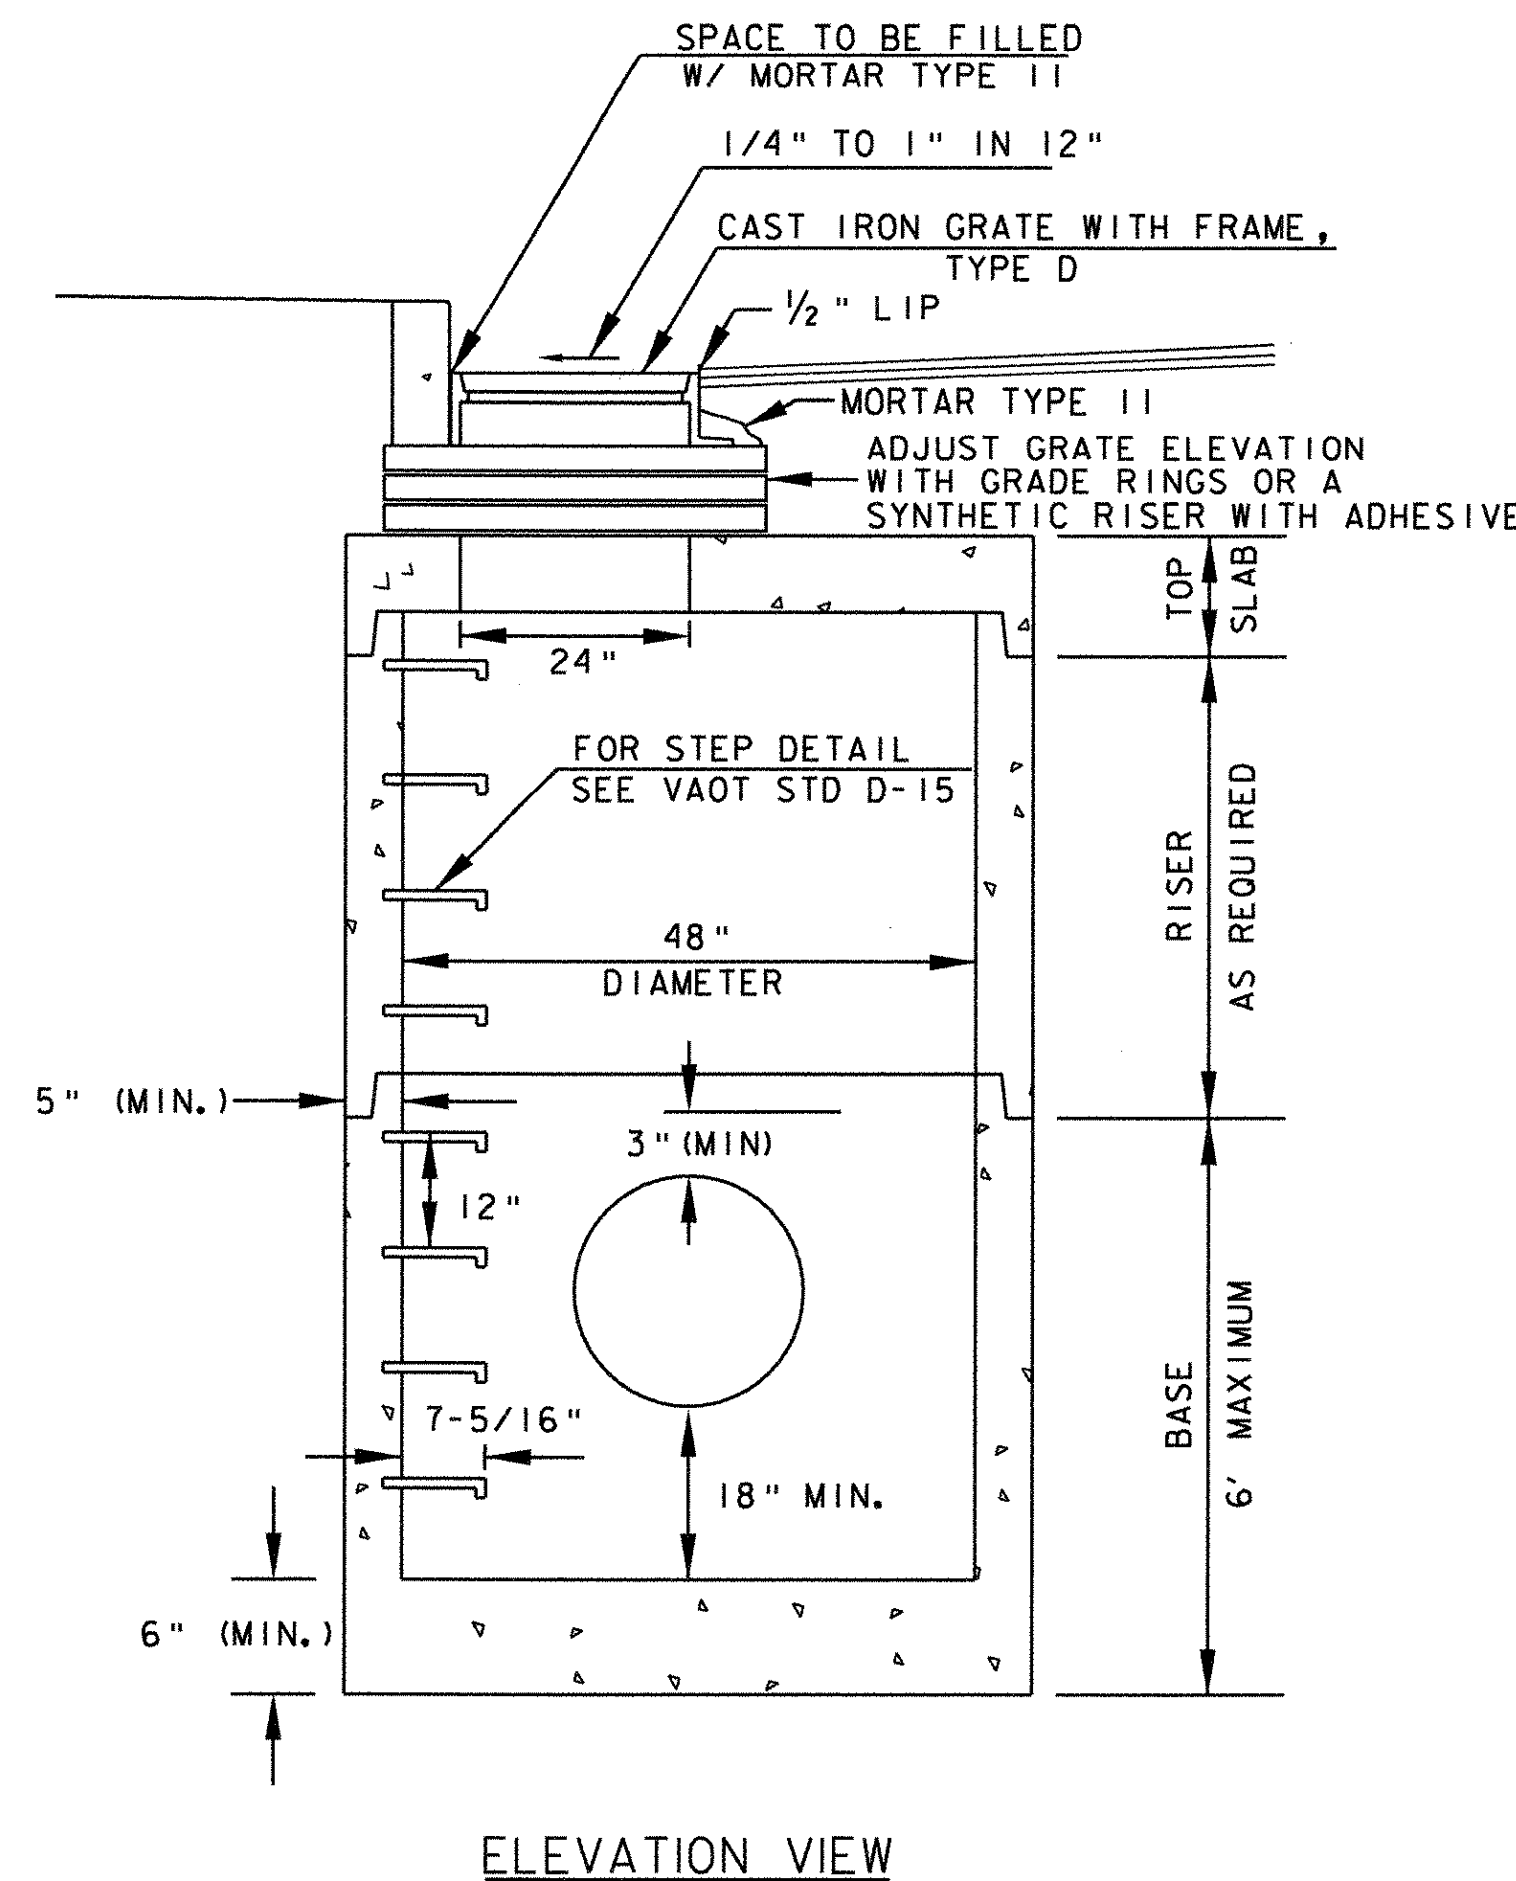


TYPICAL PRECAST DROP INLET INSTALLED IN ROADWAY
NOT TO SCALE

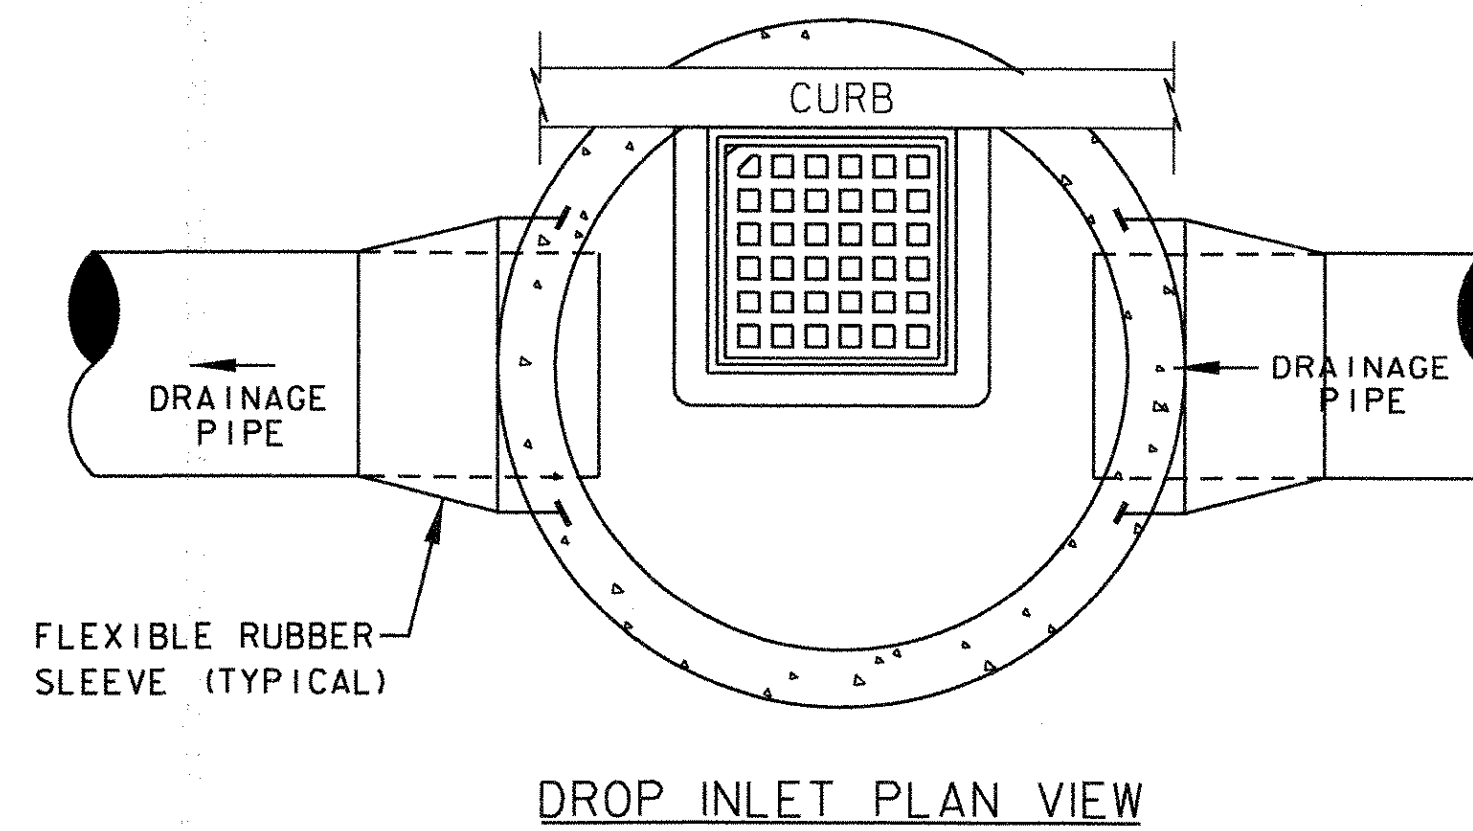


DROP INLET PLAN VIEW

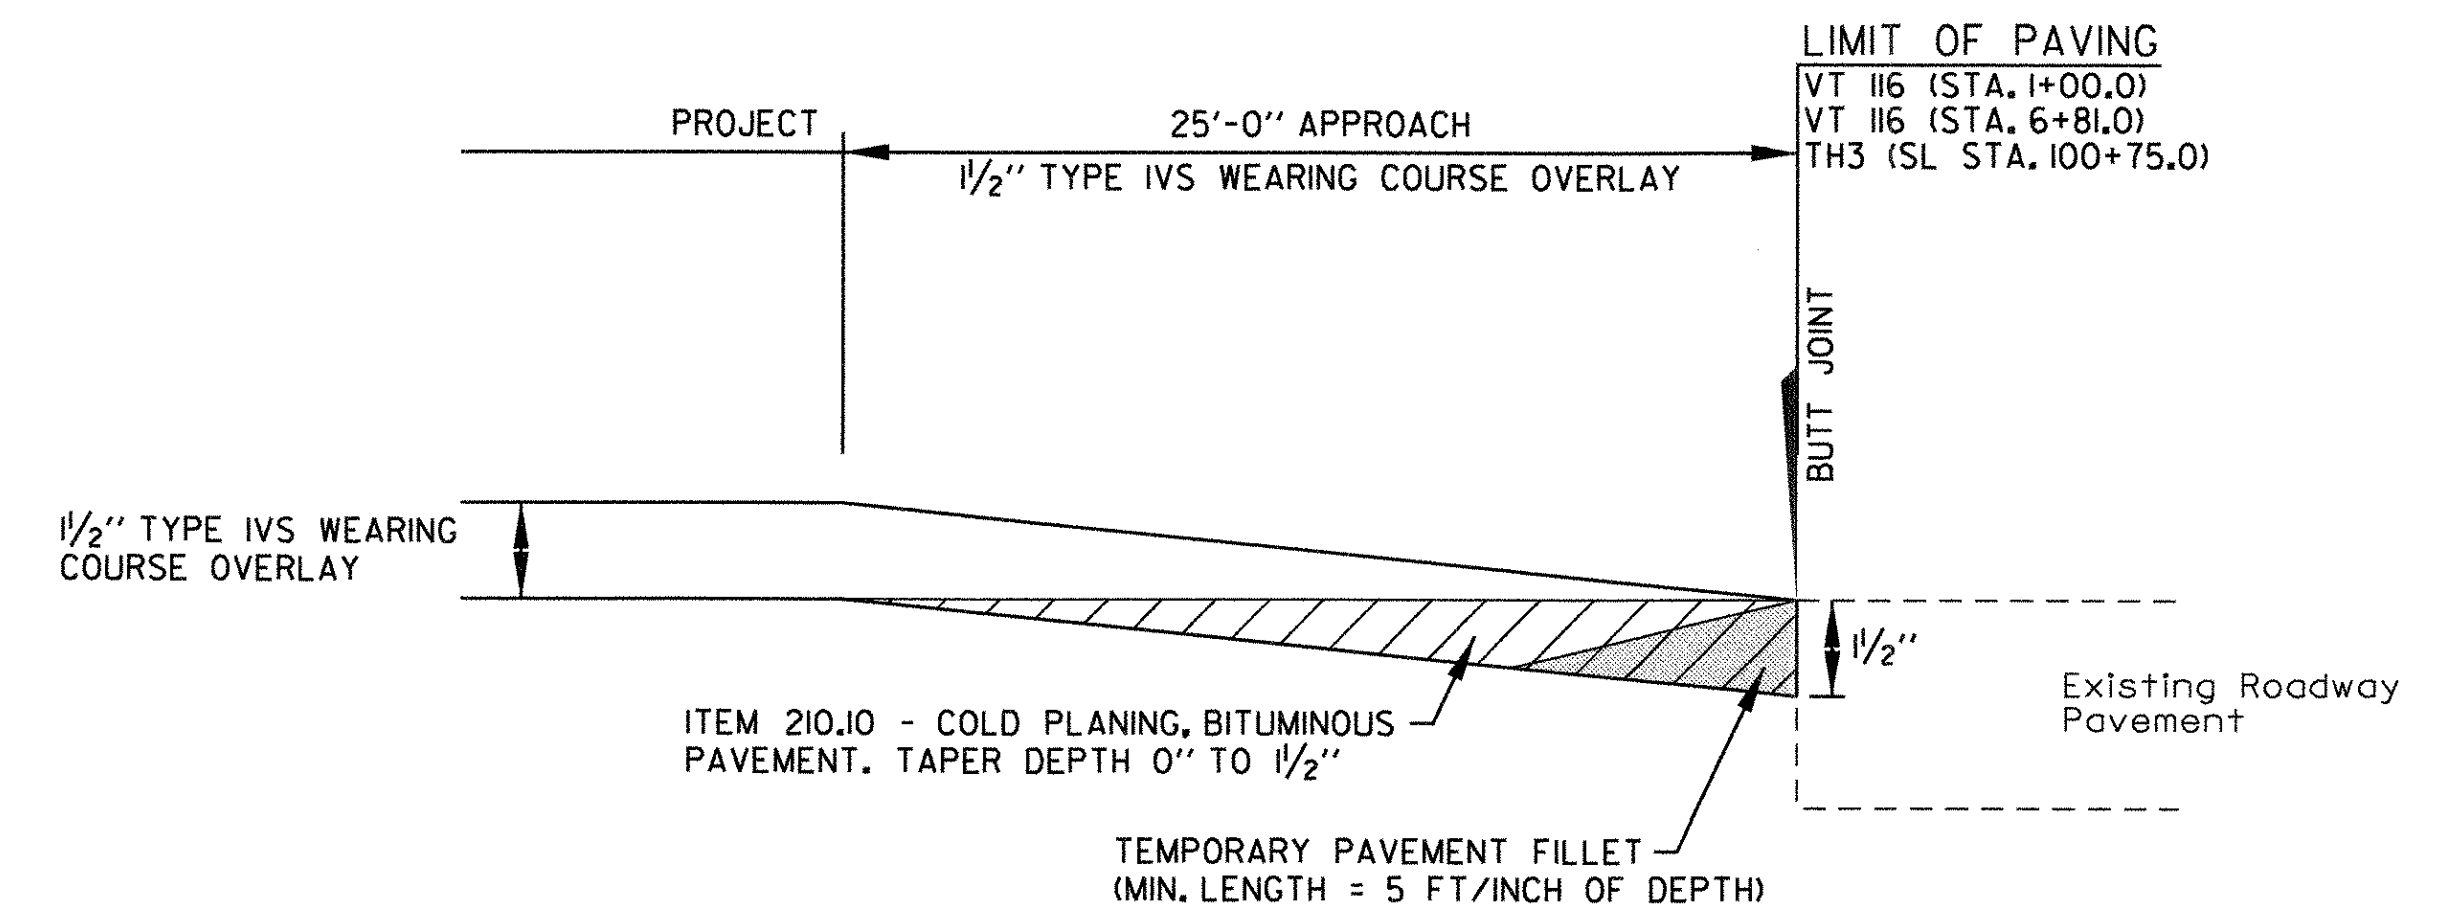

OVERLAY PAVEMENT MATCH TRANSITION DETAIL
NOT TO SCALE

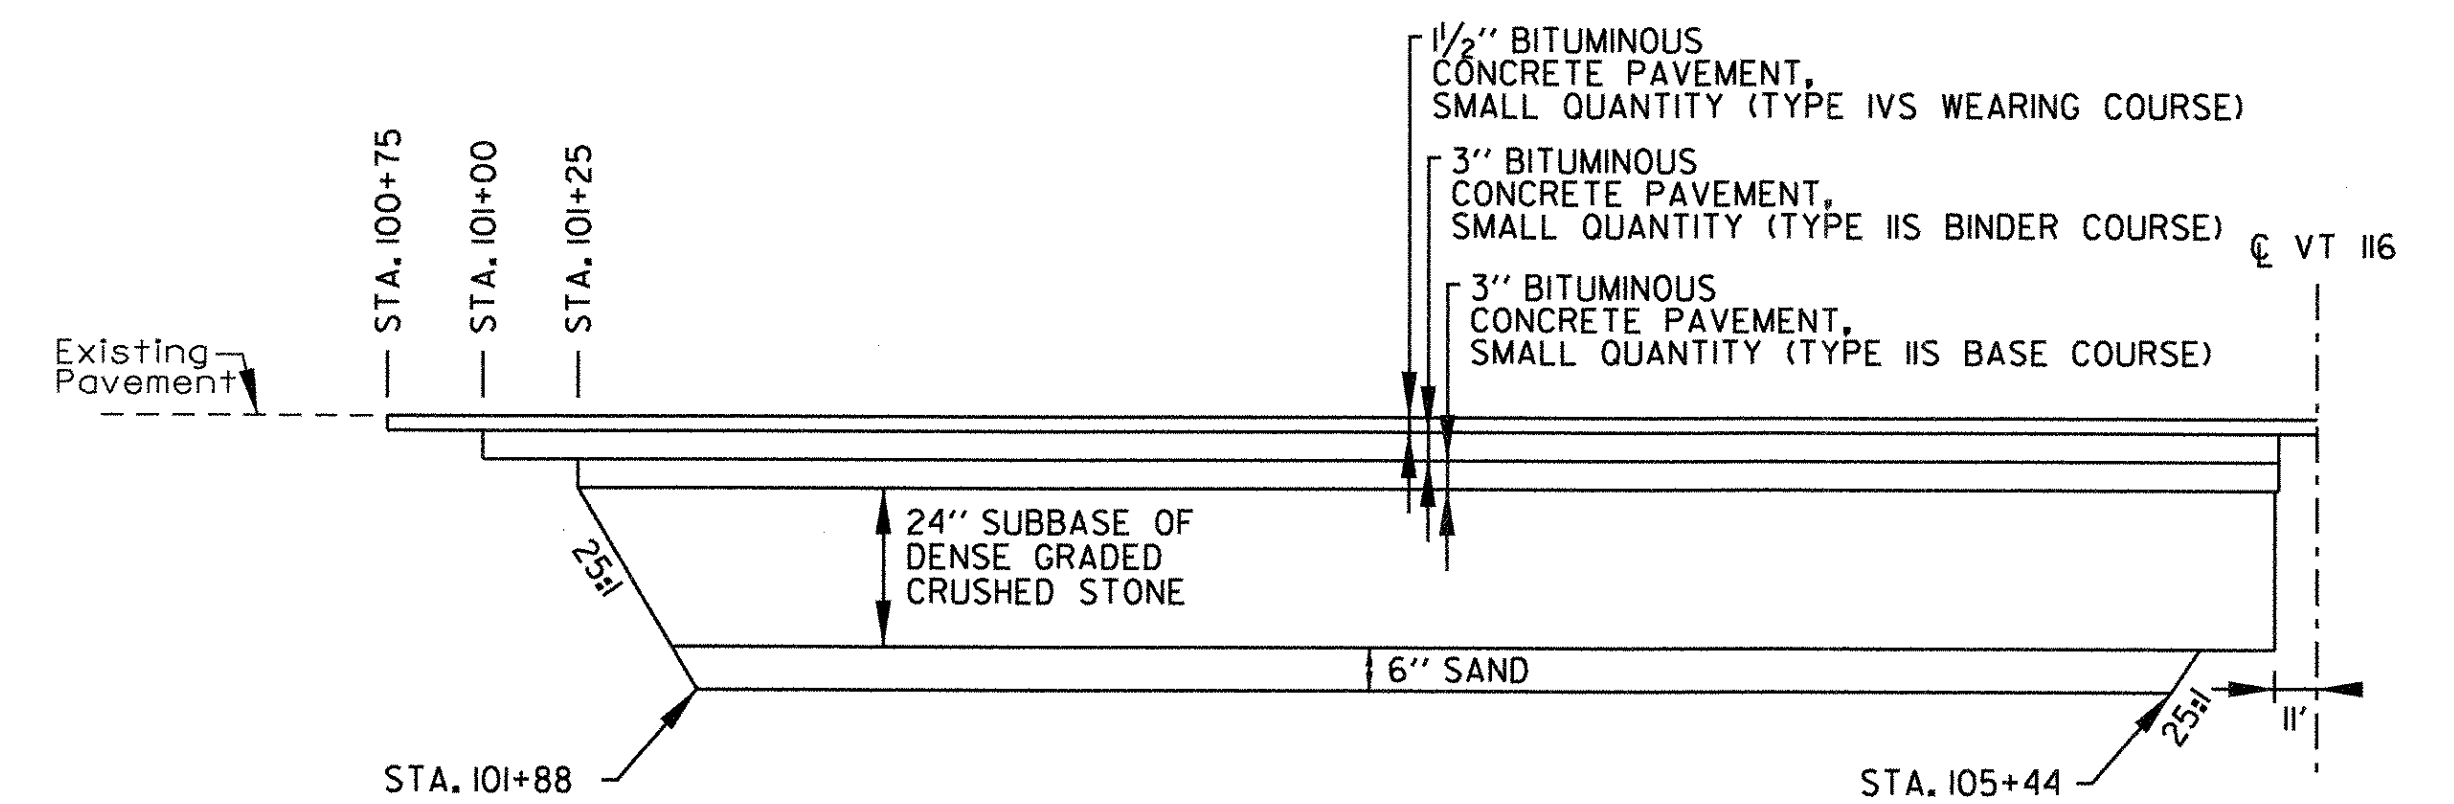

TH4 SILVER STREET PAVEMENT TRANSITION DETAIL
NOT TO SCALE

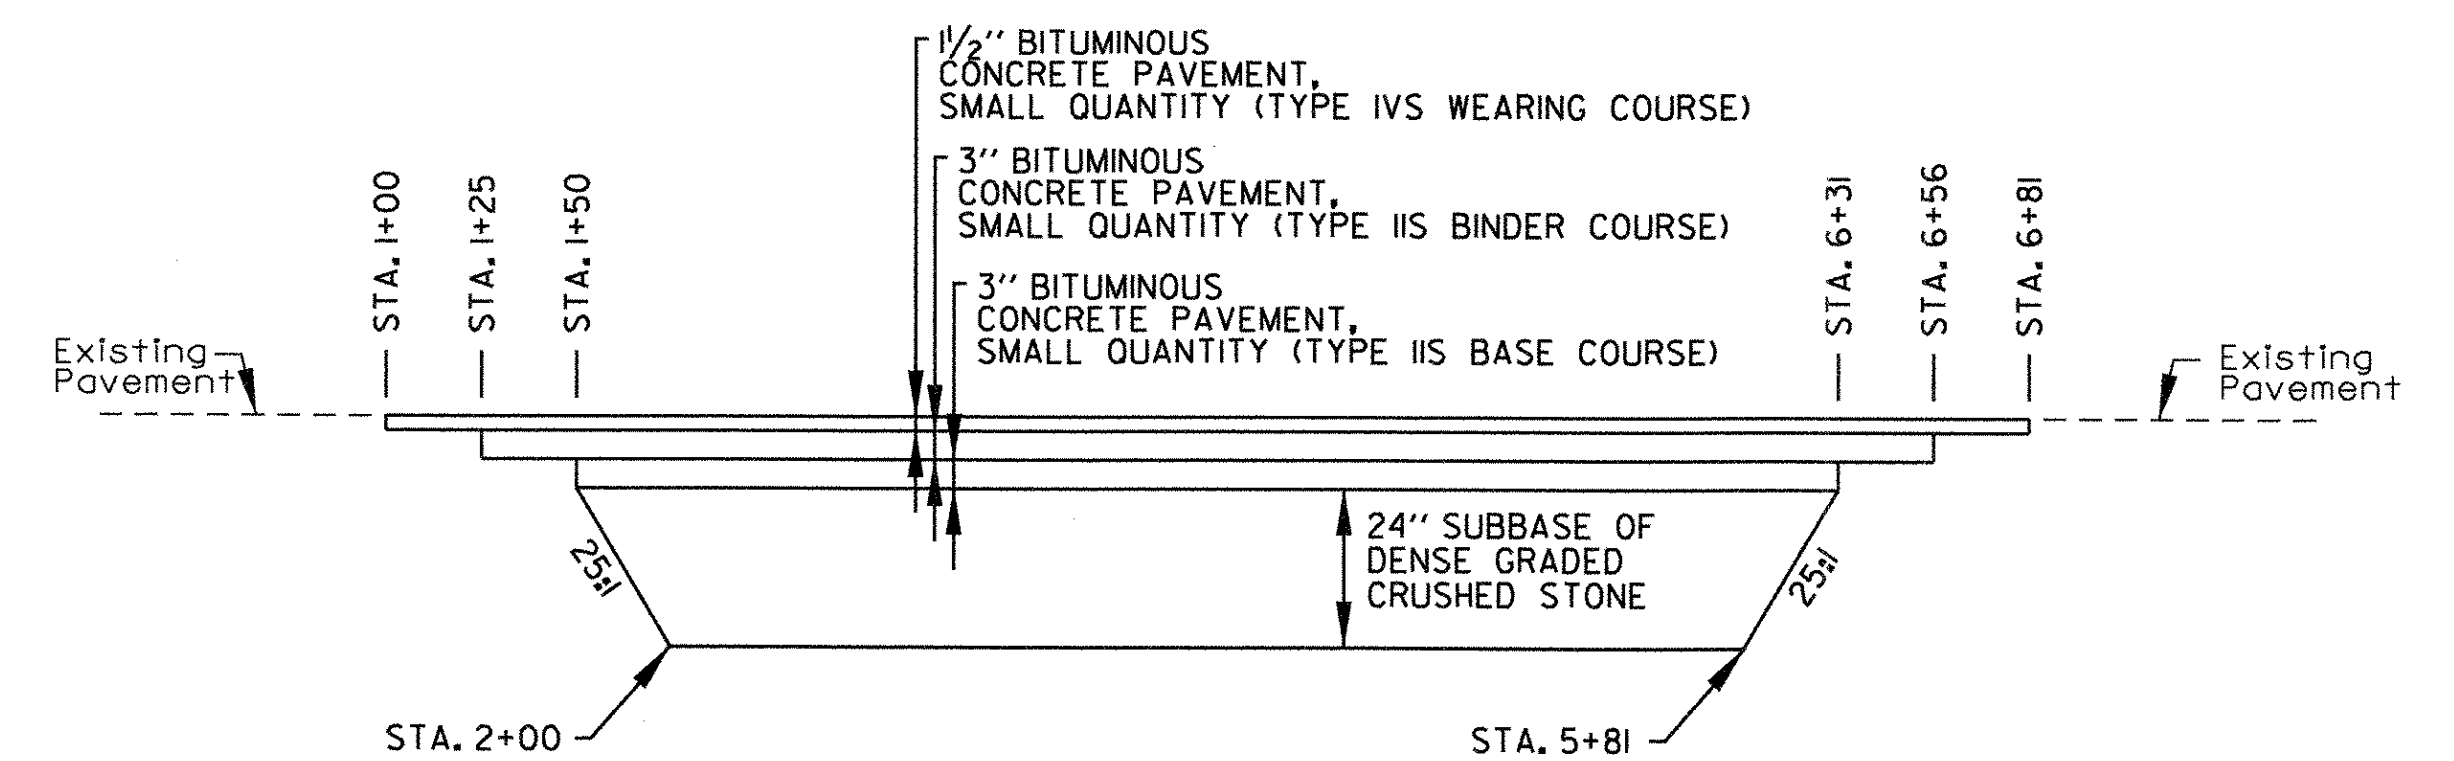

VT 116 PAVEMENT TRANSITION DETAIL
NOT TO SCALE

PRECAST CONCRETE DROP INLET AND MANHOLE NOTES:


1. PRECAST CONCRETE SECTIONS SHALL CONFORM TO THE STANDARD SPECIFICATIONS AND ASTM C-478.
2. MINIMUM CONCRETE COMPRESSIVE STRENGTH: 4,000 PSI AT 28-DAYS
3. STEEL REINFORCING SHALL CONFORM TO ASTM A185 OR A82 FOR HS25 LOADING.
4. MANHOLE STEPS SHALL BE 14" WIDE STEEL REINFORCED COPOLYMER POLYPROPYLENE PLASTIC CONFORMING TO ASTM C-478 AND SHALL BE CAST INTO MANHOLE SECTIONS BY THE PRECAST CONCRETE MANUFACTURER.
5. FACE OF PIPE SHALL NOT PROJECT MORE THAN 2" OR LESS THAN 1" FROM INSIDE WALL OF STRUCTURE.
6. ALL STRUCTURES WITH MULTIPLE PIPES SHALL HAVE A MINIMUM OF 12" OF OUTSIDE SURFACE BETWEEN HOLES, NO MORE THAN 75% OF A HORIZONTAL CROSS-SECTION SHALL BE HOLES, AND THERE SHALL BE NO HOLES CLOSER THAN 3" TO JOINTS.
7. FITTING FRAME TO FINAL GRADE MAY BE DONE WITH A SYNTHETIC RISER OR WITH PRECAST CONCRETE GRADE RINGS OF APPROPRIATE THICKNESS (3 COURSES MAX).
8. ALL PIPE INVERTS AND PENETRATION ANGLES SHALL BE FIELD VERIFIED PRIOR TO PRECASTING.
9. PRECAST SECTIONS SHALL HAVE A TONGUE AND GROOVE JOINT AND BE ASSEMBLED USING A BUTYL RUBBER OR APPROVED EQUAL SEALANT.
10. PROVIDE FLEXIBLE RUBBER SLEEVES CONFORMING TO ASTM C-923, RESILIENT, OF SIZE REQUIRED, FOR EACH PIPE CONNECTING TO STRUCTURE. SLEEVES SHALL BE CAST INTO PRECAST STRUCTURE BY THE MANUFACTURER FOR ALL PIPE PENETRATIONS.
11. DROP INLET GRATE ORIENTATION SHALL BE IN ACCORDANCE WITH STANDARD DRAWING D-15 FOR TYPE D GRATES.
12. INSTALLATION OF DROP INLETS OVER EXISTING PIPES SHALL INCLUDE CLEAN CUTTING OF EXISTING PIPES, PROVIDING AN EXTENSION PIPE OF SIMILAR MATERIAL AND SIZE AS THE EXISTING PIPE, COUPLINGS REQUIRED FOR THE CONNECTION BETWEEN THE EXTENSION PIPE AND THE EXISTING PIPE, AND INSTALLING FLEXIBLE RUBBER SLEEVES AS SHOWN IN DETAILS PROVIDED ON THIS SHEET.
13. PAYMENT FOR INSTALLATION OF THE DROP INLETS SHALL BE MADE UNDER PRECAST REINFORCED CONC. DROP INLET WITH CAST IRON GRATE (ITEM 604.18).

PROJECT NAME: HINESBURG
PROJECT NUMBER: HES 021-1(20)


FILE NAME: z04b206det.dgn
PROJECT LEADER: G. BAKOS
DESIGNED BY: D. PECK
DETAILS SHEET

PLOT DATE: 2/18/2009
DRAWN BY: D. PECK
CHECKED BY: G. BAKOS
SHEET 4 OF 25



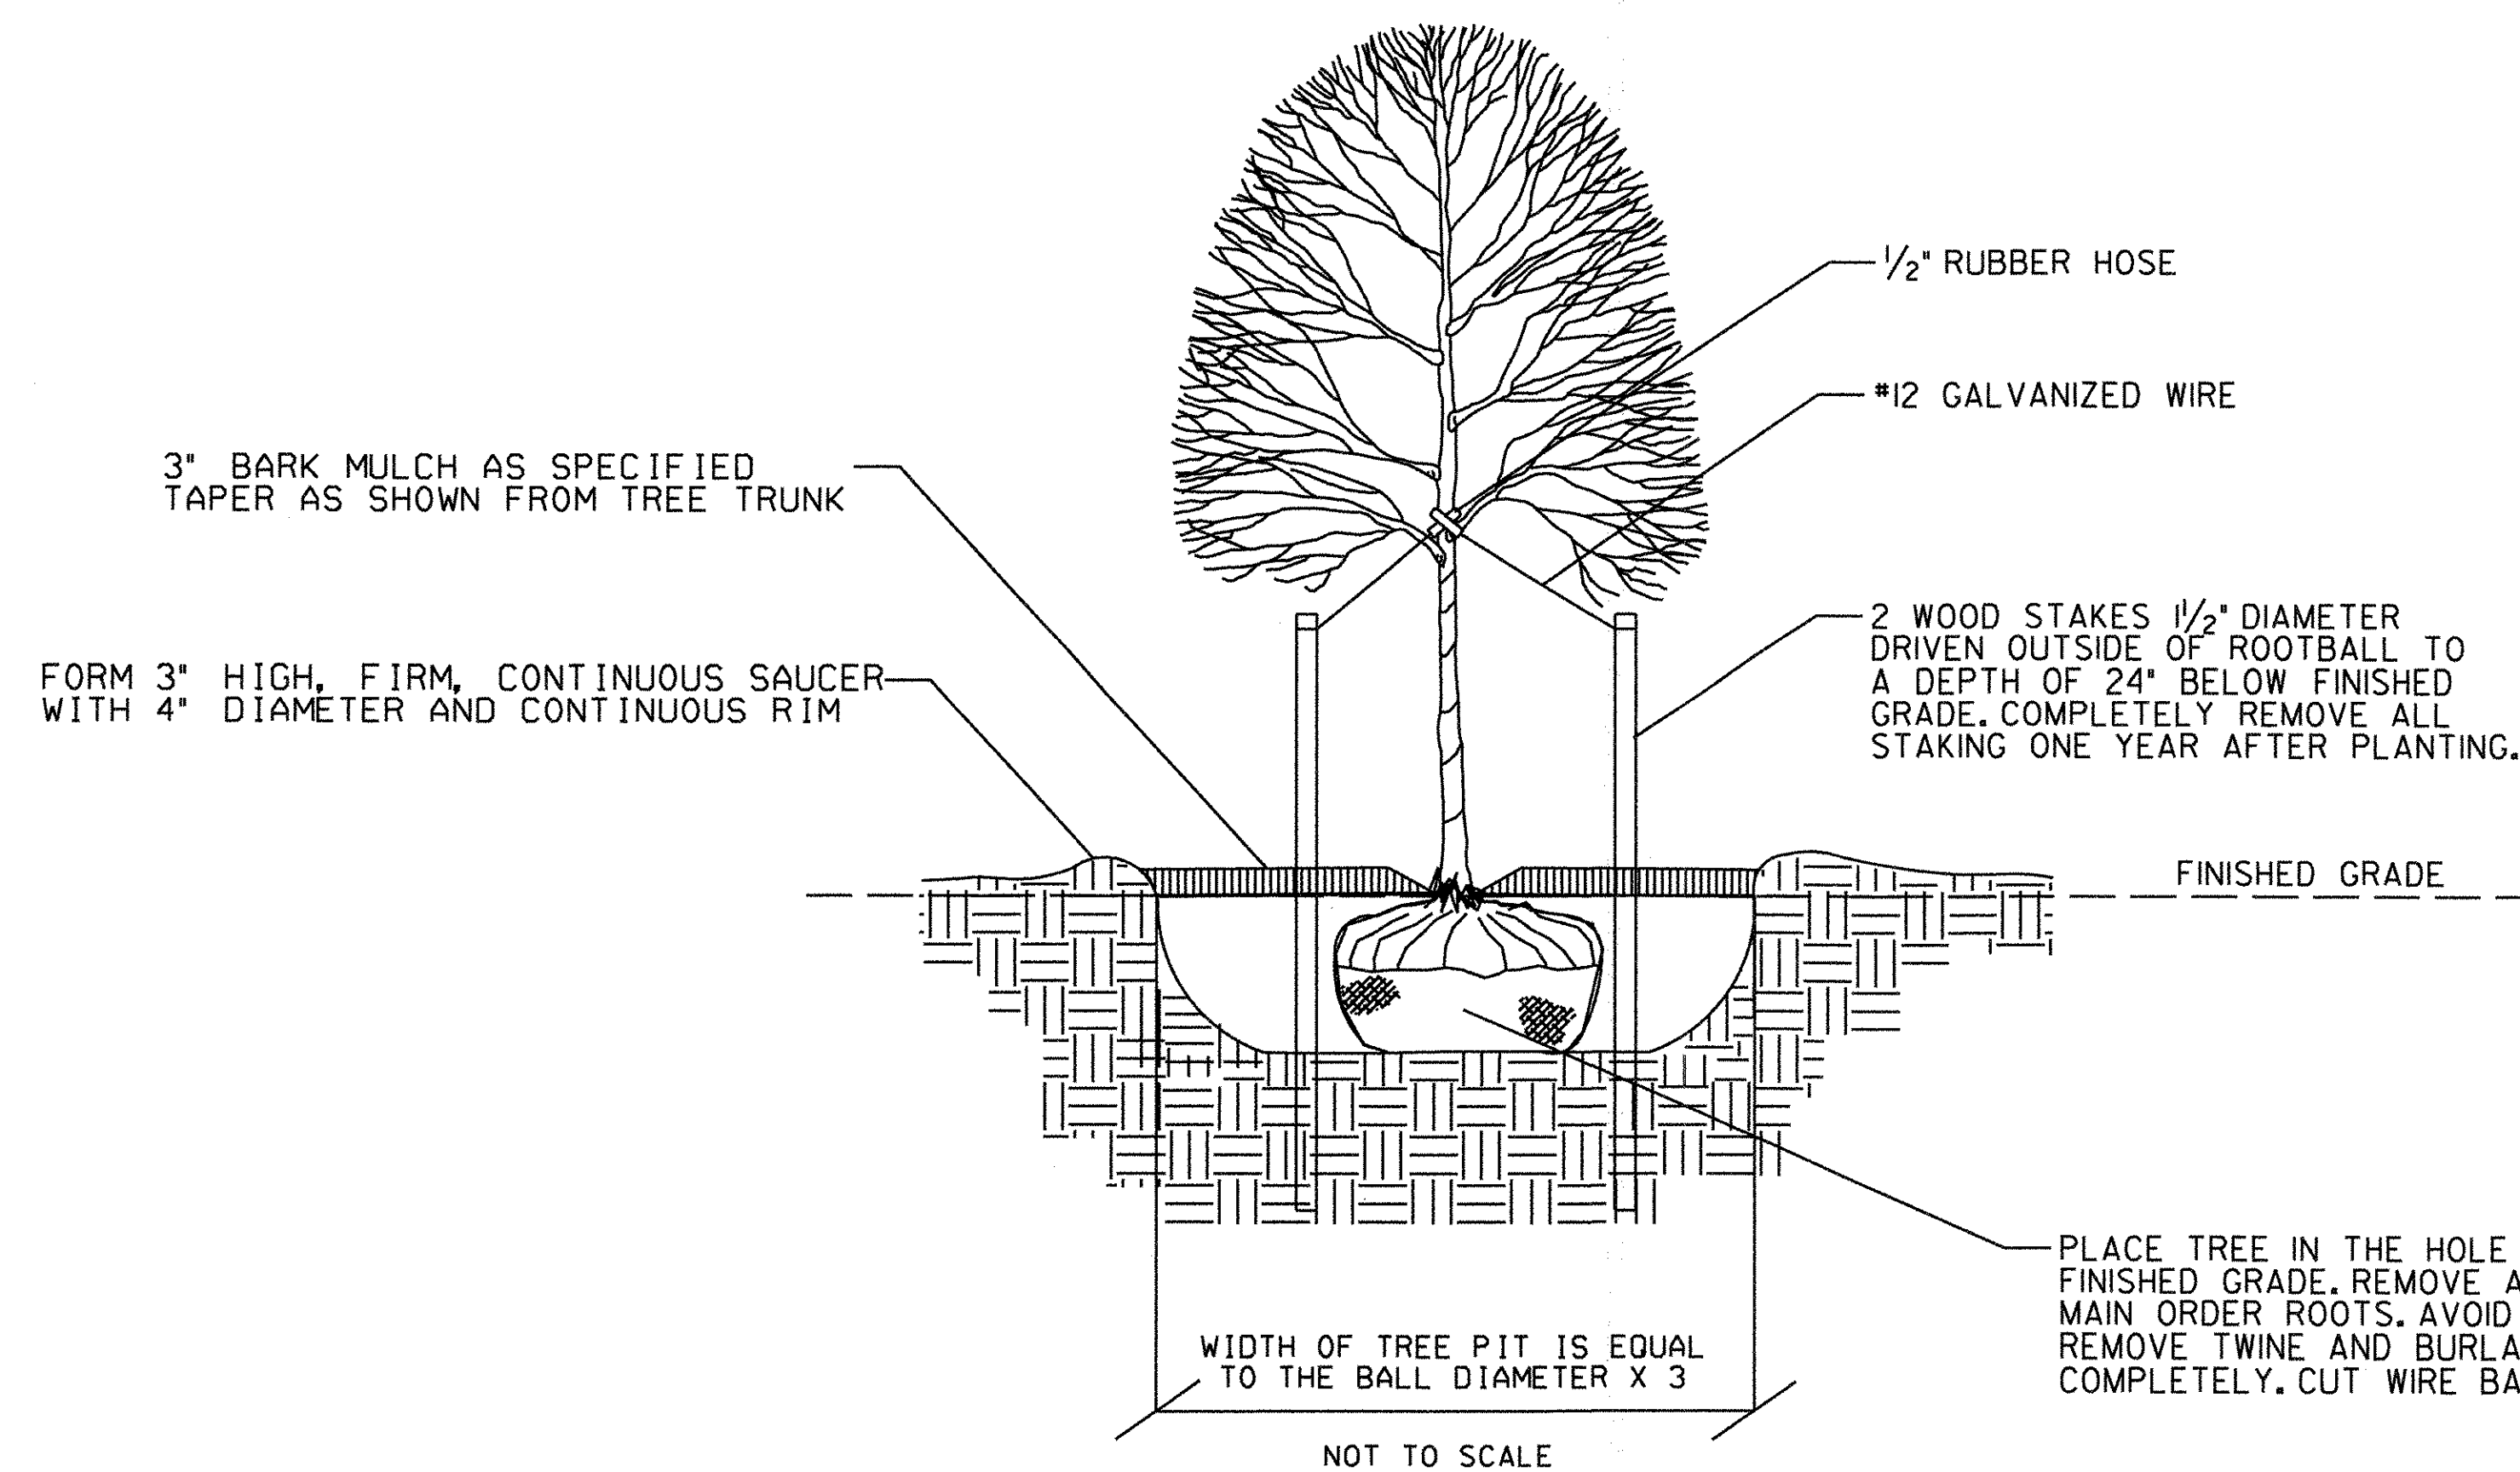

DECIDUOUS TREE PLANTING DETAIL

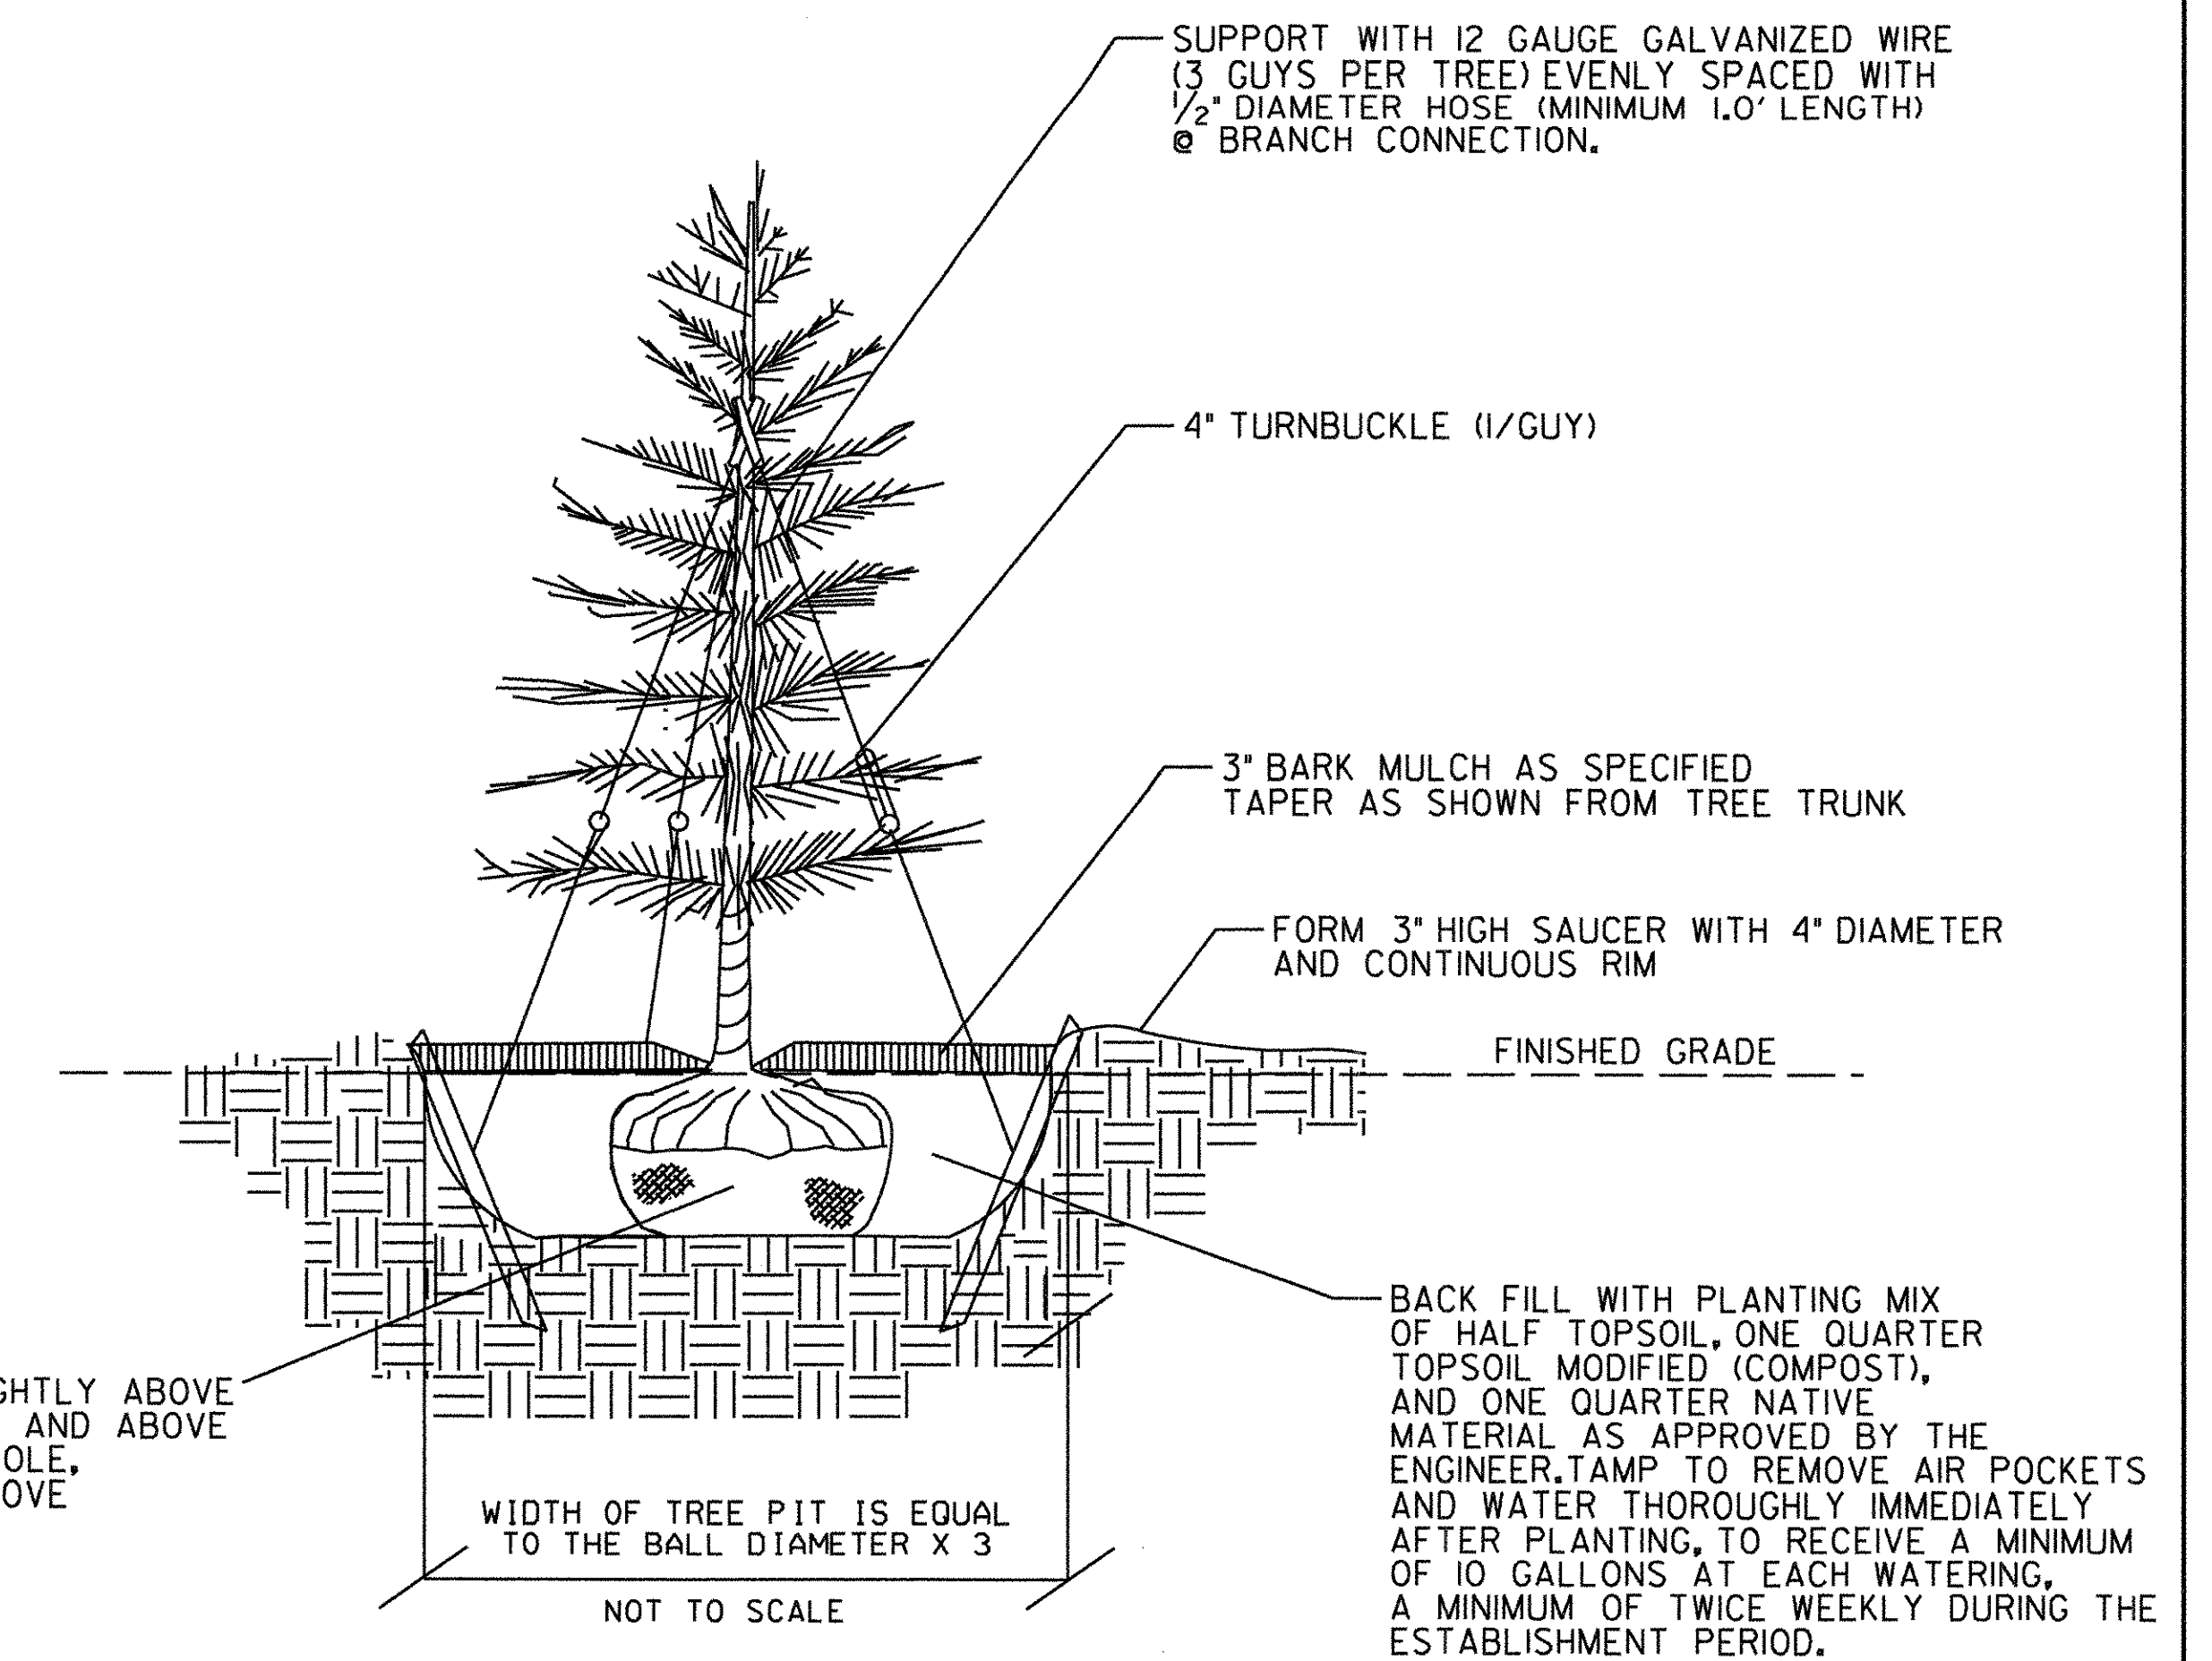

EVERGREEN TREE PLANTING DETAIL

NOTES:

1. ANTI-DESICCANT SPRAY IS TO BE APPLIED TO ALL EVERGREENS PER MANUFACTURER SPECIFICATIONS.
2. COMPLETELY REMOVE ALL GUY-WIRES AND TURNBUCKEL ONE YEAR AFTER PLANTING.

GENERAL NOTES:

1. SECTION 656 'PLANTING TREES, SHRUBS AND VINES' SHALL BE FOLLOWED.
2. CLEAN CUT ALL ROOTS. TRANSPLANT TREES WITH TREE SPADE OF SUITABLE SIZE TO THE EXISTING TREES. IF PLANT MATERIAL IS DAMAGED AND NOT IN VIABLE CONDITION IT SHALL BE REPLACED BY THE CONTRACTOR AS DIRECTED BY THE RESIDENT ENGINEER.
3. THE NEW PLANTING HOLES SHALL BE PREPARED AND PRE-DUG SO THE TREES AND SHRUBS CAN BE TRANSPLANTED THE SAME DAY OR WITH 24 HOURS AT THE MOST.
4. IF NATIVE SOILS ARE DETERMINED TO BE UNSUITABLE THE CONTRACTOR SHALL REPLACE WITH APPROVED 3/4 TOPSOIL AND 1/4 COMPOST MIX.

PROJECT NAME: HINESBURG
PROJECT NUMBER: HES 021-1(20)


FILE NAME: z04b2061s det.dgn PLOT DATE: 2/18/2009
PROJECT LEADER: G. BAKOS DRAWN BY: D. PECK
DESIGNED BY: D. PECK CHECKED BY: G. BAKOS
LANDSCAPING DETAILS SHEET 5 OF 25

3" BARK MULCH
AS SPECIFIED
TAPER AT BASE
AS SHOWN.

FORM SAUCER WITH
4" DIAMETER AND
CONTINUOUS RIM.

EXISTING GRADE

BACK-FILL WITH PLANTING
MIX OF 1/2 TOPSOIL,
1/4 NATIVE MATERIAL,
AND 1/4 COMPOST
AS APPROVED BY THE
ENGINEER. TAMP TO
REMOVE AIR POCKETS
AND WATER THOROUGHLY
AT TIME OF
PLANTING.

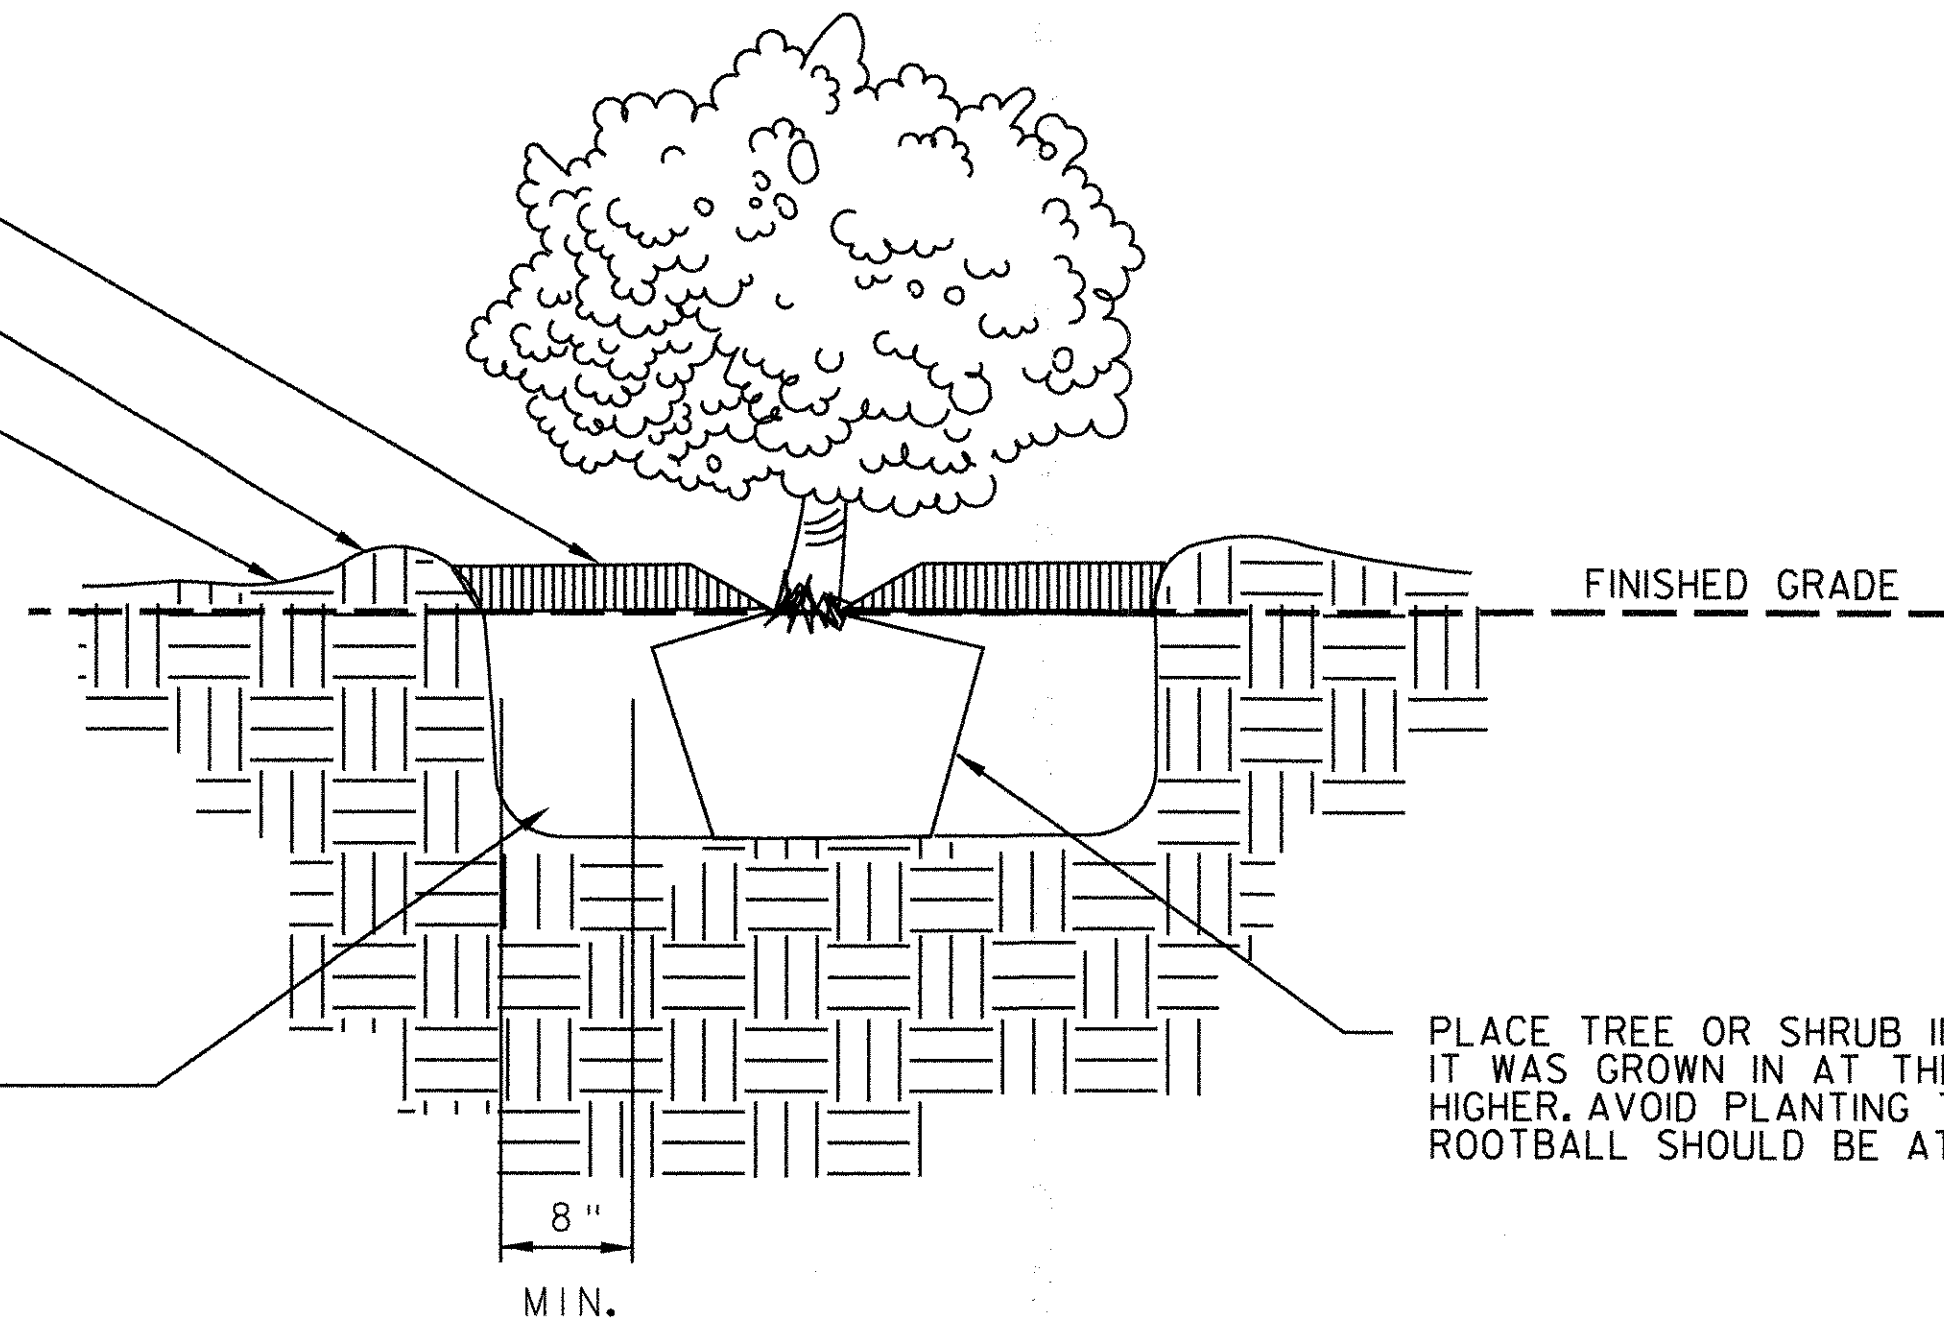


PLACE TREE OR SHRUB IN THE HOLE AT THE LEVEL
IT WAS GROWN IN AT THE NURSERY, OR SLIGHTLY
HIGHER. AVOID PLANTING TOO DEEP. TOP OF
ROOTBALL SHOULD BE AT FINISHED GRADE.

SHRUB PLANTING DETAIL
NOT TO SCALE

MAINTAIN MIN. 4" DIA.
AND CONTINUOUS RIM
ON LOWER SIDES OF
PLANTING TO RETAIN
WATER.

BACK-FILL WITH PLANTING
MIX OF 1/2 TOPSOIL,
1/4 NATIVE MATERIAL,
AND 1/4 COMPOST
AS APPROVED BY THE
ENGINEER. TAMP TO
REMOVE AIR POCKETS
AND WATER THOROUGHLY
AT TIME OF
PLANTING.

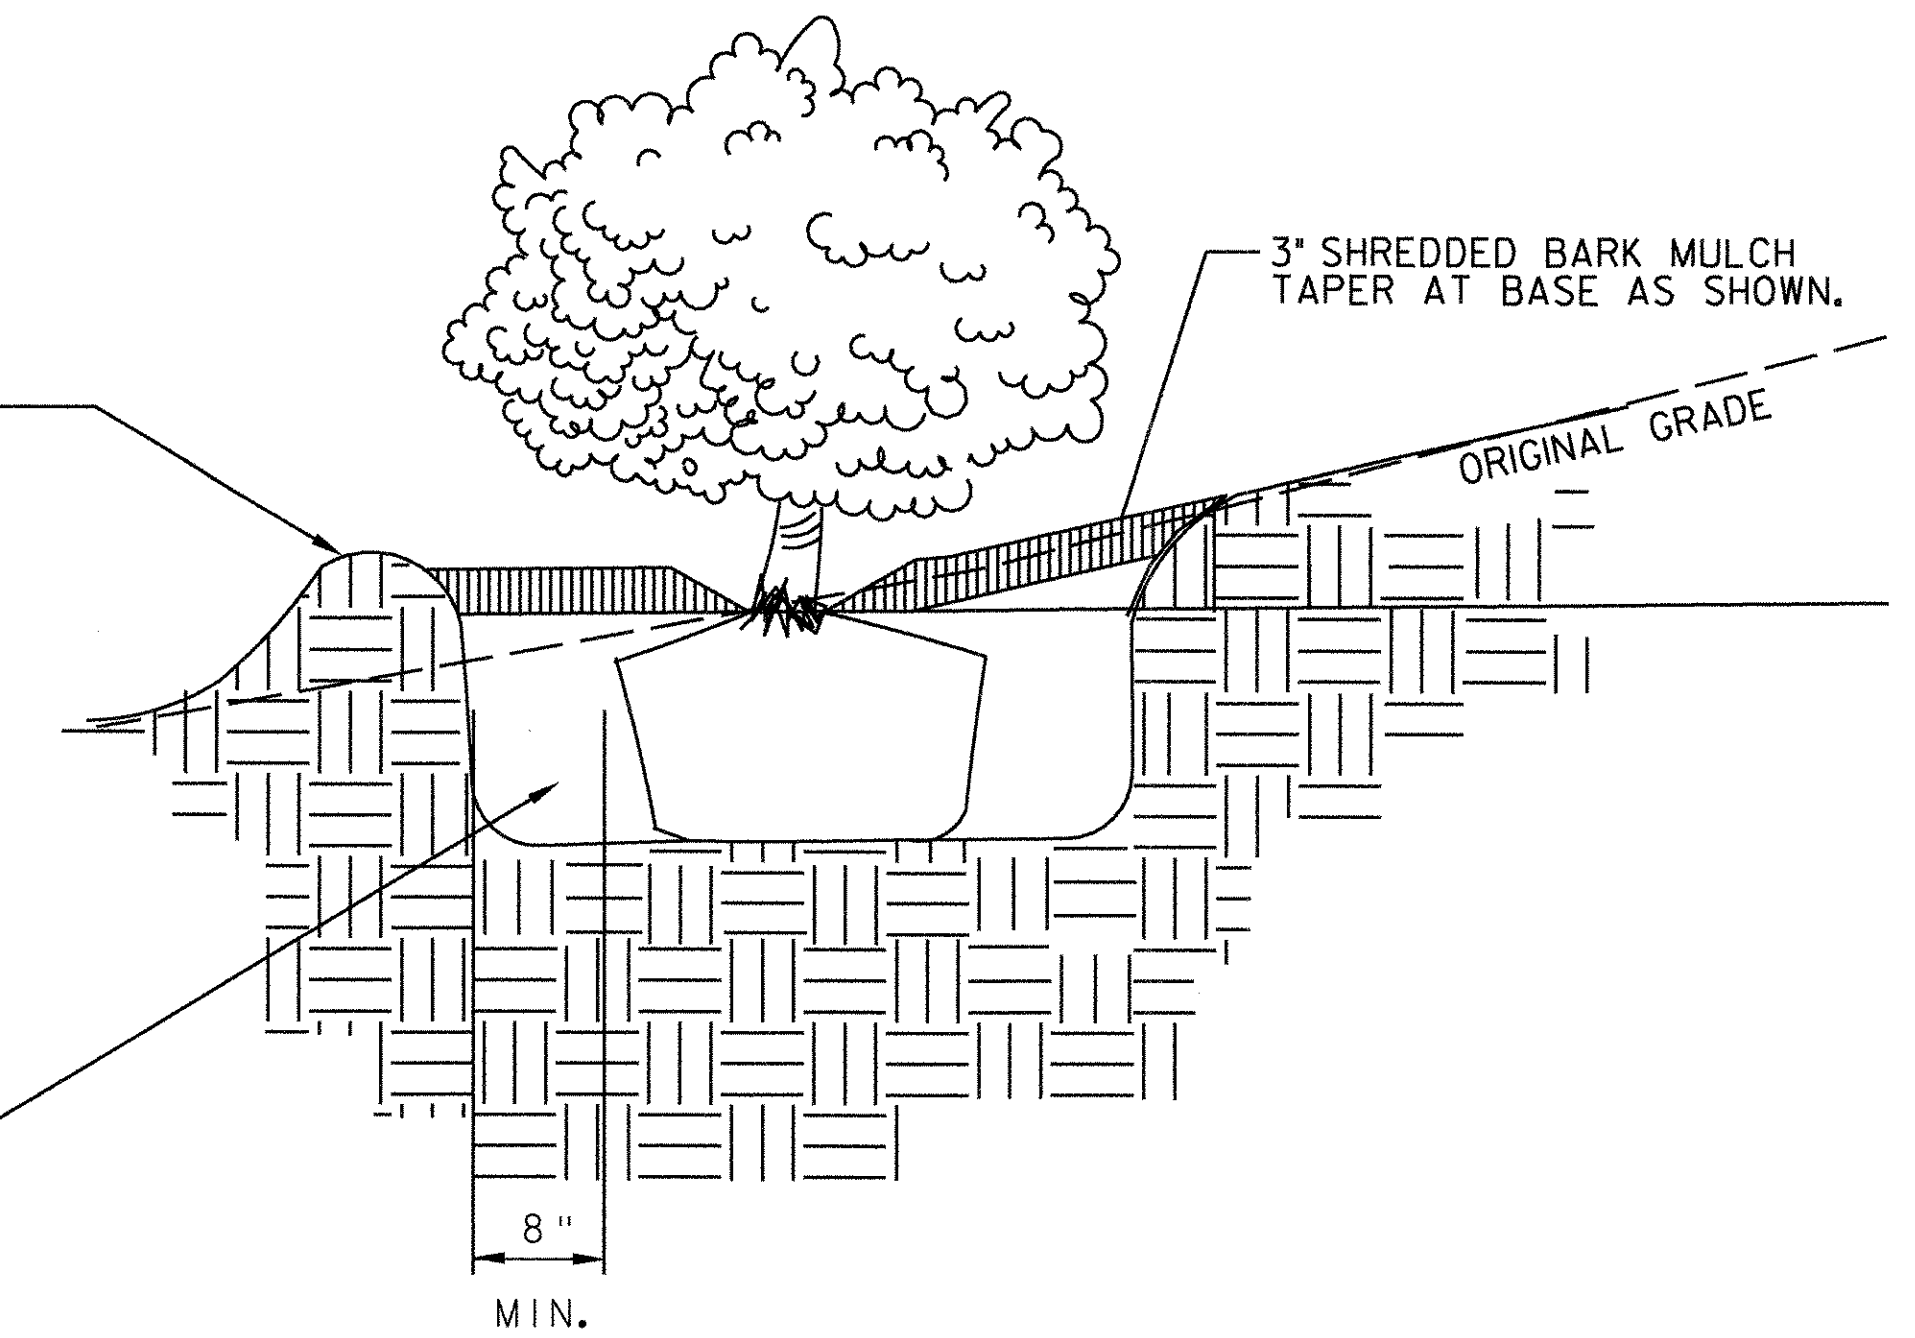

SHRUB PLANTING ON SLOPES DETAIL
NOT TO SCALE

GENERAL NOTES:

1. SECTION 656 "PLANTING TREES, SHRUBS AND VINES" SHALL BE FOLLOWED.
2. CLEAN CUT ALL ROOTS. TRANSPLANT TREES WITH TREE SPADE OF SUITABLE SIZE TO THE EXISTING TREES. IF PLANT MATERIAL IS DAMAGED AND NOT IN VIABLE CONDITION IT SHALL BE REPLACED BY THE CONTRACTOR AS DIRECTED BY THE RESIDENT ENGINEER.
3. THE NEW PLANTING HOLES SHALL BE PREPARED AND PRE-DUG SO THE TREES AND SHRUBS CAN BE TRANSPLANTED THE SAME DAY OR WITH 24 HOURS AT THE MOST.
4. IF NATIVE SOILS ARE DETERMINED TO BE UNSUITABLE THE CONTRACTOR SHALL REPLACE WITH APPROVED 3/4 TOPSOIL AND 1/4 COMPOST MIX.

PROJECT NAME: HINESBURG
PROJECT NUMBER: HES 021-K(20)

FILE NAME: z04b2061s det.dgn
PROJECT LEADER: G. BAKOS
DESIGNED BY: D. PECK
LANDSCAPING DETAILS

PLOT DATE: 2/18/2009
DRAWN BY: D. PECK
CHECKED BY: G. BAKOS
SHEET 6 OF 25

QUANTITY SHEET #2

SUMMARY OF ESTIMATED QUANTITIES

DETAILED SUMMARY OF QUANTITIES

SUMMARY OF ESTIMATED QUANTITIES														DETAILED SUMMARY OF QUANTITIES			
															QUANTITIES	UNIT	ITEMS
						FULL C.E. ITEMS	EROSION CONTROL	ROADWAY	GRAND TOTAL	UNIT	DESCRIPTION	ITEM NUMBER	ROUNDING				
								320	320	EACH	LINE STRIPING TARGETS	646.76	2				
							95		95	SY	GEOTEXTILE UNDER STONE FILL	649.31	2				
							850		850	SY	GEOTEXTILE FOR SILT FENCE	649.51	7				
							27		27	LB	SEED	651.15	0.7				
							165		165	LB	FERTILIZER	651.18	0.6				
							1		1	TON	AGRICULTURAL LIMESTONE	651.20	0.3				
							1		1	TON	HAY MULCH	651.25	0.3				
								180	180	CY	TOPSOIL	651.35	3.2				
							300		300	SY	TEMPORARY EROSION MATTING	653.20	6.7				
							15		15	CY	TEMPORARY STONE CHECK DAM, TYPE I	653.25	-				
							5		5	EACH	INLET PROTECTION DEVICE, TYPE I	653.40	-				
							760		760	FT	PROJECT DEMARCATION FENCE	653.55	1				
								6	6	EACH	TRANSPLANTING TREES	656.45	-				
								14	14	EACH	TRANSPLANTING SHRUBS	656.50	-				
								32	32	SF	TRAFFIC SIGNS, TYPE A	675.20	-				
								105	105	FT	SQUARE TUBE SIGN POSTS AND ANCHOR	675.341	-				
								12	12	EACH	REMOVING SIGNS	675.50	-				
								1	1	EACH	ERECTING SALVAGED SIGNS	675.60	-				
								1	1	LU	PRICE ADJUSTMENT, FUEL (N.A.B.I.)	690.50	-				
								1	1	EACH	SPECIAL PROVISION (RELOCATE FLASHING BEACON, GROUND MOUNTED)	900.620	-				
								1	1	EACH	SPECIAL PROVISION (RELOCATE SIGN, COMMERCIAL/LIGHTED)	900.620	-				
								1	1	LS	SPECIAL PROVISION (FIELD OFFICE, ENGINEERS)	900.645	-				
								1	1	LU	SPECIAL PROVISION (MAT DENSITY PAY ADJUSTMENT, SMALL QUANTITY) (N.A.B.I.)	900.650	-				
								1	1	LU	SPECIAL PROVISION (MIXTURE PAY ADJUSTMENT) (N.A.B.I.)	900.650	-				
								930	930	SY	SPECIAL PROVISION (HAND-PLACED BITUMINOUS CONCRETE MATERIAL, DRIVES)	900.675	4.0				
						LIN		1550	1550	TON	SPECIAL PROVISION (BITUMINOUS CONCRETE PAVEMENT, SMALL QUANTITY)	900.680	21.9				
						9000		I	I	EA	SUPPLEMENTAL AGREEMENT SA/CO 01 DTD 07-22-09 (604J8 PRCDI WITH CAST IRON GRATE (MOD.)) \$967.00	900.520					
						9005		I	I	LS	SUPPLEMENTAL AGREEMENT SA/CO 02 DTD 05-19-10 (EXTRA WORK, SEWER & WATERLINE CONFLICTS) \$3089.00	900.545					
						9010		I	I	LS	MOB/DEMOB SA/CO 03 DTD 06-29-10 (MILLER PROPERTY DRAINAGE WORK) COD/SA DTD 5-18-10 \$1000.00	635.11					
						9015			TON		SA/CO 03 DTD 06-29-10 (WASHED STONE 1/2") COD/SA DTD 6-21-10 \$14.60/TON	900.58					
						9020		I	I	LS	SA/CO 03 DTD 6-29-10 (CONCRETE DRY WELL (600 GAL) WITH RISER & LAWN GRALE) COD/SA DTD 6-21-10 \$1330.00	900.545					






PROJECT NAME: **HINESBURG**
 PROJECT NUMBER: **HES 021-1(20)**
 FILE NAME: 04B206_Quantity_Summary.xls
 PROJECT MANAGER: G. BAKOS
 DESIGNED BY: D. PECK
 QUANTITY SHEET #2
 PLOT DATE: 2/18/2009
 DRAWN BY: D. PECK
 CHECKED BY:
 SHEET: 8 OF 25










EARTHWORKS

																				SUMMARY AND BALANCES																				
		TOTAL EXCAVATION EARTH AND ROCK		ROCK EXCAVATION		EMBANKMENT						TOTAL EXCAVATION EARTH AND ROCK		ROCK EXCAVATION		EMBANKMENT						TOTAL EXCAVATION EARTH AND ROCK		ROCK EXCAVATION		EMBANKMENT						STATION TO STATION		TOT EXC. EARTH & ROCK C.Y.	ROCK EXCAV C.Y.	EMBANK C.Y.	EXCESSES		ACUMULATIVE EXCESSES	
STATION	DIST	AREA	VOLUME	AREA	VOLUME	AREA	VOLUME	AREA	VOLUME	STATION	DIST	AREA	VOLUME	AREA	VOLUME	AREA	VOLUME	AREA	VOLUME	STATION	DIST	AREA	VOLUME	AREA	VOLUME	AREA	VOLUME	AREA	VOLUME	STATION TO STATION	TOT EXC. EARTH & ROCK C.Y.	ROCK EXCAV C.Y.	EMBANK C.Y.	CUT	FILL	CUT	FILL			
FT.		S.F.	C.Y.	S.F.	C.Y.	S.F.	C.Y.	S.F.	C.Y.	FT.		S.F.	C.Y.	S.F.	C.Y.	S.F.	C.Y.	S.F.	C.Y.	FT.		S.F.	C.Y.	S.F.	C.Y.	S.F.	C.Y.	S.F.	C.Y.											
VT 116																																								
1+00		0.0				0.0																																		
	50		20.1																																					
1+50		21.7				0.0																																		
	50		57.8				3.4																																	
2+00		40.7				3.6																																		
	50		80.6				3.8																																	
2+50		46.4				0.5																																		
	50		81.2				11.3																																	
3+00		41.3				11.6																																		
	35		54.4				12.3																																	
3+35		42.6				7.4																																		
	15		28.2				2.0																																	
3+50		59.1				0.0																																		
	7		14.7				0.1																																	
3+57		54.3				1.0																																		
	43		81.5				12.5																																	
4+00		48.1				14.7																																		
	50		97.4				13.6																																	
4+50		57.1				0.0																																		
	21		51.2																																					
4+71		74.6				0.0																																		
	29		69.3				2.7																																	
5+00		54.4				5.0																																		
	50		97.2				7.8																																	
5+50		50.6				3.3																																		
	50		68.3				7.2																																	
6+00		23.1				4.5																																		
	50		35.1				4.1																																	
6+50		14.7				0.0																																		
	31		8.5																																					
6+81		0.0				0.0																																		
VT 116 SUBTOTAL			845.5				80.8																																	
TH 4 SILVER STREET																																								
100+75		0.0				0.0																																		
	25		3.7																																					
101+00		8.0				0.0																																		
	50		50.4																																					
101+50		46.5				0.0																																		
	25		60.6																																					
101+75		84.5				0.0																																		
	25		72.7																																					
102+00		72.6				0.0																																		
	50		140.2				5.4																																	
102+50		78.8				5.8																																		
	20		57.0				4.9																																	
102+70		75.1				7.3																																		
	30		76.9				9.1																																	
103+00		63.3				9.0																																		
	50		102.8				14.8																																	
103+50		47.7				7.0																																		
	50		76.4				14.1																																	
104+00		34.8				8.2																																		

VT ROUTE 116

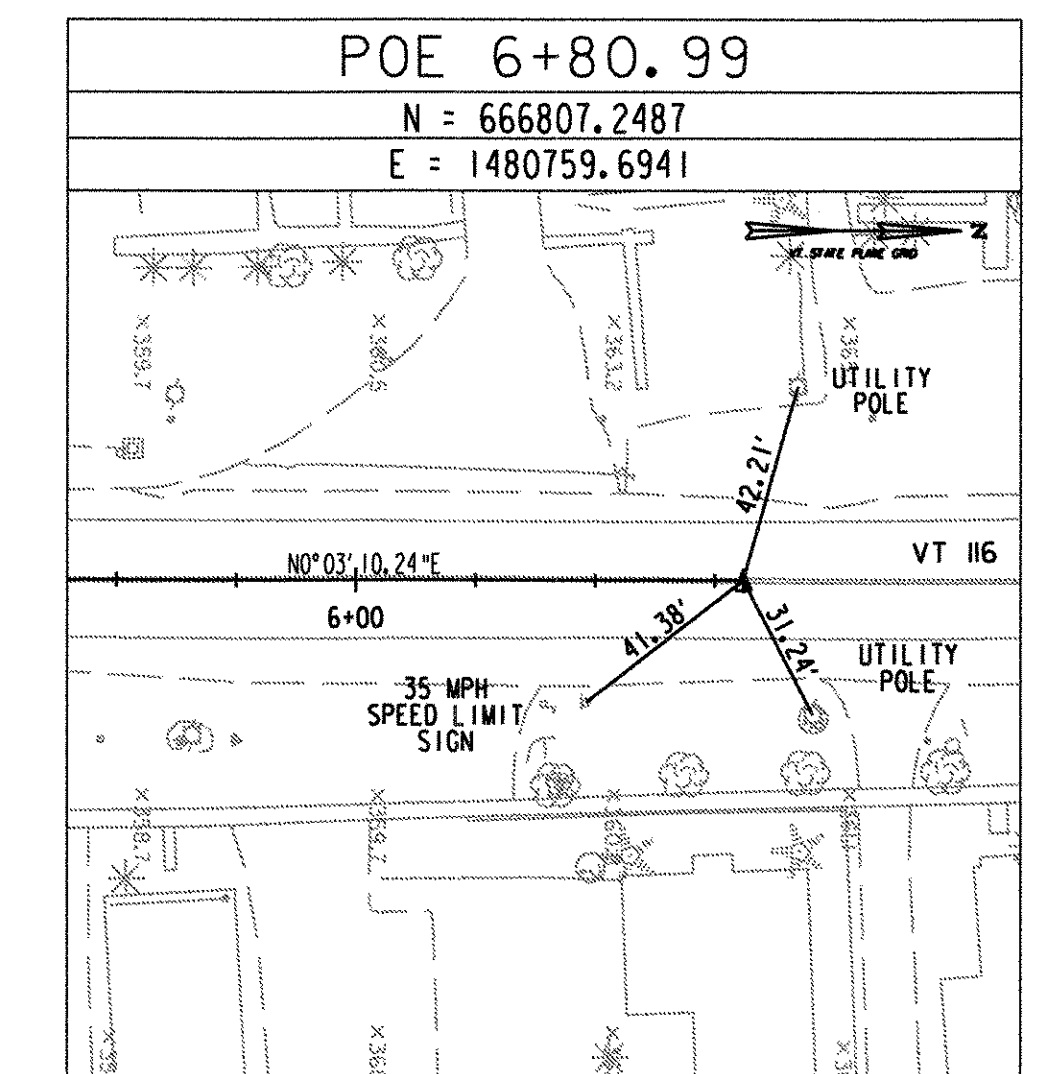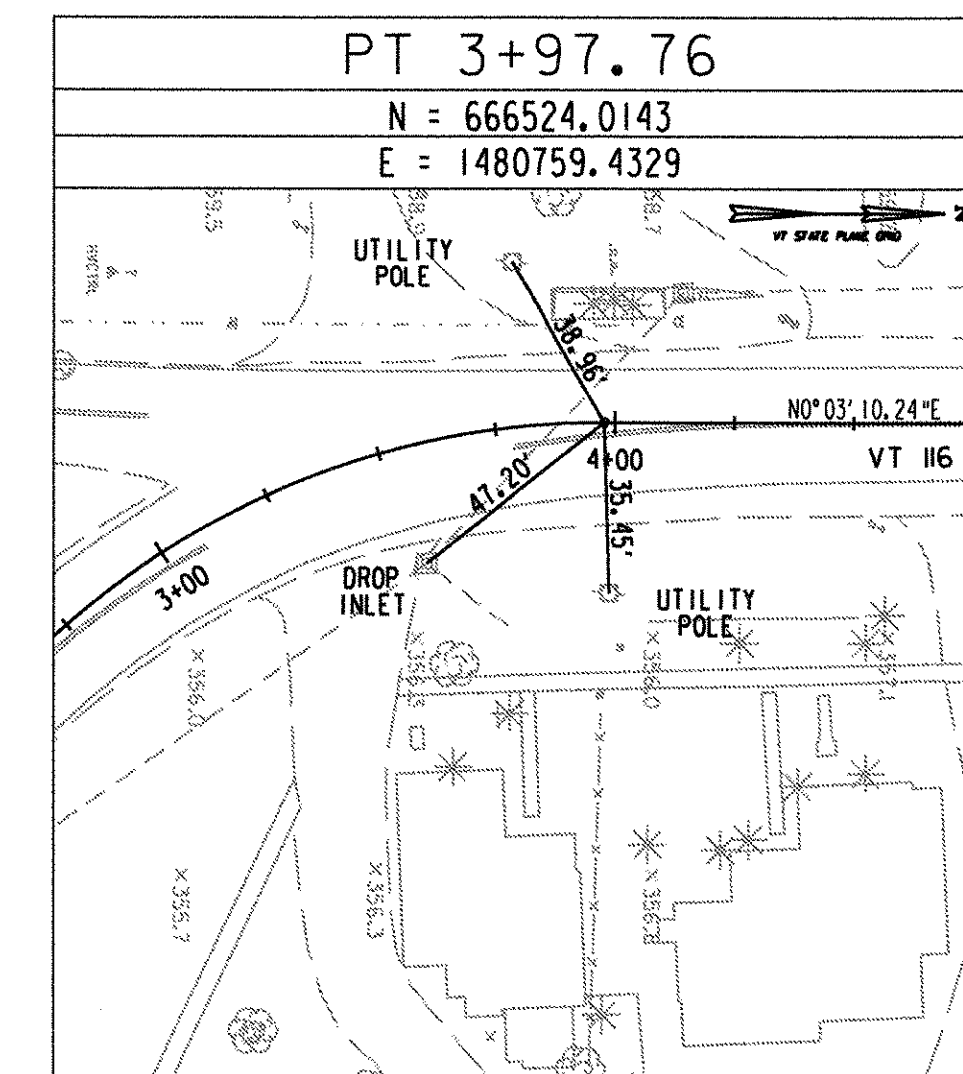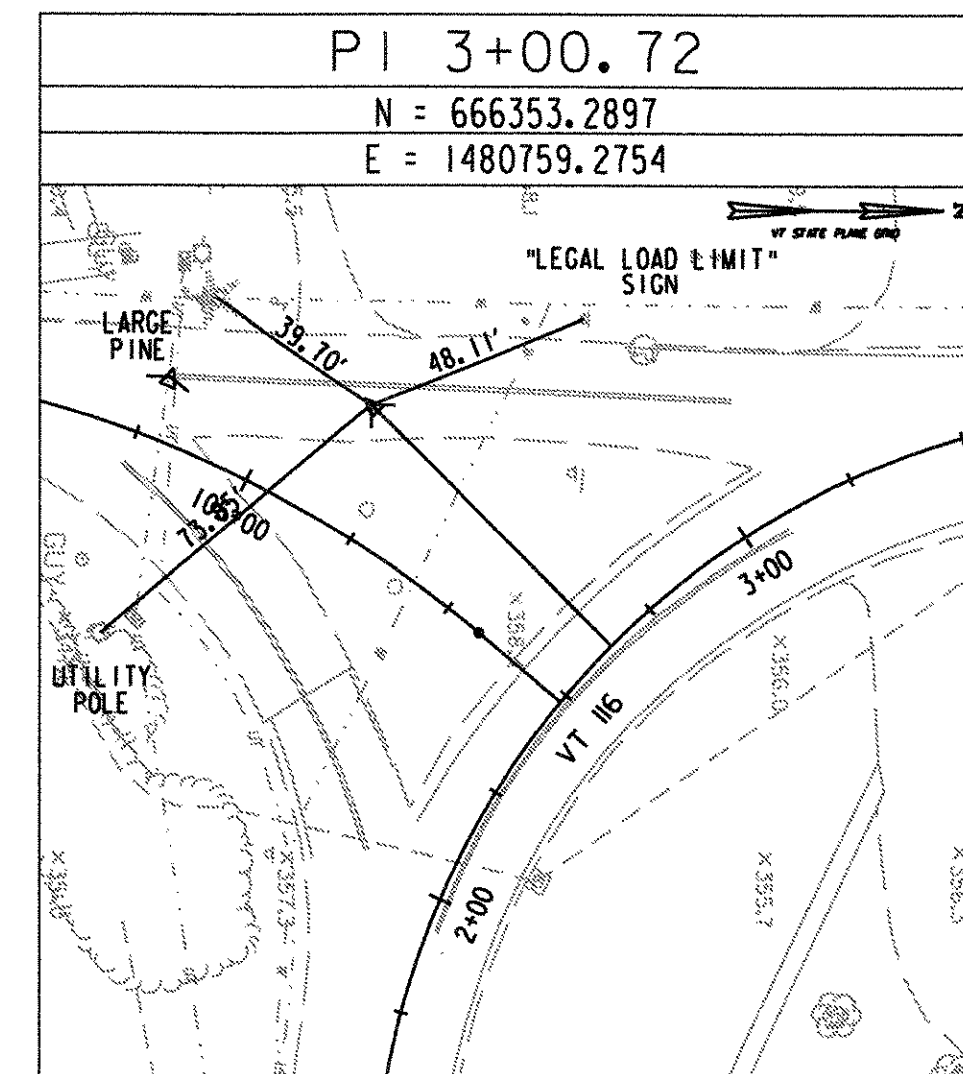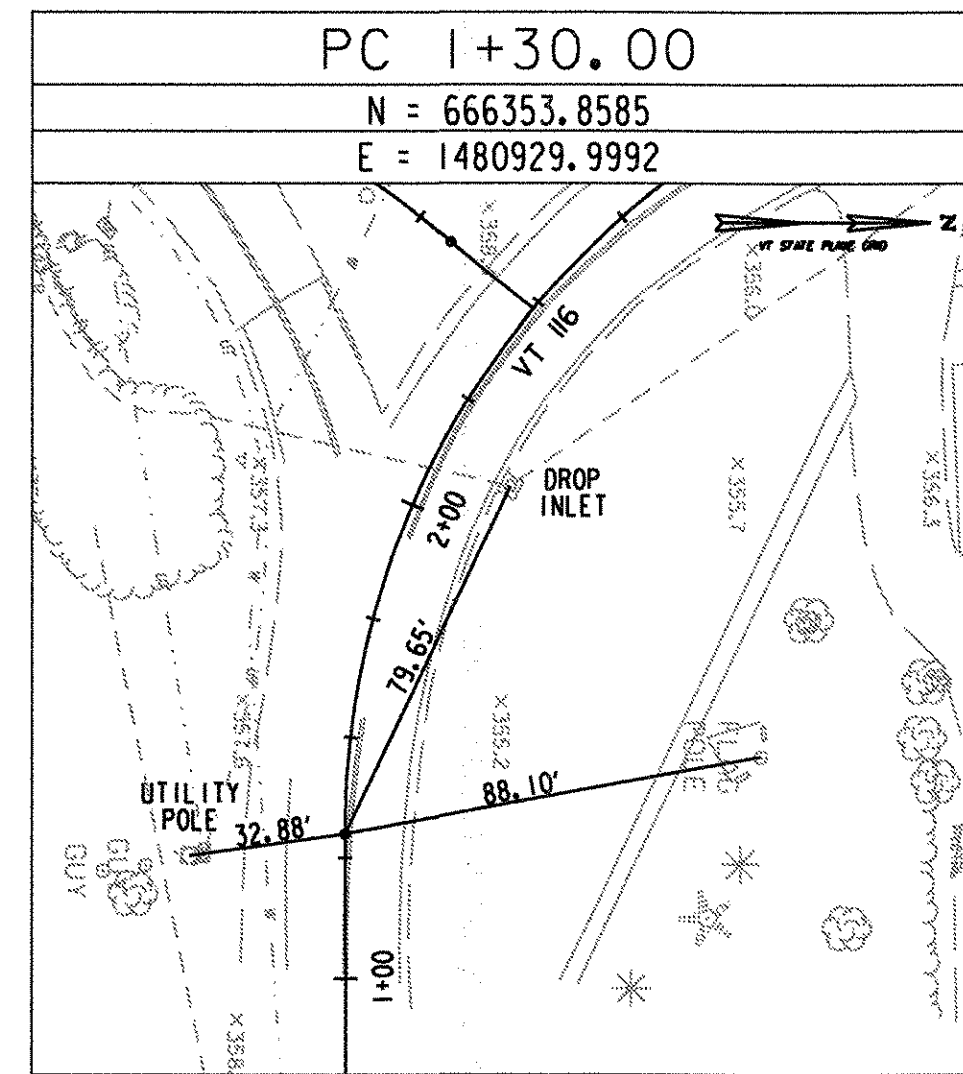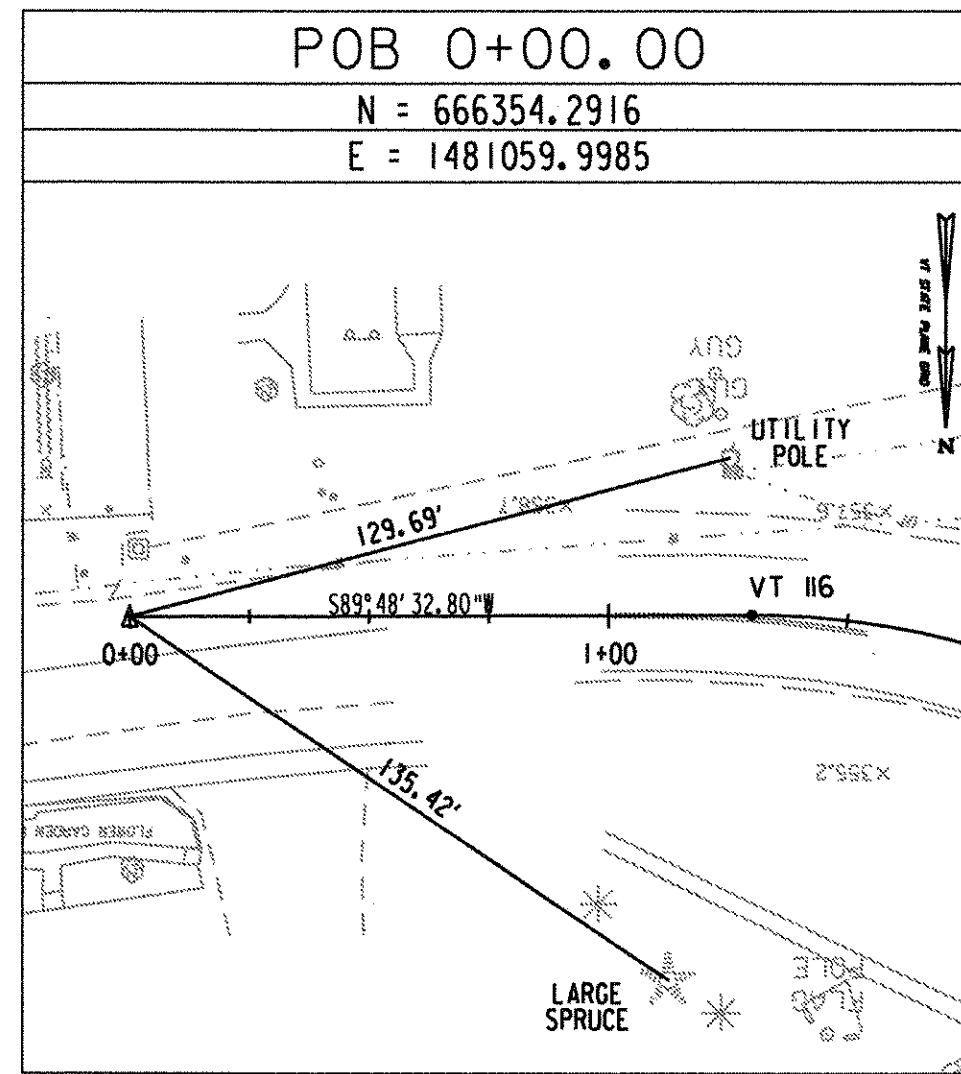


TH4 SILVER STREET

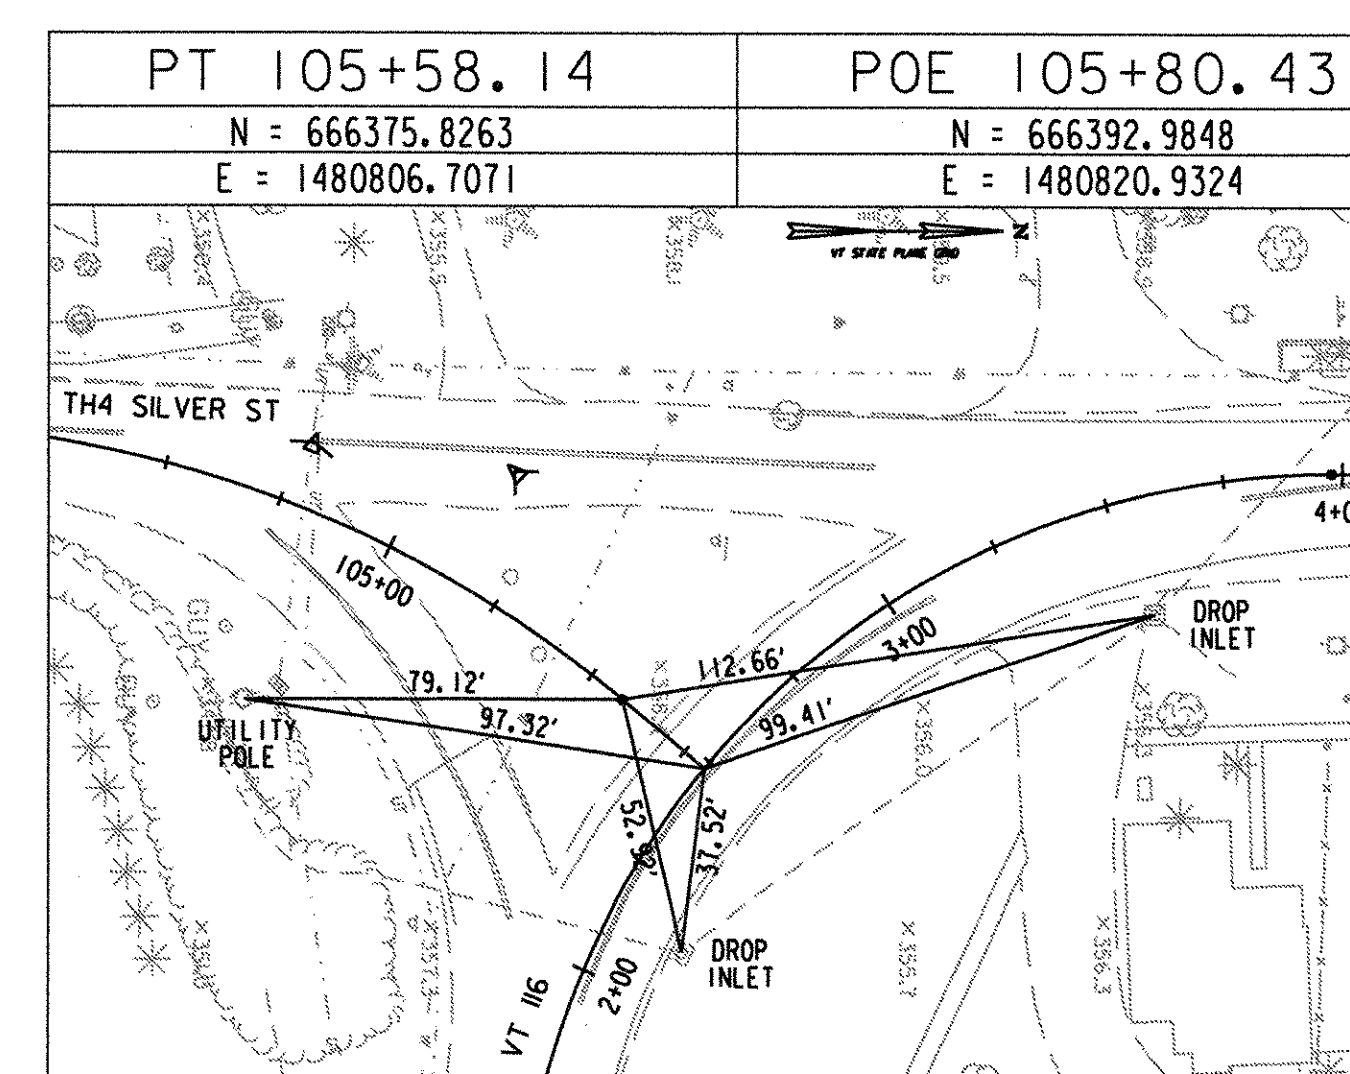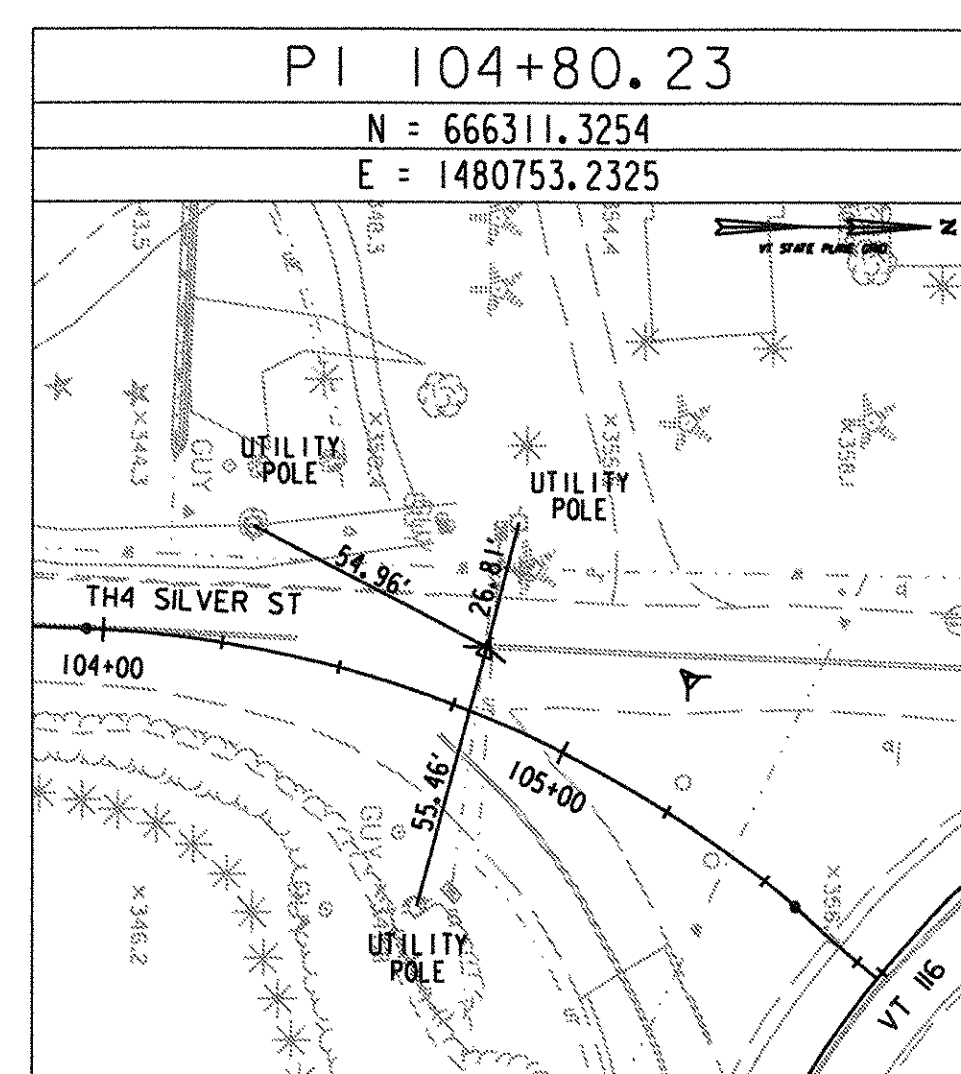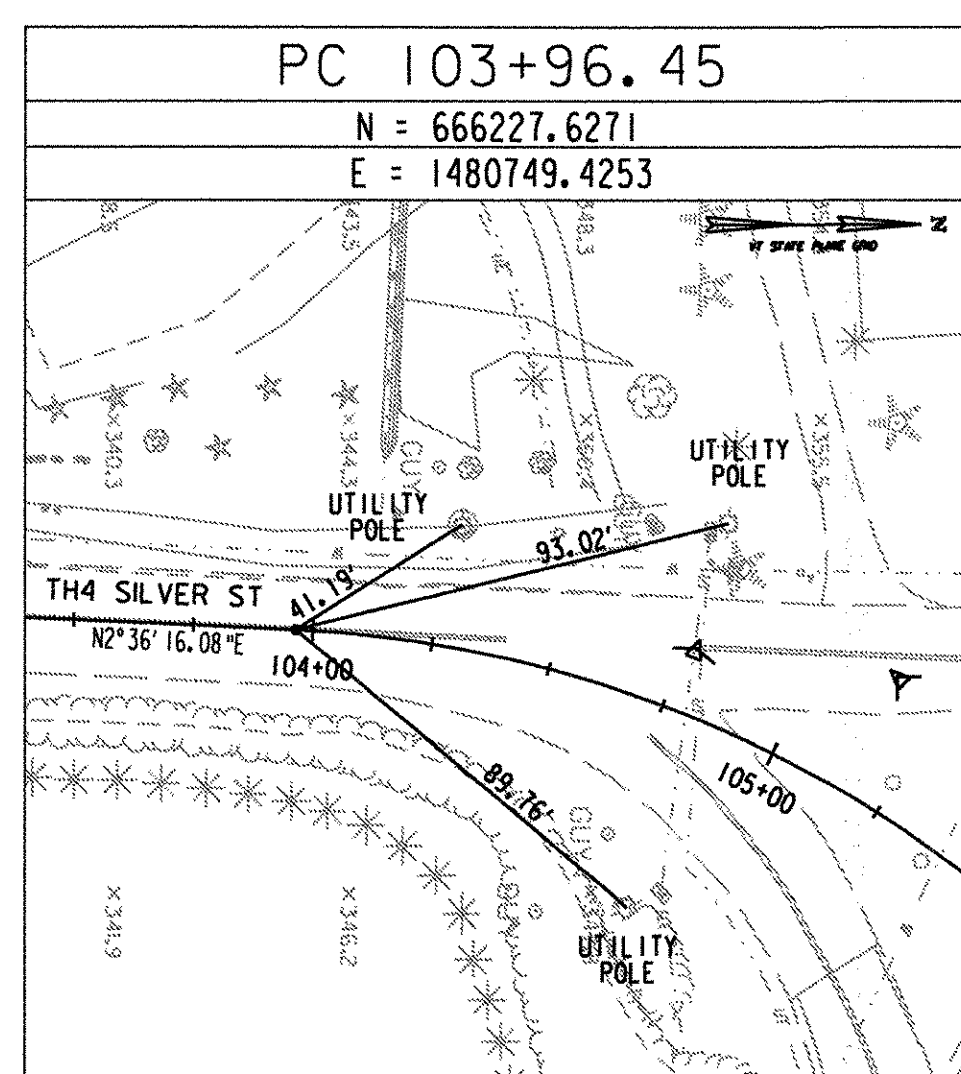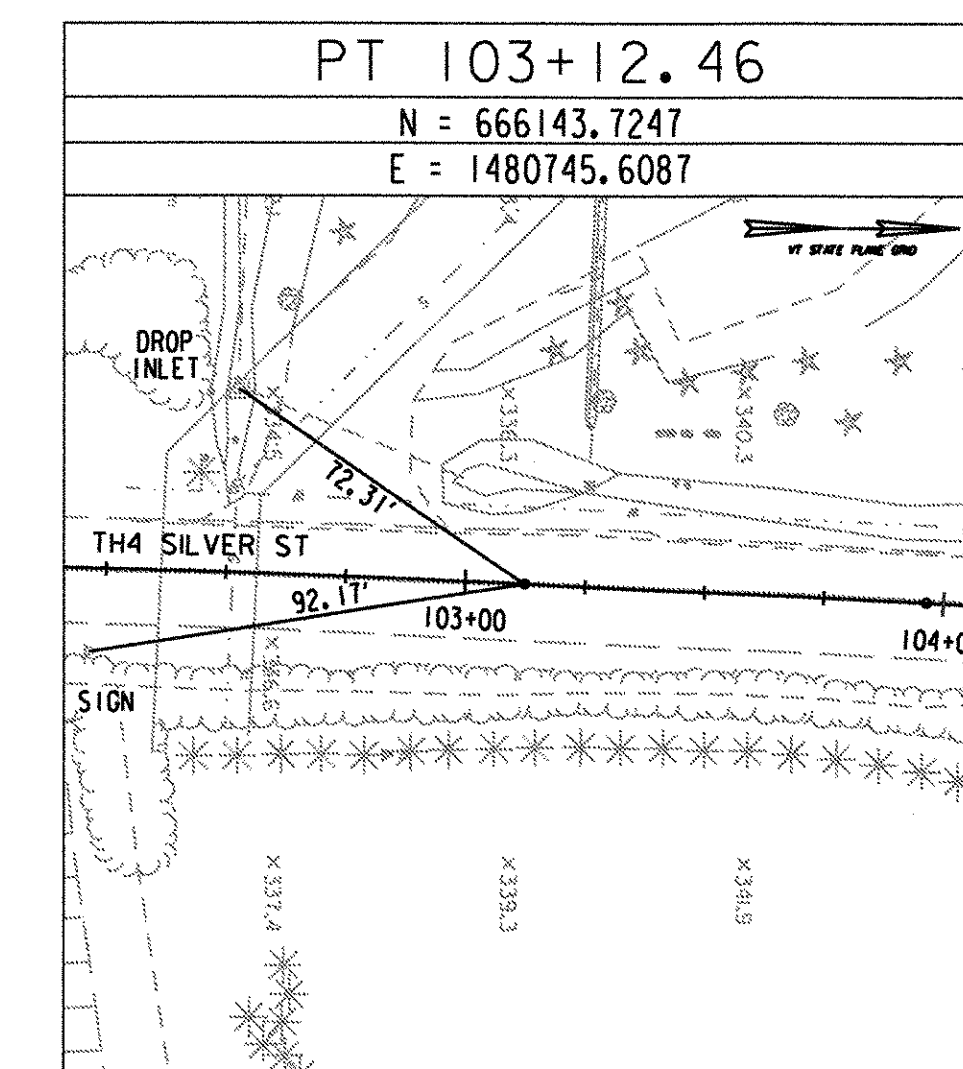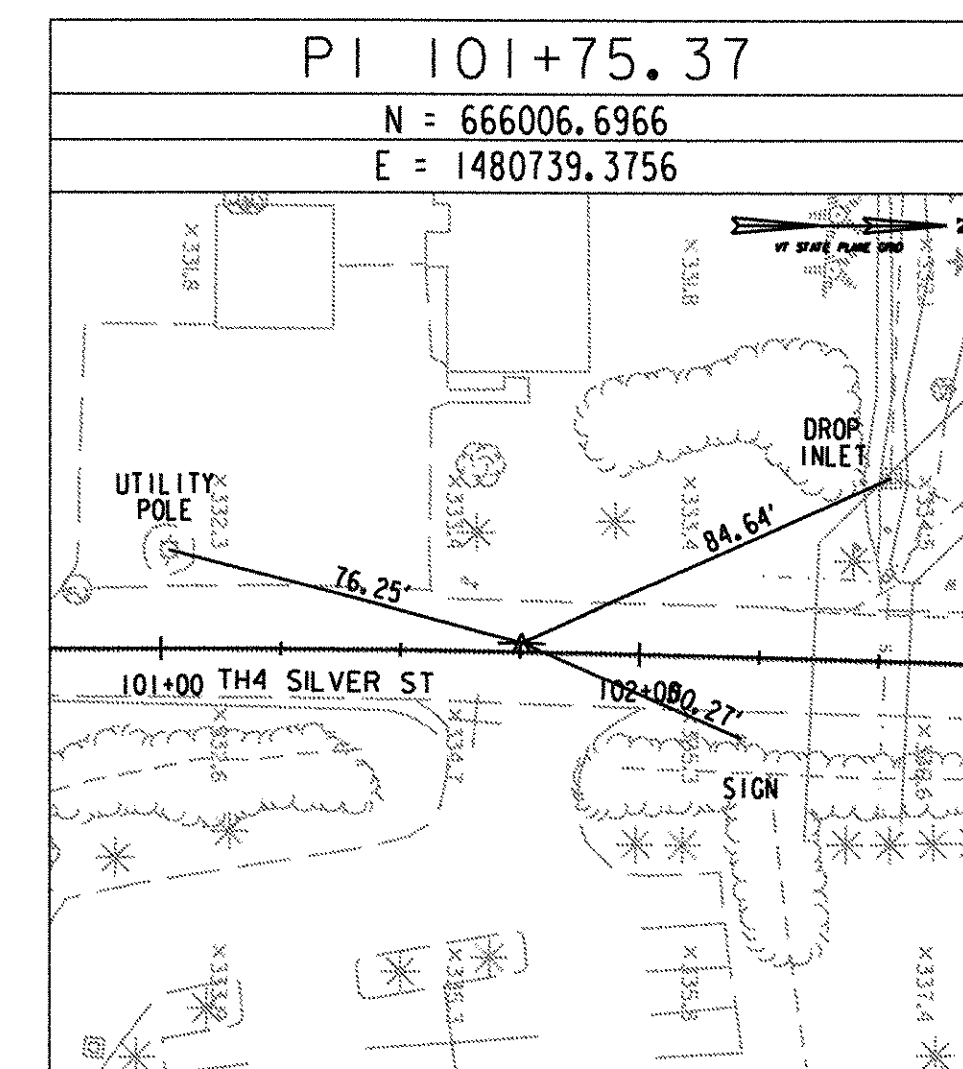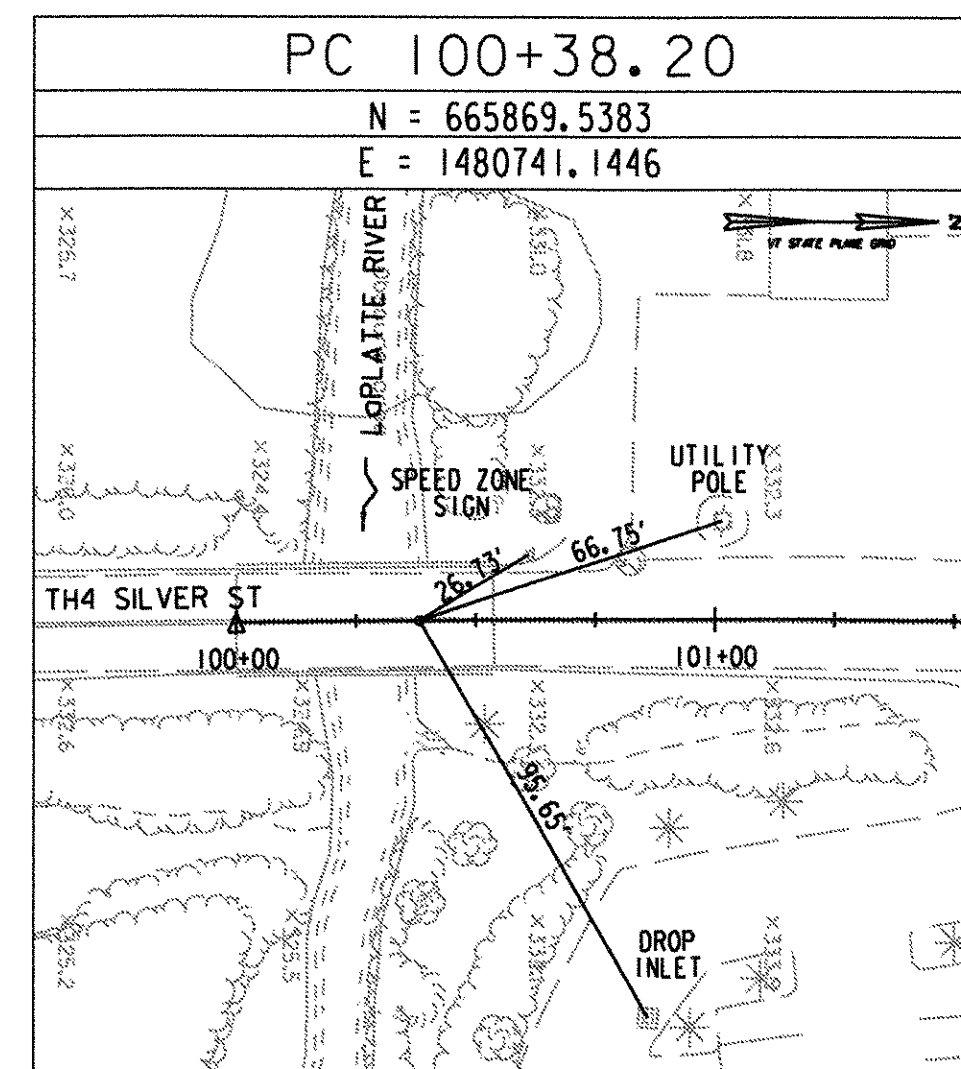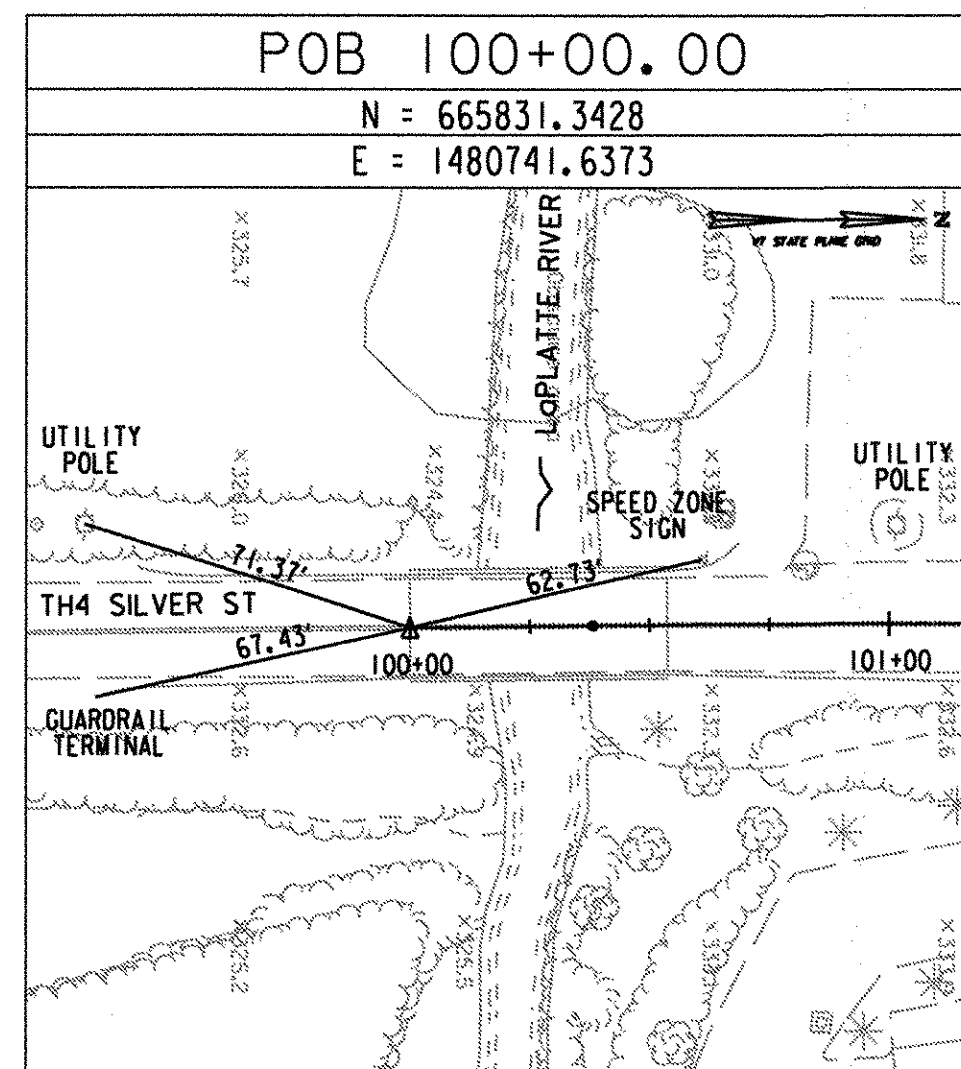

AERIAL SURVEY BY: COL-EAST, INC.
SURVEYED DATE: 2004

DATUM
VERTICAL NAVD 88
HORIZONTAL NAD 83

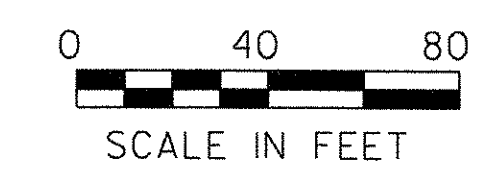

VHB Vanasse Hangen Brustlin, Inc.

TIE SHEET

PROJECT NAME: HINESBURG
PROJECT NUMBER: HES 021-K(20)

FILE NAME: z04b206+1e.dgn
PROJECT LEADER: G. BAKOS
DESIGNED BY: D. PECK
TIE SHEET

PLOT DATE: 2/18/2009
DRAWN BY: D. PECK
CHECKED BY: G. BAKOS
SHEET 11 OF 25

RIGHT - OF - WAY DETAIL SHEET

TABLE OF PROPERTY ACQUISITION

PARCEL NO.	PROPERTY OWNER	SHEET NO.	BEGINNING STATION	ENDING STATION	TAKE AREA±	REMAINDER AREA±	RIGHT			RECORDING DATA					REMARKS
							TYPE	(T)/(P)	AREA ±	TITLE	DATE	TOWN / CITY	BOOK	PAGE	
1A	TOWN OF HINESBURG	9	TH 4 103+12.46 RT. TH 4 100+75 CL. TH 4 102+56 RT. TH 4 103+00 RT. TH 4 104+61 RT. TH 4 104+76 RT. TH 4 104+90 RT. 1+97 LT.	TH 4 104+94.88 RT. TH 4 104+81.95 RT. TH 4 105+36 RT. TH 4 104+15 RT. TH 4 105+21 RT. TH 4 105+15 RT. TH 4 104+98 RT.	1,260 SF		APPROACH	(T)		QCD	05/30/08	HINESBURG	198	644-647	TH 4 INCLUDES EC & PDF RELOCATE SHRUBS INCLUDES EC INCLUDES EC
1B		9	3+35 RT.												29' PAVED DRIVE MM 0443
1C		9	5+60 RT.												28' PAVED DRIVE MM 0448
2	APPLIN TOMASI LLC	9	3+20.03 RT. 3+35 RT. 3+62 RT. 3+64 RT.	3+96.80 RT. 3+81 RT. 3+79 RT.	640 SF		INSTALL	(T)	24 SF	WD	09/22/08	HINESBURG	200	464-465	29' PAVED DRIVE MM 0443 EC DRAIN INLET
3	CARLSMITH, LAURA AND BAST, ROBERT S., TRUSTEES OF THE LAURA CARLSMITH REVOCABLE TRUST	9	3+81.36 LT. 3+82 LT. 3+88 LT. 4+00 LT. 4+03 LT. 4+43 LT.	4+30 LT. 4+32 LT. 4+11 LT. 4+10 LT.			INSTALL	(T)	93 SF	WD	10/08/08	HINESBURG	200	551-553	EC INCLUDES EC STONE PLANTER SIGN DRAIN INLET & PIPE 20' PAVED DRIVE MM 0445
4	NOT USED														
5	GREEN STREET, LLC	9	3+57 LT.												23' PAVED DRIVE MM 0443
6	ROBINSON, REGINALD H. & SANDRA J.	9	4+73 RT.												14.5' PAVED DRIVE MM 0446
7	CORBETT, BRUCE L. & MAUREEN T.	9	4+70 LT.												13.5' PAVED DRIVE MM 0446

TABLE OF REVISIONS

REVISION NO.	SHEET NO.	DESCRIPTION	DATE
		ELECTRONIC FILES TO CONSULTANT	01/08/09

PLAN LEGEND

	EXISTING RIGHT-OF-WAY		TOE OF SLOPE
	TAKING WITH ACCESS		TOP OF CUT
	TAKING WITHOUT ACCESS		SLOPE RIGHT
	CLEAR ZONE		CONSTRUCTION RIGHT
	PROPERTY LINE		PROJECT DEMARCATION FENCE

- EC - EROSION CONTROL
- (P) - PERMANENT
- (T) - TEMPORARY
- DR. - DRAINAGE RIGHT
- DIT. - DITCHING RIGHT
- CH. - CHANNEL RIGHT
- DRIVE - DRIVE RIGHT
- CUL. - CULVERT RIGHT
- C&T - CLEARING & TRIMMING RIGHT
- SR - SLOPE RIGHT
- UE - UTILITY EASEMENT

APPROVED: HARRY PETROVS DATE: 03-06-08
CHIEF, PLANS & TITLES

PLOT DATE 02/18/09

PROJECT NAME:	HINESBURG	PLOT DATE:	
PROJECT NUMBER:	HES 021-1(20)	DRAWN BY:	MR
FILE NAME:	04b206/detail sheet.xls	CHECKED BY:	EP
PROJECT LEADER:	G. BACKOS	SHEET	12 OF 25
DESIGNED BY:	D. PECK		
R.O.W. SHEET	7 OF 9		

EXCAVATION OF SURFACES AND PAVEMENTS
 STA. 1+50, LT. - SL STA. 105+00, RT.
 SL STA. 104+50, LT. - STA. 3+40, LT.

COLD PLANING, BITUMINOUS PAVEMENT
 SL STA. 100+75 - 101+25
 STA. 1+00 - 1+50
 STA. 6+31 - 6+81

RELOCATE MAILBOX, SINGLE SUPPORT
 SL STA. 101+63, LT.
 SL STA. 104+90, LT.
 STA. 4+35, LT.
 STA. 4+54, RT.
 STA. 4+90, LT.
 STA. 5+18, RT.
 STA. 6+39, RT.
 STA. 6+55, LT.

RELOCATE MAILBOX, MULTIPLE SUPPORT
 STA. 3+87, LT.

VERTICAL GRANITE CURB
 STA. 1+50, LT. - SL STA. 105+08, RT.
 STA. 105+25, LT. - STA. 3+35, LT.
 STA. 3+78 - STA. 4+28, LT.
 STA. 4+86 - STA. 6+07, LT.

CONSTRUCT DRIVES - 1 1/2" BCP, TYPE IV
 SL STA. 101+75, RT. - 28' WIDE
 SL STA. 102+73, LT. - 30' WIDE
 SL STA. 105+01, LT. - 10' WIDE
 STA. 3+35, RT. - 29' WIDE (COMM.)
 STA. 3+57, LT. - 23' WIDE
 STA. 4+43, LT. - 20' WIDE (COMM.)
 STA. 4+70, LT. - 13.5' WIDE
 STA. 4+73, RT. - 14.5' WIDE
 STA. 5+85, RT. - 99' WIDE
 STA. 6+30, LT. - 24' WIDE

TRANSPLANTING SHRUBS
 SL STA. 103+00 - 104+15, RT. (14 SHRUBS)


DRAINAGE NOTES

- ① STA. 2+15, RT. 25 - STA. 2+13, RT. 17
 NEW PRECAST DI, TYPE A
 RIM ELEV. = 355.15
 NEW 18" x 5 LF CPEP (SL)
 INV. OUT = 351.95
- ② STA. 2+13, RT. 17
 ADJUST DI
 REMOVE DI GRATE & FRAME
 REPLACE WITH MH COVER & FRAME
 RIM ELEV. = 356.08
- ③ STA. 3+71, RT. 41
 REMOVE EXIST. PRIVATE DI
 NEW PRECAST DI, TYPE D
 CONST. OVER EXIST. 6" PVC
 RIM ELEV. = 356.00
- ④ STA. 3+54, RT. 25
 ADJUST DI
 REMOVE DI GRATE & FRAME
 REPLACE WITH MH COVER & FRAME
 RIM ELEV. = 356.47

- ⑤ STA. 4+88, LT. 25 - STA. 4+13, LT. 26
 NEW PRECAST DI, TYPE D
 RIM ELEV. = 359.69
 NEW 18" x 72 LF CPEP (SL)
 18" INV. OUT (S) = 354.25
- ⑥ STA. 4+05, LT. 42 - STA. 4+13 LT. 26
 NEW PRECAST DI, TYPE A
 RIM ELEV. = 357.64
 NEW 18" x 14 LF CPEP (SL)
 INV. OUT = 354.43
- ⑦ STA. 4+13, LT. 26
 NEW PRECAST DI, TYPE D
 RIM ELEV. = 359.27
 15" INV. OUT (E) = 353.3 (Exist.)
 18" INV. IN (N) = 353.55
 18" INV. IN (W) = 353.65
 REMOVE EXIST. CB
- ⑧ STA. 3+00, LT. 26 - SL STA. 105+25, LT. 18
 NEW PRECAST DI, TYPE D
 RIM ELEV. = 358.10
 NEW 18" x 56 LF CPEP (SL)
 INV. OUT = 352.76
- ⑨ STA. 105+10, LT. 28 - STA. 105+25, LT. 18
 NEW PRECAST DI, TYPE A
 RIM ELEV. = 353.00
 NEW 18" x 16 LF CPEP (SL)
 18" INV. OUT = 349.83

CURVE 1 DATA	CURVE 2 DATA	CURVE 3 DATA
A = 90°03'37"	A = 3°20'36"	A = 37°03'22"
D = 33°08'12"	D = 1°13'09"	D = 22°55'06"
R = 170'	R = 4700'	R = 250'
T = 170.2'	T = 137.17'	T = 83.78'
L = 267.2'	L = 274.26'	L = 161.69'
E = 170.92'	E = 2.00'	E = 13.67'

REFERENCE:
 LEASE TO HINESBURG TOWN SCHOOL DISTRICT
 VOL. 122 P. 518
END RELINQUISHMENT #1
 TH4 STA. 104+94.88, 40.00' RT.
 = 2+27.60, 92.84' LT.

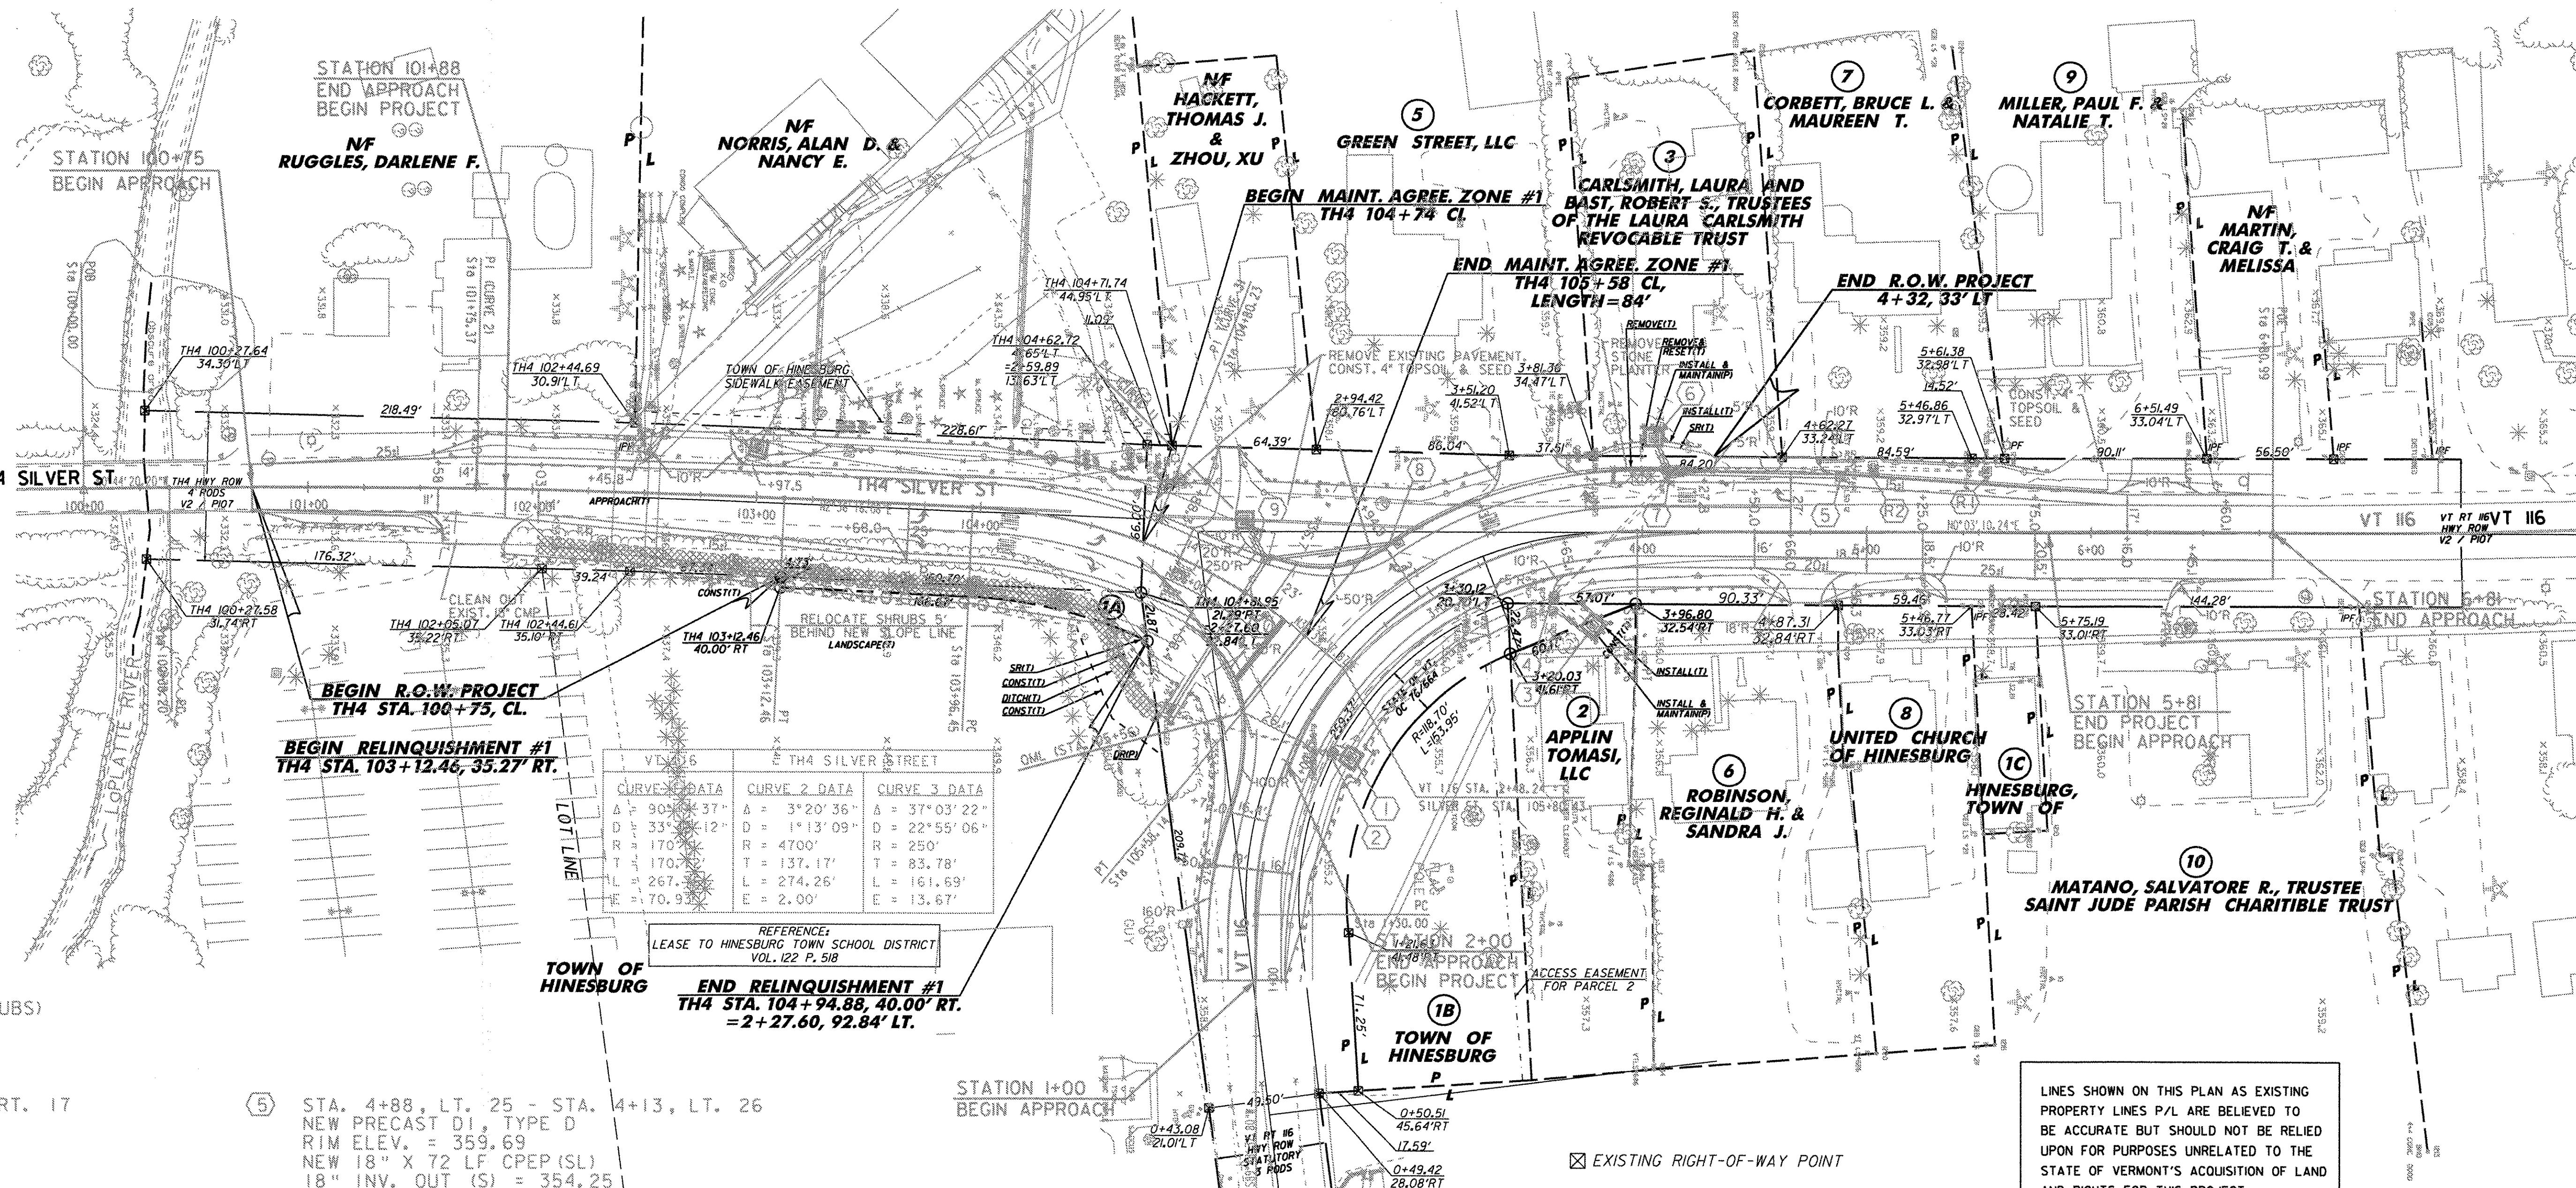

LINES SHOWN ON THIS PLAN AS EXISTING PROPERTY LINES P/L ARE BELIEVED TO BE ACCURATE BUT SHOULD NOT BE RELIED UPON FOR PURPOSES UNRELATED TO THE STATE OF VERMONT'S ACQUISITION OF LAND AND RIGHTS FOR THIS PROJECT.

NOTES


1. THE DRAINAGE STRUCTURE RIM AND INVERT ELEVATIONS ARE BASED ON SURVEY INFORMATION FROM AERIAL SURVEY. THE CONTRACTOR SHALL SET ACTUAL RIM ELEVATIONS ONE INCH BELOW FINISHED PAVEMENT ELEVATIONS. THE CONTRACTOR SHALL FIELD CHECK PROPOSED PIPE INVERTS BEFORE ORDERING DRAINAGE STRUCTURES.
2. THE USE OF BRICK AND MORTAR TO ADJUST THE ELEVATION OF DRAINAGE STRUCTURES IS PROHIBITED. ALL ELEVATION ADJUSTMENTS SHALL BE MADE USING EITHER GRADE RINGS OR A SYNTHETIC RISER.
3. ALL CONNECTIONS BETWEEN PRECAST DRAINAGE STRUCTURES AND DRAINAGE PIPES SHALL BE A BOOTED CONNECTION.

DATE PLOTTED: 02/18/09

RIGHT OF WAY PLAN SHEET


PROJECT NAME: HINESBURG	PLOT DATE: \$\$\$DATE\$\$\$
PROJECT NUMBER: HES 021-(K20)	DRAWN BY: D. PECK
FILE NAME: R04B206ZZZ.DGN	CHECKED BY: G. BAKOS
PROJECT LEADER: G. BAKOS	R. O. W. SHEET 9 OF 9
DESIGNED BY: D. PECK	SHEET 14 OF 25

FOR R.O.W. USE ONLY

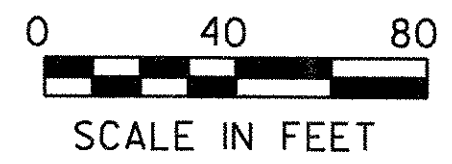

AERIAL SURVEY BY: COL-EAST, INC.
 SURVEYED DATE: 2004

DATUM	
VERTICAL	NAVD 88
HORIZONTAL	NAD 83

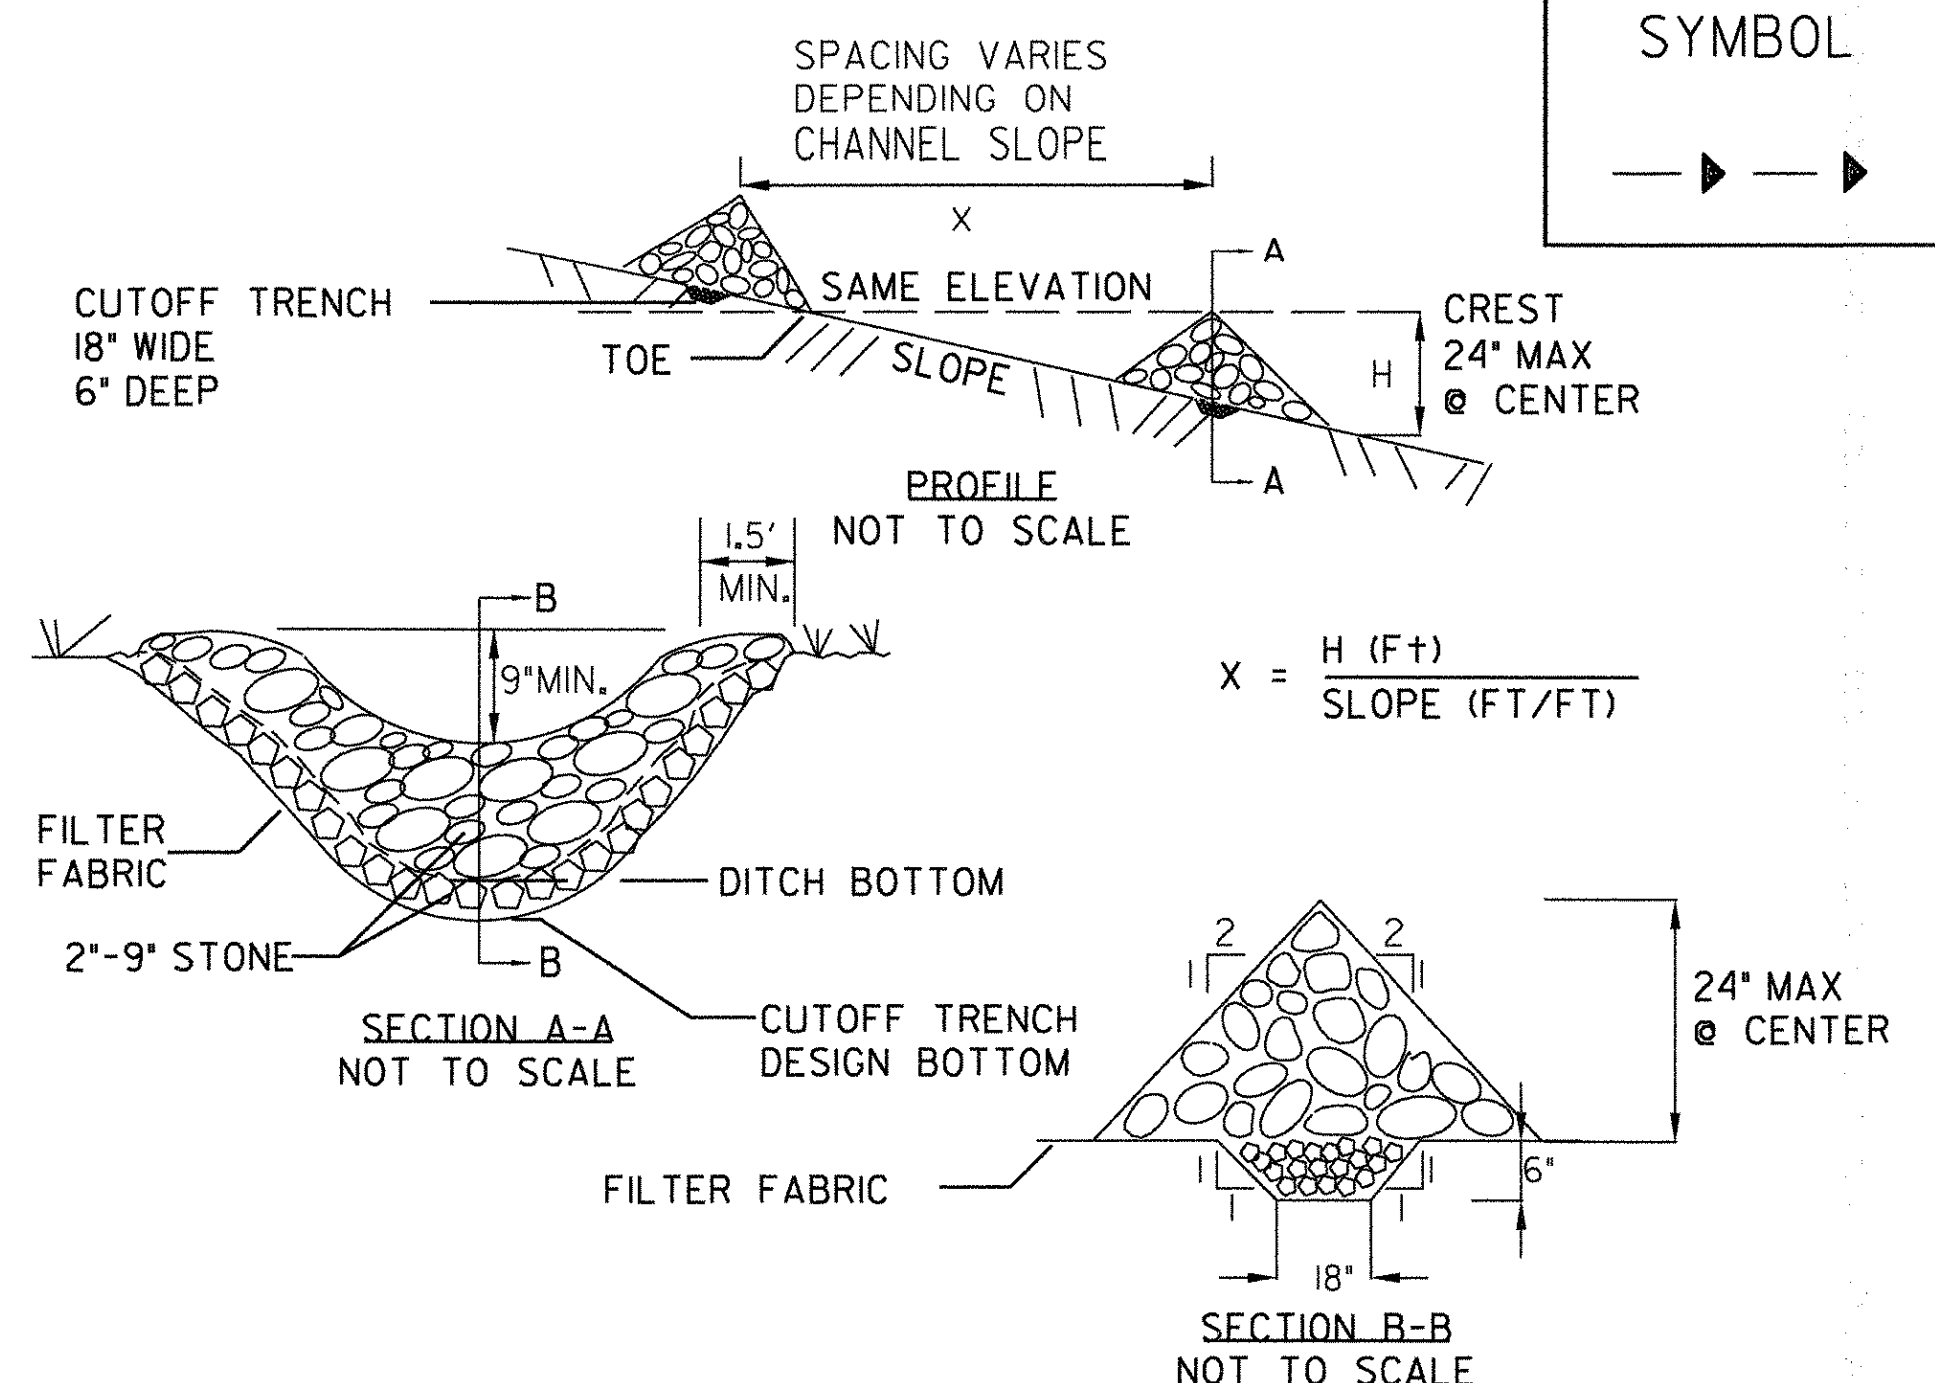

CONSTRUCTION SPECIFICATIONS


1. STONE WILL BE PLACED ON A FILTER FABRIC FOUNDATION.
2. SET SPACING OF CHECK DAMS SO THAT THE ELEVATION OF THE CREST OF THE DOWNSTREAM DAM IS AT THE SAME ELEVATION AS THE TOE OF THE UPSTREAM DAM.
3. EXTEND THE STONE A MINIMUM OF 1.5 FEET BEYOND THE DITCH BANKS TO PREVENT CUTTING AROUND THE DAM.
4. PROTECT THE CHANNEL DOWNSTREAM OF THE LOWEST CHECK DAM FROM SCOUR AND EROSION WITH STONE OR LINER AS APPROPRIATE.
5. ENSURE THAT CHANNEL APPURTENANCES SUCH AS CULVERT ENTRANCES BELOW CHECK DAMS ARE NOT SUBJECT TO DAMAGE OR BLOCKAGE FROM DISPLACED STONE. MAXIMUM DRAINAGE AREA 2 ACRES.

ADAPTED FROM DETAILS PROVIDED BY: NEW YORK STATE DEC ORIGINALLY DEVELOPED BY USDA-NRCS VERMONT DEPARTMENT OF ENVIRONMENTAL CONSERVATION

CHECK DAM

NOTES:
REFER TO "THE VERMONT STANDARDS & SPECIFICATIONS FOR EROSION PREVENTION & SEDIMENT CONTROL -2006-" FROM THE VT AGENCY OF NATURAL RESOURCES FOR ADDITIONAL GUIDANCE.
THIS ITEM SHALL BE PAID FOR UNDER ITEM 653.25 TEMPORARY STONE CHECK DAM, TYPE 1

REVISIONS	
MARCH 8, 2007	JMF

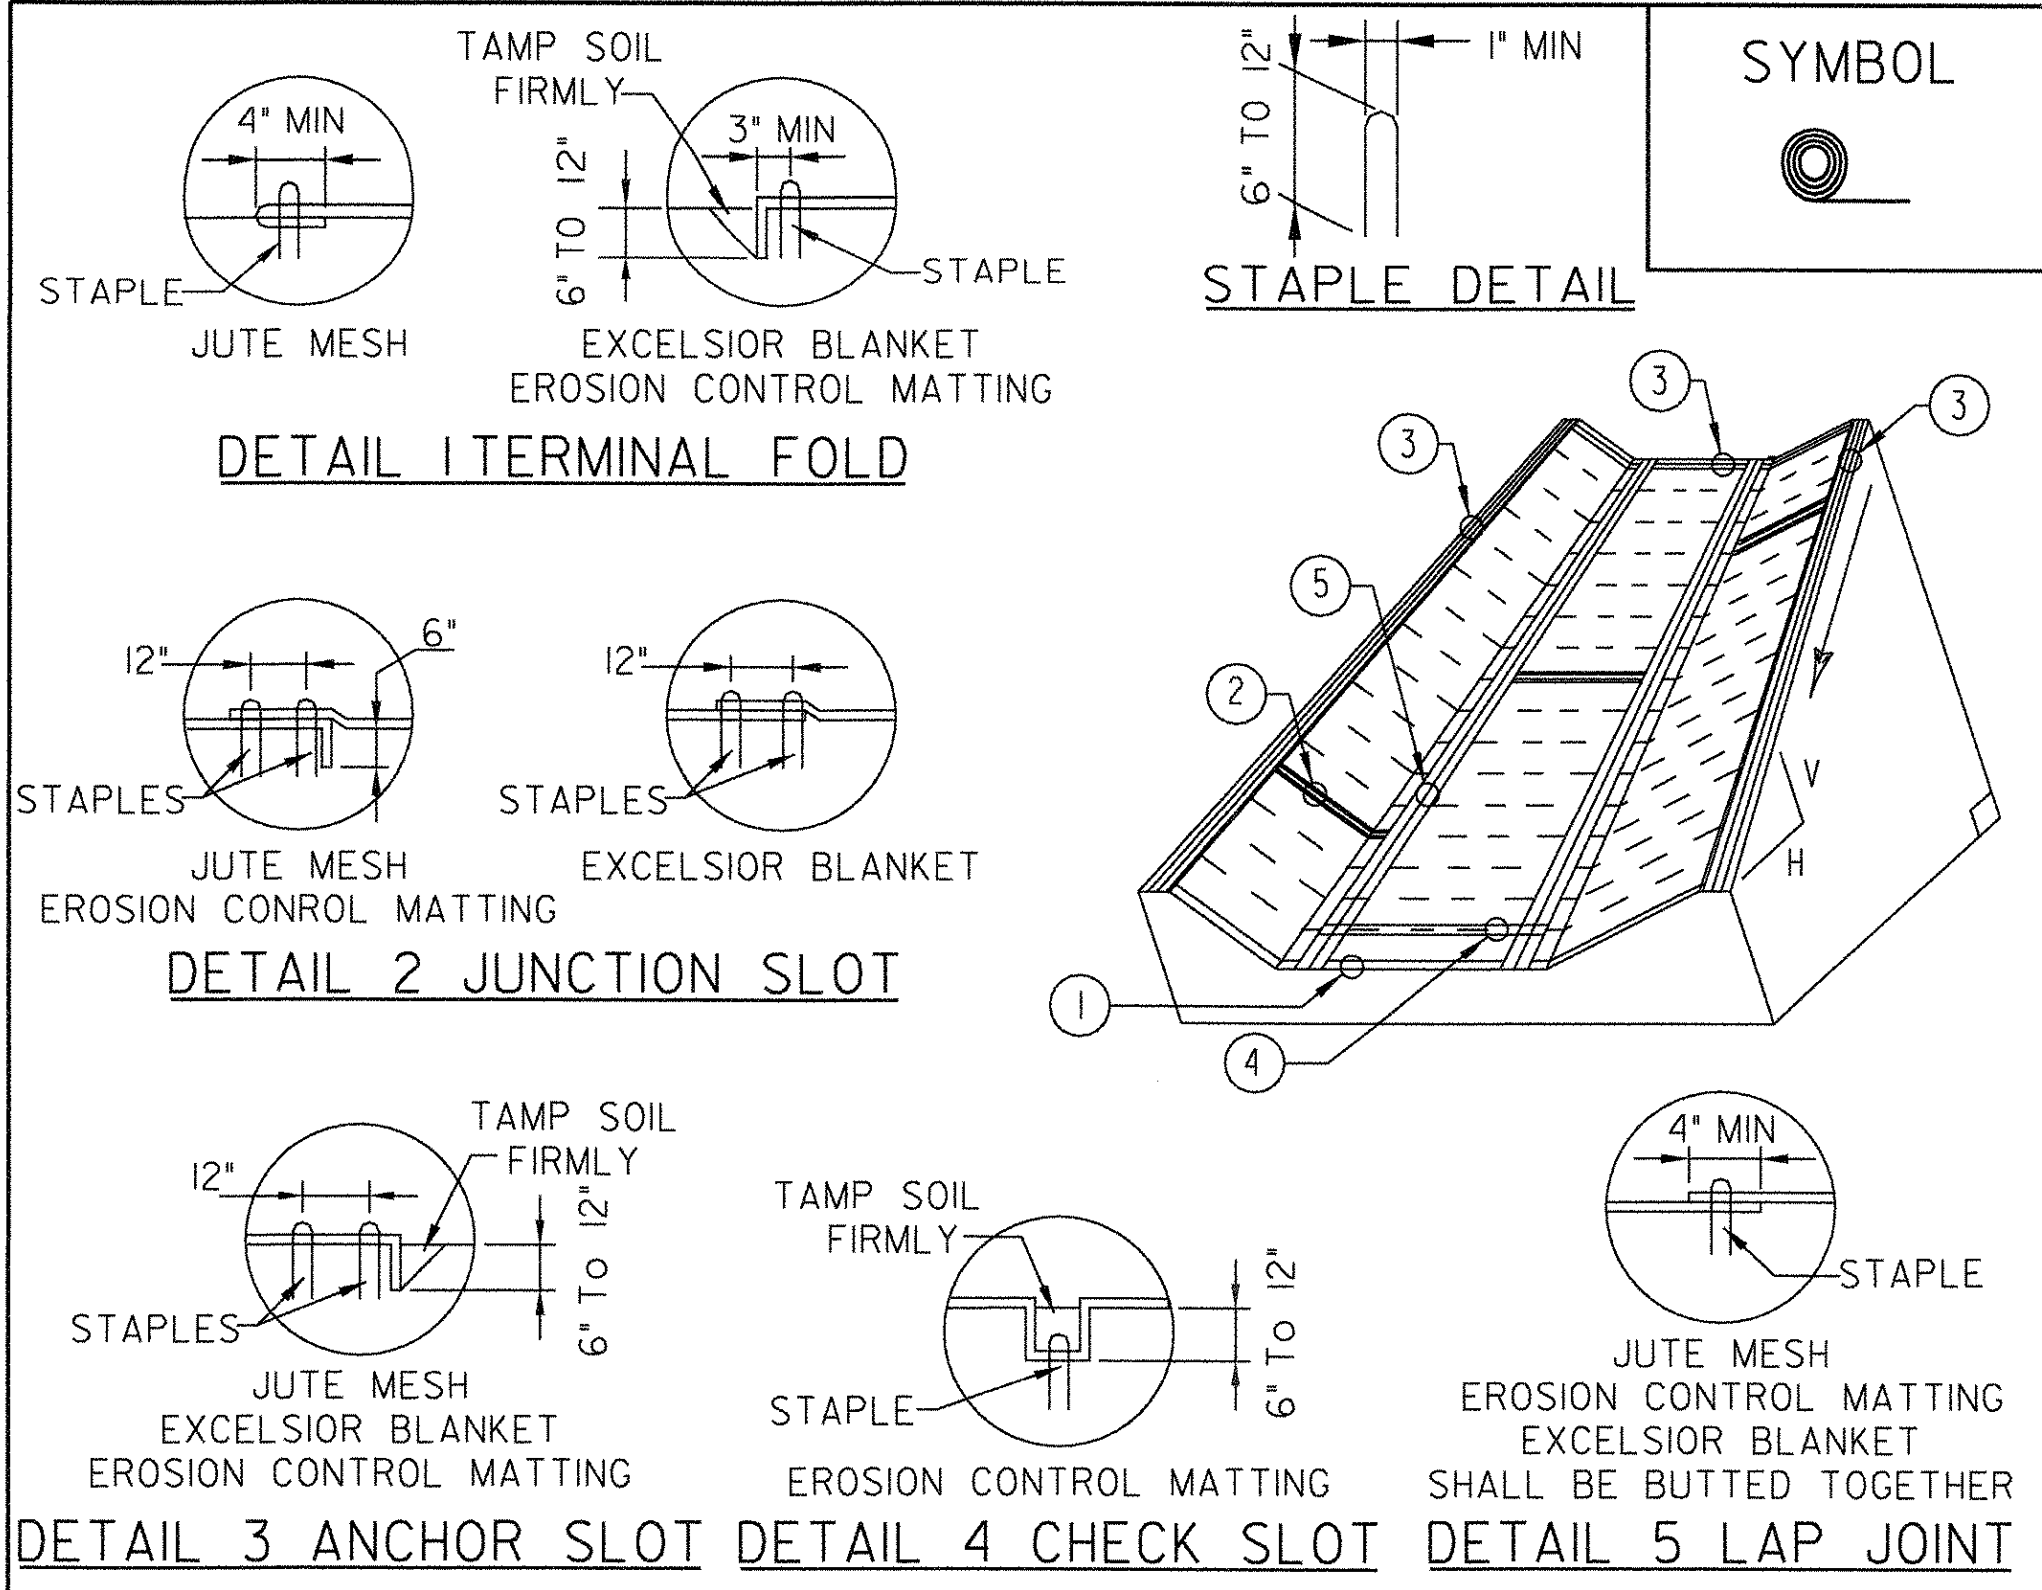

CONSTRUCTION SPECIFICATIONS


1. EROSION MATTING, CHECK SLOTS, SHALL BE SPACED IN DITCH CHANNEL SO THAT ONE OCCURS WITHIN EACH 50' ON SLOPES OF MORE THAN 4% AND LESS THAN 6%. ON SLOPES OF 6% OR MORE, THEY SHALL BE SPACED SO THAT ONE OCCURS WITHIN EACH 25'.
2. APPLY FERTILIZER, LIME SEED PRIOR TO PLACING MATTING.
3. STAPLES ARE TO BE PLACED ALTERNATELY, IN COLUMNS APPROXIMATELY 2' APART AND IN ROWS APPROXIMATELY 3' APART. APPROXIMATELY 175 STAPLES ARE REQUIRED PER 4'X225' ROLL OF MATERIAL AND 125 STAPLES ARE REQUIRED PER 4'X150' ROLL OF MATERIAL.
4. DISTURBED AREAS SHALL BE SMOOTHLY GRADED. EROSION CONTROL MATERIAL SHALL BE PLACED LOOSELY OVER GROUND SURFACE. DO NOT STRETCH.
5. ALL TERMINAL ENDS AND TRANSVERSE LAPS SHALL BE STAPLED AT APPROXIMATELY 12' INTERVALS.

ADAPTED FROM DETAILS PROVIDED BY: ILLINOIS USDA-NRCS ORIGINALLY DEVELOPED BY USDA-NRCS VERMONT DEPARTMENT OF ENVIRONMENTAL CONSERVATION

ROLLED EROSION CONTROL PRODUCT (RECP) DITCH

NOTES:
REFER TO "THE VERMONT STANDARDS & SPECIFICATIONS FOR EROSION PREVENTION & SEDIMENT CONTROL -2006-" FROM THE VT AGENCY OF NATURAL RESOURCES FOR ADDITIONAL GUIDANCE.
THIS ITEM SHALL BE PAID FOR UNDER ITEM 653.20 TEMPORARY EROSION MATTING OR 653.21 PERMANENT EROSION MATTING

REVISIONS	
MARCH 8, 2007	JMF
APRIL 16, 2007	WHF

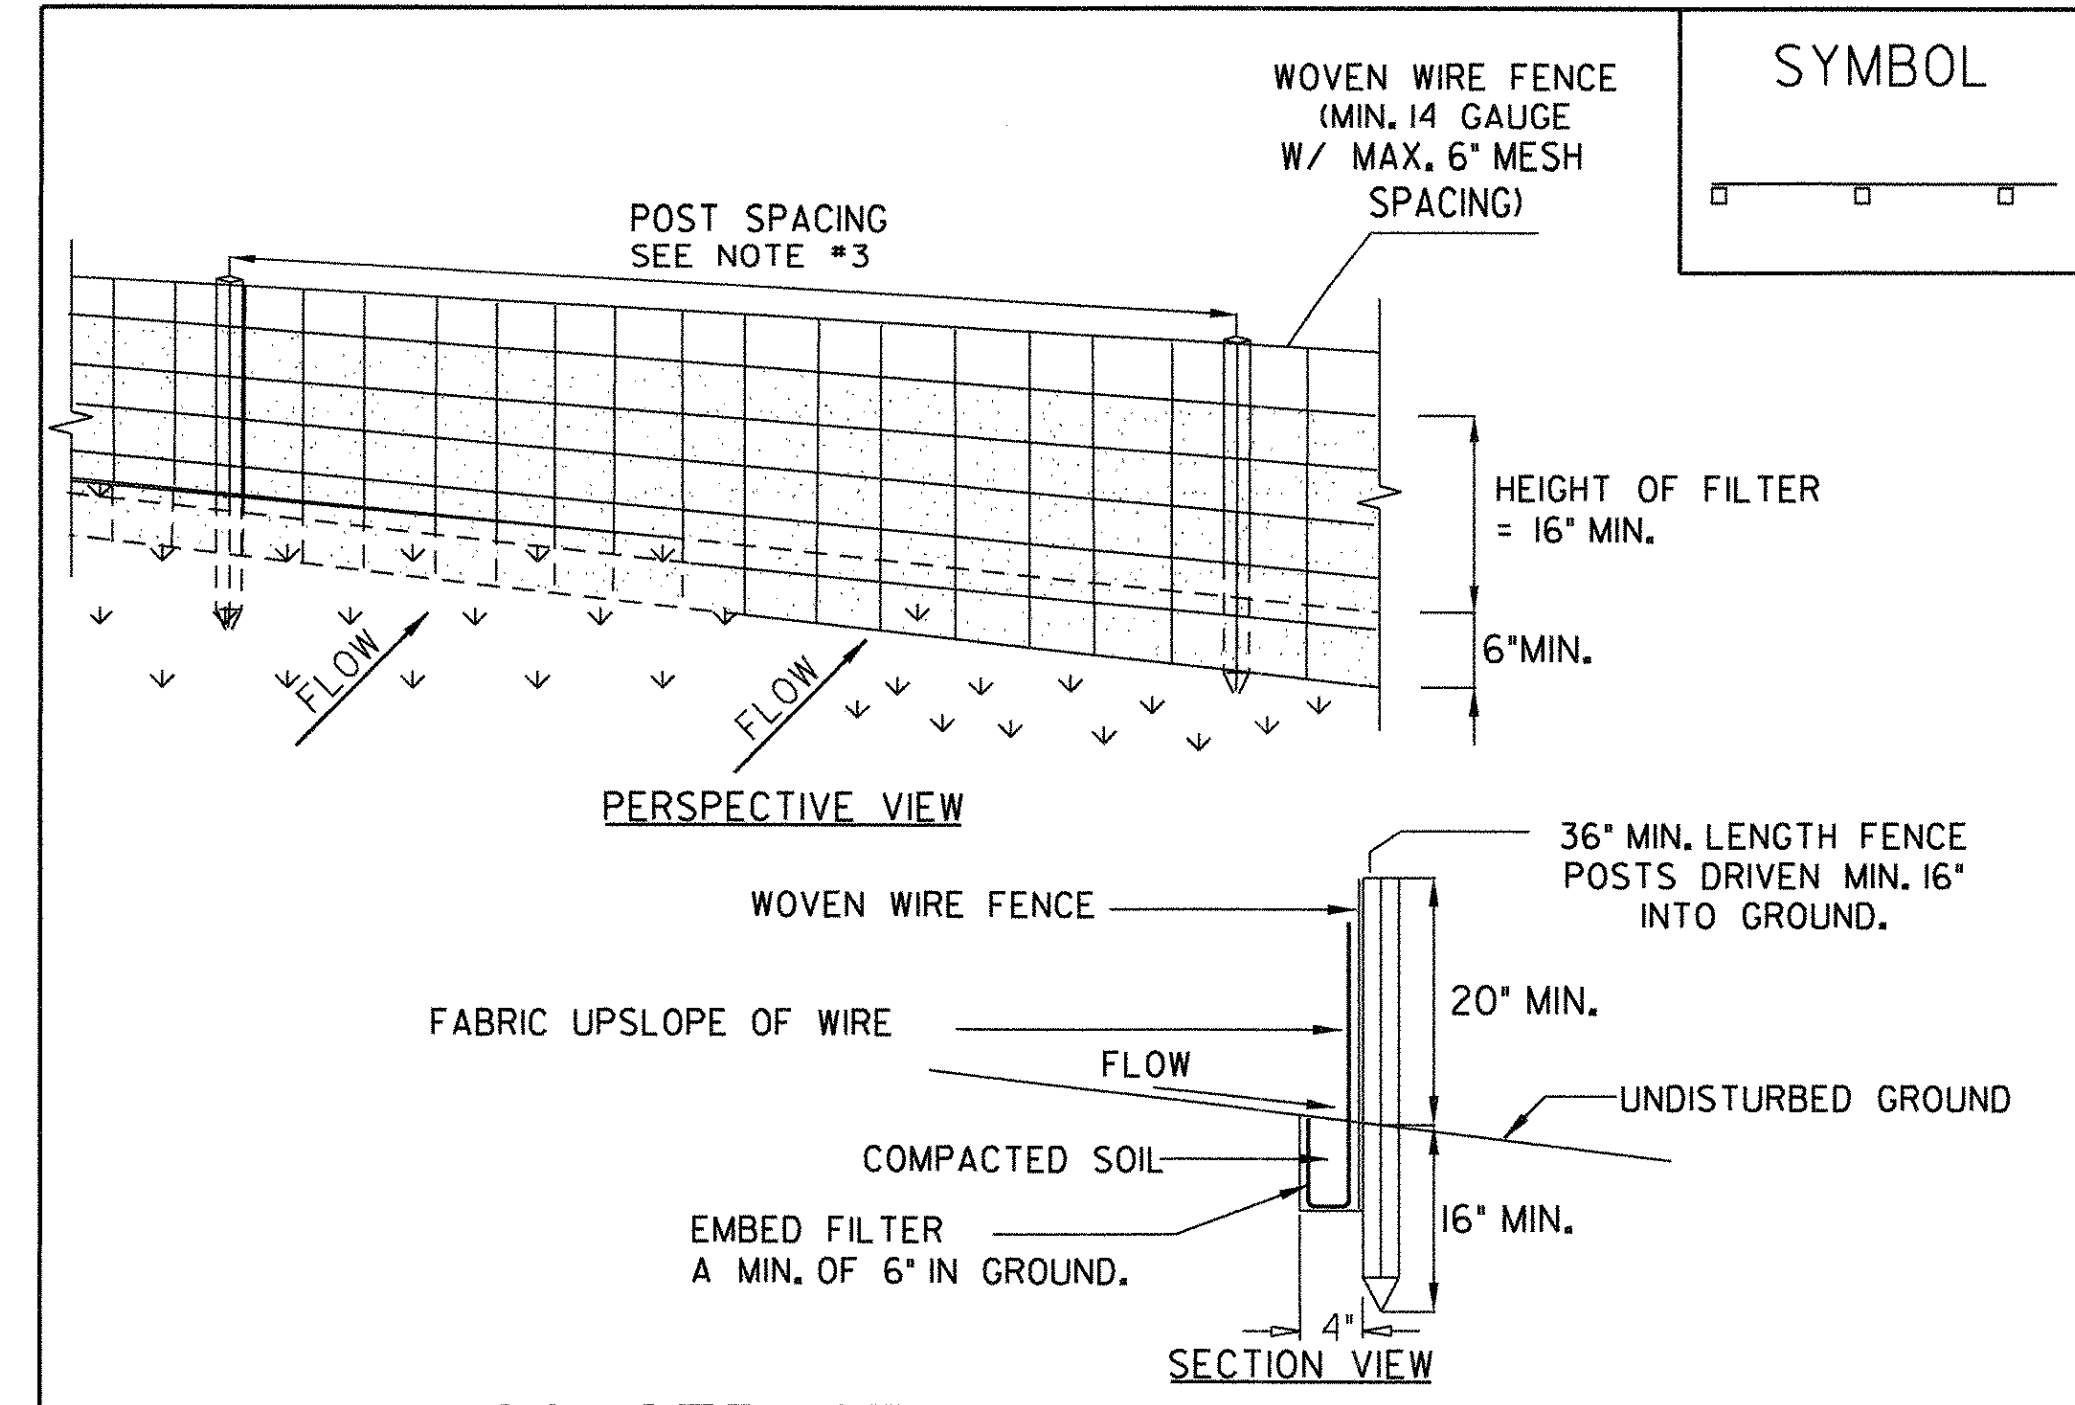

CONSTRUCTION SPECIFICATIONS

1. WOVEN WIRE FENCE REINFORCEMENT IS ONLY REQUIRED WITHIN 100 FT UPSLOPE OF RECEIVING WATERS.
2. WHERE REQUIRED FENCE SHALL BE WOVEN WIRE, MIN. 14 GAUGE WITH A 6" MAXIMUM MESH OPENING. FILTER CLOTH SHALL BE EITHER FILTER X, MIRAFIBROX, STABILINKA T140N OR APPROVED EQUIVALENT.
3. POST SPACING FOR WIRE-BACKED FENCE SHALL BE 10' MAXIMUM. FOR FILTER-CLOTH FENCE, WHEN ELONGATION IS >50%, POST SPACING SHALL NOT EXCEED 4'. FOR FILTER-CLOTH FENCE, WHEN ELONGATION IS <50%, POST SPACING SHALL NOT EXCEED 6'.
4. WOVEN WIRE FENCE IS TO BE FASTENED SECURELY TO FENCE POSTS WITH WIRE TIES. FILTER CLOTH IS TO BE FASTENED SECURELY TO WOVEN WIRE FENCE WITH TIES SPACED EVERY 24" AT TOP AND MID SECTION.
5. WHEN TWO SECTIONS OF FILTER CLOTH ADJOIN EACH OTHER THEY SHALL BE OVER-LAPPED BY SIX INCHES AND FOLDED.
6. PREFABRICATED UNITS SHALL BE GEOFAB, ENVIROFENCE, OR APPROVED EQUIVALENT.
7. MAINTENANCE SHALL BE PERFORMED AS NEEDED AND MATERIAL REMOVED WHEN SEDIMENT REACHES HALF OF FABRIC HEIGHT.


ADAPTED FROM DETAILS PROVIDED BY: NEW YORK STATE DEC ORIGINALLY DEVELOPED BY USDA-NRCS VERMONT DEPARTMENT OF ENVIRONMENTAL CONSERVATION

SILT FENCE

NOTES:
REFER TO "THE VERMONT STANDARDS & SPECIFICATIONS FOR EROSION PREVENTION & SEDIMENT CONTROL -2006-" FROM THE VT AGENCY OF NATURAL RESOURCES FOR ADDITIONAL GUIDANCE.

PROJECT NAME:	HINESBURG	PLOT DATE:	2/18/2009
PROJECT NUMBER:	HES 021-K(20)	DRAWN BY:	D. PECK
FILE NAME:	z04b206_ero-det.dgn	CHECKED BY:	G. BAKOS
PROJECT LEADER:	G. BAKOS	DESIGNED BY:	D. PECK
DESIGNED BY:	D. PECK	EPSC DETAILS SHEET 1	SHEET 15 OF 25



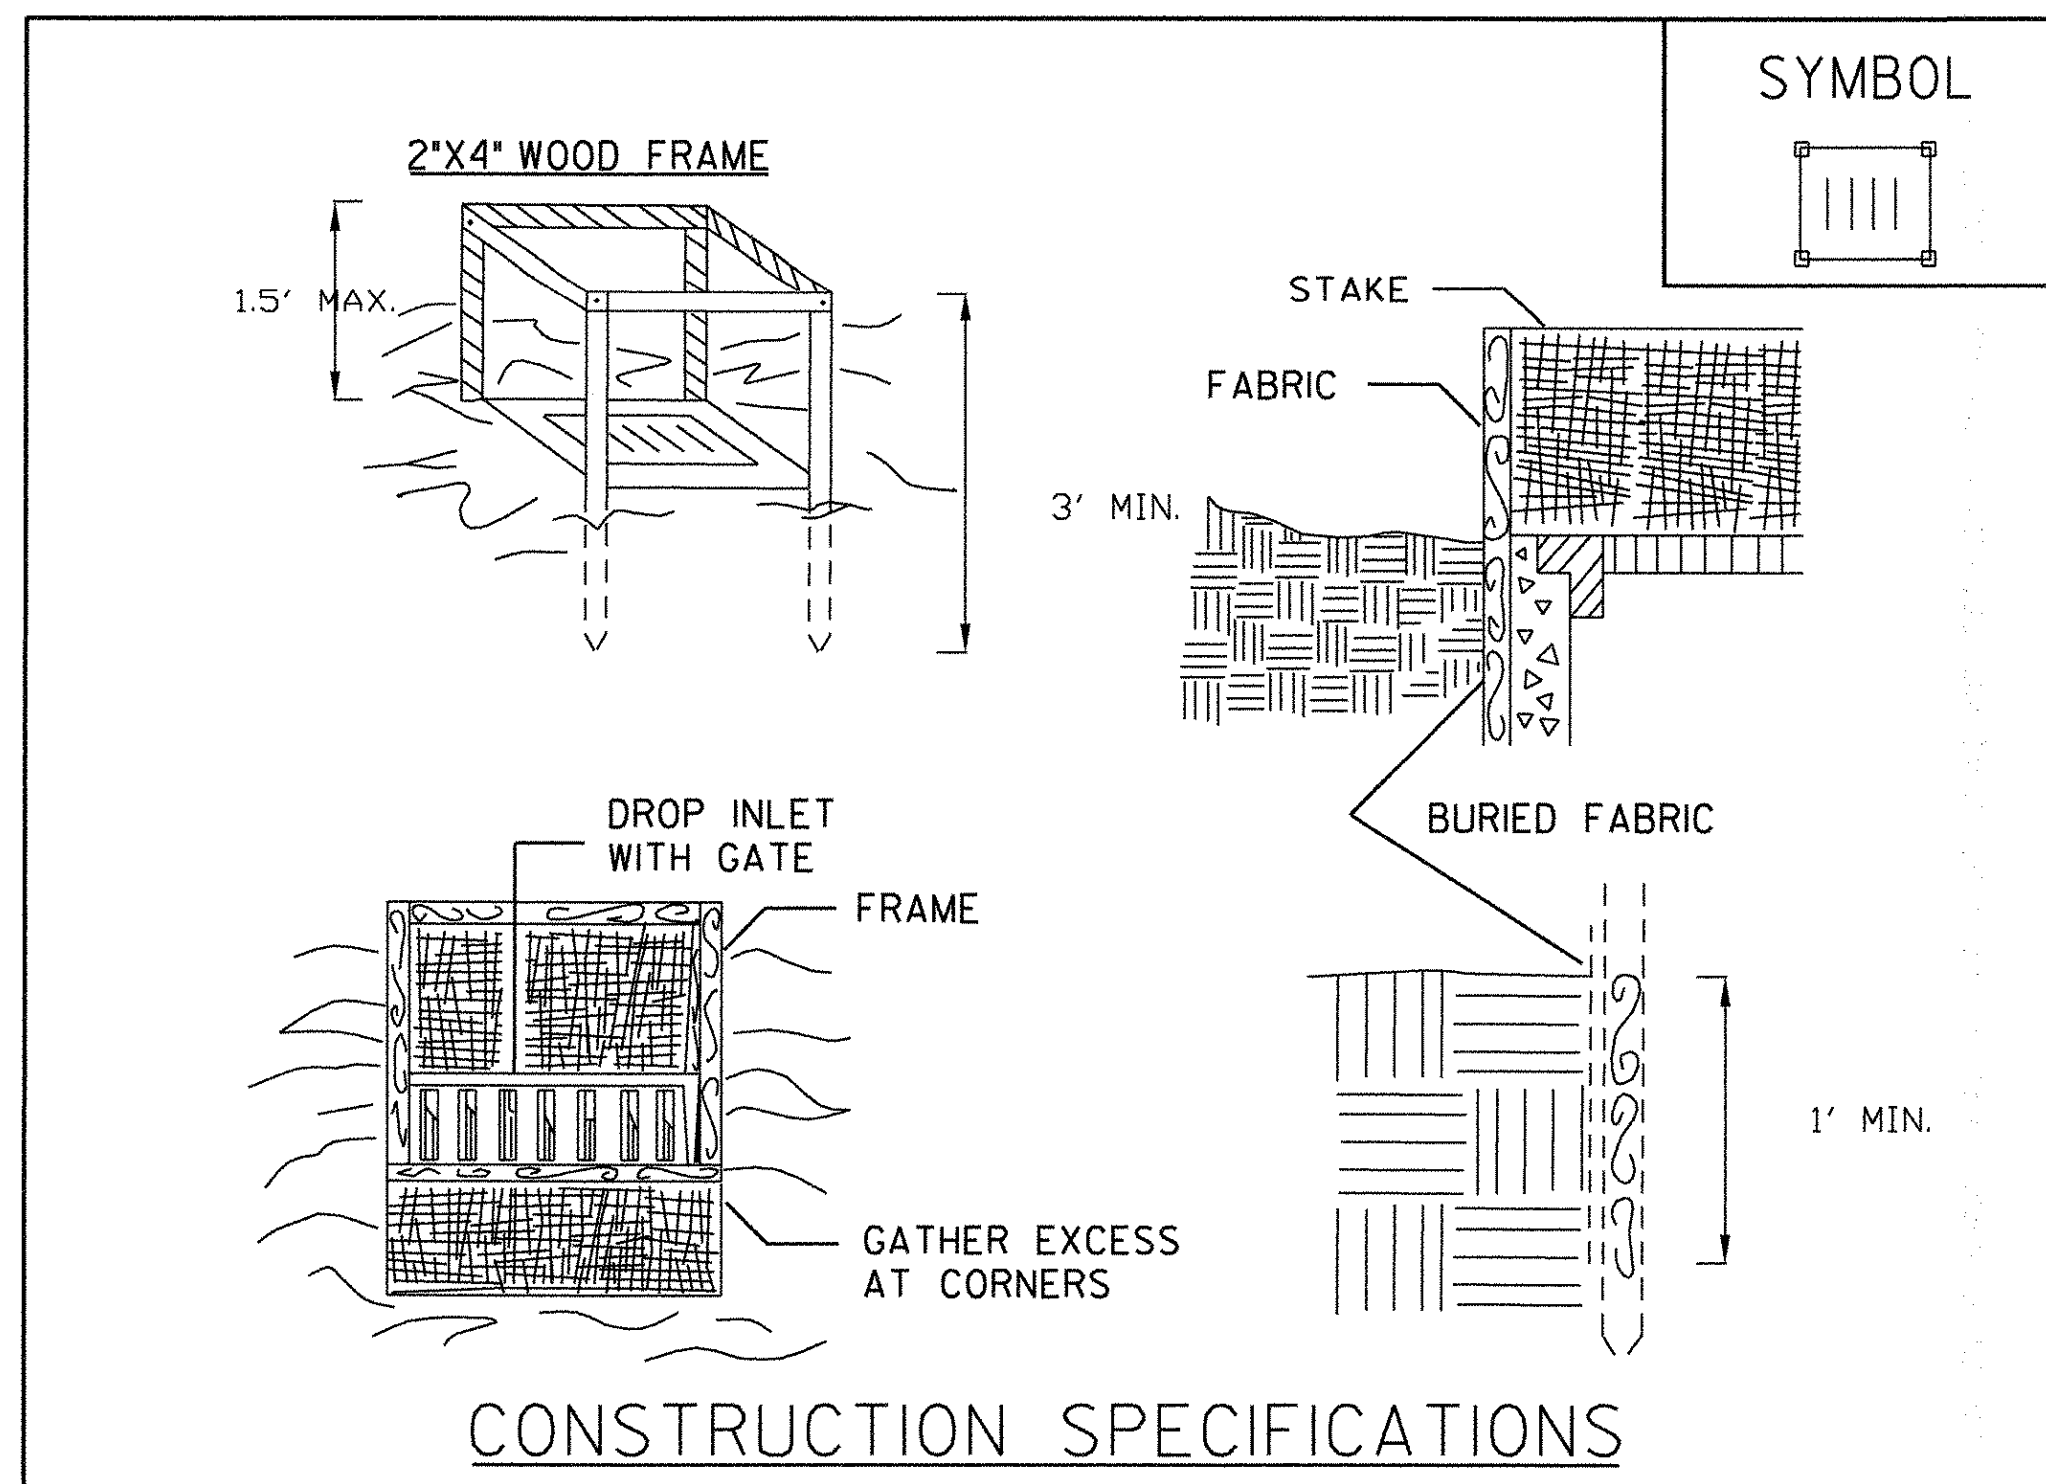

CONSTRUCTION SPECIFICATIONS

1. FILTER FABRIC SHALL HAVE AN EOS OF 40-85. BURLAP MAY BE USED FOR SHORT TERM APPLICATIONS.
 2. CUT FABRIC FROM A CONTINUOUS ROLL TO ELIMINATE JOINTS. IF JOINTS ARE NEEDED THEY WILL BE OVERLAPPED TO THE NEXT STAKE.
 3. STAKE MATERIALS WILL BE STANDARD 2" x 4" WOOD OR EQUIVALENT METAL WITH A MINIMUM LENGTH OF 3 FEET.
 4. SPACE STAKES EVENLY AROUND INLET 3 FEET APART AND DRIVE A MINIMUM 18 INCHES DEEP. SPANS GREATER THAN 3 FEET MAY BE BRIDGED WITH THE USE OF WIRE MESH BEHIND THE FILTER FABRIC FOR SUPPORT.
 5. FABRIC SHALL BE EMBEDDED 1 FOOT MINIMUM BELOW GROUND AND BACKFILLED. IT SHALL BE SECURELY FASTENED TO THE STAKES AND FRAME.
 6. A 2" x 4" WOOD FRAME SHALL BE COMPLETED AROUND THE CREST OF THE FABRIC FOR OVER FLOW STABILITY.
- MAXIMUM DRAINAGE AREA 1 ACRE


ADAPTED FROM DETAILS PROVIDED BY: NEW YORK STATE DEC
ORIGINALLY DEVELOPED BY USDA-NRCS
VERMONT DEPARTMENT OF ENVIRONMENTAL CONSERVATION

**FILTER FABRIC
DROP INLET
PROTECTION**

NOTES:
REFER TO "THE VERMONT STANDARDS & SPECIFICATIONS FOR EROSION PREVENTION & SEDIMENT CONTROL -2006-" FROM THE VT AGENCY OF NATURAL RESOURCES FOR ADDITIONAL GUIDANCE.

THIS ITEM SHALL BE PAID FOR UNDER ITEM
653.40 INLET PROTECTION DEVICE, TYPE I

REVISIONS	
MARCH 8, 2007	JMF

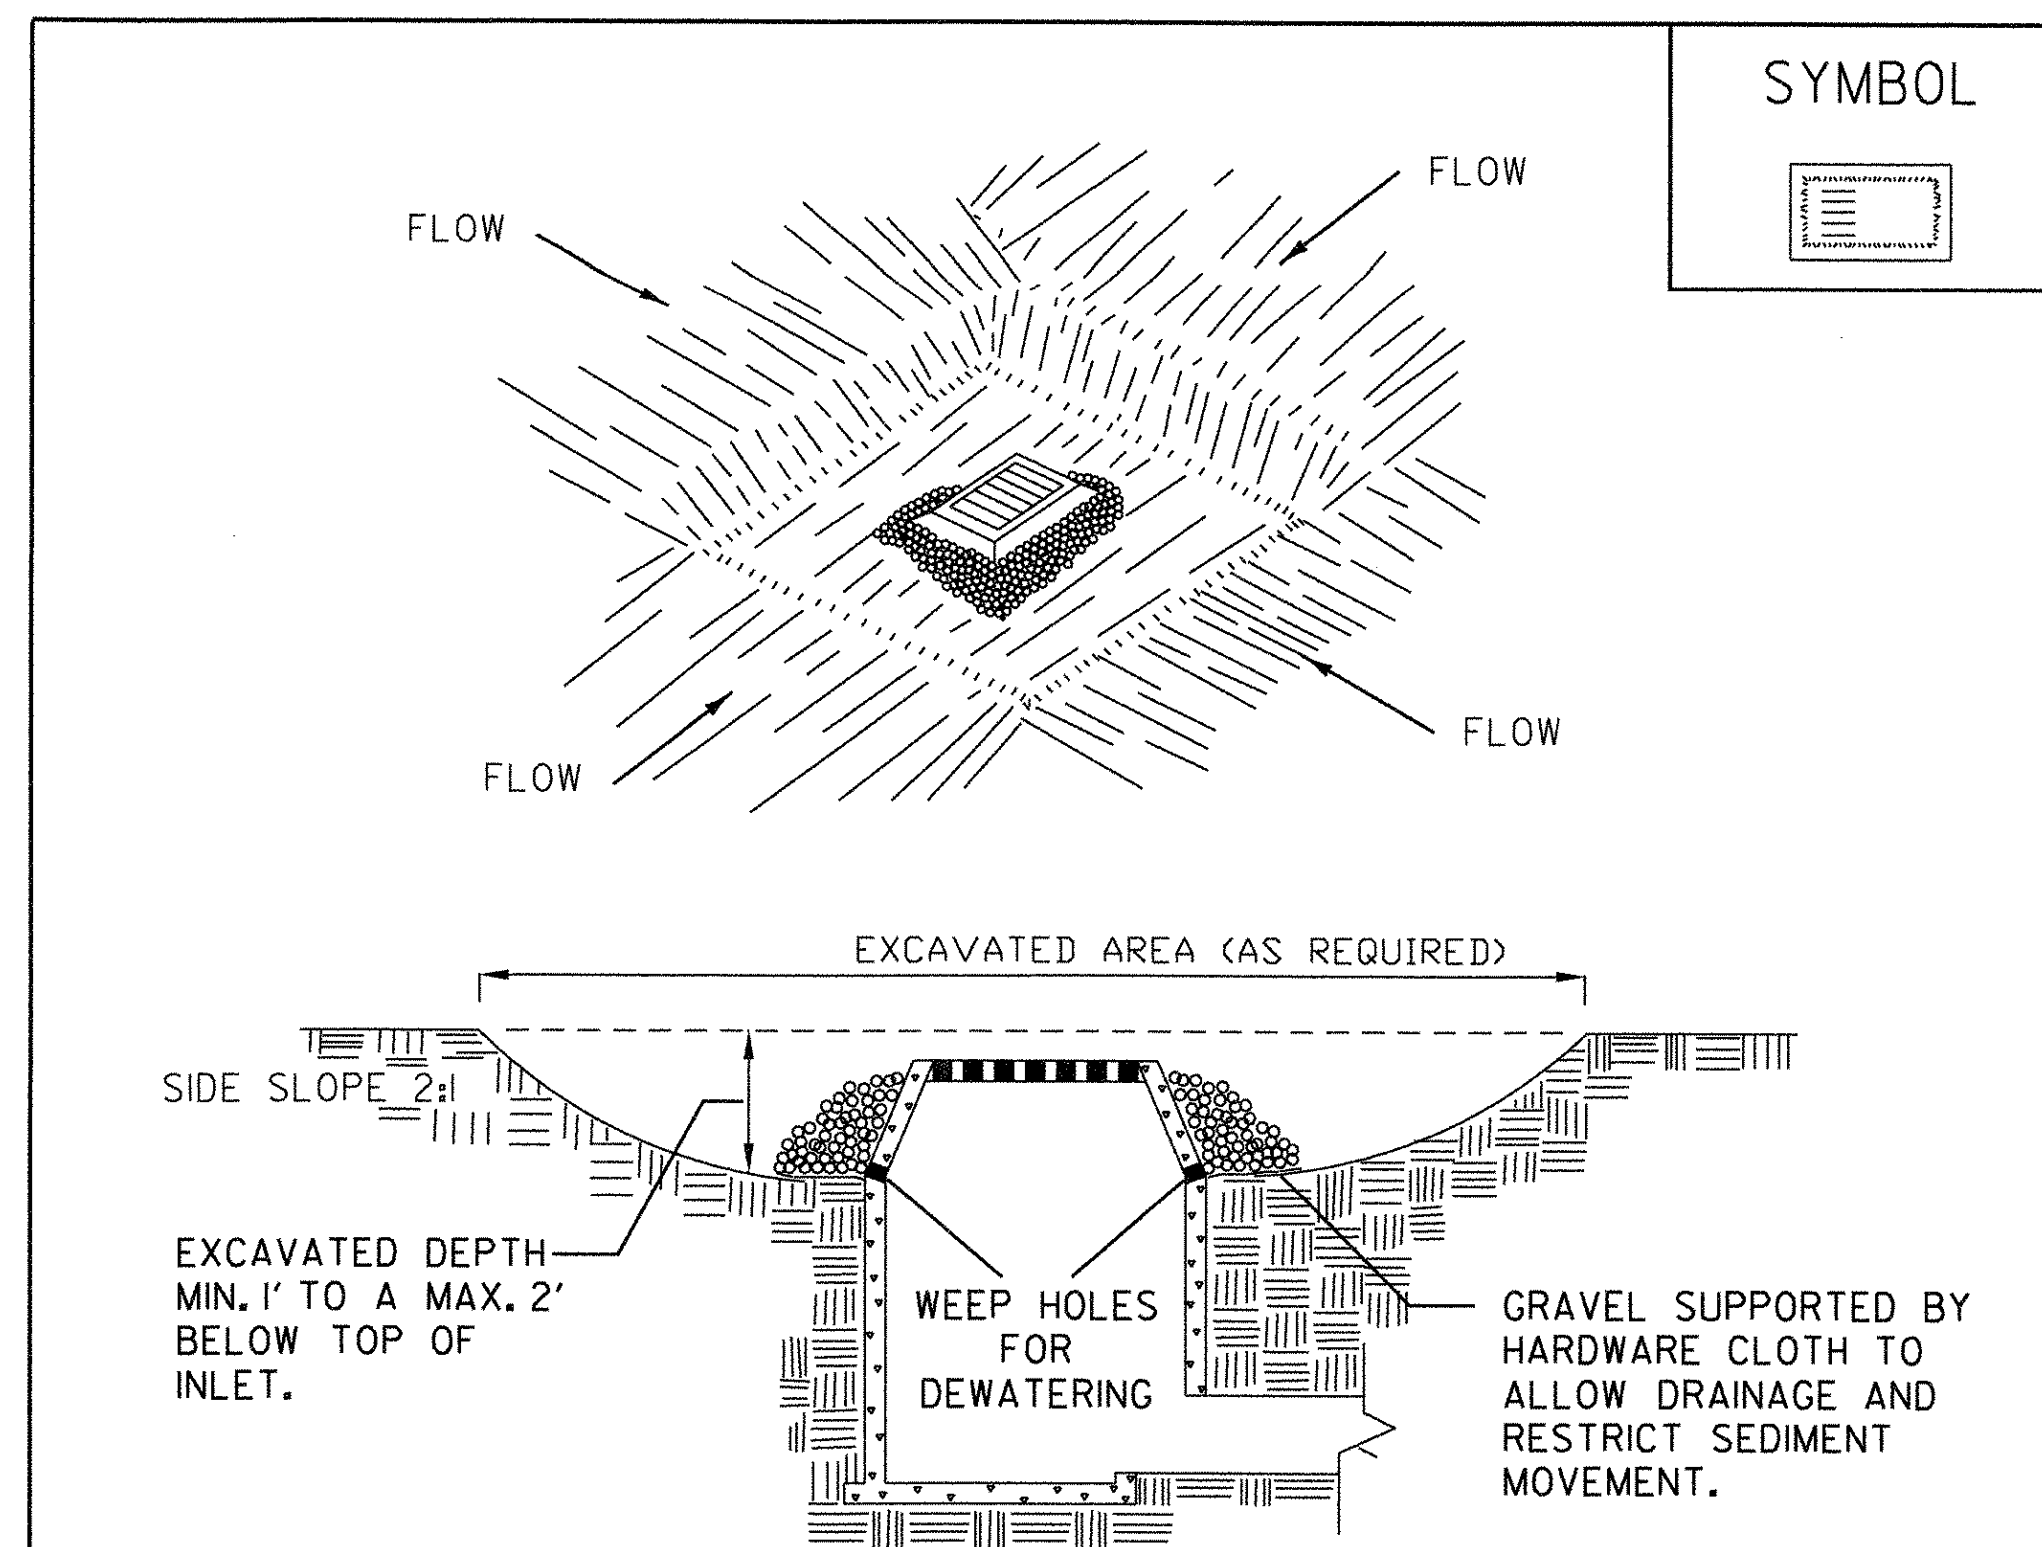

CONSTRUCTION SPECIFICATIONS


1. CLEAR THE AREA OF ALL DEBRIS THAT WILL HINDER EXCAVATION.
 2. GRADE APPROACH TO THE INLET UNIFORMLY AROUND THE BASIN.
 3. WEEP HOLES SHALL BE PROTECTED BY GRAVEL.
 4. UPON STABILIZATION OF CONTRIBUTING DRAINAGE AREA, SEAL WEEP HOLES, FILL BASIN WITH STABLE SOIL TO FINAL GRADE, COMPACT IT PROPERLY AND STABILIZE WITH PERMANENT SEEDING.
- MAXIMUM DRAINAGE AREA 1 ACRE

ADAPTED FROM DETAILS PROVIDED BY: NEW YORK STATE DEC
ORIGINALLY DEVELOPED BY USDA-NRCS
VERMONT DEPARTMENT OF ENVIRONMENTAL CONSERVATION

**EXCAVATED DROP
INLET PROTECTION**

NOTES:
REFER TO "THE VERMONT STANDARDS & SPECIFICATIONS FOR EROSION PREVENTION & SEDIMENT CONTROL -2006-" FROM THE VT AGENCY OF NATURAL RESOURCES FOR ADDITIONAL GUIDANCE.

THIS ITEM SHALL BE PAID FOR UNDER ITEM
653.40 INLET PROTECTION DEVICE, TYPE I

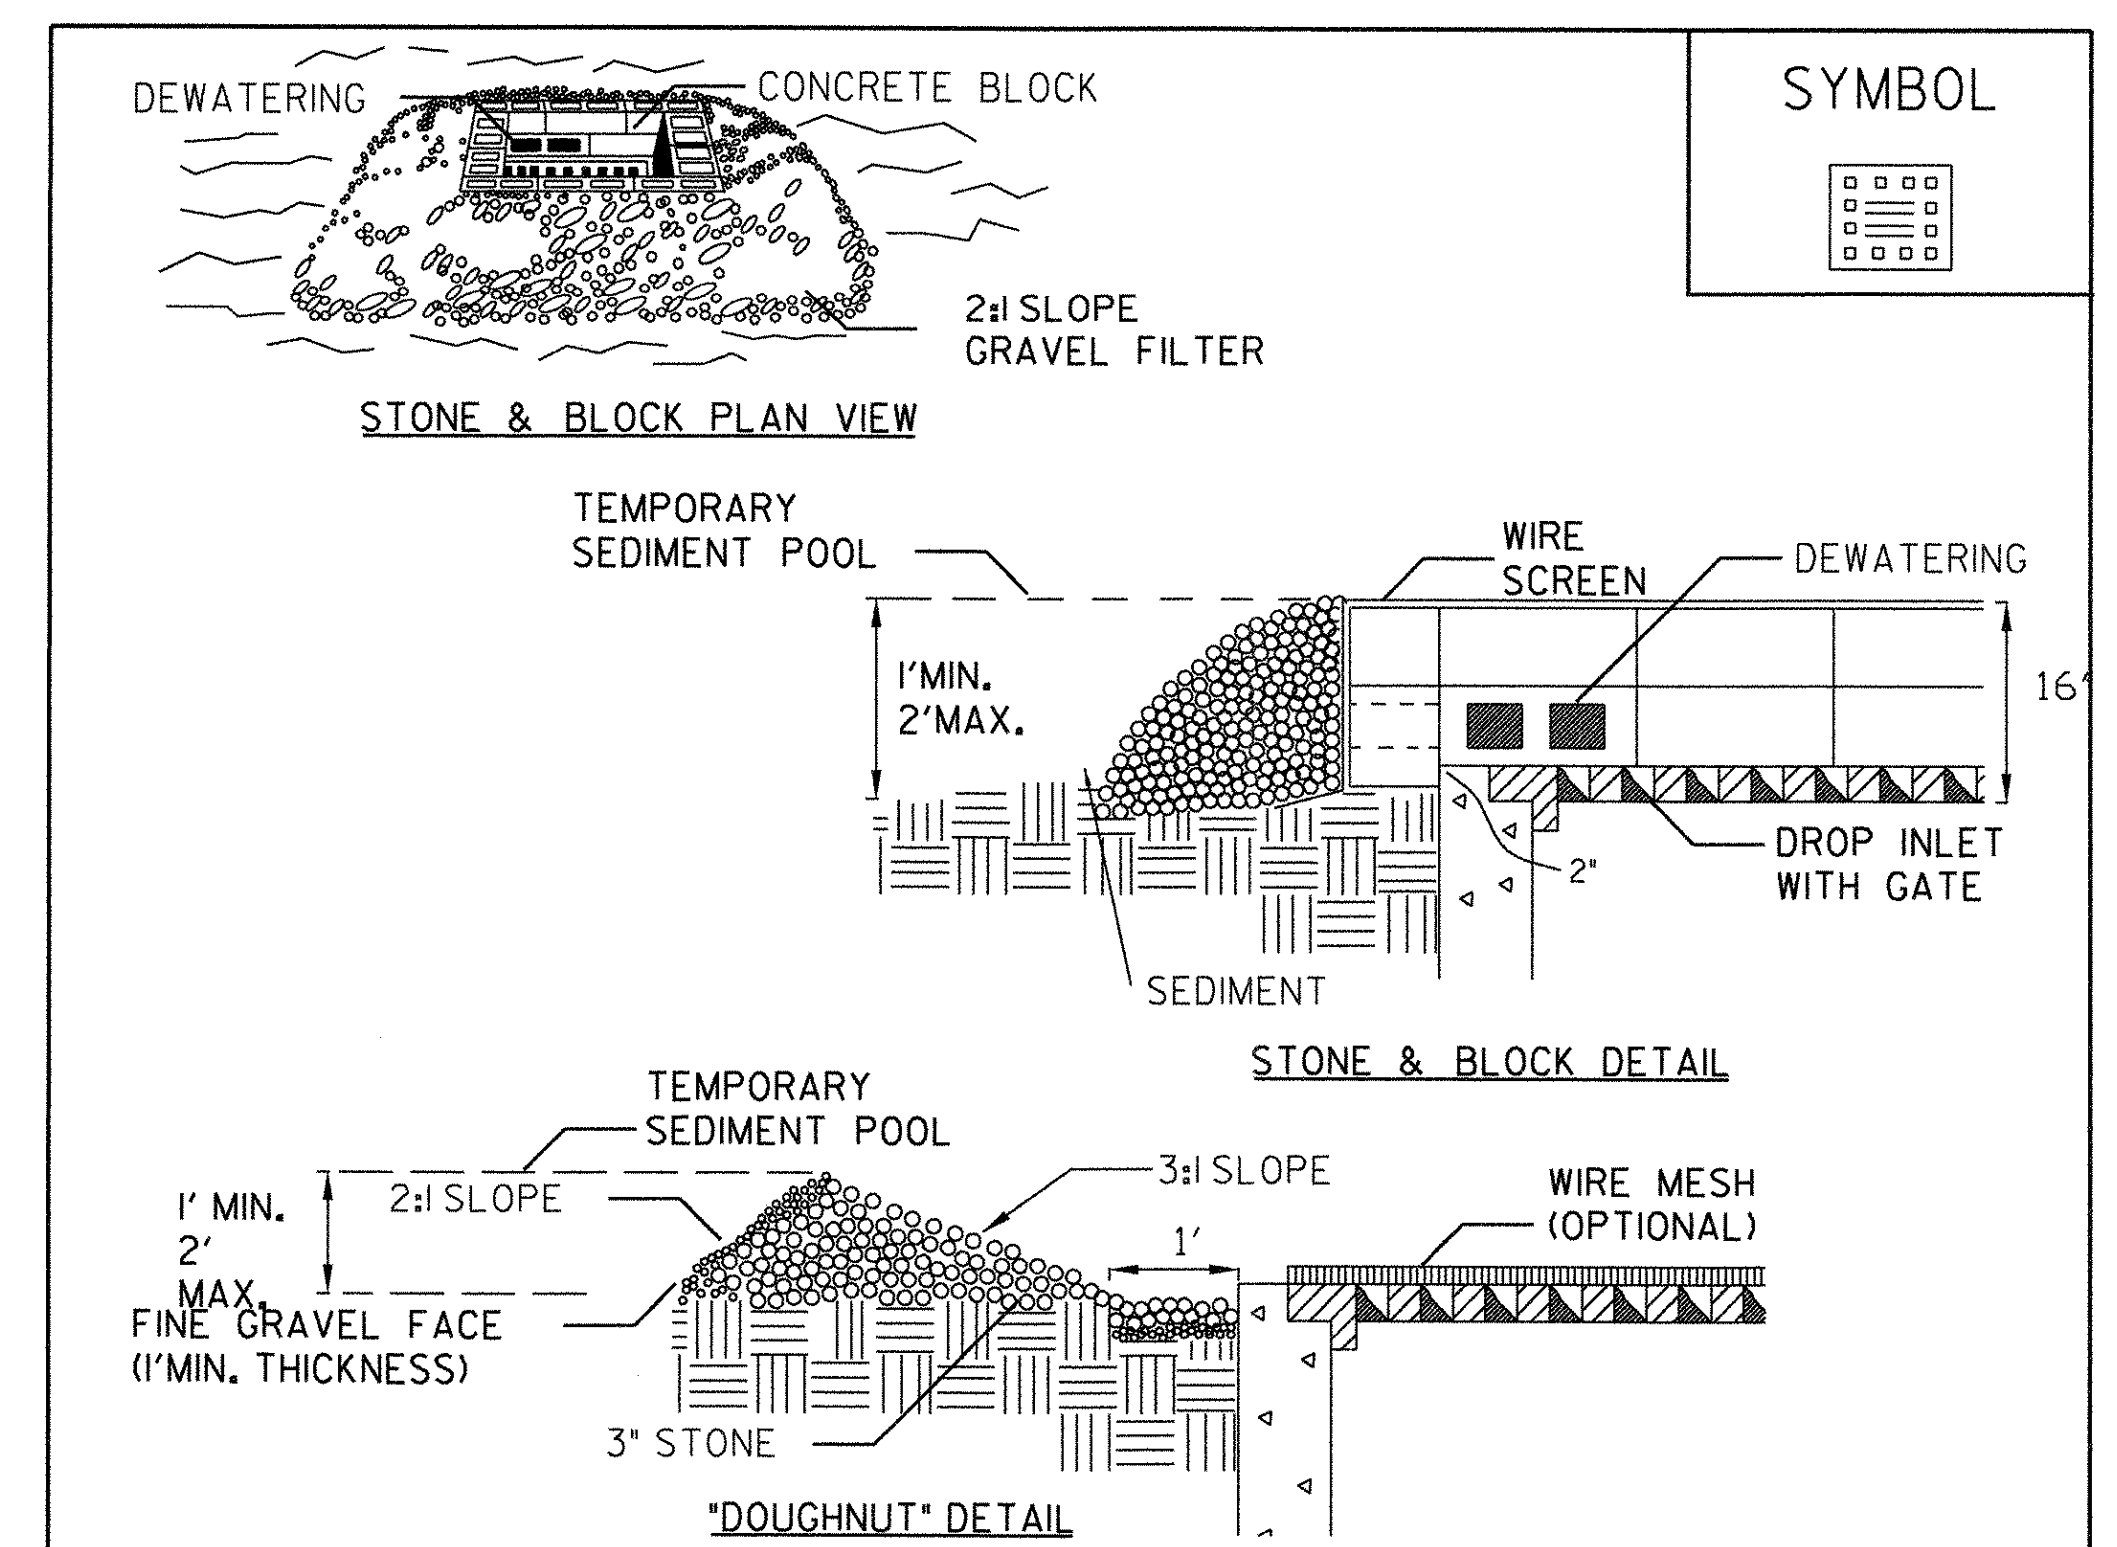

CONSTRUCTION SPECIFICATIONS

1. LAY ONE BLOCK ON EACH SIDE OF THE STRUCTURE ON ITS SIDE FOR DEWATERING. FOUNDATION SHALL BE 2 INCHES MINIMUM BELOW REST OF INLET AND BLOCKS SHALL BE PLACED AGAINST INLET FOR SUPPORT.
 2. HARDWARE CLOTH OR 1/2" WIRE MESH SHALL BE PLACED OVER BLOCK OPENINGS TO SUPPORT STONE.
 3. USE CLEAN STONE OR GRAVEL 1/2-3/4 INCH IN DIAMETER PLACED 2 INCHES BELOW TOP OF THE BLOCK ON A 2:1 SLOPE OR FLATTER.
 4. FOR STONE STRUCTURES ONLY, A 1 FOOT THICK LAYER OF THE FILTER STONE WILL BE PLACED AGAINST THE 3 INCH STONE AS SHOWN ON THE DRAWINGS.
- MAXIMUM DRAINAGE AREA 1 ACRE

ADAPTED FROM DETAILS PROVIDED BY: NEW YORK STATE DEC
ORIGINALLY DEVELOPED BY USDA-NRCS
VERMONT DEPARTMENT OF ENVIRONMENTAL CONSERVATION

**STONE & BLOCK DROP
INLET PROTECTION**

NOTES:
REFER TO "THE VERMONT STANDARDS & SPECIFICATIONS FOR EROSION PREVENTION & SEDIMENT CONTROL -2006-" FROM THE VT AGENCY OF NATURAL RESOURCES FOR ADDITIONAL GUIDANCE.

THIS ITEM SHALL BE PAID FOR UNDER ITEM
653.40 INLET PROTECTION DEVICE, TYPE I

PROJECT NAME: HINESBURG
PROJECT NUMBER: HES 021-1(20)

FILE NAME: z04b206_ero-det.dgn PLOT DATE: 2/18/2009
PROJECT LEADER: G. BAKOS DRAWN BY: D. PECK
DESIGNED BY: D. PECK CHECKED BY: G. BAKOS
EPC DETAILS SHEET 2 SHEET 16 OF 25

EXCAVATION OF SURFACES AND PAVEMENTS

STA. 1+50, LT. - SL STA. 105+00, RT.
SL STA. 104+50, LT. - STA. 3+40, LT.

COLD PLANING, BITUMINOUS PAVEMENT

SL STA. 100+75 - 101+25
STA. 1+00 - 1+50
STA. 6+31 - 6+81

RELOCATE MAILBOX, SINGLE SUPPORT

SL STA. 101+63, LT.
SL STA. 104+90, LT.
STA. 4+35, LT.
STA. 4+54, RT.
STA. 4+90, LT.
STA. 5+18, RT.
STA. 6+39, RT.
STA. 6+55, LT.

RELOCATE MAILBOX, MULTIPLE SUPPORT

STA. 3+87, LT.

VERTICAL GRANITE CURB

STA. 1+50, LT. - SL STA. 105+08, RT.
STA. 105+25, LT. - STA. 3+35, LT.
STA. 3+78 - STA. 4+28, LT.
STA. 4+86 - STA. 6+07, LT.

HAND-PLACED BITUMINOUS CONCRETE MATERIAL, DRIVES

SL STA. 101+75, RT. - 28' WIDE
SL STA. 102+73, LT. - 30' WIDE
SL STA. 105+01, LT. - 10' WIDE
STA. 3+35, RT. - 29' WIDE (COMM.)
STA. 3+57, LT. - 23' WIDE
STA. 4+43, LT. - 20' WIDE (COMM.)
STA. 4+70, LT. - 13.5' WIDE
STA. 4+73, RT. - 14.5' WIDE
STA. 5+85, RT. - 99' WIDE
STA. 6+30, LT. - 24' WIDE

TRANSPLANTING SHRUBS

SL STA. 103+00 - 104+15, RT. (14 SHRUBS)

TRANSPLANTING TREES

SL STA. 103+00 - 104+15, RT. (6 TREES)

CLEAN CULV. PIPE, IN-PLACE (0-24 IN., INCL.)

STA. 2+00, LT. - STA. 2+13, RT.
STA. 2+13, RT. - STA. 3+54, RT.
STA. 3+54, RT. - 4+13, LT.
SL STA. 101+43, RT - SL STA. 101+95, RT.

DRAINAGE NOTES

- ① STA. 2+15, RT. 25 - STA. 2+13, RT. 17
NEW PRECAST DI, TYPE A
RIM ELEV. = 355.15
NEW 18" x 5 LF CPEP (SL)
INV. OUT = 351.95
- ② STA. 2+13, RT. 17
ADJUST DI
REMOVE DI GRATE & FRAME
REPLACE WITH MH COVER & FRAME
RIM ELEV. = 356.08
- ③ STA. 3+71, RT. 41 - STA. 3+54, RT. 25
REMOVE EXIST. PRIVATE DI
NEW PRECAST DI, TYPE D
RIM ELEV. = 356.00
NEW 18" x 18 LF CPEP (SL)
INV. OUT = 352.00
INV AT EXIST DI = 351.73 (+54, RT. 25)
REMOVE EXIST. 6" PVC


DRAINAGE NOTES CONT.

- ④ STA. 3+54, RT. 25
ADJUST DI
REMOVE DI GRATE & FRAME
REPLACE WITH MH COVER & FRAME
RIM ELEV. = 356.47
- ⑤ STA. 4+88, LT. 25 - STA. 4+13, LT. 26
NEW PRECAST DI, TYPE D
RIM ELEV. = 359.69
NEW 18" x 72 LF CPEP (SL)
18" INV. OUT (S) = 354.25
- ⑥ STA. 4+05, LT. 42 - STA. 4+13 LT. 26
NEW PRECAST DI, TYPE A
RIM ELEV. = 357.64
NEW 18" x 14 LF CPEP (SL)
INV. OUT = 354.43
- ⑦ STA. 4+13, LT. 26
NEW PRECAST DI, TYPE D
RIM ELEV. = 359.27
15" INV. OUT (E) = 353.3 (Exist.)
18" INV. IN (N) = 353.55
18" INV. IN (W) = 353.65
REMOVE EXIST. CB
- ⑧ STA. 3+00, LT. 26 - SL STA. 105+25, LT. 18
NEW PRECAST DI, TYPE D
RIM ELEV. = 358.10
NEW 18 X 56 LF CPEP (SL)
INV. OUT = 352.76
- ⑨ STA. 105+10, LT. 28 - STA. 105+25, LT. 18
NEW PRECAST DI, TYPE A
RIM ELEV. = 353.00
NEW 18" x 16 LF CPEP (SL)
18" INV. OUT = 349.83

STATION 1+00
BEGIN APPROACH

DRAINAGE NOTES CONT.

- ⑩ SL STA. 105+25 LT. 18 - SL STA. 105+25, RT. 59
NEW PRECAST DI, TYPE D
RIM ELEV. = 355.05
NEW 18" x 75 LF CPEP (SL)
18" INV. OUT = 349.75
18" INV. IN (S) = 349.75
18" INV. IN (N) = 350.43
INV. AT OUTLET = 349.37
CONST. TYPE II STONE PAD (2' x 5' x 2')
- ⑪ SL STA. 103+00, LT. 21
NEW PRECAST DI, TYPE A
RIM ELEV. = 337.50
INV. OUT = 331.0 (Exist.)
- ⑫ STA. 5+03, LT. 29 - STA. 5+53, LT. 27
REMOVE 47 LF X 12" RCP
REMOVE DI, STA. 5+53, LT. 27
- ⑬ STA. 4+14, LT. 27 - STA. 5+03, LT. 29
REMOVE 83 LF X 12" RCP
REMOVE DI, STA. 5+03, LT. 29

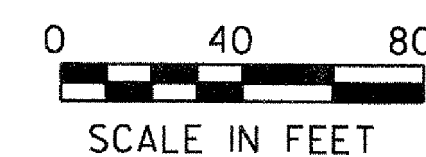

VHB Vanasse Hangen Brustlin, Inc.

VT 116		TH4 SILVER STREET	
CURVE 1 DATA	CURVE 2 DATA	CURVE 3 DATA	
A = 90° 14' 37"	A = 3° 20' 36"	A = 37° 03' 22"	
D = 33° 42' 12"	D = 1° 13' 09"	D = 22° 55' 06"	
R = 170'	R = 4700'	R = 250'	
T = 170.72'	T = 137.17'	T = 83.78'	
L = 267.76'	L = 274.26'	L = 161.69'	
E = 70.93'	E = 2.00'	E = 13.67'	

NOTES

1. THE DRAINAGE STRUCTURE RIM AND INVERT ELEVATIONS ARE BASED ON SURVEY INFORMATION FROM AERIAL SURVEY. THE CONTRACTOR SHALL SET ACTUAL RIM ELEVATIONS ONE INCH BELOW FINISHED PAVEMENT ELEVATIONS. THE CONTRACTOR SHALL FIELD CHECK PROPOSED PIPE INVERTS BEFORE ORDERING DRAINAGE STRUCTURES.
2. THE USE OF BRICK AND MORTAR TO ADJUST THE ELEVATION OF DRAINAGE STRUCTURES IS PROHIBITED. ALL ELEVATION ADJUSTMENTS SHALL BE MADE USING EITHER GRADE RINGS OR A SYNTHETIC RISER WITH ADHESIVE.
3. ALL CONNECTIONS BETWEEN PRECAST DRAINAGE STRUCTURES AND DRAINAGE PIPES SHALL BE A BOOTED CONNECTION.


PROJECT NAME: HINESBURG
PROJECT NUMBER: HES 021-1(20)


FILE NAME: z04b206 BDR.dgn
PROJECT LEADER: G. BAKOS
DESIGNED BY: D. PECK
GENERAL PLAN

PLOT DATE: 2/18/2009
DRAWN BY: D. PECK
CHECKED BY: G. BAKOS
SHEET 17 OF 25


LEGEND

	SILT FENCE
	PROJECT DEMARCATION FENCE
	LIMITS OF SOIL DISTURBANCE
	EROSION MATTING
	CHECK DAM
	INLET PROTECTION DEVICES

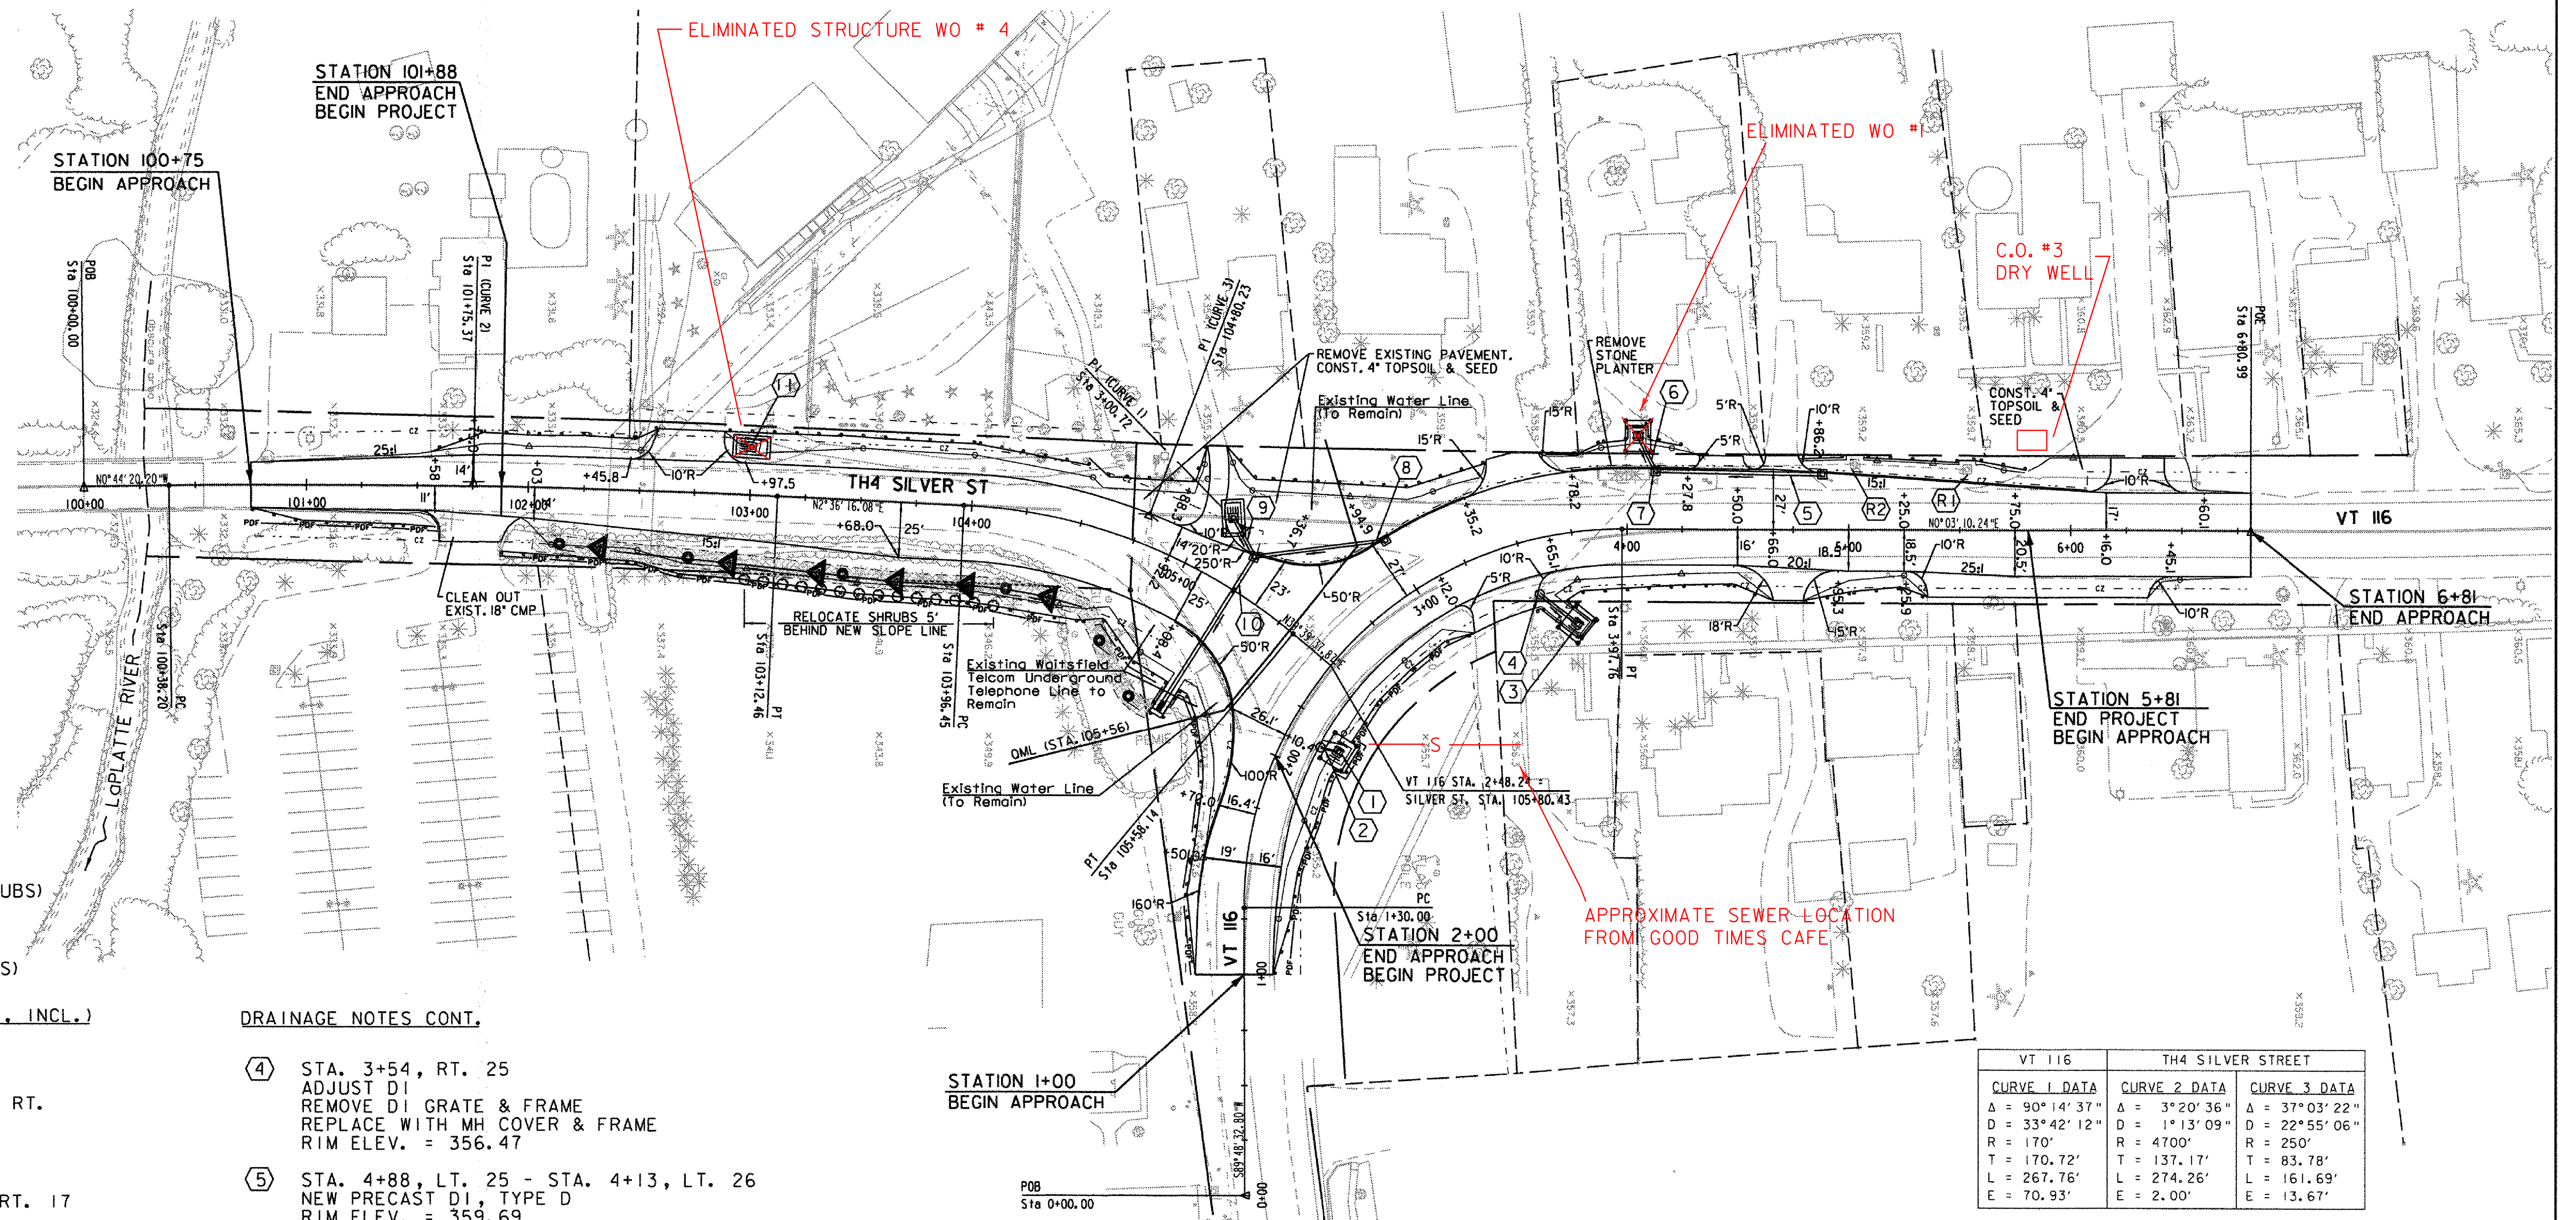

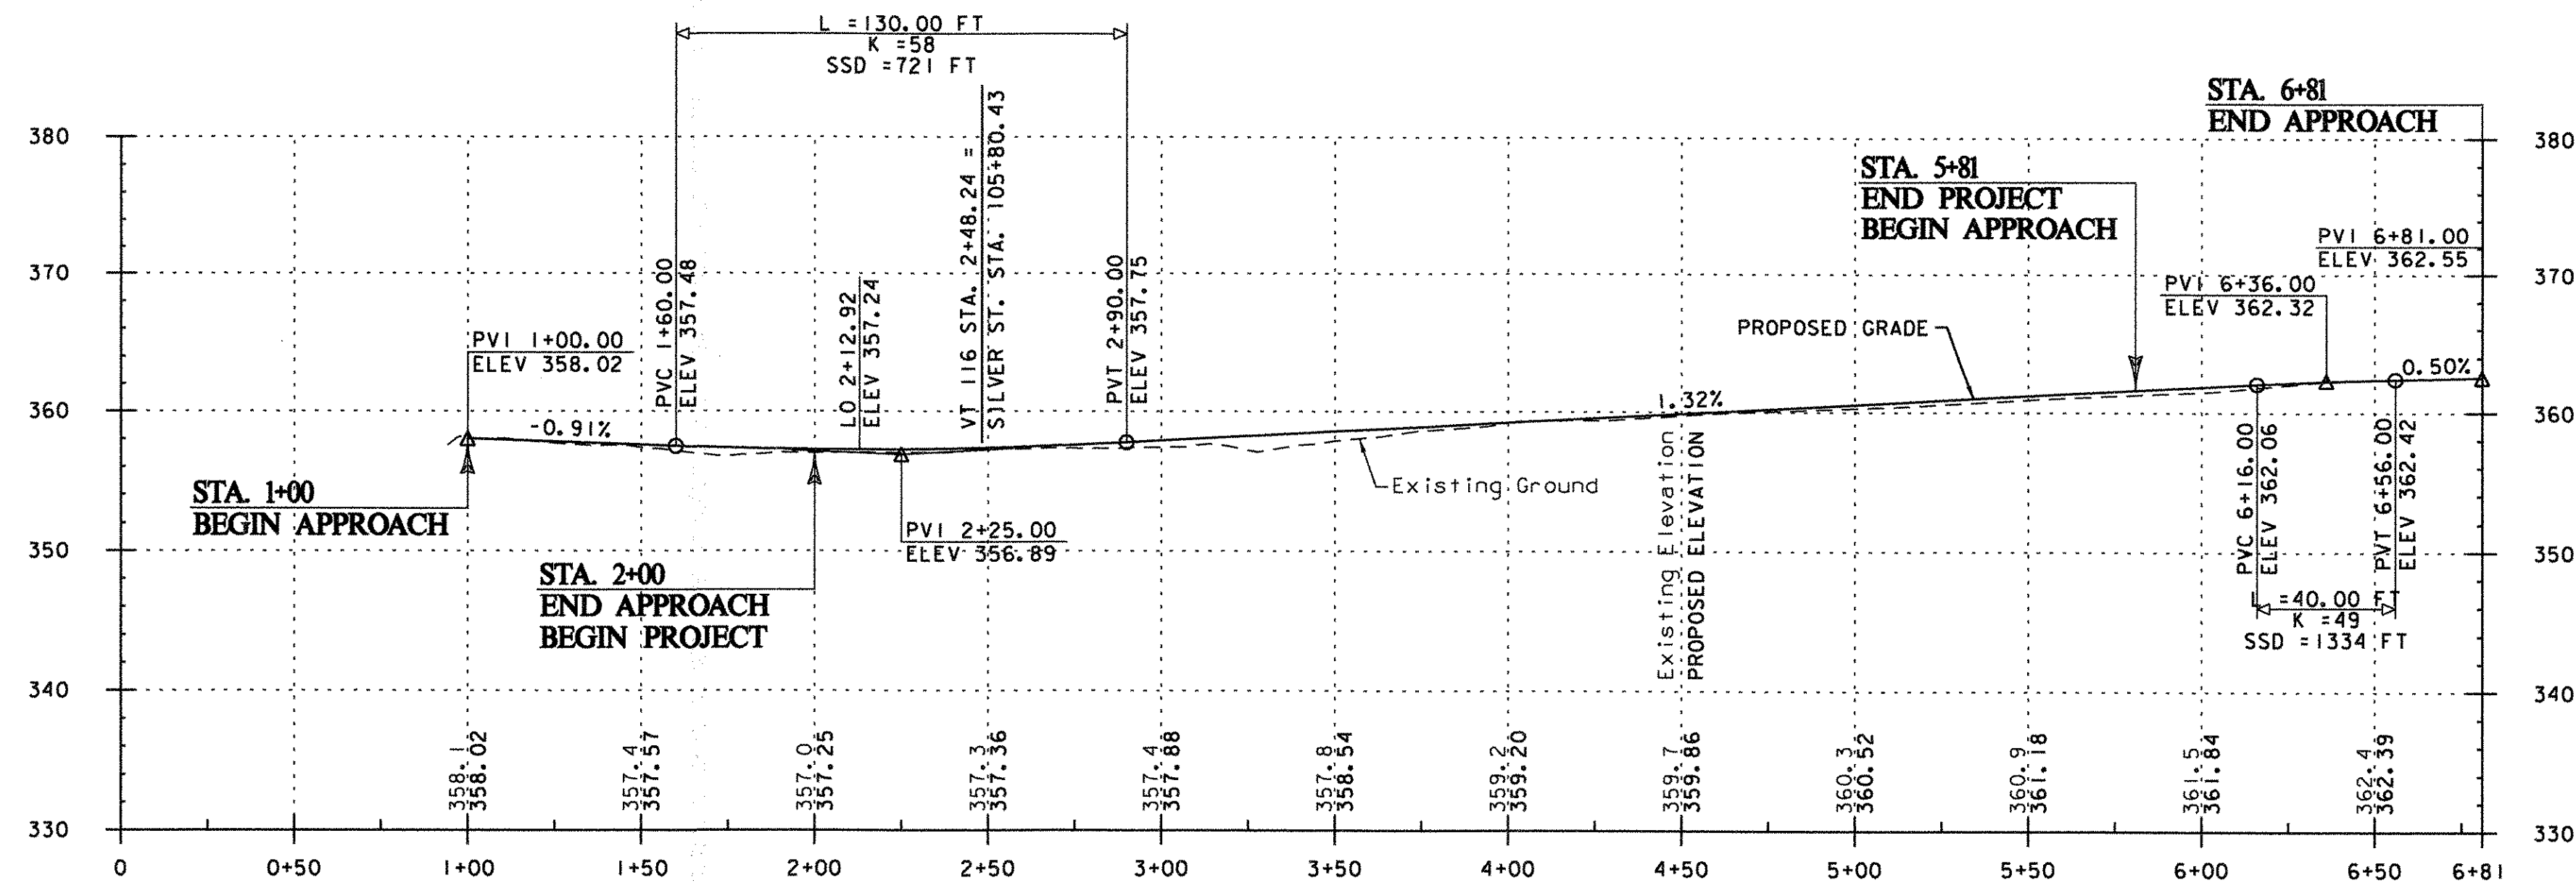


PROFILE VT ROUTE 116

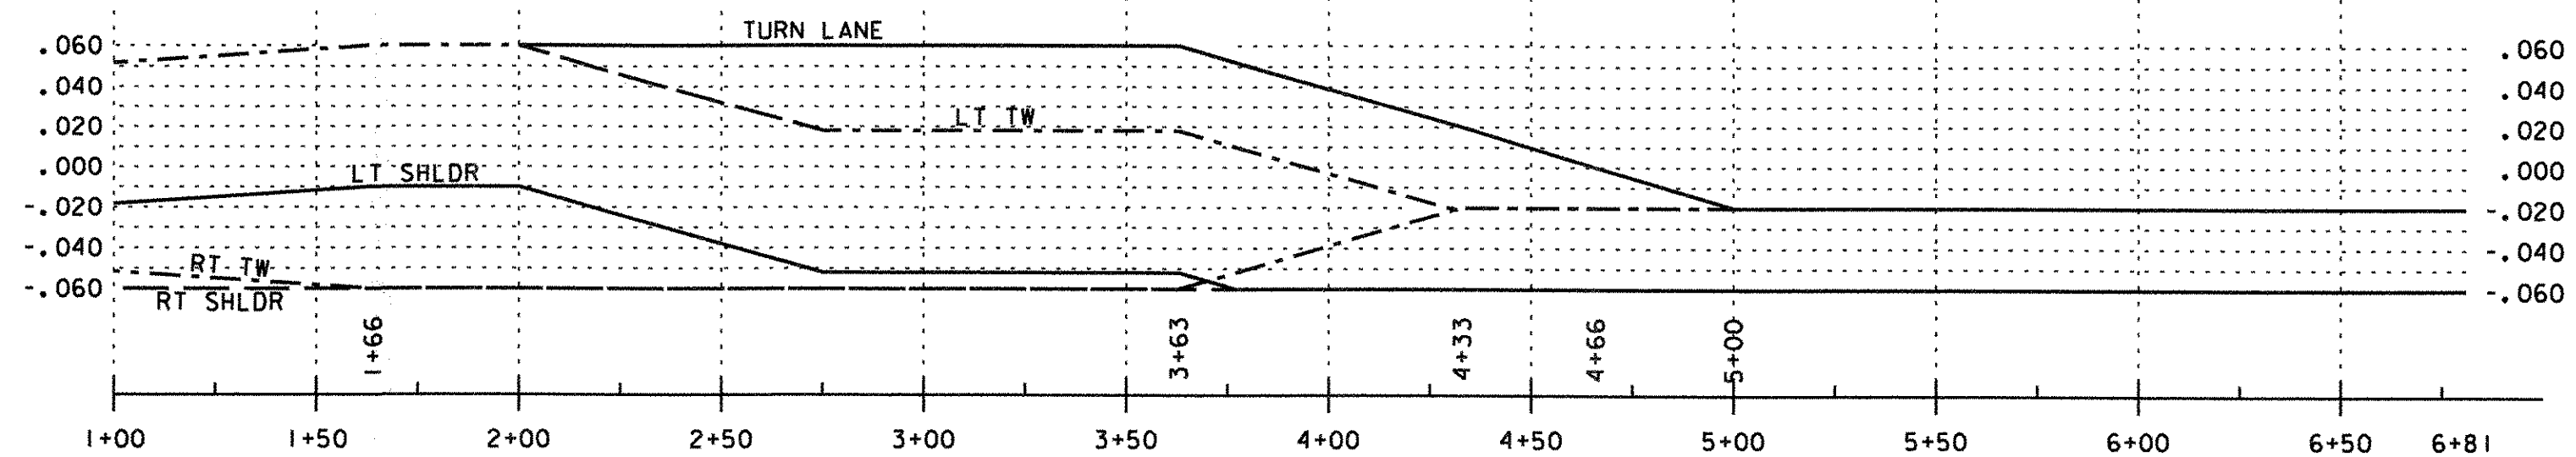


VT ROUTE 116 BANKING PROFILE

NOTE:
GRADES ARE SHOWN ALONG PROPOSED CENTERLINE.
GRADES SHOWN TO 0.1 FT ARE EXISTING GROUND.
GRADES SHOWN TO 0.10 FT ARE FINISH GRADE.

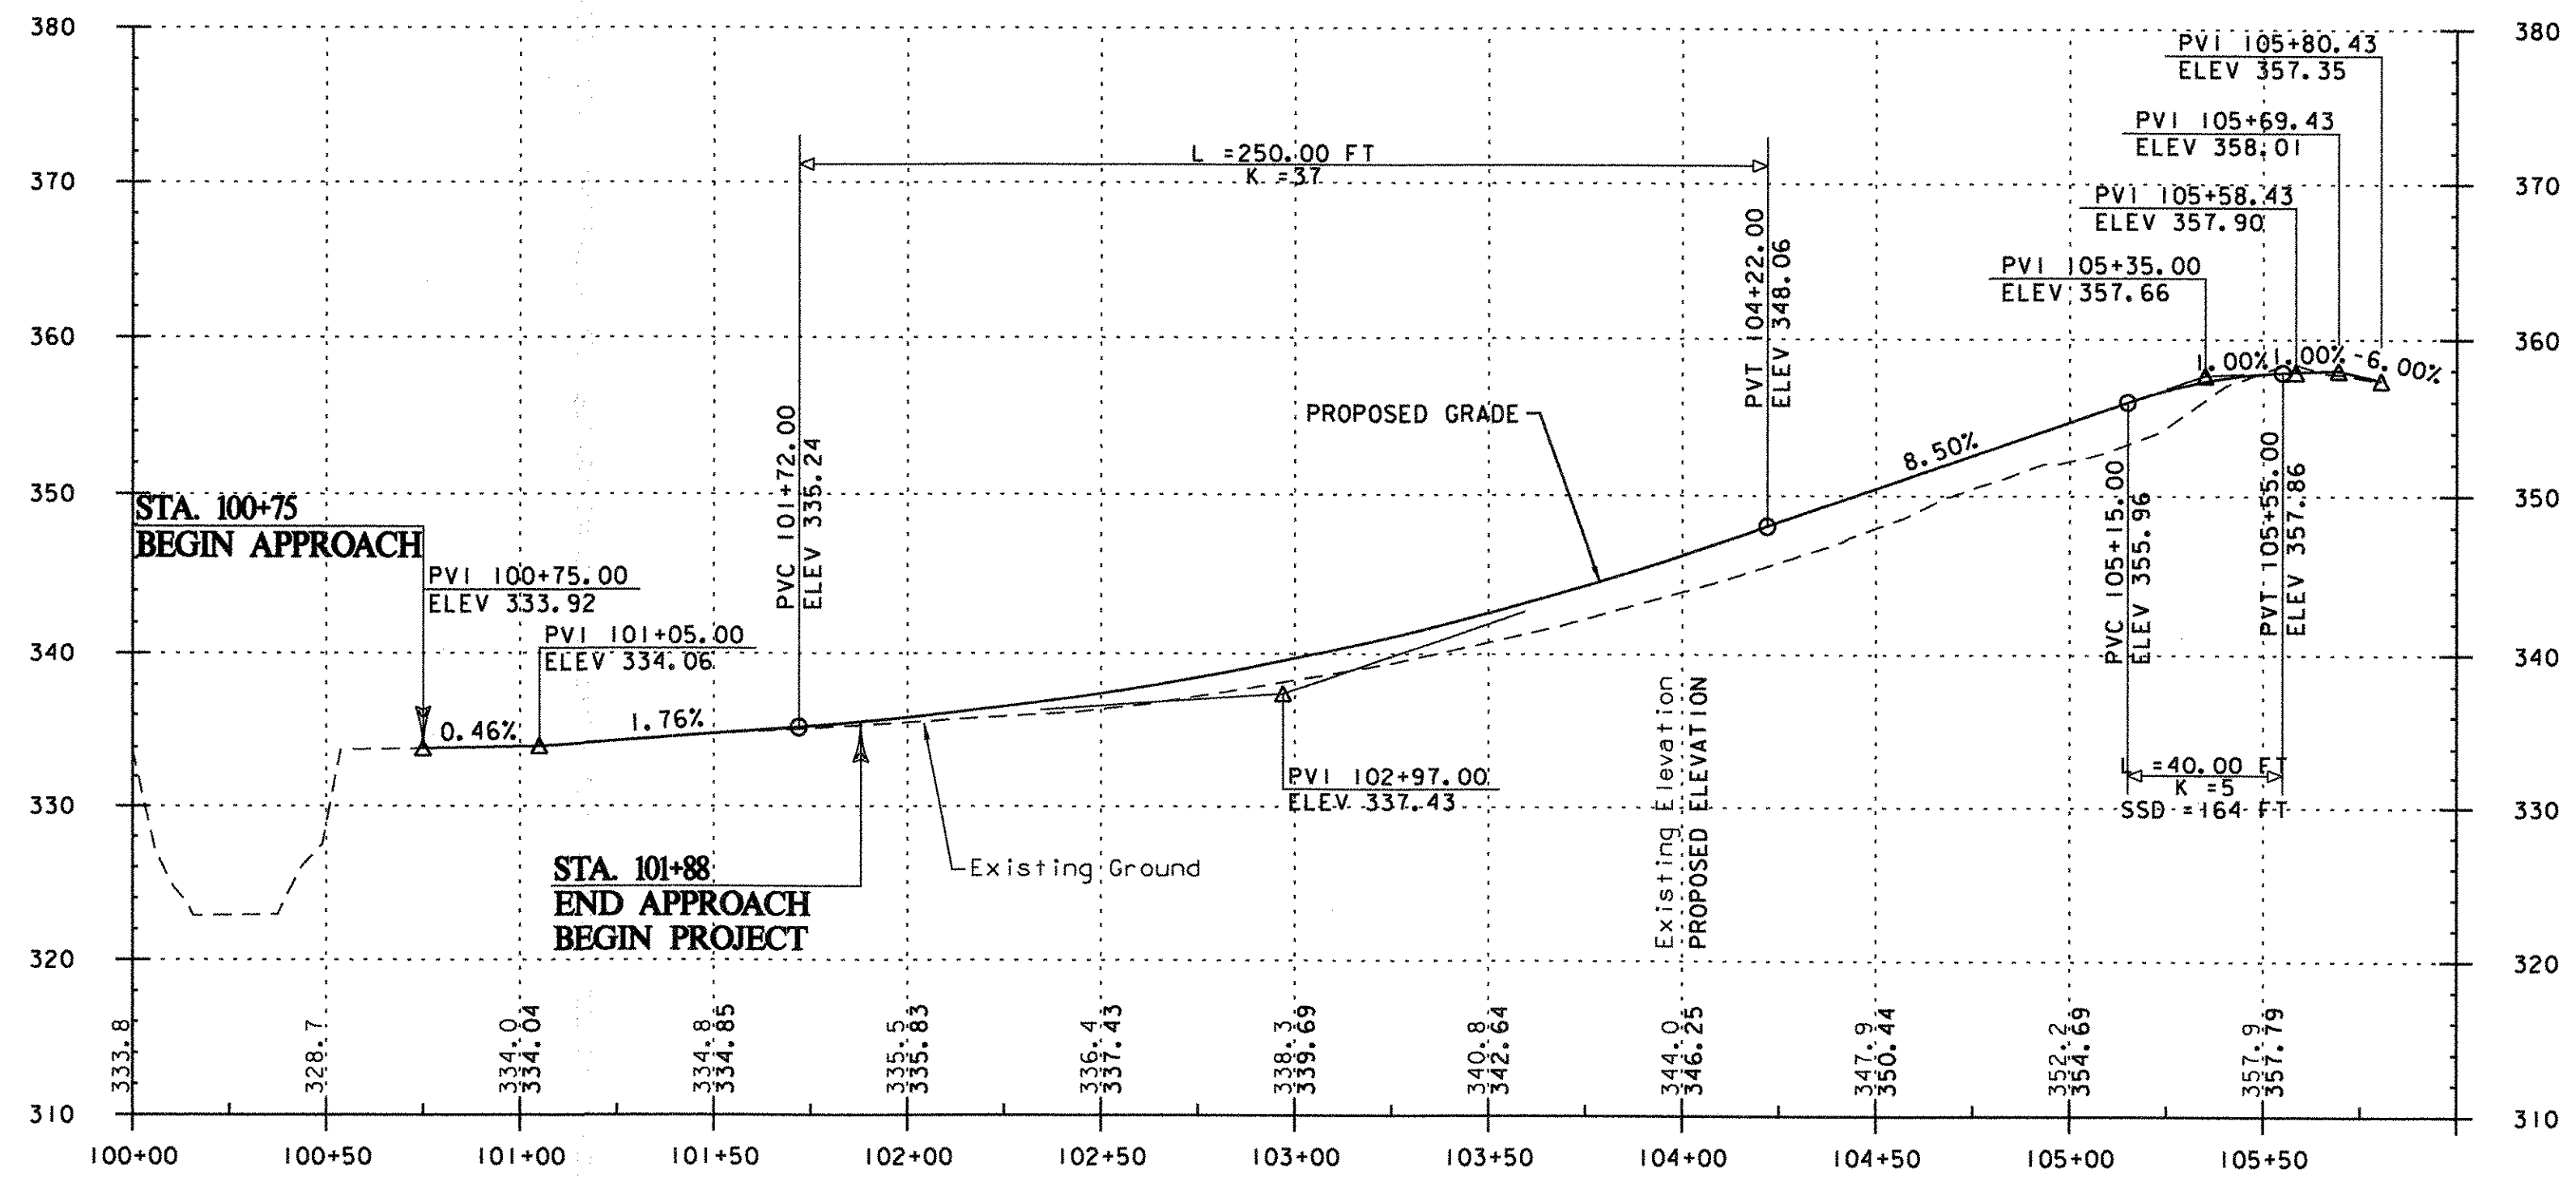

PROFILE SILVER ST

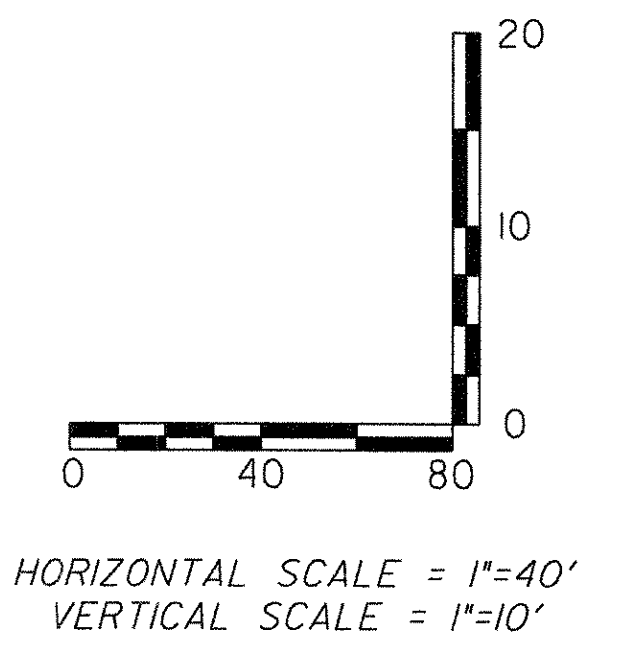

PROJECT NAME: HINESBURG
PROJECT NUMBER: HES 021-1(20)

FILE NAME: z04b206pro.dgn
PROJECT LEADER: G. BAKOS
DESIGNED BY: D. PECK
PROFILES

PLOT DATE: 2/18/2009
DRAWN BY: D. PECK
CHECKED BY: G. BAKOS
SHEET 18 OF 25



DURABLE 4 INCH WHITE LINE, THERMOPLASTIC

SL STA. 102+03 - STA. 105+46, RT.
 SL STA. 101+75, LT. - STA. 6+81, LT.
 SL STA. 103+68 - SL STA. 105+46, RT.
 STA. 1+00 - STA. 2+07, LT.
 STA. 1+00 - STA. 6+81, RT.
 STA. 2+76 - STA. 4+66, LT.

DURABLE 4-INCH YELLOW LINE, THERMOPLASTIC

SL STA. 100+75 - SL STA. 105+48
 STA. 1+00 - STA. 2+37
 STA. 2+76 - STA. 6+81

DURABLE 24-INCH STOP BAR, THERMOPLASTIC

SL STA. 105+46, RT.

DURABLE LETTER OR SYMBOL, THERMOPLASTIC

SL STA. 103+69, RT. (LEFT TURN ARROW)
 SL STA. 103+69, RT. (RIGHT TURN ARROW)
 SL STA. 104+09, RT. ("ONLY")
 SL STA. 104+09, RT. ("ONLY")
 SL STA. 104+50, RT. (LEFT TURN ARROW)
 SL STA. 104+50, RT. (RIGHT TURN ARROW)
 SL STA. 104+91, RT. ("ONLY")
 SL STA. 104+91, RT. ("ONLY")
 SL STA. 105+32, RT. (LEFT TURN ARROW)
 SL STA. 105+32, RT. (RIGHT TURN ARROW)
 STA. 2+98, LT. (RIGHT TURN ARROW)
 STA. 3+40, LT. ("ONLY")
 STA. 3+82, LT. (RIGHT TURN ARROW)
 STA. 4+24, LT. ("ONLY")
 STA. 4+66, LT. (RIGHT TURN ARROW)

TEMPORARY 4 INCH YELLOW LINE

SL STA. 100+75 - SL STA. 105+48
 STA. 1+00 - STA. 2+37
 STA. 2+76 - STA. 6+81

TEMPORARY 4 INCH WHITE LINE

STA. 2+76 - STA. 4+66, LT.
 SL STA. 103+68 - SL STA. 104+46, RT.

TEMPORARY 24 INCH STOP BAR

SL STA. 105+46, RT.

TEMPORARY LETTER OR SYMBOL

STA. 2+98, LT. (RIGHT TURN ARROW)
 STA. 3+82, LT. ("ONLY")
 STA. 4+66, LT. (RIGHT TURN ARROW)

REMOVING SIGNS

SL STA. 102+21, RT.
 SL STA. 105+25, LT.
 SL STA. 105+38, RT.
 STA. 1+95, LT.
 STA. 2+80, LT.
 STA. 2+97, LT. (2 SIGNS)
 STA. 4+14, LT. (3 SIGNS)
 STA. 7+94, LT. (2 SIGNS)

ERECTING SALVAGED SIGNS


SL STA. 104+66, LT.

SPECIAL PROVISION (RELOCATE SIGN, COMMERCIAL/LIGHTED)

STA. 4+00, LT. (3 SIGNS)


SPECIAL PROVISION (RELOCATE FLASHING BEACON, GROUND MOUNTED)

STA. 5+51, LT.

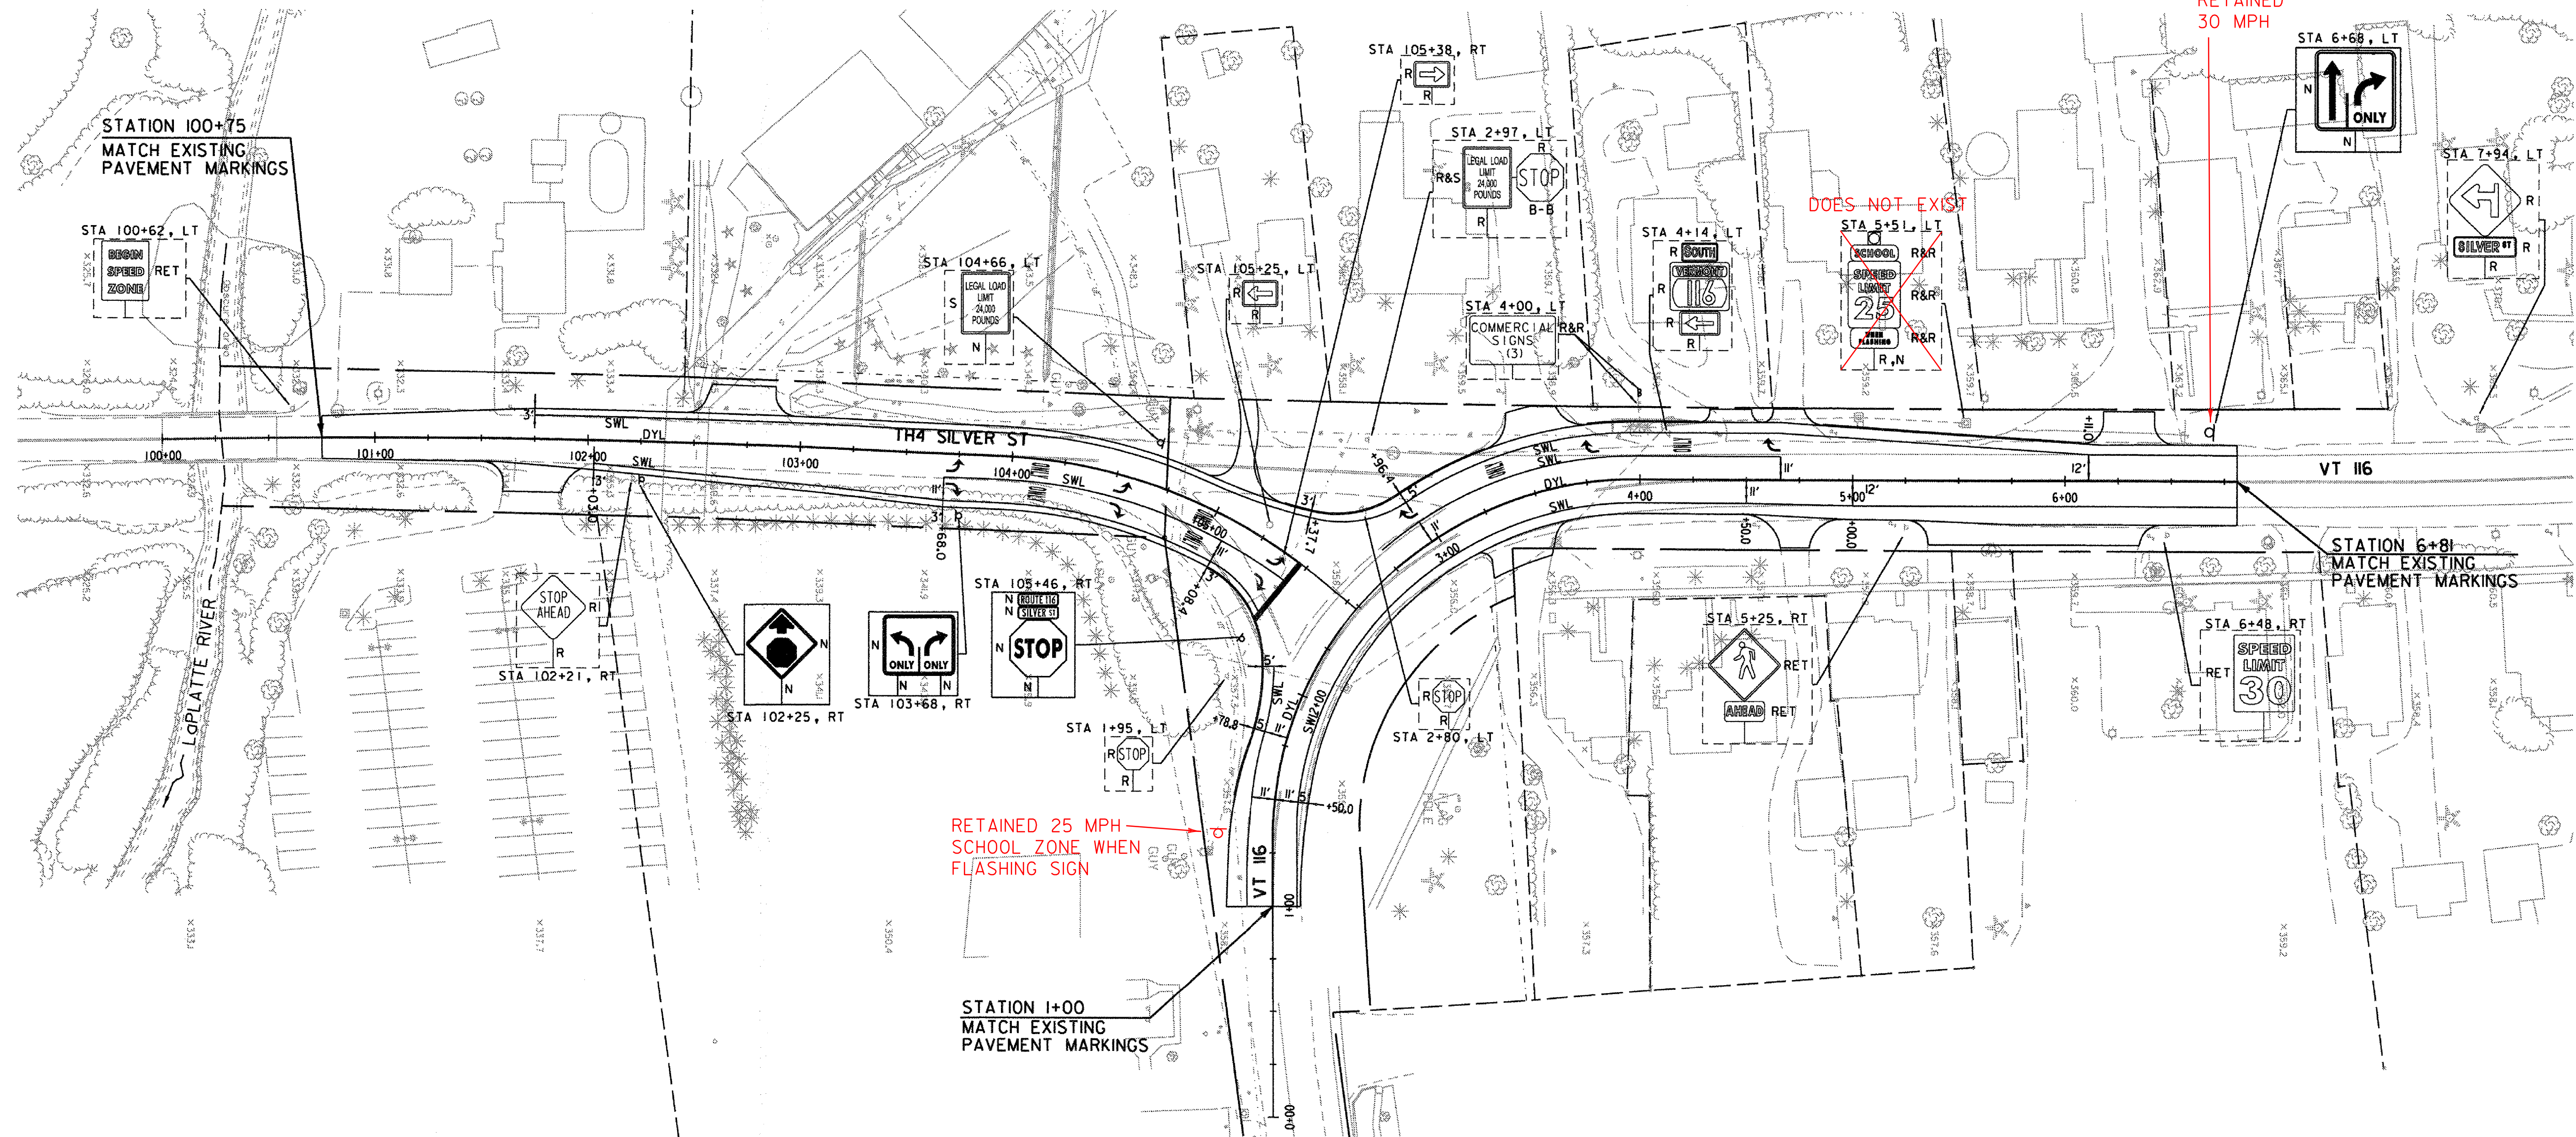

SIGN LEGEND	
N	= NEW
R	= REMOVE
S	= SALVAGED SIGN
B-B	= BACK TO BACK
RET	= RETAIN
R&R	= REMOVE & RESET
R&S	= REMOVE & SALVAGE SIGN


STRIPING LEGEND	
SWL	= SINGLE WHITE LINE
DYL	= DOUBLE YELLOW LINE

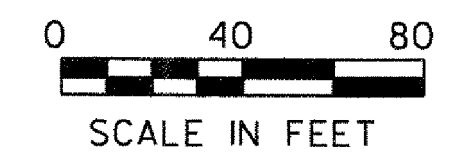

NOTE:
 ALL SIGNS REMOVED AND NOT REUSED ON THE PROJECT WILL BE RETURNED TO THE DISTRICT 5 OFFICES, COLCHESTER, VT FOR REUSE.

PROJECT NAME:	HINESBURG
PROJECT NUMBER:	HES 021-1(20)
FILE NAME:	z04b206 BDR Sign.dgn
PROJECT LEADER:	G. BAKOS
DESIGNED BY:	D. PECK
SIGNING AND STRIPING PLAN	
PLOT DATE:	2/18/2009
DRAWN BY:	D. PECK
CHECKED BY:	G. BAKOS
SHEET	19 OF 25




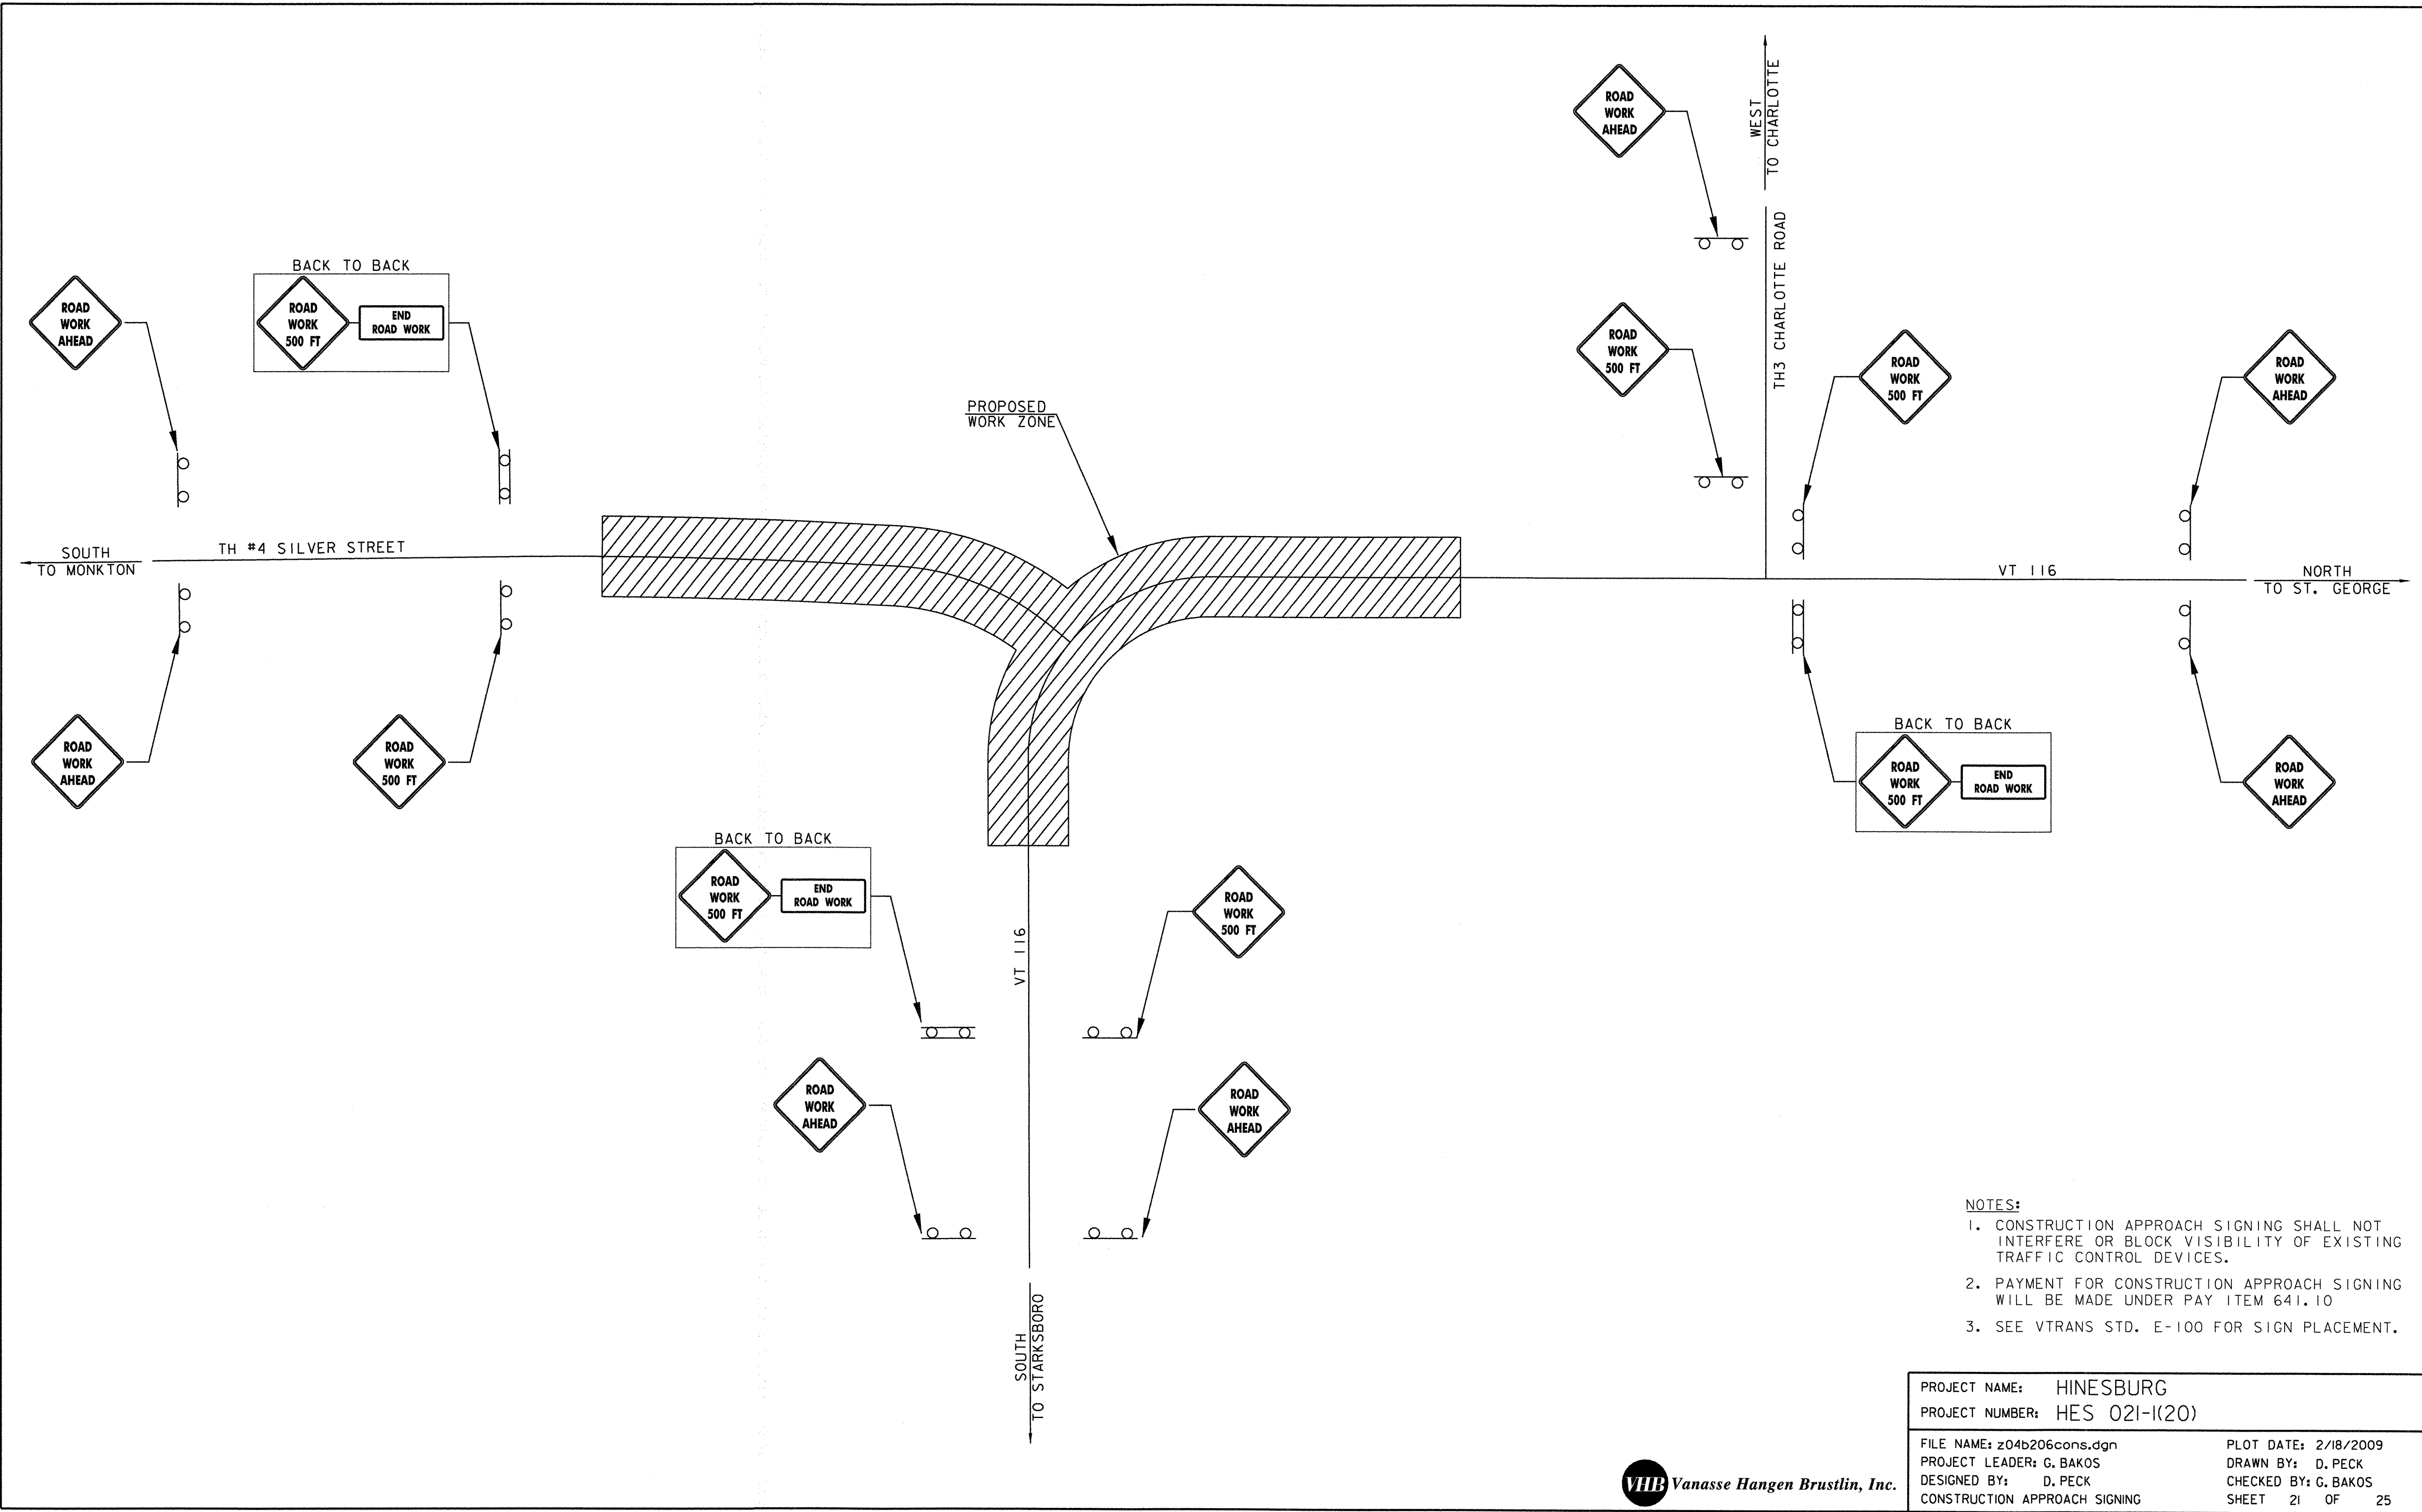


- NOTES:**
1. CONSTRUCTION APPROACH SIGNING SHALL NOT INTERFERE OR BLOCK VISIBILITY OF EXISTING TRAFFIC CONTROL DEVICES.
 2. PAYMENT FOR CONSTRUCTION APPROACH SIGNING WILL BE MADE UNDER PAY ITEM 641.10
 3. SEE VTRANS STD. E-100 FOR SIGN PLACEMENT.

PROJECT NAME:	HINESBURG
PROJECT NUMBER:	HES 021-1(20)
FILE NAME:	z04b206cons.dgn
PROJECT LEADER:	G. BAKOS
DESIGNED BY:	D. PECK
CONSTRUCTION APPROACH SIGNING	
PLOT DATE:	2/18/2009
DRAWN BY:	D. PECK
CHECKED BY:	G. BAKOS
SHEET	21 OF 25




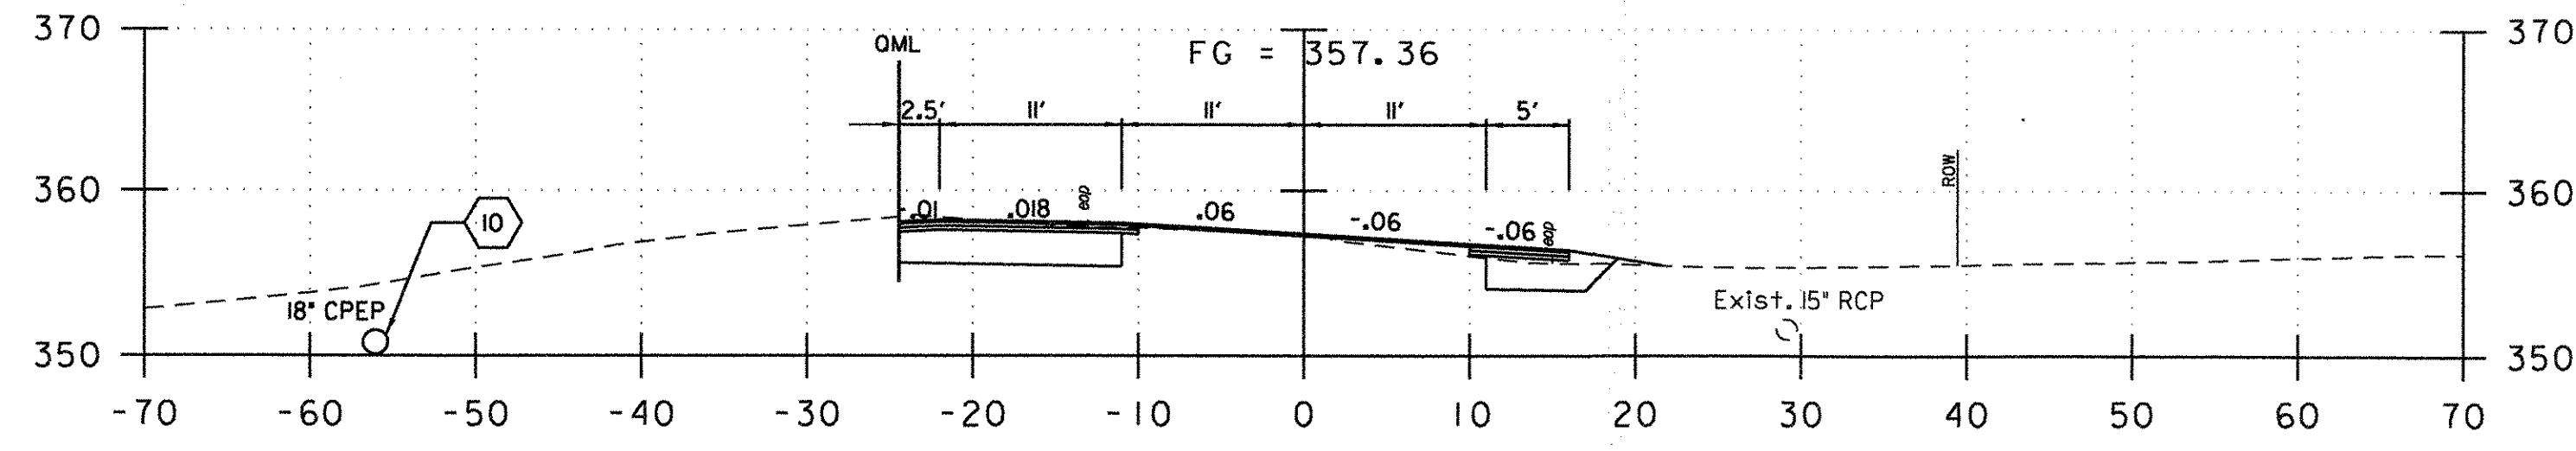


2+50

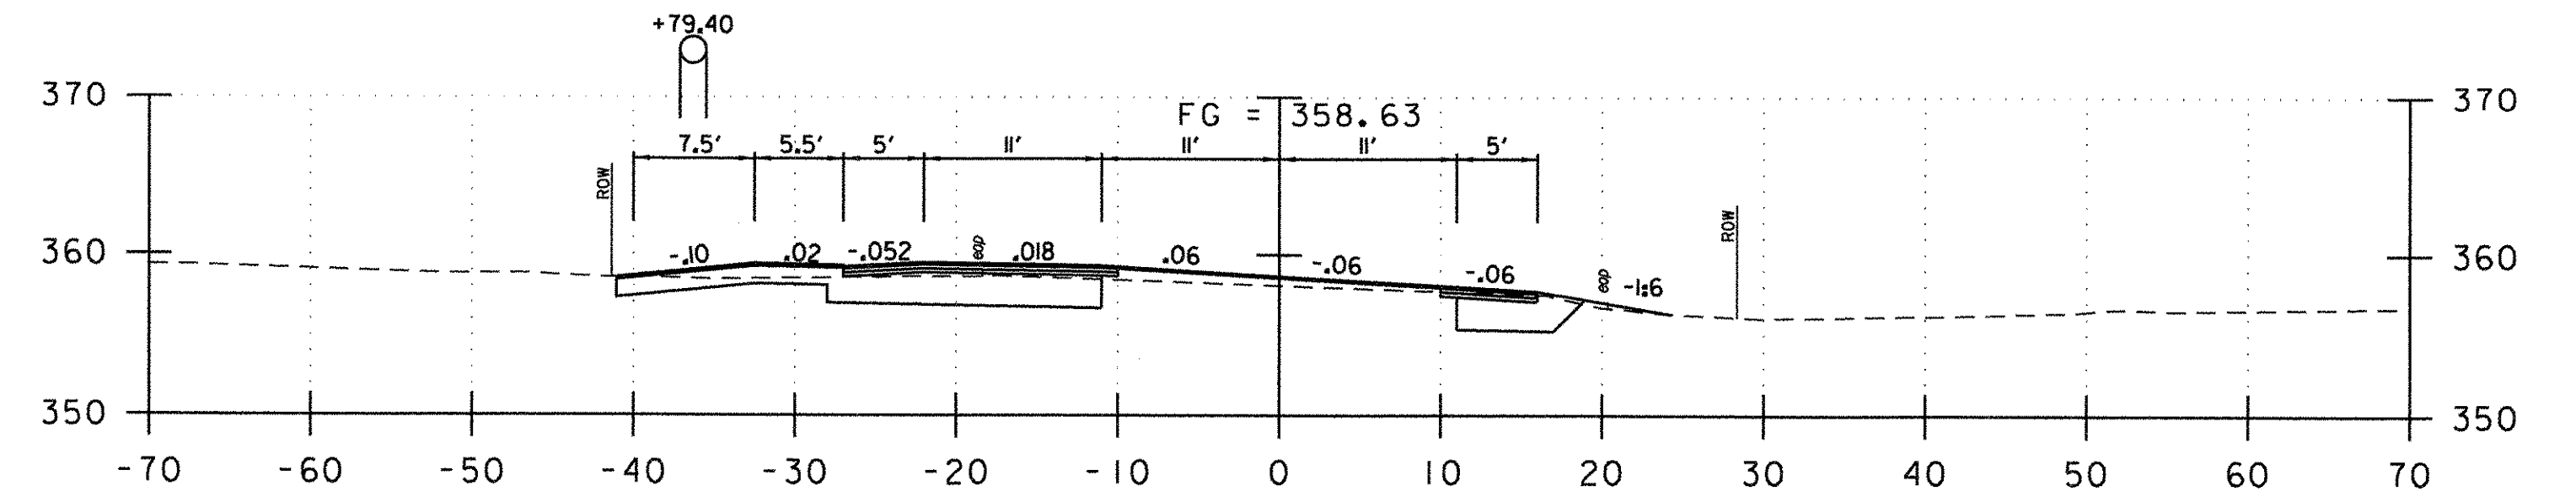


3+57

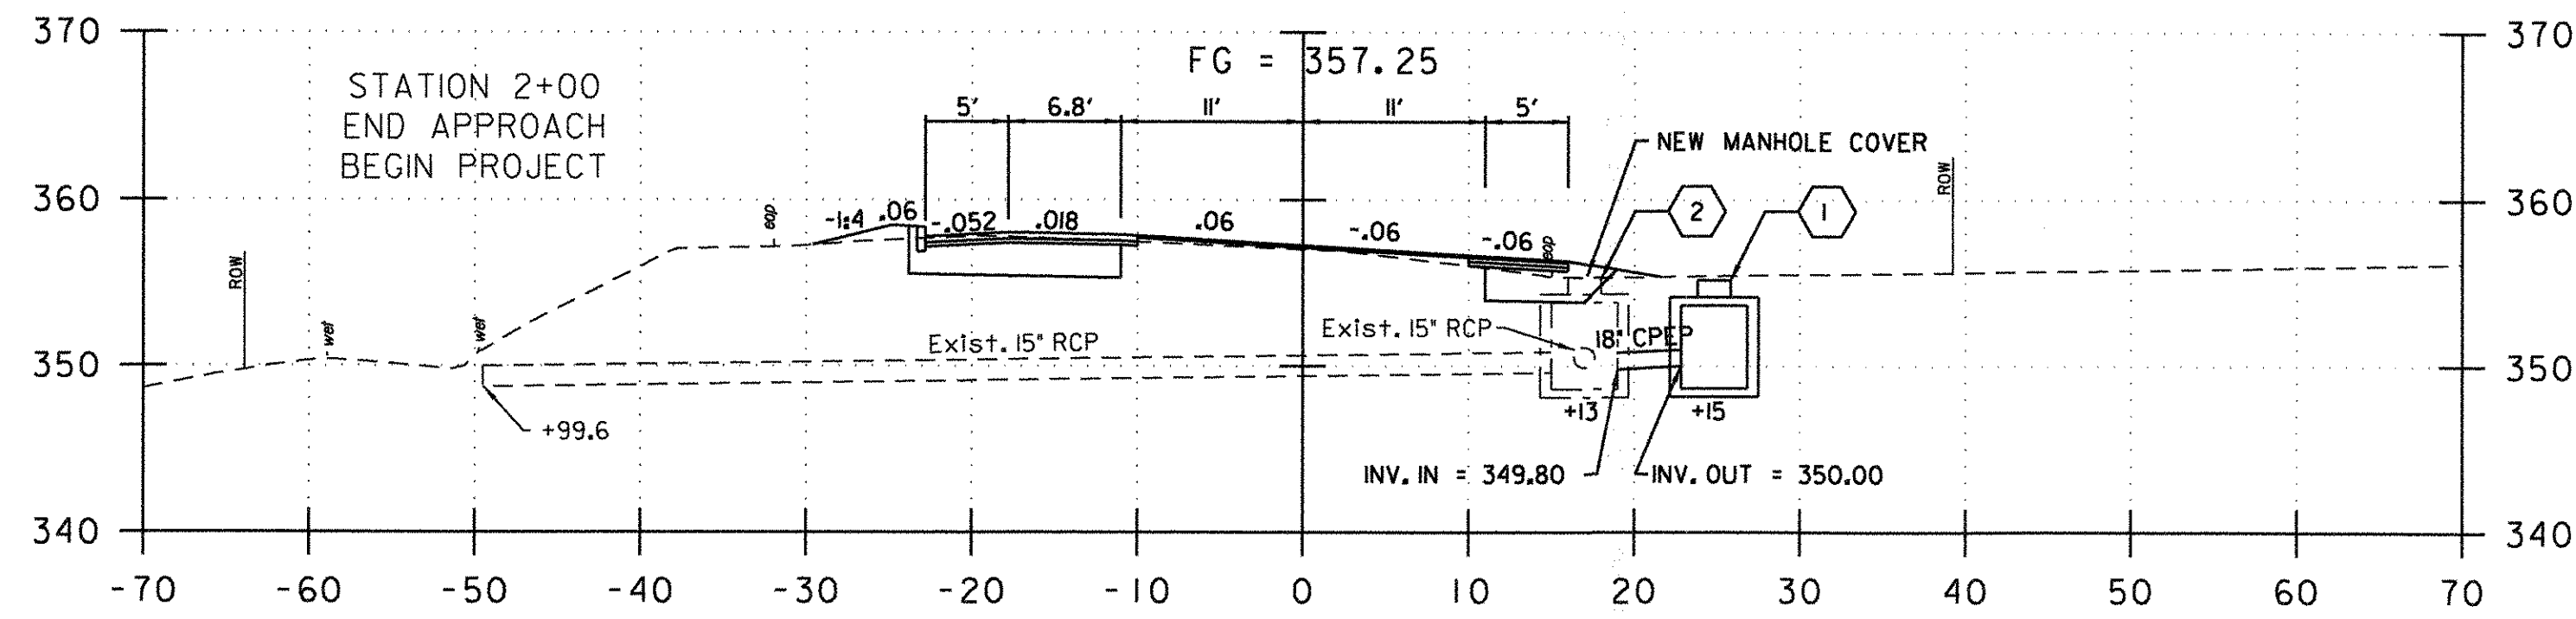


2+00

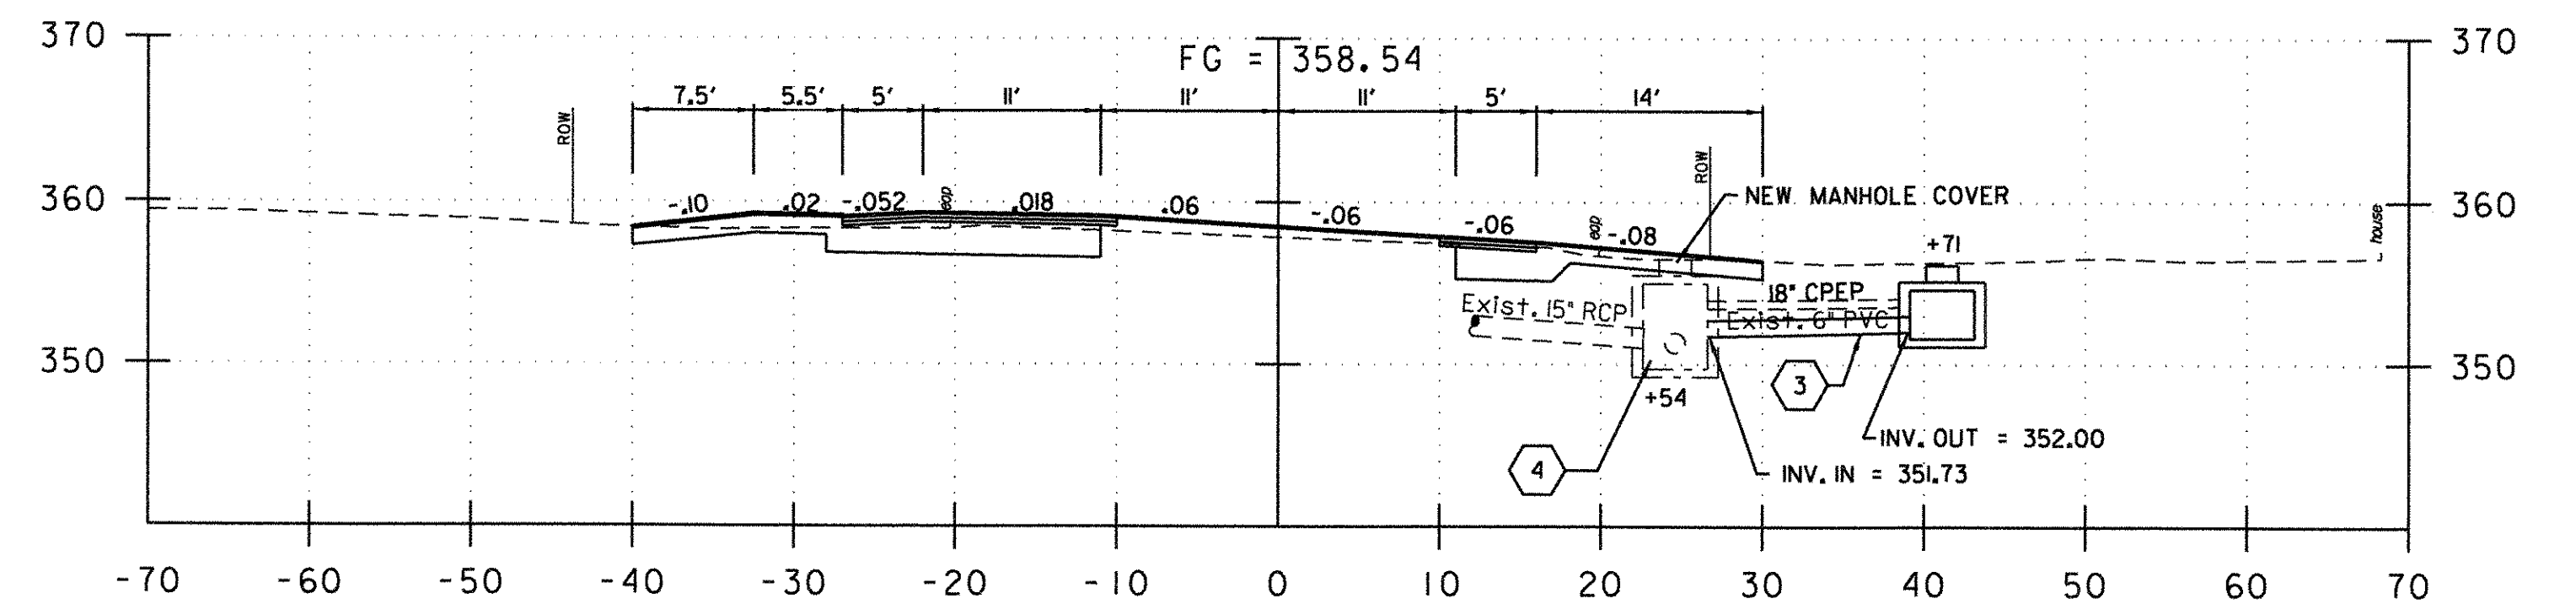


3+50

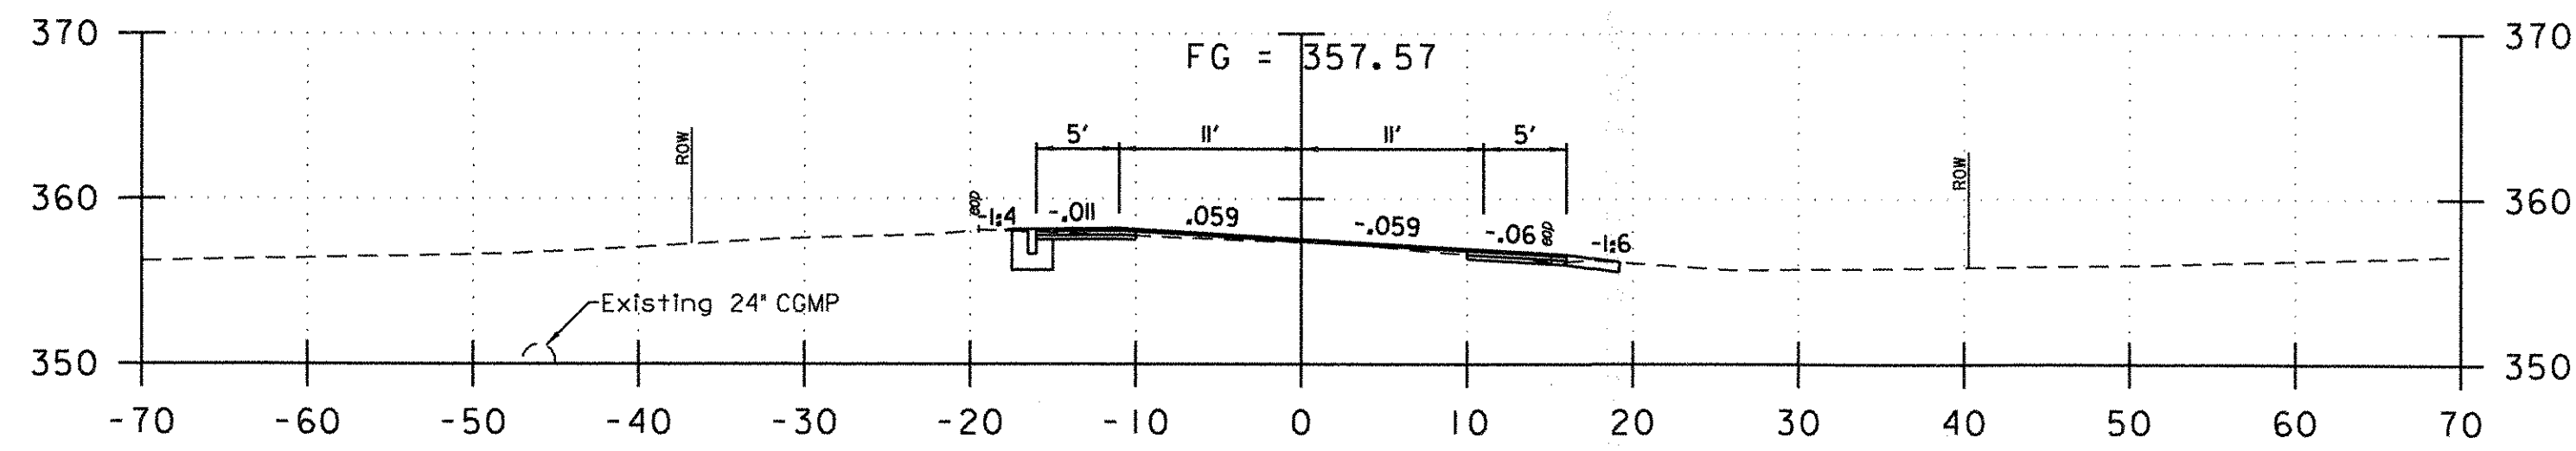


1+50

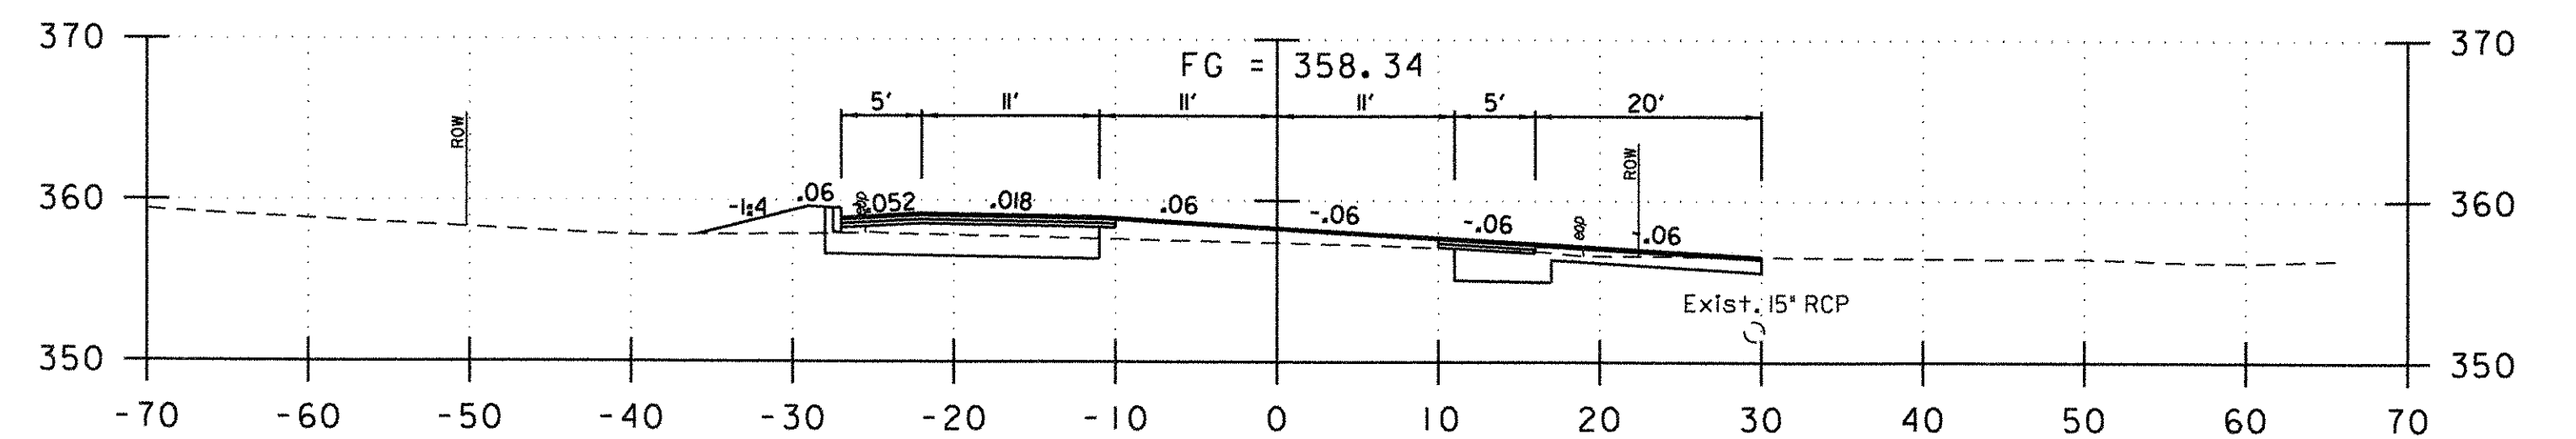

3+35

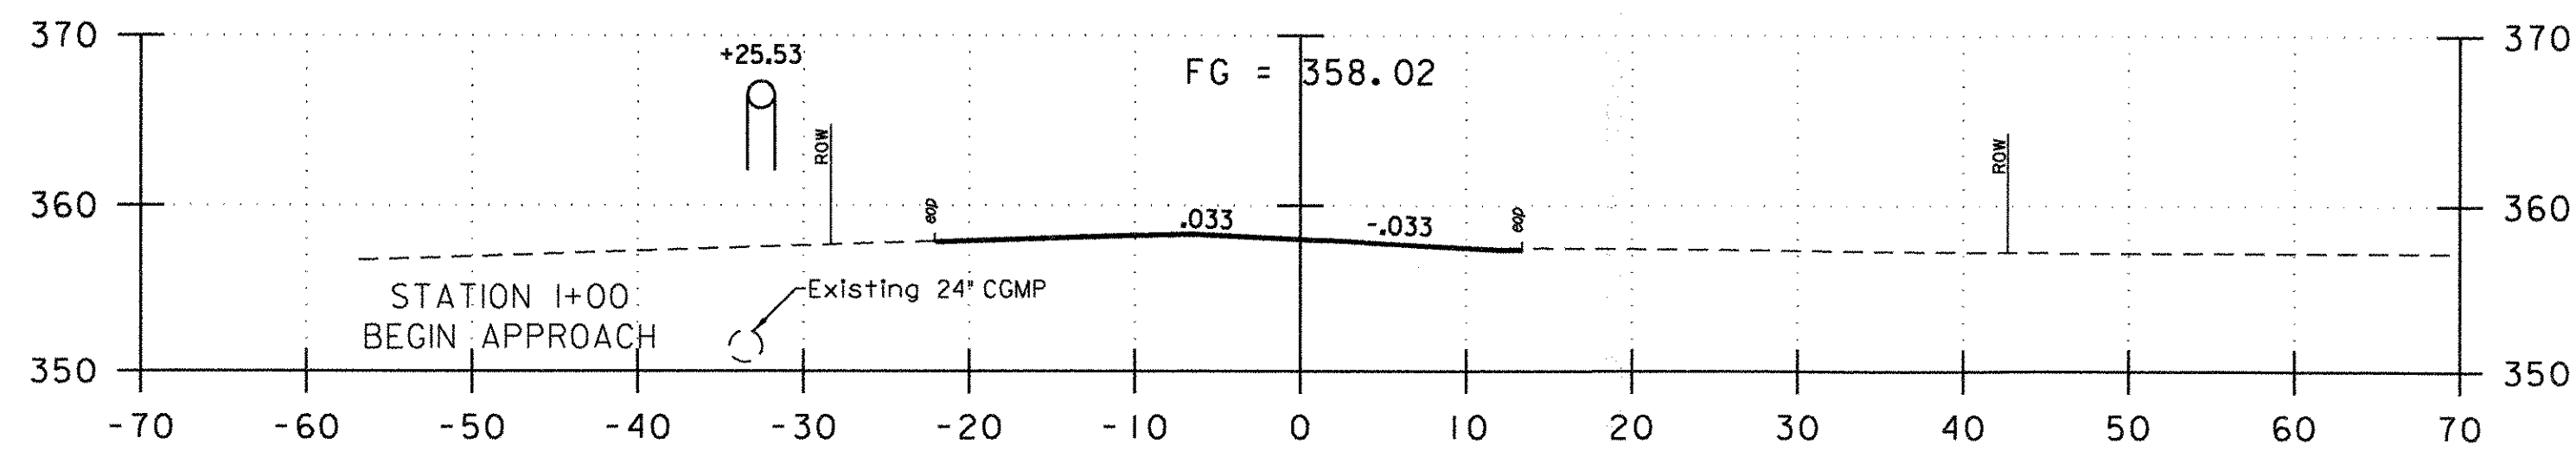

1+00

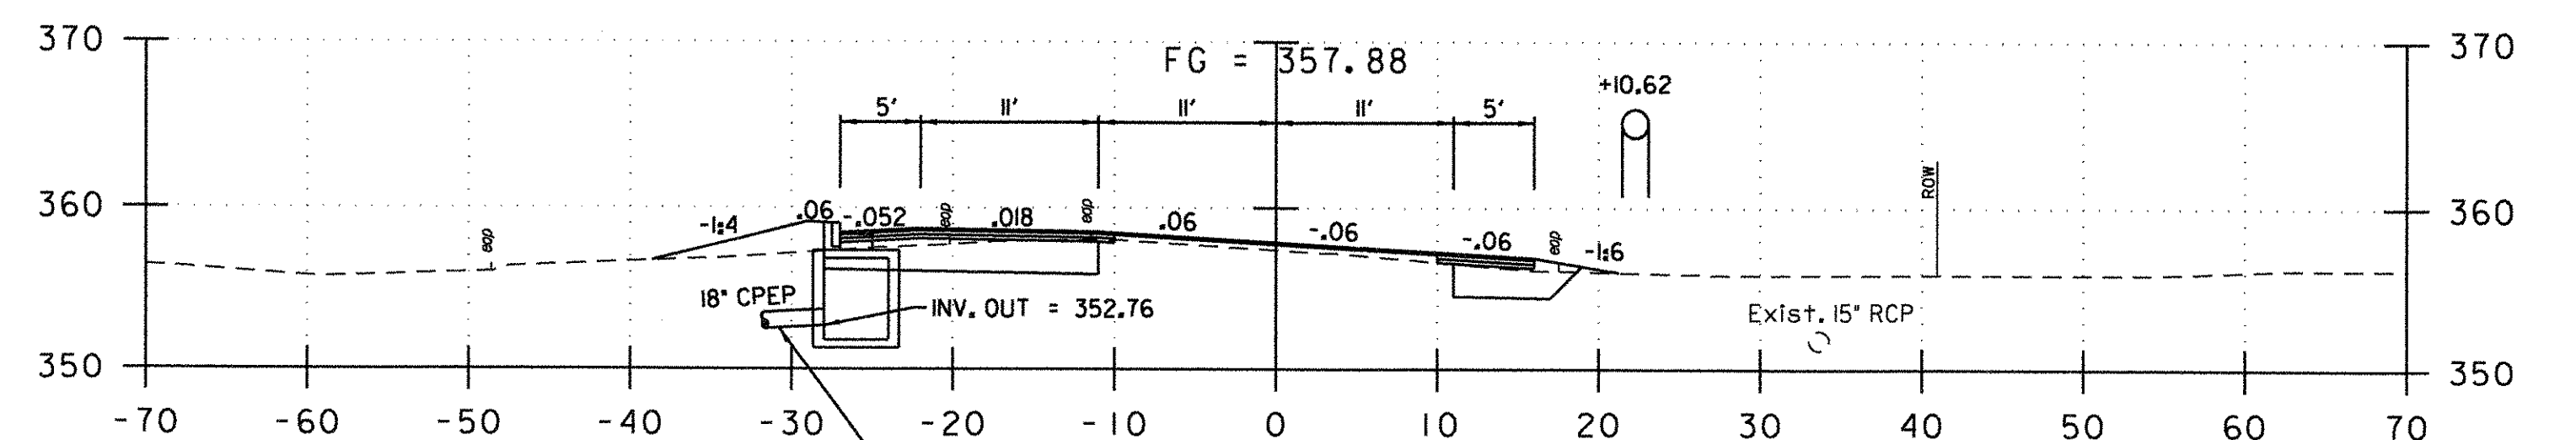

3+00

VT 116












SCALE IN FEET

VHIB Vanasse Hangen Brustlin, Inc.

PROJECT NAME: HINESBURG
PROJECT NUMBER: HES 021-(120)

FILE NAME: z04b206xsec.dgn
PROJECT LEADER: G. BAKOS
DESIGNED BY: D. PECK
CROSS SECTIONS 1










PLOT DATE: 2/18/2009
DRAWN BY: D. PECK
CHECKED BY: G. BAKOS
SHEET 22 OF 25

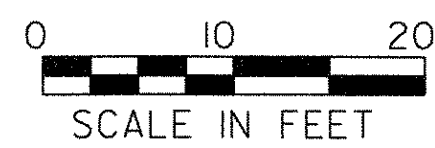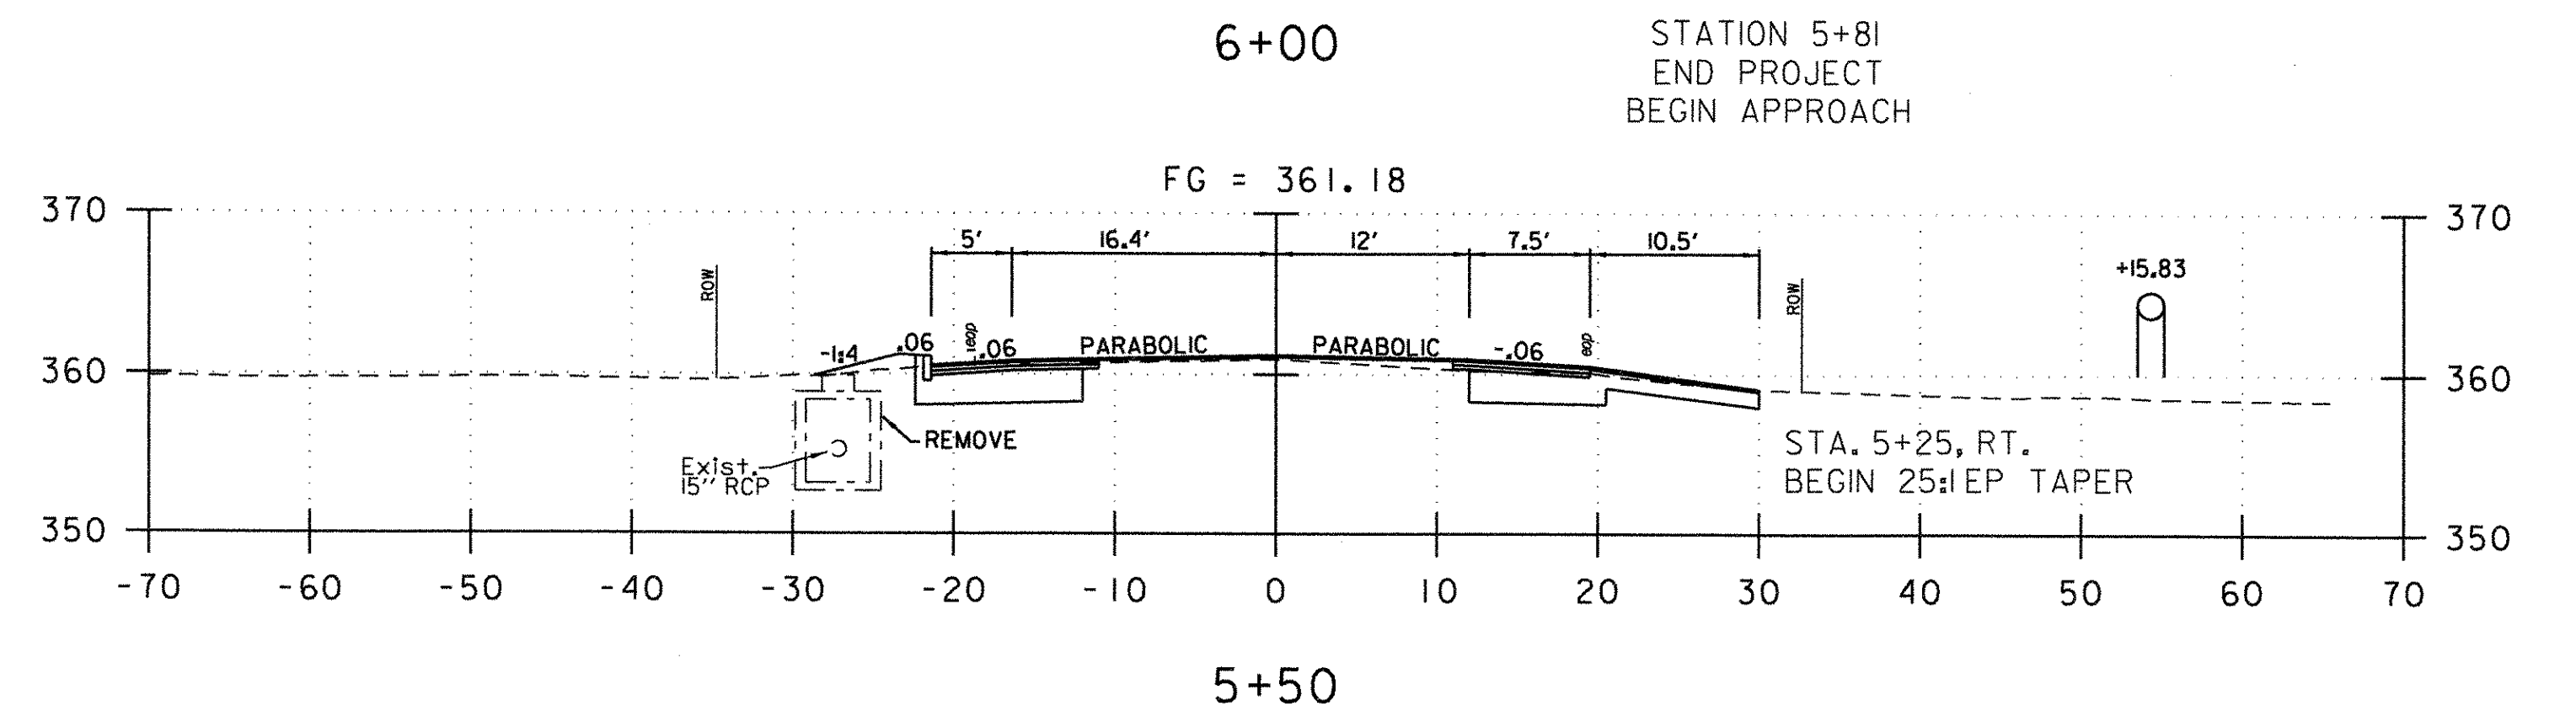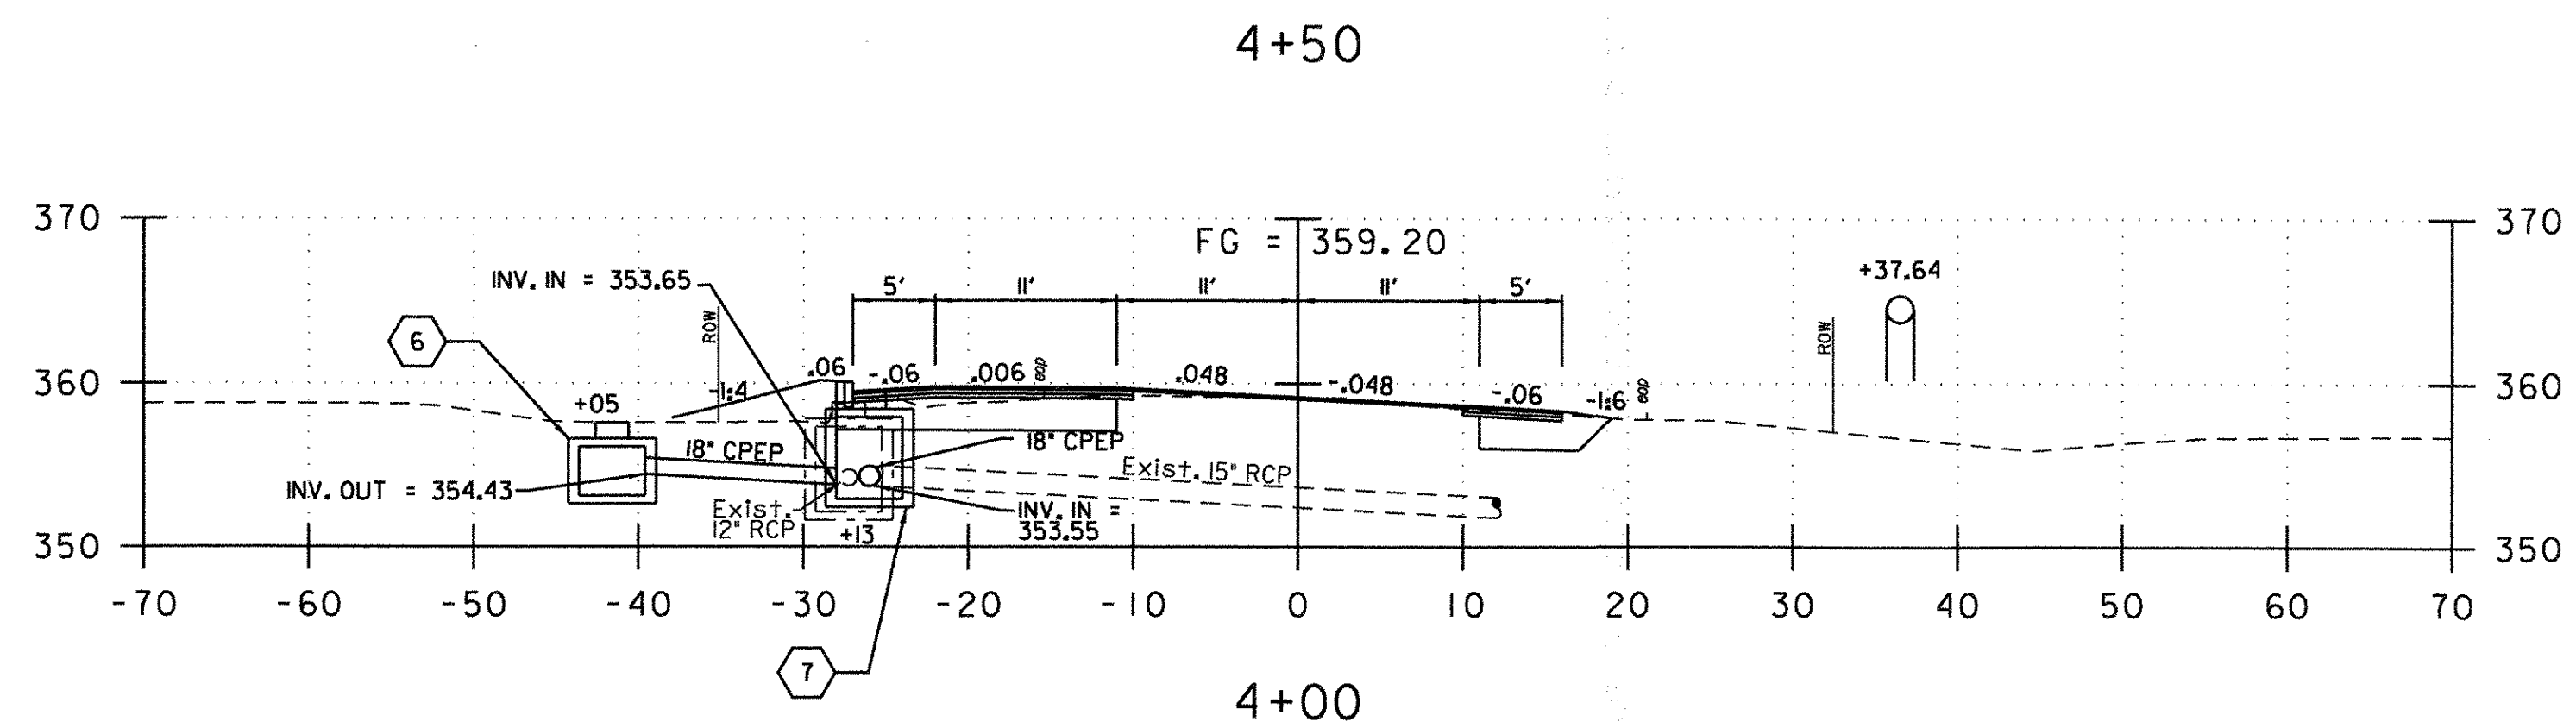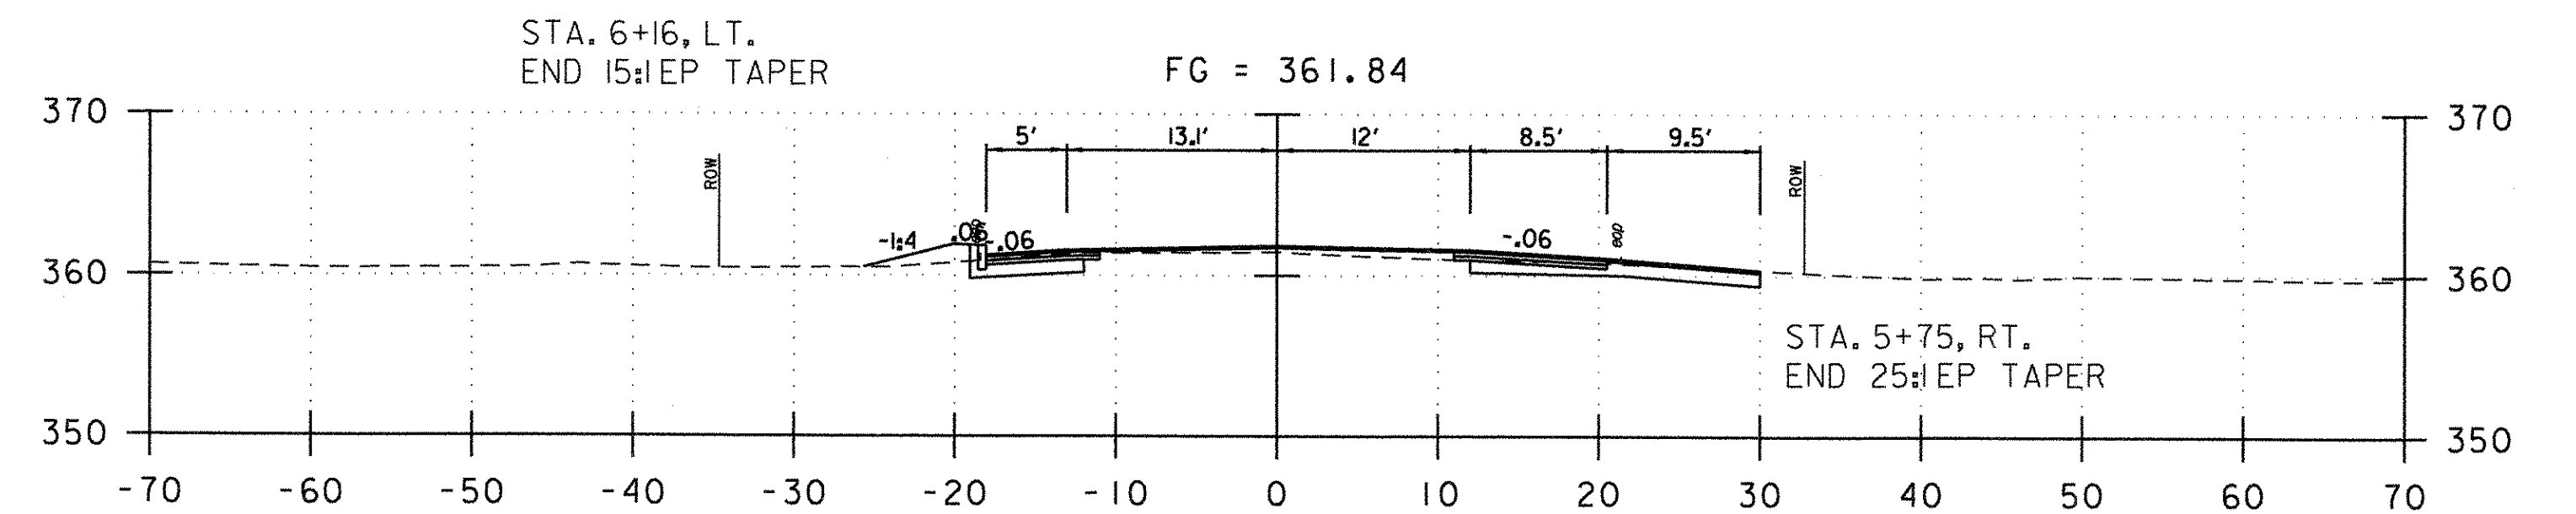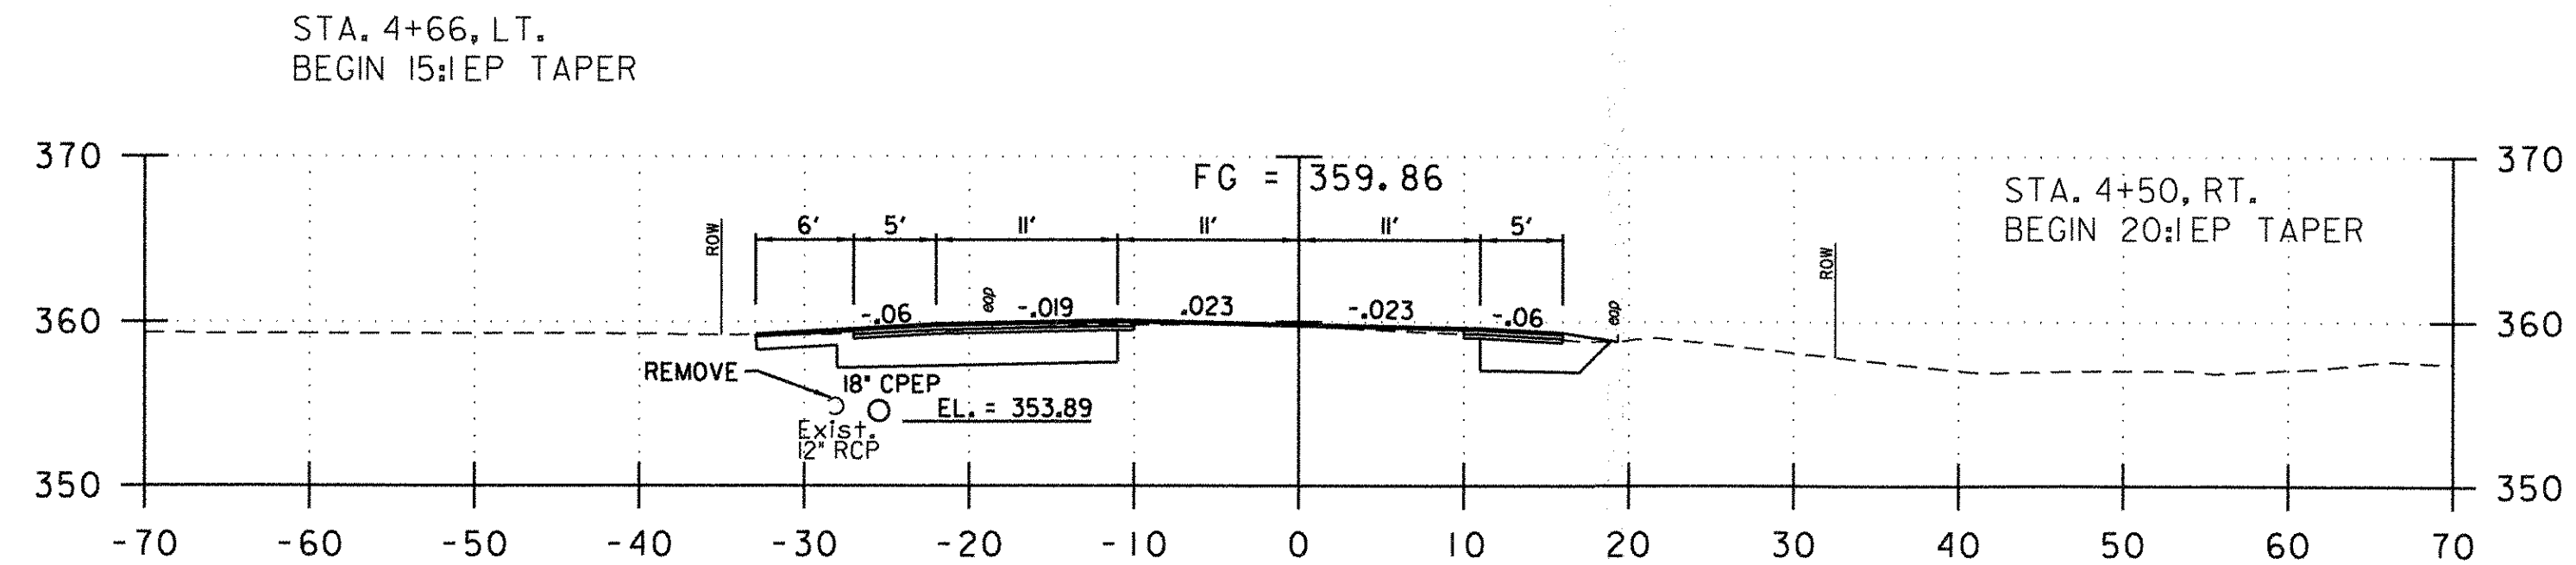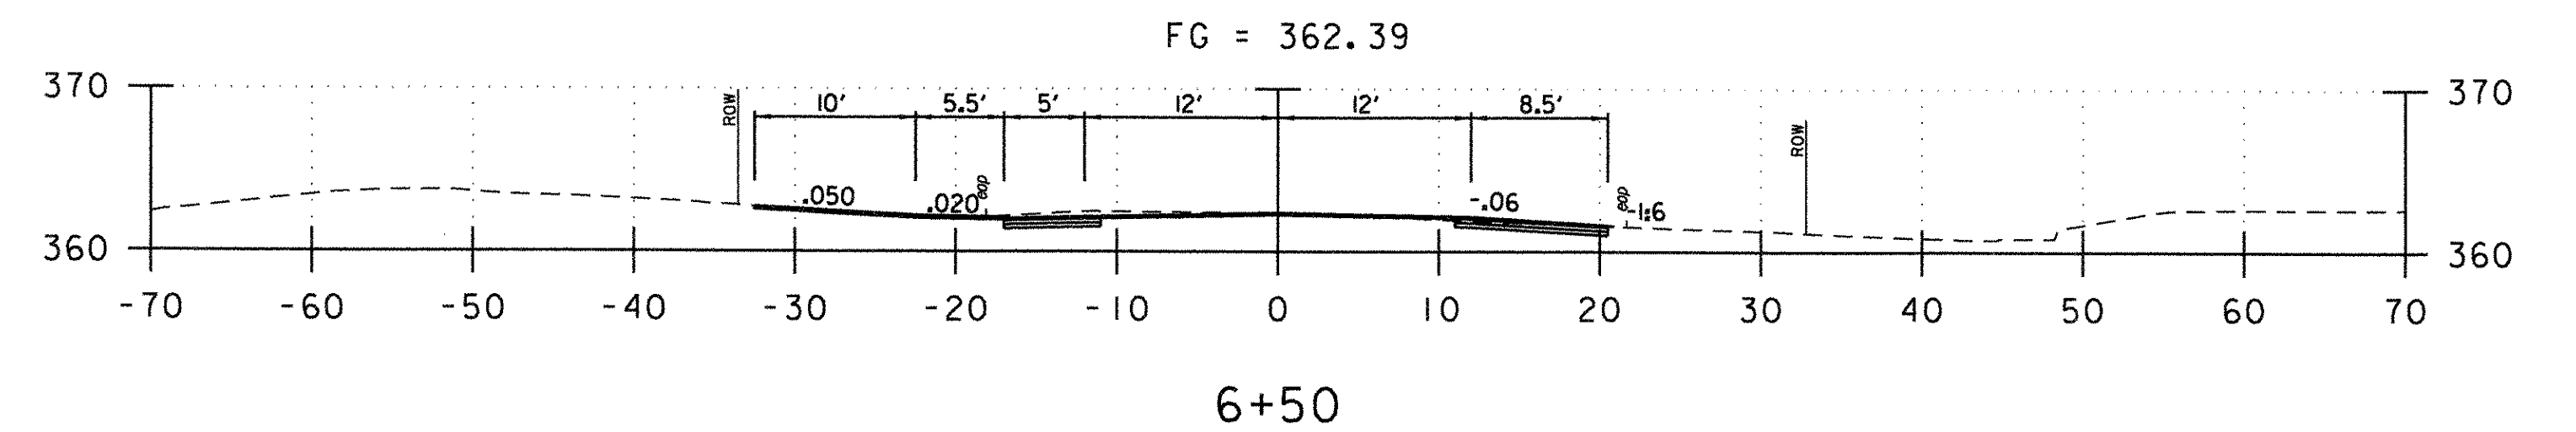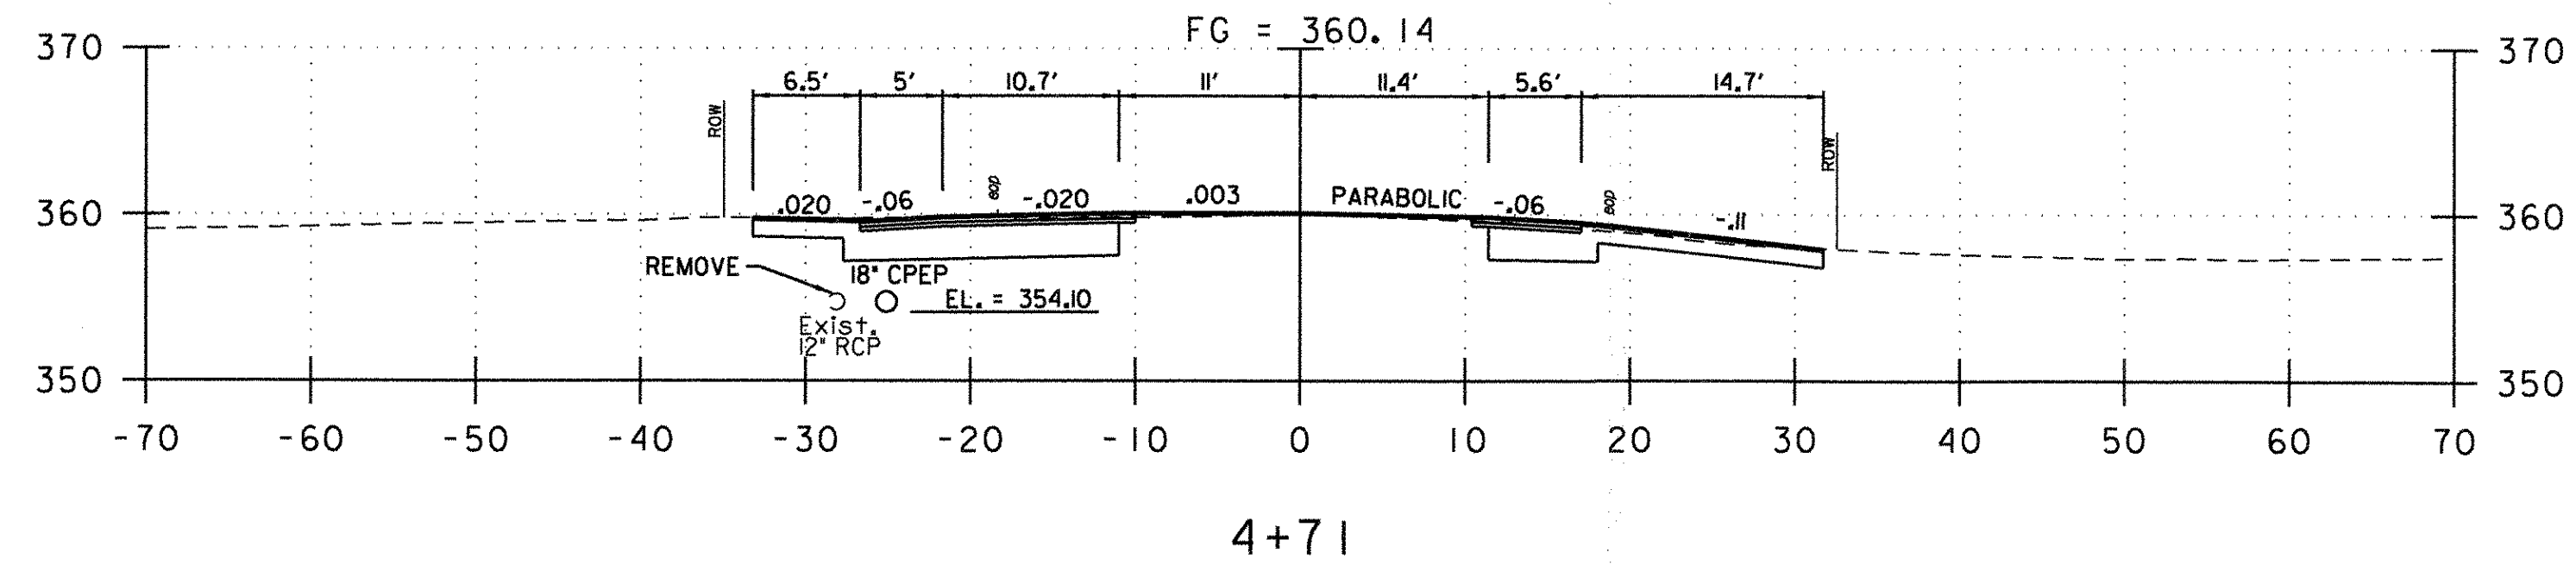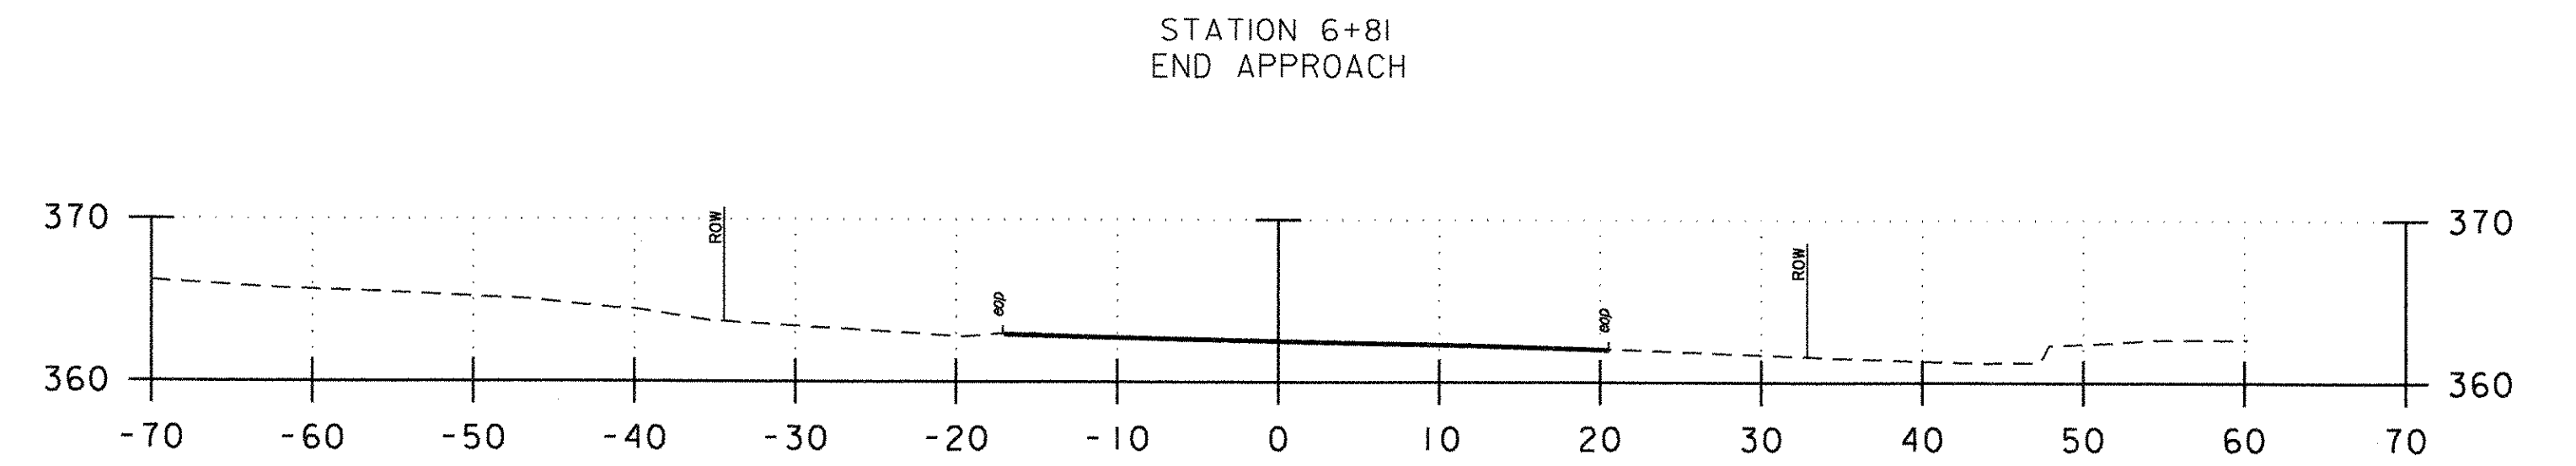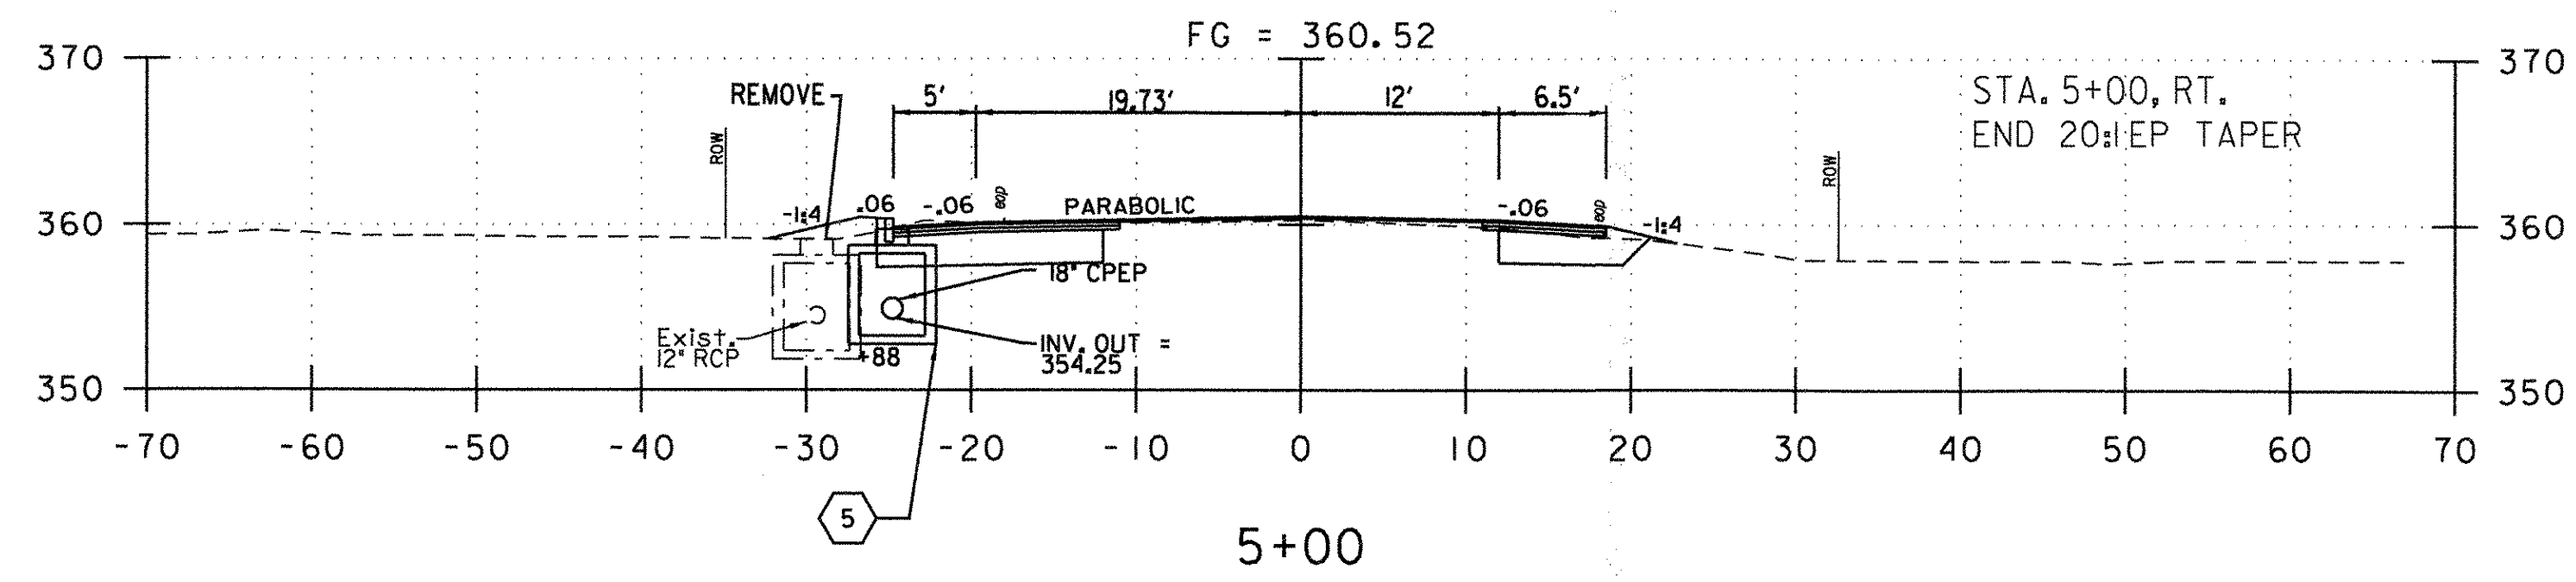


VT 116

PROJECT NAME:	HINESBURG	PLOT DATE:	2/18/2009
PROJECT NUMBER:	HES 021-1(20)	DRAWN BY:	D. PECK
FILE NAME:	z04b206xsec.dgn	CHECKED BY:	G. BAKOS
PROJECT LEADER:	G. BAKOS	CROSS SECTIONS	2
DESIGNED BY:	D. PECK	SHEET	23 OF 25




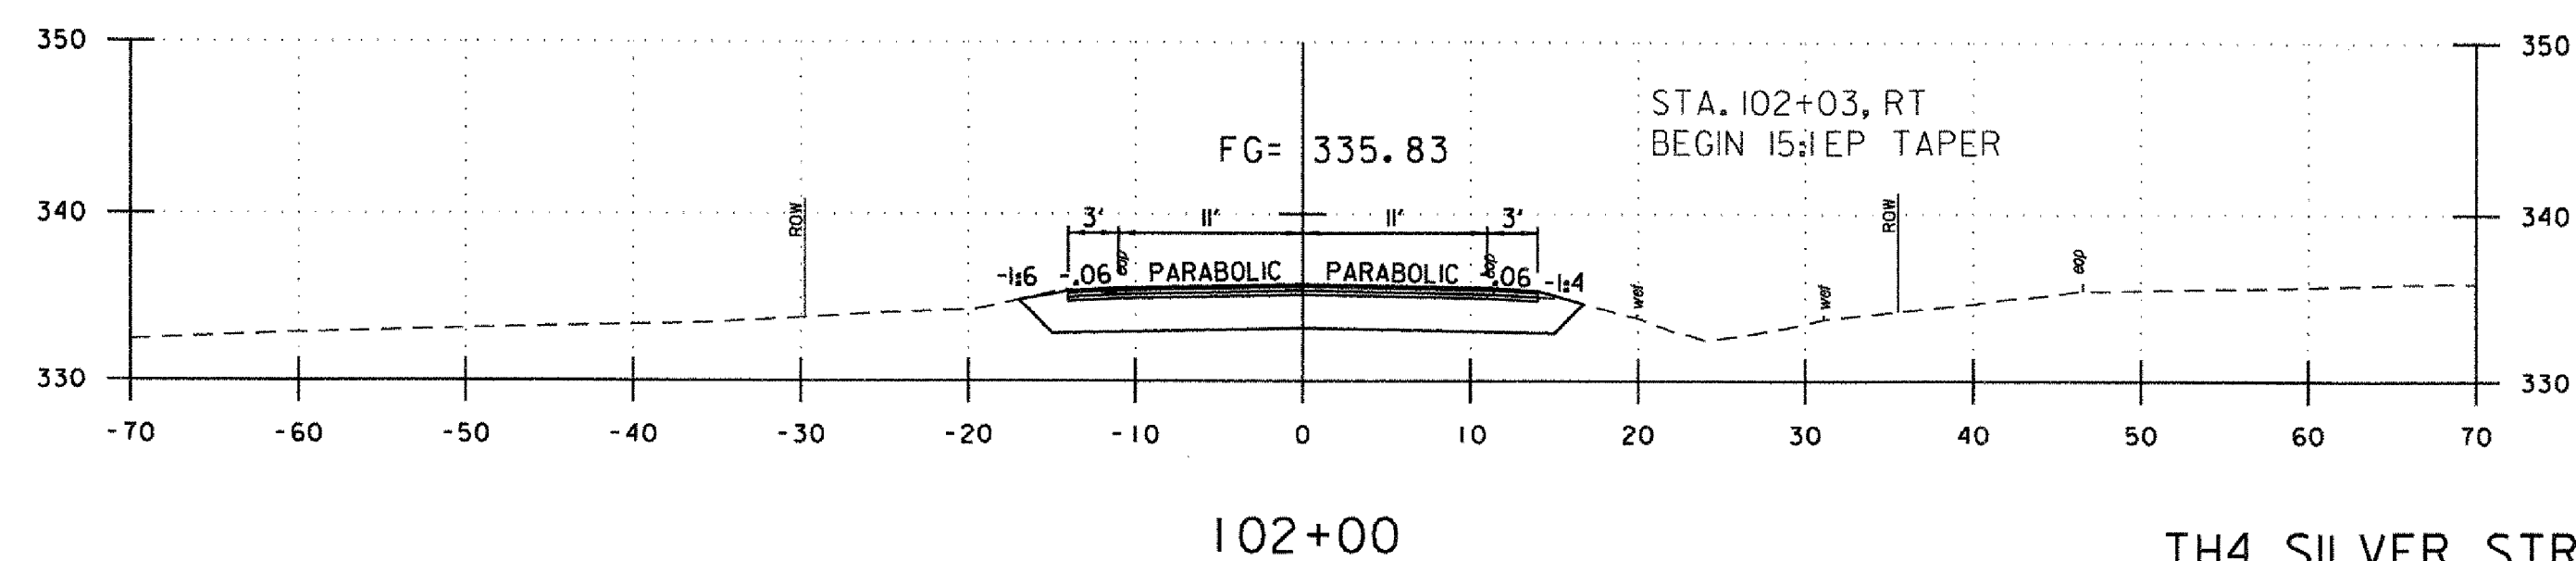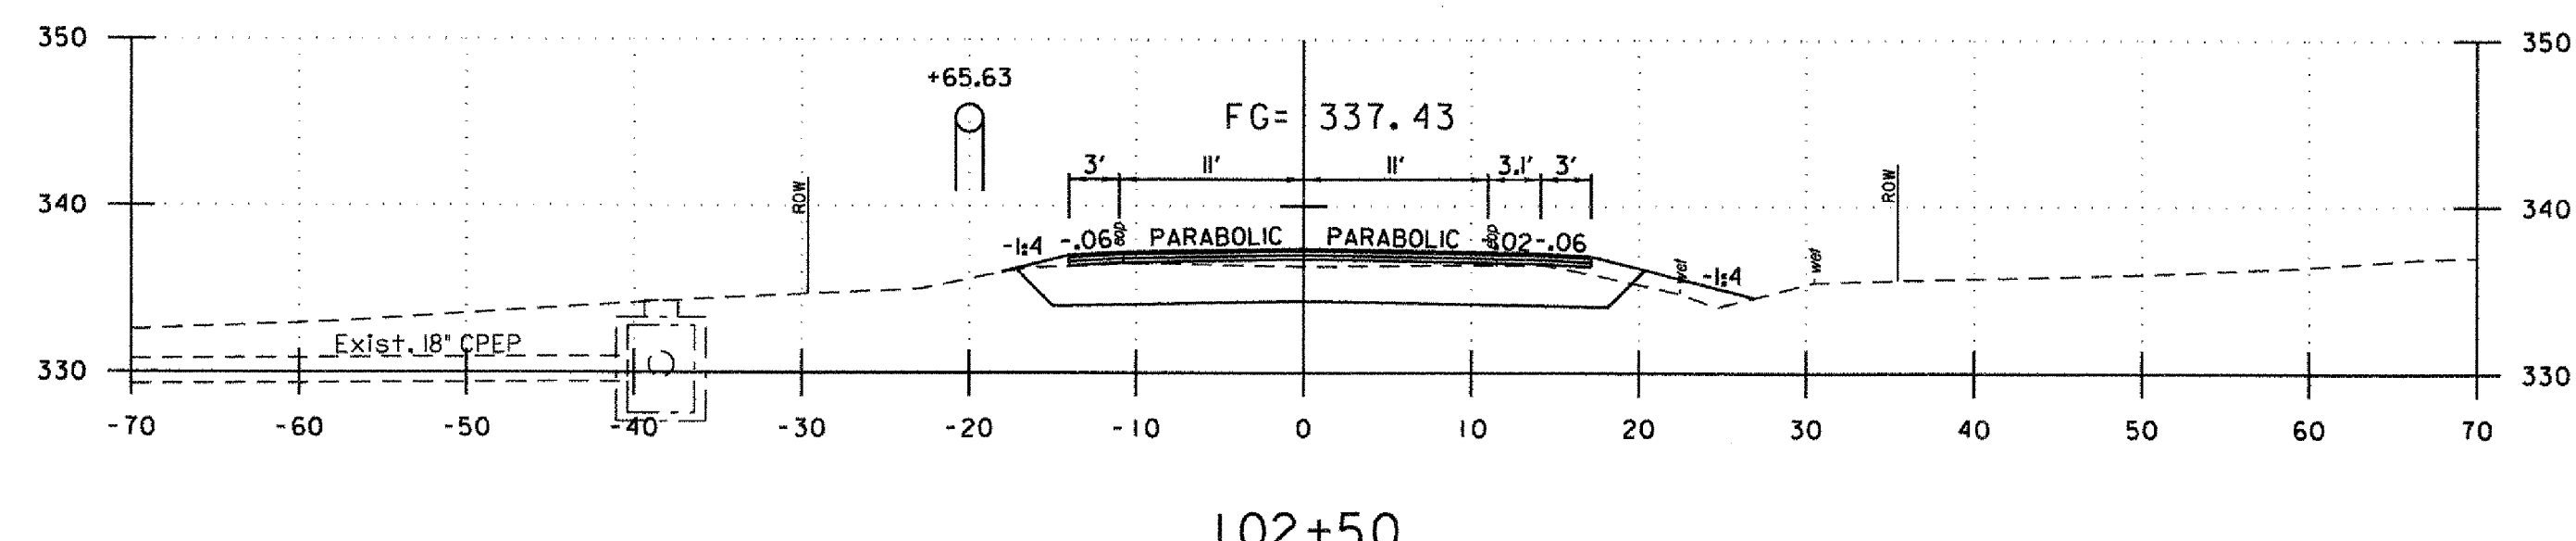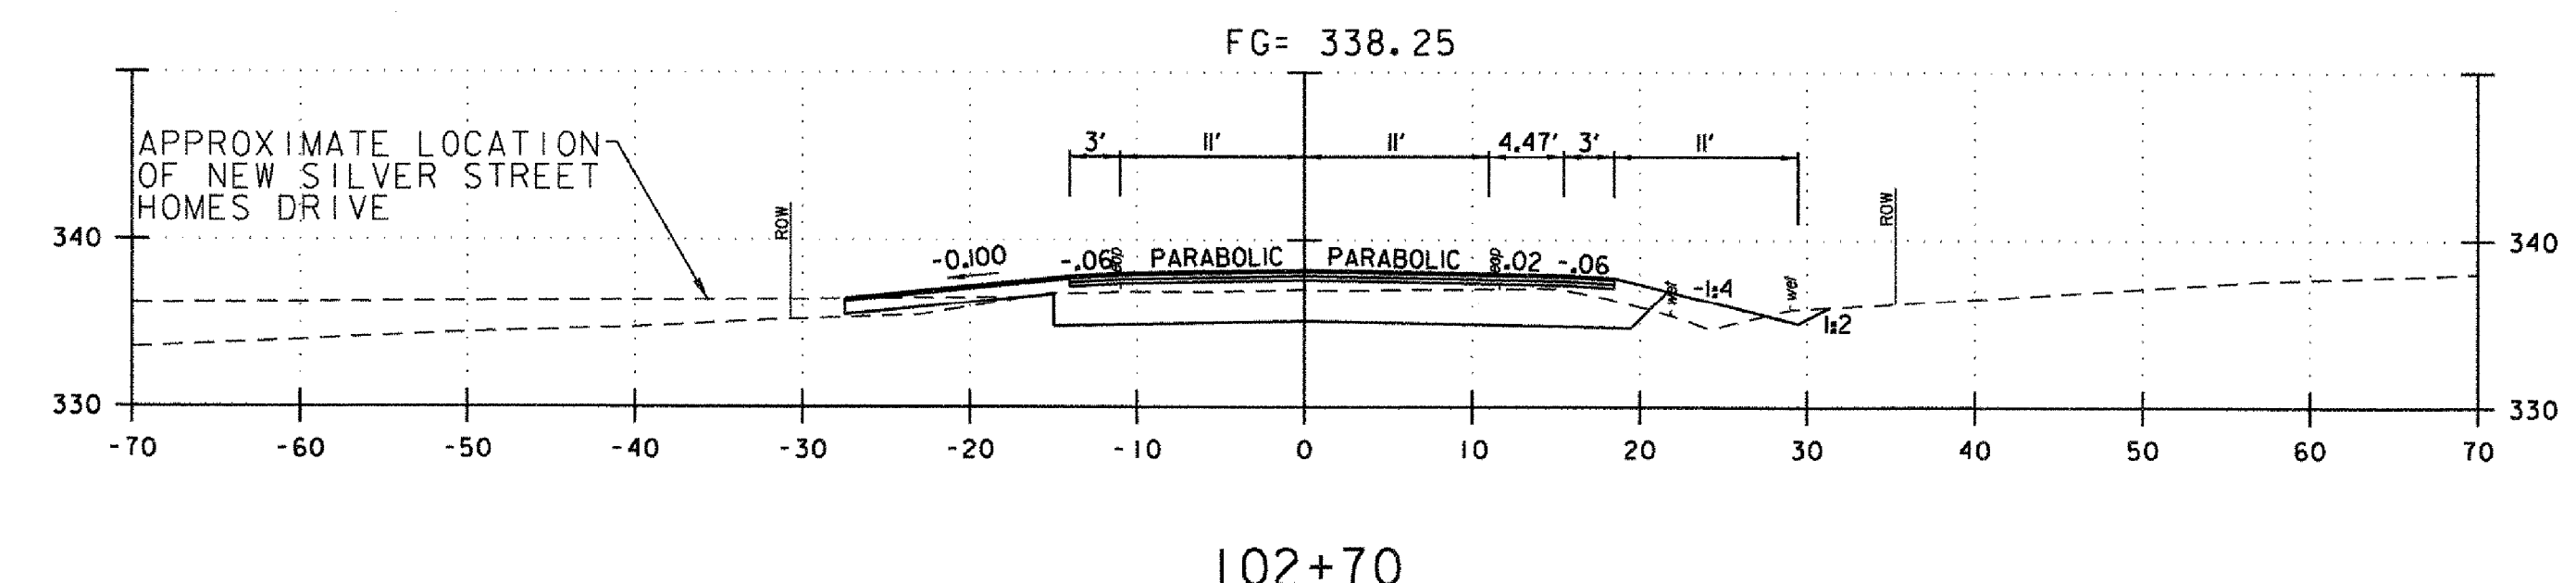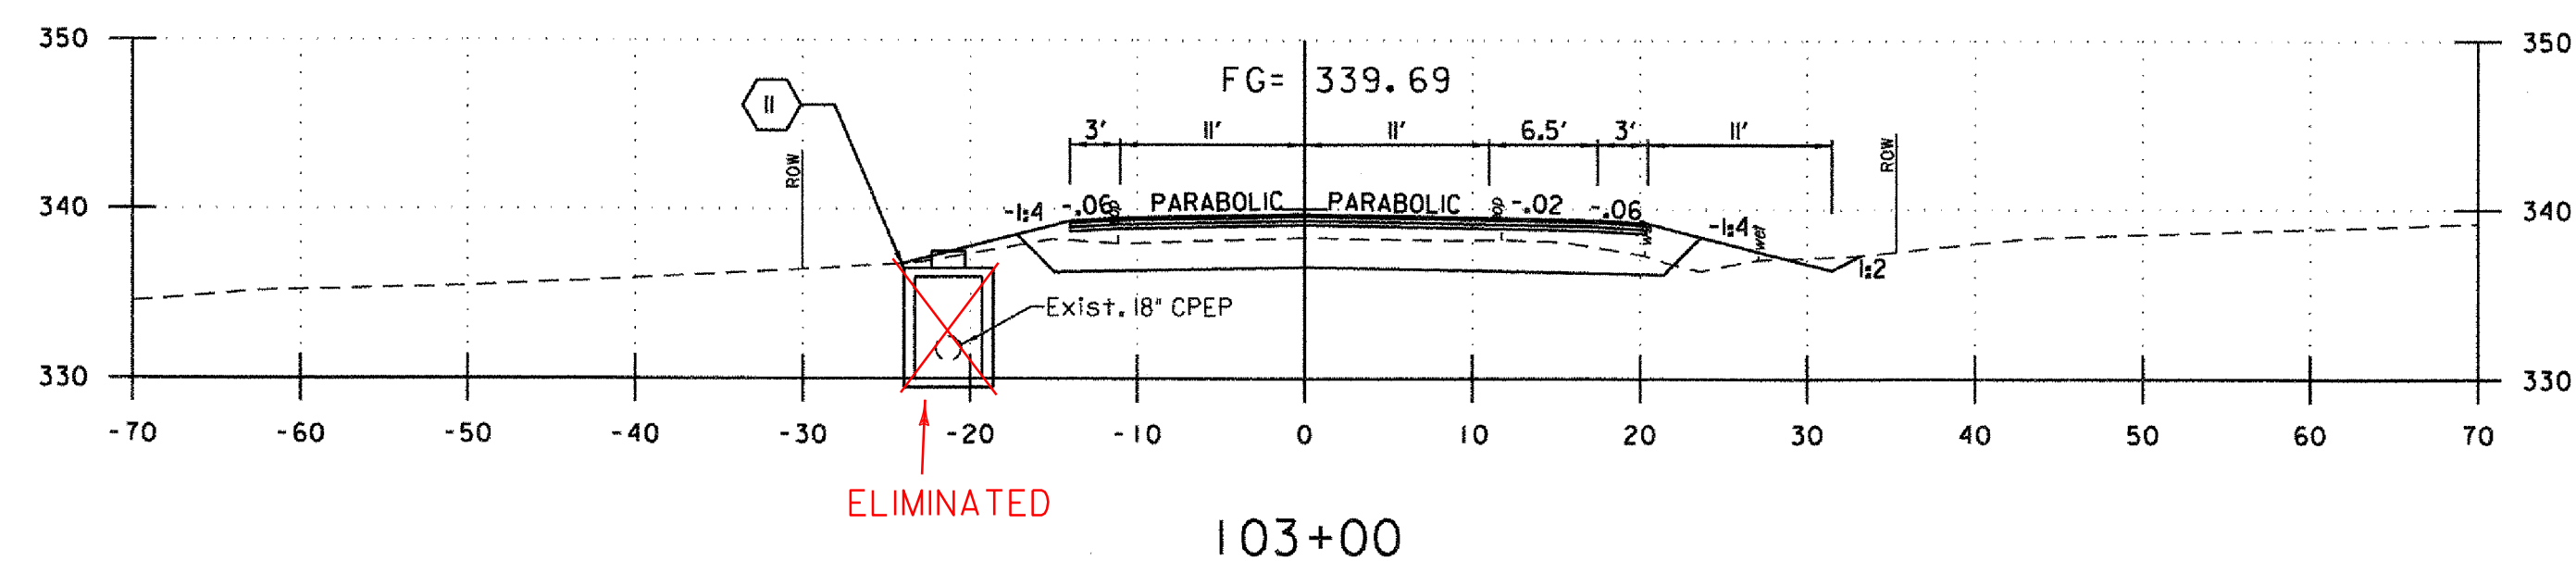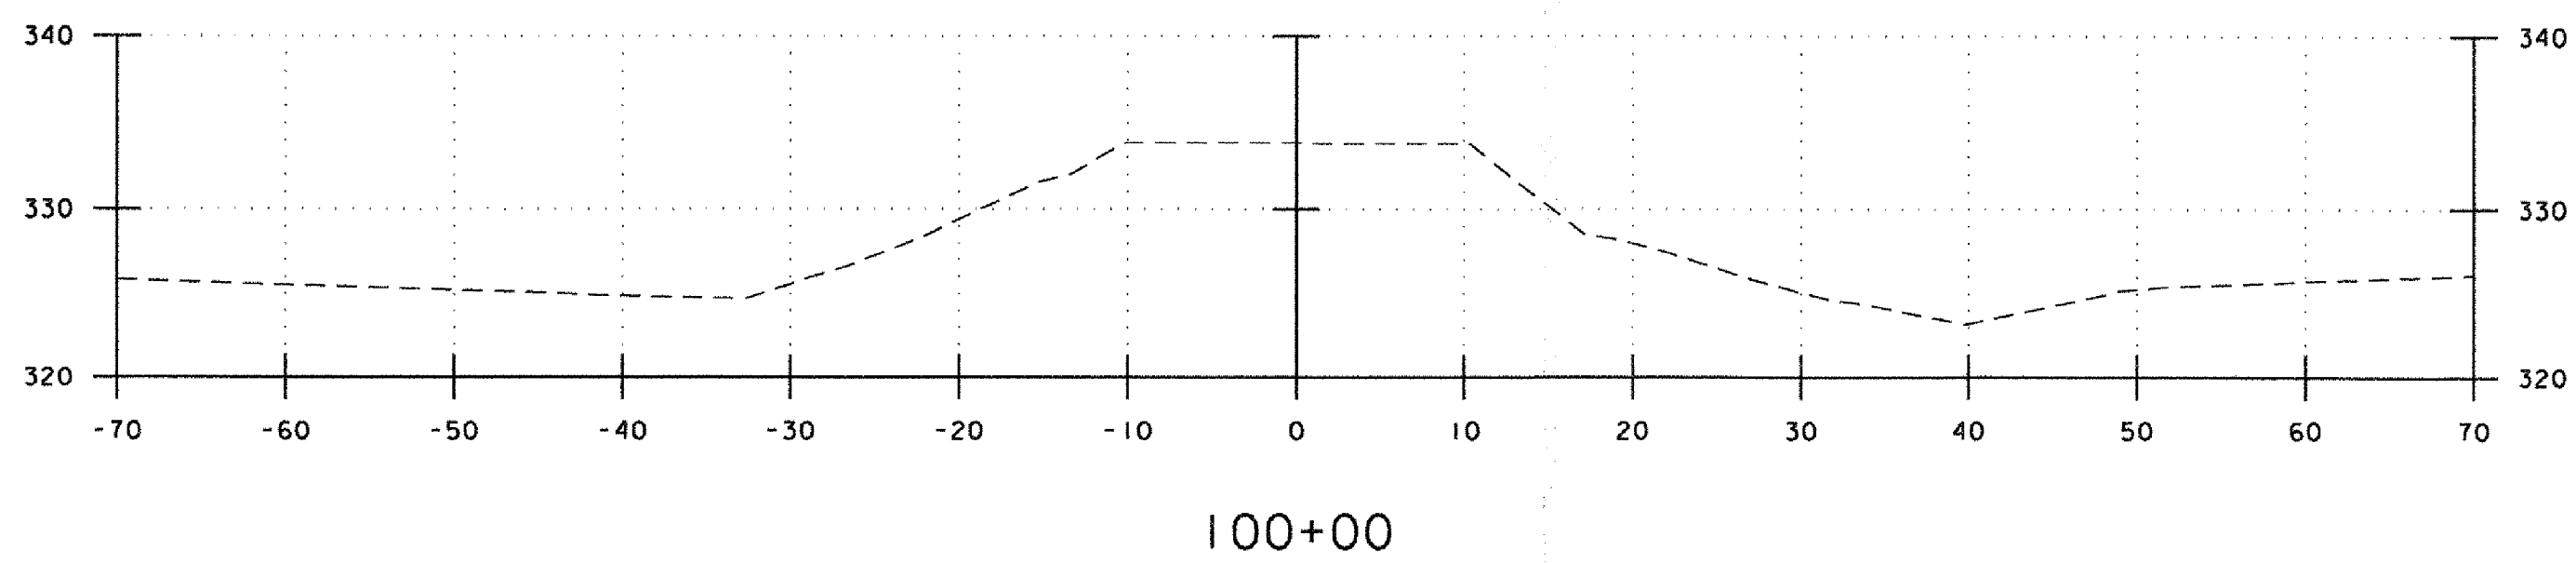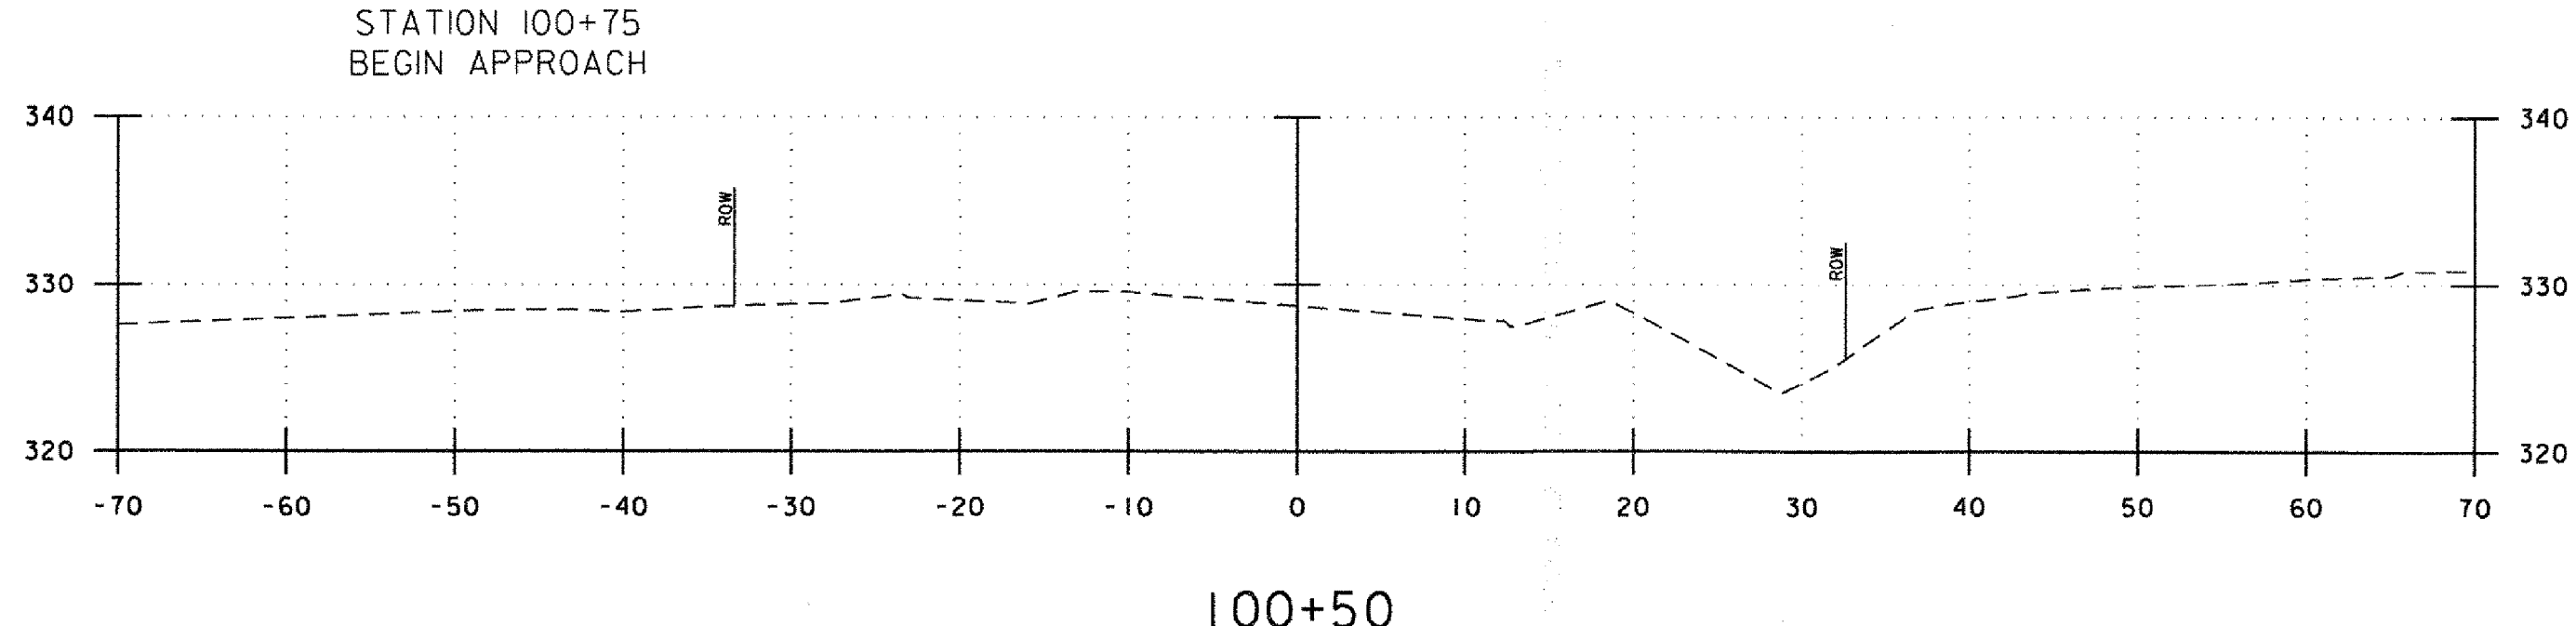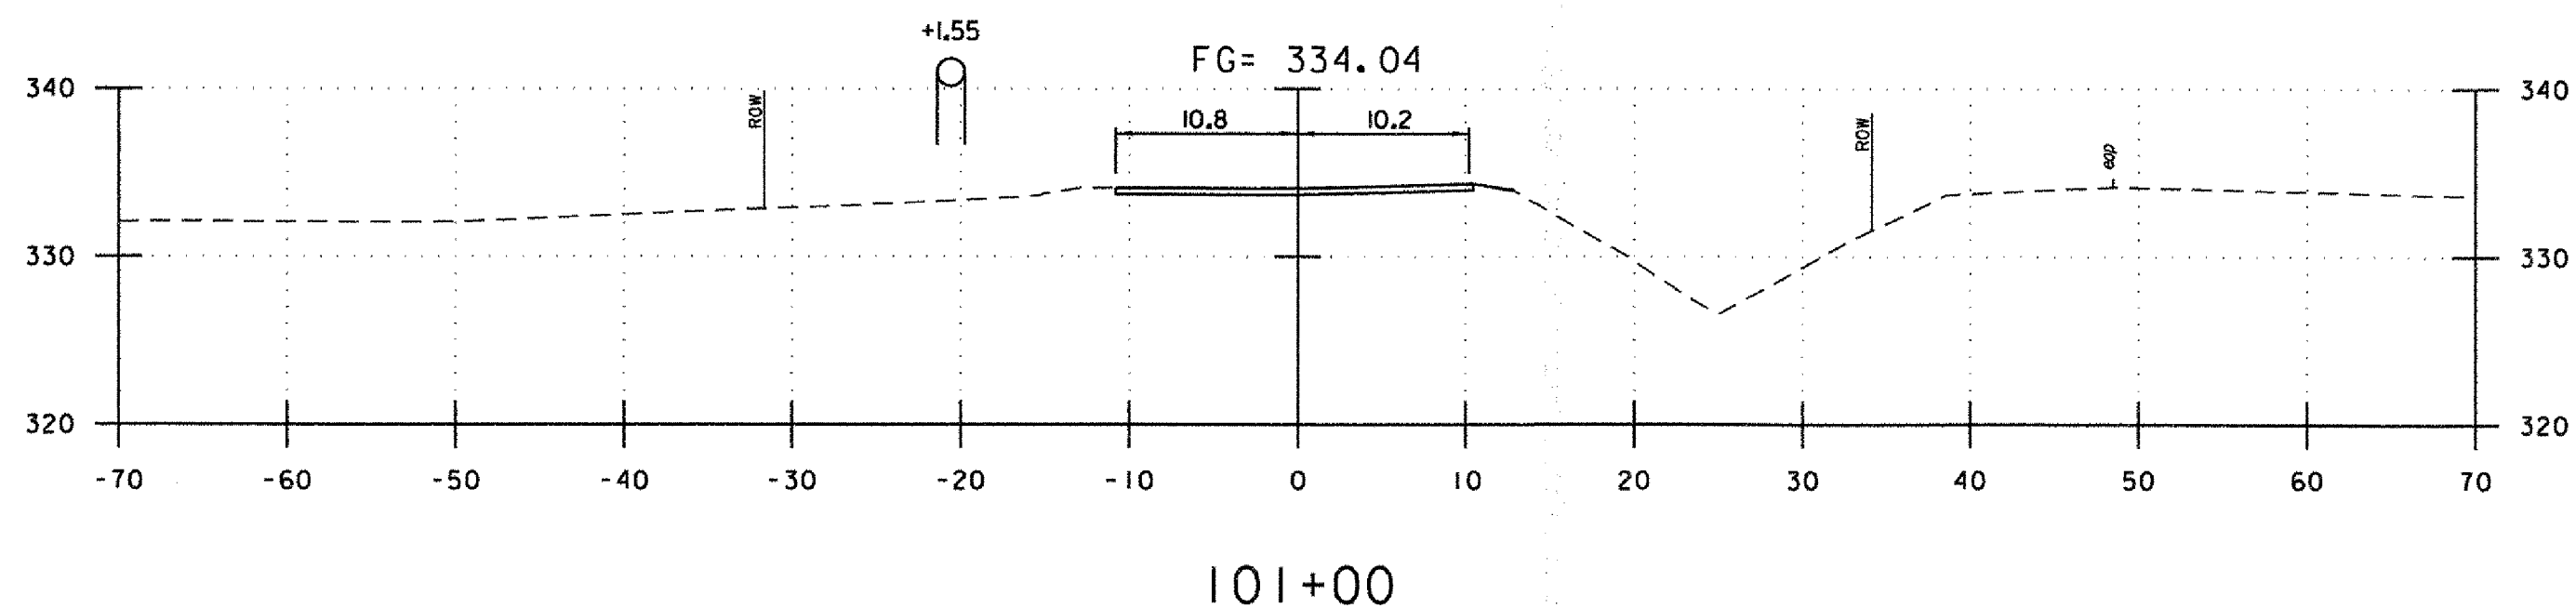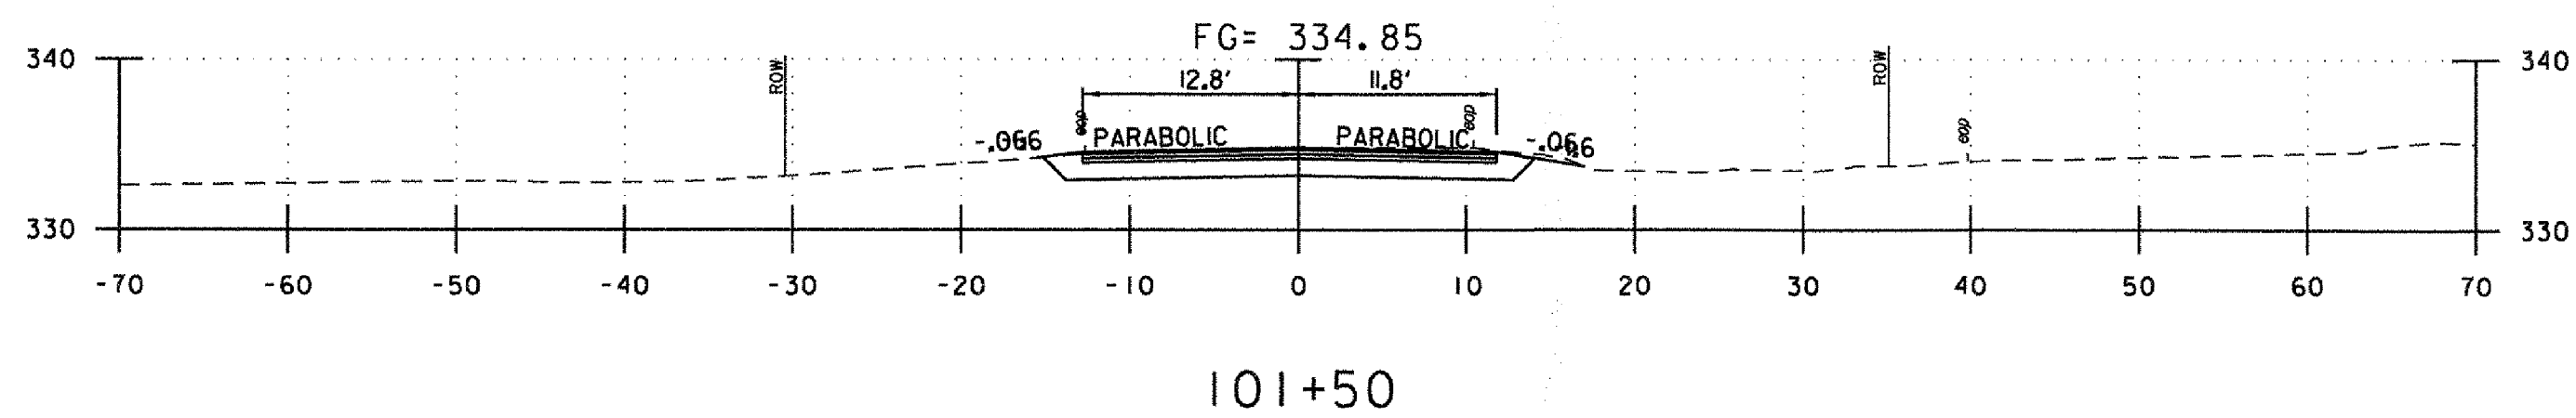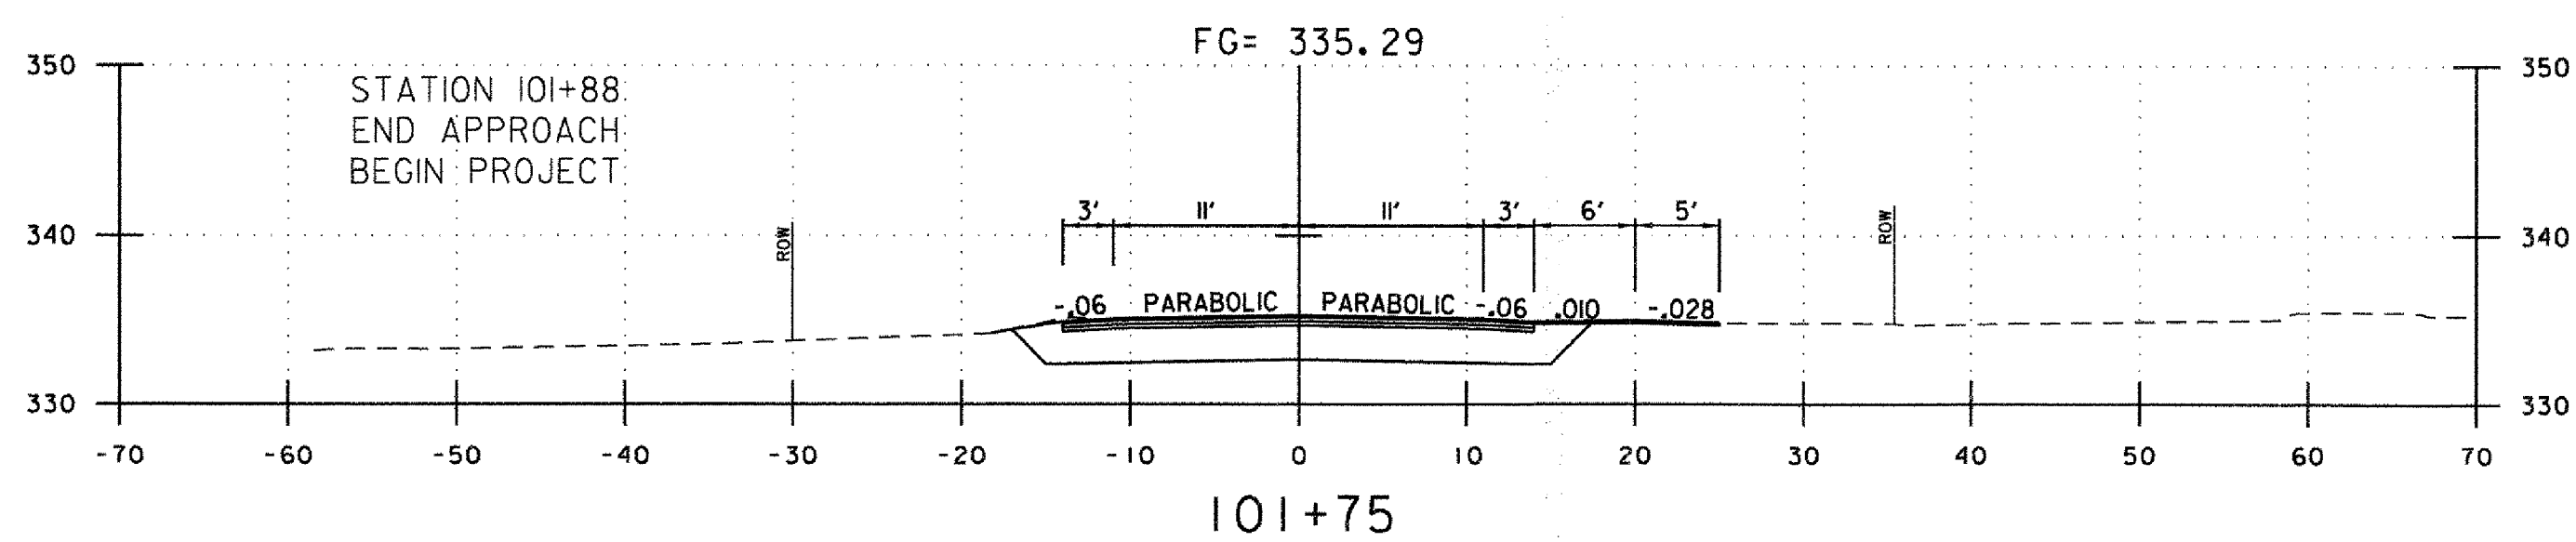


TH4 SILVER STREET

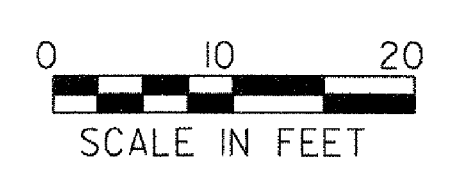


PROJECT NAME:	HINESBURG	PLOT DATE:	2/18/2009
PROJECT NUMBER:	HES 021-1(20)	DRAWN BY:	D. PECK
FILE NAME:	z04b206xsec.dgn	DESIGNED BY:	D. PECK
PROJECT LEADER:	G. BAKOS	CHECKED BY:	G. BAKOS
CROSS SECTIONS:	3	SHEET:	24 OF 25

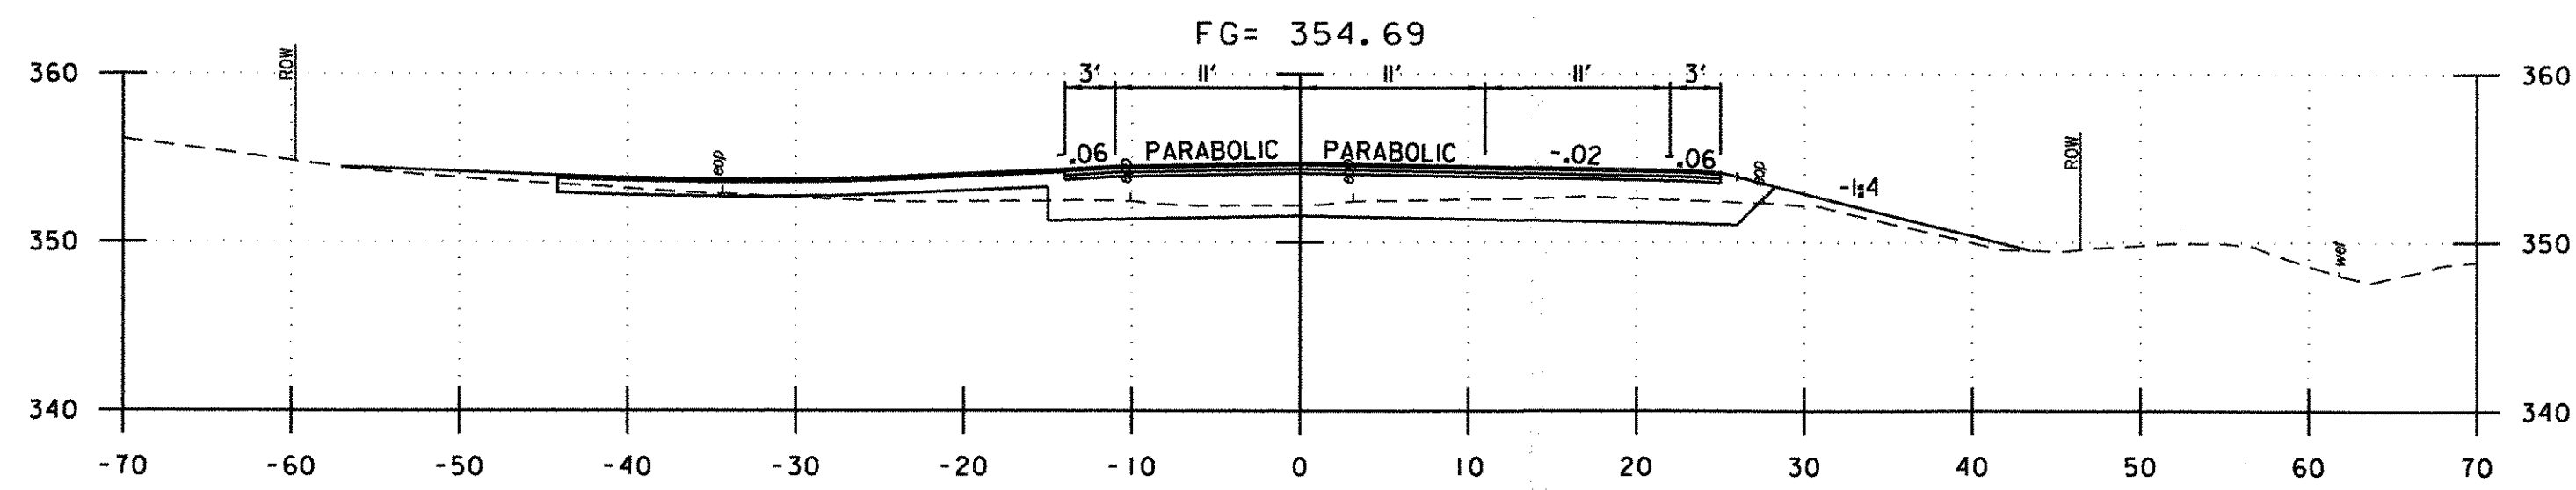


105+00

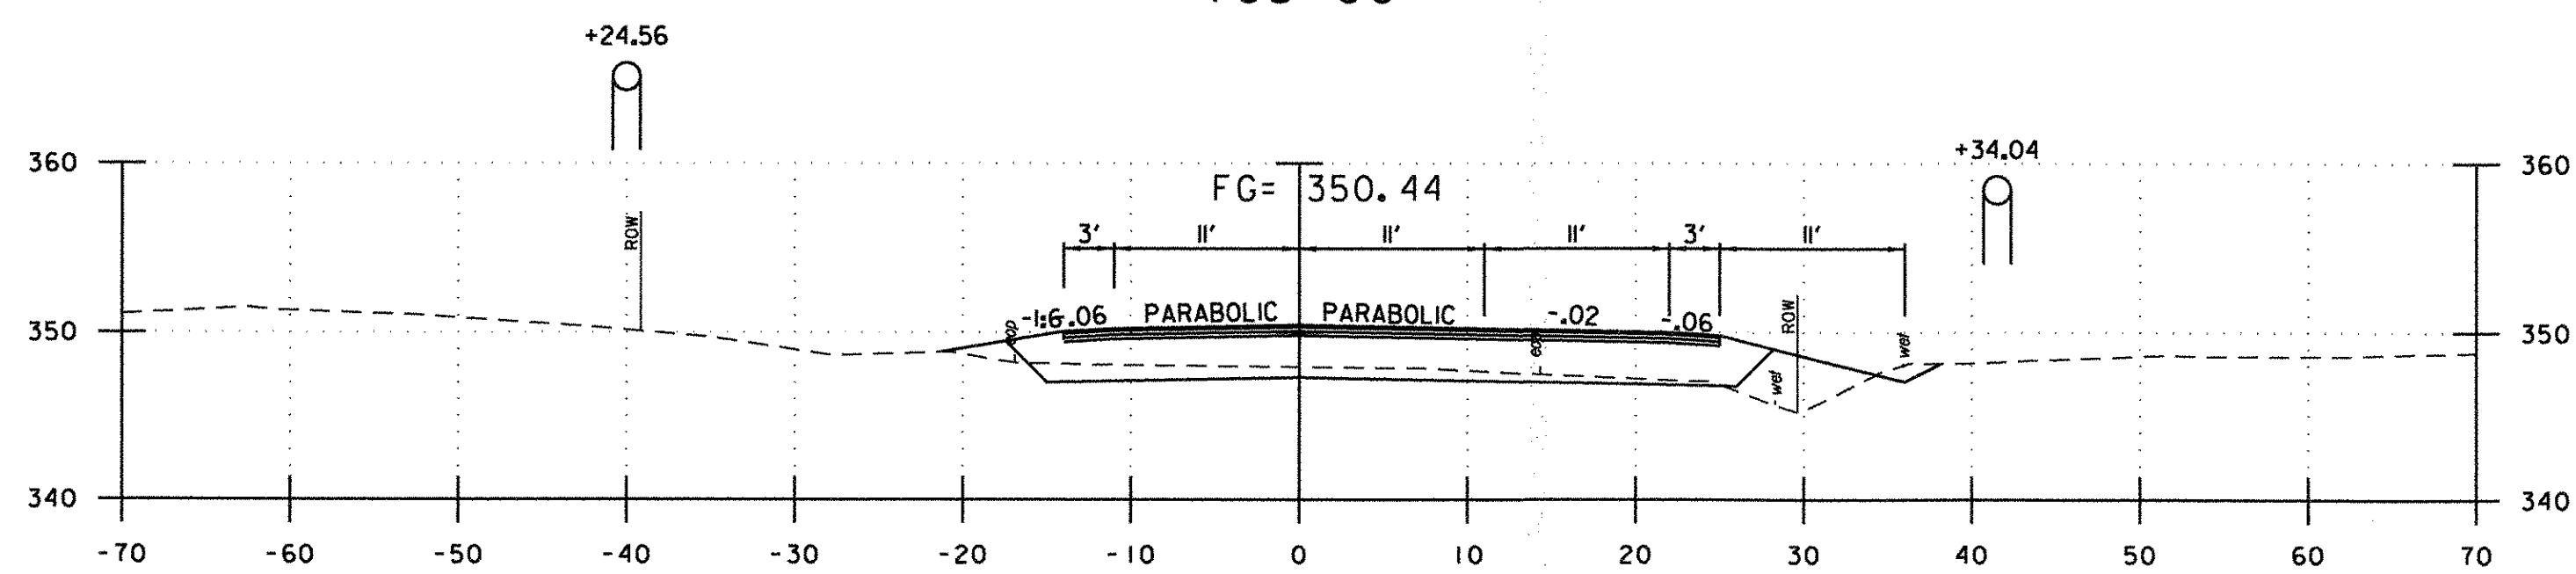

104+50

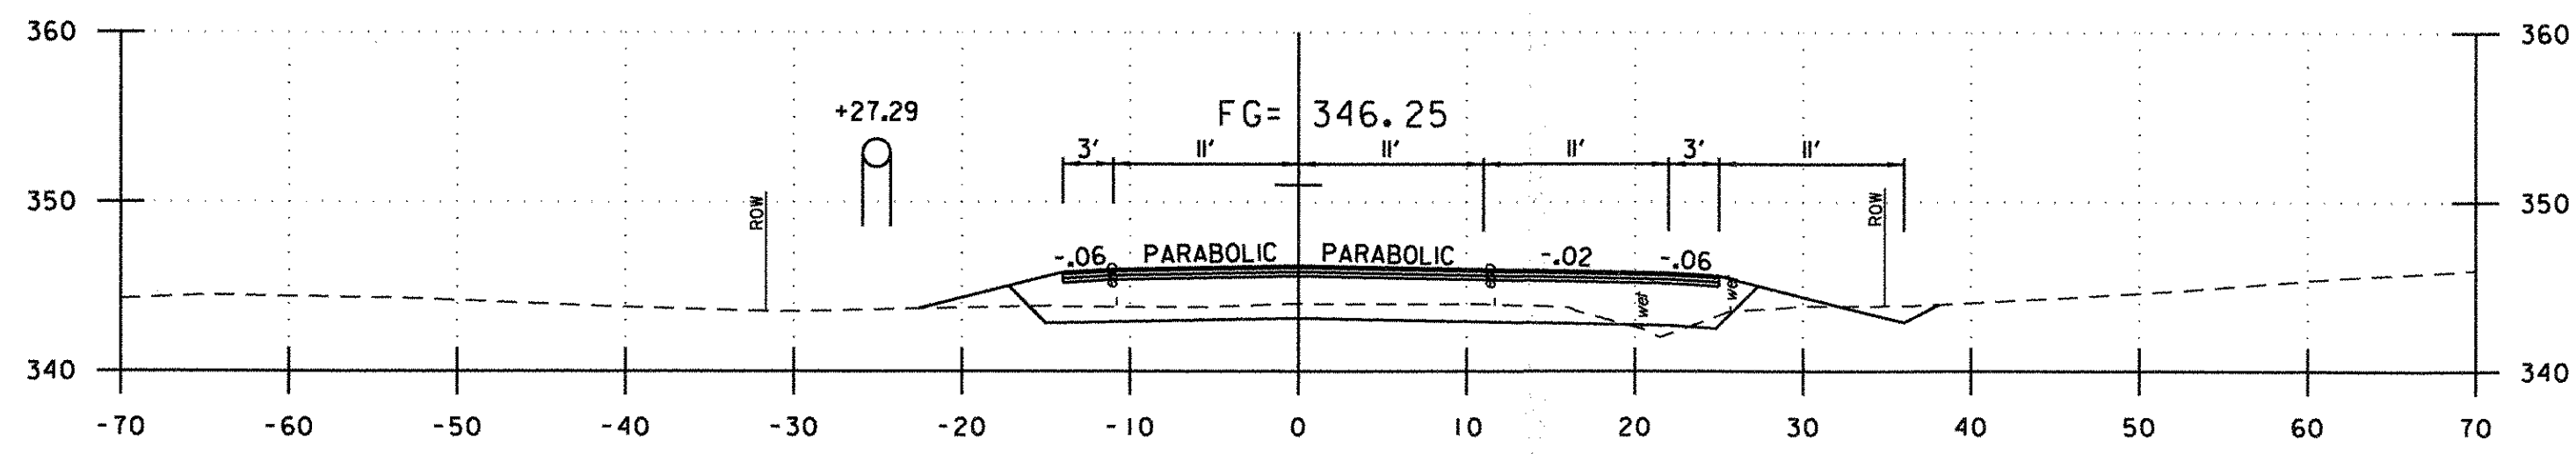


104+00

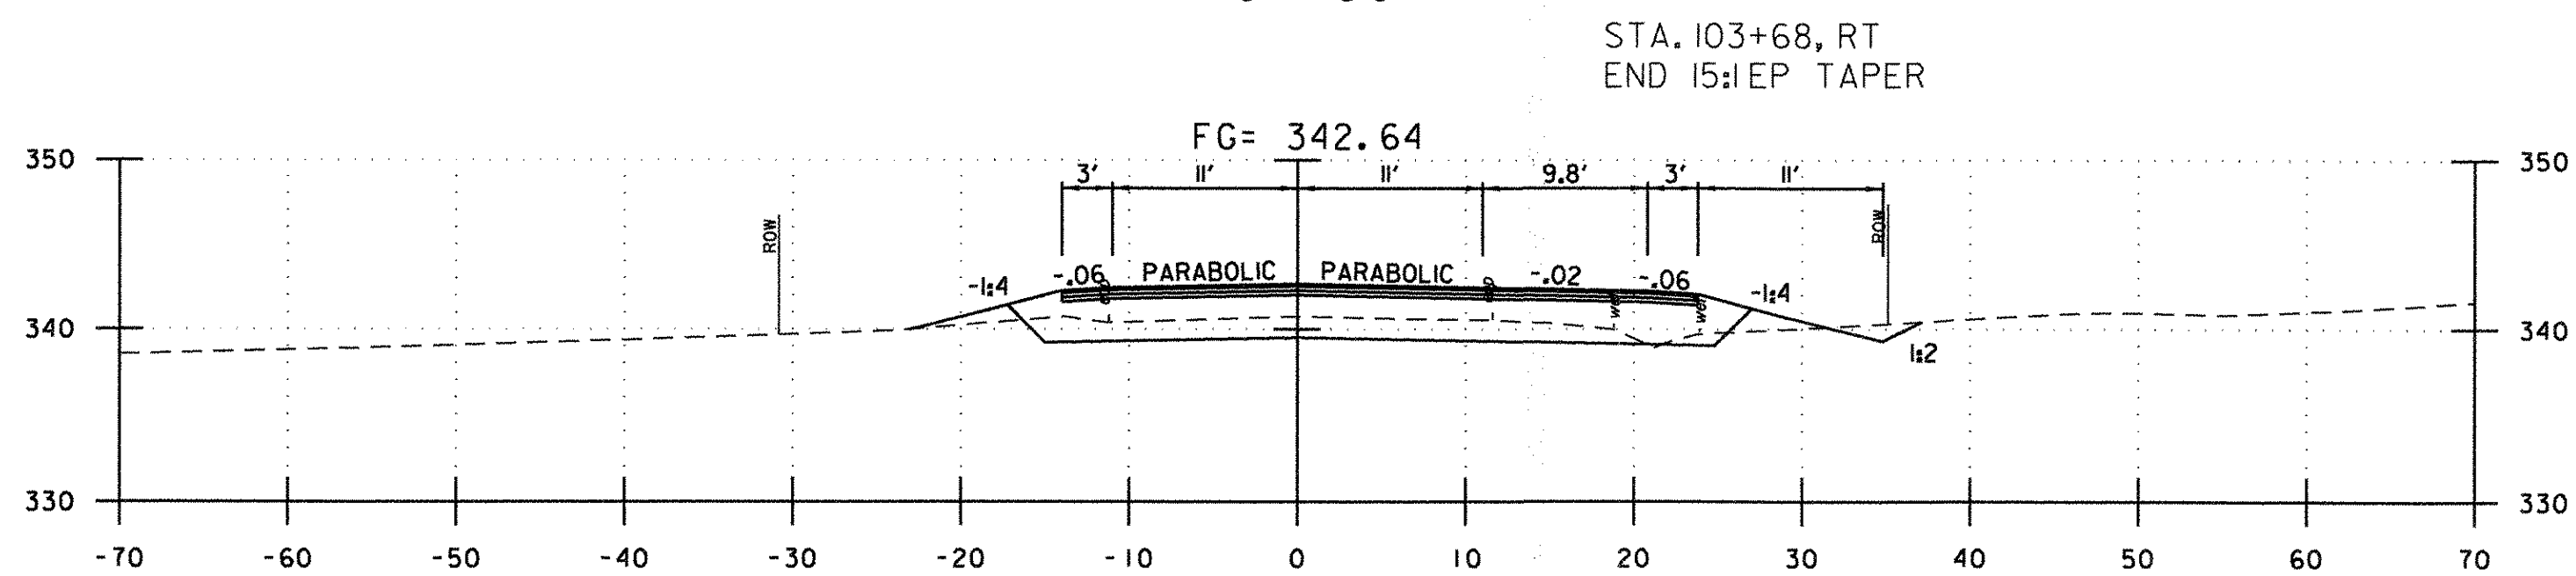

103+50

TH 4 SILVER ST STA 105+80.43 =
VT 116 STA 2+48.24

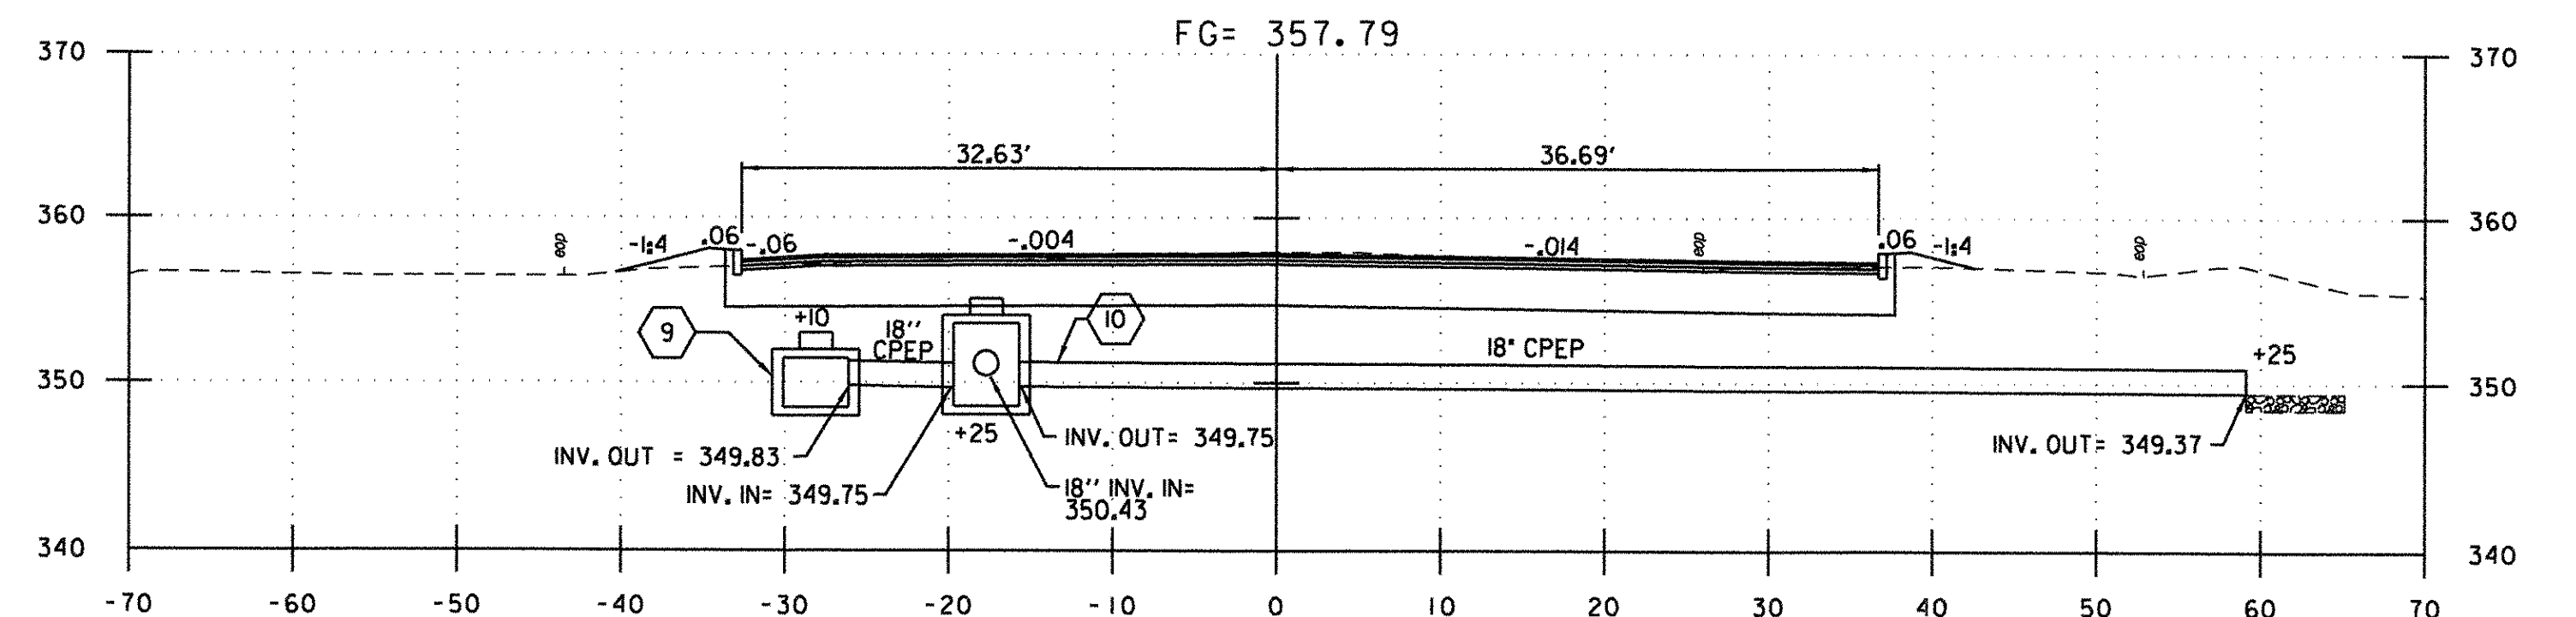

105+50

TH4 SILVER STREET



PROJECT NAME: HINESBURG
PROJECT NUMBER: HES 021-1(20)

FILE NAME: z04b206xsec.dgn
PROJECT LEADER: G. BAKOS
DESIGNED BY: D. PECK
CROSS SECTIONS 4

PLOT DATE: 2/18/2009
DRAWN BY: D. PECK
CHECKED BY: G. BAKOS
SHEET 25 OF 25