

CONSTRUCTION NOTES

DURABLE 4 INCH WHITE LINE, THERMOPLASTIC

SIA. 2+84.0 - 3+90.5, LI.  
 STA. 2+84.0 - 3+80.5, RT.  
 STA. 3+06.0 - 3+41.0, RT.  
 STA. 4+80.0 - 5+65.0, RT.  
 SIA. 5+03.7 5+65.0, LI.  
 STA. 100+36.4 101+00.0, LT.  
 STA. 100+37.4 - 101+25.0, LT.  
 STA. 100+31.2 - 101+25.0, RT.

TEMPORARY 4 INCH YELLOW LINE (DOUBLE CENTER LINE)

SIA. 2+84.0 - 3+09.0  
 STA. 5+40.0 - 5+65.0  
 STA. 101+00 - 101+25.0

REMOVING SIGNS

SIA. 2+97, RI. (2 SIGNS)  
 STA. 3+00, LT. (2 SIGNS)  
 STA. 4+80, LT.  
 STA. 100+47, LT. (3 SIGNS)

DURABLE 4 INCH YELLOW LINE, THERMOPLASTIC (DOUBLE CENTER LINE)

STA. 2+84.0 - 3+80.5  
 STA. 5+03.7 - 5+65.0  
 SIA. 100+36.0 - 101+25.0

DURABLE 8 INCH WHITE LINE, THERMOPLASTIC

STA. 3+06.0 - 3+41.0, RT.

DURABLE LETTER OR SYMBOL, THERMOPLASTIC



STA. 100+42.0, LT. (LEFT TURN ARROW)  
 STA. 100+42.0, LT. (RIGHT TURN ARROW)  
 STA. 100+82.0, LT. ("ONLY")  
 SIA. 100+82.0, LI. ("ONLY")

DURABLE 24 INCH STOP BAR, THERMOPLASTIC

STA. 3+80.5, RT.  
 STA. 5+03.7, LT.  
 SIA. 100+36.0, LI.  
 STA. 4+43.1 - 4+60.1, RT.

DURABLE CROSSWALK MARKING, THERMOPLASTIC

SIA. 3+85.8, RI. - 3+98.0, LI  
 STA. 4+43.0 4+60.0, RT.  
 STA. 100+28.0, LT. - RT.

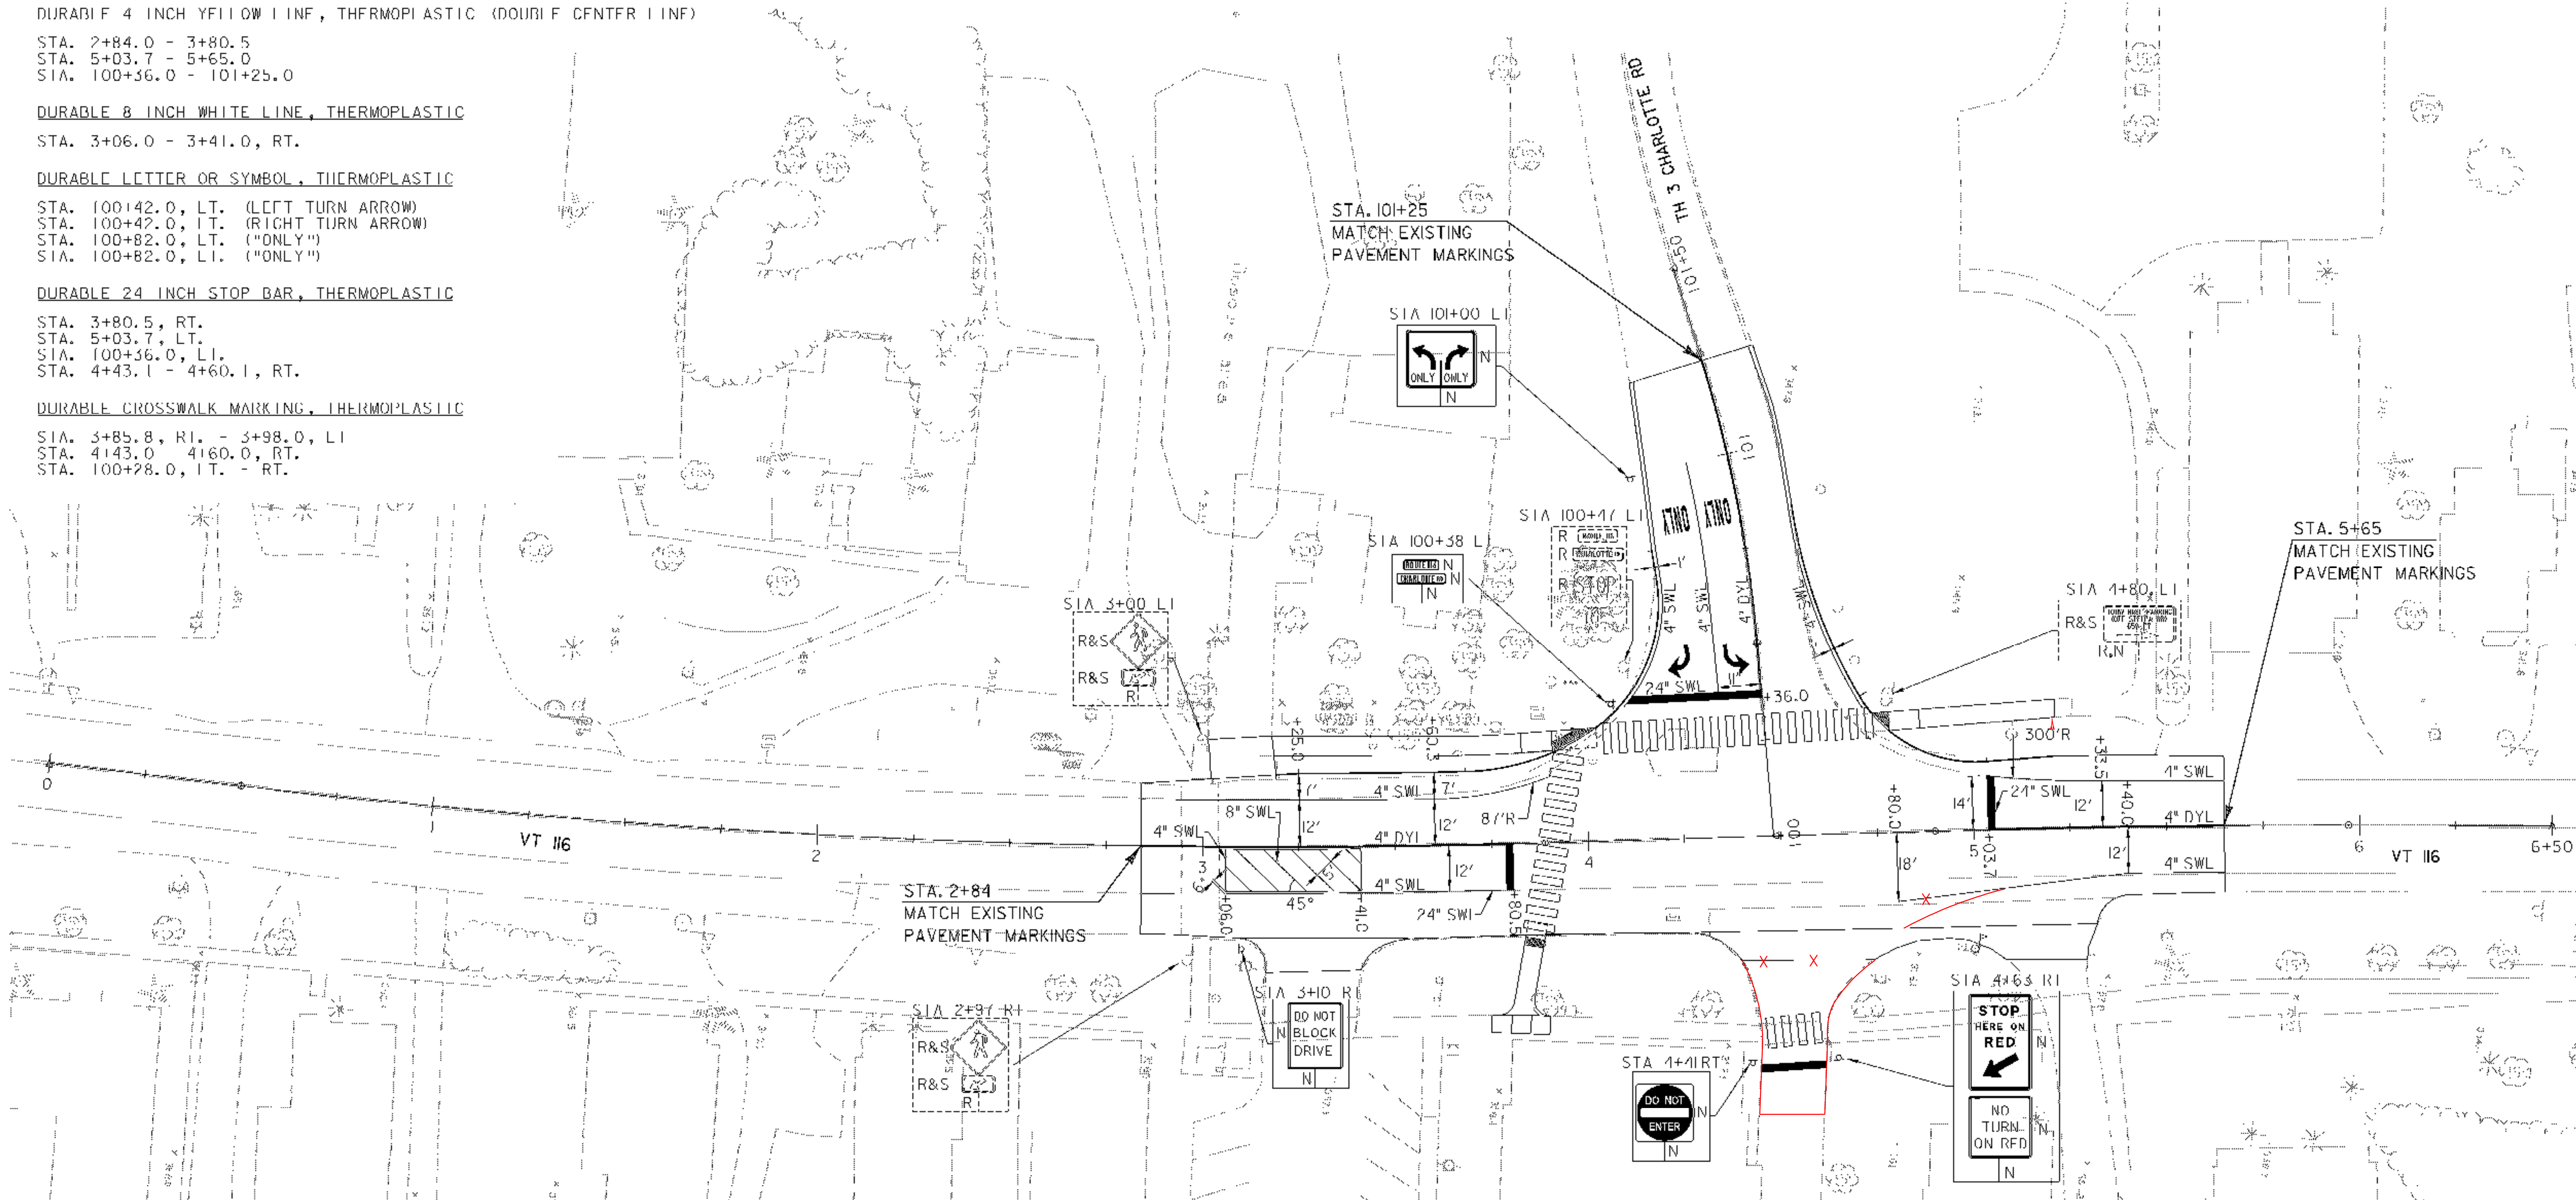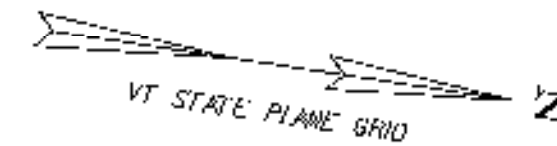

SIGN LEGEND	
N	= NEW
R	= REMOVE
RET	= RETAIN
R&S	= REMOVE & SALVAGE SIGN

STRIPING LEGEND	
SWL	= SINGLE WHITE LINE
DYL	= DOUBLE YELLOW LINE

NOTE:  
 ALL SIGNS REMOVED AND NOT REUSED ON THE PROJECT WILL BE RETURNED TO THE DISTRICT 5 OFFICES, COLCHESTER, VT FOR REUSE, EXCEPT FOR SIGNS REMOVED AT STATION 100+47, LI, WHICH SHALL BE DISPOSED OF BY THE CONTRACTOR.



PROJECT NAME:	HINFSBURG	FILE NAME:	z01b2081a2.dgn	PLOT DATE:	5/4/2007
PROJECT NUMBER:	HES 021-K(21)	PROJECT LEADER:	G. BAKOS	DRAWN BY:	D. PECK
		DISTRICT ENGINEER:	D. PECK	CHECKED BY:	G. BAKOS
		SIGNING AND STRIPING PLAN			SHEET 11 OF 19

