

INDEX OF SHEETS

- 1 TITLE SHEET
- 2 TYPICAL SECTIONS
- 3 DETAILS SHEET
- 4 QUANTITY SUMMARY SHEET
- 5 DRAINAGE DETAIL SHEET
- 6 TIE SHEET
- 7 RIGHT OF WAY DETAIL SHEET
- 8 RIGHT OF WAY PLAN
- 9 GENERAL PLAN
- 10 PROFILES
- 11 SIGNING AND STRIPING PLAN
- 12 TRAFFIC SIGN SUMMARY SHEET
- 13 TRAFFIC SIGNAL PLAN
- 14 TRAFFIC SIGNAL NOTES
- 15 SINGLE MAST ARM CANTILEVER / FOOTING DETAIL SHEET
- 16 MAST ARM CROSS SECTIONS
- 17 CONSTRUCTION APPROACH SIGNING
- 18 EXISTING CONDITIONS PLAN
- 19 EROSION PREVENTION & SEDIMENT CONTROL PLAN (EPSCI)




STATE OF VERMONT
AGENCY OF TRANSPORTATION



PROPOSED SAFETY IMPROVEMENTS
TOWN OF HINESBURG
COUNTY OF CHITTENDEN
VT 116 (MINOR ARTERIAL)
AT CHARLOTTE ROAD (MAJOR T.H. COLLECTOR)

BEGINNING ON VT 116 AT A POINT APPROXIMATELY 130 FT. SOUTH OF CHARLOTTE ROAD
AND EXTENDING NORTHERLY ALONG VT 116 FOR 231 FT.

LENGTH OF ROADWAY: 231 FT = 0.044 MILES
LENGTH OF PROJECT: 231 FT = 0.044 MILES
WORK TO BE PERFORMED UNDER THIS PROJECT INCLUDES REHABILITATION OF VT 116 AND CHARLOTTE RD.
INTERSECTION, WITH SOME MINOR WIDENING AND SIDEWALK RECONSTRUCTION, PAVEMENT MARKINGS AND SIGNS,
AND THE ADDITION OF A TRAFFIC SIGNAL SYSTEM, INCLUDING THE INSTALLATION OF PEDESTRIAN SIGNALS.

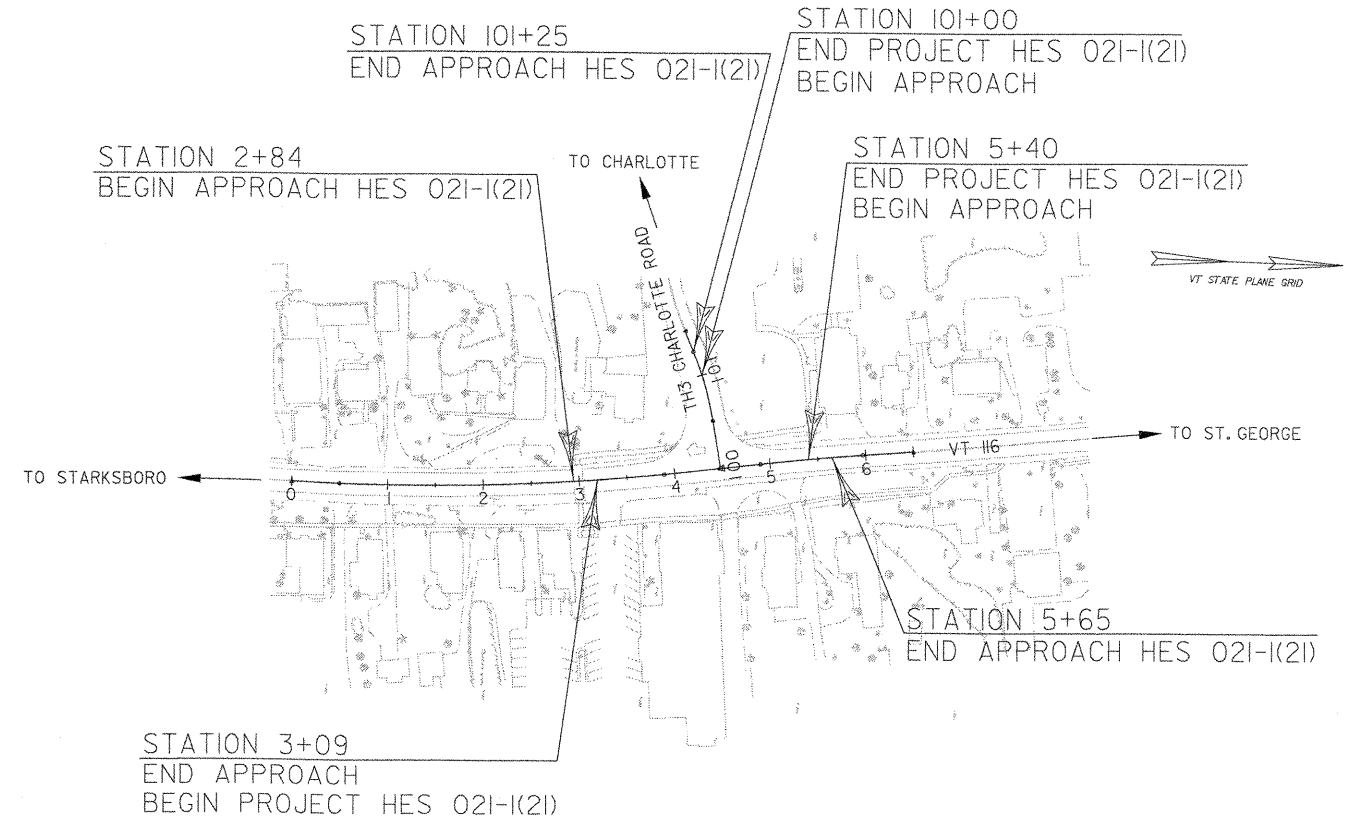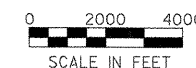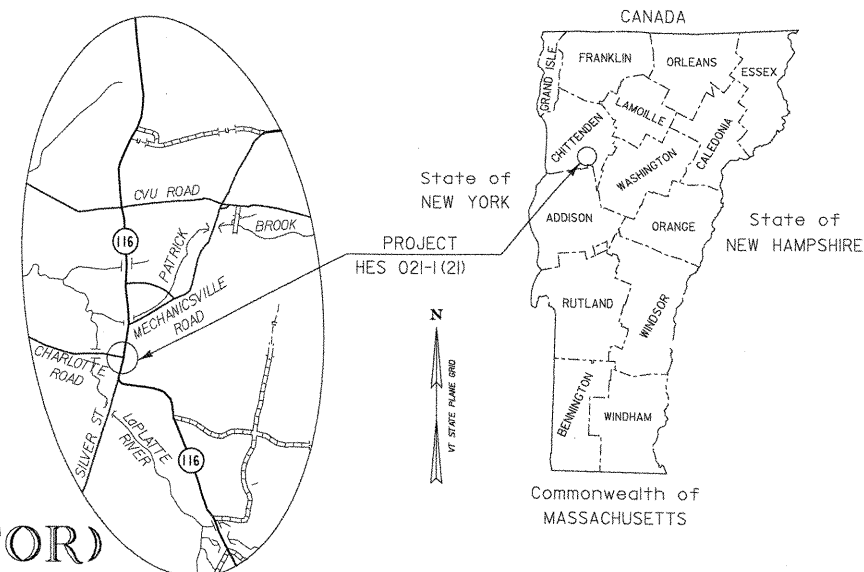

TRAFFIC DATA			
VT 116		116S	
ADT 2007 = 12,600	ADT 2027 = 15,700	ADT 2007 = 2,500	ADT 2027 = 3,000
2007 DHV = 1,300	2027 DHV = 1,600	2007 DHV = 280	2027 DHV = 350
2007 ADTT = 980	2027 ADTT = 1,900	2007 ADTT = 210	2027 ADTT = 350
2007 TD = 11	2027 TD = 11	2007 TD = 58	2027 TD = 58
2007 XT = 6.8	2027 XT = 10.9	2007 XT = 6.6	2027 XT = 9.2
DESIGN SPEED = 25 MPH		DESIGN SPEED = 35 MPH	
POSTED SPEED = 25 MPH		POSTED SPEED = 25 MPH	
2007-2027 ESAL'S = 1,150,000		2007-2027 ESAL'S = 1,027,000	
2007-2047 ESAL'S = 16,360,000		2007-2047 ESAL'S = 2,530,000	

RECORD PLANS

CONTRACTOR: DON WESTON EXCAVATING INC. - WILLISTON, VT

RESIDENT ENGINEER: TOM MANCINI

CONSTRUCTION BEGAN: AUGUST 6, 2007

CONSTRUCTION COMPLETE: NOVEMBER 1, 2008

RECORD PLANS BY: TOM MANCINI & N. GARRACK

I HEREBY CERTIFY THAT ALL THE CONSTRUCTION REQUIRED BY THIS SET OF DRAWINGS HAS BEEN ACCOMPLISHED AS INDICATED HEREIN.


BY: *Tom Mancini* RESIDENT ENGINEER

DATE: 3/1/09

NOTE: Any further information concerning final quantities, amounts or other details relative to this project may be found at Central Files in the electronic archives.

THESE PLANS ARE SUBJECT TO SUCH ENGINEERING CHANGES AS MAY BE REQUIRED BY THE FEDERAL HIGHWAY ADMINISTRATION OR THE DIRECTOR OF PROGRAM DEVELOPMENT.

CONSTRUCTION IS TO BE CARRIED ON IN ACCORDANCE WITH THESE PLANS AND THE STANDARD SPECIFICATIONS FOR CONSTRUCTION DATED 2004 AS APPROVED BY THE FEDERAL HIGHWAY ADMINISTRATION ON JUNE 5, 2006. FOR USE ON THIS PROJECT, INCLUDING ALL SUBSEQUENT REVISIONS AND SUCH REVISED SPECIFICATIONS AND SPECIAL PROVISIONS AS ARE INCORPORATED IN THESE PLANS.

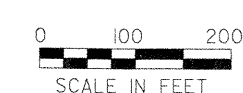

STANDARDS

C-1	1/3/00	E-105	3/1/04	E-162	5/20/99
C-3A	9/1/04	E-107	6/30/03	E-163	5/20/99
C-3B	9/1/04	E-107A	8/8/95	E-164	5/20/99
D-1	6/1/94	E-118	3/1/97	E-170	1/4/99
D-8	1/3/00	E-119	3/1/04	E-171A	8/9/95
D-11	6/1/94	E-121	8/8/95	E-171B	8/9/95
D-13	1/3/00	E-123	3/16/04	E-171C	8/9/95
D-15	6/1/94	E-140	8/30/96	E-172	8/9/95
E-100	1/2/04	E-143	6/25/04	E-173	8/9/95
E-100A	1/2/04	E-145A	12/23/94	E-175	11/17/93
E-101	5/30/03	E-146	3/20/95	E-181	2/1/93
E-102	6/30/03	E-160	5/20/99	E-182	10/21/00
E-102A	5/1/04	E-161	8/18/95	J-3	8/7/95

CONVENTIONAL SIGNS

TOWN LINE	---	AIRIAL SURVEY BY: COL. EAST, INC.
LIMITS OF ACCESS	---	SURVEYED DATE: 2004
POINT OF ACCESS	X	DATUM
FENCE LINE	---	VERTICAL
STONE WALL	-----	HORIZONTAL
TRAVELED WAY	-----	NAVD 83
GUARD RAIL	-----	NAD 83
BARBED WIRE	-----	
UTILITY LINE	---	
CULVERT	---	
POWER POLE	---	
TELEPHONE POLE	---	
TREES	---	
CONTROL OF ACCESS	---	
PROPERTY LINE	---	
ROW: TRUNK LINE	---	
SLOPE RIGHTS	---	
TOP OF CUT	---	
TOE OF SLOPE	---	



APPROVED: *Tom Mancini* DATE: 5-29-07

DIRECTOR OF PROGRAM DEVELOPMENT

PROJECT: HINESBURG HES 021-1(21)

SHEET 1 OF 18 SHEETS

MATERIAL TOLERANCES

MATERIAL ITEM	THICKNESS TOLERANCE
PAVEMENT (TOTAL DEPTH)	± 3/16"
SUBBASE	± 1-3/16"

TYPICAL SECTIONS


1 1/2" BITUMINOUS CONCRETE PAVEMENT - TYPE III (PG 58-28)
 3 1/2"-4 1/2" BITUMINOUS CONCRETE PAVEMENT - TYPE I (PG 58-28) (1 LIFT)
 18" SUBBASE OF DENSE GRADED CRUSHED STONE

SEEDING FORMULA
 URBAN AREAS


% WT.	LBS./A.	NAME	PUR %	GERM %
42.5	34.0	CREeping RED FESCUE	98	85
10.0	8.0	PERENNIAL RYE GRASS	95	90
42.5	34.0	KENTUCKY BLUE GRASS	85	85
5.0	4.0	ANNUAL RYE GRASS	95	85
100.00	80.0			

GENERAL NOTES


- SEED MIXTURE: SHALL NOT HAVE A WEED CONTENT EXCEEDING 0.40% BY WEIGHT AND SHALL BE FREE OF ALL NOXIOUS SEED.
- SEED: TO BE APPLIED PER SEEDING FORMULAS OR AS DIRECTED BY THE ENGINEER.
- FERTILIZER: FORMULA 10-20-10, TO BE USED WITH SEED, APPLIED AT THE RATE OF 500 LBS./ACRE. (HYDRO SEEDERS MAY USE 19-19-19 FORMULA).
- AGRICULTURAL LIMESTONE: TO BE APPLIED AT THE RATE OF 2 TONS/ACRE, OR AS DIRECTED BY THE ENGINEER.
- HAY MULCH: TO BE PLACED ON EARTH SLOPES AT THE RATE OF 2 TONS/ACRE, OR AS DIRECTED BY THE ENGINEER.
- TOPSOIL: TO BE USED WITH SEED AS INDICATED ON THE PLANS, OR AS DIRECTED BY THE ENGINEER.

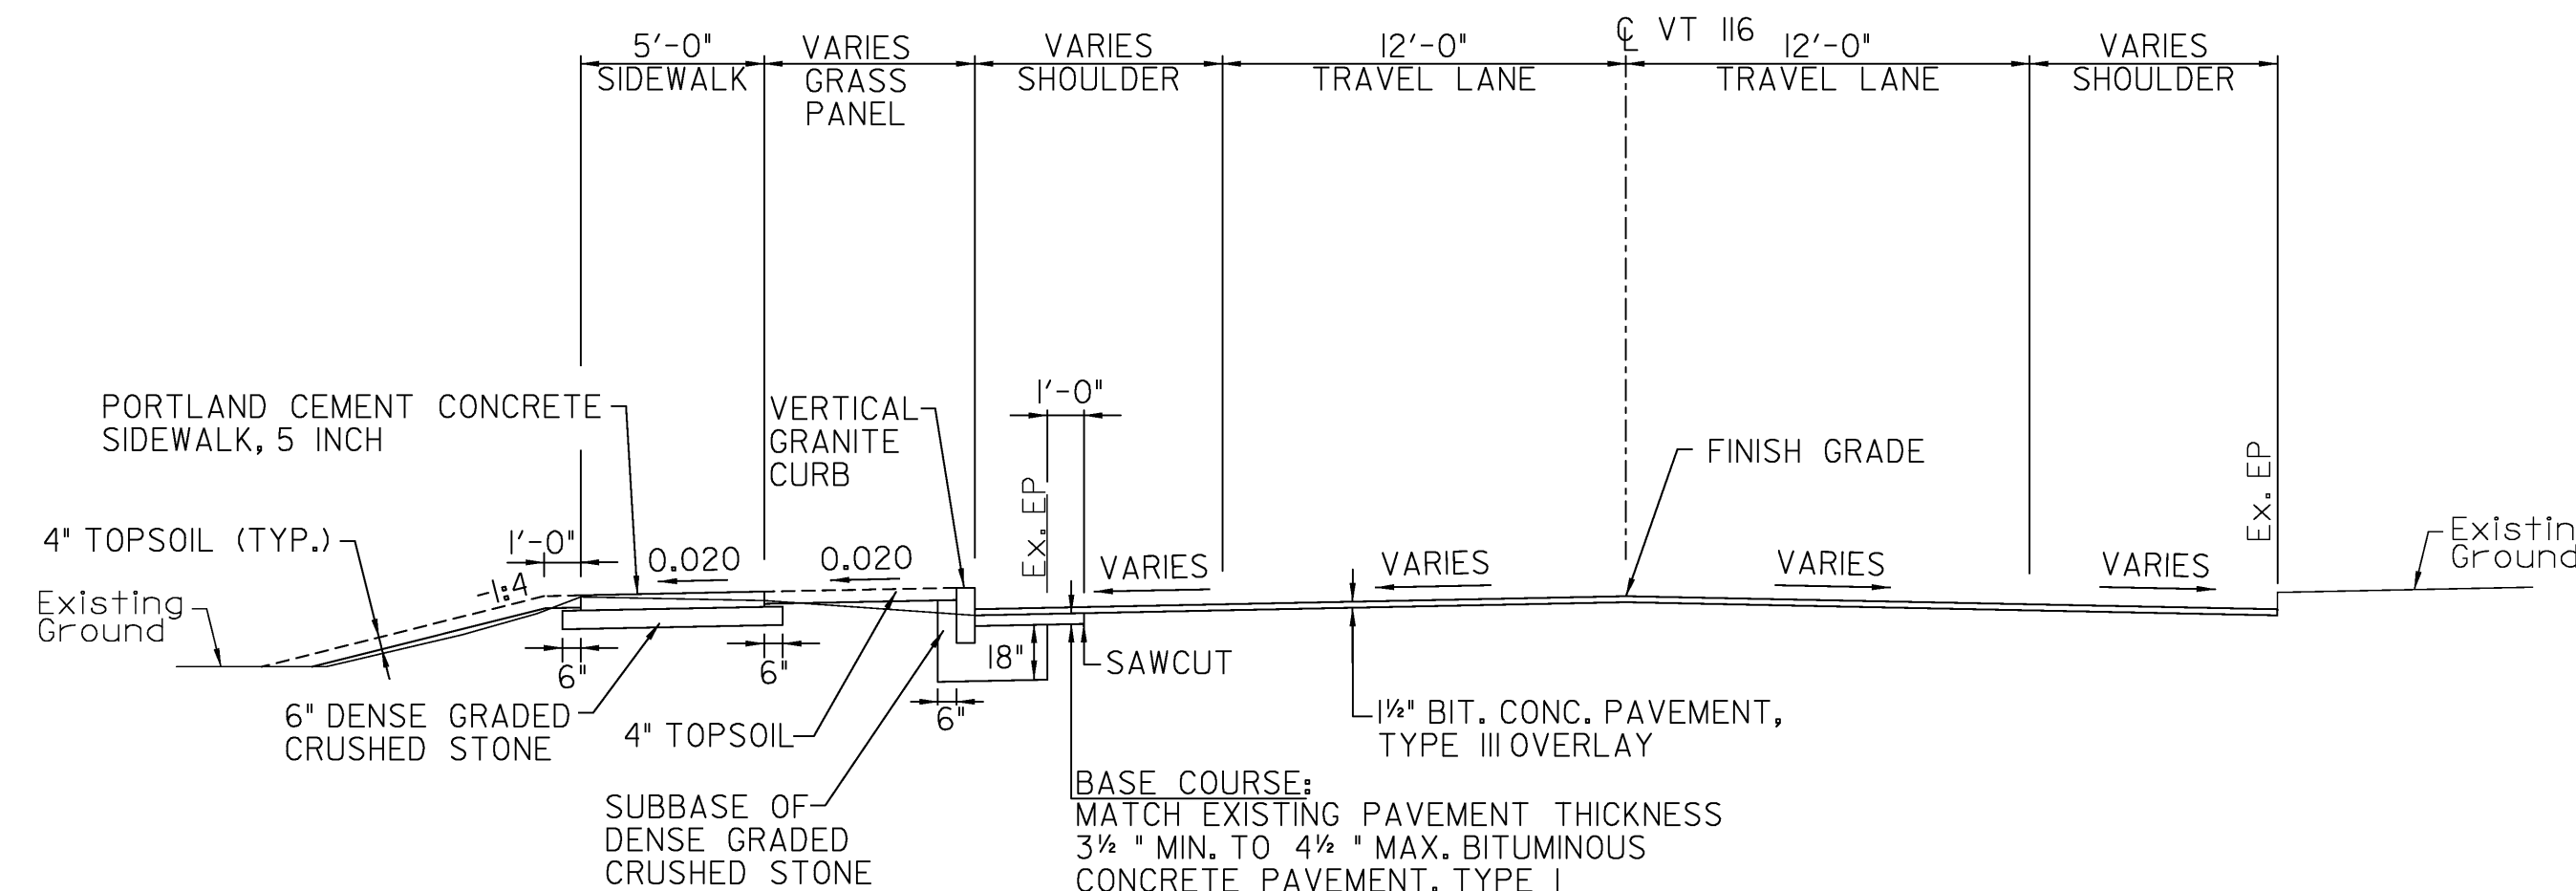

VT 116
 NOT TO SCALE

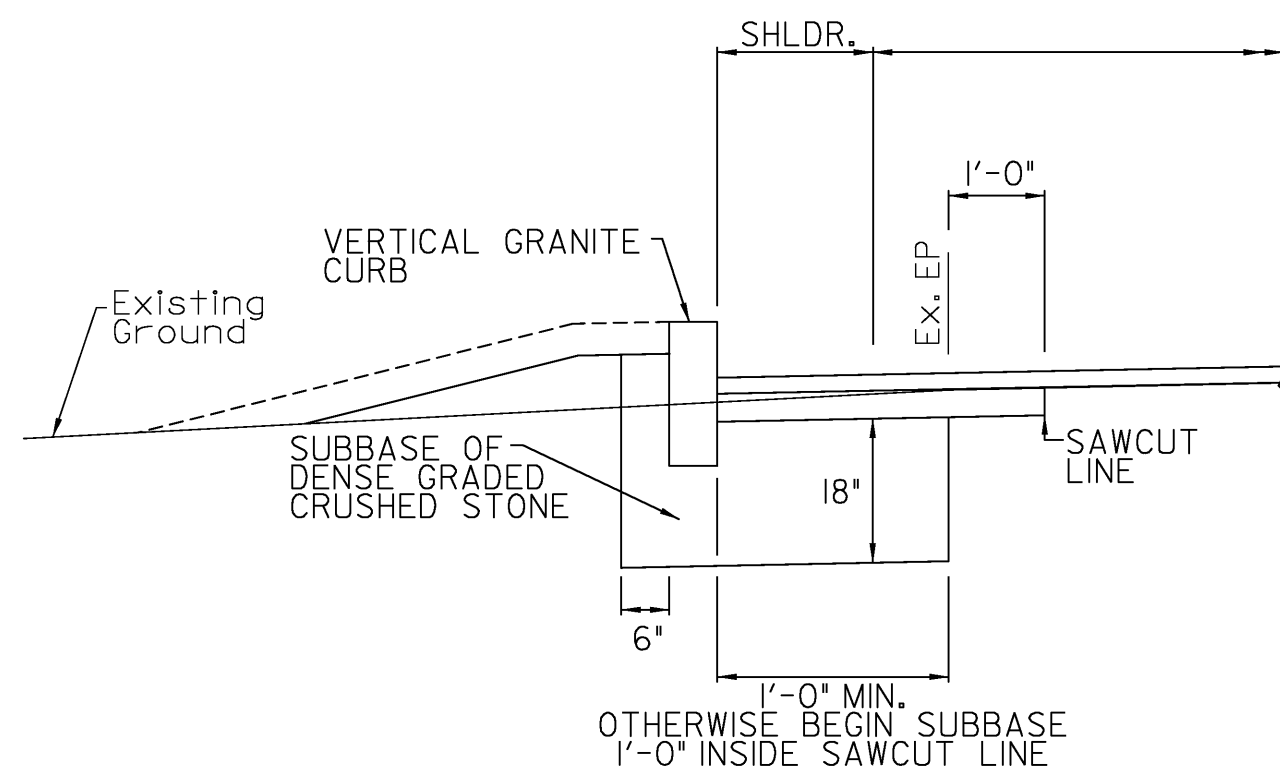

VERTICAL GRANITE CURB INSTALLATION
 NOT TO SCALE

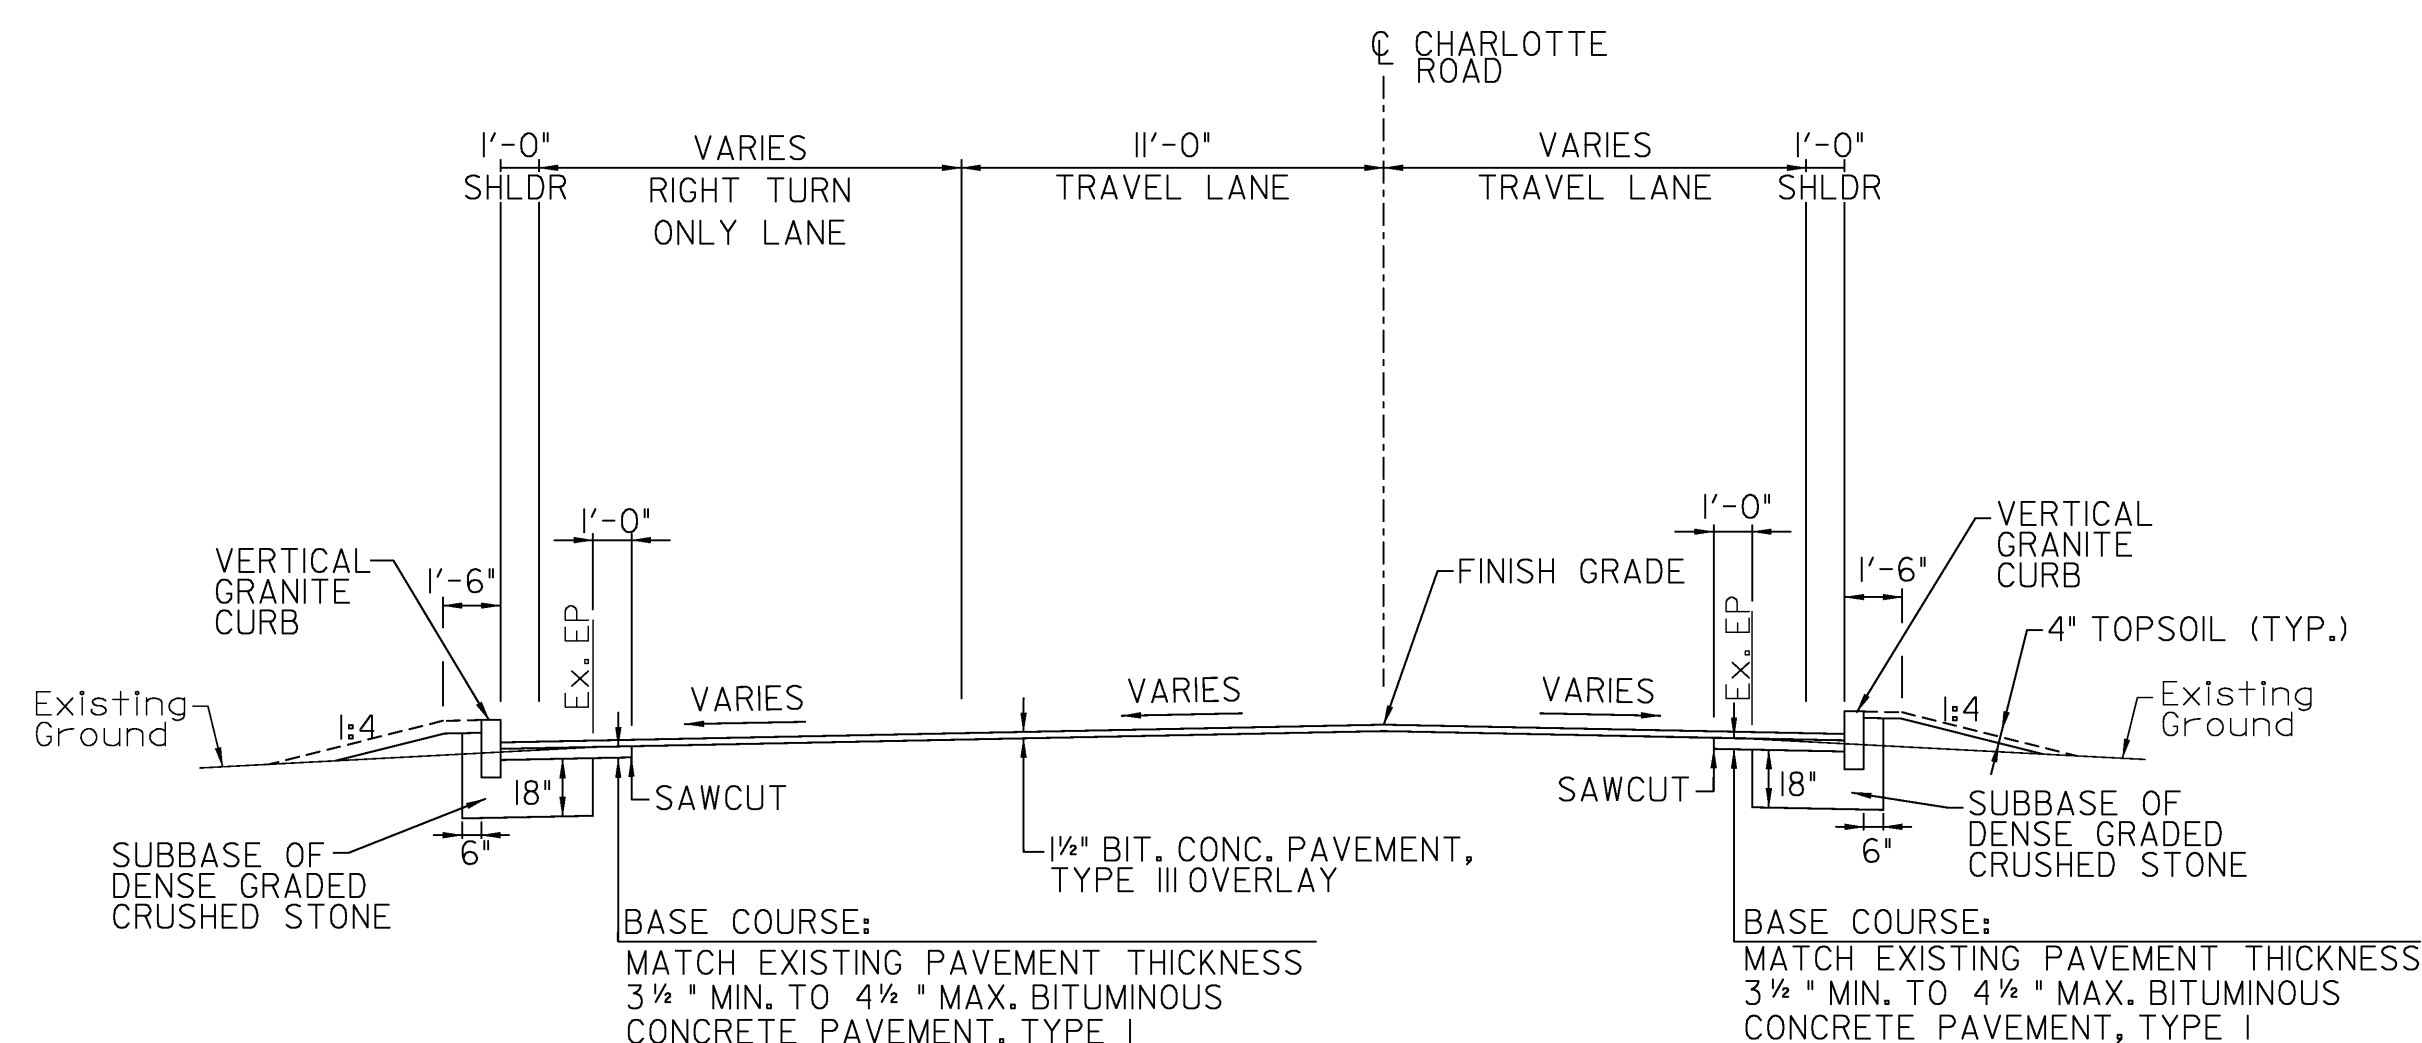

CHARLOTTE ROAD
 NOT TO SCALE

NOTES


- ALL NEW CURB SHALL HAVE A FINAL INSTALLED REVEAL OF SEVEN (7) INCHES.
- THE PROPOSED PAVEMENT OVERLAYS AND PAVEMENT WIDENINGS SHALL MATCH THE EXISTING ROADWAY CROSS SLOPES.
- PROPOSED DRIVE APRONS SHALL INCLUDE 1/2" COLD PLANED PAVEMENT MATCH.
- TACK COAT: EMULSIFIED ASPHALT IS TO BE APPLIED AT THE RATE OF 0.025 GAL/SY BETWEEN SUCCESSIVE COURSES OF PAVEMENT AS DIRECTED BY THE ENGINEER.
- MARKER POSTS: TO BE PLACED AS INDICATED OR AS DIRECTED BY THE ENGINEER.
- SIDEWALK RAMP DETECTABLE WARNING SURFACES SHALL BE TRUNCATED DOME DETECTABLE WARNING PLATES MANUFACTURED BY NEENAH FOUNDRY OR ANOTHER EQUAL CAST IRON PRODUCT FROM THE AGENCY'S APPROVED PRODUCTS LIST.
- SAWCUT OF EXISTING PAVEMENT SHALL BE SUBSIDIARY TO COMMON EXCAVATION (ITEM 203.15).

PROJECT NAME: HINESBURG
 PROJECT NUMBER: HES 021-(21)


FILE NAME: z04bB208+yp.dgn
 PROJECT LEADER: G. BAKOS
 DESIGNED BY: D. PECK
 TYPICAL SECTIONS

PLOT DATE: 5/4/2007
 DRAWN BY: D. PECK
 CHECKED BY: G. BAKOS
 SHEET 2 OF 19



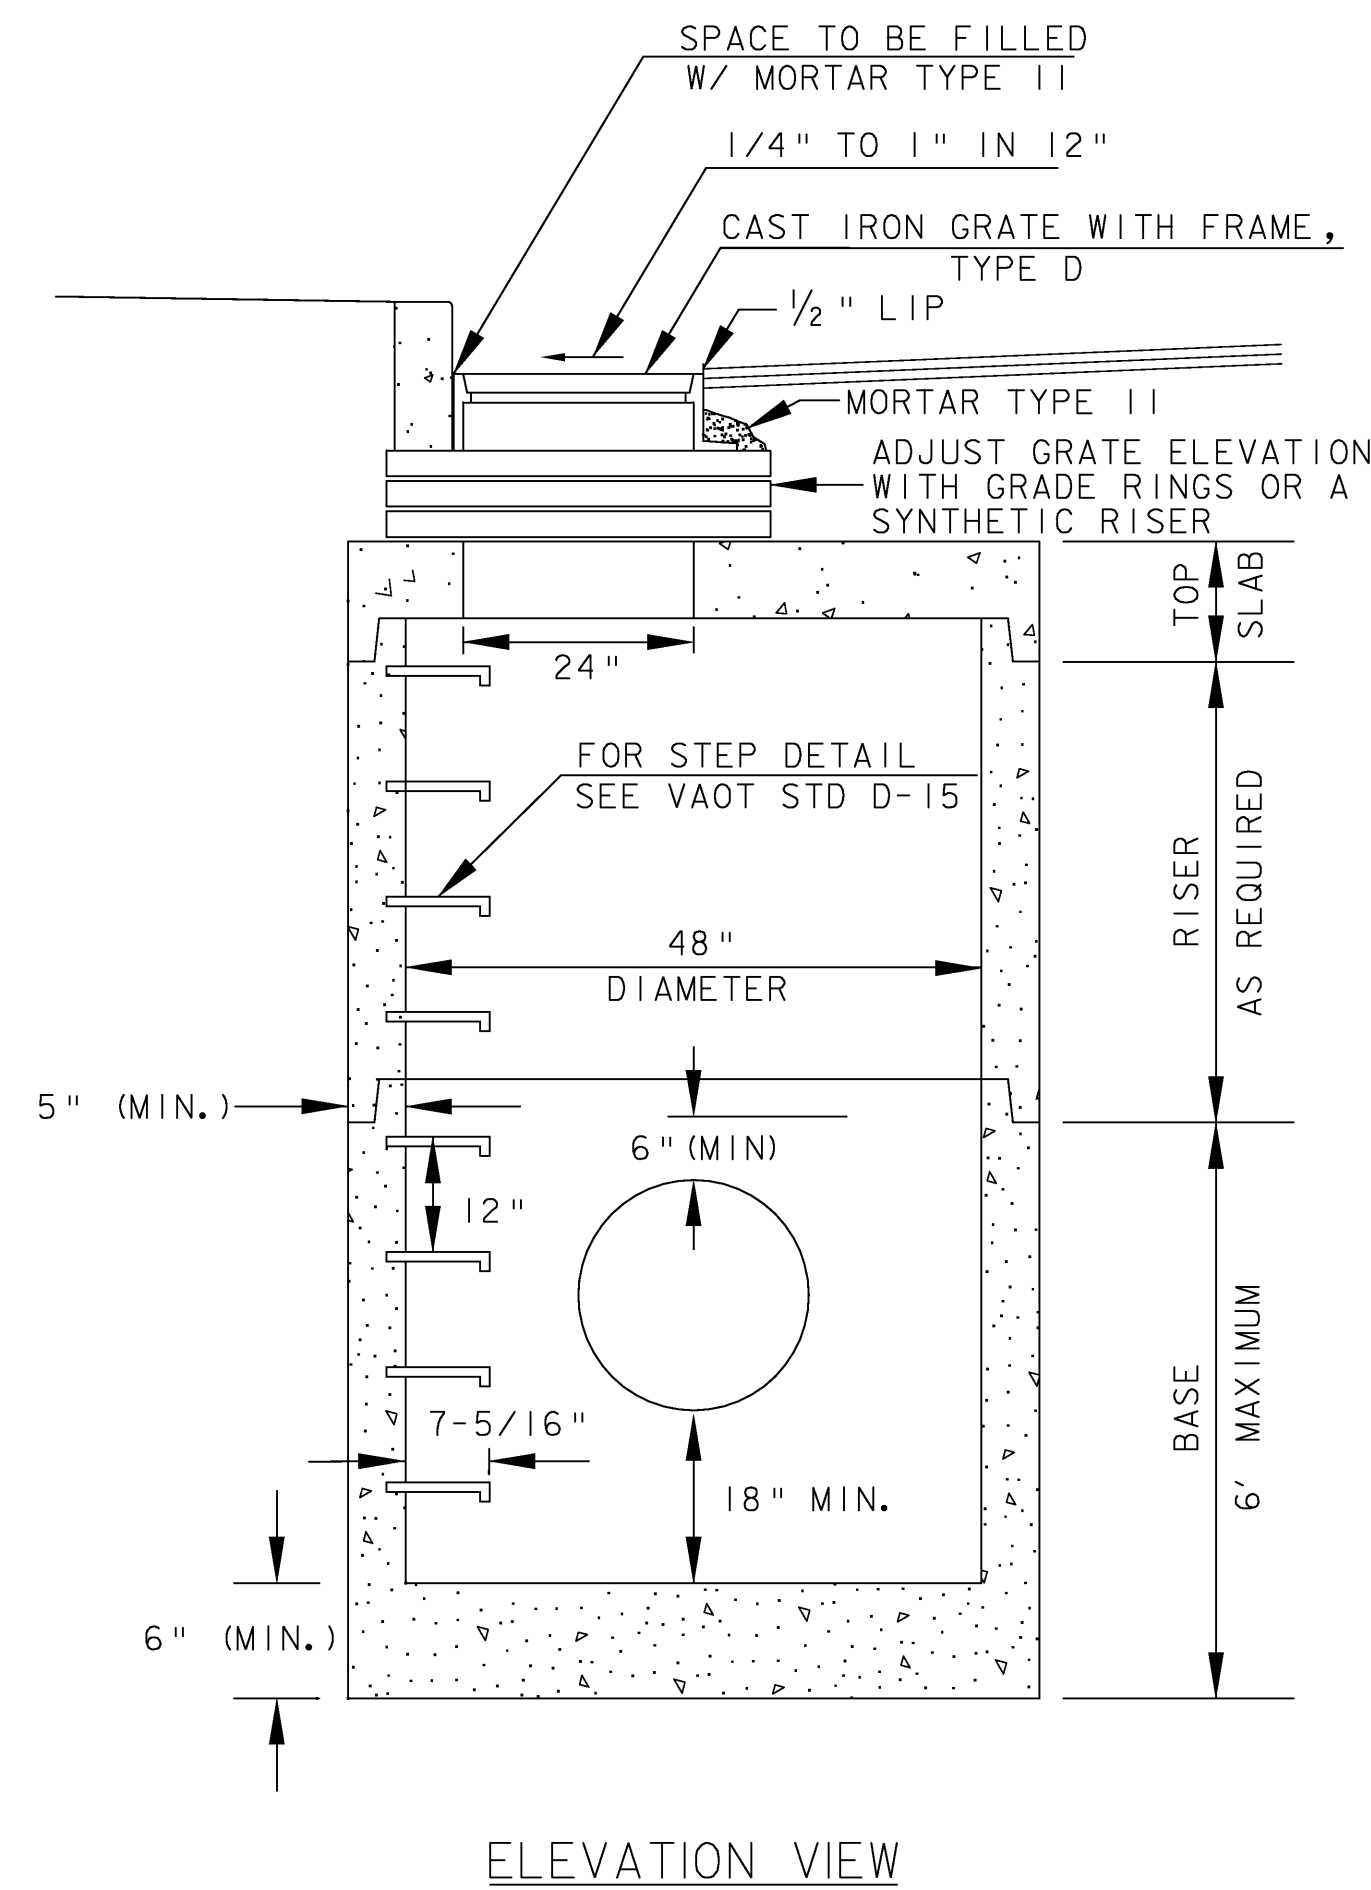

ELEVATION VIEW

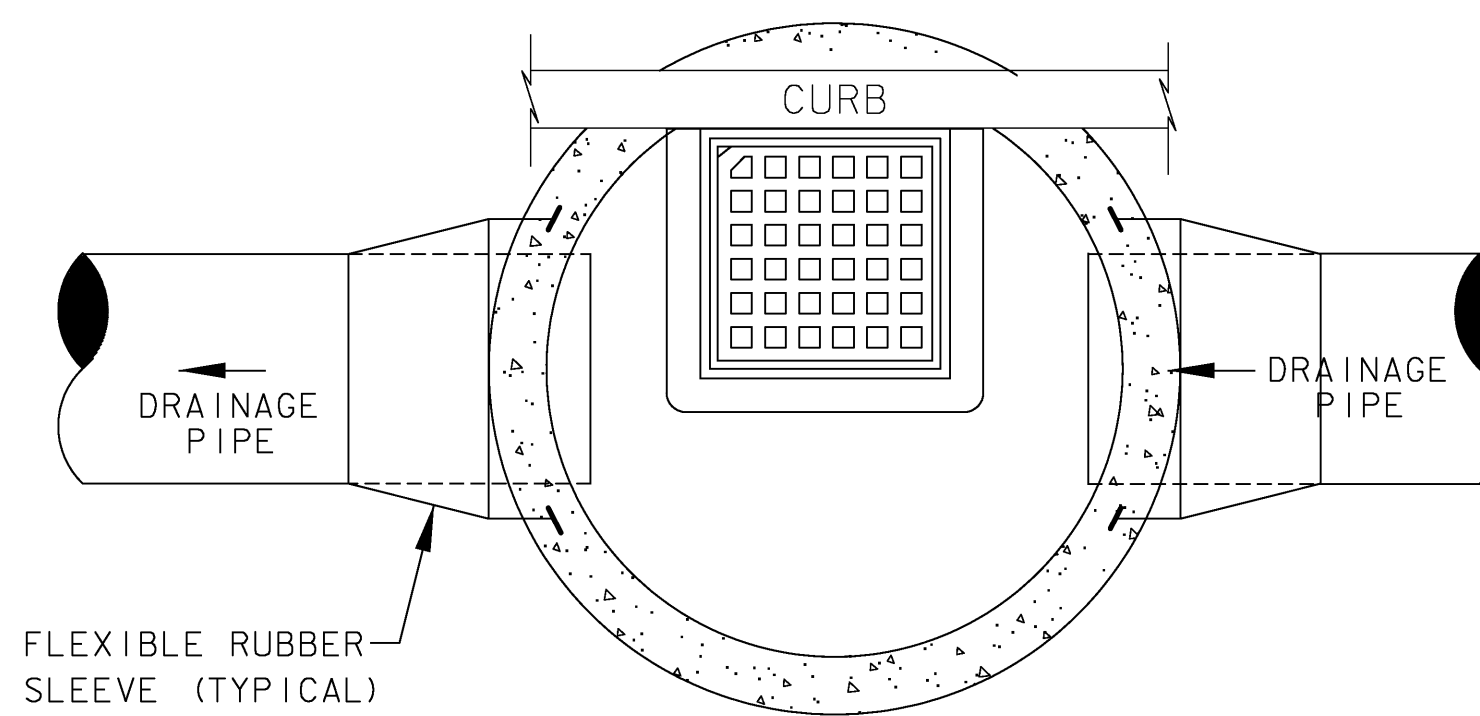


DROP INLET PLAN VIEW


TYPICAL PRECAST DROP INLET INSTALLED IN ROADWAY
NOT TO SCALE

PRECAST CONCRETE DROP INLET AND MANHOLE NOTES:

1. PRECAST CONCRETE SECTIONS SHALL CONFORM TO THE STANDARD SPECIFICATIONS AND ASTM C-478.
2. MINIMUM CONCRETE COMPRESSIVE STRENGTH: 4,000 PSI AT 28-DAYS
3. STEEL REINFORCING SHALL CONFORM TO ASTM A185 OR A82 FOR HS25 LOADING.
4. MANHOLE STEPS SHALL BE 14" WIDE STEEL REINFORCED COPOLYMER POLYPROPYLENE PLASTIC CONFORMING TO ASTM C-478 AND SHALL BE CAST INTO MANHOLE SECTIONS BY THE PRECAST CONCRETE MANUFACTURER.
5. FACE OF PIPE SHALL NOT PROJECT MORE THAN 2" OR LESS THAN 1" FROM INSIDE WALL OF STRUCTURE.
6. ALL STRUCTURES WITH MULTIPLE PIPES SHALL HAVE A MINIMUM OF 12" OF OUTSIDE SURFACE BETWEEN HOLES, NO MORE THAN 75% OF A HORIZONTAL CROSS-SECTION SHALL BE HOLES, AND THERE SHALL BE NO HOLES CLOSER THAN 3" TO JOINTS.
7. FITTING FRAME TO FINAL GRADE MAY BE DONE WITH A SYNTHETIC RISER OR WITH PRECAST CONCRETE GRADE RINGS OF APPROPRIATE THICKNESS (3 COURSES MAX).
8. ALL PIPE INVERTS AND PENETRATION ANGLES SHALL BE FIELD VERIFIED PRIOR TO PRECASTING.
9. PRECAST SECTIONS SHALL HAVE A TONGUE AND GROOVE JOINT AND BE ASSEMBLED USING A BUTYL RUBBER OR APPROVED EQUAL SEALANT.
10. PROVIDE FLEXIBLE RUBBER SLEEVES CONFORMING TO ASTM C-923, RESILIENT, OF SIZE REQUIRED, FOR EACH PIPE CONNECTING TO STRUCTURE. SLEEVES SHALL BE CAST INTO PRECAST STRUCTURE BY THE MANUFACTURER FOR ALL PIPE PENETRATIONS.
11. DROP INLET GRATE ORIENTATION SHALL BE IN ACCORDANCE WITH STANDARD DRAWING D-15 FOR TYPE D GRATES.
12. INSTALLATION OF DROP INLETS OVER EXISTING PIPES SHALL INCLUDE CLEAN CUTTING OF EXISTING PIPES, PROVIDING AN EXTENSION PIPE OF SIMILAR MATERIAL AND SIZE AS THE EXISTING PIPE, COUPLINGS REQUIRED FOR THE CONNECTION BETWEEN THE EXTENSION PIPE AND THE EXISTING PIPE, AND INSTALLING FLEXIBLE RUBBER SLEEVES AS SHOWN IN DETAILS PROVIDED ON THIS SHEET.
13. PAYMENT FOR INSTALLATION OF THE DROP INLETS SHALL BE MADE UNDER THE PRECAST REINFORCED CONC. DROP INLET WITH CAST IRON GRATE (ITEM 604.18).

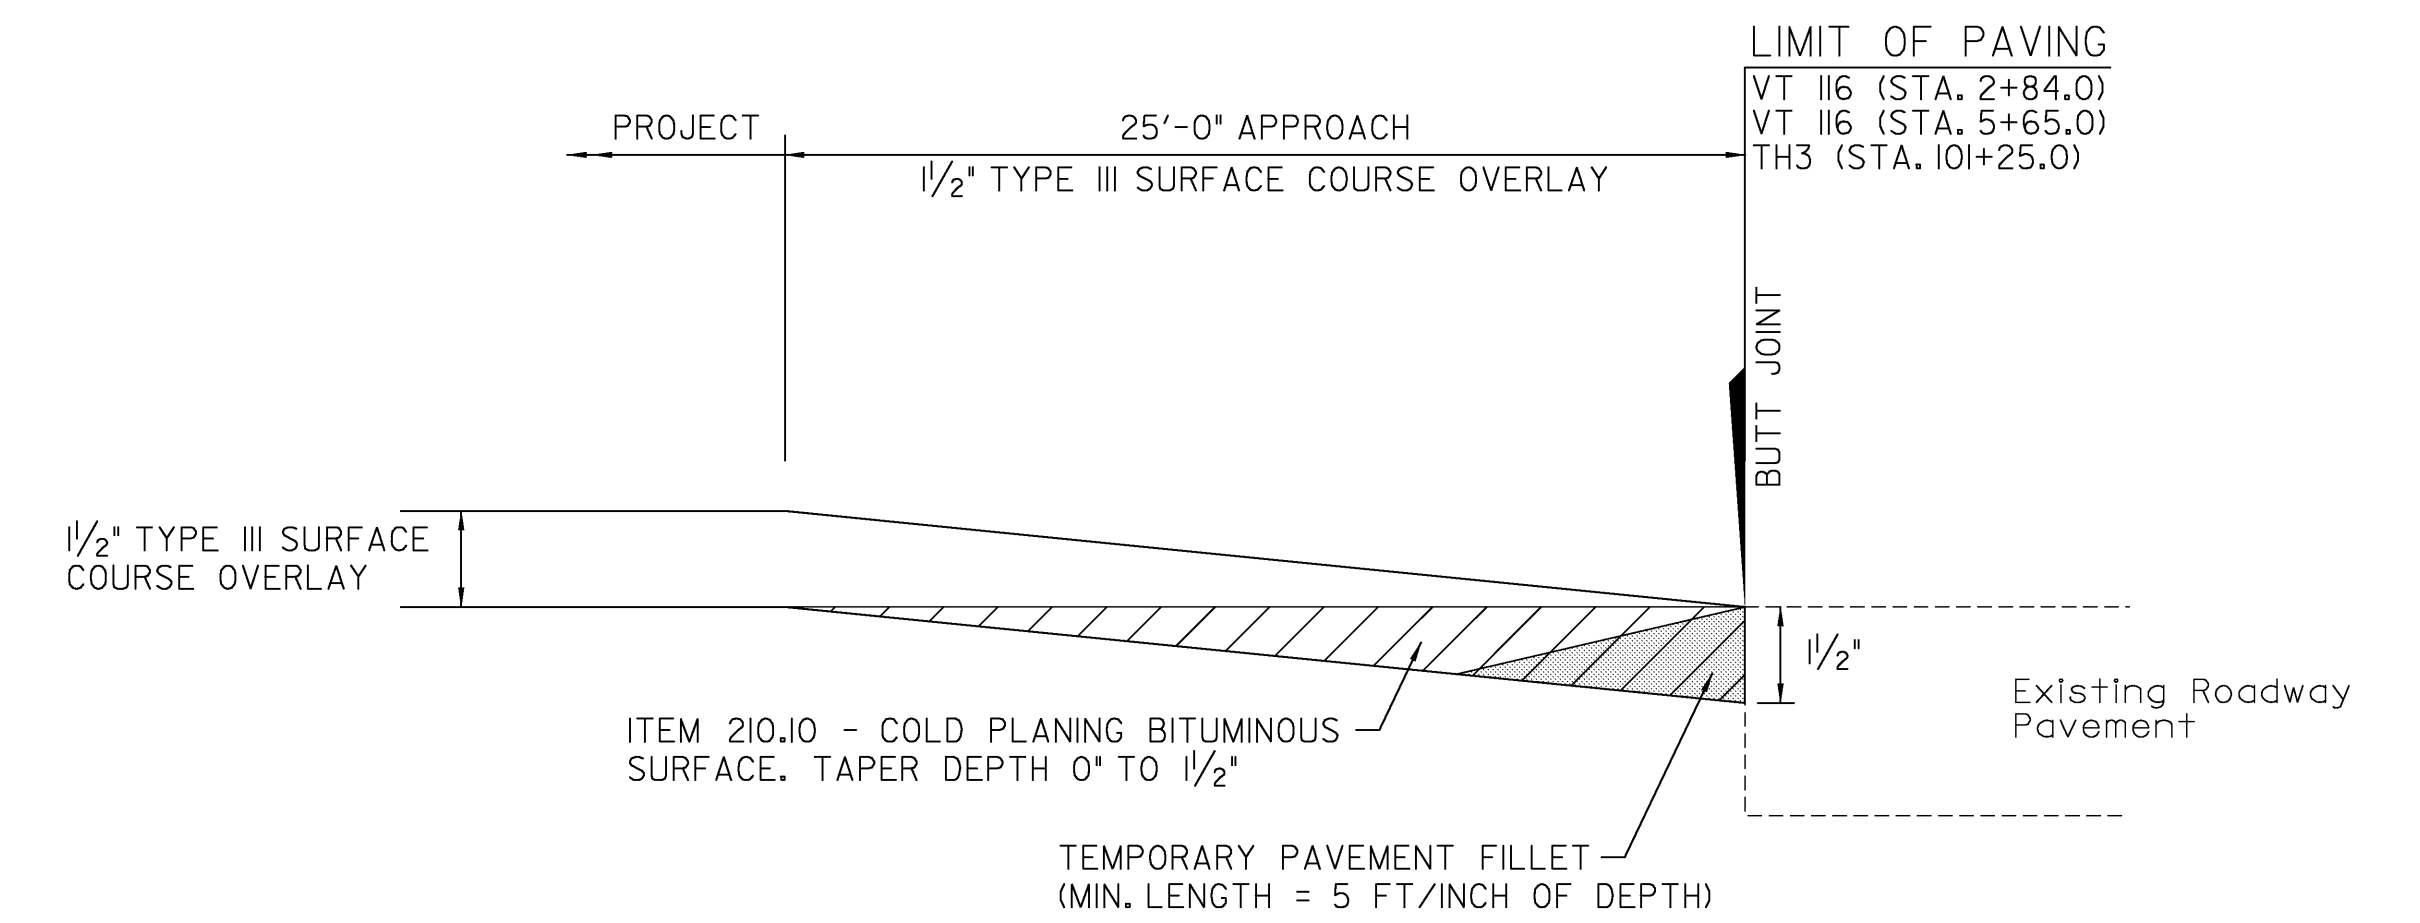

OVERLAY PAVEMENT MATCH TRANSITION DETAIL
NOT TO SCALE

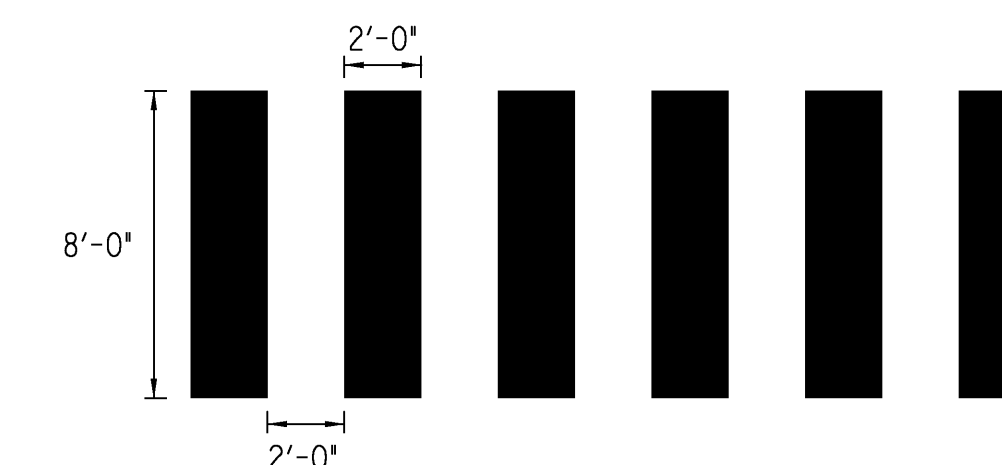

BLOCK STYLE CROSSWALK MARKING DETAIL
NOT TO SCALE

QUANTITY SUMMARY SHEET

SUMMARY OF ESTIMATED QUANTITIES							
TRAINEESHIP	FULL E&C ITEMS	EROSION CONTROL	ROADWAY	QUANTITIES GRAND TOTAL	UNIT	ITEMS	ITEM NO. ROUNDING
			100	100	CY	COMMON EXCAVATION	203.15 8.4
			18	18	CY	EXCAVATION OF SURFACES & PAVEMENTS	203.28 0.2
			12	12	CY	EARTH BORROW	203.30 EST.
			18	18	CY	TRENCH EXCAVATION OF EARTH	204.20 0.2
			14	14	CY	GRANULAR BACKFILL FOR STRUCTURES	204.30 0.5
			410	410	SY	COLD PLANING - BITUMINOUS PAVEMENT	210.10 2.3
			60	60	CY	SUBBASE OF DENSE GRADED CRUSHED STONE	301.35 6.9
			4	4	CWT	EMULSIFIED ASPHALT	404.65 0.1
			190	190	TON	BITUMINOUS CONCRETE PAVEMENT (PG 58-28)	406.25 9.9
			15	15	LF	12" PCCSP 0.064 (2-2/3 X 1/2)	601.0405 -
			1	1	EACH	PRECAST REINFORCED CONCRETE DROP INLET WITH CAST IRON GRATE	604.18 -
			2	2	EACH	CHANGING ELEV. OF DI'S CB'S OR MANHOLES	604.40 -
			1	1	EACH	CAST IRON COVER WITH FRAME	604.55 -
			60	60	MGAL	DUST CONTROL WITH WATER	609.10 6.2
			240	240	LF	VERTICAL GRANITE CURB	616.21 2.6
			1	1	EACH	RELOCATE MAILBOX, SINGLE SUPPORT	617.10 -
			100	100	SY	PORTLAND CEMENT CONCRETE SIDEWALK, 5 INCH	618.10 10.69
			45	45	SF	DETECTABLE WARNING SURFACE	618.30 1.5
			2	2	EACH	YIELDING MARKER POSTS	619.17 -
			50	50	LF	REMOVING AND RESETTING FENCE	620.50 2.0
			100	100	HR	UNIFORMED TRAFFIC OFFICERS	630.10 -
			100	100	HR	FLAGGERS	630.15 -
			1	1	LS	TESTING EQUIPMENT - CONCRETE	631.16 -
			1	1	LS	TESTING EQUIPMENT - BITUMINOUS	631.17 -
			1	1	LS	MOBILIZATION / DEMOBILIZATION	635.11 -
			1	1	LS	TRAFFIC CONTROL	641.10 -
			700	700	LF	DURABLE 4 INCH WHITE LINE, THERMOPLASTIC	646.402 8.0
			500	500	LF	DURABLE 4 INCH YELLOW LINE, THERMOPLASTIC	646.412 6.4
			80	80	LF	DURABLE 8 INCH WHITE LINE, THERMOPLASTIC	646.442 2.8
			80	80	LF	DURABLE 24 INCH STOP BAR, THERMOPLASTIC	646.482 2.0
			10	10	EACH	DURABLE LETTER OR SYMBOL, THERMOPLASTIC	646.492 -
			150	150	LF	DURABLE CROSSWALK MARKING, THERMOPLASTIC	646.502 5.0
			150	150	LF	TEMPORARY 4 INCH YELLOW LINE	646.610 -
			50	50	LF	TEMPORARY CROSSWALK MARKING	646.700 -
			65	65	EACH	LINE STRIPING TARGETS	646.76 4

SUMMARY OF ESTIMATED QUANTITIES							
TRAINEESHIP	FULL E&C ITEMS	EROSION CONTROL	ROADWAY	QUANTITIES GRAND TOTAL	UNIT	ITEMS	ITEM NO. ROUNDING
		150		150	SY	GEOTEXTILE FOR SILT FENCE	649.51 8.0
		4		4	LB	SEED	651.15 0.1
		25		25	LB	FERTILIZER	651.18 0.7
		0.10		0.10	TON	AGRICULTURAL LIMESTONE	651.20 -
		0.10		0.10	TON	HAY MULCH	651.25 -
		30		30	CY	TOPSOIL	651.35 4.8
			330	330	LF	PROJECT DEMARCATION FENCE	653.55 4.0
			40	40	SF	TRAFFIC SIGNS, TYPE A	675.20 0.49
						*** BEGIN SIGN POST OPTION ***	
			90	90	LF	FLANGED CHANNEL SIGN POST	675.301 -
			90	90	LF	SQUARE TUBE SIGN POST AND ANCHOR	675.341 -
						*** END SIGN POST OPTION ***	
			8	8	EACH	REMOVING SIGNS	675.50 -
			1	1	EACH	ERECTING SALVAGED SIGNS	675.60 -
			1	1	EACH	TRAFFIC CONTROL SIGNAL SYSTEM - INTERSECTION	678.15 -
			15	15	LF	ELECTRICAL CONDUIT (2") (PVC)	678.21 -
			610	610	LF	VEHICLE LOOP DETECTOR	678.22 2
			400	400	LF	WIRED CONDUIT (2") (PVC)	678.23 29
			75	75	LF	WIRED CONDUIT (2-1/2") (PVC)	678.23 5
			165	165	LF	ELECTRICAL CONDUIT SLEEVE (6") (PVC)	678.30 4

DETAILED SUMMARY OF QUANTITIES		
QUANTITIES	UNIT	ITEMS
		BITUMINOUS CONCRETE PAVEMENT
155.0	TON	TYPE III SURFACE COURSE - VT 116 & CHARLOTTE ROAD
8.5	TON	TYPE III SURFACE COURSE - DRIVES
16.6	TON	TYPE I BASE COURSE - VT 116 & CHARLOTTE ROAD
9.9	TON	ROUNDING
190		TOTAL

PROJECT NAME: HINESBURG
PROJECT NUMBER: HES 021-(K21)

FILE NAME: z04b208qty.dgn
PROJECT LEADER: G. BAKOS
DESIGNED BY: D. PECK
QUANTITY SUMMARY SHEET

PLOT DATE: 5/4/2007
DRAWN BY: D. PECK
CHECKED BY: G. BAKOS
SHEET 4 OF 19



DRAINAGE DETAIL SHEET

STATE OF VERMONT
AGENCY OF TRANSPORTATION

DRAINAGE STRUCTURES


STATION	STATION	POS.	DRAINAGE NOTE	INLET/OUTLET TYPE		DITCH		ELLIPTICAL PIPE		ROUND PIPE		ALLOWABLE OPTIONS					MH EA	ES EA	CB EA	PCC/DI EA	DI EA	CONC CLASS B CY	REINF STEEL LBS	GRATE TYPE	CHAN ELEV EA	CRM CY	TRENCH EXCAVATION		COMM EXC CY	UNC CHAN EXC CY	STRUCT EXCAV CY	GRAN BK/FILL STRUCT CY	GRAN BORR CY	EROS MATT CY	STONE FILL		MARKER POSTS		REMARKS														
				INLET	OUTLET	IN	OUT	SPAN IN	RISE IN	L FT	D IN	L FT	PCCSP TH	CAAP TH	RCP CL	CSP PI											CPEP SL	PCCSP PI TH							EARTH CY	ROCK CY	CY	CY		CY	CY	CY	CY	CY	CY	CY	CY	CY	CY	CY	CY	CY	CY
VT 116 AT SILVER STREET																																																					
3+77.3	3+87.8	LT	1	CB	MH					12	15.0	.064																									CONNECT TO EXISTING STRUCTURE																
4+21.3		RT	2	CB																		I														I	ADJUST GRATE ELEVATION																
3+87.8		LT	3	MH																		MH	I														REMOVE DI GRATE AND FRAME NEW MH COVER AND FRAME																
3+92.0		LT																																	I	EXISTING FIRE HYDRANT																	
SHEET SUBTOTAL																																																					
										12	15.0	.064												2	17.8									2																			

PROJECT NAME: HINESBURG	FILE NAME: z04b208qty.dgn	PLOT DATE: 5/4/2007
PROJECT NUMBER: HES 021-(121)	PROJECT LEADER: G. BAKOS	DRAWN BY: D. PECK
	DESIGNED BY: D. PECK	CHECKED BY: G. BAKOS
	DRAINAGE DETAIL SHEET	SHEET 5 OF 19




POB 0+00.00 PC 0+50.00

N = 666784.9519
E = 1480759.5244

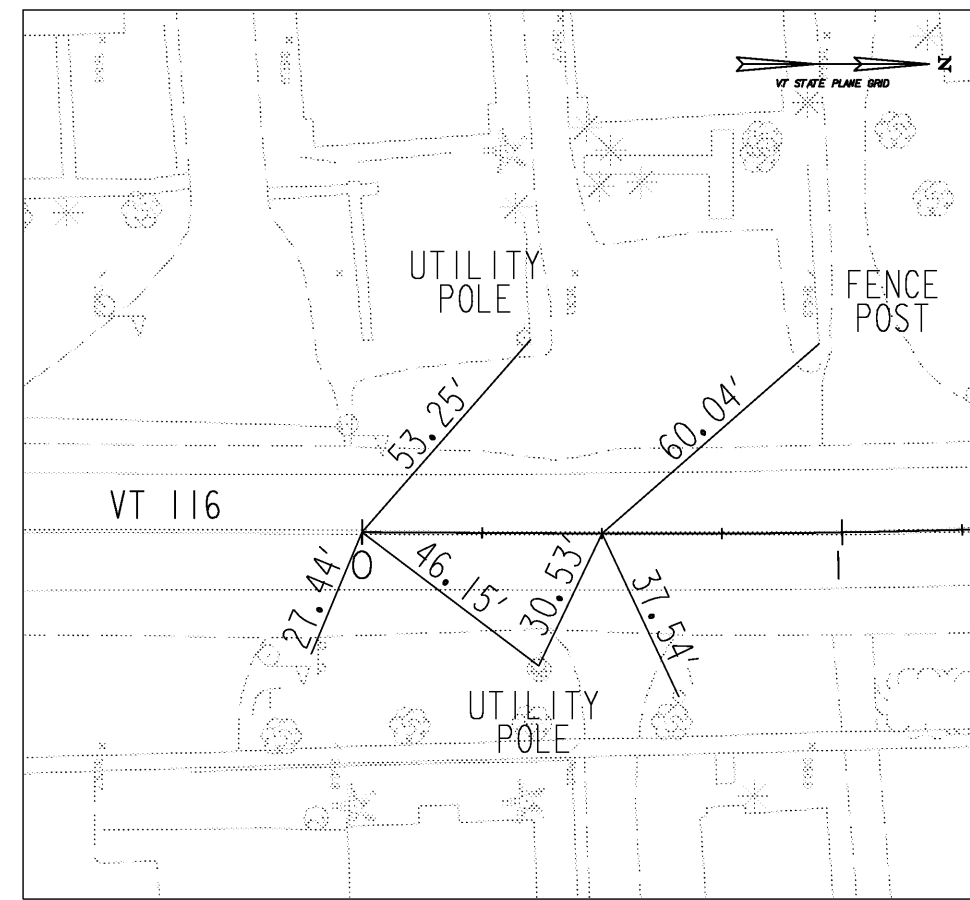


PI 2+19.79

N = 667004.7333
E = 1480760.8006

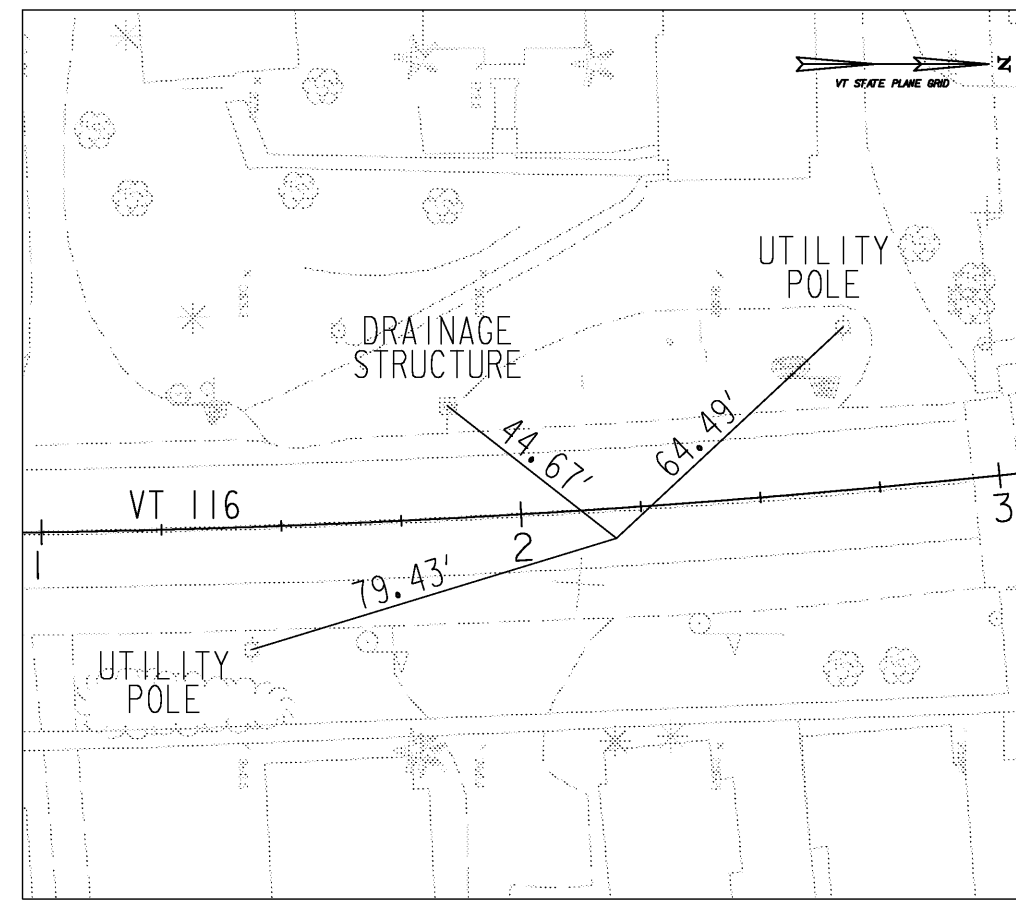


PT 3+88.96

N = 667172.8199
E = 1480736.8452

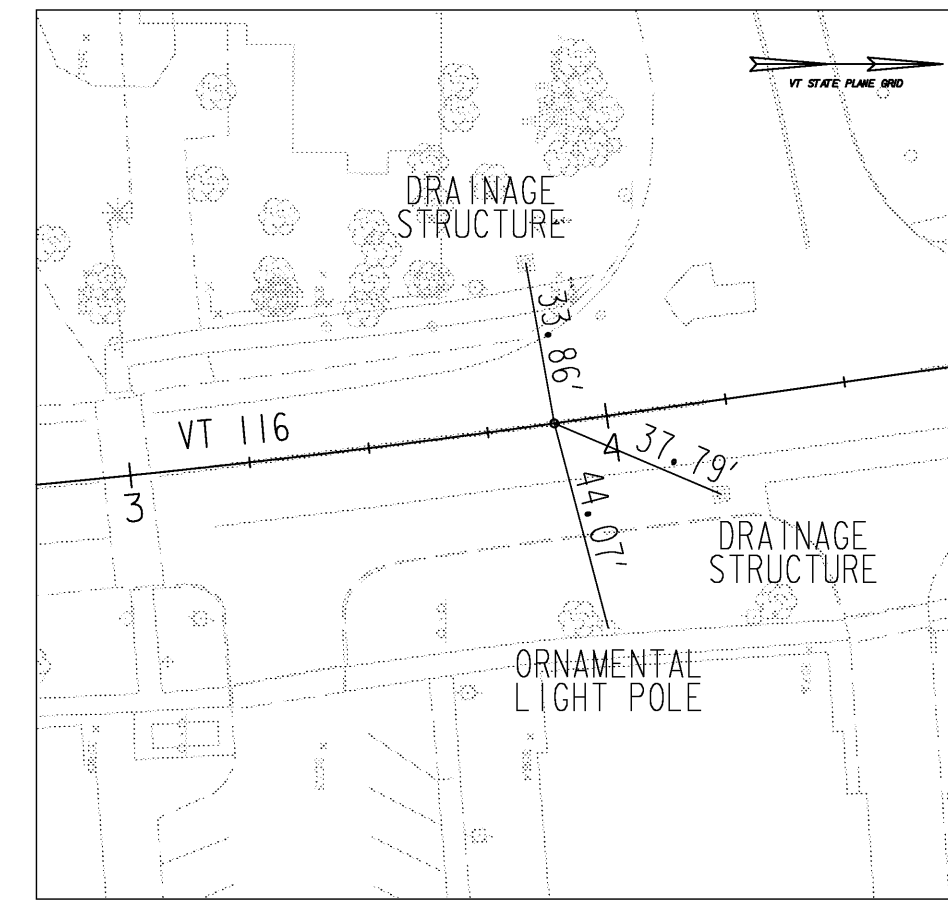


PC 4+90.03

N = 667272.8788
E = 1480722.5850

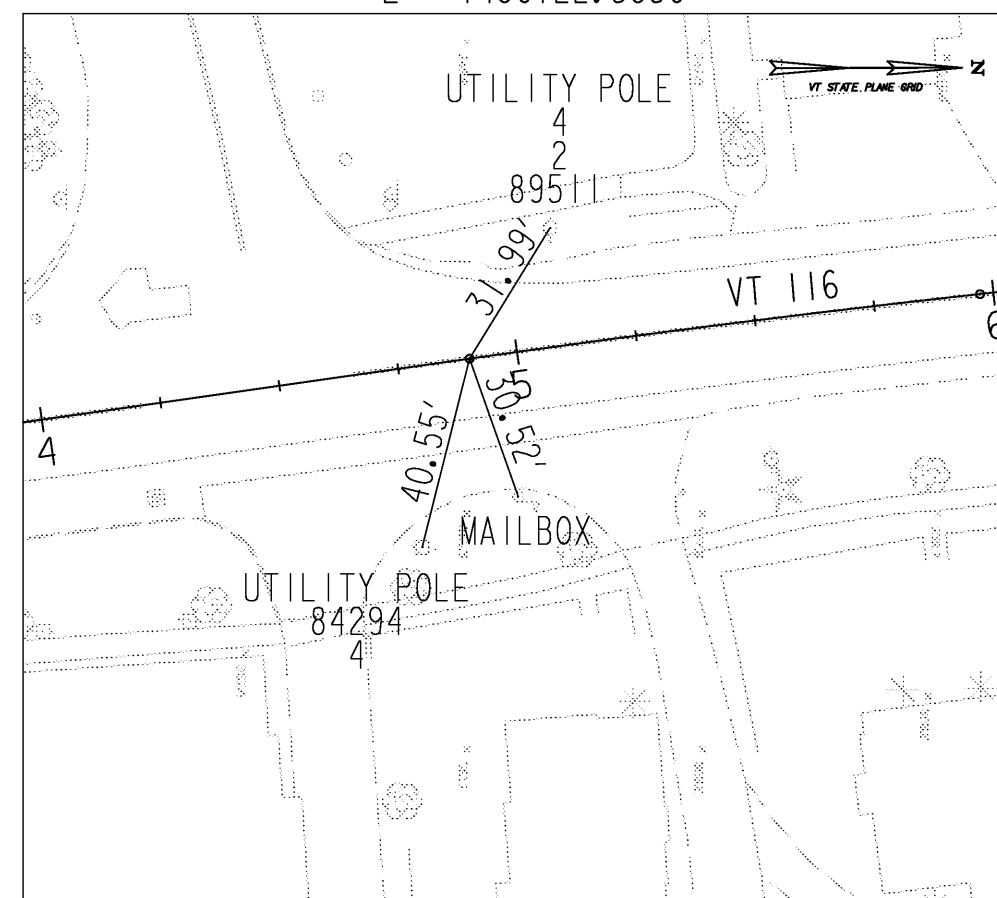


PI 5+43.62

N = 667325.9350
E = 1480715.0235

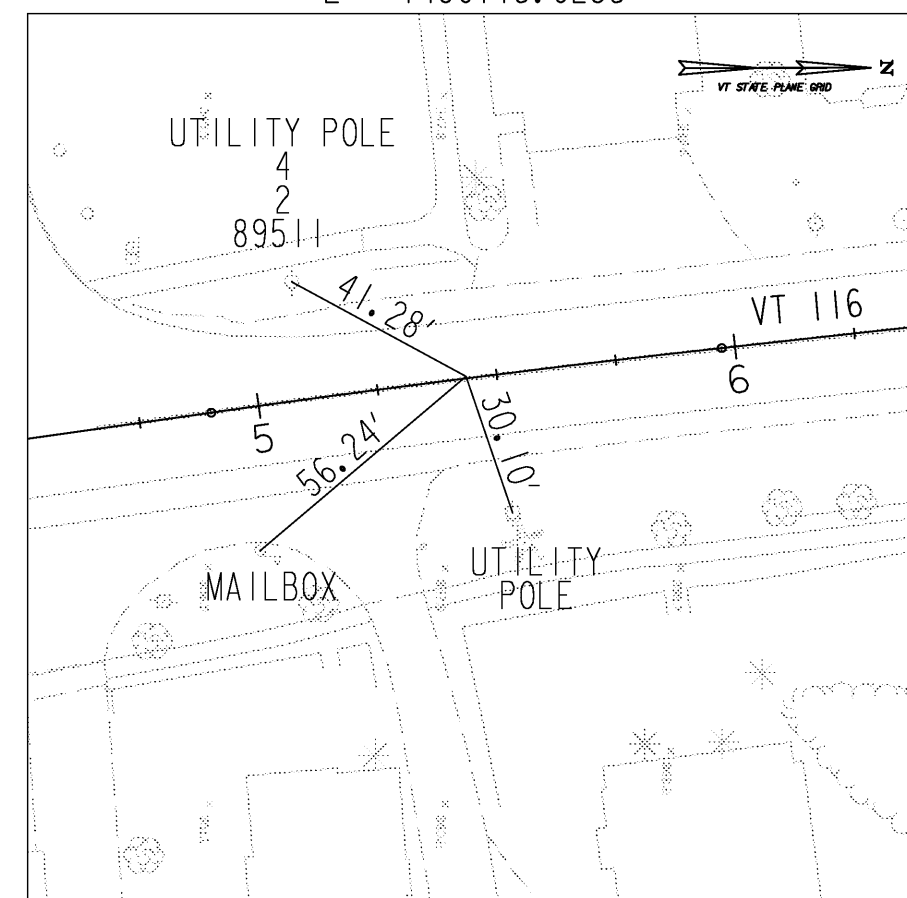


PT 5+97.20 POE 6+50.00

N = 667379.2032
E = 1480709.1380

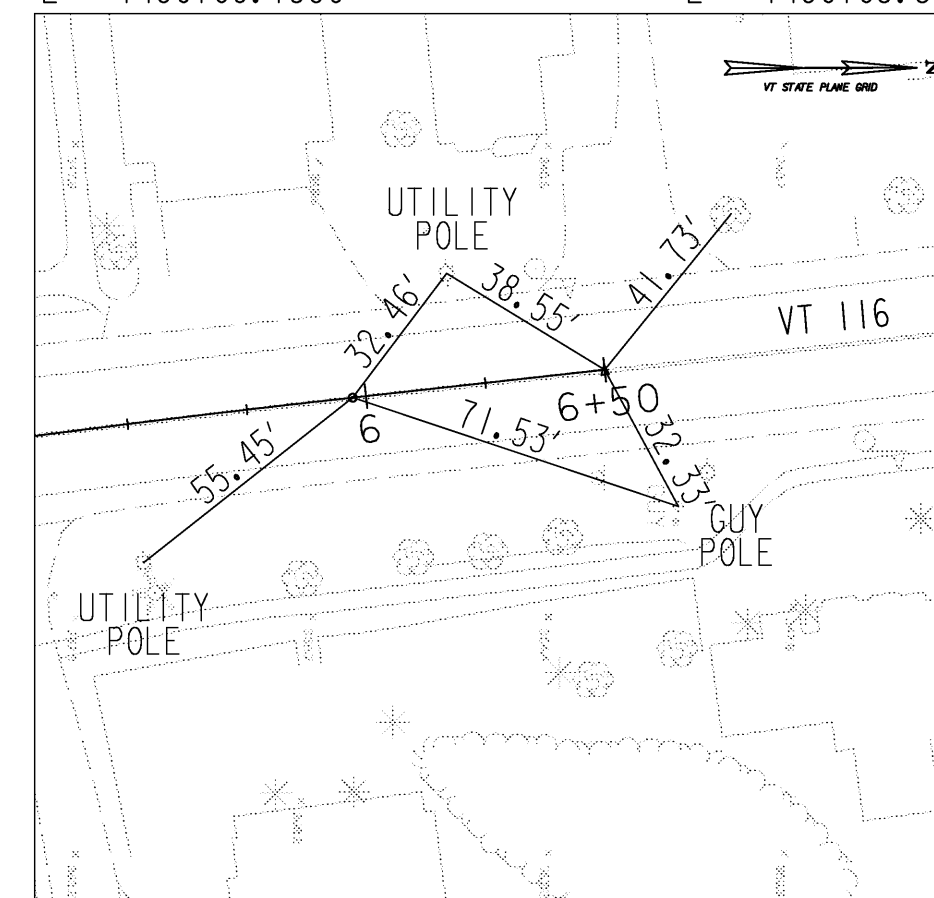


POB 100+00.00

N = 667231.3577
E = 1480728.5025

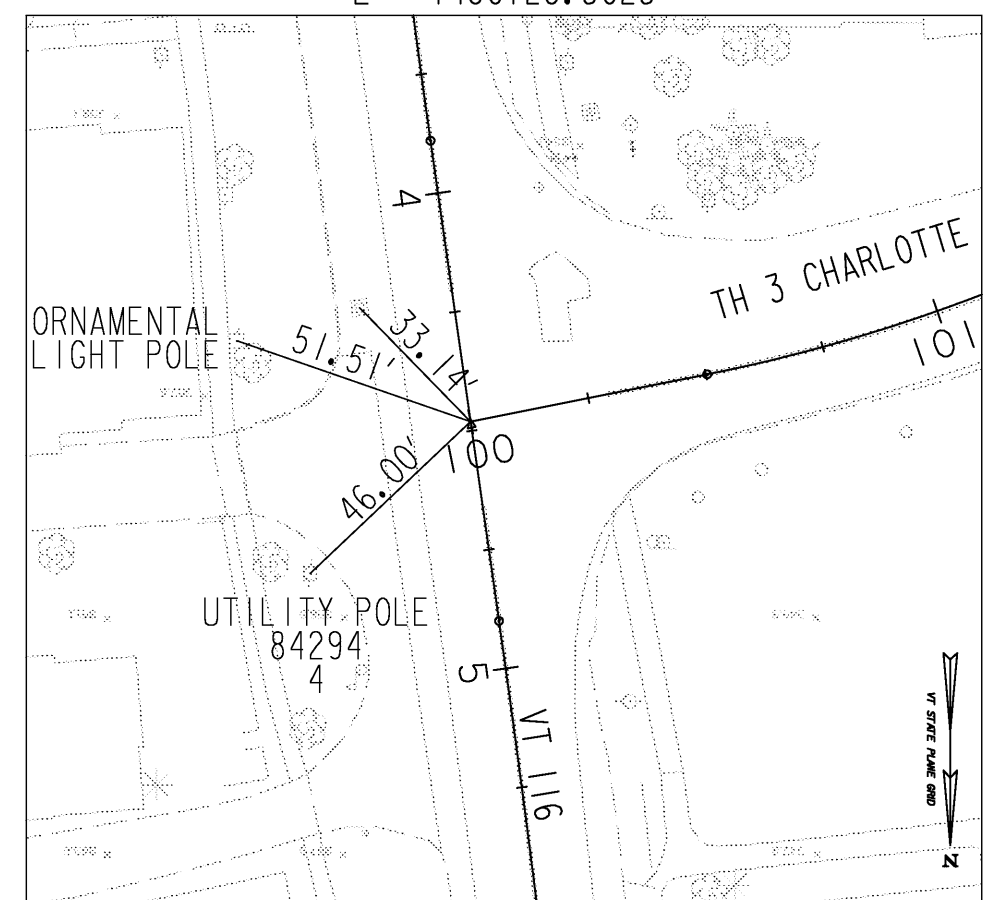


PC 100+50.27

N = 667221.4926
E = 1480679.2140

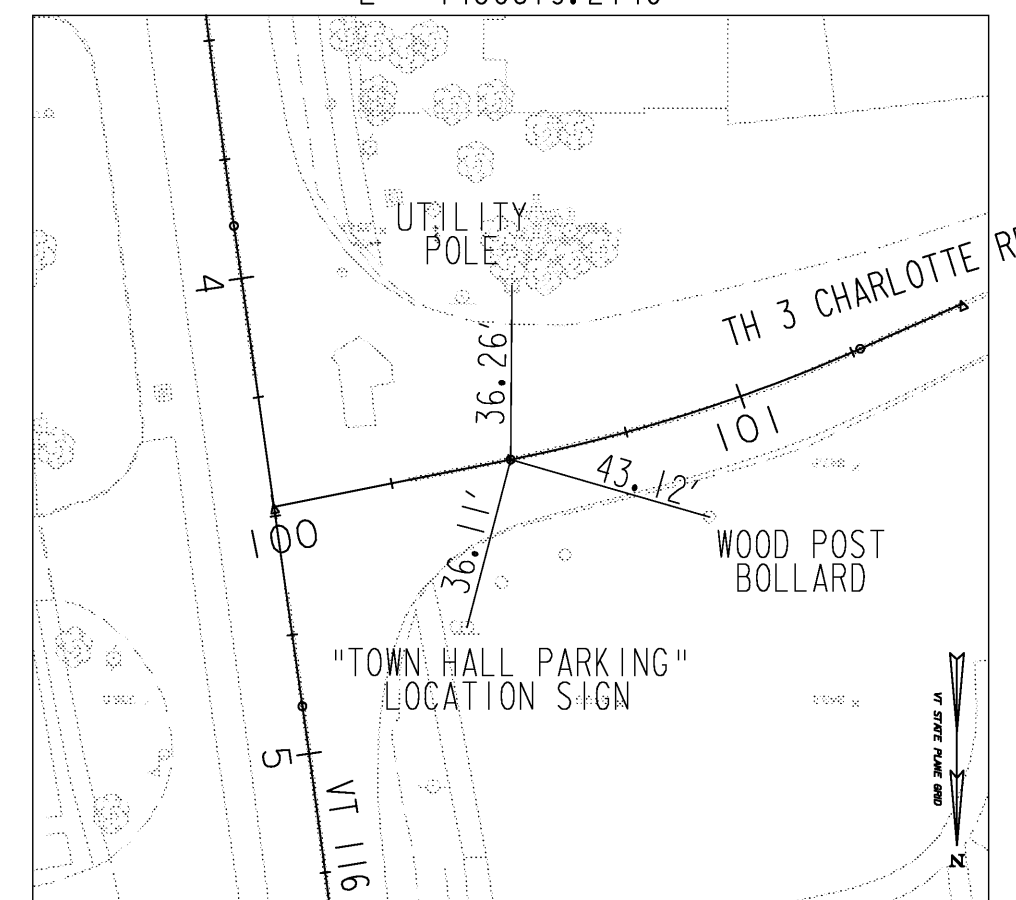


PI 100+88.69

N = 667213.9514
E = 1480641.5367

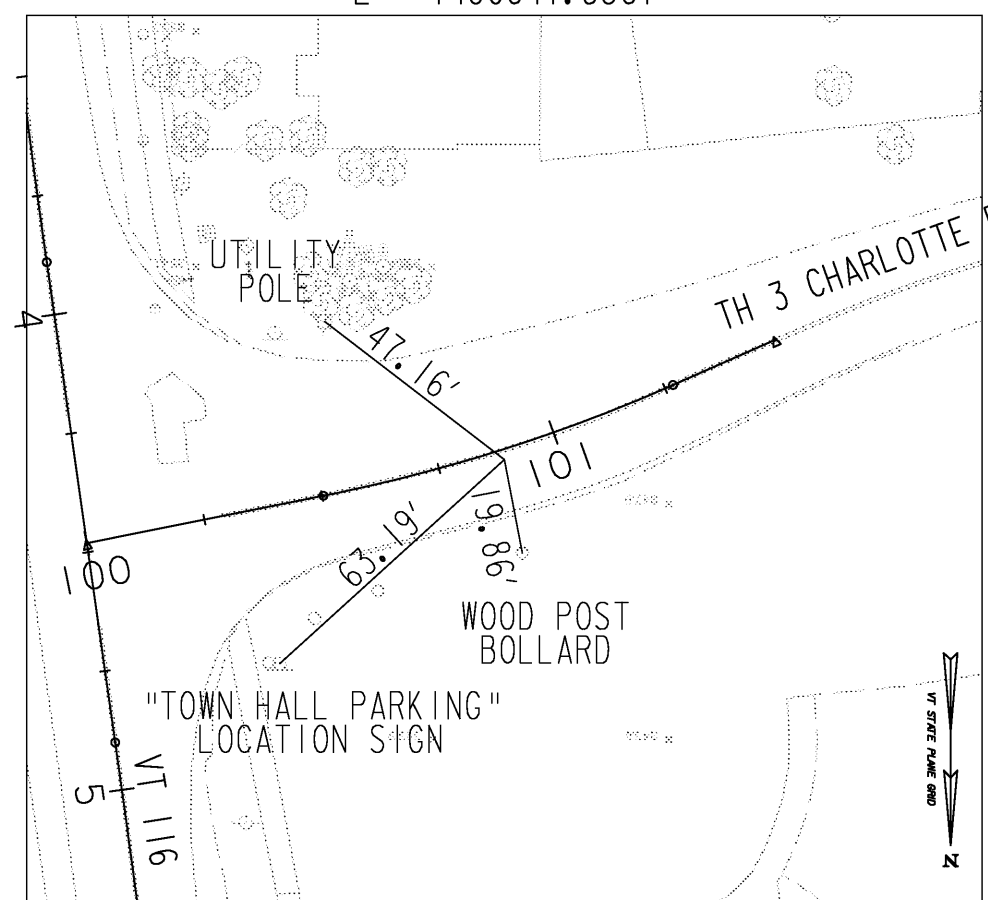


PT 101+26.81

N = 667198.4156
E = 1480606.3928

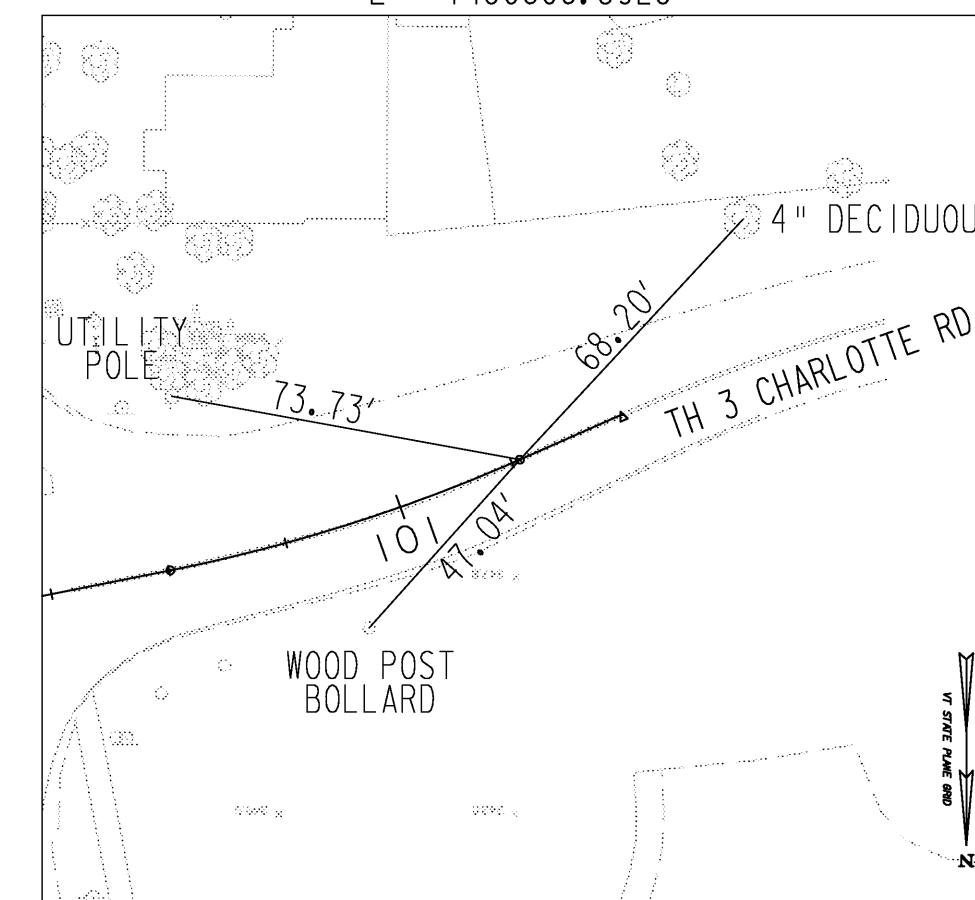

POE 101+50.00

N = 667189.0389
E = 1480585.1818

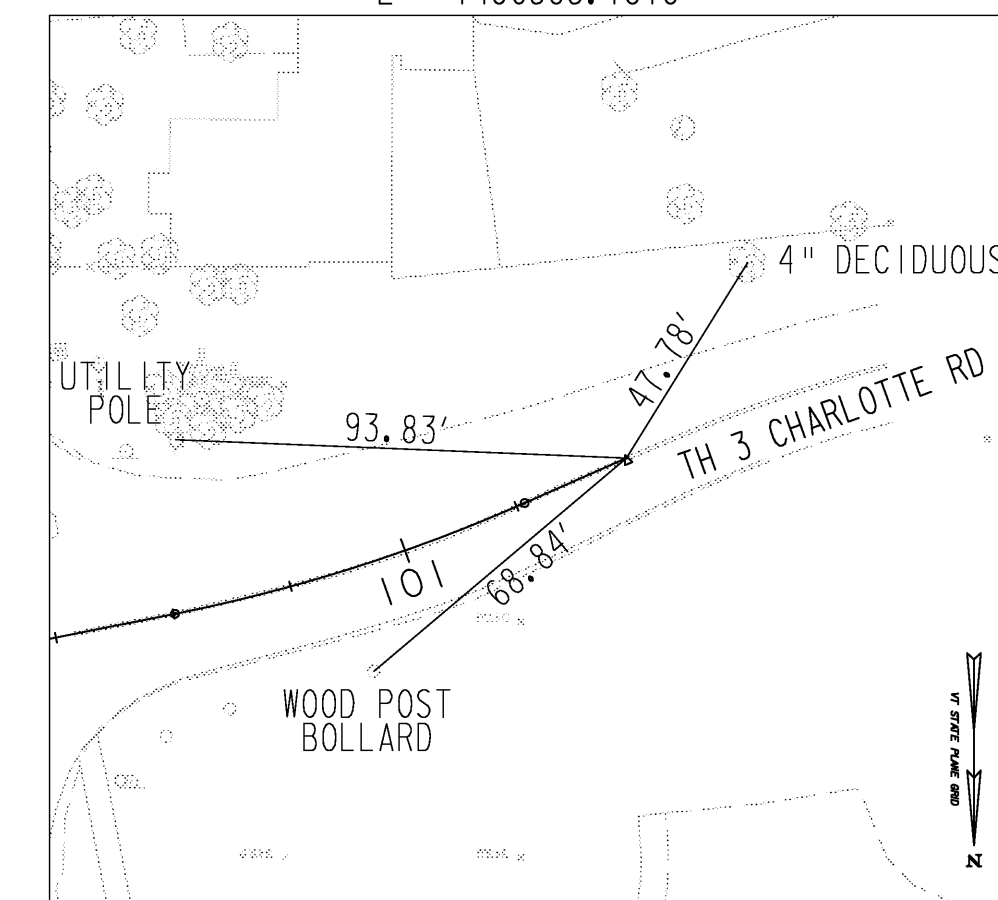


PROJECT NAME: HINESBURG
PROJECT NUMBER: HES 021-(K21)

FILE NAME: z04b208+1e.dgn
PROJECT LEADER: G. BAKOS
DESIGNED BY: D. PECK
TIE SHEET

PLOT DATE: 5/4/2007
DRAWN BY: D. PECK
CHECKED BY: G. BAKOS
SHEET 6 OF 19


CONSTRUCT DRIVES

STA. 3+10, LT. - 16' WIDE, GRAVEL
 STA. 3+29, RT. - 24' WIDE, PAVED COMM.
 STA. 4+58, RT. - 34' WIDE, PAVED COMM.
 STA. 5+20, RT. - 20' WIDE PAVED

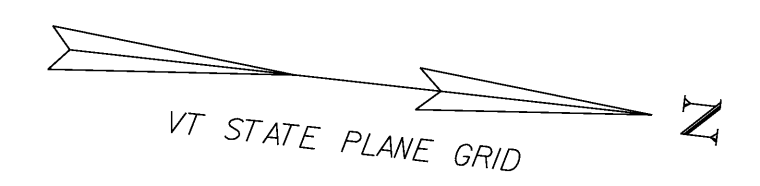


LINES SHOWN ON THIS PLAN AS EXISTING PROPERTY LINES P/L ARE BELIEVED TO BE ACCURATE BUT SHOULD NOT BE RELIED UPON FOR PURPOSES UNRELATED TO THE STATE OF VERMONT'S ACQUISITION OF LAND AND RIGHTS FOR THIS PROJECT.

VT ROUTE 116		TH3
CURVE #1 DATA	CURVE #2 DATA	CURVE #3 DATA
Δ = 18°26'37.63"	Δ = 1°48'21.94"	Δ = 12°31'48.77"
D = 2°29'28.04"	D = 1°41'6.61"	D = 16°22'12.80"
R = 2300'	R = 3400'	R = 350'
T = 169.79'	T = 53.59'	T = 38.42'
L = 338.96'	L = 107.18'	L = 76.54'
E = 6.26'	E = 0.42'	E = 2.10'

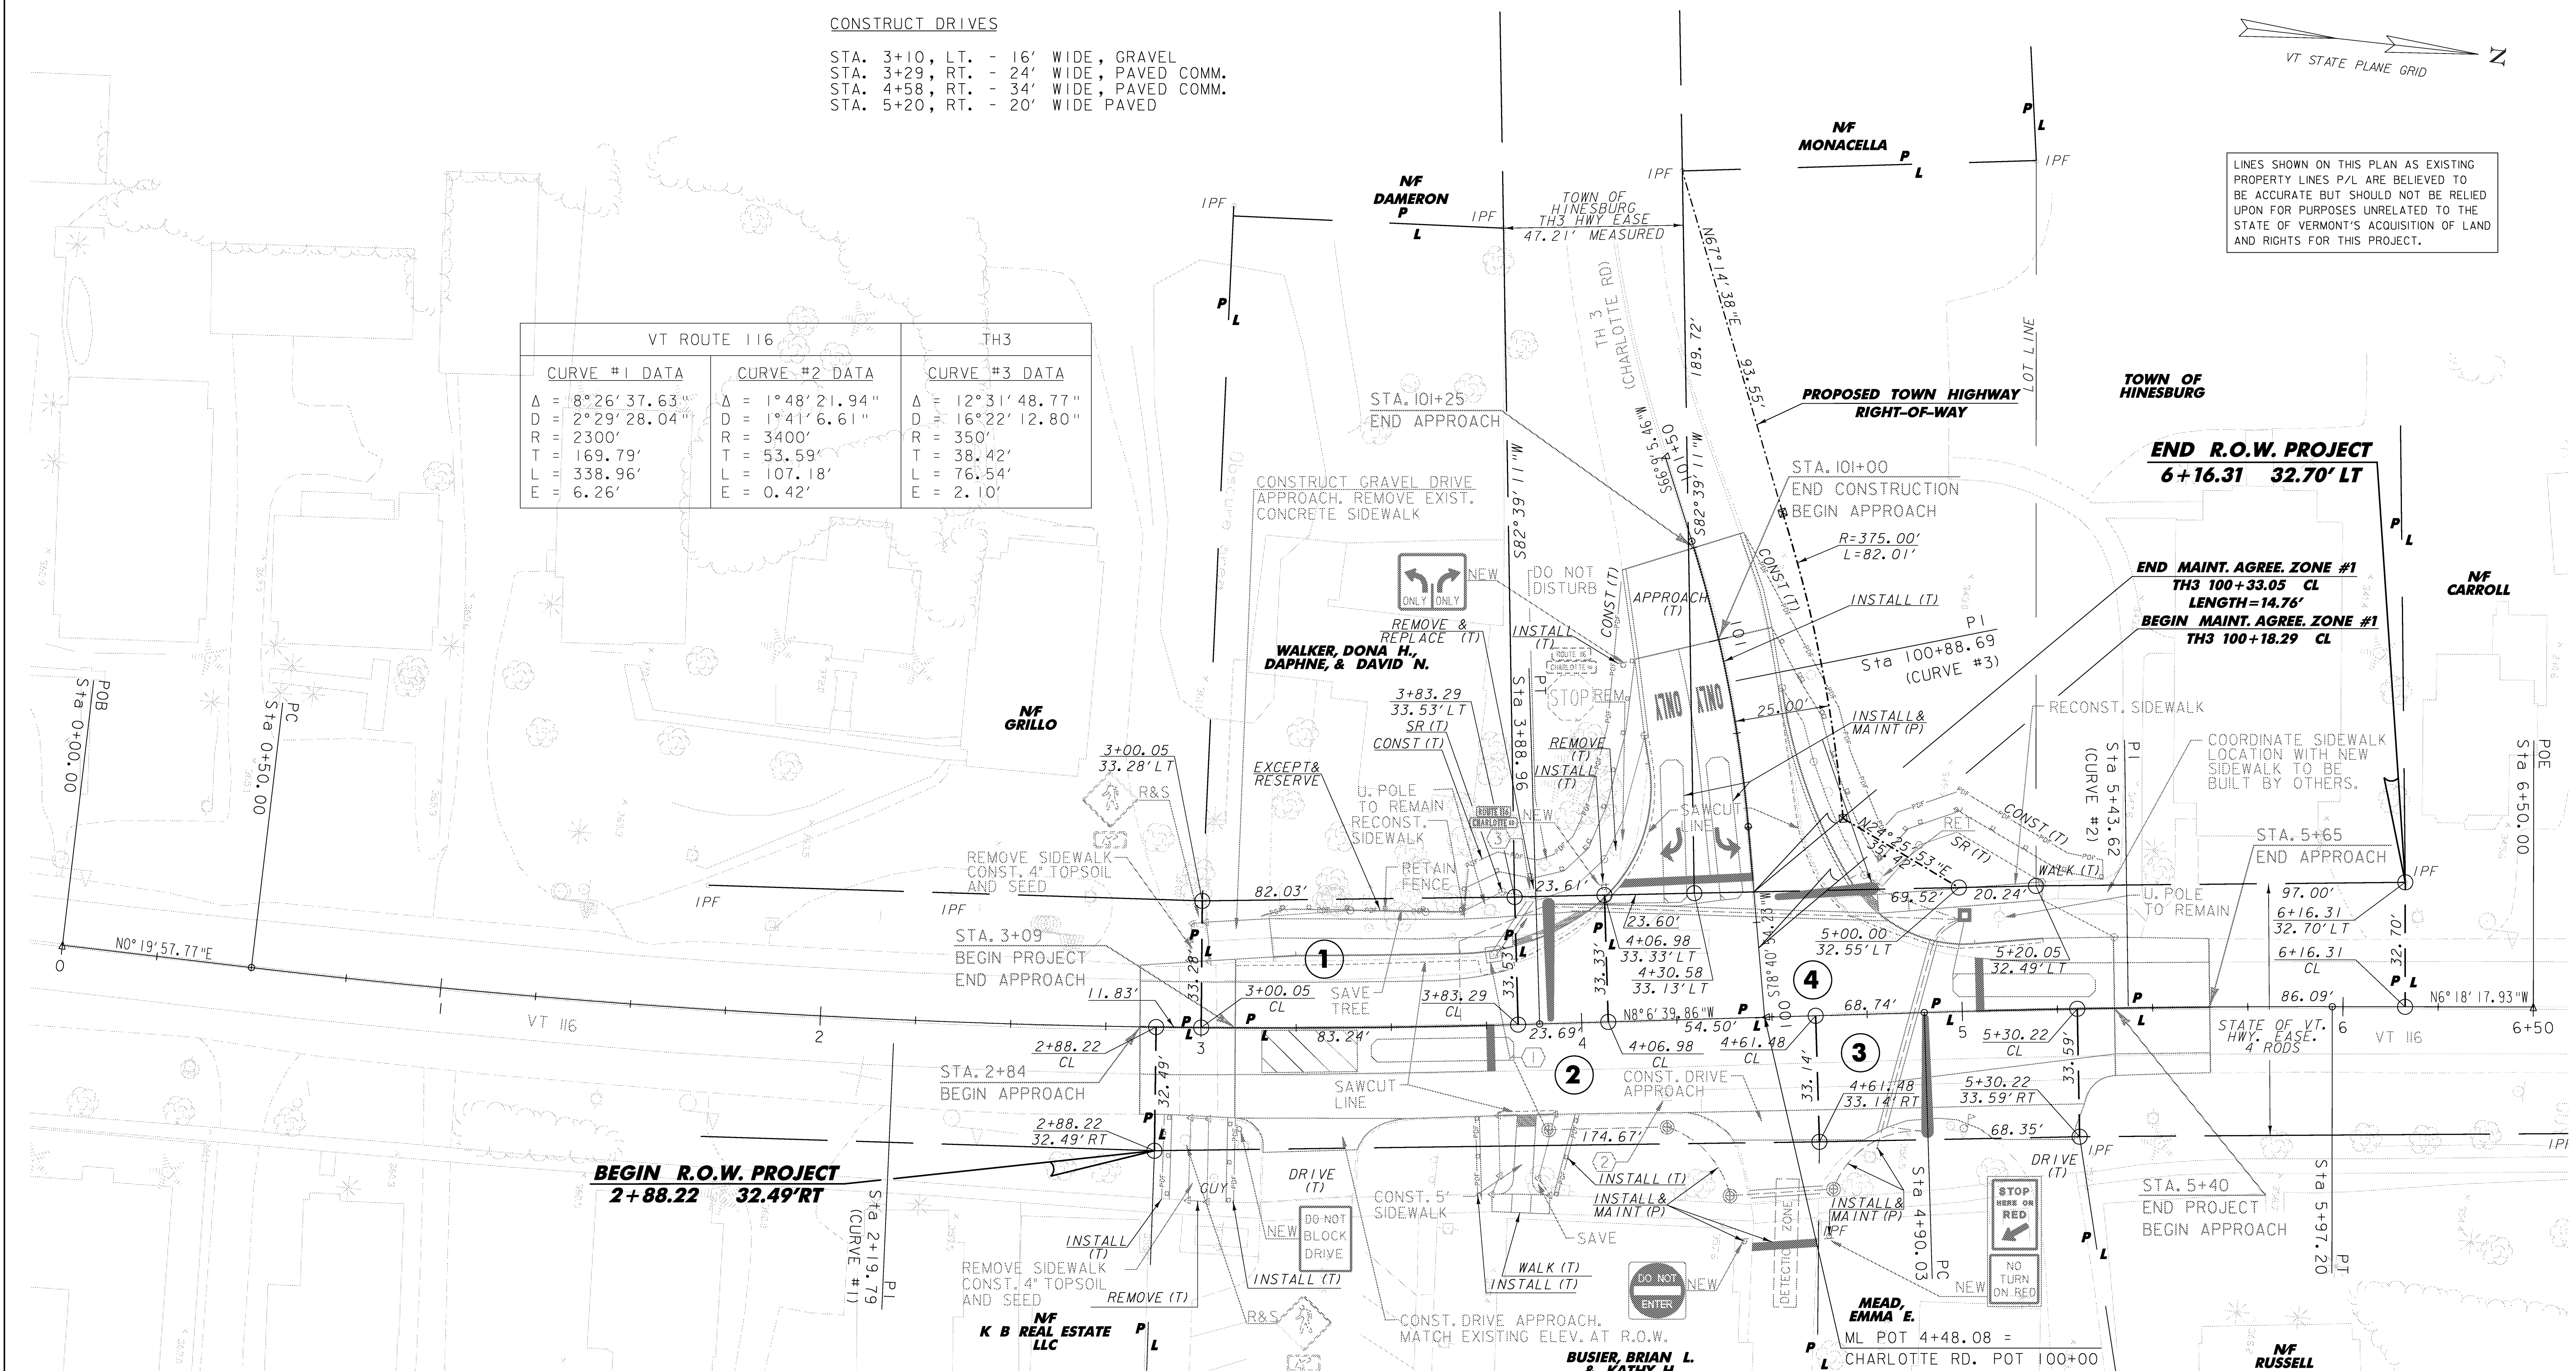

NOTE: THE DRAINAGE STRUCTURE RIM AND INVERT ELEVATIONS ARE BASED ON SURVEY INFORMATION FROM AERIAL SURVEY, AND CONTRACTOR SHALL SET ACTUAL RIM ELEVATIONS ONE INCH BELOW FINISHED PAVEMENT ELEVATIONS, AND CONTRACTOR SHALL FIELD CHECK PROPOSED PIPE INVERTS BEFORE ORDERING DRAINAGE STRUCTURES.

- ① STA. 3+77.3, LT. 18.6 - STA. 3+87.8, LT. 33.8
 NEW D1, TYPE D
 RIM ELEV. = 355.33
 NEW 12" x 15 LF PCCSP
 INV. OUT = 350.12
- ② STA. 4+21.3, RT. 19.5
 ADJUST CB (TO NEW GRADE)
 RIM ELEV. = 355.75
- ③ STA. 3+87.8, LT. 33.8
 ADJUST CB (TO NEW GRADE)
 REMOVE CB GRATE & FRAME
 REPLACE WITH MH COVER & FRAME
 RIM ELEV. = 353.9 ±

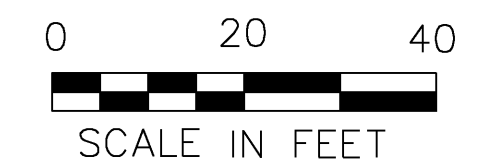

DATUM

VERTICAL	NAVD 88
HORIZONTAL	NAD 83



RIGHT OF WAY PLAN	
PROJECT: HINESBURG	PROJECT NO.: HES 021-1(21)
DESIGN FILE NAME: ...te\plansear\row\04b2081.dgn	PLOT DATE: 1/11/2007
IPARM FILE NAME:	SURVEY DATE: 2004
SURVEYED BY: COL-EAST, Inc.	DRAWN BY: D. PECK
SQUAD LEADER: G. BAKOS	SHEET: 8 OF 19
TEXT FILE:	

CONSTRUCTION NOTFS

COLD PLANING BITUMINOUS PAVEMENT

STATION 2+84.0 - 3+09.0
 STATION 3+09.0 - 3+54.4, RT.
 STATION 4+27.1 - 5+31.7, RT.
 STATION 5+10.0 - 5+65.0
 STATION 101+00.0 - 101+25.0

RELOCATE MAILBOX SINGLE SUPPORT

STATION 5+00.0, RT.

VERTICAL GRANITE CURB

STA. 3+19.0 - 3+92.9, LT.
 STA. 4+07.8, LT. - TH3 STA. 100+77.4, LT.
 STA. 100+29.6 - 100+85.1, RT.
 STA. 5+21.6, LT. - TH3 STA. 100+24.6, RT.
 STA. 3+79.3 - 3+83.3, RT.
 STA. 3+88.3 - 3+92.3, RT.

PORTLAND CEMENT CONCRETE SIDEWALK, 5 INCH

STA. 3+17.9 - 4+01.7, LT.
 STA. 3+75.1 - 3+90.0, RT.
 STA. 4+74.4 - 5+21.6, LT.

DETECTABLE WARNING SURFACE

STA. 3+98, LT.
 STA. 3+85, RT.
 STA. 100+27, RT.

CONSTRUCT DRIVES - 1 1/2" BCP, TYPE III



SIA. 3+30, RT. - 25' WIDE
 STA. 4+56, RT. - 34' WIDE
 STA. 5+18, RT. - 21' WIDE

EXCAVATION OF SURFACES AND PAVEMENTS

STATION 2+97 - 4+02, LT.
 STATION 3+00, RT.
 STATION 3+75 - 3+90, RT.
 STATION 4+68 - 5+22, LT.

REMOVING AND RESETTING FENCE

STATION 3+20 - 3+70, LT.

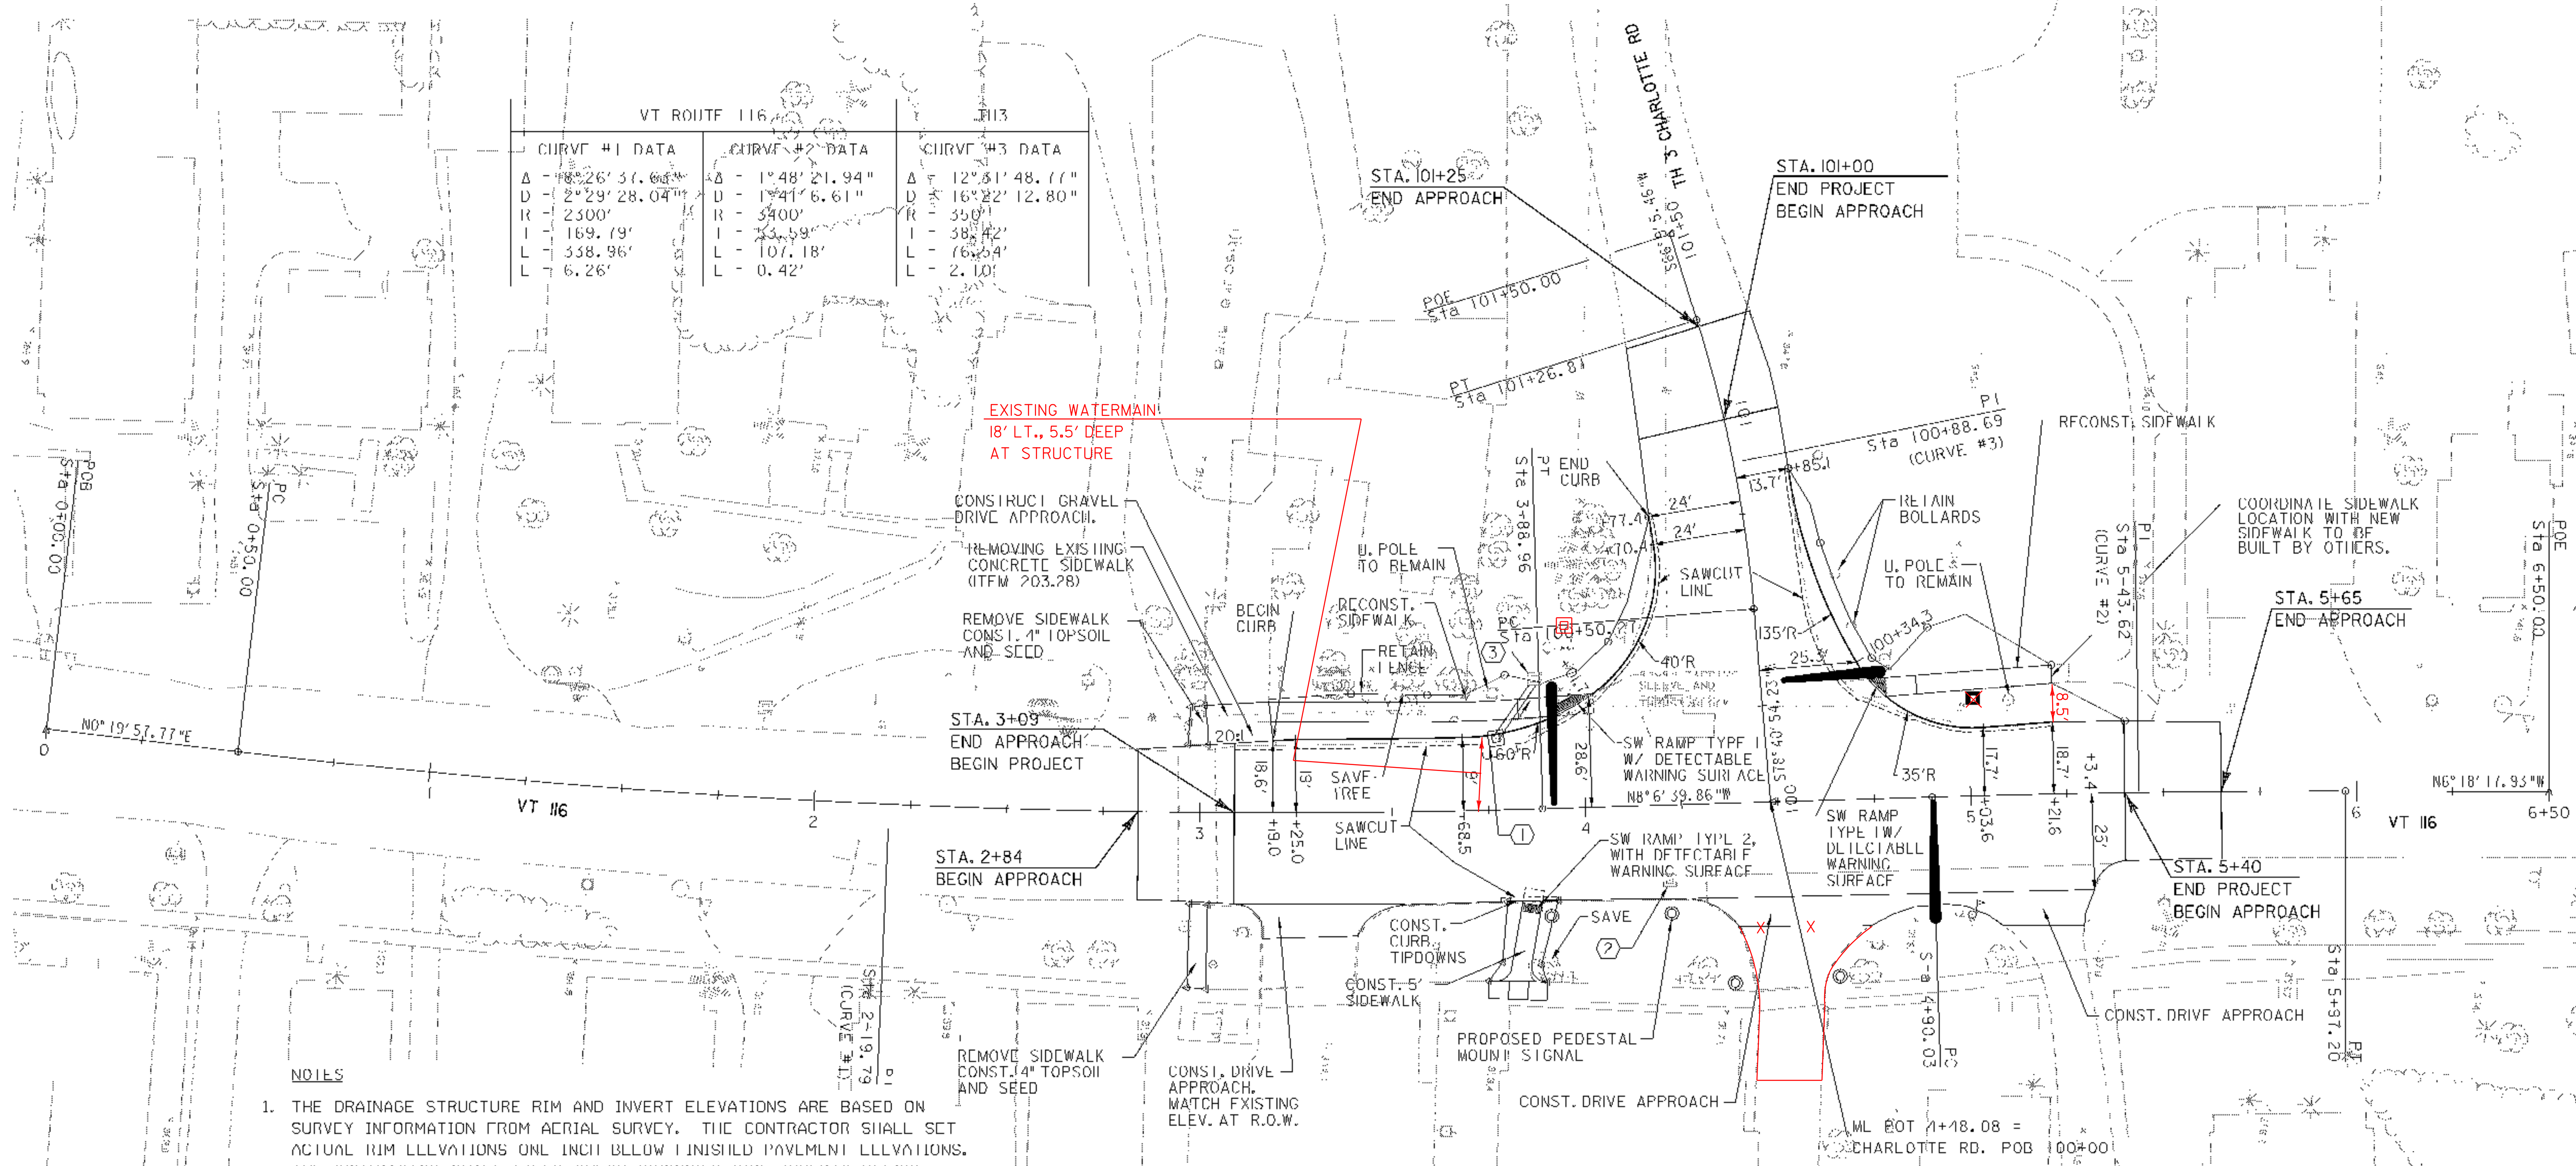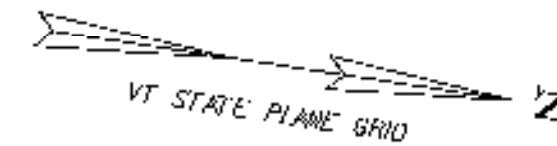


VT ROUTE 116		113	
CURVE #1 DATA	CURVE #2 DATA	CURVE #3 DATA	
Δ - 18°26'37.03"	Δ - 1°48'21.94"	Δ - 12°31'48.77"	
D - 2°29'28.04"	D - 1°41'6.61"	D - 16°22'12.80"	
R - 2500'	R - 3400'	R - 3500'	
I - 169.79'	I - 23.59'	I - 38.42'	
L - 338.96'	L - 107.18'	L - 76.04'	
L - 6.26'	L - 0.42'	L - 2.10'	

NOTES

1. THE DRAINAGE STRUCTURE RIM AND INVERT ELEVATIONS ARE BASED ON SURVEY INFORMATION FROM AERIAL SURVEY. THE CONTRACTOR SHALL SET ACTUAL RIM ELEVATIONS ONE INCH BELOW FINISHED PAVEMENT ELEVATIONS. THE CONTRACTOR SHALL FILL CHECK PROPOSED PIPE INVERTS BEFORE ORDERING DRAINAGE STRUCTURES.
2. THE USE OF BRICK AND MORTAR TO ADJUST THE ELEVATION OF DRAINAGE STRUCTURES IS PROHIBITED. ALL ELEVATION ADJUSTMENTS SHALL BE MADE USING EITHER GRADE RINGS OR A SYNTHETIC RISER.
3. ALL CONNECTIONS BETWEEN PRECAST DRAINAGE STRUCTURES AND DRAINAGE PIPES SHALL BE A BOOTED CONNECTION.

- (1) SIA. 3+77.3, LT. 18.6
 NGW PRECAST DI, TYPE D CURB INLET, DUE TO HAVING TO SET STRUCTURE BACK BECAUSE OF EXISTING WATER MAIN.
 RIM ELEV. = 355.33
 NEW 12" x 15 LF PCCSP
 INV. OUI = 350.12
- (2) SIA. 4+21.3, RT. 19.5
 ADJUST CB (TO NEW GRADE)
 RIM ELEV. = 355.75
- (3) SIA. 3+87.8, LT. 33.8
 ADJUST CB (TO NGW GRADE)
 REMOVE CB CRATF & FRAME
 REPLACE WITH MH COVER & FRAME
 RIM ELEV. = 353.9'

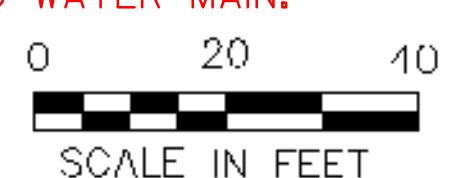


DATUM

VERTICAL	NAVD 88
HORIZONTAL	NAD 83


PROJECT NAME: HINFSBURC
 PROJECT NUMBER: HES 021-K(21)

FILE NAME: z01b2081.dgn
 PROJECT LEADER: G. ISAKOS
 DESIGNER: D. PECK
 GENERAL PLAN

PLOT DATE: 5/4/2007
 DRAWN BY: D. PECK
 CHECKED BY: C. BAKOS
 SHEET 9 OF 19

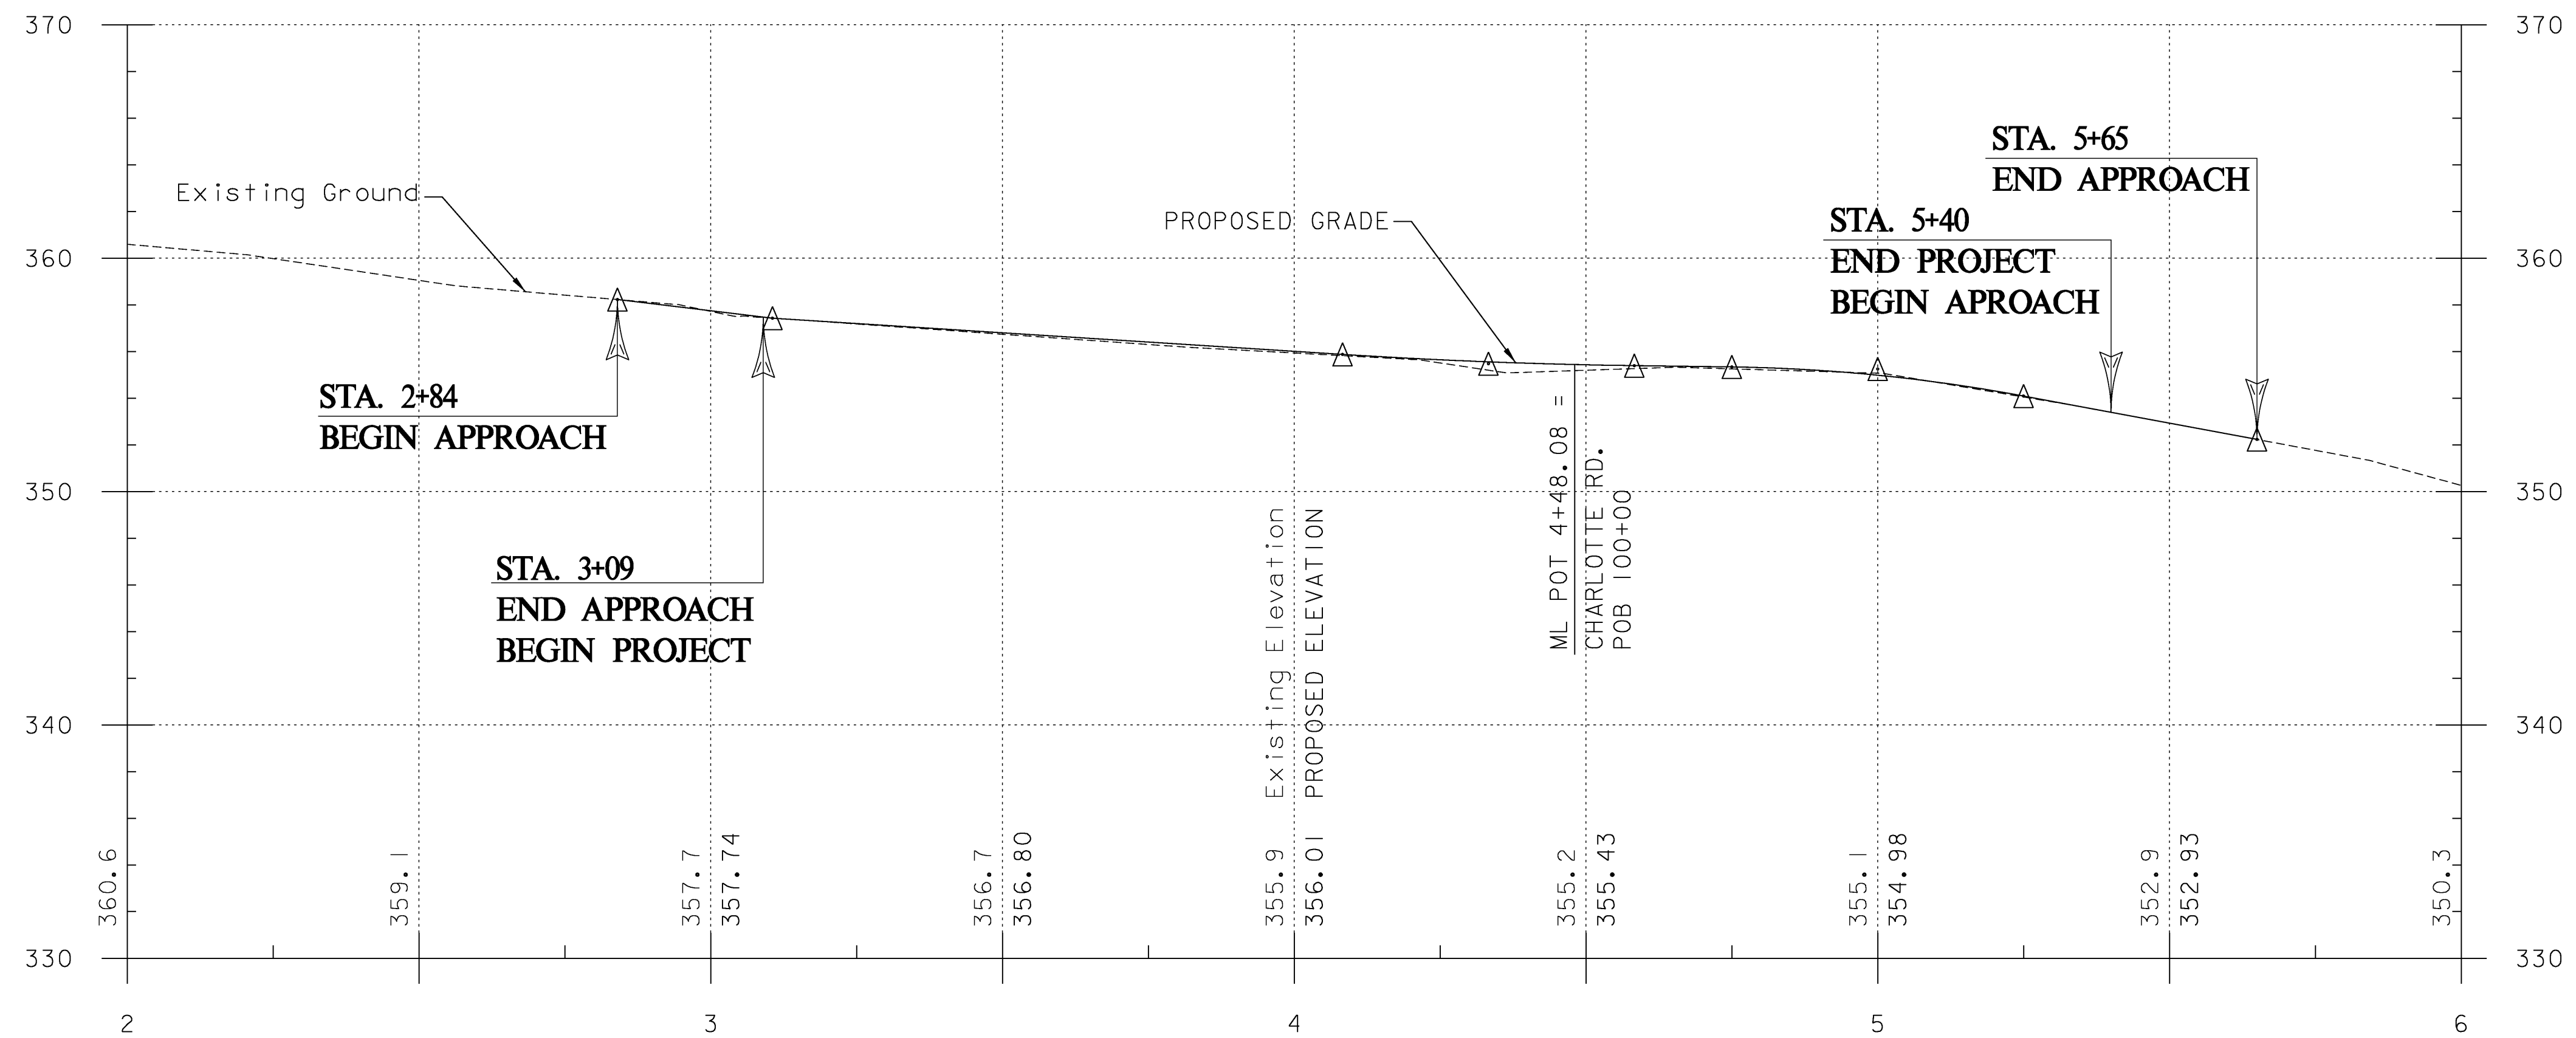


PROFILE VT RTE 116

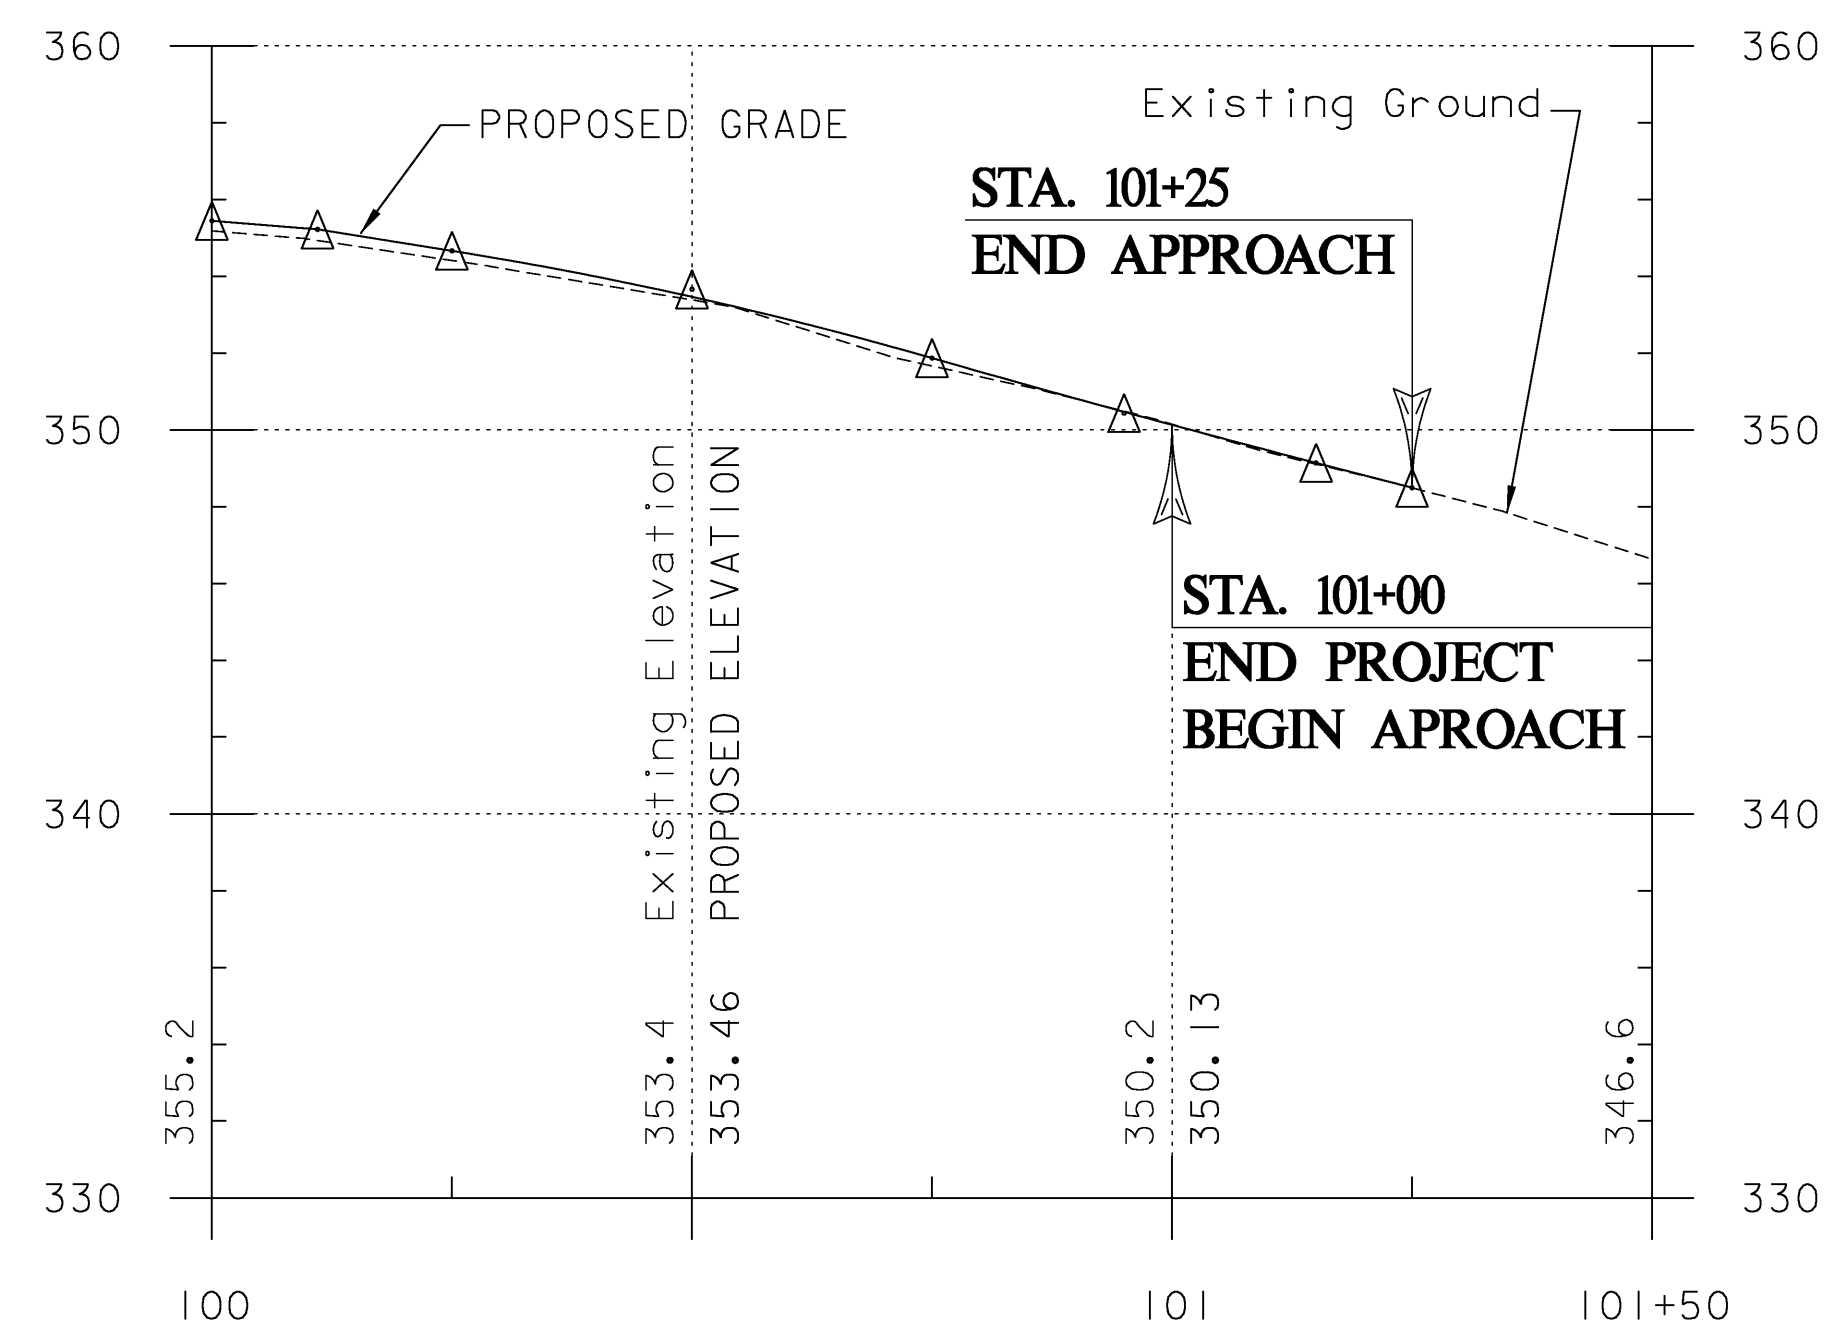

PROFILE CHARLOTTE RD

NOTE: THESE PROFILES ARE PROVIDED FOR INFORMATION ONLY AND ARE NOT INTENDED FOR USE IN SETTING FINISHED PAVEMENT SURFACE ELEVATIONS.

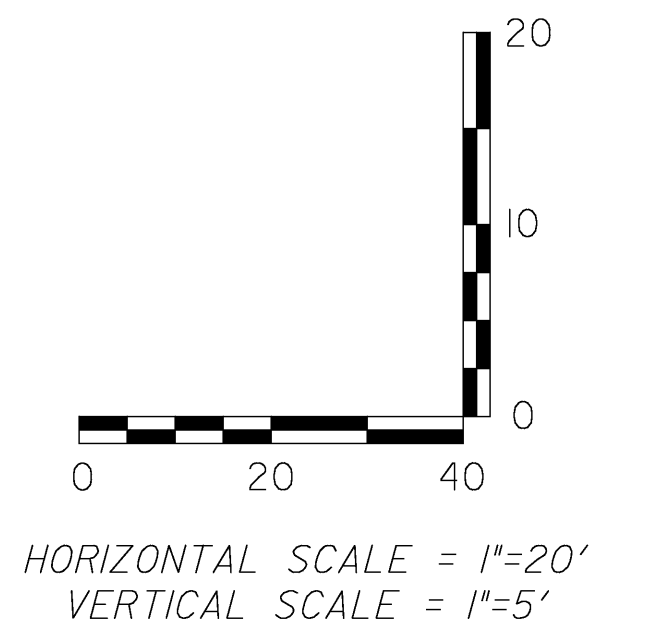

DATUM	
VERTICAL	NAVD 88
HORIZONTAL	NAD 83



PROJECT NAME:	HINESBURG	FILE NAME:	z04b208pro.dgn	PLOT DATE:	5/4/2007
PROJECT NUMBER:	HES 021-(121)	PROJECT LEADER:	G. BAKOS	DRAWN BY:	D. PECK
		DESIGNED BY:	D. PECK	CHECKED BY:	G. BAKOS
		PROFILES		SHEET	10 OF 19

CONSTRUCTION NOTES

DURABLE 4 INCH WHITE LINE, THERMOPLASTIC

SIA. 2+84.0 - 3+90.5, LI.
 STA. 2+84.0 - 3+80.5, RT.
 STA. 3+06.0 - 3+41.0, RT.
 STA. 4+80.0 - 5+65.0, RT.
 SIA. 5+03.7 5+65.0, LI.
 STA. 100+36.4 101+00.0, LT.
 STA. 100+37.4 - 101+25.0, LT.
 STA. 100+31.2 - 101+25.0, RT.

TEMPORARY 4 INCH YELLOW LINE (DOUBLE CENTER LINE)

SIA. 2+84.0 - 3+09.0
 STA. 5+40.0 - 5+65.0
 STA. 101+00 - 101+25.0

REMOVING SIGNS

SIA. 2+97, RI. (2 SIGNS)
 STA. 3+00, LT. (2 SIGNS)
 STA. 4+80, LT.
 STA. 100+47, LT. (3 SIGNS)

DURABLE 4 INCH YELLOW LINE, THERMOPLASTIC (DOUBLE CENTER LINE)

STA. 2+84.0 - 3+80.5
 STA. 5+03.7 - 5+65.0
 SIA. 100+36.0 - 101+25.0

DURABLE 8 INCH WHITE LINE, THERMOPLASTIC

STA. 3+06.0 - 3+41.0, RT.

DURABLE LETTER OR SYMBOL, THERMOPLASTIC



STA. 100+42.0, LT. (LEFT TURN ARROW)
 STA. 100+42.0, LT. (RIGHT TURN ARROW)
 STA. 100+82.0, LT. ("ONLY")
 SIA. 100+82.0, LI. ("ONLY")

DURABLE 24 INCH STOP BAR, THERMOPLASTIC

STA. 3+80.5, RT.
 STA. 5+03.7, LT.
 SIA. 100+36.0, LI.
 STA. 4+43.1 - 4+60.1, RT.

DURABLE CROSSWALK MARKING, THERMOPLASTIC

SIA. 3+85.8, RI. - 3+98.0, LI
 STA. 4+43.0 4+60.0, RT.
 STA. 100+28.0, LT. - RT.

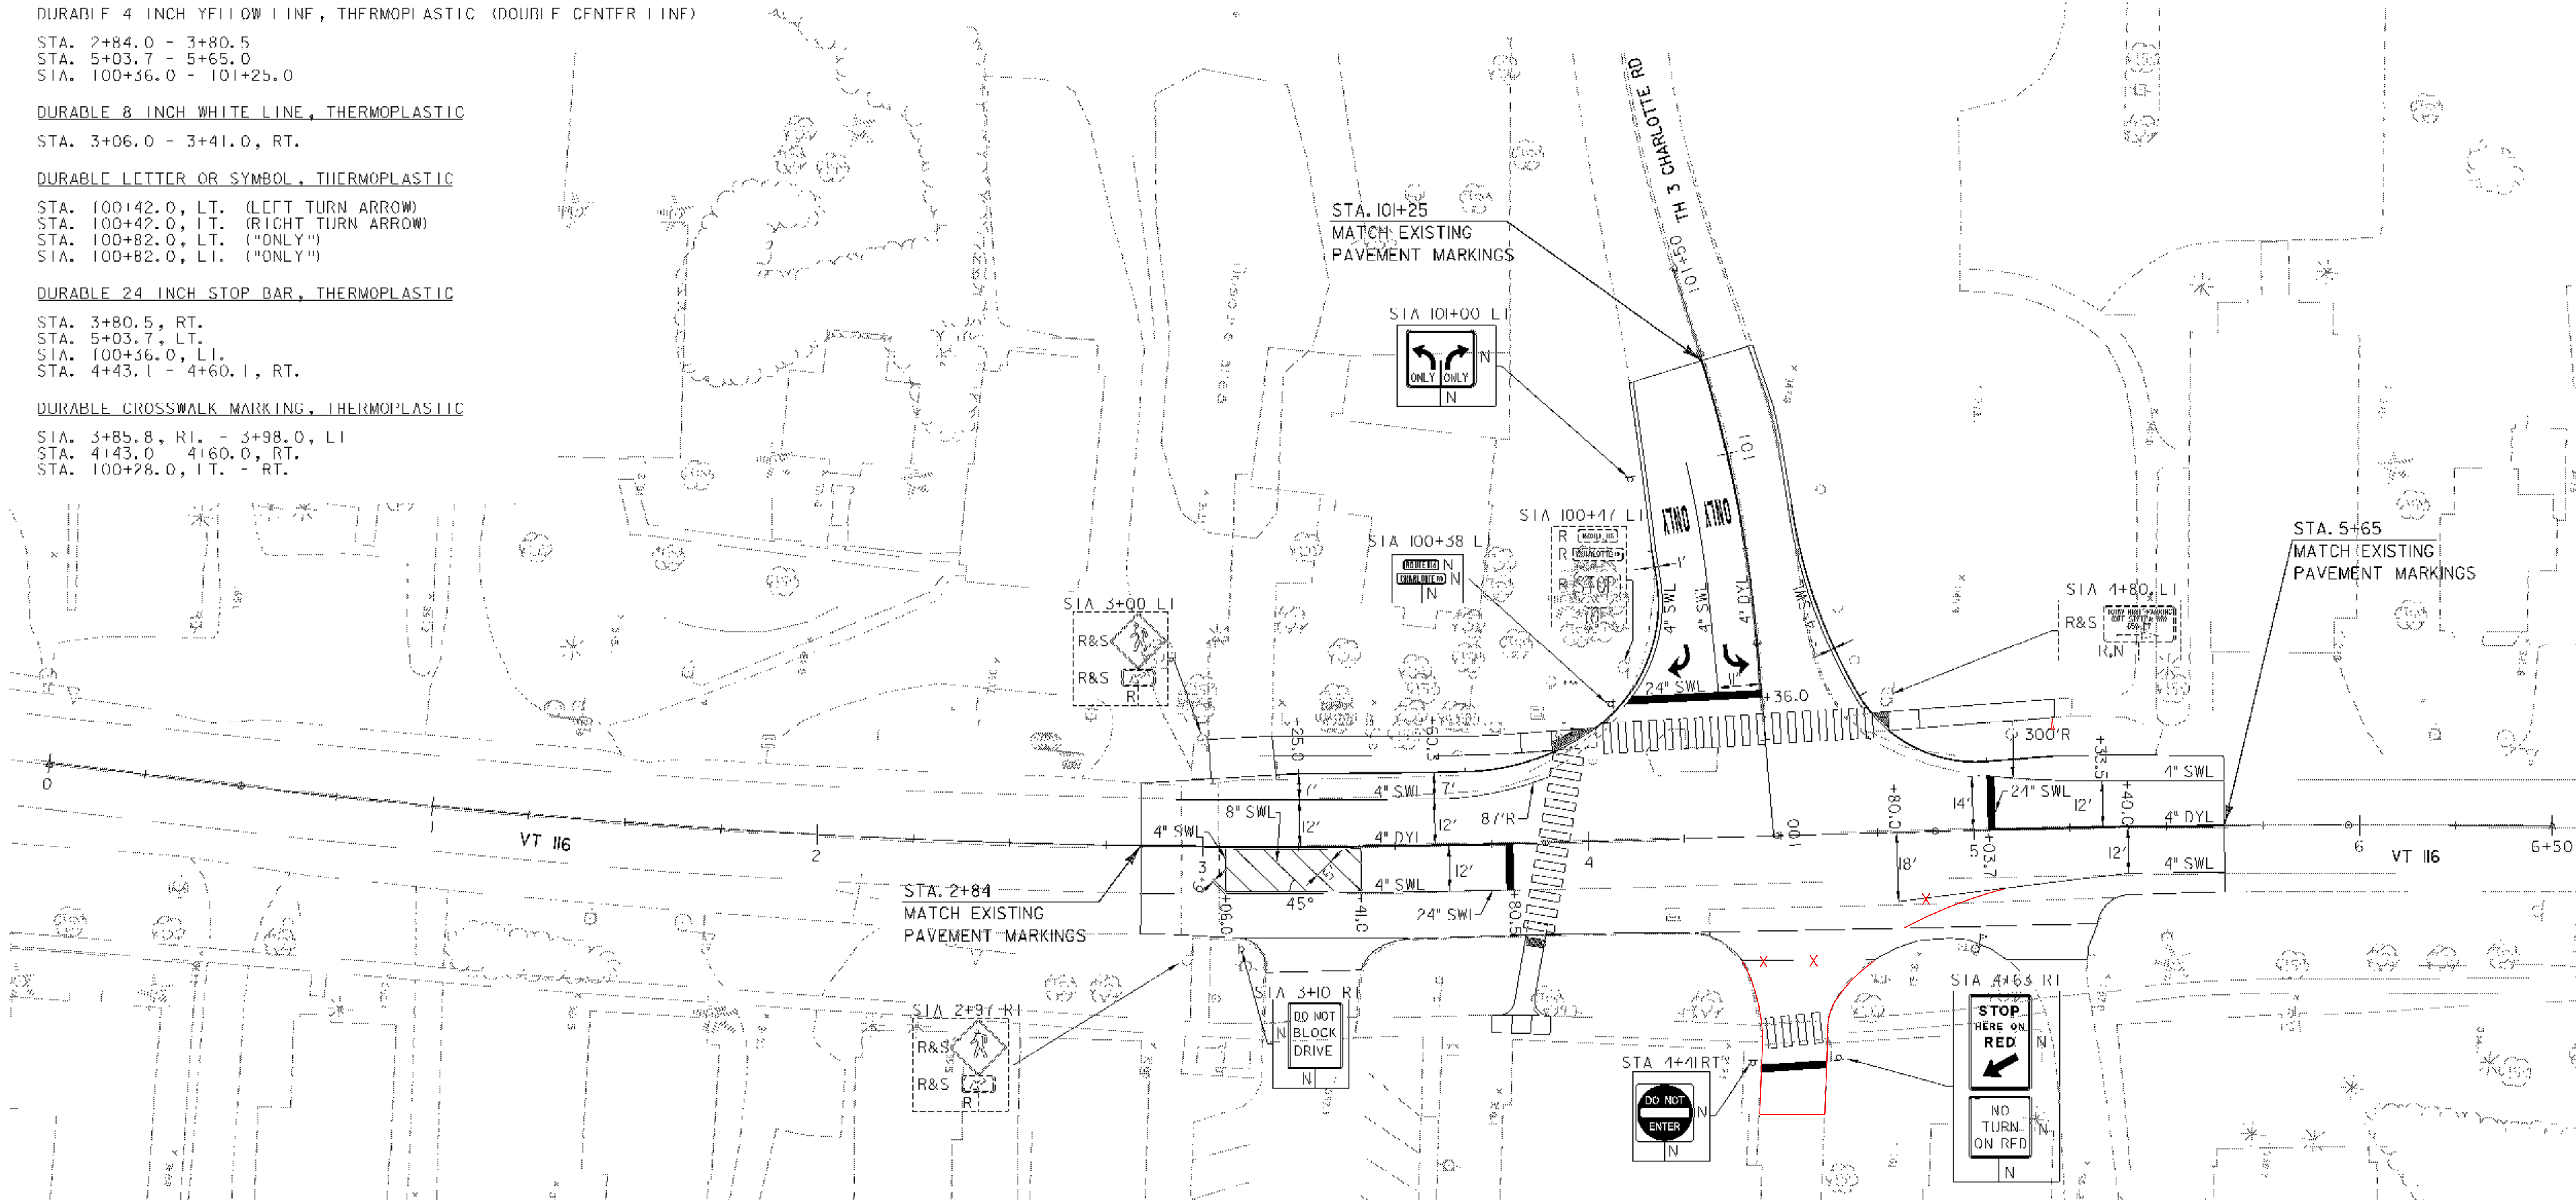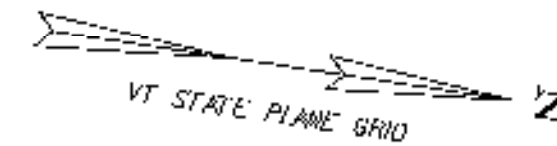

SIGN LEGEND

N = NEW
 R = REMOVE
 RET = RETAIN
 R&S = REMOVE & SALVAGE SIGN

DATUM

VERTICAL: NAD 88
 HORIZONTAL: NAD 83

STRIPING LEGEND

SWL = SINGLE WHITE LINE
 DYL = DOUBLE YELLOW LINE

NOTE:
 ALL SIGNS REMOVED AND NOT REUSED ON THE PROJECT WILL BE RETURNED TO THE DISTRICT 5 OFFICES, COLCHESTER, VT FOR REUSE, EXCEPT FOR SIGNS REMOVED AT STATION 100+47, LI, WHICH SHALL BE DISPOSED OF BY THE CONTRACTOR.




PROJECT NAME: HINFSBURG
 PROJECT NUMBER: HES 021-K(21)

FILE NAME: z01b2081a2.dgn
 PROJECT LEADER: G. BAKOS
 DESIGNER: D. PECK
 SIGNING AND STRIPING PLAN

PLOT DATE: 5/4/2007
 DRAWN BY: D. PECK
 CHECKED BY: G. BAKOS
 SHEET 11 OF 19

LIST OF MAJOR EQUIPMENT

EQUIPMENT ITEM 678.15	QUANTITY
ECONOLITE TRAFFIC SIGNAL CONTROLLER	1
ECONOLITE P44 CONTROLLER CABINET WITH GENERATOR HOOKUP PLUG ON 15-INCH EXTENDED BASE, PAINTED FLAT BLACK, ON A CONC. FOUNDATION WITH ANCILLARY CONTROL EQUIPMENT.	1
FLAT BLACK PAINTED STEEL MAST ARM SIGNAL POLE WITH TWENTY-FIVE FOOT (25') SPECIAL CURVED MAST ARM.	1
FLAT BLACK PAINTED STEEL MAST ARM SIGNAL POLE WITH THIRTY FOOT (30') SPECIAL CURVED MAST ARM.	2
FLAT BLACK PAINTED PEDESTAL POST.	4
ONE-WAY, 3-SECTION, 12-INCH POLYCARBONATE MAST ARM MOUNTED LED TRAFFIC SIGNAL HEAD WITH TUNNEL VISORS AND LOUVERED BACKPLATE WITH ALL PIECES PAINTED FLAT BLACK.	6
ONE-WAY, 3-SECTION, 12-INCH POLYCARBONATE POST MOUNTED LED TRAFFIC SIGNAL HEAD WITH TUNNEL VISORS AND LOUVERED BACKPLATE WITH ALL PIECES PAINTED FLAT BLACK.	3
POST MOUNTED 16-INCH LED PEDESTRIAN SIGNAL HEAD WITH SOLID WALKING PERSON AND HAND SYMBOLS	3
POST MOUNTED 16-INCH LED PEDESTRIAN SIGNAL HEAD WITH SOLID WALKING PERSON AND HAND SYMBOLS	1
POST MOUNTED 16 INCH LED PEDESTRIAN SIGNAL HEAD WITH SOLID WALKING PERSON, HAND AND HAND SYMBOLS	2
VTRANS SPEC ACCESSIBLE PEDESTRIAN PUSHBUTTONS (PER SPECIAL PROVISION 6(B) AND (5)(2)) WITH R10 4 TYPE SIGN ASSEMBLY & AUDIBLE PEDESTRIAN CROSSING INDICATORS	3
NON-INTRUSIVE, NON-MICROWAVE VIDEO BASED PRESENCE DETECTION SYSTEM, TRAFICAM OR APPROVED EQUAL	1
ASTRO BRACKETS	9
SINGLE CHANNEL WIRE LOOP DETECTOR AMPLIFIERS	3
SINGLE CHANNEL WIRE LOOP DETECTOR AMPLIFIERS WITH DISPLAY	1
ELEC. SERVICE CONNECTION/POWER DROP STANCHION	1
MAST ARM MOUNTED LED BLANKOUT	1
POST MOUNTED LED BLANKOUT	1

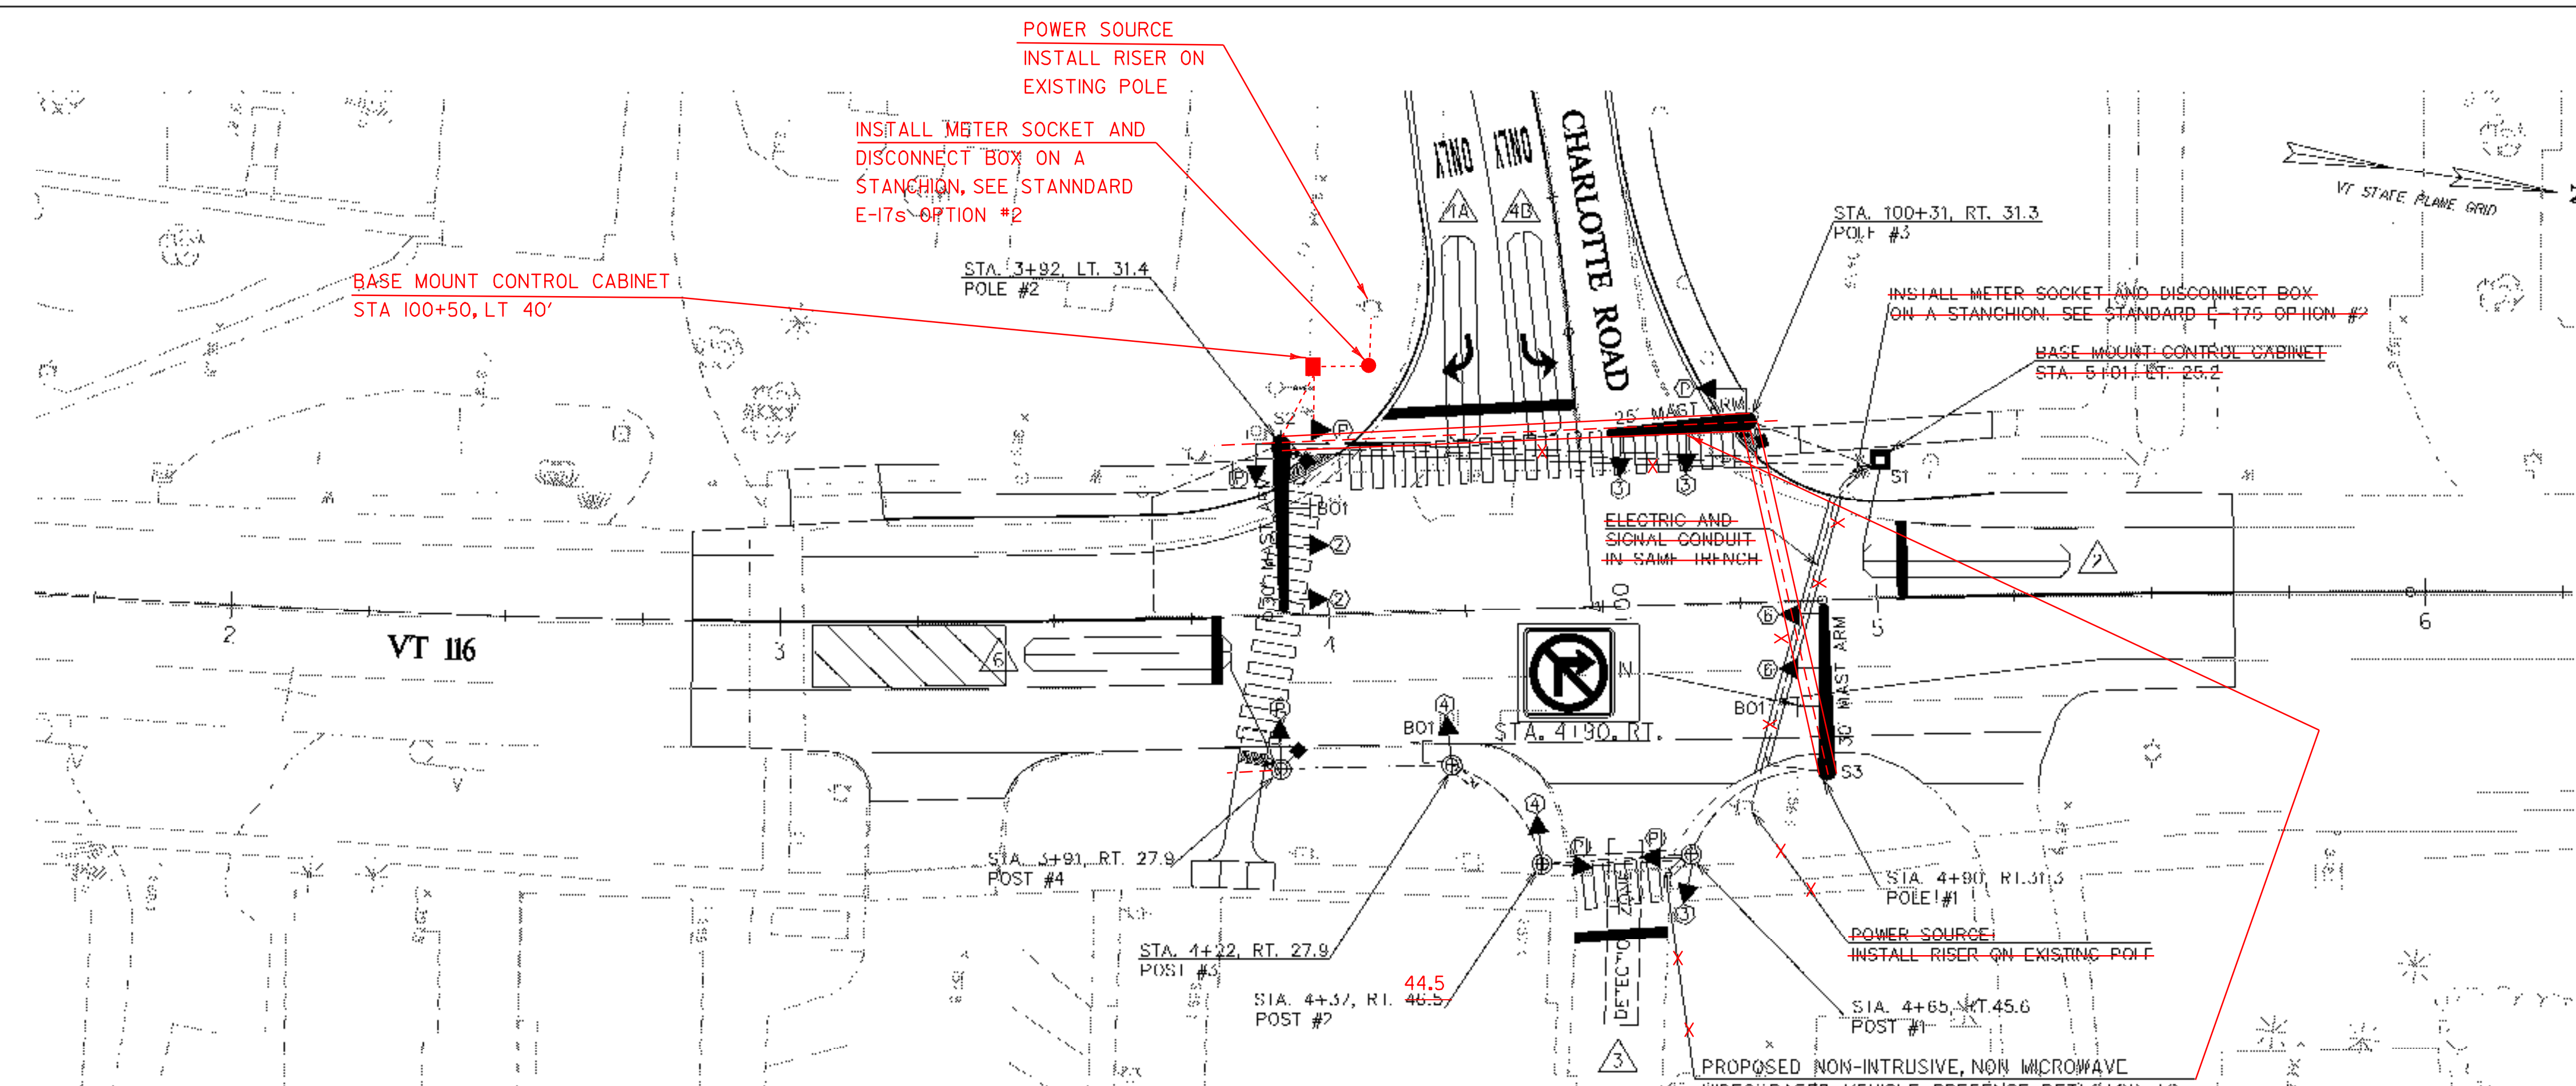

WIRED CONDUIT (PVC) AND ELECTRICAL CONDUIT SLEEVE SCHEDULE


ITEM NUMBER	678.23		678.30		DESCRIPTION
	WIRED CONDUIT	CONDUIT SLEEVE	6"	8"	
FROM/TO	2"	2 1/2"	6"	8"	
POWER TO STANCHION	55		55		POWER (INCLUDES WIRED CONDUIT FOR RISER)
STANCHION TO CABINET	16				POWER
CABINET TO POLE #3	104				POLE #3 WIRING
POLE #3 TO POLE #1	74				POLE #1, POST #1, POST #2, POST #3, POST #4, VIDEO AND LOOP 6 WIRING
POLE #1 TO POST #1	39.3				POST #1, POST #2, POST #3, POST #4, VIDEO AND LOOP 6 WIRING
POST #1 TO POST #2	32.3				POST #2, POST #3, POST #4 AND LOOP 6 WIRING
POST #2 TO POST #3	35.3				POST #3, POST #4 AND LOOP 6 WIRING
POST #3 TO POST #4	34.3				POST #4 AND LOOP 6 WIRING
CABINET TO POLE #2	24				POLE #2 AND LOOP 4A & 4B WIRING
LOOP 2 TO POLE #3	18				LOOP 2 WIRING
LOOP 4A/4B TO POLE #2	12				LOOPS 1A AND 1B WIRING
LOOP 6 TO POST #3	5				LOOP 6 WIRING
SUB-TOTALS	450	371	70	161	159.5
ROUNDING	29	5	4		
TOTALS	400	75	165		

* CONDUIT IN SAME SIZE AS POWER
** CHARLOTTE ROAD NOT WIRED (SPARE)


ELECTRICAL CONDUIT SCHEDULE

ITEM 678.21	STATION	TYPE	
S1	5+01, LT. 25.2	SPARE SWEEP AT CABINET (FUTURE INTERCONNECT)	12'
S2	3+68, LT. 27.2	SPARE SWEEP AT POLE #2 (FUTURE INTERCONNECT)	10'
S3	4+90, RT. 31.3	SPARE SWEEP AT POLE #1 (FUTURE INTERCONNECT)	7'
S4	3+91, RT. 27.9	SPARE SWEEP AT POST #4 (FUTURE INTERCONNECT)	12'-8"

2005 AVERAGE WEEKDAY TRAFFIC DATA

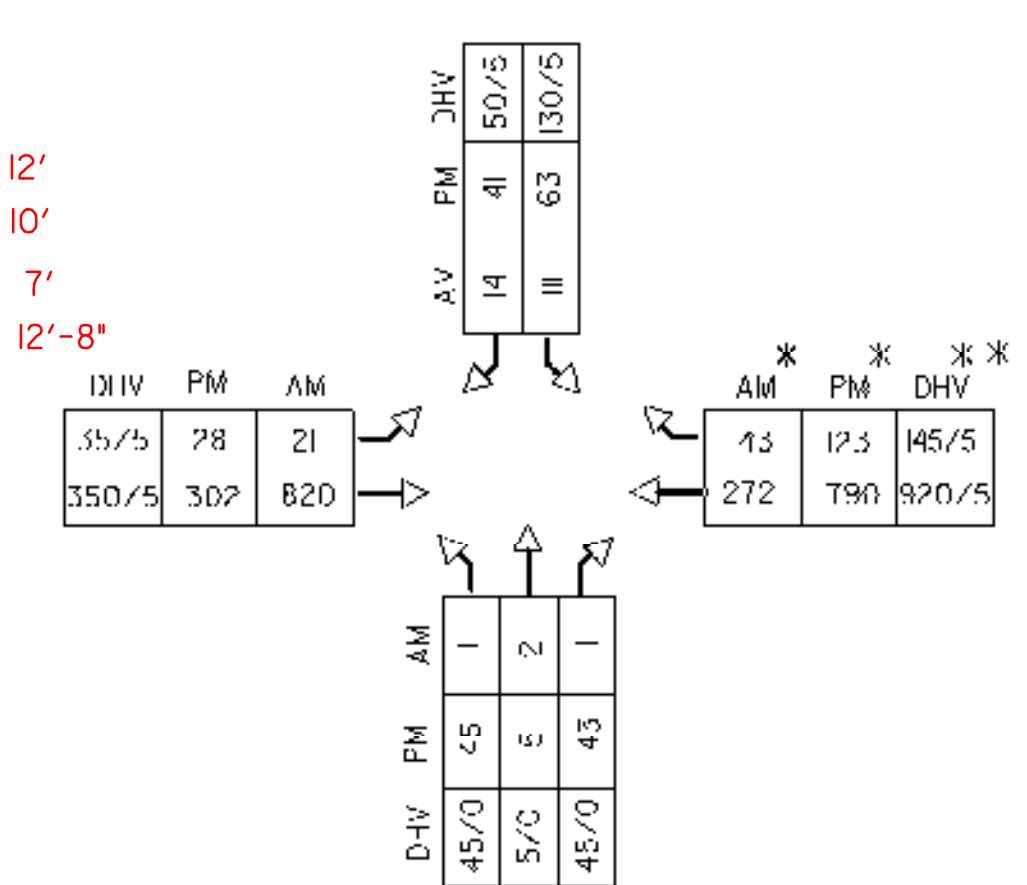

SIGNAL FACE ARRANGEMENT

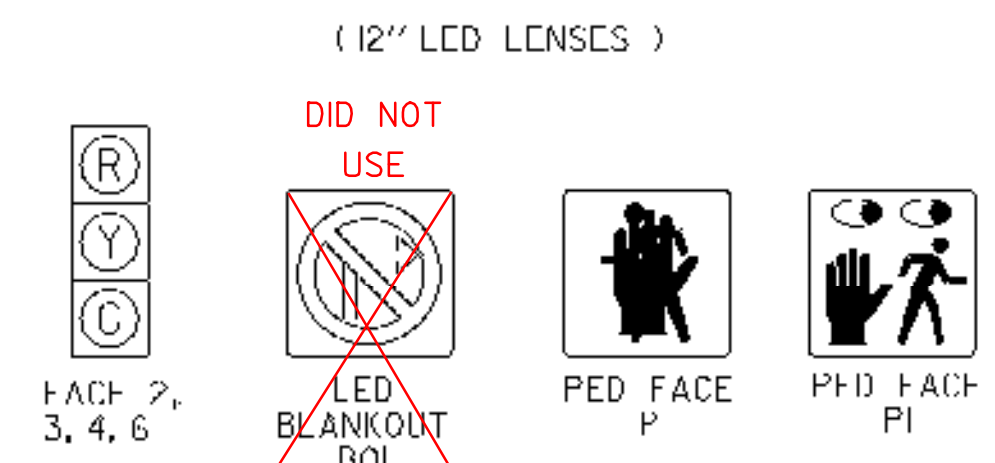

* BASE YEAR TRAFFIC FOR SIGNAL TIMING - 1st YEAR OF OPERATION
** DESIGN HOUR VOLUME, % TRUCKS - BASE YEAR + 10 YEARS

NOTE: POI SHALL ILLUMINATE UPON PHASE 9 PEDESTRIAN ACTUATION. SEE GENERAL NOTE 4 (SHEET 11) FOR FACE 3 POSITIONING.

EQUIPMENT NOTES


- (A) SEE STANDARDS E-1/1B, 1/1C, 1/2, 1/3, & 1/5 FOR ADDITIONAL INFORMATION.
- (B) SEE TRAFFIC SIGNAL NOTE SHEET 14 AND SINGLE MAST ARM CANNISTER/PODING DETAIL SHEET 15 AND MAST ARM CROSS SECTIONS SHEET 16 FOR ADDITIONAL INFORMATION.

DETECTION SCHEDULE

ITEM 678.22 VEHICLE DETECTOR LOOPS										
LOOP NO.	LANE	CALL	SI/F	TYPE & NO. TURNS	DELAY OR PRESENCE	INDUCTANCE CAL. C.	RESISTANCE CAL. ACT.	IF RAKE TO GROUND	LOCKING MEMORY	
1	SBTH	2	6X40	QUAD 2-4-2	PRESENCE	325	366	0.47	1.03	0
2	CBRT	4	6X40	QUAD 2 4 2	5 SEC DELAY	350	348	0.65	0.82	0
3	EBLT	4	6X40	QUAD 2-4-2	PRESENCE	350	341	0.69	0.79	0
4	NBTH	6	6X40	QUAD 2-4-2	PRESENCE	360	426	0.71	1.67	0

ALL CALCULATED VALUES ARE AT THE CONTROLLER. MEASURED VALUES MUST BE FILLED IN PRIOR TO TEST PERIOD.

DATUM
VERTICAL NAVD 88
HORIZONTAL NAD 83

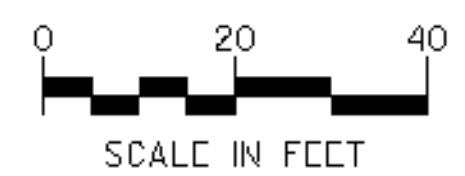

LEGEND

NEW	LEGEND
[Symbol]	CONTROL CABINET
[Symbol]	SIGNAL HEAD
[Symbol]	CONDUIT
[Symbol]	VEHICLE LOOPS
[Symbol]	PEDESTRIAN POST
[Symbol]	STANCHION
[Symbol]	SPARE SWEEP
[Symbol]	MAST ARM
[Symbol]	AUDIBLE PEDESTRIAN INDICATOR
[Symbol]	PEDESTRIAN PUSH BUTTON
[Symbol]	LED BLANKOUT
[Symbol]	VIDEO BASED DETECTION
[Symbol]	OPTIONAL VIDEO LOCATION

PROJECT NAME: HINFSBURG
PROJECT NUMBER: HES 021-1(21)
FILE NAME: z01b208sig.dgn
PROJECT LEADER: G. BAKOS
DESIGNED BY: D. PECK
TRAFFIC SIGNAL PLAN
PLOT DATE: 5/4/2007
DRAWN BY: D. PECK
CHECKED BY: C. BAKOS
SHEET 13 OF 19



WITH GENERATOR HOOKUP PLUG INSTALLED. THE CABINET SHALL BE INSTALLED ON THE FOUNDATION WITH THE DOOR FACING AWAY FROM TRAFFIC.

TRAFFIC SIGNAL NOTES

A. NEW EQUIPMENT

- ALL SIGNAL HEADS MOUNTED ON CANTILEVER ARMS SHALL BE POLY-CARBONATE. BACKPLATES SHALL BE REQUIRED ON ALL HEADS.
- CONTROLLER SHALL BE ECONOLITE ASC/3S-2100 (TS2, TYPE 2) AND THE CABINET SHALL BE ECONOLITE GROUND MOUNTED P44 WITH A BASE EXTENSION WITH GENERATOR HOOKUP PLUG INSTALLED. THE CABINET SHALL BE INSTALLED ON THE FOUNDATION WITH THE DOOR FACING AWAY FROM TRAFFIC.
- A DISCONNECT BREAKER FOR EACH CIRCUIT SHALL BE INSTALLED IN A RAINPROOF (NEMA 3R), LOCKED CABINET ON A STANCHION NEXT TO OR BELOW THE METER SOCKET. RECOMMENDED OPTION #2 ON STD E-175.

B. SIGNAL OPERATION

- UPON STARTUP THE SIGNAL TIMING SHOWN ON THE PLANS MAY REQUIRE FINE-TUNING IN THE FIELD BASED ON TRAFFIC OBSERVATION.
- THE TRAFFIC SIGNALS SHALL NOT BE OPERATED BEFORE PAVEMENT MARKINGS AND SIGNAL RELATED SIGNING IS IN PLACE.
- ALL SIGNALS SHALL DWELL ON THE VT 116 THRU MOVEMENT PHASES (2+6).
- VT 116 THRU PHASES 2+6 SHALL BE USED FOR THE START-UP PHASE FOLLOWING FLASHING OPERATION.

C. TRAFFIC SIGNAL CONDUIT

- ALL TRAFFIC SIGNAL CONDUIT SHALL BE PVC.
- MINIMUM CONDUIT SIZES SHALL BE:
 - 1-1/2" FOR LOOP LEAD-INS,
 - 2" FOR ALL OTHERS.
- WHEN CONDUIT IS PLACED BELOW THE ROADWAY OR ACROSS SIDE ROADS, IT SHALL BE PLACED IN A PVC ELECTRICAL CONDUIT SLEEVE, SIZE AS SHOWN ON THE PLANS (6" MINIMUM).

D. VEHICLE DETECTOR LOOP - SEE STD E-172

- ALL LOOP DETECTORS SHALL BE LABELED WITH THE PHASE NUMBER, APPROACH DIRECTION AND MOVEMENT CONTROLLED BY THE UNIT (I.E. PHASE 2, SB)
- ALL LOOP DETECTORS SHALL BE A TYPE THAT FAIL IN THE 'ON' MODE.

E. VIDEO DETECTION

- PHASE 3 DETECTION SHALL BE A NON-INTRUSIVE, NON-MICROWAVE, VIDEO BASED, VEHICLE PRESENCE SYSTEM WITH 2.5MM OPTICS, TRAFICAM OR APPROVED EQUAL.
- THE VIDEO DETECTION UNIT HAS BEEN RECOMMENDED FOR MOUNTING ABOVE THE POST MOUNTED PEDESTRIAN AND SIGNAL HEAD ASSEMBLY. THE CONTRACTOR MAY OPTIONALLY INSTALL THE UNIT BEHIND SIGNAL HEAD 4 (AS SHOWN ON THE TRAFFIC SIGNAL LAYOUT) IF BETTER VISUAL ACUITY CAN BE OBTAINED. THIS DECISION CAN BE MADE IN THE FIELD WITH APPROVAL BY THE ENGINEER. VIDEO DETECTION EQUIPMENT AND INSTALLATION IS INCIDENTAL TO THE TRAFFIC SIGNAL INSTALLATION, ITEM 678.15.


F. GENERAL

- THE CONTRACTOR SHALL ACQUIRE ALL NECESSARY PERMITS AND MAKE ALL NECESSARY ARRANGEMENTS WITH THE UTILITY COMPANY TO PROVIDE A PERMANENT POWER SUPPLY TO THE SIGNAL AND STREET LIGHTING EQUIPMENT.
- SEE SUPPLEMENTAL SPECIFICATIONS FOR SECTIONS 678, 679, 752 & 753 FOR ADDITIONAL INFORMATION.
- THE CONTRACTOR SHALL REFERENCE SECTION 678 OF THE STANDARD SPECIFICATIONS FOR FURNISHING AND INSTALL PEDESTRIAN SIGNAL EQUIPMENT. NOTE THAT NO AUDIBLE EQUIPMENT OR PEDESTRIAN PUSHBUTTONS SHALL BE REQUIRED FOR THE PEDESTAL POST CONTROLLING PEDESTRIAN MOVEMENT ACROSS THE RETAIL DRIVEWAY GIVEN THAT THESE PEDESTRIAN SIGNALS SHALL BE ON RECALL WITH ALL PHASES EXCEPT PHASE 3.
- THE CONTRACTOR SHALL NOTE THAT POLE #3 IS TO BE LOCATED BEHIND EXISTING OVERHEAD UTILITY LINES. THE CONTRACTOR SHALL POSITION AND INSTALL THE FACE 3 SIGNAL HEADS SO THAT ALL LENSES ARE VISIBLE FROM THE ADJACENT APPROACH WHILE CONFORMING TO MUTCD AND VTRANS VERTICAL HEIGHT CRITERIA. IF FULL VIEW OF ALL THREE (RED, YELLOW, AND GREEN) LENSES IS FOUND INFEASIBLE, THE CONTRACTOR SHALL OPTIONALLY POLE MOUNT THE NORTHERN MOST SIGNAL HEAD ON POLE #3 (SEE SHEET 13 FOR ADDITIONAL INFORMATION).
- DUE TO THE PRESENCE OF MANY EXISTING OVERHEAD UTILITIES IN THE VICINITY OF THE VT116 AND CHARLOTTE ROAD INTERSECTION, THE CONTRACTOR SHALL FIELD VERIFY AND ADJUST AS NECESSARY THE FINAL LOCATION OF THE SIGNAL STRUCTURES TO ENSURE ALL APPLICABLE CRITERIA IN THE NATIONAL ELECTRICAL CODE (NEC) AND NATIONAL ELECTRICAL SAFETY CODE (NEC) IS MET. TO ASSIST IN MEETING THIS CRITERIA, SPECIAL CURVED MAST ARM POLES HAVE BEEN PROPOSED WITH A 16-FOOT VERTICAL MAST MOUNTING AND A 10-FOOT MINIMUM HORIZONTAL CURVED MAST ARM BEFORE THE 20 FOOT VERTICAL MAST ARM HEIGHT IS ACHIEVED; HOWEVER, THE 10-FOOT HORIZONTAL CURVED SECTION CAN BE MODIFIED PER MANUFACTURERS RECOMMENDATION WITH APPROVAL OF THE ENGINEER UPON SUBMISSION OF SHOP DRAWINGS.
- SEE THE CONTROLLER ID PLAQUE DETAIL ON THIS SHEET.

TIMING AND PHASING

	PHASE 2+6 (DWELL)					PHASE 3					PHASE 4					PED PHASE 9					FLASHING OPERATION	
	R/W	Ø 3	Ø 4	Ø 4	PED Ø 9	R/W	Ø 4	PED Ø 9	Ø 2+6	R/W	PED Ø 9	Ø 2+6	Ø 3	R/W	Ø 2+6	Ø 3	Ø 4					
AM PEAK 7-9 AM	VEHICLE	4				2				2												
	MINIMUM	8	4	2	4	2	4	2	4	2	4	2	4	2								
	MAXIMUM																					
	MAXIMUM2	40	4	2	4	2	4	2	4	2	4	2	4	2								
	PED ACT																					
OFF PEAK REST OF DAY	VEHICLE	4				2				2												
	MINIMUM	8	4	2	4	2	4	2	4	2	4	2	4	2								
	MAXIMUM																					
	MAXIMUM2	25	4	2	4	2	4	2	4	2	4	2	4	2								
	PED ACT																					
PM PEAK 3:00-6:00 PM	VEHICLE	4				2				2												
	MINIMUM	8	4	2	4	2	4	2	4	2	4	2	4	2								
	MAXIMUM																					
	MAXIMUM2	40	4	2	4	2	4	2	4	2	4	2	4	2								
	PED ACT																					
FACE 2	G	Y	R	Y	R	Y	R	R	R	R	R	R	R	R	R	R	R	R	F	Y		
FACE 3	R	R	R	R	R	R	R	G	Y	R	Y	Y	R	R	R	R	R	R	R	F	R	
FACE 4A	R	R	R	R	R	R	R	R	R	R	R	R	R	G	Y	R	Y	Y	R	R	F	R
FACE 4B	R	R	R	R	R	R	R	R	R	R	R	R	R	G	Y	R	Y	Y	R	R	F	R
FACE 6	G	Y	R	Y	R	Y	R	R	R	R	R	R	R	R	R	R	R	R	R	R	F	Y
PED 9	D	W	D	W	D	W	D	W	D	W	D	W	D	W	D	W	D	W	D	W	F	B
CONC PED	W	F	D	W	W	W	W	D	W	D	W	D	W	W	W	W	F	D	W	W	F	B

W = WALK, FD = FLASHING DON'T WALK, DW = DON'T WALK, B = BLANK
 * = FACE NUMBERS ARE BASED ON NEMA PHASES (2, 4, 6 & 8 FOR THRU/RIGHTS)
 ** = A CONCURRENT PEDESTRIAN PHASE ACROSS LANTMANS DRIVE SHALL BE PROGRAMMED FOR ALL VEHICLE PHASES EXCEPT PHASE 3
 *** = LED BLANKOUT B02 SHALL BE ILLUMINATED WITH EXCLUSIVE PEDESTRIAN PHASE 9. LED BLANKOUT B01 SHALL BE ILLUMINATED DURING ALL HOURS OF THE DAY.

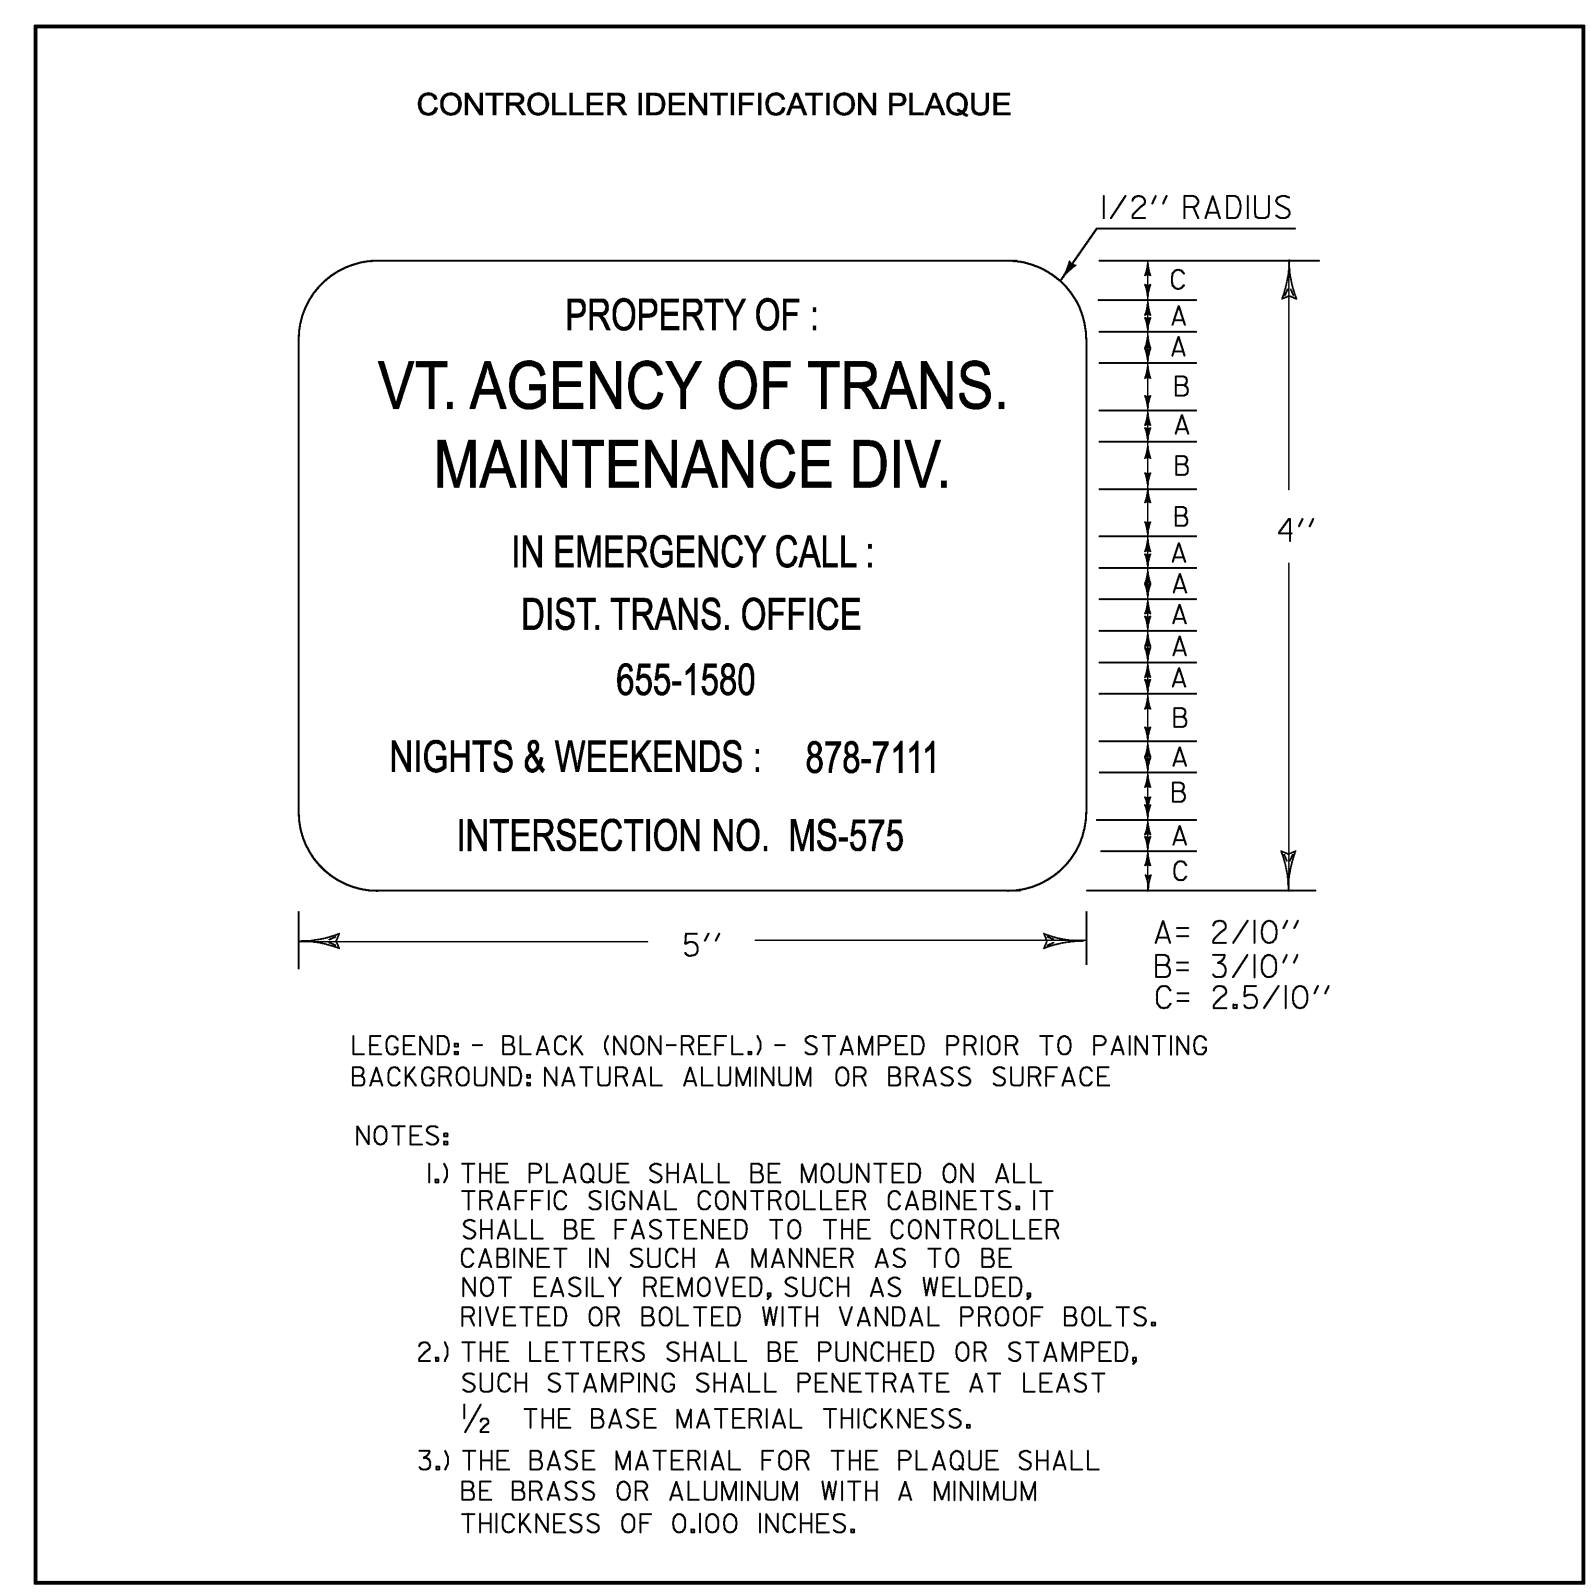


LEGEND: - BLACK (NON-REFL.) - STAMPED PRIOR TO PAINTING
 BACKGROUND: NATURAL ALUMINUM OR BRASS SURFACE

NOTES:
 1.) THE PLAQUE SHALL BE MOUNTED ON ALL TRAFFIC SIGNAL CONTROLLER CABINETS. IT SHALL BE FASTENED TO THE CONTROLLER CABINET IN SUCH A MANNER AS TO BE NOT EASILY REMOVED, SUCH AS WELDED, RIVETED OR BOLTED WITH VANDAL PROOF BOLTS.
 2.) THE LETTERS SHALL BE PUNCHED OR STAMPED, SUCH STAMPING SHALL PENETRATE AT LEAST 1/2 THE BASE MATERIAL THICKNESS.
 3.) THE BASE MATERIAL FOR THE PLAQUE SHALL BE BRASS OR ALUMINUM WITH A MINIMUM THICKNESS OF 0.010 INCHES.


PROGRAM PERIODS OF OPERATION

	1	2	3	4	5	6	7	8	9	10	11	12	1	2	3	4	5	6	7	8	9	10	11	12
	AM												PM											
SUNDAY																								
MONDAY																								
TUESDAY																								
WEDNESDAY																								
THURSDAY																								
FRIDAY																								
SATURDAY																								


NOTES:
 PLAN 1 - OFFPEAK (MAXIMUM 1): MIDNIGHT TO 7:00 AM, M-F
 9:00 AM TO 3:00 PM, M-F
 6:00 PM TO MIDNIGHT, M-F
 ALL DAY SATURDAY AND SUNDAY
 PLAN 2 - RUSH HOUR PEAK (MAXIMUM 2): 7:00 AM TO 9:00 AM, M-F
 3:00 PM TO 6:00 PM, M-F

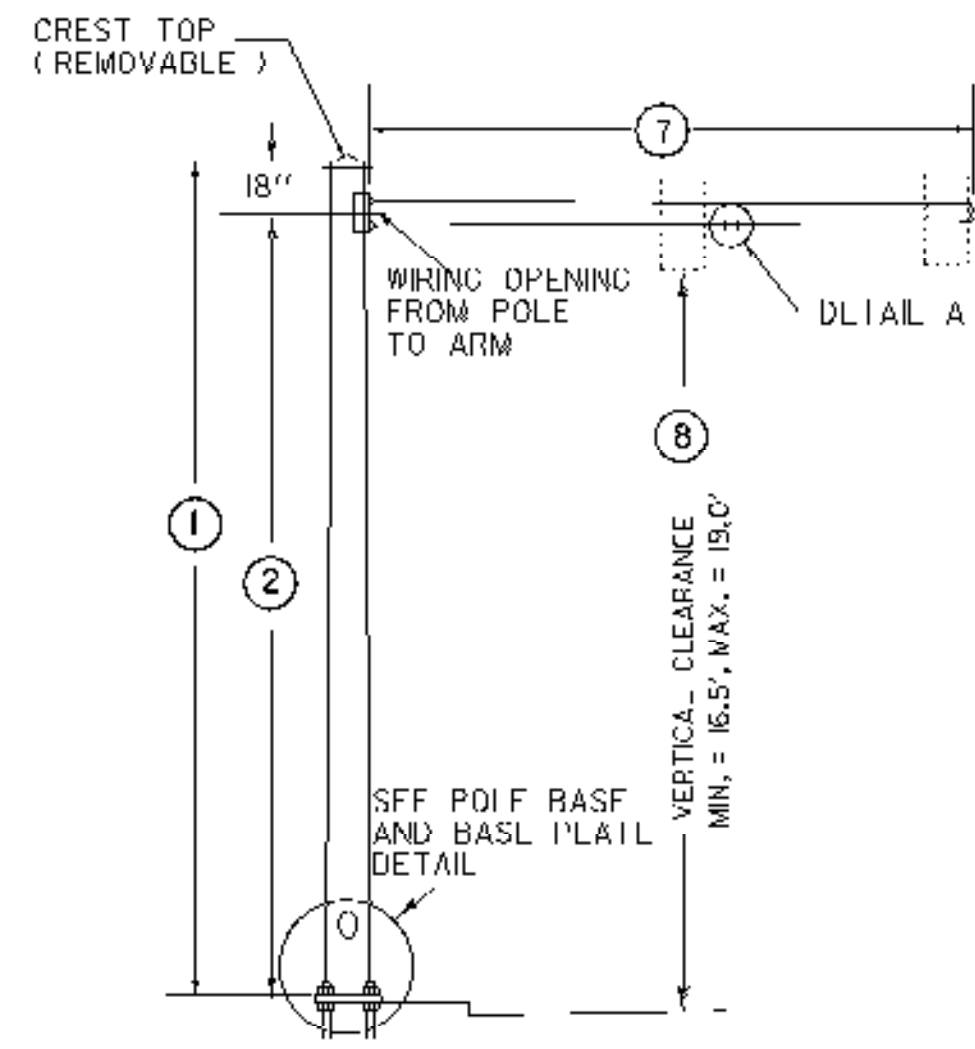


TYPE A

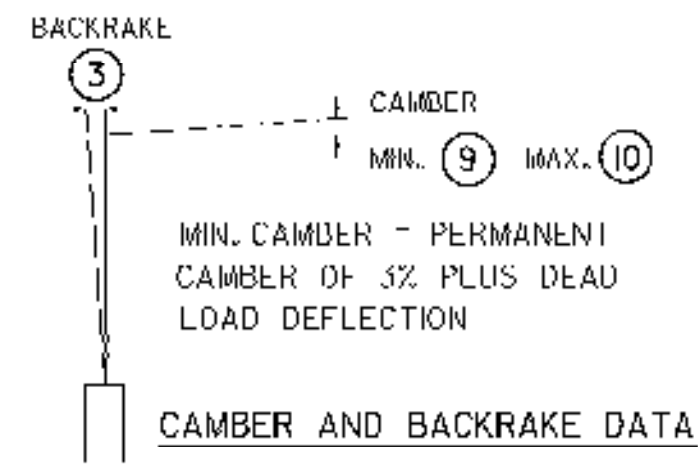

- POLE BASE DIAMETER (4)
- POLE GAUGE (5)
- POLE TAPER RATE (6)
- ARM DIAMETER (11)
- ARM GAUGE (12)
- ARM TAPER RATE (13)

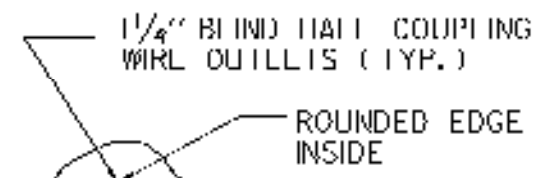


DETAIL A

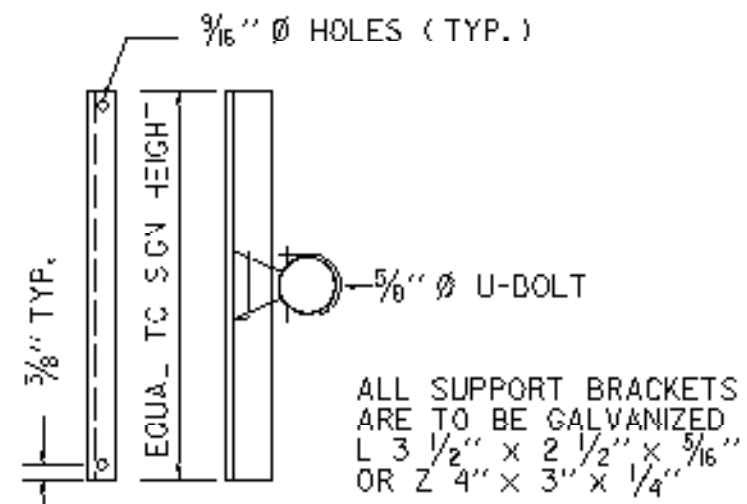


SIGN ON SINGLE MAST ARM

SIGN BRACKET DETAILS

ANCHOR BOLT DETAIL		
SIZE	I (IN)	I (IN)
1- 1/4" X 48"	42	8
1- 1/2" X 60"	54	9
1- 3/4" X 90"	84	9
2" X 96"	96	9

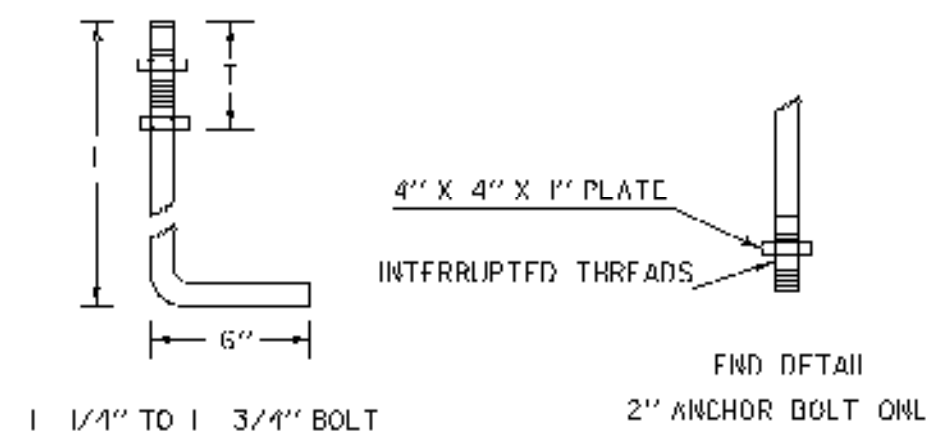


ANCHOR BOLT DETAIL


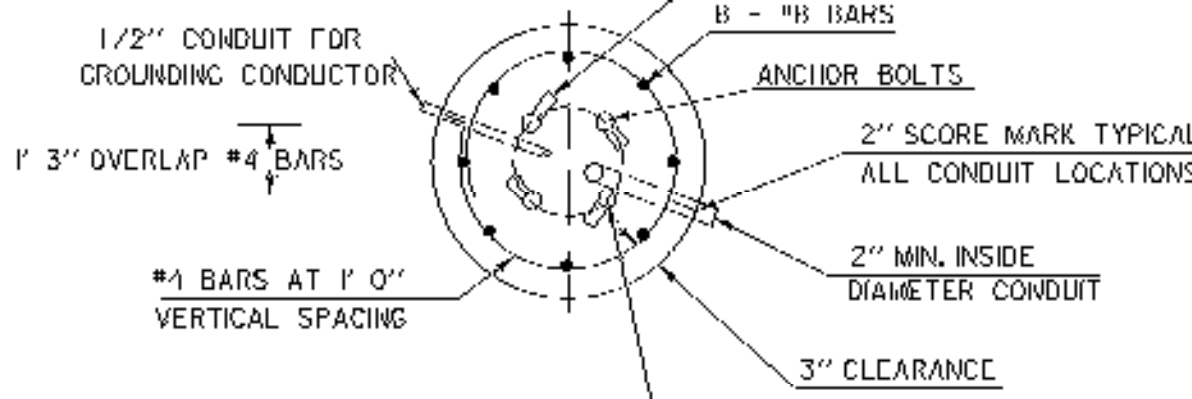


SECTION


CANTILEVER FOOTING DETAIL
(SPREAD FOOTINGS OR PILES ARE OPTIONAL)

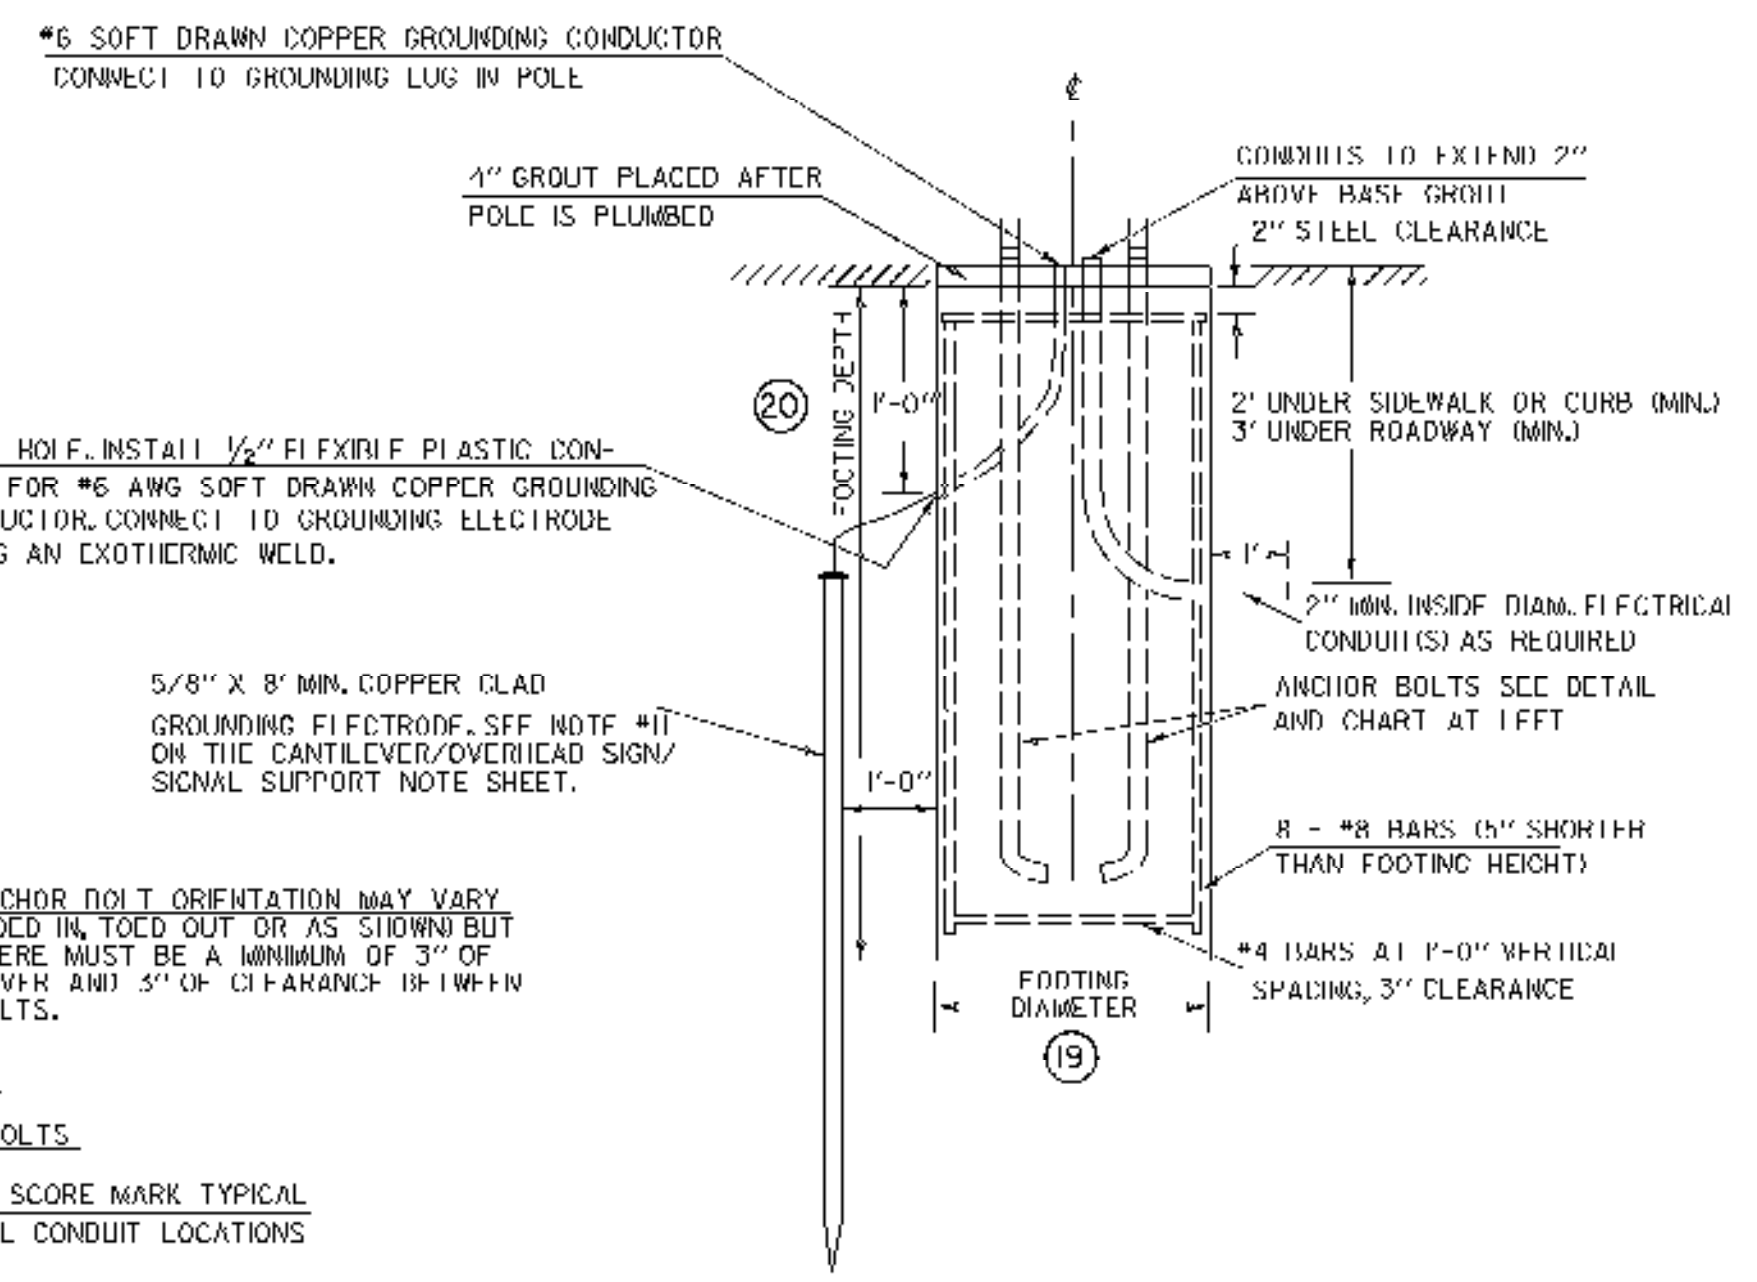




ELEVATION

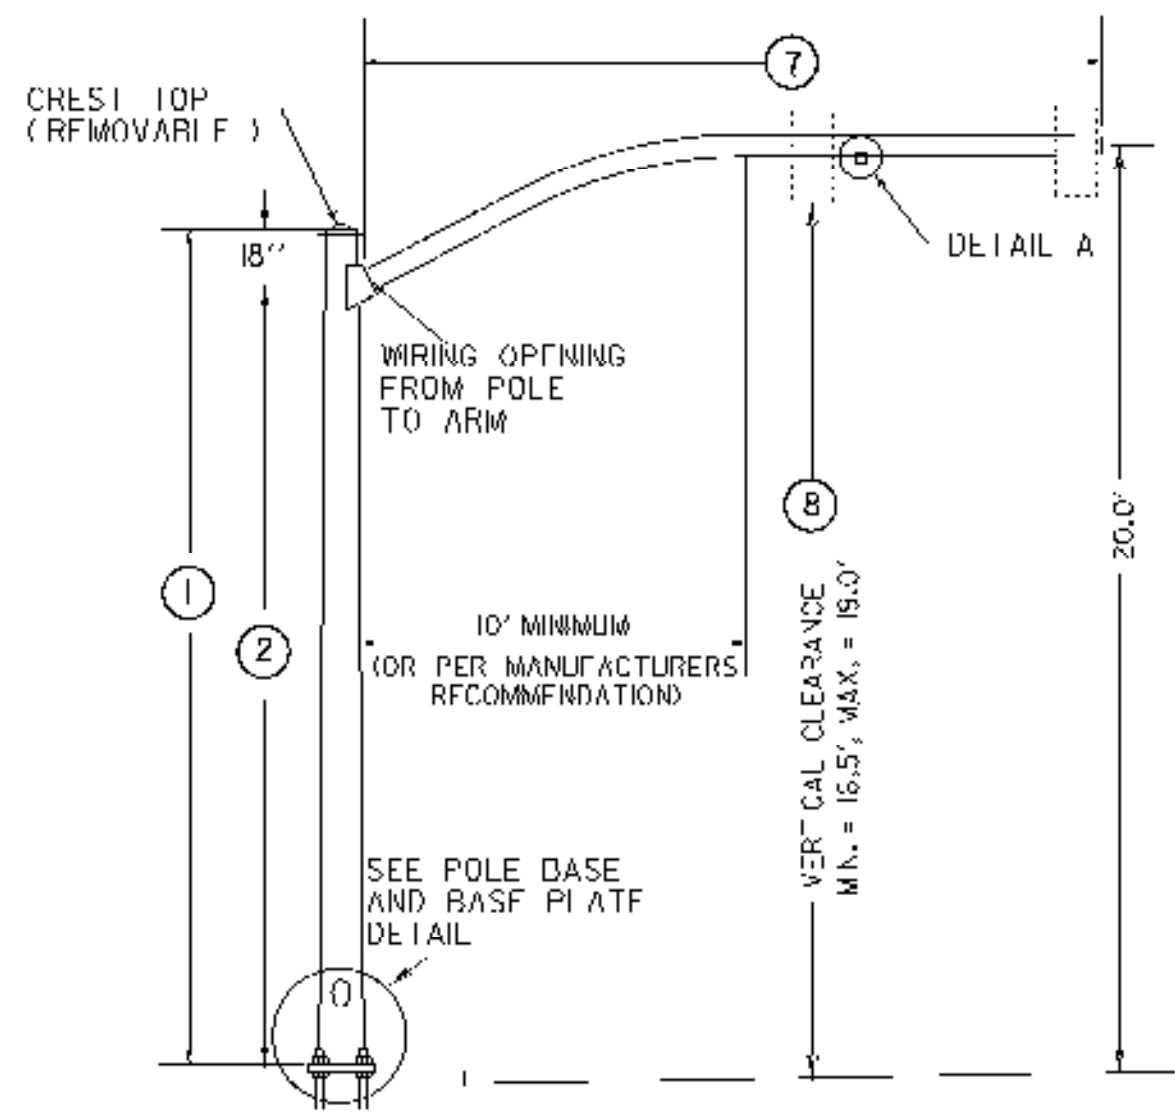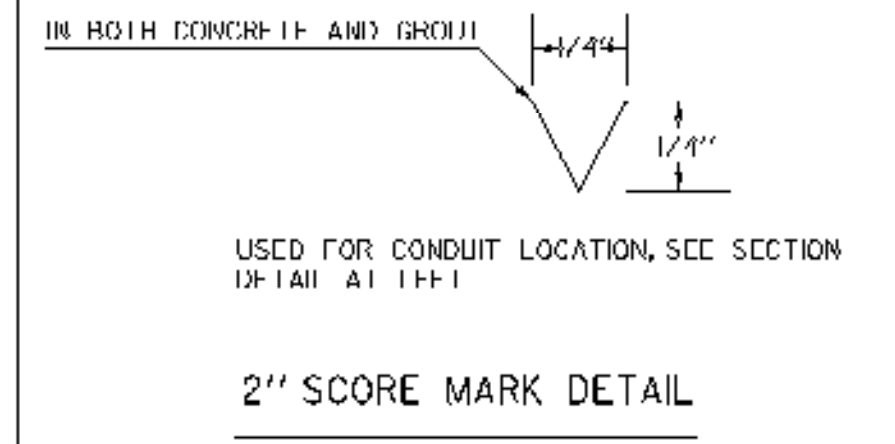


TYPE AI
(SPECIAL CURVED MAST ARM)

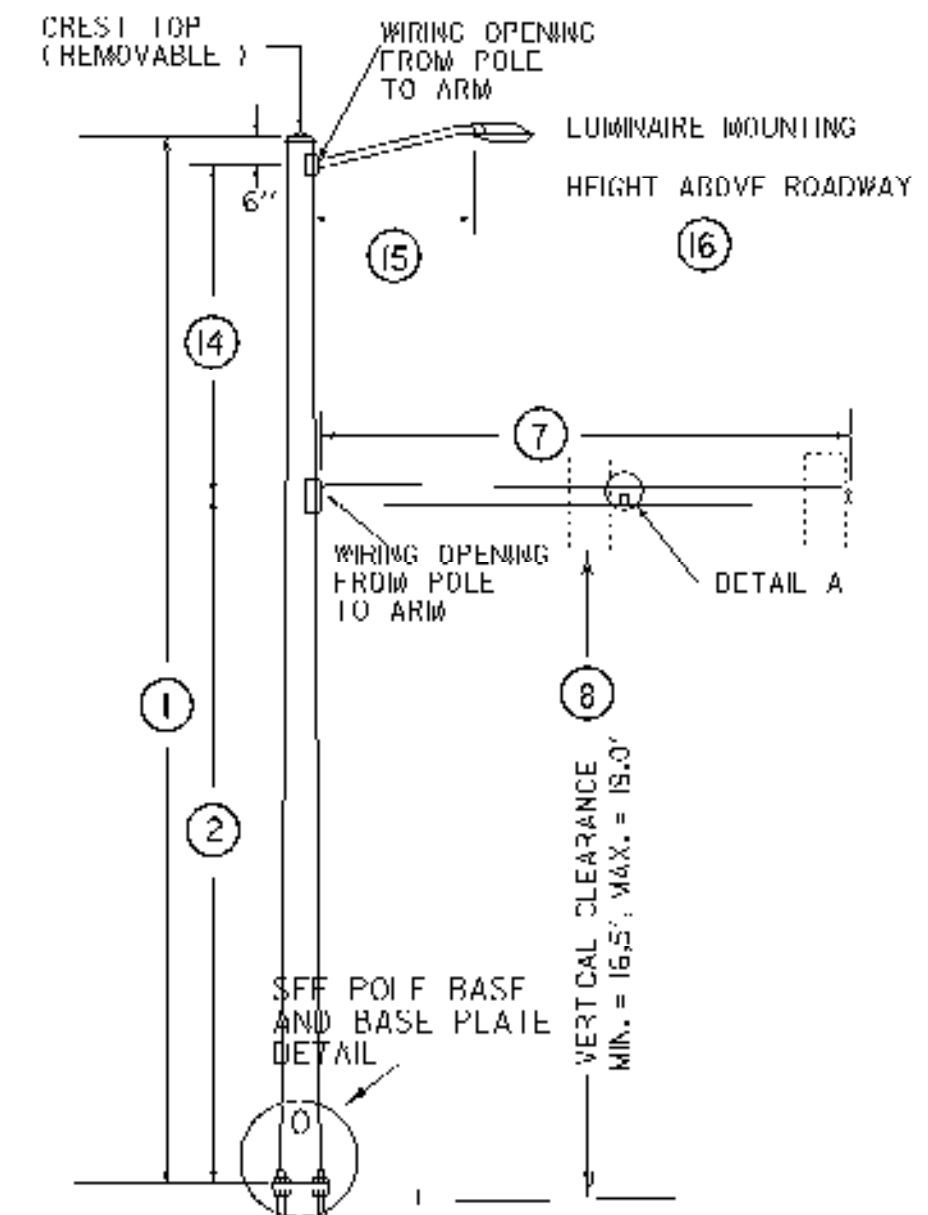

TYPE B

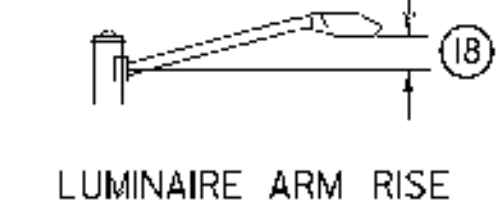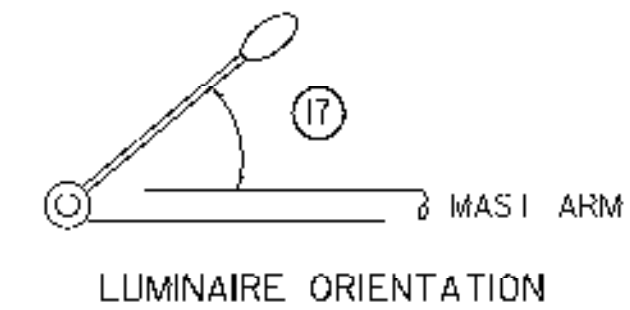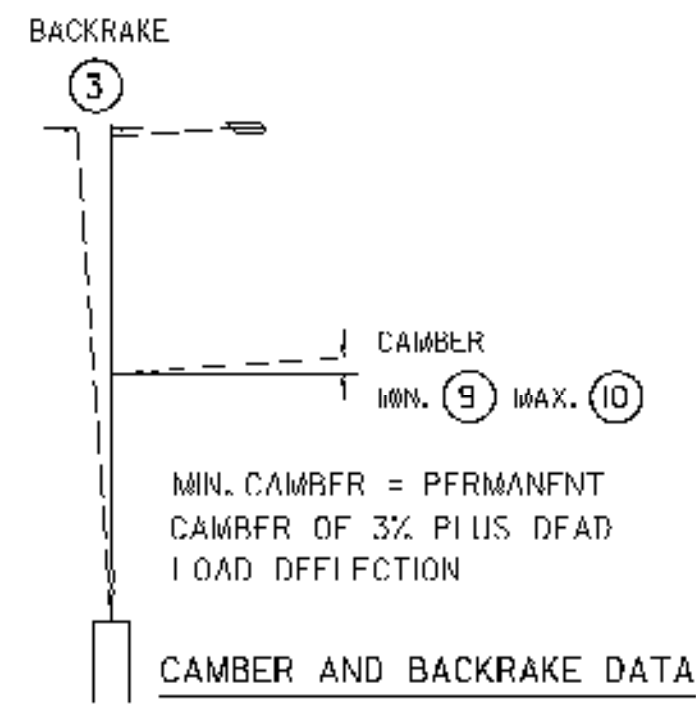






POLE I	TYPE	STRUCTURAL DIMENSIONS													FOOTING DATA		BASE PLATE / BOLT DATA										
		POLE DATA			ARM DATA			LIGHTING DATA			ANCHOR BOLT SIZE		ANCHOR BOLT SIZE														
		(1)	(2)	(3)	(4)	(5)	(6)	(7)	(8)	(9)	(10)	(11)	(12)	(13)	(14)	(15)	(16)	(17)	(18)	(19)	(20)	(C)	(F)	(S)	(T)	(P)	
#1	A1	17.5'	16'	0	12'	7	0.14 FT	30'	19'	18°		8"	7	0.14 FT						3'	3.5'	16"	1 1/8"	16"	1.25"	4.5'	1 x 36
#2	A1	17.5'	16'	0	12'	7	0.14 FT	30'	17.5'	18°		8"	7	0.14 FT						3'	3.5'	16"	1 1/8"	16"	1.25"	4.5'	1 x 36
#3	A1	17.5'	16'	0	10.5'	7	0.14 FT	25'	18'	26°		7"	7	0.14 FT						3'	3.5'	14"	9 7/8"	14.5'	1"	4.25'	1 x 36

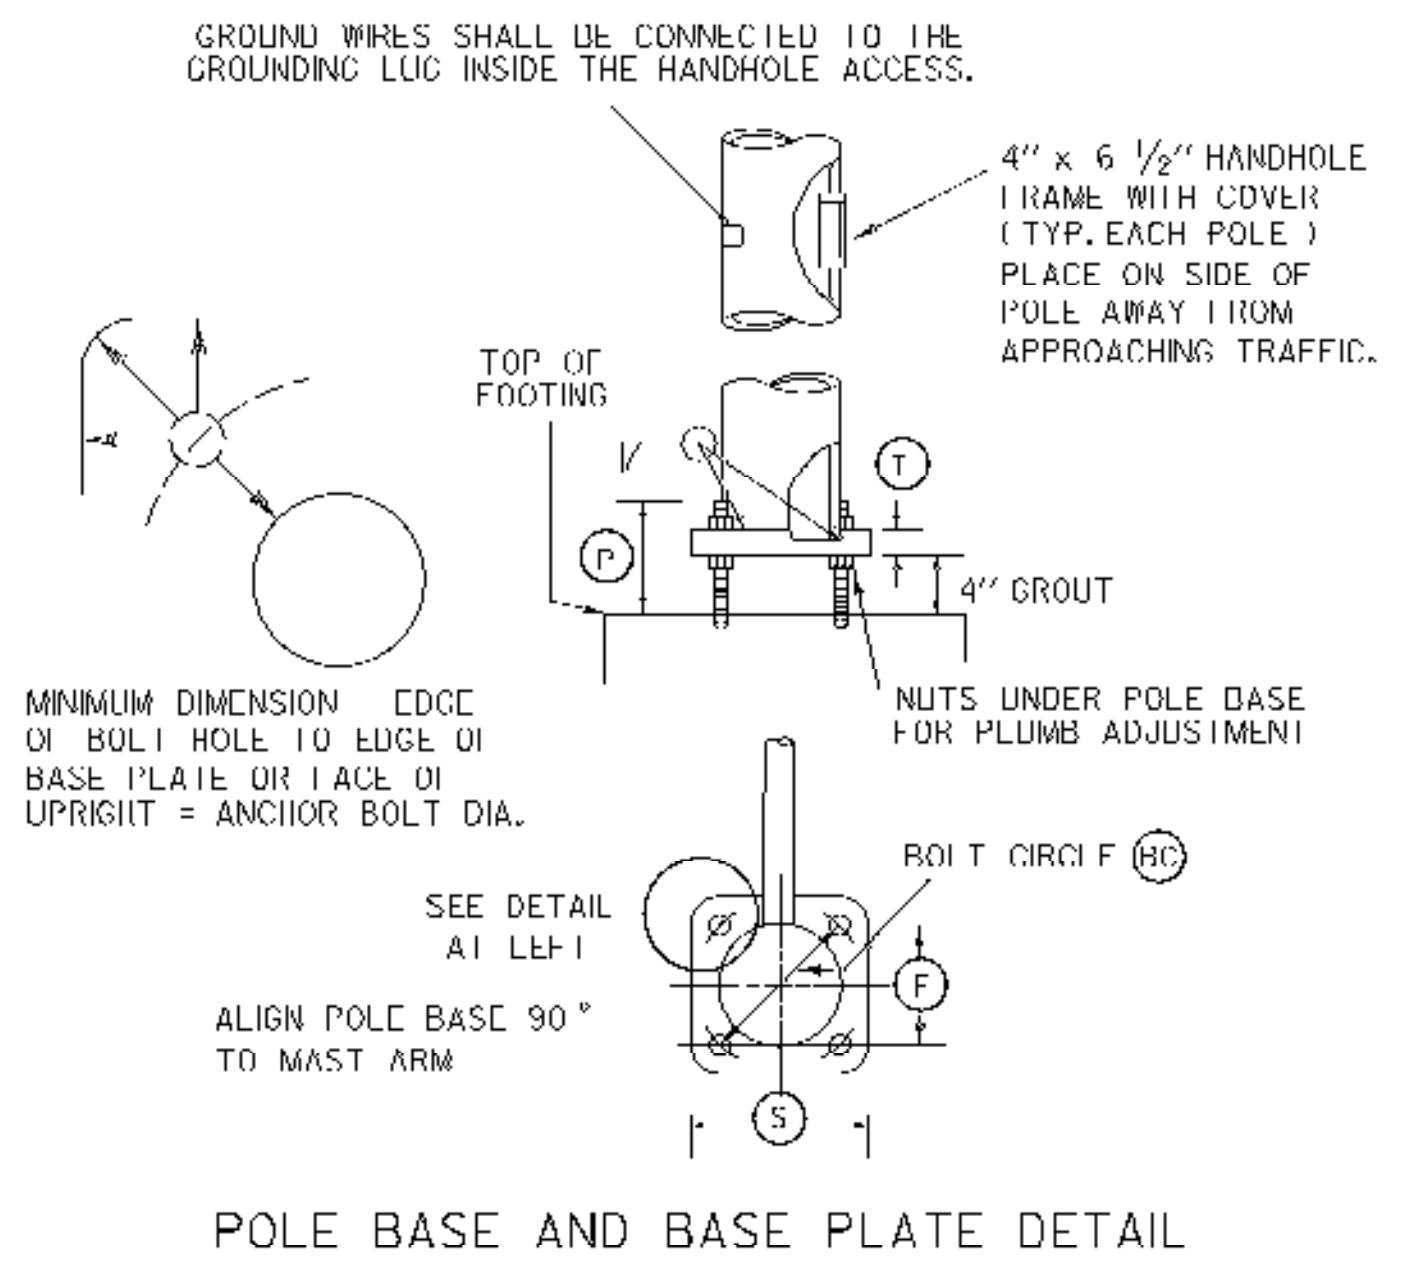

NOTE: DETAILS NOTS
/ Inp / forms / can / illw / .dgn
DATE 08/01/06
PLOT 08/01/06


SINGLE MAST ARM CANTILEVER / FOOTING DETAIL SHEET

PREPARED BY: JAR DATE 08/01/06
CHECKED BY: CMB DATE 08/01/06
DESIGN SUPERVISOR: DAIL
PROJECT NAME: HINESBURG
PROJECT NUMBER: HES 021-1(21)
TRAFFIC SHEET NO. 5 OF 4
SHEET 15 OF 19 SHEETS

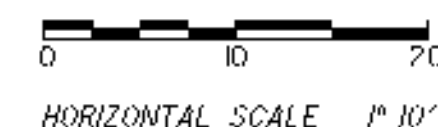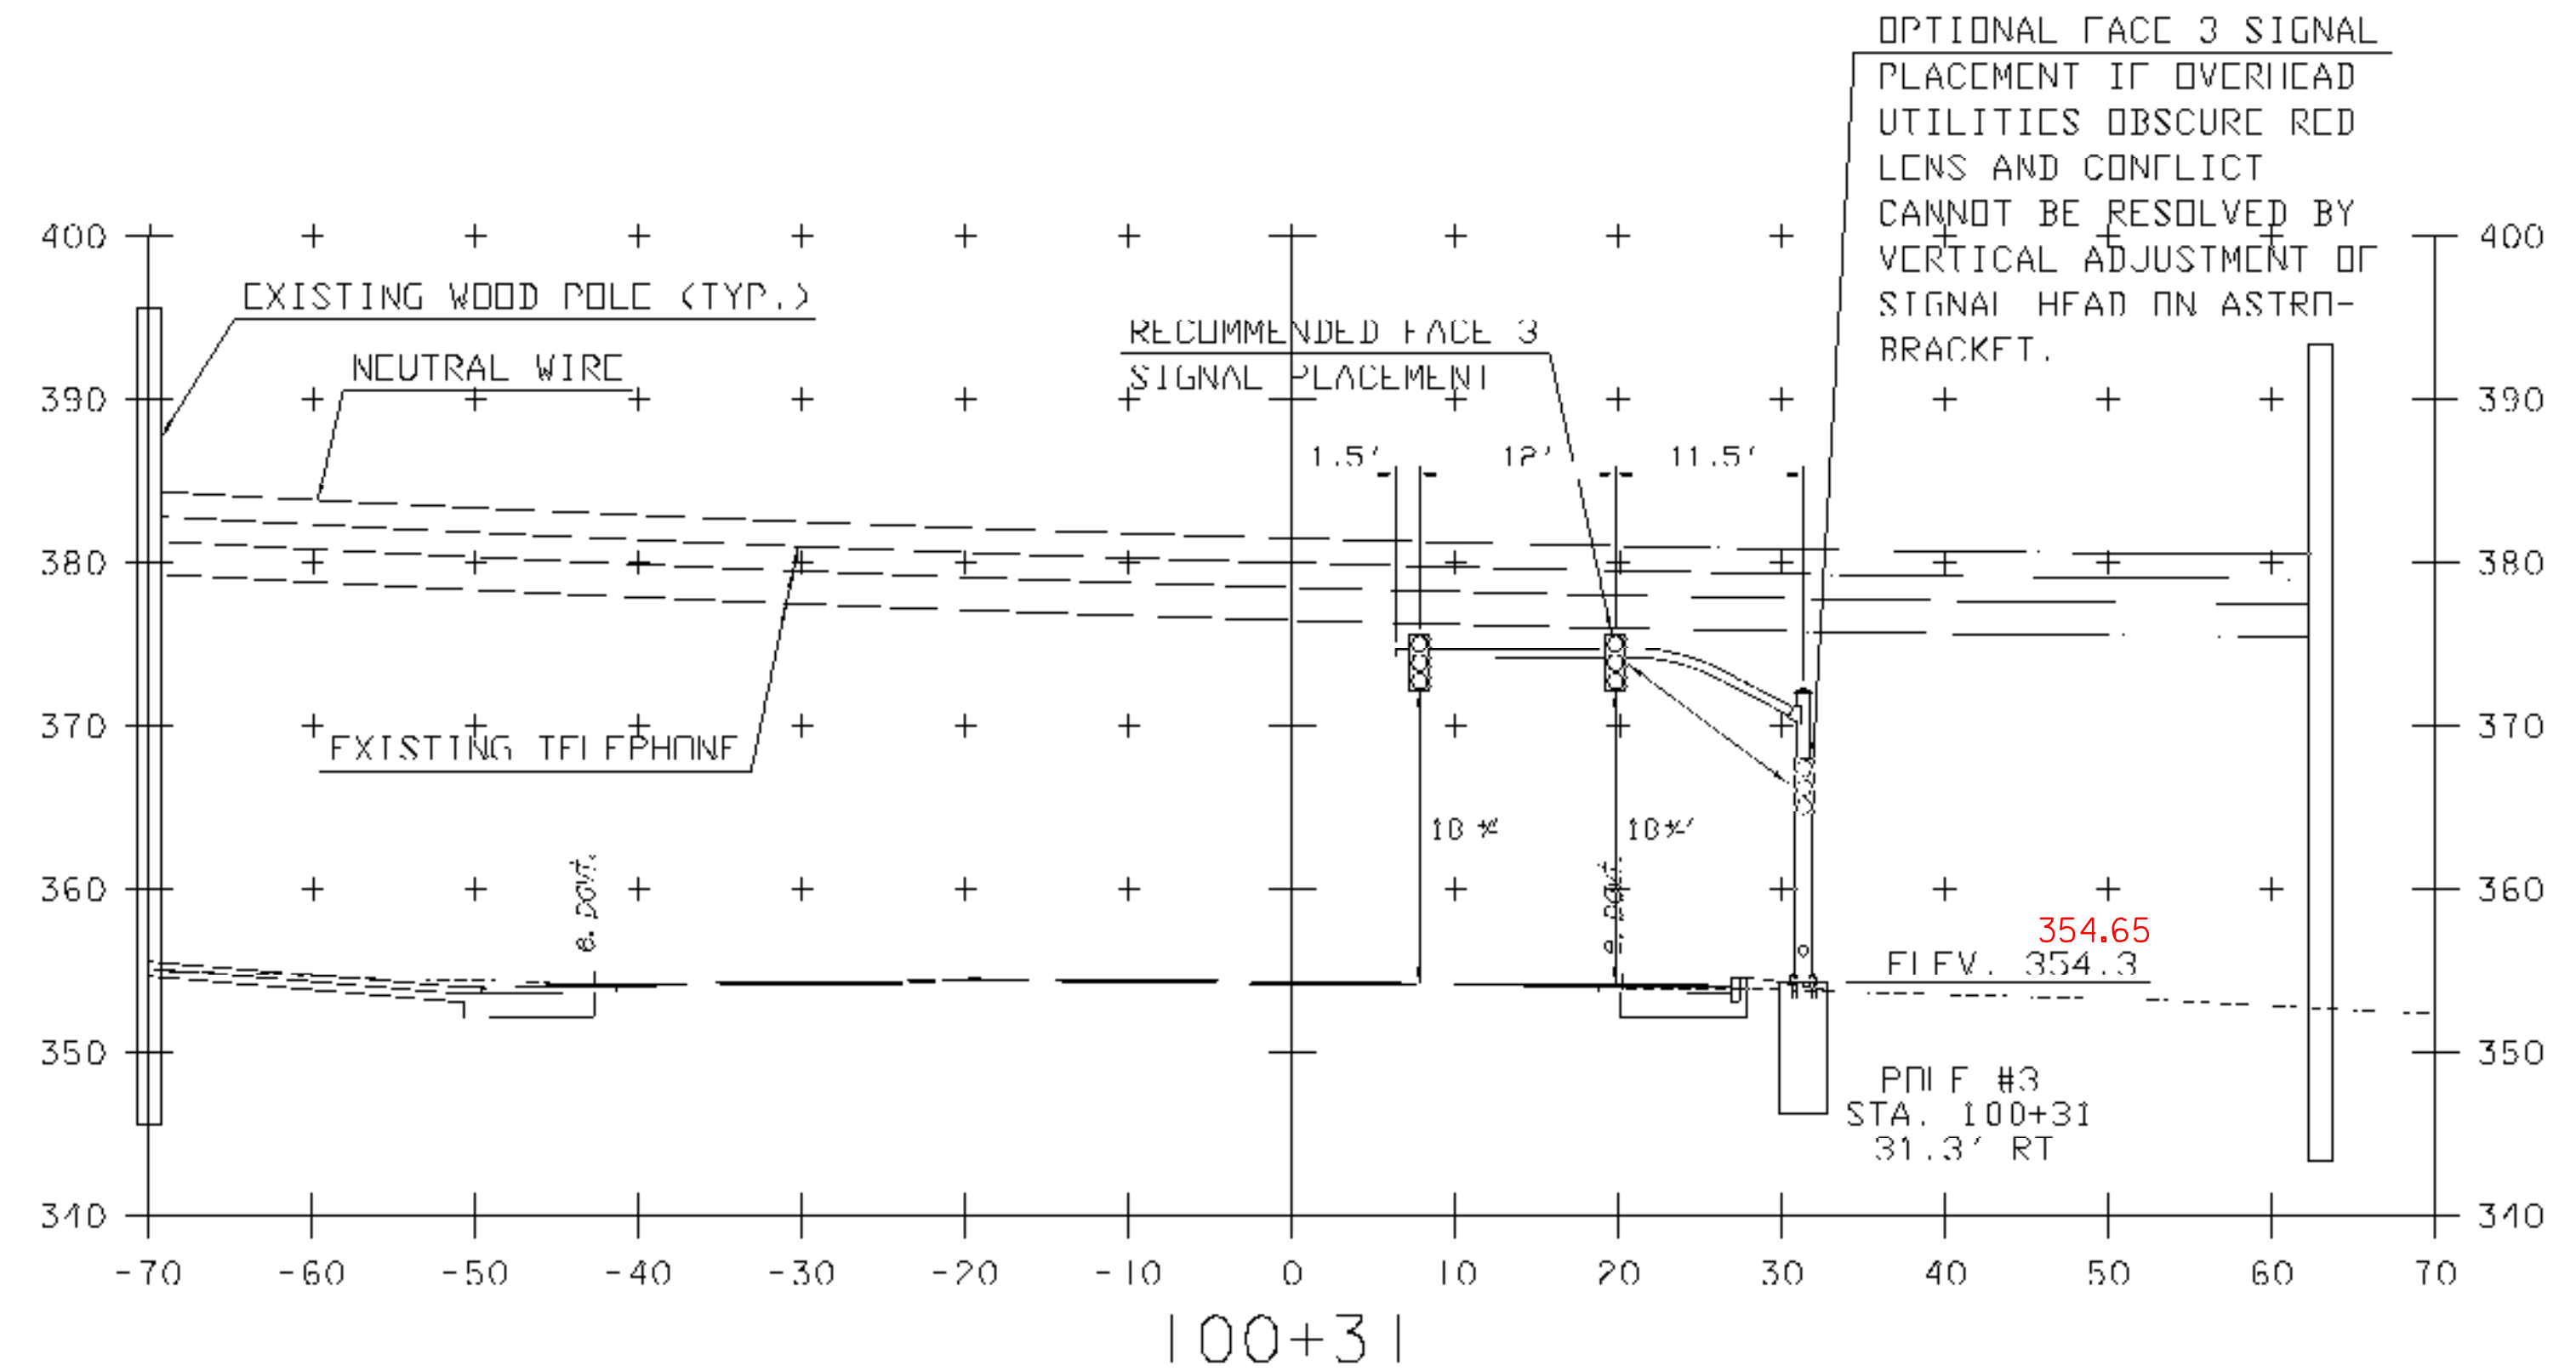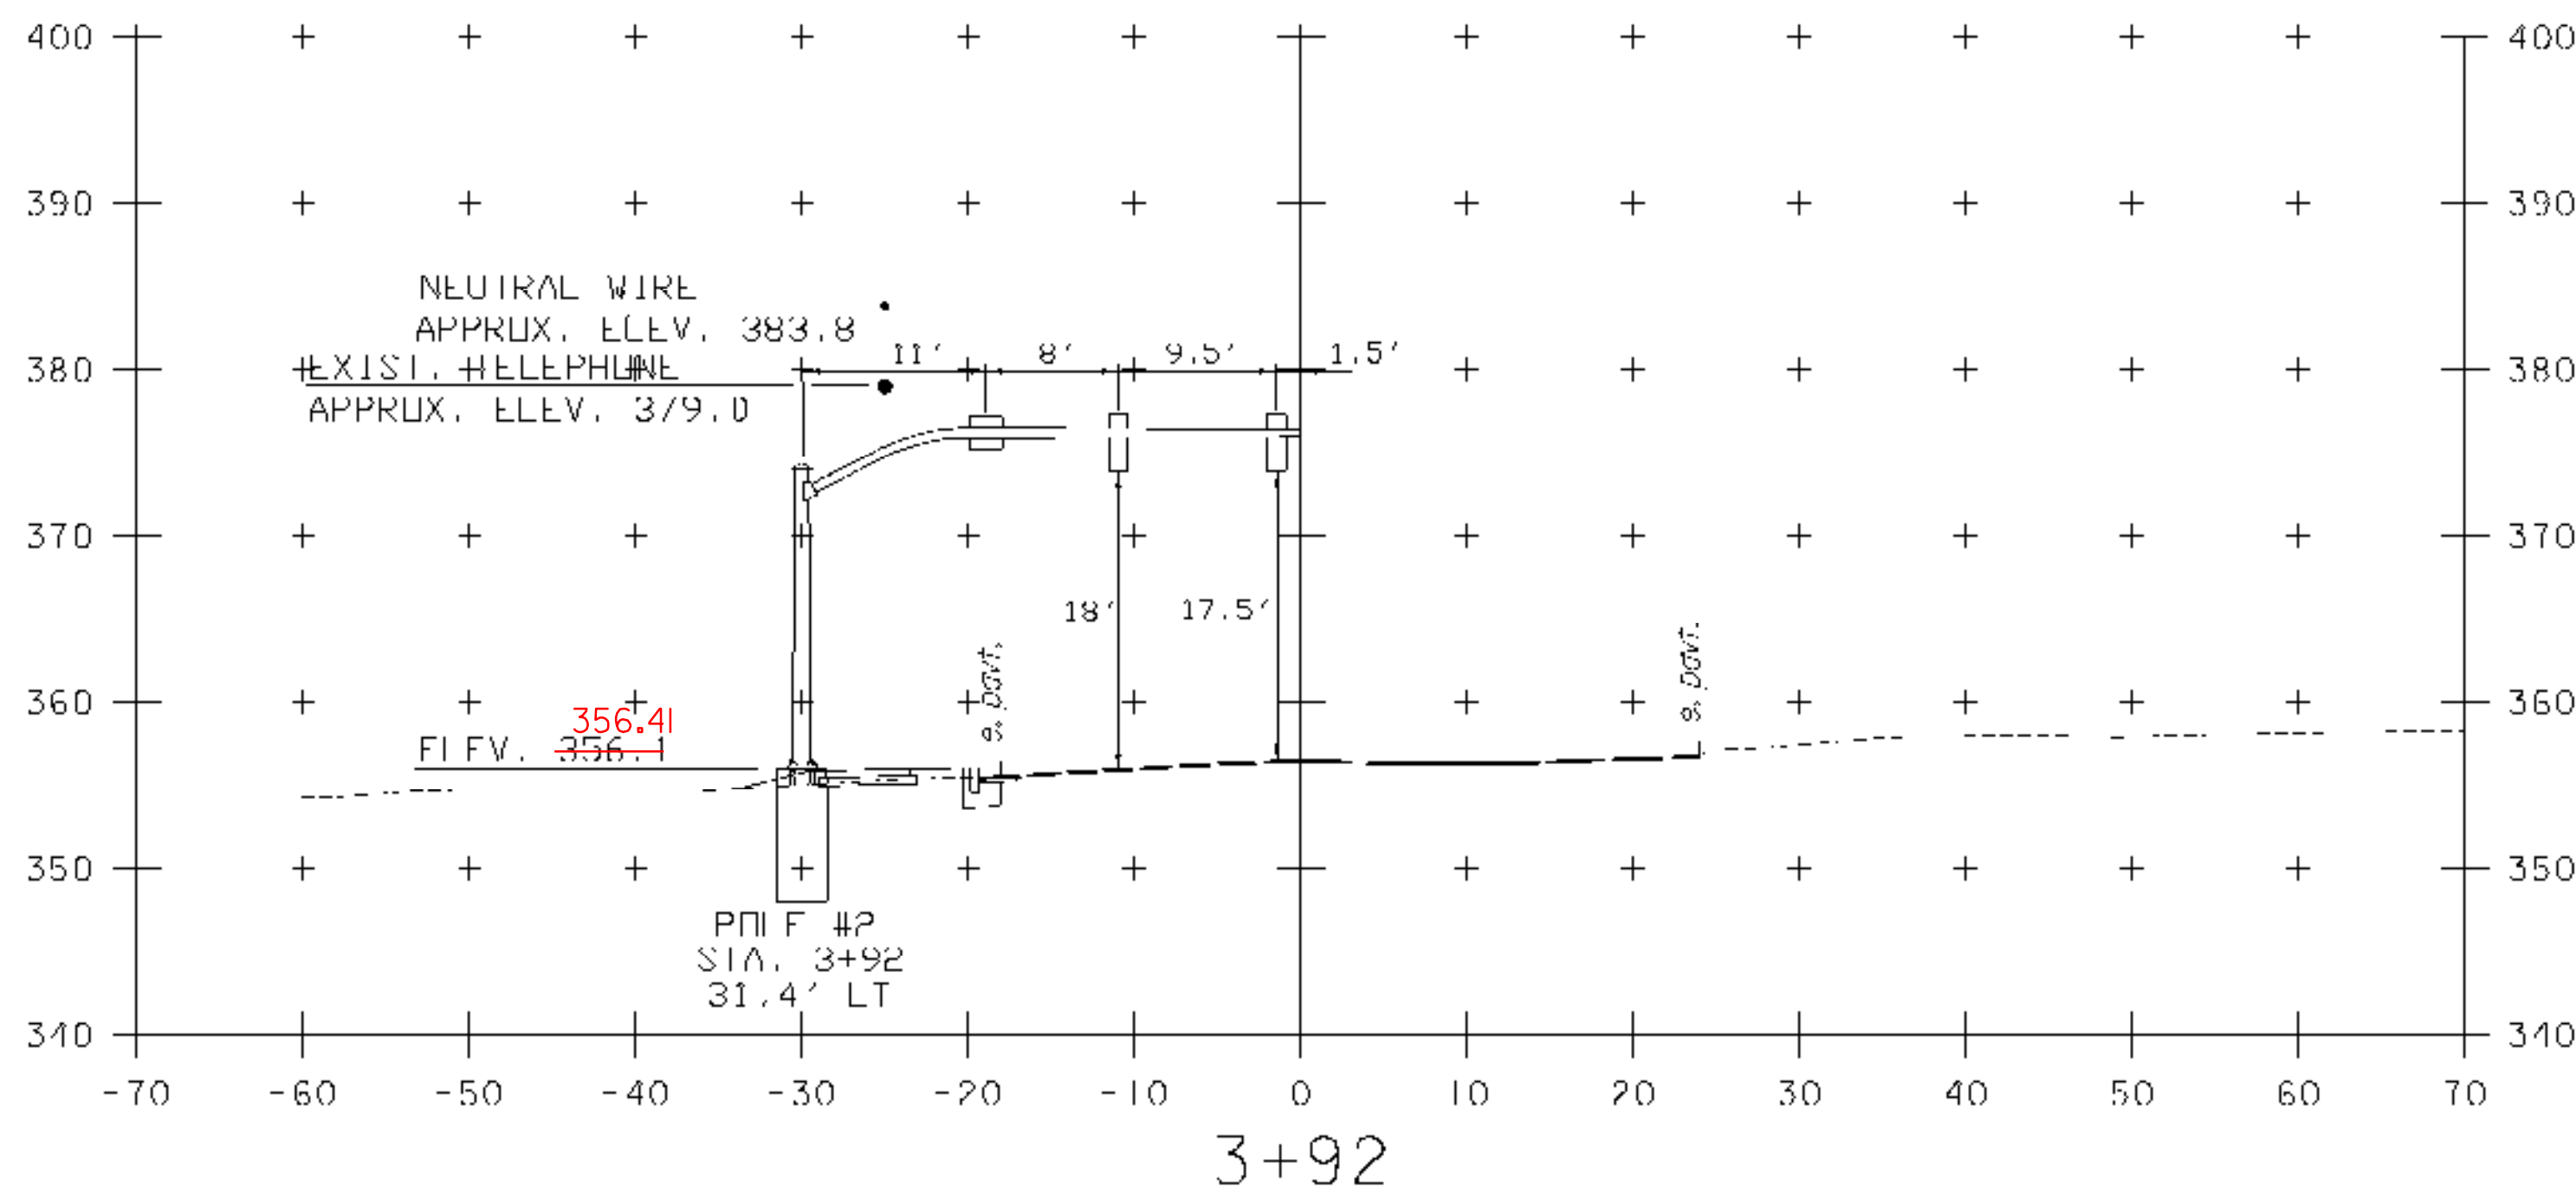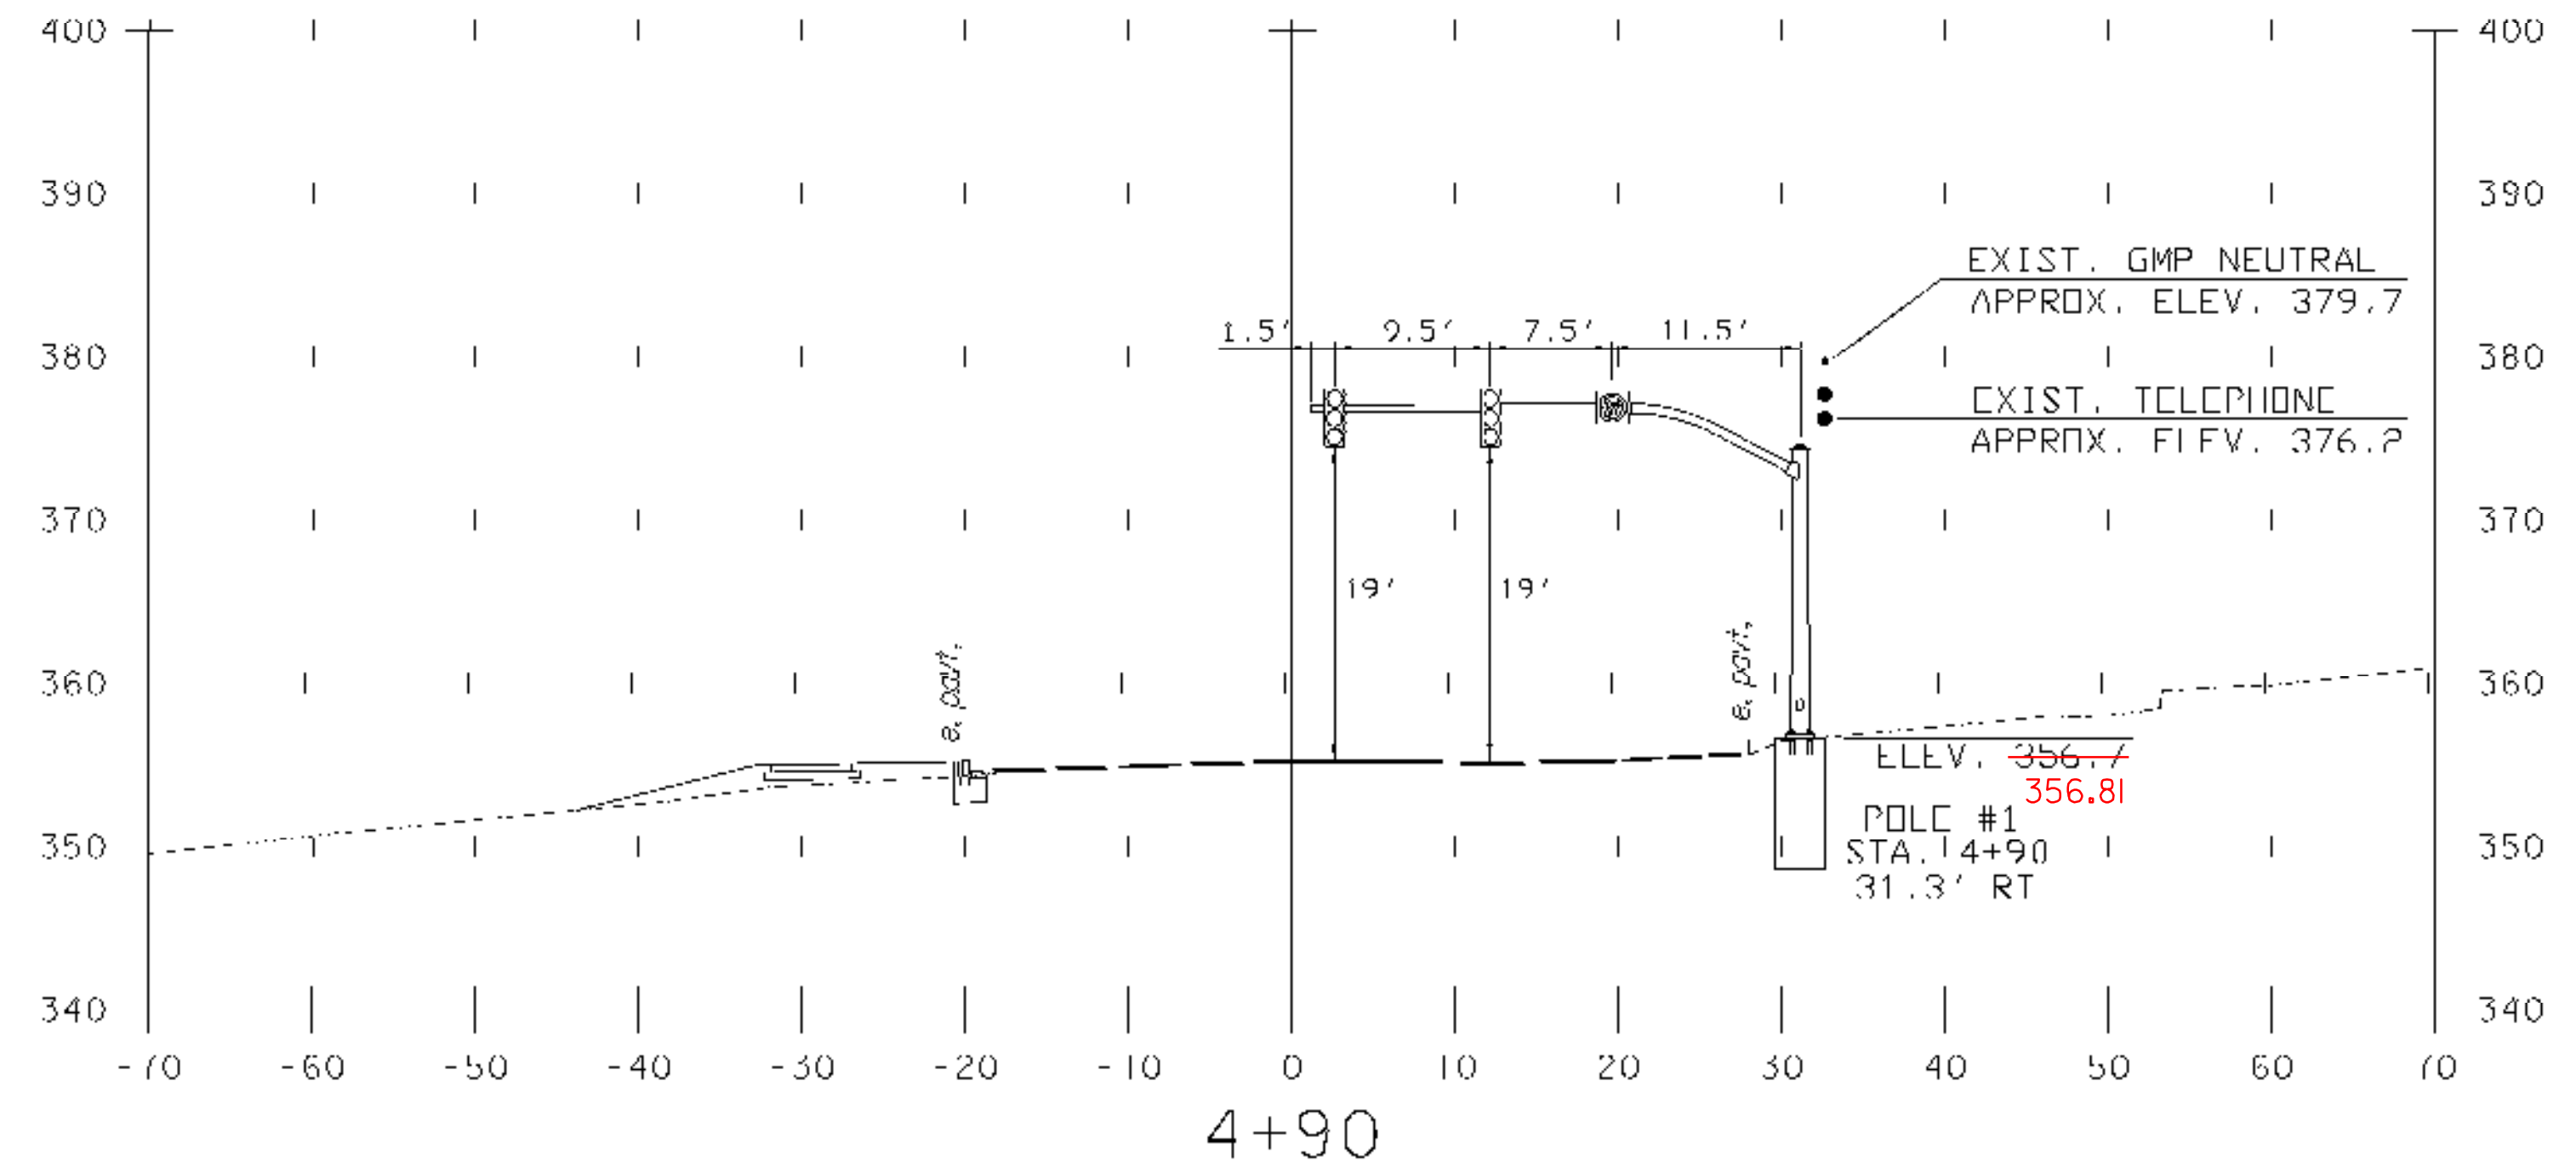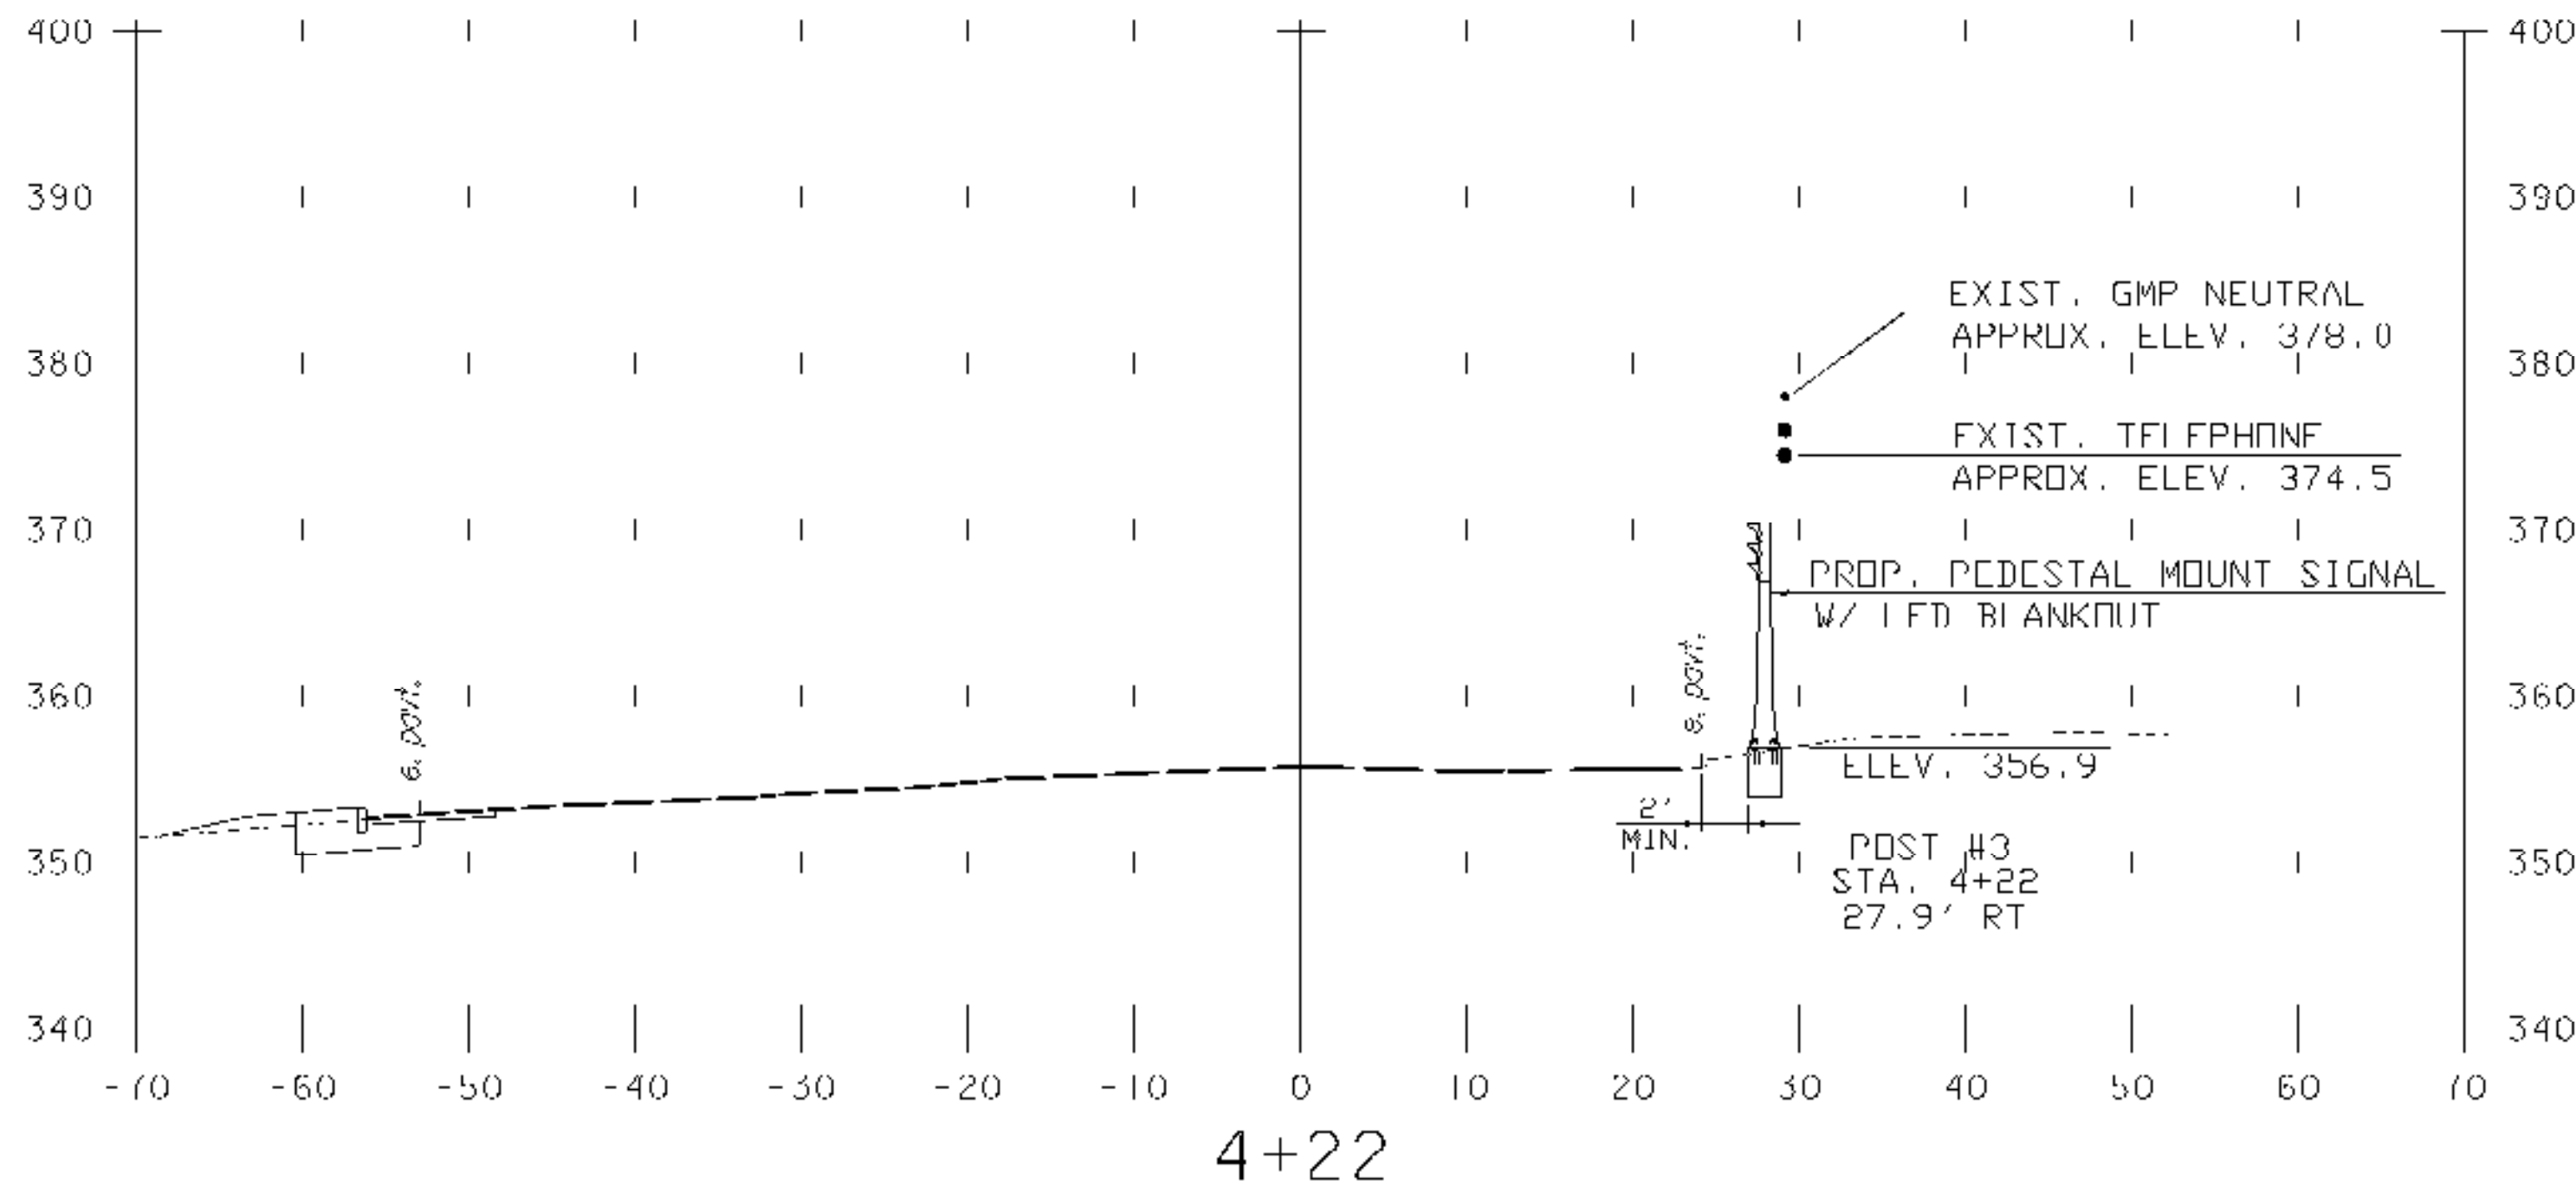

PROJECT NAME: HINFSBURG
PROJECT NUMBER: HES 021-1(21)

FILE NAME: z01b208ts xs.dgn
PROJECT LEADER: G. BAKOS
DRAWN BY: D. PECK
CHECKED BY: C. BAKOS
PLOT DATE: 5/4/2007
SHEET 16 OF 19


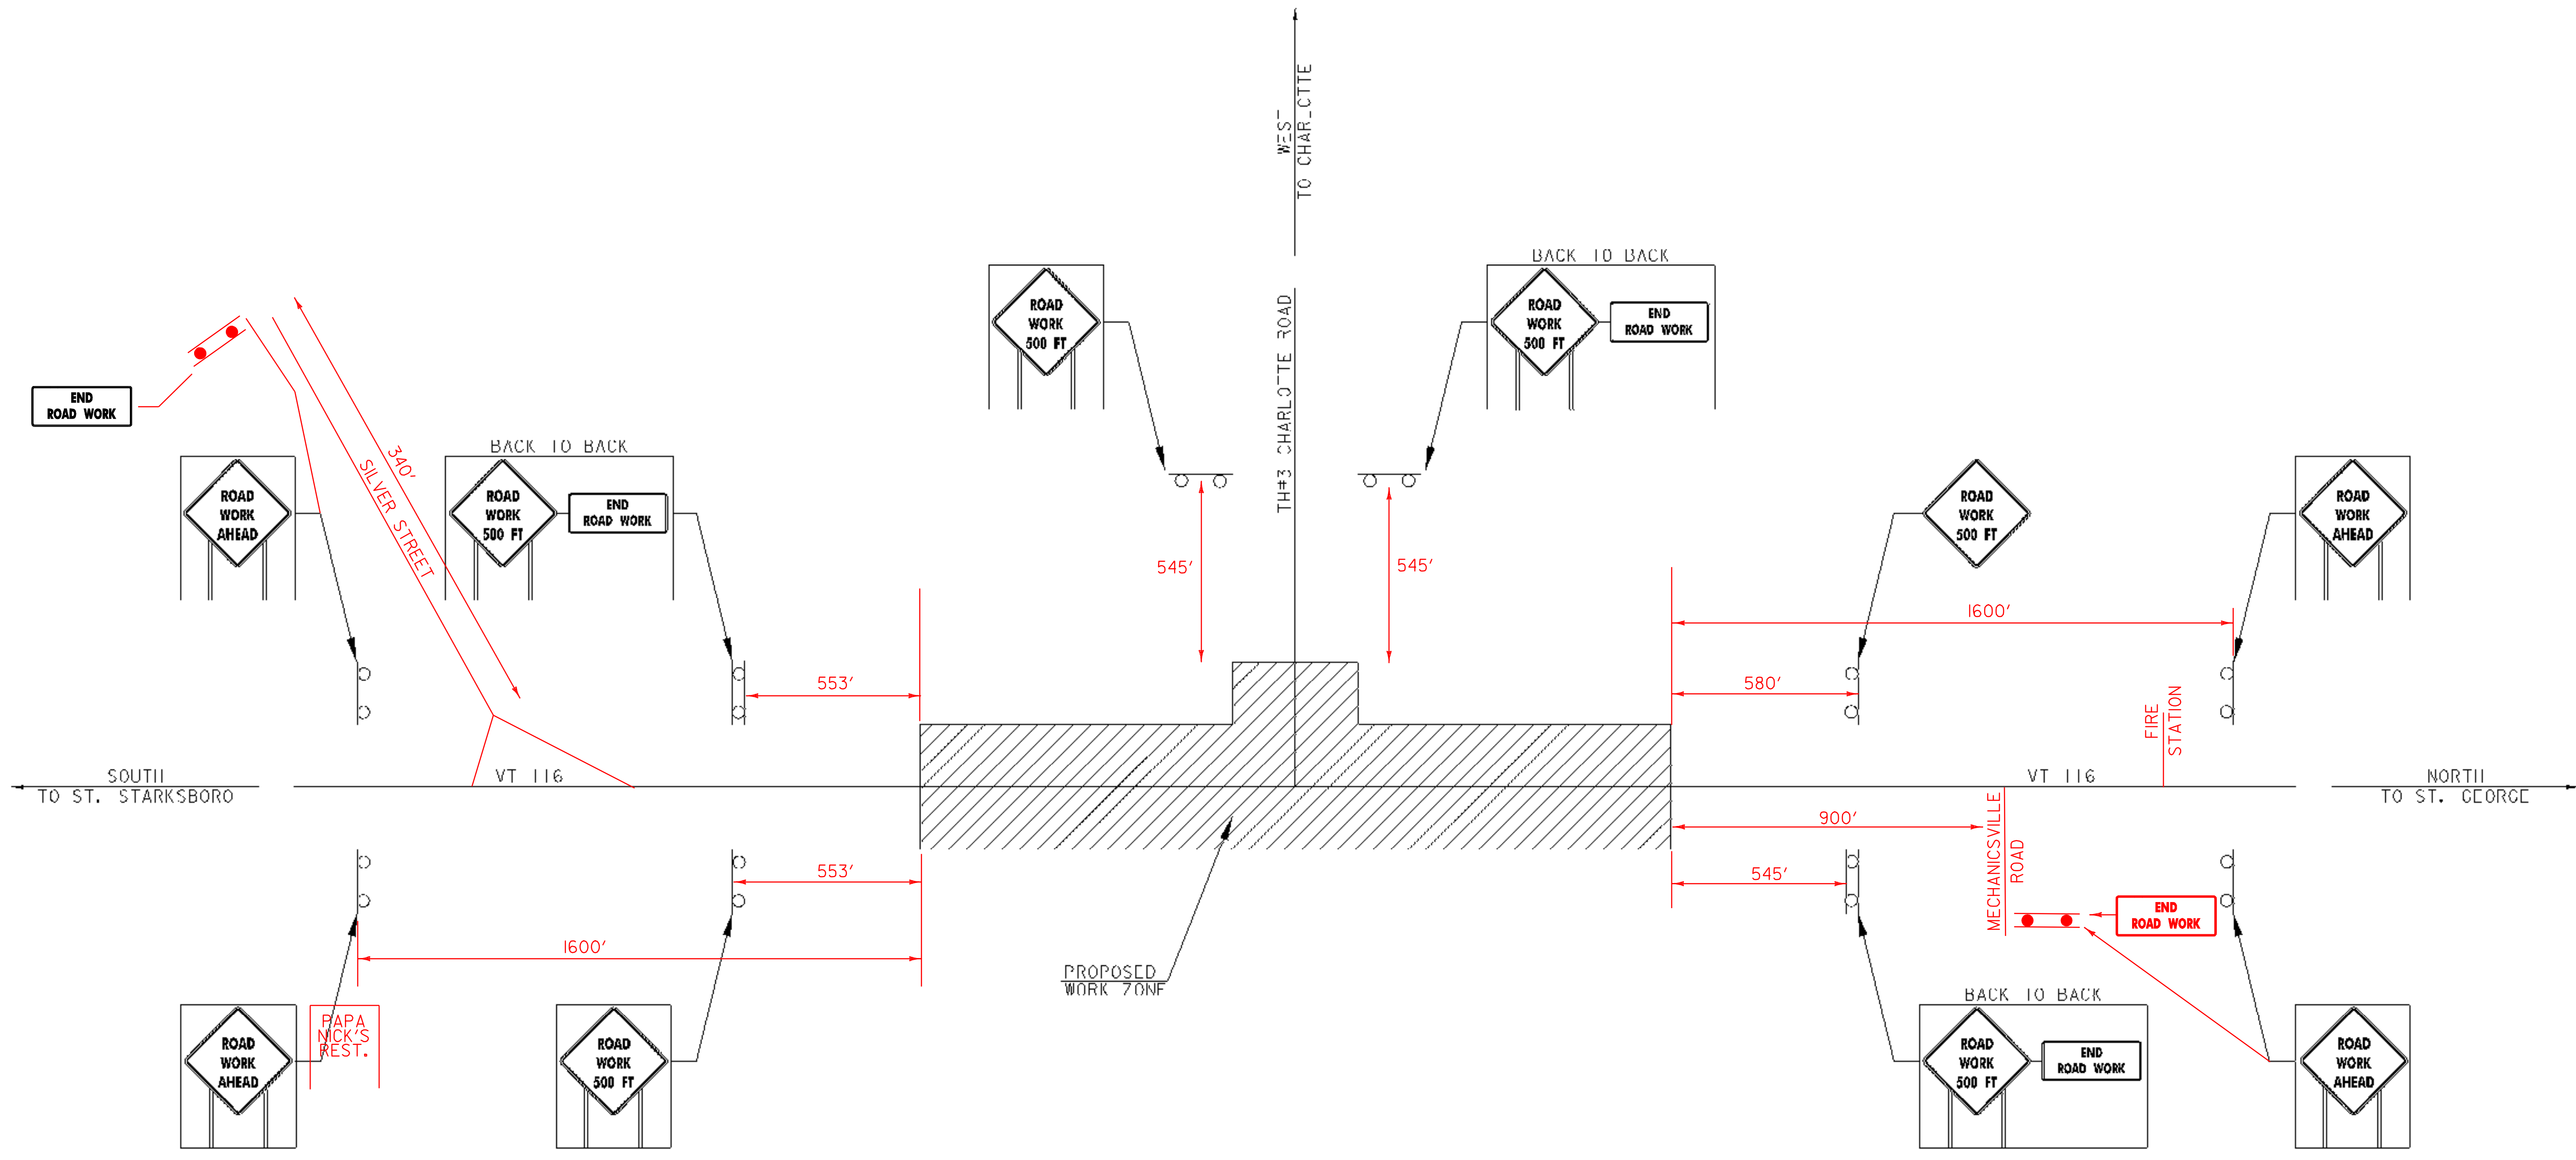


- NOTES:
1. CONSTRUCTION APPROACH SIGNING SHALL NOT INTERFERE OR BLOCK VISIBILITY OF EXISTING TRAFFIC CONTROL DEVICES.
 2. PAYMENT FOR CONSTRUCTION APPROACH SIGNING WILL BE MADE UNDER PAY ITEM 641.10
 3. SEE VTRANS STD. F-100 FOR SIGN PLACEMENT.

DATUM	
VERTICAL	NAVD 88
HORIZONTAL	NAD 83

PROJECT NAME:	HINFSBURG
PROJECT NUMBER:	HES 021-1(21)
FILE NAME:	z01b208cons.dgn
PROJECT LEADER:	G. BAKOS
DESIGNER:	D. PECK
CHECKER:	G. BAKOS
CONSTRUCTION APPROACH SIGNING	
PLOT DATE:	5/4/2007
DRAWN BY:	D. PECK
CHECKED BY:	G. BAKOS
SHEET	17 OF 19





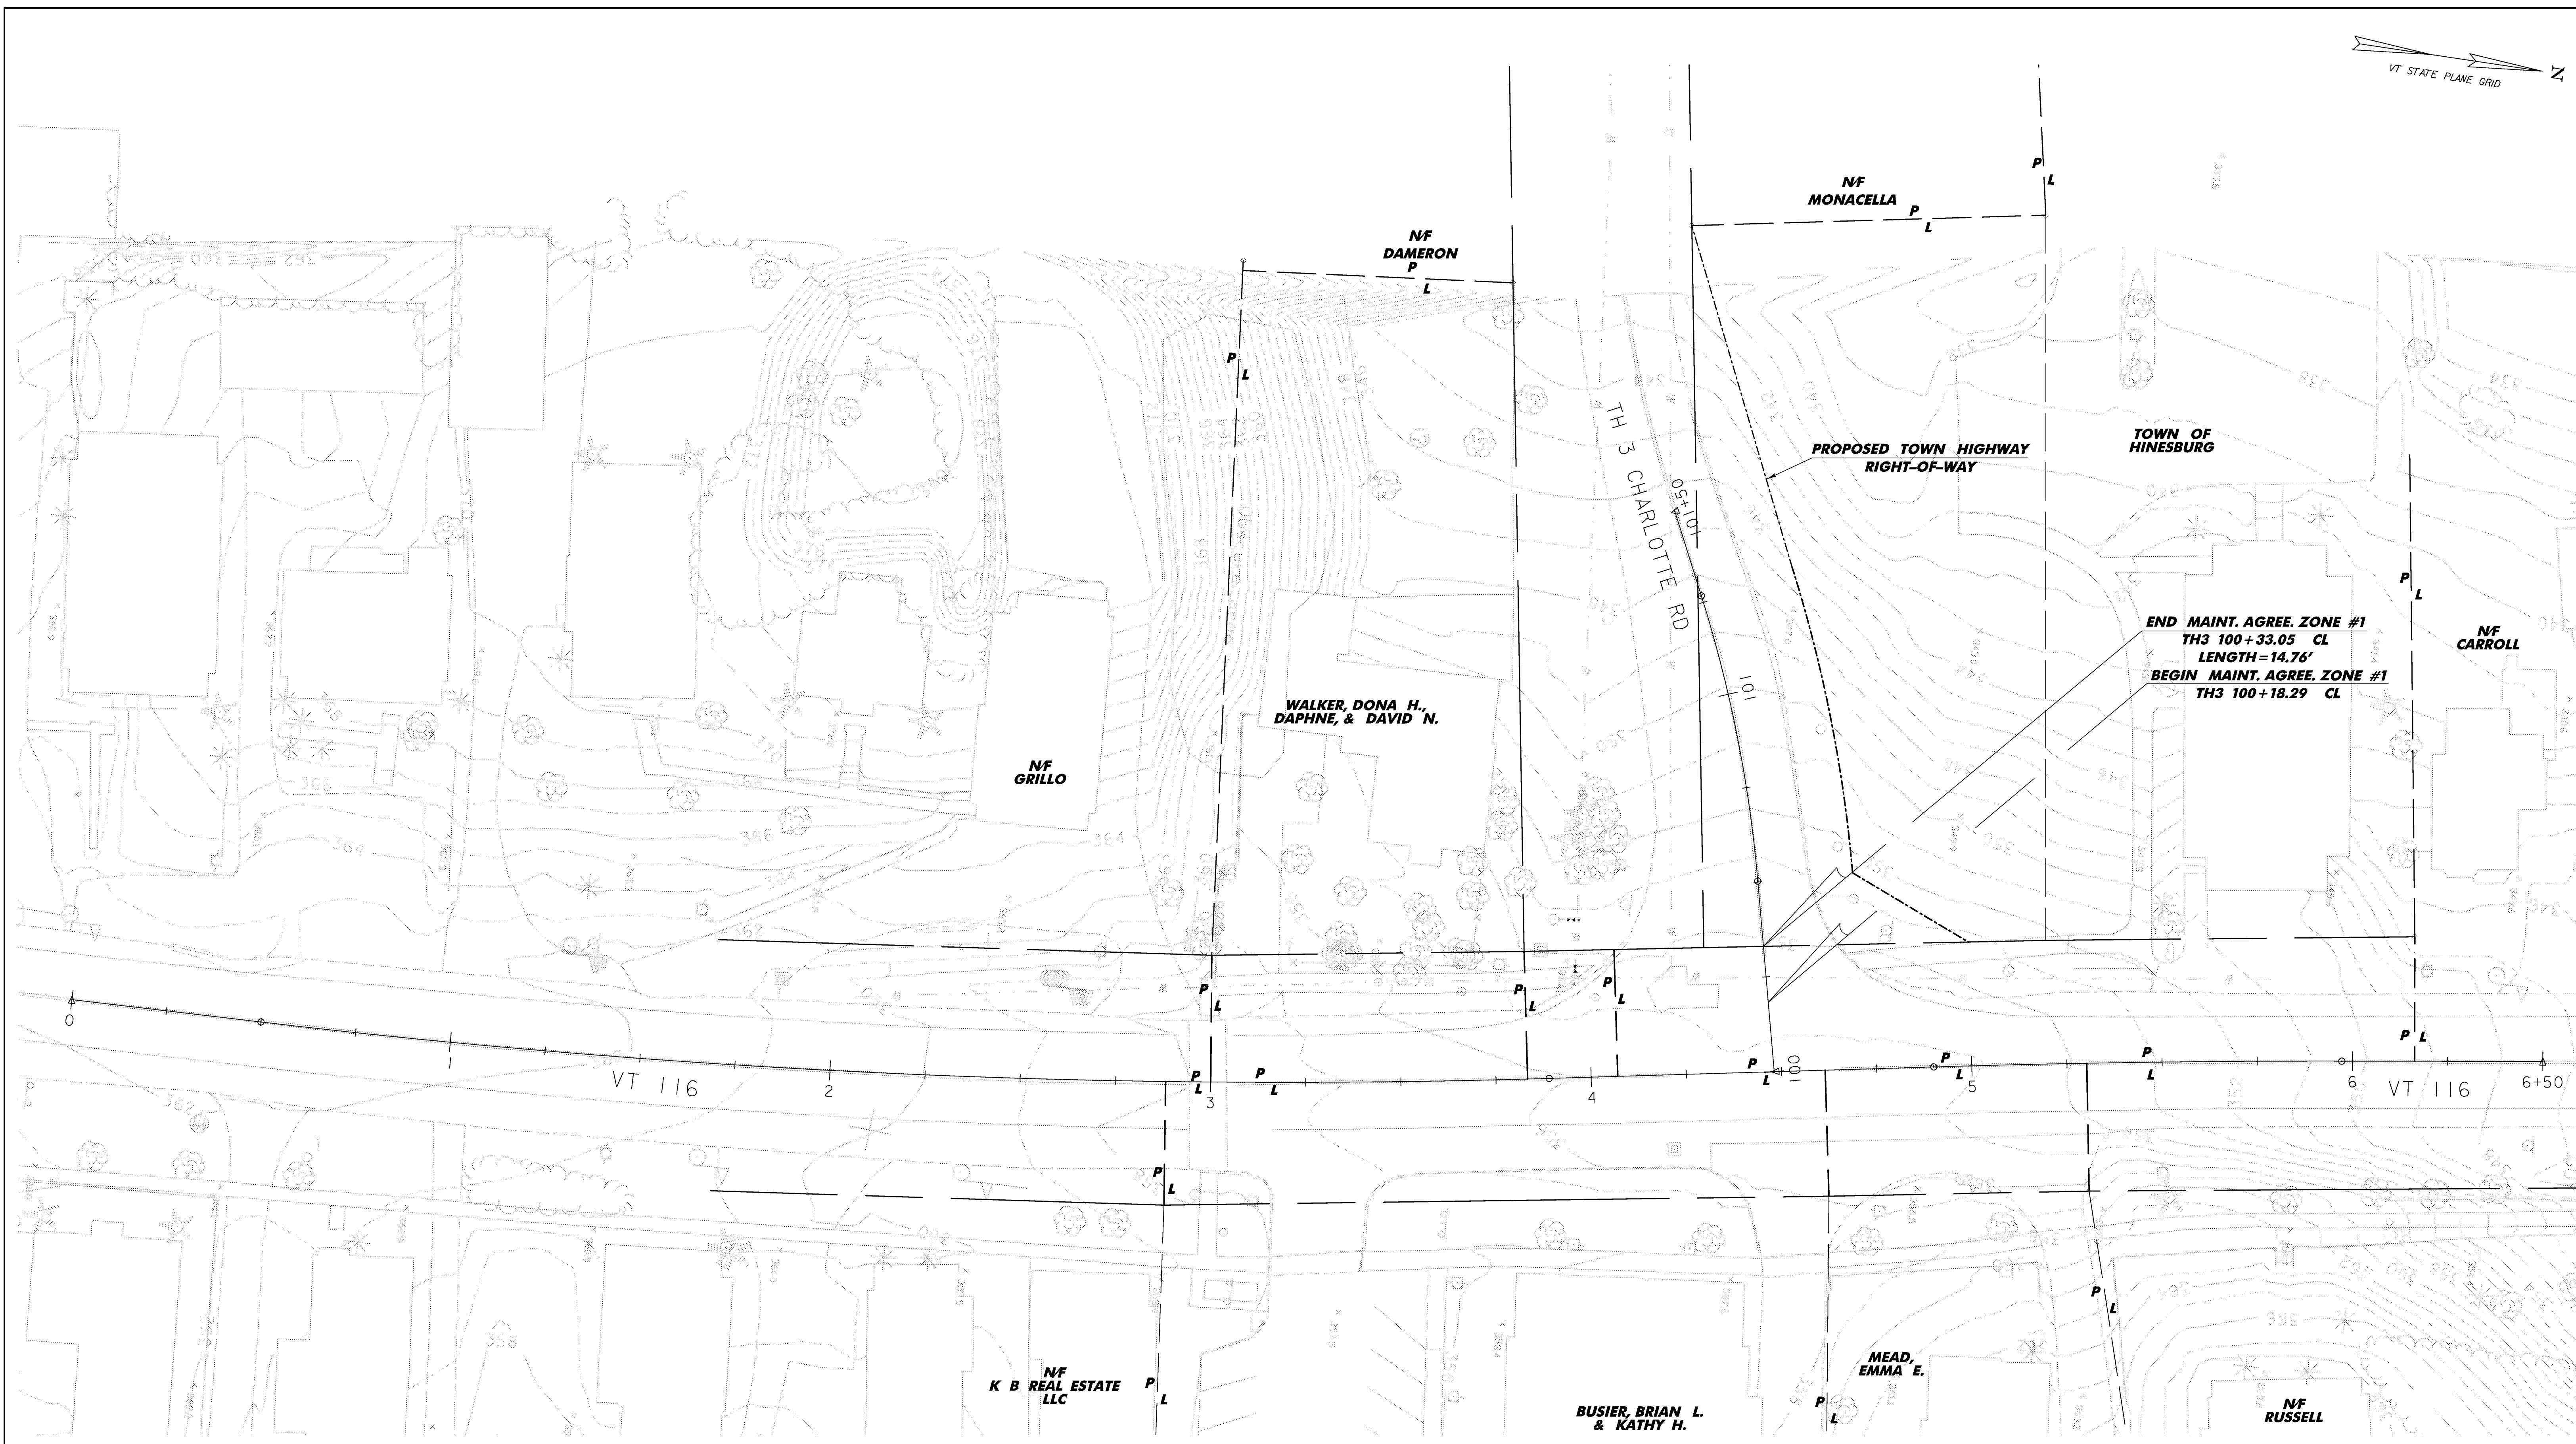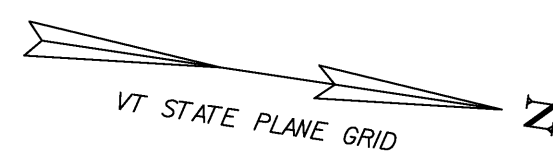

DATUM	
VERTICAL	NAVD 88
HORIZONTAL	NAD 83



PROJECT NAME:	HINESBURG	FILE NAME:	z04b208er1.dgn	PLOT DATE:	5/4/2007
PROJECT NUMBER:	HES 021-(K21)	PROJECT LEADER:	G. BAKOS	DRAWN BY:	D. PECK
		DESIGNED BY:	D. PECK	CHECKED BY:	G. BAKOS
		EXISTING CONDITIONS PLAN		SHEET	18 OF 19

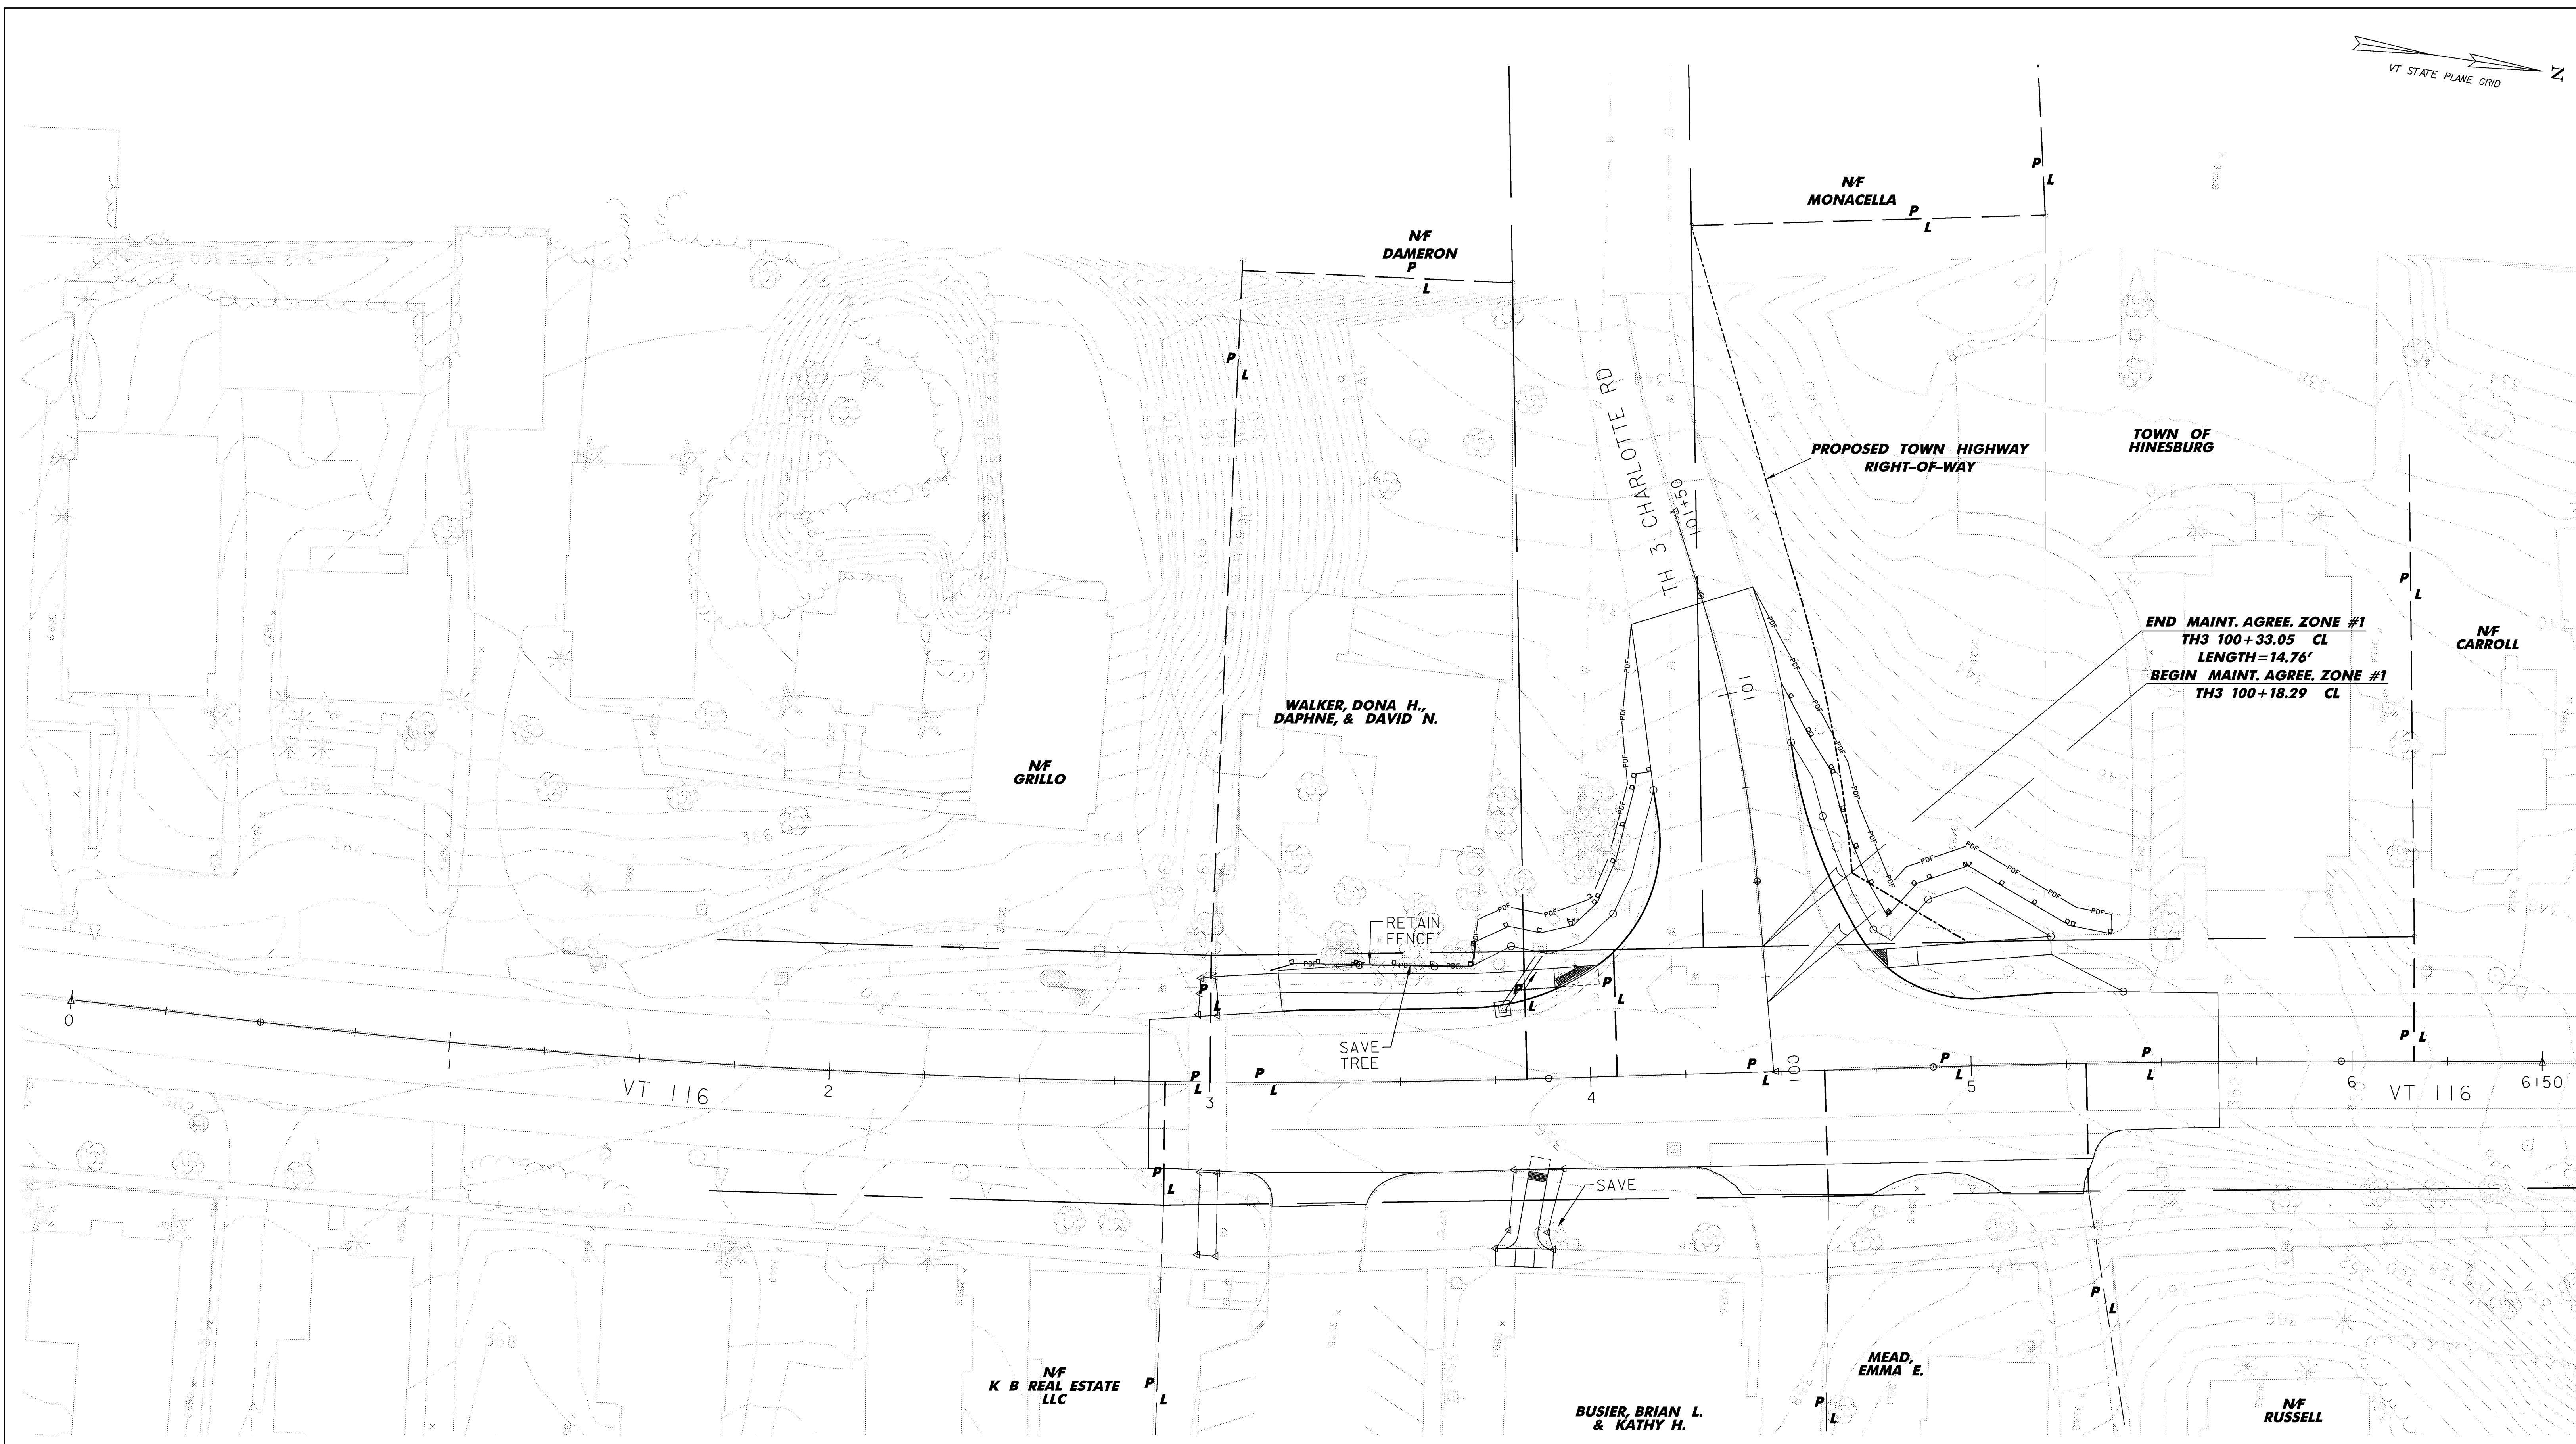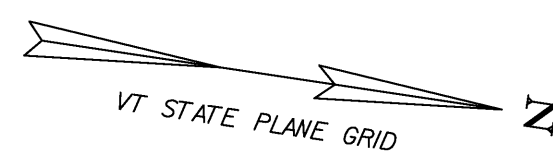



END MAINT. AGREE. ZONE #1
TH3 100+33.05 CL
LENGTH=14.76'
BEGIN MAINT. AGREE. ZONE #1
TH3 100+18.29 CL

LEGEND	
	TOE OF FILL SLOPE
	TOP OF CUT SLOPE
	SILT FENCE
	PROJECT DEMARCATION FENCE DEFINING LIMITS OF DISTURBANCE

DATUM	
VERTICAL	NAVD 88
HORIZONTAL	NAD 83



PROJECT NAME:	HINESBURG	FILE NAME:	z04b208er2.dgn	PLOT DATE:	5/4/2007
PROJECT NUMBER:	HES 021-(K21)	PROJECT LEADER:	G. BAKOS	DRAWN BY:	D. PECK
		DESIGNED BY:	D. PECK	CHECKED BY:	G. BAKOS
		EPSC PLAN		SHEET	19 OF 19

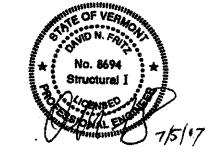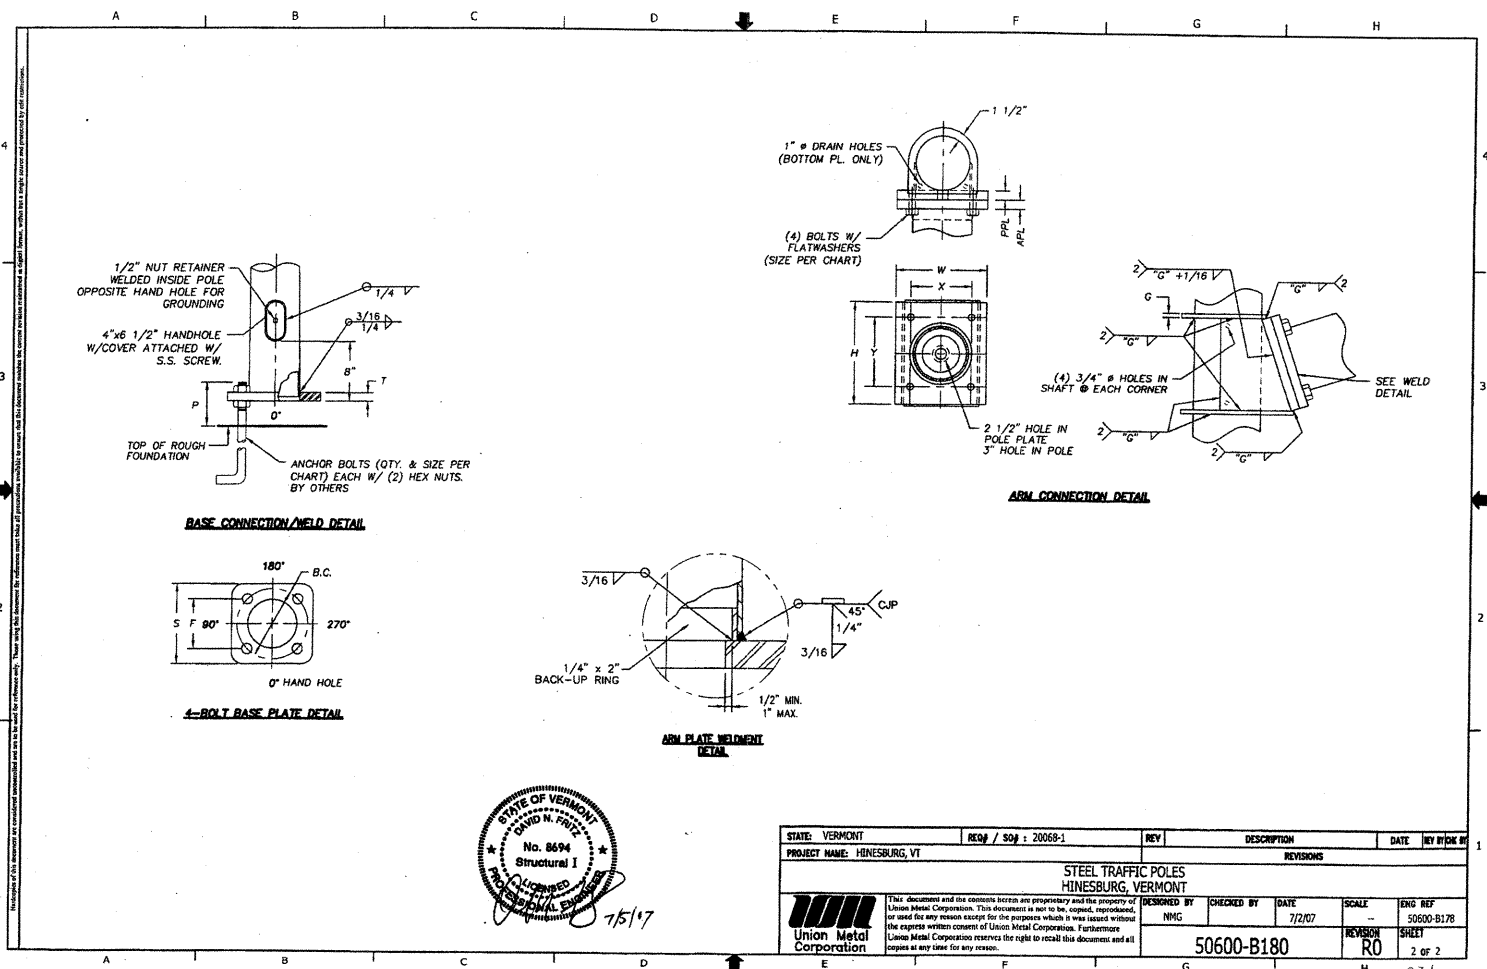

DATE: 05/05/17	REV: 1	BY: J. R. ...	CHK: J. R. ...	APP: J. R. ...	DATE: 05/05/17
STEEL TRUSS POLES OVERHEAD SYSTEM 50500-B180					
PROJECT: 50500-B180			SHEET: 80		