

INDEX OF SHEETS


1.	TITLE SHEET
2.	TYPICAL SECTION SHEET
3.	QUANTITY SHEET
4.	BLANK
5.	TIE SHEET
6.-7.	CONSTRUCTION LAYOUT SHEETS
8.	PAVEMENT MARKING AND SIGN SHEET
9.	CONSTRUCTION SIGNING PLAN
10.	SIGN SUMMARY SHEET
11.	BLANK
12.-14.	EROSION CONTROL SHEETS
15.-16.	TRAFFIC CONTROL SHEETS

E-100	01/02/04
E-100A	01/02/04
E-101	05/30/03
E-102	06/30/03
E-102A	05/01/04
E-106	03/01/04
E-107	06/30/03
E-108	08/18/95
E-145A	12/23/94
E-191	02/01/99
E-192	10/12/00
E-193	08/18/95

STATE OF VERMONT AGENCY OF TRANSPORTATION




PROPOSED IMPROVEMENT TOWN OF SWANTON COUNTY OF FRANKLIN VT. ROUTE 78 (MAJOR COLLECTOR)

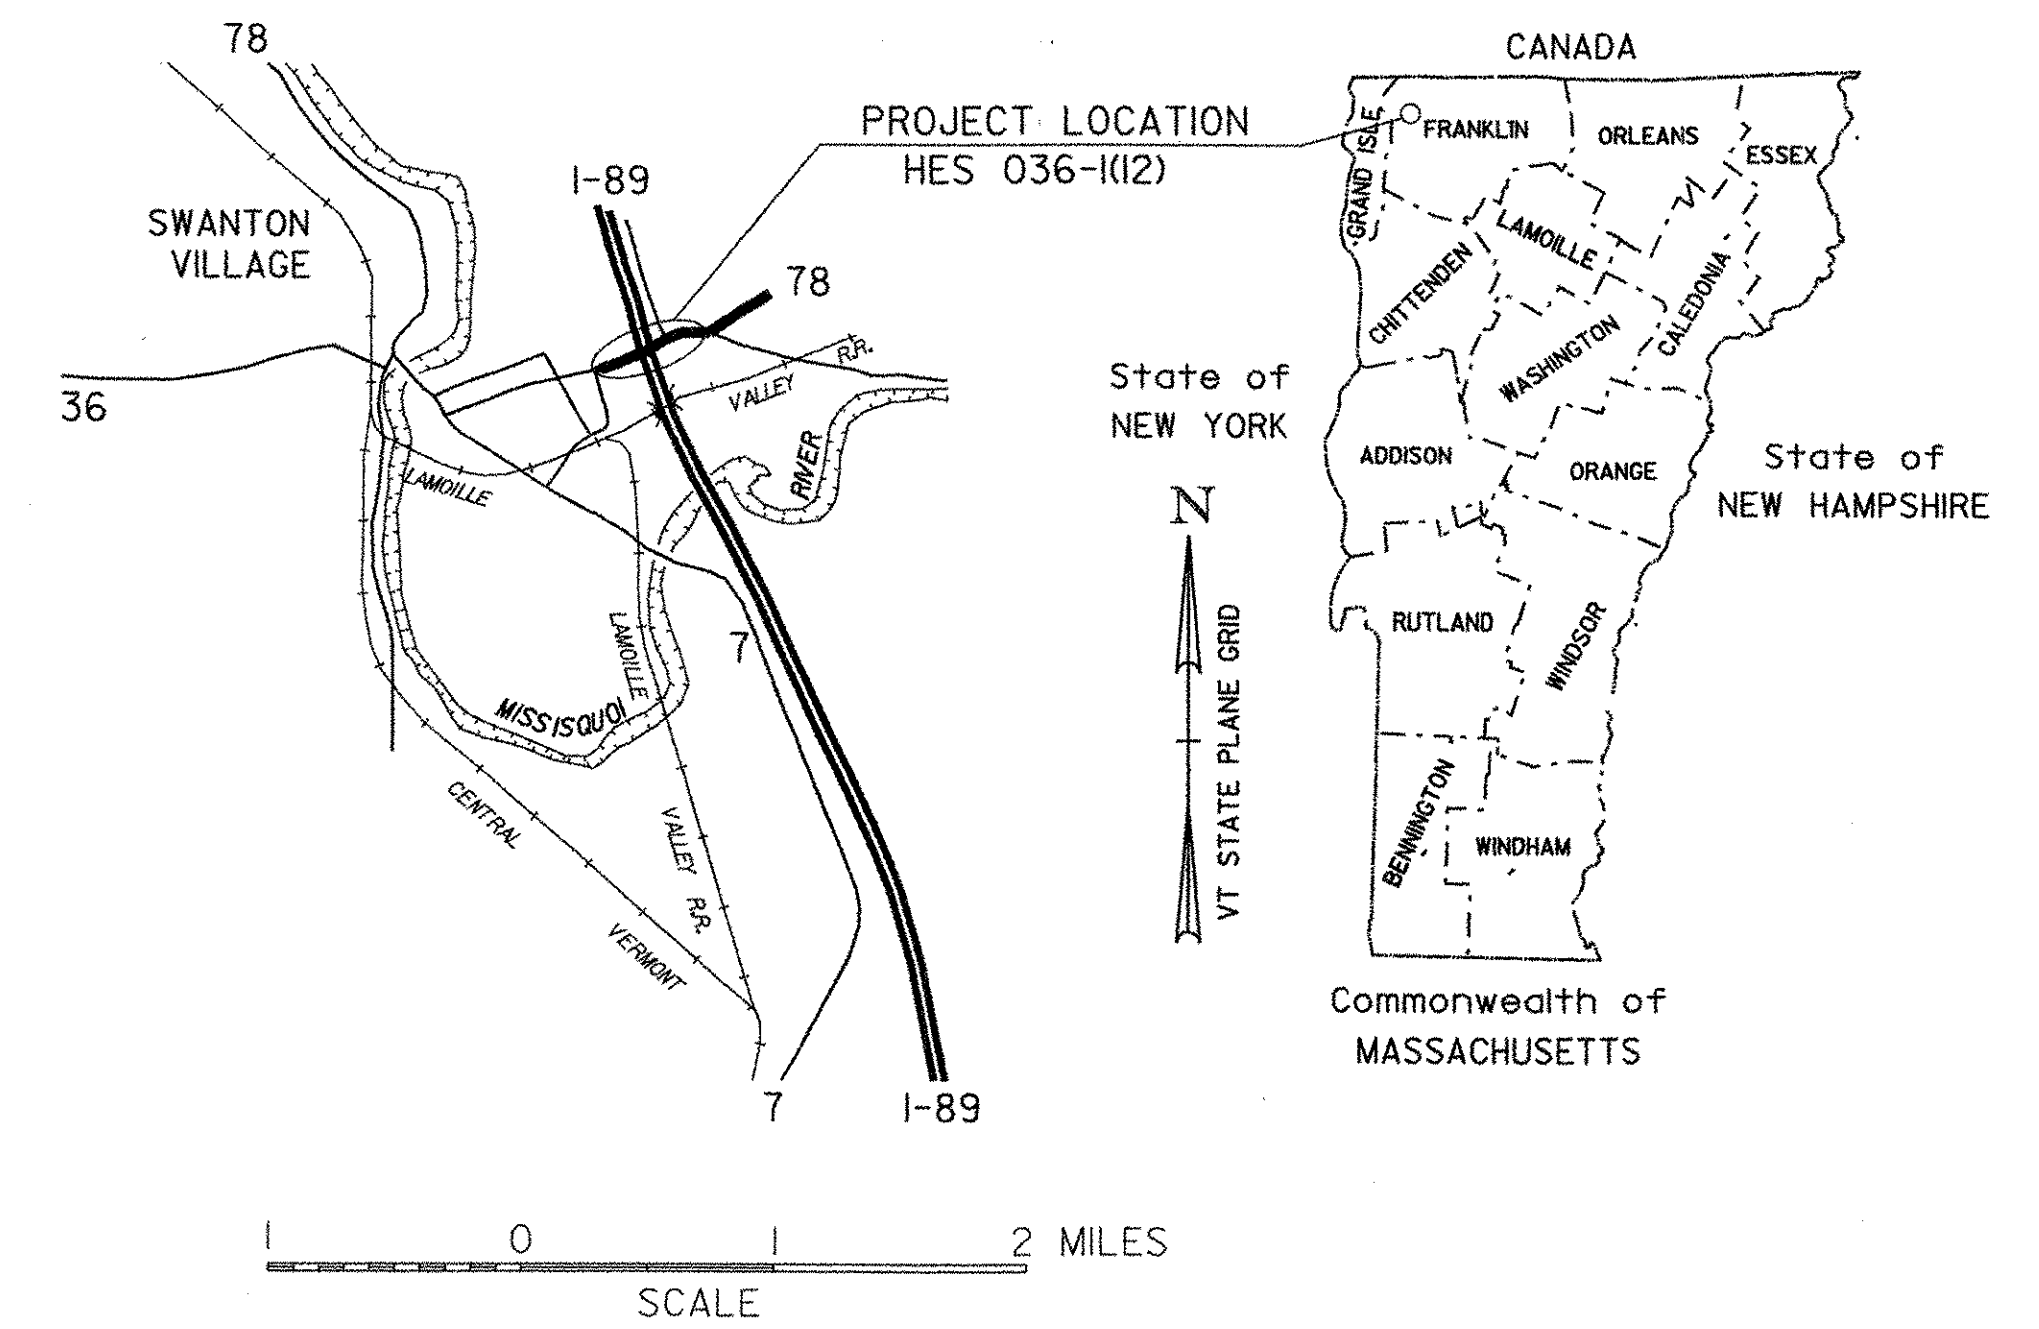

BEGINNING AT A POINT ON VT. ROUTE 78, WEST OF I-89 AT
MILEMARKER 7.54 IN THE TOWN OF SWANTON, AND EXTENDING EASTERLY 0.17 MILES TO MILEMARKER 7.71
WORK TO BE PERFORMED UNDER THIS PROJECT INCLUDES SHOULDER RECONSTRUCTION AND RESURFACING
IN ORDER TO ADD LEFT TURN LANES AND TO INCLUDE SIGNS AND PAVEMENT MARKINGS.

LENGTH OF PROJECT (0.180 MILES) 950 FEET

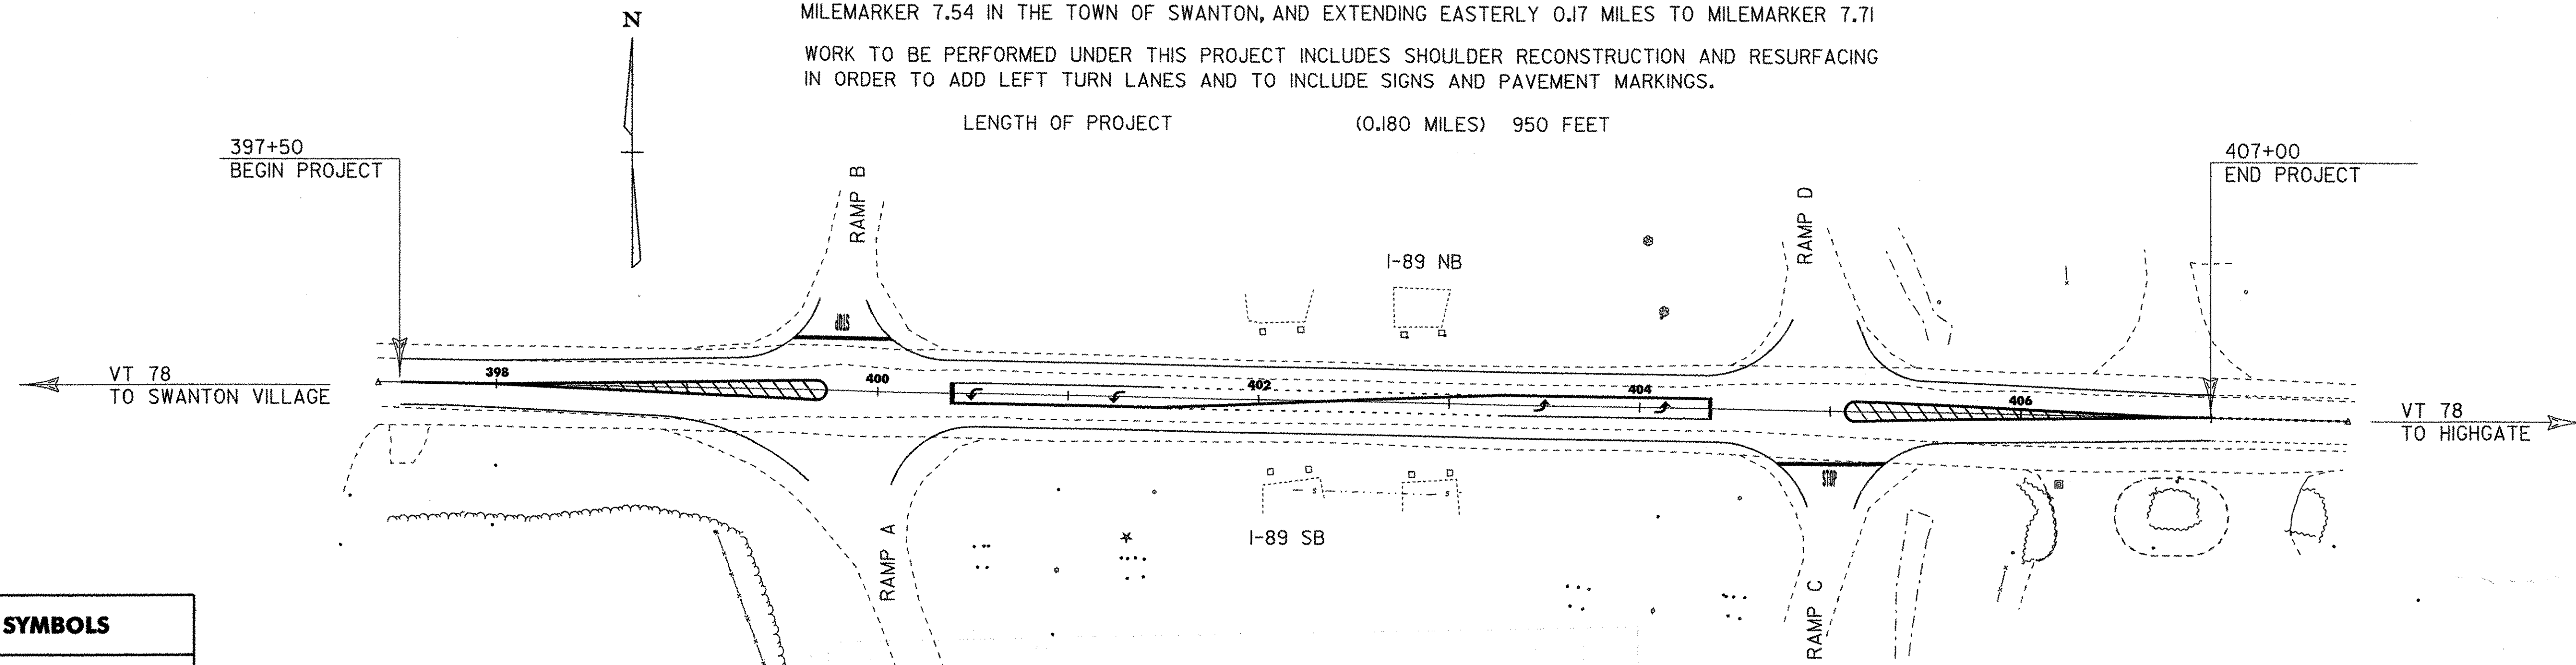

CONVENTIONAL SYMBOLS

COUNTY LINE	
TOWN LINE	
LIMITS OF ACCESS	
POINT OF ACCESS	
FENCE LINE	
STONE WALL	
TRAVELED WAY	
GUARD RAIL	
RAILROAD	
SURVEY LINE	
CULVERT	
POWER POLE	
TELEPHONE POLE	
TREES	
CONTROL OF ACCESS	
PROPERTY LINE	
R.O.W. TAKING LINE	
SLOPE RIGHTS	
TOP OF CUT	
TOE OF SLOPE	

SURVEYED BY : L. ORVIS
SURVEYED DATE : 21-SEPT-2005

DATUM
VERTICAL NAVD88
HORIZONTAL ASSUMED

RECORD PLANS

CONTRACTOR: A.C. PAVING - SO. BURLINGTON, VT
RESIDENT ENGINEER: JEREMY REED
CONSTRUCTION BEGAN: APRIL 19, 2007
CONSTRUCTION COMPLETE: JUNE 7, 2007
RECORD PLANS BY: JEREMY REED
I HEREBY CERTIFY THAT ALL THE CONSTRUCTION REQUIRED BY THIS SET OF DRAWINGS HAS BEEN ACCOMPLISHED AS INDICATED HEREIN.
BY *Jeremy Reed* RESIDENT ENGINEER
DATE February 25, 2008

NOTE: Any further information concerning final quantities, amounts or other details relative to this project may be found at Central Files in the electronic archives.



THESE PLANS ARE SUBJECT TO SUCH ENGINEERING CHANGES AS MAY BE REQUIRED BY THE FEDERAL HIGHWAY ADMINISTRATION OR THE DIRECTOR OF PROGRAM DEVELOPMENT.
CONSTRUCTION IS TO BE CARRIED ON IN ACCORDANCE WITH THESE PLANS AND THE STANDARD SPECIFICATIONS FOR CONSTRUCTION DATED 2001, AS APPROVED BY THE FEDERAL HIGHWAY ADMINISTRATION ON JANUARY 4, 2001 FOR USE ON THIS PROJECT, INCLUDING ALL SUBSEQUENT REVISIONS AND SUCH REVISED SPECIFICATIONS AND SPECIAL PROVISIONS AS ARE INCORPORATED IN THESE PLANS.
10-AUG-2006 +04b212nui.dgn +b21211t.j

DIRECTOR OF PROGRAM DEVELOPMENT	
APPROVED <i>Richard J. Stewart</i>	DATE 8-22-06
PROJECT MANAGER : B. NYQUIST	
PROJECT NAME :	SWANTON
PROJECT NUMBER :	HES 036-1(12)
SHEET 1 OF 16 SHEETS	