


SILT FENCE 

405+18 RT OFFSET 75' (RAMP C) - 406+16 RT OFFSET 56' (DRIVE)
 405+07 LT OFFSET 80' (RAMP D) - 406+61 LT OFFSET 79' (FRONTAGE RD.)

EROSION CONTROL SHEET

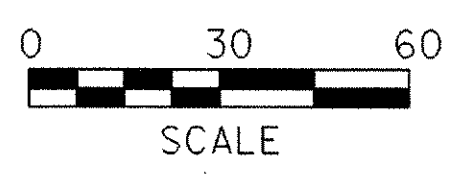

PROJECT NAME: SWANTON	PLOT DATE: 14-SEP-2006
PROJECT NUMBER: HES 036-1(12)	DRAWN BY: jfg
FILE NAME: tb212ero.dgn	CHECKED BY: traffic
PROJECT LEADER: nyquist	SHEET 13 OF 16
DESIGNED BY: traffic	
td212ecl.i	