

646.40 DURABLE 4" WHITE LINE (THERMOPLASTIC)
 (ALL LINES WILL INCLUDE EDGE LINE BREAKS AND RADIUS FOR TOWN HIGHWAYS)

CASTLETON:
 STA. 273+60.96 - STA. 289+00.00 EDGE LINE LT & RT

646.41 DURABLE 4" YELLOW LINE (THERMOPLASTIC)
 (ALL LINES WILL INCLUDE C/L BREAKS FOR TOWN HIGHWAYS) S=SOLID, D=DASHED

CASTLETON:
 STA. 273+60.96 - STA. 289+00.00 S - C - RT S

646.60 TEMPORARY 4" WHITE LINE (PAINT)
 (ALL LINES WILL INCLUDE EDGE LINE BREAKS AND RADIUS FOR TOWN HIGHWAYS)

CASTLETON:
 STA. 273+60.96 - STA. 289+00.00 EDGE LINE LT & RT

646.61 TEMPORARY 4" YELLOW LINE (PAINT)
 (ALL LINES WILL INCLUDE C/L BREAKS FOR TOWN HIGHWAYS) S=SOLID, D=DASHED

CASTLETON:
 STA. 273+60.96 - STA. 289+00.00 S - C - RT S


675.50 REMOVING SIGNS

AS SHOWN - 7

675.60 ERECTING SALVAGED SIGNS

AS SHOWN - 6

VT. ROUTE 30
 MM 5.182 = STA. 273+60.96
 BEGIN STP 2402(I)S

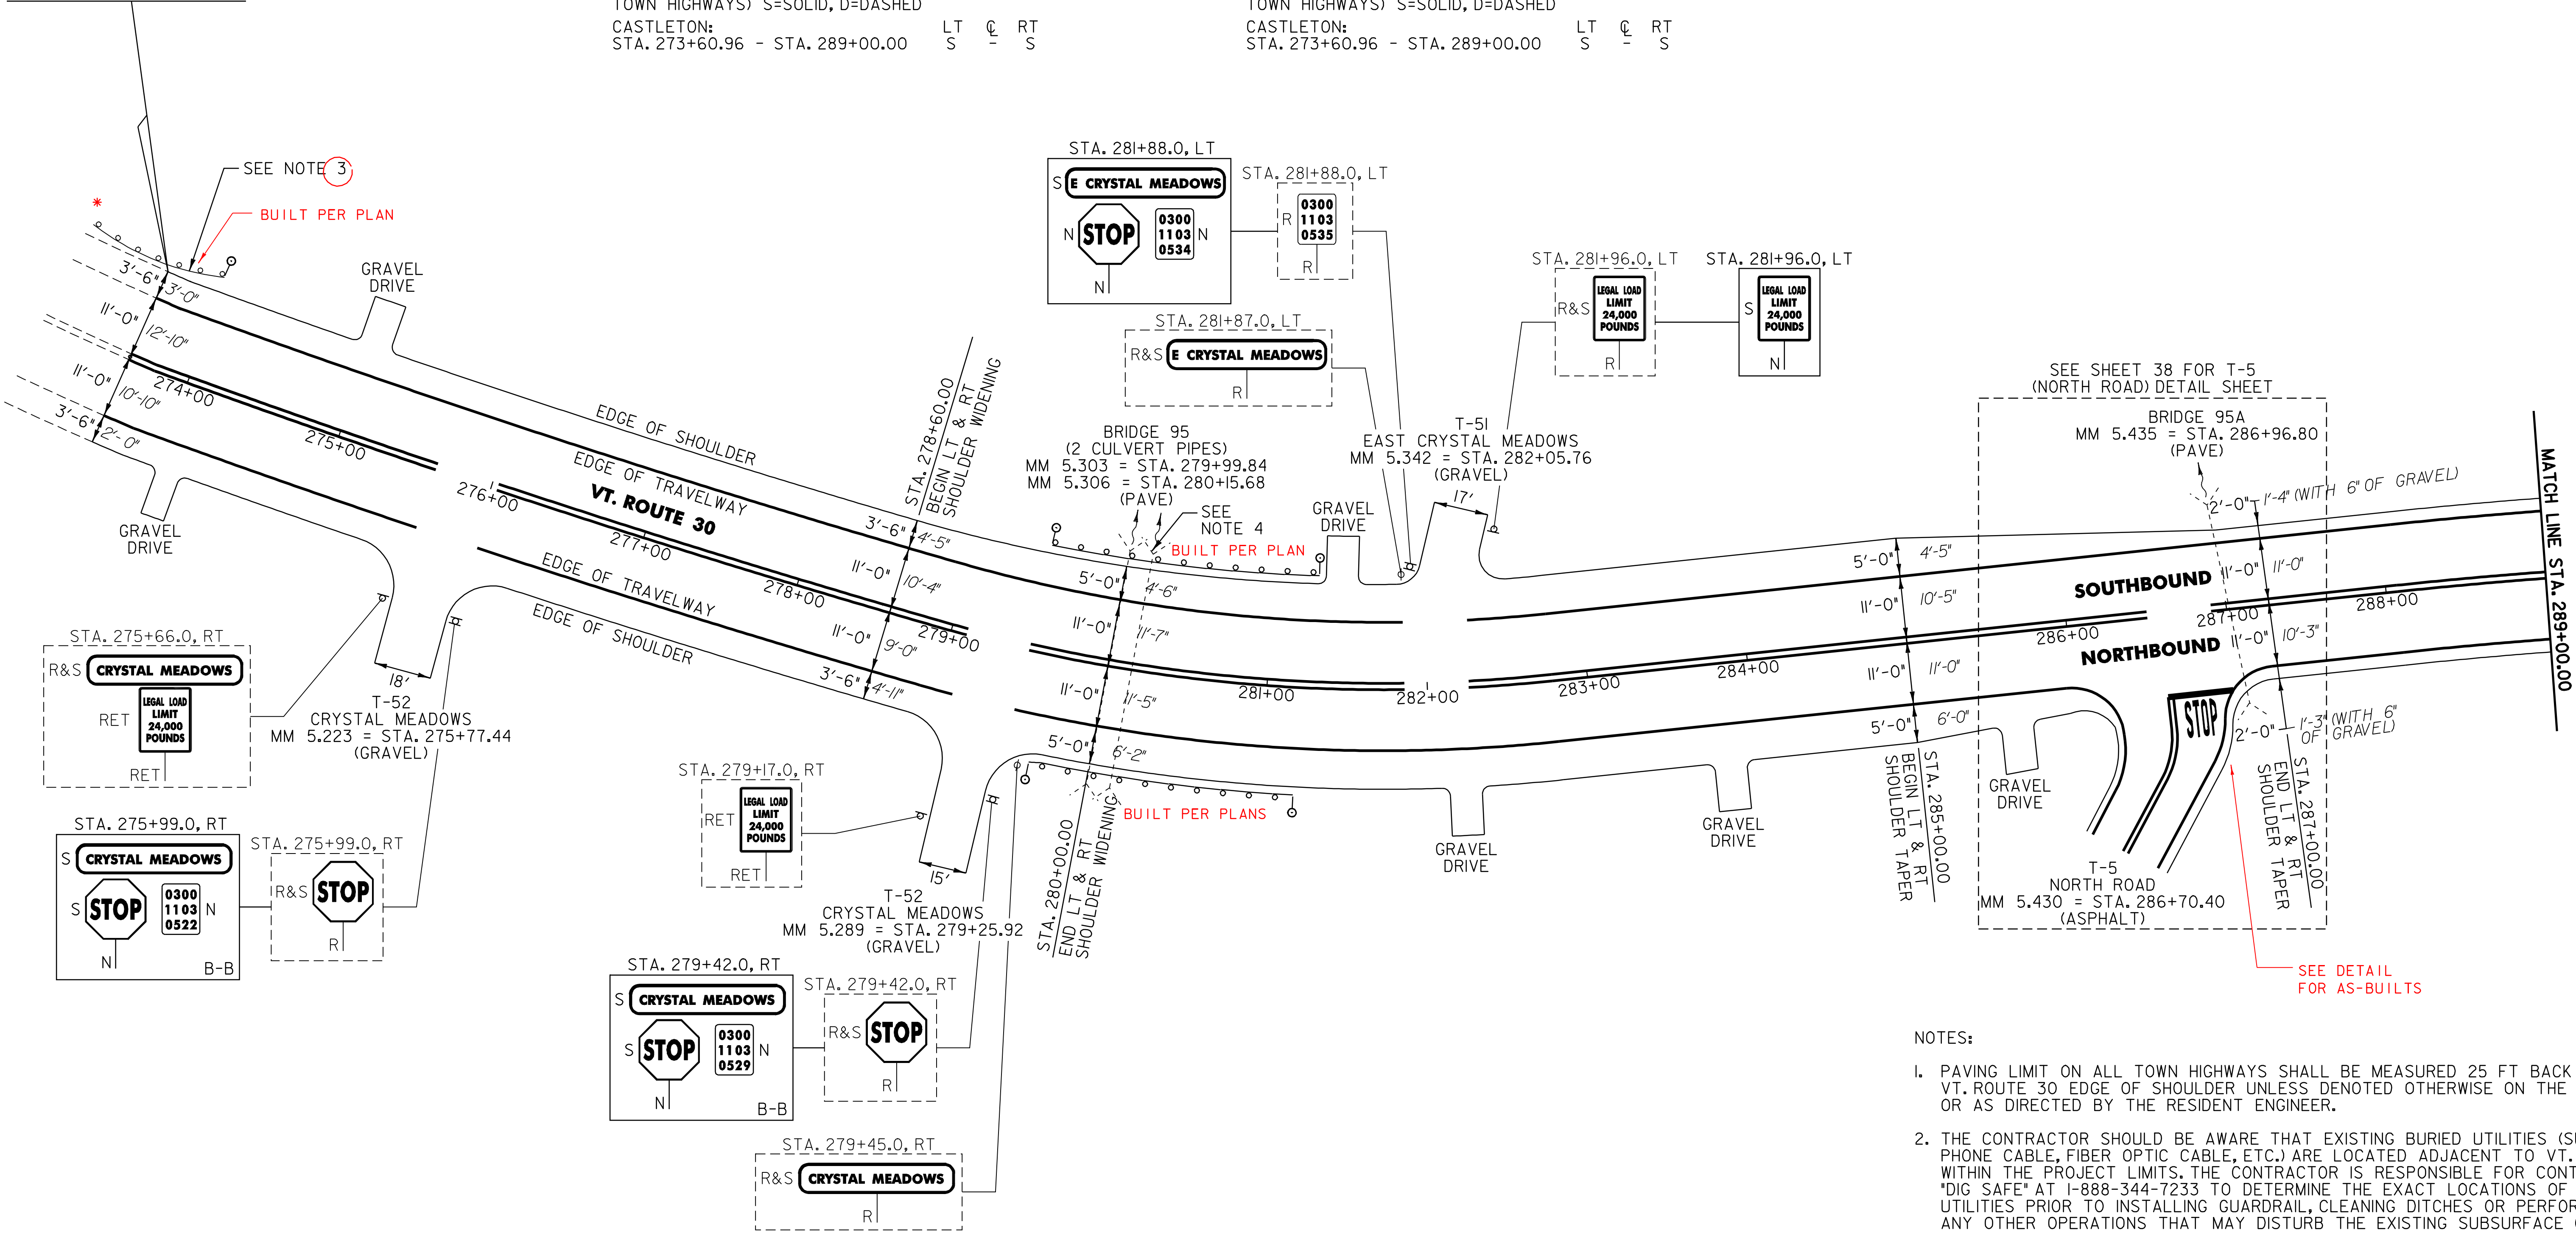

621.20 STEEL BEAM GUARDRAIL (GALVANIZED)

CASTLETON:
 STA. 279+83.0 - STA. 280+83.0 RT (100.0 LF)
 STA. 279+87.0 - STA. 280+99.5 LT (112.5 LF)
 STA. 273+24.0 - STA. 273+36.5 LT (12.5 LF)

621.80 REMOVAL & DISPOSAL OF GUARDRAIL

CASTLETON: 24.0
 * STA. 273+36.5 - STA. 273+74.0 LT (37.5 LF)
 STA. 279+46.0 - STA. 281+20.0 RT (174.0 LF)
 STA. 279+55.0 - STA. 281+33.0 LT (178.0 LF)

621.505 MANUFACTURED TERMINAL SECTION (FLARED)

CASTLETON:
 STA. 273+36.5 - STA. 273+74.0 LT
 STA. 279+45.5 - STA. 279+83.0 RT
 STA. 279+49.5 - STA. 279+87.0 LT
 STA. 280+83.0 - STA. 281+20.5 RT
 STA. 280+99.5 - STA. 281+37.0 LT

676.10 DELINEATORS WITH STEEL POSTS

TYPE I WHITE
 CASTLETON:
 STA. 273+74.0 LT STA. 281+20.5 LT
 STA. 279+45.5 RT STA. 281+37.0 LT
 STA. 279+49.5 LT

NOTES:

- PAVING LIMIT ON ALL TOWN HIGHWAYS SHALL BE MEASURED 25 FT BACK FROM VT. ROUTE 30 EDGE OF SHOULDER UNLESS DENOTED OTHERWISE ON THE PLANS OR AS DIRECTED BY THE RESIDENT ENGINEER.
- THE CONTRACTOR SHOULD BE AWARE THAT EXISTING BURIED UTILITIES (SUCH AS PHONE CABLE, FIBER OPTIC CABLE, ETC.) ARE LOCATED ADJACENT TO VT. ROUTE 30 WITHIN THE PROJECT LIMITS. THE CONTRACTOR IS RESPONSIBLE FOR CONTACTING "DIG SAFE" AT 1-888-344-7233 TO DETERMINE THE EXACT LOCATIONS OF THESE UTILITIES PRIOR TO INSTALLING GUARDRAIL, CLEANING DITCHES OR PERFORMING ANY OTHER OPERATIONS THAT MAY DISTURB THE EXISTING SUBSURFACE CONDITIONS.
- REMOVE EXISTING GUARDRAIL END SECTION AND INSTALL NEW MANUFACTURED TERMINAL SECTION (FLARED) AS DIRECTED BY THE RESIDENT ENGINEER. REMAINING EXISTING RAIL SHALL BE RETAINED.
- SEE SHEET 49 FOR STEEL BEAM GUARDRAIL AT SMALL CULVERTS DETAIL AND STEEL BEAM GUARDRAIL AT LARGE CULVERTS DETAIL.

SIGN LEGEND

R = REMOVE
 S = SALVAGE
 N = NEW
 RET = RETAIN
 B-B = BACK TO BACK
 EXISTING = - - - - -
 NEW = _____

PROJECT LAYOUT SHEET

PROJECT NAME: CASTLETON - SUDBURY
 PROJECT NUMBER: STP 2402(I)S

FILE NAME: p04c028.dgn PLOT DATE: 11-JUN-2007 13:33
 PROJECT LEADER: D.E.G. DRAWN BY: C.A.K.
 DESIGNED BY: D.W.E. CHECKED BY: D.E.G.
 IPARM FILE: p04c028I01.I SHEET 13 OF 92