

646.40 DURABLE 4" WHITE LINE (THERMOPLASTIC)
 (ALL LINES WILL INCLUDE EDGE LINE BREAKS AND
 RADIUS FOR TOWN HIGHWAYS)

HUBBARDTON:
 STA. 7+00.00 - STA. 39+00.00 EDGE LINE LT & RT

646.41 DURABLE 4" YELLOW LINE (THERMOPLASTIC)
 (ALL LINES WILL INCLUDE C/L BREAKS FOR
 TOWN HIGHWAYS) S=SOLID, D=DASHED


HUBBARDTON:	LT	CL	RT
STA. 7+00.00 - STA. 10+03.00	S	-	S
STA. 10+03.00 - STA. 14+25.00	D	-	S
STA. 14+25.00 - STA. 16+89.00	-	D	-
STA. 16+89.00 - STA. 23+76.00	S	-	D
STA. 23+76.00 - STA. 24+82.00	-	D	-
STA. 24+82.00 - STA. 32+21.00	D	-	S
STA. 32+21.00 - STA. 32+74.00	S	-	S
STA. 32+74.00 - STA. 39+00.00	S	-	D

646.60 TEMPORARY 4" WHITE LINE (PAINT)
 (ALL LINES WILL INCLUDE EDGE LINE BREAKS AND
 RADIUS FOR TOWN HIGHWAYS)

HUBBARDTON:
 STA. 7+00.00 - STA. 39+00.00 EDGE LINE LT & RT

646.61 TEMPORARY 4" YELLOW LINE (PAINT)
 (ALL LINES WILL INCLUDE C/L BREAKS FOR
 TOWN HIGHWAYS) S=SOLID, D=DASHED

HUBBARDTON:	LT	CL	RT
STA. 7+00.00 - STA. 10+03.00	S	-	S
STA. 10+03.00 - STA. 14+25.00	D	-	S
STA. 14+25.00 - STA. 16+89.00	-	D	-
STA. 16+89.00 - STA. 23+76.00	S	-	D
STA. 23+76.00 - STA. 24+82.00	-	D	-
STA. 24+82.00 - STA. 32+21.00	D	-	S
STA. 32+21.00 - STA. 32+74.00	S	-	S
STA. 32+74.00 - STA. 39+00.00	S	-	D

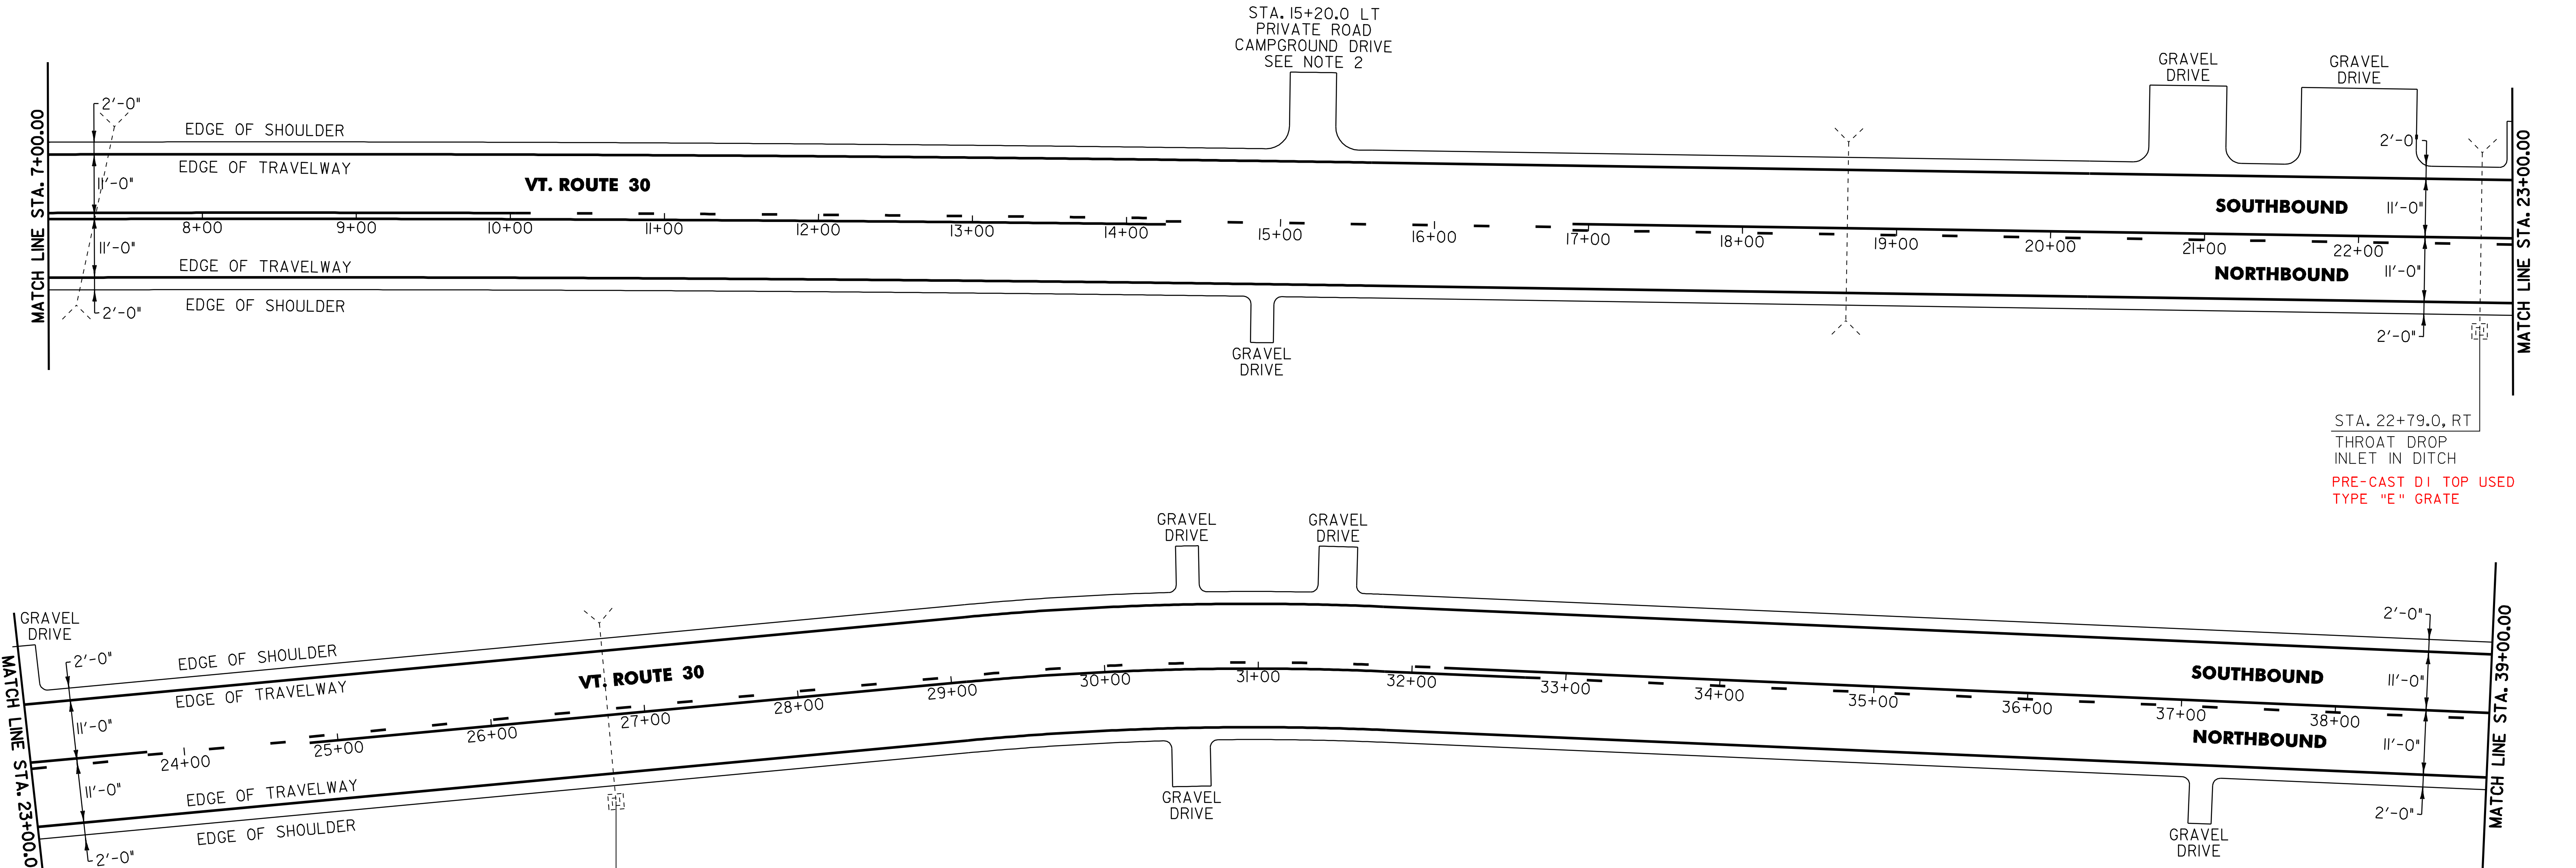

STA. 26+76.0, RT
 THROAT DROP
 INLET IN DITCH
 PRE-CAST DI TOP
 USED TYPE "E" GRATE

STA. 22+79.0, RT
 THROAT DROP
 INLET IN DITCH
 PRE-CAST DI TOP USED
 TYPE "E" GRATE

NOTES:

- THE CONTRACTOR SHOULD BE AWARE THAT EXISTING BURIED UTILITIES (SUCH AS PHONE CABLE, FIBER OPTIC CABLE, ETC.) ARE LOCATED ADJACENT TO VT. ROUTE 30 WITHIN THE PROJECT LIMITS. THE CONTRACTOR IS RESPONSIBLE FOR CONTACTING "DIG SAFE" AT 1-888-344-7233 TO DETERMINE THE EXACT LOCATIONS OF THESE UTILITIES PRIOR TO INSTALLING GUARDRAIL, CLEANING DITCHES OR PERFORMING ANY OTHER OPERATIONS THAT MAY DISTURB THE EXISTING SUBSURFACE CONDITIONS.
- PROVIDE A 15 FT WIDE 1/4" TYPE IV APRON FOR THE EXISTING PRIVATE ROAD. ANY REQUIRED EXCAVATION SHALL BE PERFORMED AS DIRECTED BY THE RESIDENT ENGINEER AND PAID FOR UNDER ITEM 608.25 ALL PURPOSE EXCAVATOR RENTAL, TYPE I.

604.412 REHABING DI, CB OR MH, CLASS I

HUBBARDTON:
 STA. 22+79.0 RT
 STA. 26+76.0 RT

PROJECT LAYOUT SHEET

PROJECT NAME: CASTLETON - SUDBURY	PLOT DATE: 11-JUN-2007 13:33
PROJECT NUMBER: STP 2402(I)S	DRAWN BY: C.A.K.
FILE NAME: p04c028.dgn	CHECKED BY: D.E.G.
DESIGNED BY: D.W.E.	SHEET 16 OF 92
IPARM FILE: p04c028104.i	