

646.40 DURABLE 4" WHITE LINE (THERMOPLASTIC)  
 (ALL LINES WILL INCLUDE EDGE LINE BREAKS AND  
 RADIUS FOR TOWN HIGHWAYS)

HUBBARDTON:  
 STA. 87+00.00 - STA. 88+73.50 EDGE LINE LT & RT  
 STA. 101+23.50 - STA. 103+00.00 EDGE LINE LT & RT

646.41 DURABLE 4" YELLOW LINE (THERMOPLASTIC)  
 (ALL LINES WILL INCLUDE C/L BREAKS FOR  
 TOWN HIGHWAYS) S=SOLID, D=DASHED


HUBBARDTON:  
 STA. 87+00.00 - STA. 88+73.50 LT C RT  
 STA. 101+23.50 - STA. 103+00.00 S - D S

646.60 TEMPORARY 4" WHITE LINE (PAINT)  
 (ALL LINES WILL INCLUDE EDGE LINE BREAKS AND  
 RADIUS FOR TOWN HIGHWAYS)

HUBBARDTON:  
 STA. 87+00.00 - STA. 88+73.50 EDGE LINE LT & RT  
 STA. 101+23.50 - STA. 103+00.00 EDGE LINE LT & RT

646.61 TEMPORARY 4" YELLOW LINE (PAINT)  
 (ALL LINES WILL INCLUDE C/L BREAKS FOR  
 TOWN HIGHWAYS) S=SOLID, D=DASHED

HUBBARDTON:  
 STA. 87+00.00 - STA. 88+73.50 LT C RT  
 STA. 101+23.50 - STA. 103+00.00 S - D S

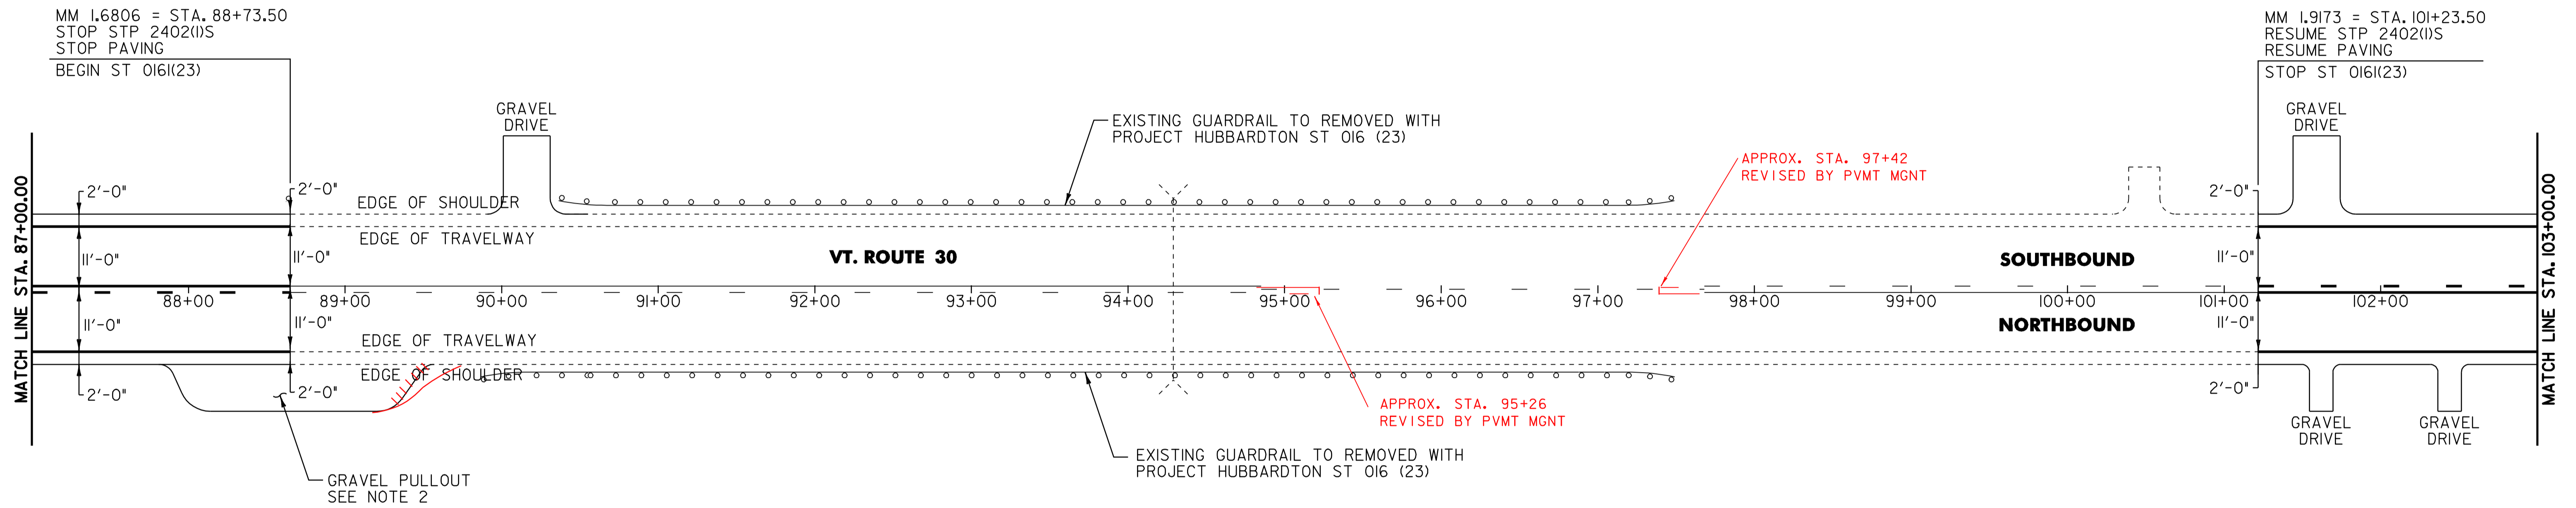

NOTES:

1. THE CONTRACTOR SHOULD BE AWARE THAT EXISTING BURIED UTILITIES (SUCH AS PHONE CABLE, FIBER OPTIC CABLE, ETC.) ARE LOCATED LOCATED ADJACENT TO VT. ROUTE 30 WITHIN THE PROJECT LIMITS. THE CONTRACTOR IS RESPONSIBLE FOR CONTACTING "DIG SAFE" AT 1-888-344-7233 TO DETERMINE THE EXACT LOCATIONS OF THESE UTILITIES PRIOR TO INSTALLING GUARDRAIL, CLEANING DITCHES OR PERFORMING ANY OTHER OPERATIONS THAT MAY DISTURB THE EXISTING SUBSURFACE CONDITIONS.
2. PROVIDE A 5 FT WIDE 1/4" TYPE IV APRON FOR THE EXISTING GRAVEL PULLOUT. ANY REQUIRED EXCAVATION SHALL BE PERFORMED AS DIRECTED BY THE ENGINEER AND PAID FOR UNDER ITEM 608.25 ALL PURPOSE EXCAVATOR RENTAL, TYPE 1.

**PROJECT LAYOUT SHEET**

PROJECT NAME: CASTLETON - SUDBURY  
 PROJECT NUMBER: STP 2402(I)S

FILE NAME: p04c028.dgn PLOT DATE: 11-JUN-2007 13:33  
 PROJECT LEADER: D.E.G. DRAWN BY: C.A.K.  
 DESIGNED BY: D.W.E. CHECKED BY: D.E.G.  
 IPARM FILE: p04c028107.i SHEET 19 OF 92