

646.40 DURABLE 4" WHITE LINE (THERMOPLASTIC)
 (ALL LINES WILL INCLUDE EDGE LINE BREAKS AND RADIUS FOR TOWN HIGHWAYS)

HUBBARDTON:
 STA. 103+00.00 - STA. 119+00.00 EDGE LINE LT & RT

646.41 DURABLE 4" YELLOW LINE (THERMOPLASTIC)
 (ALL LINES WILL INCLUDE C/L BREAKS FOR TOWN HIGHWAYS) S=SOLID, D=DASHED

HUBBARDTON:
 STA. 103+00.00 - STA. 105+60.00 D - S
 STA. 105+60.00 - STA. 111+94.00 S - S
 STA. 111+94.00 - STA. 118+27.00 S - D
 STA. 118+27.00 - STA. 119+00.00 S - S
 STA. 107+07.84 DOUBLE SOLID RT, T-2

646.60 TEMPORARY 4" WHITE LINE (PAINT)
 (ALL LINES WILL INCLUDE EDGE LINE BREAKS AND RADIUS FOR TOWN HIGHWAYS)

HUBBARDTON:
 STA. 103+00.00 - STA. 119+00.00 EDGE LINE LT & RT

646.61 TEMPORARY 4" YELLOW LINE (PAINT)
 (ALL LINES WILL INCLUDE C/L BREAKS FOR TOWN HIGHWAYS) S=SOLID, D=DASHED

HUBBARDTON:
 STA. 103+00.00 - STA. 105+60.00 D - S
 STA. 105+60.00 - STA. 111+94.00 S - S
 STA. 111+94.00 - STA. 118+27.00 S - D
 STA. 118+27.00 - STA. 119+00.00 S - S
 STA. 107+07.84 DOUBLE SOLID RT, T-2

646.46 DURABLE 24" STOP BAR (THERMOPLASTIC)

HUBBARDTON:
 STA. 107+07.84 RT, T-2

646.66 TEMPORARY 24" STOP BAR (PAINT)

HUBBARDTON:
 STA. 107+07.84 RT, T-2

646.50 DURABLE LETTER OR SYMBOL (THERMOPLASTIC)

HUBBARDTON:
 STA. 107+07.84 RT, T-2, "S,T,O,P" (4 EA)

646.70 TEMPORARY LETTER OR SYMBOL (PAINT)


HUBBARDTON:
 STA. 107+07.84 RT, T-2, "S,T,O,P" (4 EA)

675.50 REMOVING SIGNS

AS SHOWN - 7

675.60 ERECTING SALVAGED SIGNS

AS SHOWN - 1

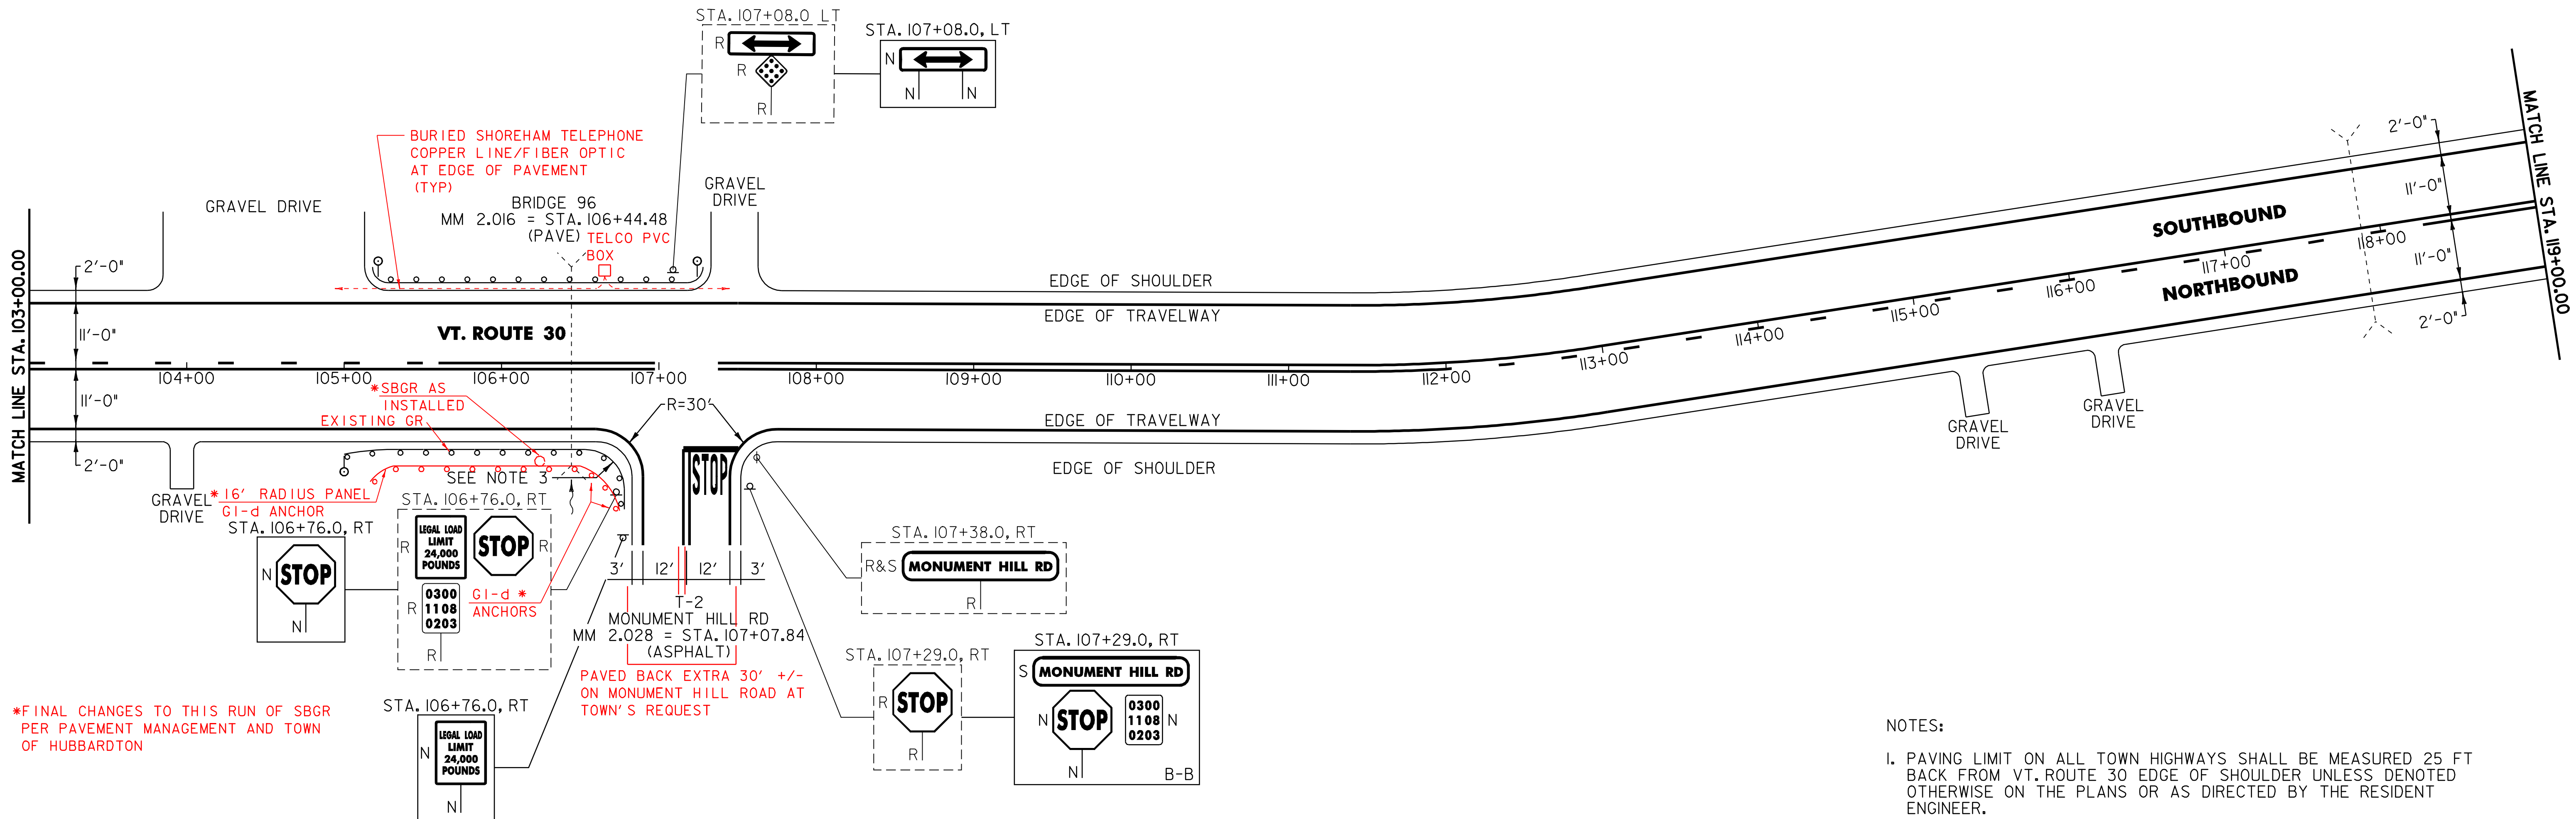

*FINAL CHANGES TO THIS RUN OF SBGR PER PAVEMENT MANAGEMENT AND TOWN OF HUBBARDTON

621.20 STEEL BEAM GUARDRAIL (GALVANIZED)

HUBBARDTON:
 STA. 105+37.5 - STA. 106+96.0 RT (172.0 LF)
 STA. 105+87.5 - STA. 106+62.5 LT (75.0 LF)

621.505 MANUFACTURED TERMINAL SECTION (FLARED)

HUBBARDTON:
 STA. 105+00.0 - STA. 105+37.5 RT
 STA. 105+50.0 - STA. 105+87.5 LT
 STA. 106+62.5 - STA. 107+00.0 LT

621.60 ANCHOR FOR STEEL BEAM RAIL

HUBBARDTON:
 STA. 106+80.0 RT
 STA. 106+96.0 RT (2 EA)

621.80 REMOVAL & DISPOSAL OF GUARDRAIL

HUBBARDTON:
 STA. 105+80.0 - STA. 106+94.0 LT (114.0 LF)
 STA. 105+98.0 - STA. 106+96.0 RT (98.0 LF)

676.10 DELINEATORS WITH STEEL POSTS

♀ TYPE I WHITE

HUBBARDTON:
 STA. 105+00.0 RT
 STA. 105+50.0 LT
 STA. 107+00.0 LT

NOTES:

- PAVING LIMIT ON ALL TOWN HIGHWAYS SHALL BE MEASURED 25 FT BACK FROM VT. ROUTE 30 EDGE OF SHOULDER UNLESS DENOTED OTHERWISE ON THE PLANS OR AS DIRECTED BY THE RESIDENT ENGINEER.
- THE CONTRACTOR SHOULD BE AWARE THAT EXISTING BURIED UTILITIES (SUCH AS PHONE CABLE, FIBER OPTIC CABLE, ETC.) ARE LOCATED ADJACENT TO VT. ROUTE 30 WITHIN THE PROJECT LIMITS. THE CONTRACTOR IS RESPONSIBLE FOR CONTACTING "DIG SAFE" AT 1-888-344-7233 TO DETERMINE THE EXACT LOCATIONS OF THESE UTILITIES PRIOR TO INSTALLING GUARDRAIL, CLEANING DITCHES OR PERFORMING ANY OTHER OPERATIONS THAT MAY DISTURB THE EXISTING SUBSURFACE CONDITIONS.
- THE CONTRACTOR SHALL INSTALL A NEW 16' RADIUS PANEL WITH ANCHORS AT EACH END AS DIRECTED BY THE RESIDENT ENGINEER.

SIGN LEGEND

R = REMOVE
 S = SALVAGE
 N = NEW
 RET = RETAIN
 B-B = BACK TO BACK
 EXISTING = - - - - -
 NEW = _____

PROJECT LAYOUT SHEET

PROJECT NAME: CASTLETON - SUDBURY

PROJECT NUMBER: STP 2402(1)S

FILE NAME: p04c028.dgn

PROJECT LEADER: D.E.G.

DESIGNED BY: D.W.E.

IPARM FILE: p04c028i08.i

PLOT DATE: 11-JUN-2007 13:33

DRAWN BY: C.A.K.

CHECKED BY: D.E.G.

SHEET 20 OF 92