


646.40 DURABLE 4" WHITE LINE (THERMOPLASTIC)  
 (ALL LINES WILL INCLUDE EDGE LINE BREAKS AND  
 RADIUS FOR TOWN HIGHWAYS)  
 HUBBARDTON:  
 STA. 119+00.00 - STA. 134+50.00 EDGE LINE LT & RT

646.41 DURABLE 4" YELLOW LINE (THERMOPLASTIC)  
 (ALL LINES WILL INCLUDE C/L BREAKS FOR  
 TOWN HIGHWAYS) S=SOLID, D=DASHED  
 HUBBARDTON:  
 STA. 119+00.00 - STA. 119+59.00 S - S  
 STA. 119+59.00 - STA. 125+93.00 D - S  
 STA. 125+93.00 - STA. 134+50.00 S - S

646.60 TEMPORARY 4" WHITE LINE (PAINT)  
 (ALL LINES WILL INCLUDE EDGE LINE BREAKS AND  
 RADIUS FOR TOWN HIGHWAYS)  
 HUBBARDTON:  
 STA. 119+00.00 - STA. 134+50.00 EDGE LINE LT & RT

646.61 TEMPORARY 4" YELLOW LINE (PAINT)  
 (ALL LINES WILL INCLUDE C/L BREAKS FOR  
 TOWN HIGHWAYS) S=SOLID, D=DASHED  
 HUBBARDTON:  
 STA. 119+00.00 - STA. 119+59.00 S - S  
 STA. 119+59.00 - STA. 125+93.00 D - S  
 STA. 125+93.00 - STA. 134+50.00 S - S

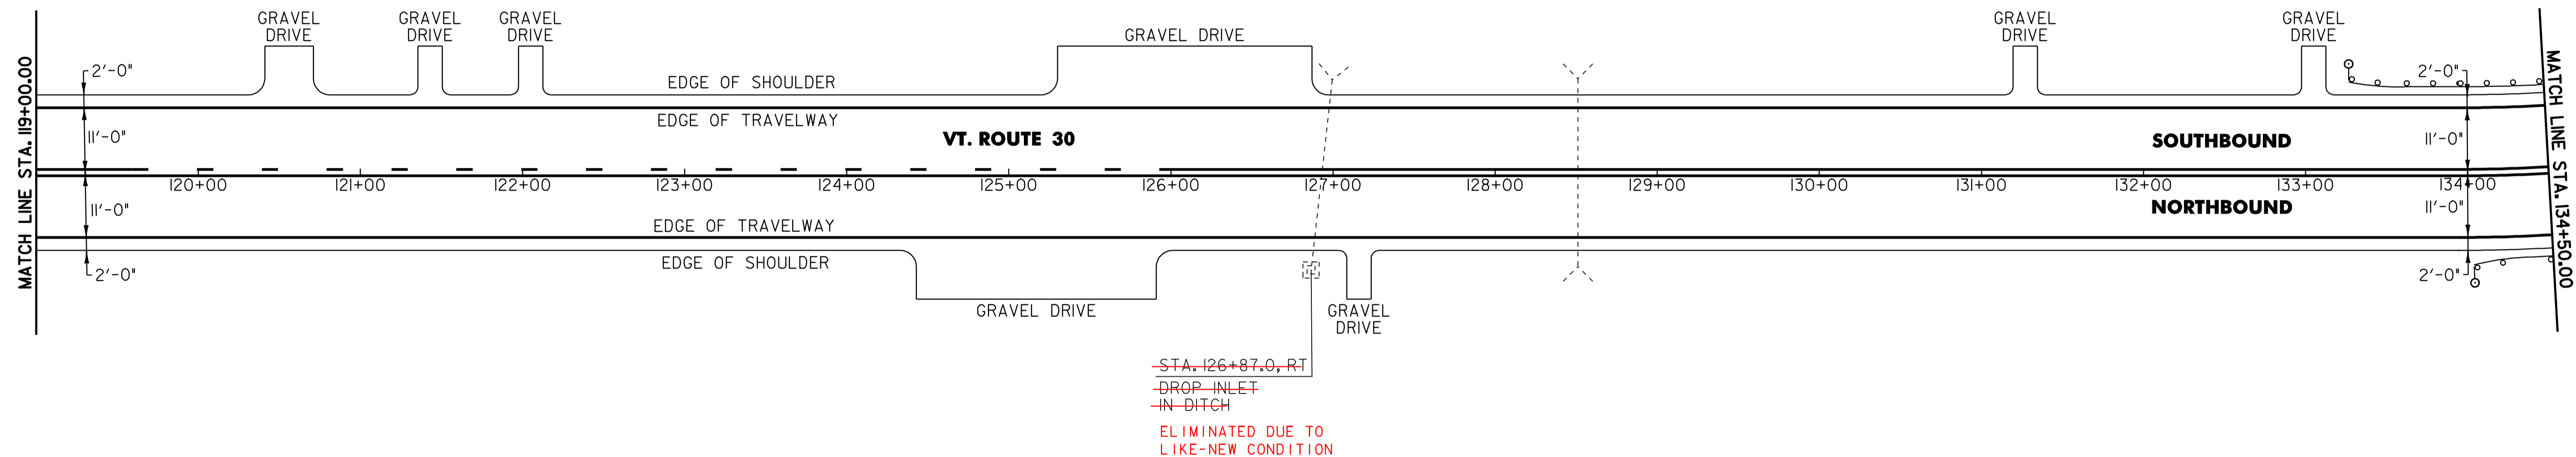

604.412 REHABING DI, CB OR MH CLASS I  
 HUBBARDTON:  
~~STA. 126+87.0 RT ELIMINATED~~

621.20 STEEL BEAM GUARDRAIL (GALVANIZED)  
 HUBBARDTON:  
 STA. 133+66.5 - STA. 134+50.0 LT (83.5 LF)  
 STA. 134+33.0 - STA. 134+50.0 RT (17.0 LF)

621.505 MANUFACTURED TERMINAL SECTION (FLARED)  
 HUBBARDTON:  
 STA. 133+29.0 - STA. 133+66.5 LT  
 STA. 133+95.5 - STA. 134+33.0 RT

621.80 REMOVAL & DISPOSAL OF GUARDRAIL  
 HUBBARDTON:  
 STA. 133+33.0 - STA. 134+50.0 LT (17.0 LF)

676.10 DELINEATORS WITH STEEL POSTS  
 TYPE I WHITE  
 HUBBARDTON:  
 STA. 133+29.0 LT  
 STA. 133+95.5 RT

NOTE:

1. THE CONTRACTOR SHOULD BE AWARE THAT EXISTING BURIED UTILITIES (SUCH AS PHONE CABLE, FIBER OPTIC CABLE, ETC.) ARE LOCATED ADJACENT TO VT. ROUTE 30 WITHIN THE PROJECT LIMITS. THE CONTRACTOR IS RESPONSIBLE FOR CONTACTING "DIG SAFE" AT 1-888-344-7233 TO DETERMINE THE EXACT LOCATIONS OF THESE UTILITIES PRIOR TO INSTALLING GUARDRAIL, CLEANING DITCHES OR PERFORMING ANY OTHER OPERATIONS THAT MAY DISTURB THE EXISTING SUBSURFACE CONDITIONS.

PROJECT LAYOUT SHEET

PROJECT NAME: CASTLETON - SUDBURY  
 PROJECT NUMBER: STP 2402(1)S

FILE NAME: p04c028.dgn PLOT DATE: 11-JUN-2007 13:33  
 PROJECT LEADER: D.E.G. DRAWN BY: C.A.K.  
 DESIGNED BY: D.W.E. CHECKED BY: D.E.G.  
 IPARM FILE: p04c028I09.I SHEET 21 OF 92