

646.40 DURABLE 4" WHITE LINE (THERMOPLASTIC)
 (ALL LINES WILL INCLUDE EDGE LINE BREAKS AND RADIUS FOR TOWN HIGHWAYS)
 HUBBARDTON:
 STA. 134+50.00 - STA. 151+00.00 EDGE LINE LT & RT

646.41 DURABLE 4" YELLOW LINE (THERMOPLASTIC)
 (ALL LINES WILL INCLUDE C/L BREAKS FOR TOWN HIGHWAYS) S=SOLID, D=DASHED
 HUBBARDTON:
 STA. 134+50.00 - STA. 151+00.00 LT S C RT S
 STA. 135+11.52 DOUBLE SOLID LT, T-I

646.60 TEMPORARY 4" WHITE LINE (PAINT)
 (ALL LINES WILL INCLUDE EDGE LINE BREAKS AND RADIUS FOR TOWN HIGHWAYS)
 HUBBARDTON:
 STA. 134+50.00 - STA. 151+00.00 EDGE LINE LT & RT

646.61 TEMPORARY 4" YELLOW LINE (PAINT)
 (ALL LINES WILL INCLUDE C/L BREAKS FOR TOWN HIGHWAYS) S=SOLID, D=DASHED
 HUBBARDTON:
 STA. 134+50.00 - STA. 151+00.00 LT S C RT S
 STA. 135+11.52 DOUBLE SOLID LT, T-I

646.50 DURABLE LETTER OR SYMBOL (THERMOPLASTIC)
 HUBBARDTON:
 STA. 135+11.52 LT, T-I, "S,T,O,P" (4 EA)


646.70 TEMPORARY LETTER OR SYMBOL (PAINT)
 HUBBARDTON:
 STA. 135+11.52 LT, T-I, "S,T,O,P" (4 EA)

675.50 REMOVING SIGNS
 AS SHOWN - 2

675.60 ERECTING SALVAGED SIGNS
 AS SHOWN - 1

646.46 DURABLE 24" STOP BAR (THERMOPLASTIC)
 HUBBARDTON:
 STA. 135+11.52 LT, T-I

646.66 TEMPORARY 24" STOP BAR (PAINT)
 HUBBARDTON:
 STA. 135+11.52 LT, T-I

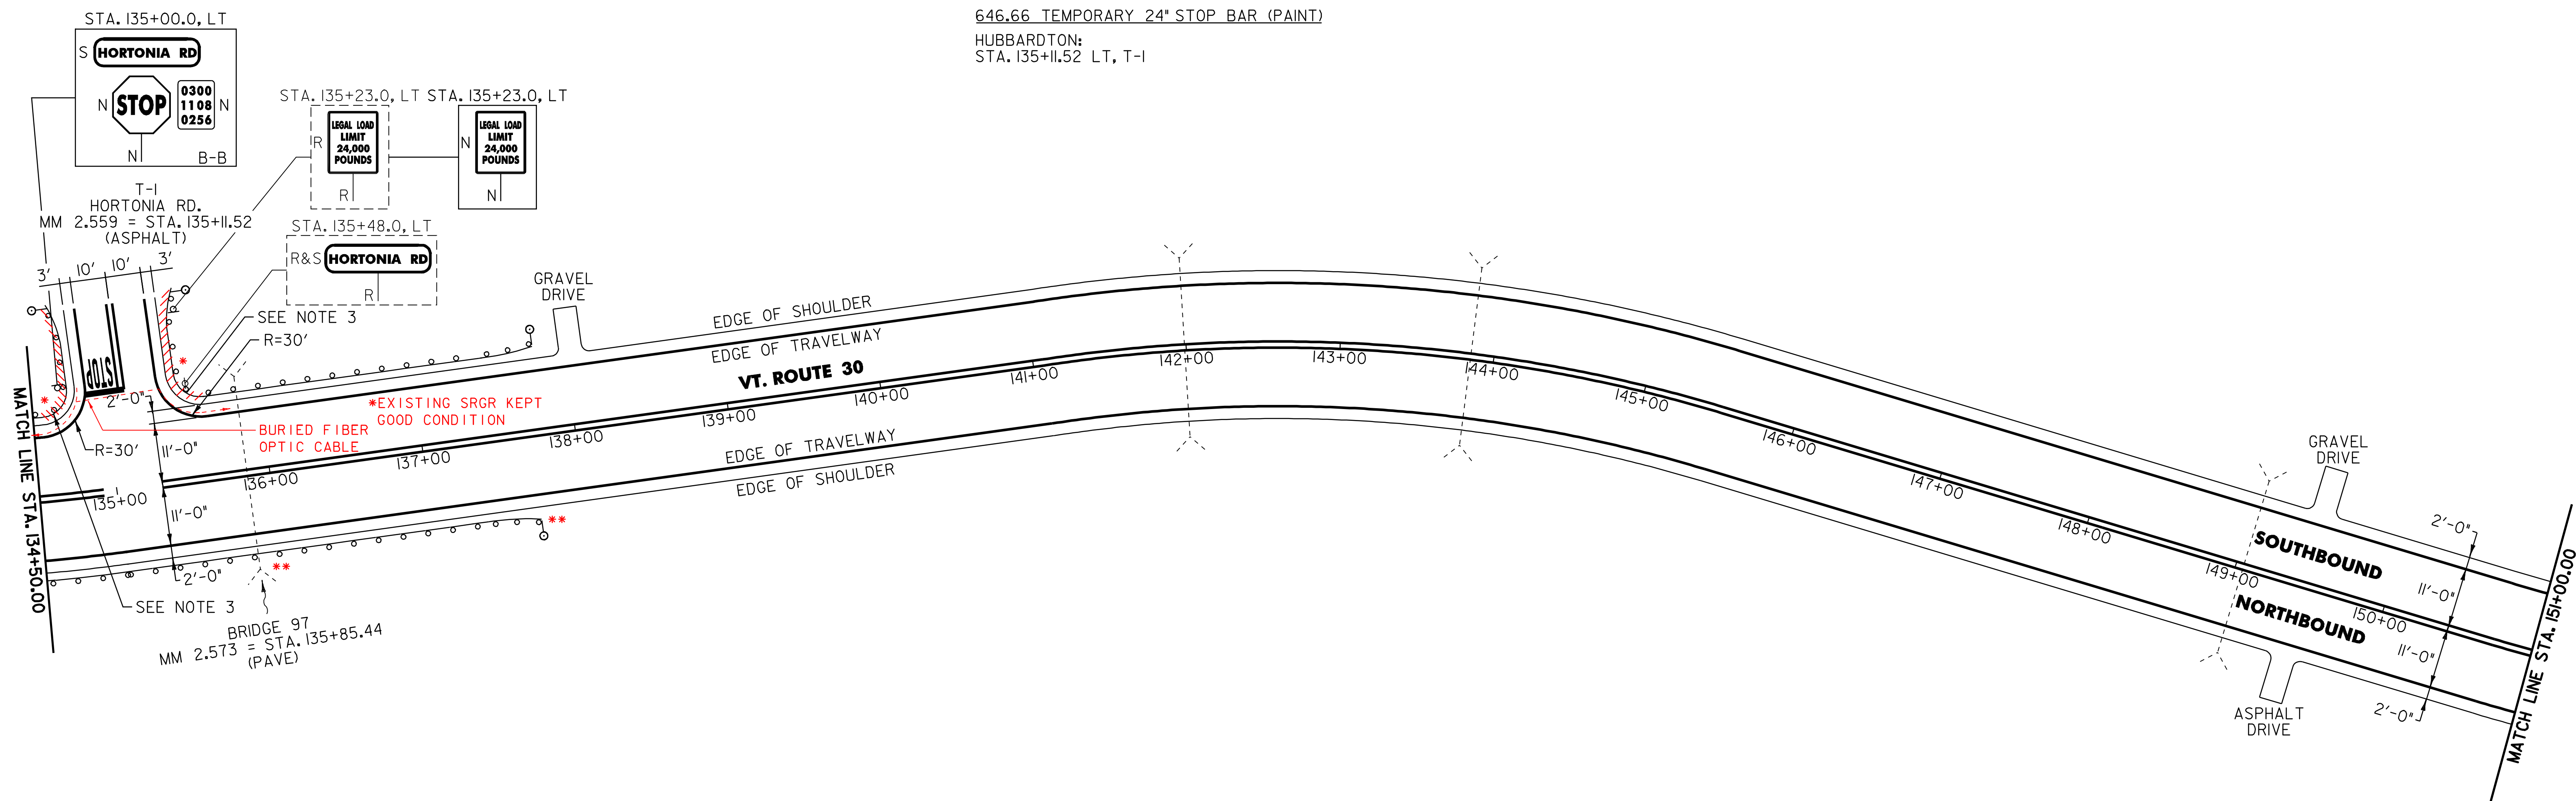

621.20 STEEL BEAM GUARDRAIL (GALVANIZED)
 HUBBARDTON:
~~STA. 134+50.0 - STA. 135+00.0 LT (129.0 LF)~~
~~STA. 134+50.0 - STA. 137+33.0 RT (283.0 LF)~~ 308 LF
~~STA. 135+24.0 - STA. 137+37.5 LT (325.0 LF)~~

621.505 MANUFACTURED TERMINAL SECTION (FLARED)
 HUBBARDTON:
~~STA. 135+00.0 LT, T-I~~
~~STA. 135+24.0 LT, T-I~~ 95.5
~~STA. 137+33.0 - STA. 137+70.5 RT~~
~~STA. 137+37.5 - STA. 137+75.0 LT~~

621.60 ANCHOR FOR STEEL BEAM RAIL
 HUBBARDTON:
~~STA. 134+84.0 LT~~
~~STA. 135+00.0 LT~~
~~STA. 135+24.0 LT~~
~~STA. 135+40.0 LT~~

621.80 REMOVAL & DISPOSAL OF GUARDRAIL
 HUBBARDTON:
~~STA. 134+50.0 - STA. 135+00.0 LT (50.0 LF)~~
~~STA. 135+24.0 - STA. 137+25.0 LT (201.0 LF)~~

621.80 REMOVAL & DISPOSAL OF GUIDE POSTS
 HUBBARDTON:
 STA. 135+04.0 - STA. 136+57.0 RT (10 EA)

676.10 DELINEATORS WITH STEEL POSTS
 ♀ TYPE I WHITE
 HUBBARDTON:
 STA. 135+00.0 LT
 STA. 135+24.0 LT
 STA. 137+70.5 RT
 STA. 137+75.0 LT

- NOTES:
- PAVING LIMIT ON ALL TOWN HIGHWAYS SHALL BE MEASURED 25 FT BACK FROM VT. ROUTE 30 EDGE OF SHOULDER UNLESS DENOTED OTHERWISE ON THE PLANS OR AS DIRECTED BY THE RESIDENT ENGINEER.
 - THE CONTRACTOR SHOULD BE AWARE THAT EXISTING BURIED UTILITIES (SUCH AS PHONE CABLE, FIBER OPTIC CABLE, ETC.) ARE LOCATED ADJACENT TO VT. ROUTE 30 WITHIN THE PROJECT LIMITS. THE CONTRACTOR IS RESPONSIBLE FOR CONTACTING "DIG SAFE" AT 1-888-344-7233 TO DETERMINE THE EXACT LOCATIONS OF THESE UTILITIES PRIOR TO INSTALLING GUARDRAIL, CLEANING DITCHES OR PERFORMING ANY OTHER OPERATIONS THAT MAY DISTURB THE EXISTING SUBSURFACE CONDITIONS.
 - THE CONTRACTOR SHALL INSTALL A NEW 16' RADIUS PANEL WITH ANCHORS AT EACH END AS DIRECTED BY THE RESIDENT ENGINEER.

SIGN LEGEND
 R = REMOVE
 S = SALVAGE
 N = NEW
 RET = RETAIN
 B-B = BACK TO BACK
 EXISTING = - - - - -
 NEW = _____

PROJECT LAYOUT SHEET	PROJECT NAME: CASTLETON - SUDBURY	
	PROJECT NUMBER: STP 2402(1)S	
	FILE NAME: p04c028.dgn	PLOT DATE: 11-JUN-2007 13:33
	PROJECT LEADER: D.E.G. DESIGNED BY: D.W.E. IPARM FILE: p04c028110.I	DRAWN BY: C.A.K. CHECKED BY: D.E.G. SHEET 22 OF 92