

646.40 DURABLE 4" WHITE LINE (THERMOPLASTIC)
 (ALL LINES WILL INCLUDE EDGE LINE BREAKS AND
 RADIUS FOR TOWN HIGHWAYS)

HUBBARDTON:
 STA. 263+00.00 - STA. 271+97.28 EDGE LINE LT & RT

SUDBURY:
 STA. 0+00.00 - STA. 23+00.00 EDGE LINE LT & RT

646.41 DURABLE 4" YELLOW LINE (THERMOPLASTIC)
 (ALL LINES WILL INCLUDE C/L BREAKS FOR
 TOWN HIGHWAYS) S=SOLID, D=DASHED

HUBBARDTON: LT C RT
 STA. 263+00.00 - STA. 271+97.28 S - S

SUDBURY:
 STA. 0+00.00 - STA. 23+00.00 S - S
 STA. 18+21.60 DOUBLE SOLID RT, T-19

646.60 TEMPORARY 4" WHITE LINE (PAINT)
 (ALL LINES WILL INCLUDE EDGE LINE BREAKS AND
 RADIUS FOR TOWN HIGHWAYS)

HUBBARDTON:
 STA. 263+00.00 - STA. 271+97.28 EDGE LINE LT & RT

SUDBURY:
 STA. 0+00.00 - STA. 23+00.00 EDGE LINE LT & RT

646.61 TEMPORARY 4" YELLOW LINE (PAINT)
 (ALL LINES WILL INCLUDE C/L BREAKS FOR
 TOWN HIGHWAYS) S=SOLID, D=DASHED

HUBBARDTON: LT C RT
 STA. 263+00.00 - STA. 271+97.28 S - S

SUDBURY:
 STA. 0+00.00 - STA. 23+00.00 S - S
 STA. 18+21.60 DOUBLE SOLID RT, T-19

646.46 DURABLE 24" STOP BAR (THERMOPLASTIC)

SUDBURY:
 STA. 18+21.60 RT, T-19

646.66 TEMPORARY 24" STOP BAR (PAINT)

SUDBURY:
 STA. 18+21.60 RT, T-19

646.50 DURABLE LETTER OR SYMBOL (THERMOPLASTIC)

SUDBURY:
 STA. 18+21.60 RT, T-19, "S,T,O,P" (4 EA)

646.70 TEMPORARY LETTER OR SYMBOL (PAINT)


SUDBURY:
 STA. 18+21.60 RT, T-19, "S,T,O,P" (4 EA)

675.50 REMOVING SIGNS

AS SHOWN - 4

675.60 ERECTING SALVAGED SIGNS

AS SHOWN - 2

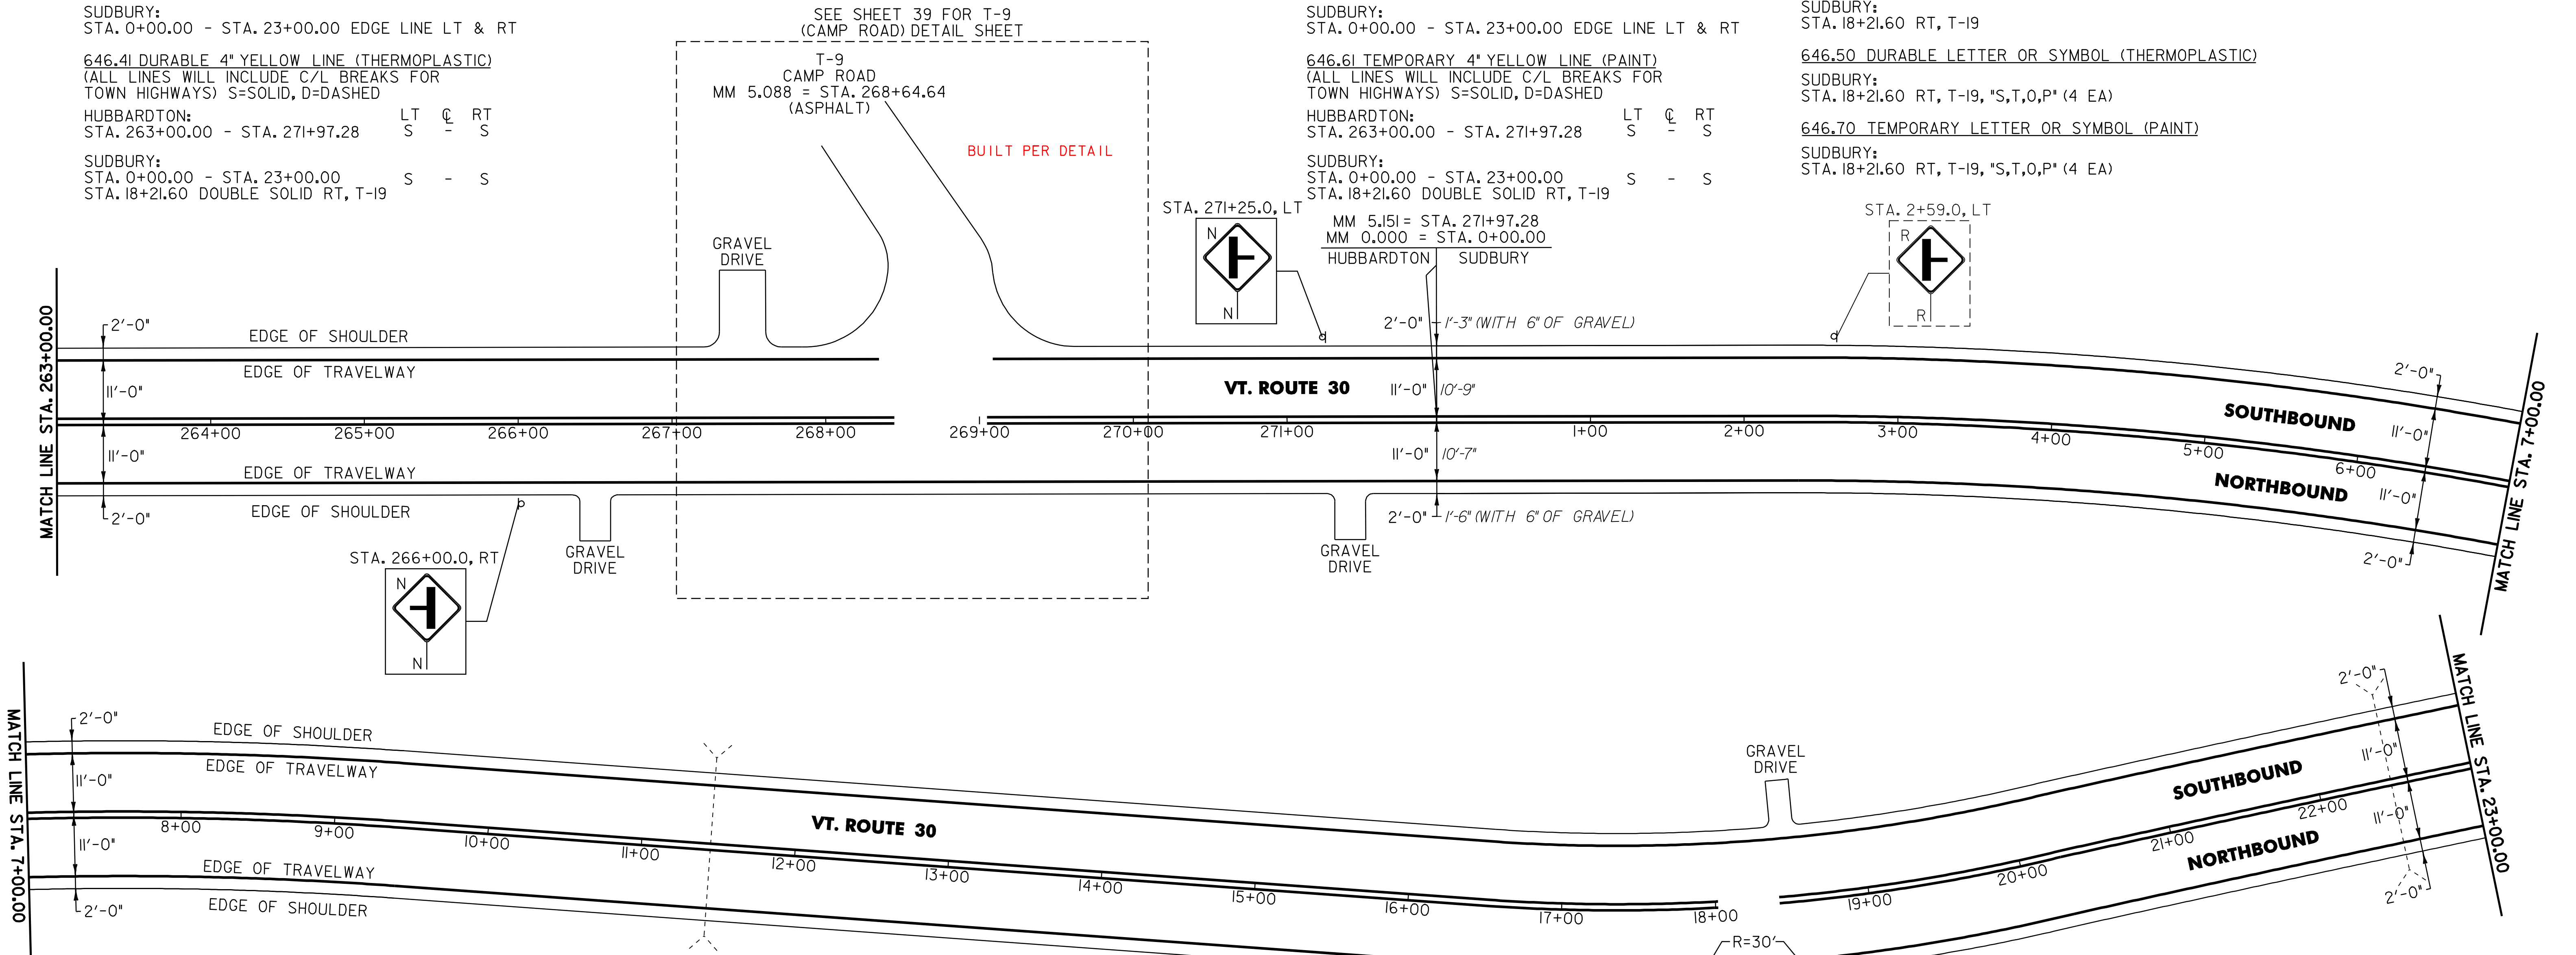

- NOTES:
- PAVING LIMIT ON ALL TOWN HIGHWAYS SHALL BE MEASURED 25 FT BACK FROM VT. ROUTE 30 EDGE OF SHOULDER UNLESS DENOTED OTHERWISE ON THE PLANS OR AS DIRECTED BY THE RESIDENT ENGINEER.
 - THE CONTRACTOR SHOULD BE AWARE THAT EXISTING BURIED UTILITIES (SUCH AS PHONE CABLE, FIBER OPTIC CABLE, ETC.) ARE LOCATED ADJACENT TO VT. ROUTE 30 WITHIN THE PROJECT LIMITS. THE CONTRACTOR IS RESPONSIBLE FOR CONTACTING "DIG SAFE" AT 1-888-344-7233 TO DETERMINE THE EXACT LOCATIONS OF THESE UTILITIES PRIOR TO INSTALLING GUARDRAIL, CLEANING DITCHES OR PERFORMING ANY OTHER OPERATIONS THAT MAY DISTURB THE EXISTING SUBSURFACE CONDITIONS.

SIGN LEGEND
 R = REMOVE
 S = SALVAGE
 N = NEW
 RET = RETAIN
 B-B = BACK TO BACK
 EXISTING = - - - - -
 NEW = _____

PROJECT LAYOUT SHEET	PROJECT NAME: CASTLETON - SUDBURY	PLOT DATE: 11-JUN-2007 13:33
	PROJECT NUMBER: STP 2402(1)S	DRAWN BY: C.A.K.
	FILE NAME: p04c028.dgn	CHECKED BY: D.E.G.
	DESIGNED BY: D.W.E.	SHEET 27 OF 92
	IPARM FILE: p04c028115.i	