


646.40 DURABLE 4" WHITE LINE (THERMOPLASTIC)
 (ALL LINES WILL INCLUDE EDGE LINE BREAKS AND RADIUS FOR TOWN HIGHWAYS)
 SUDBURY:
 STA. 23+00.00 - STA. 55+00.00 EDGE LINE LT & RT

646.4I DURABLE 4" YELLOW LINE (THERMOPLASTIC)
 (ALL LINES WILL INCLUDE C/L BREAKS FOR TOWN HIGHWAYS) S=SOLID, D=DASHED
 SUDBURY:
 STA. 23+00.00 - STA. 55+00.00 LT S RT S

646.60 TEMPORARY 4" WHITE LINE (PAINT)
 (ALL LINES WILL INCLUDE EDGE LINE BREAKS AND RADIUS FOR TOWN HIGHWAYS)
 SUDBURY:
 STA. 23+00.00 - STA. 55+00.00 EDGE LINE LT & RT

646.6I TEMPORARY 4" YELLOW LINE (PAINT)
 (ALL LINES WILL INCLUDE C/L BREAKS FOR TOWN HIGHWAYS) S=SOLID, D=DASHED
 SUDBURY:
 STA. 23+00.00 - STA. 55+00.00 LT S RT S

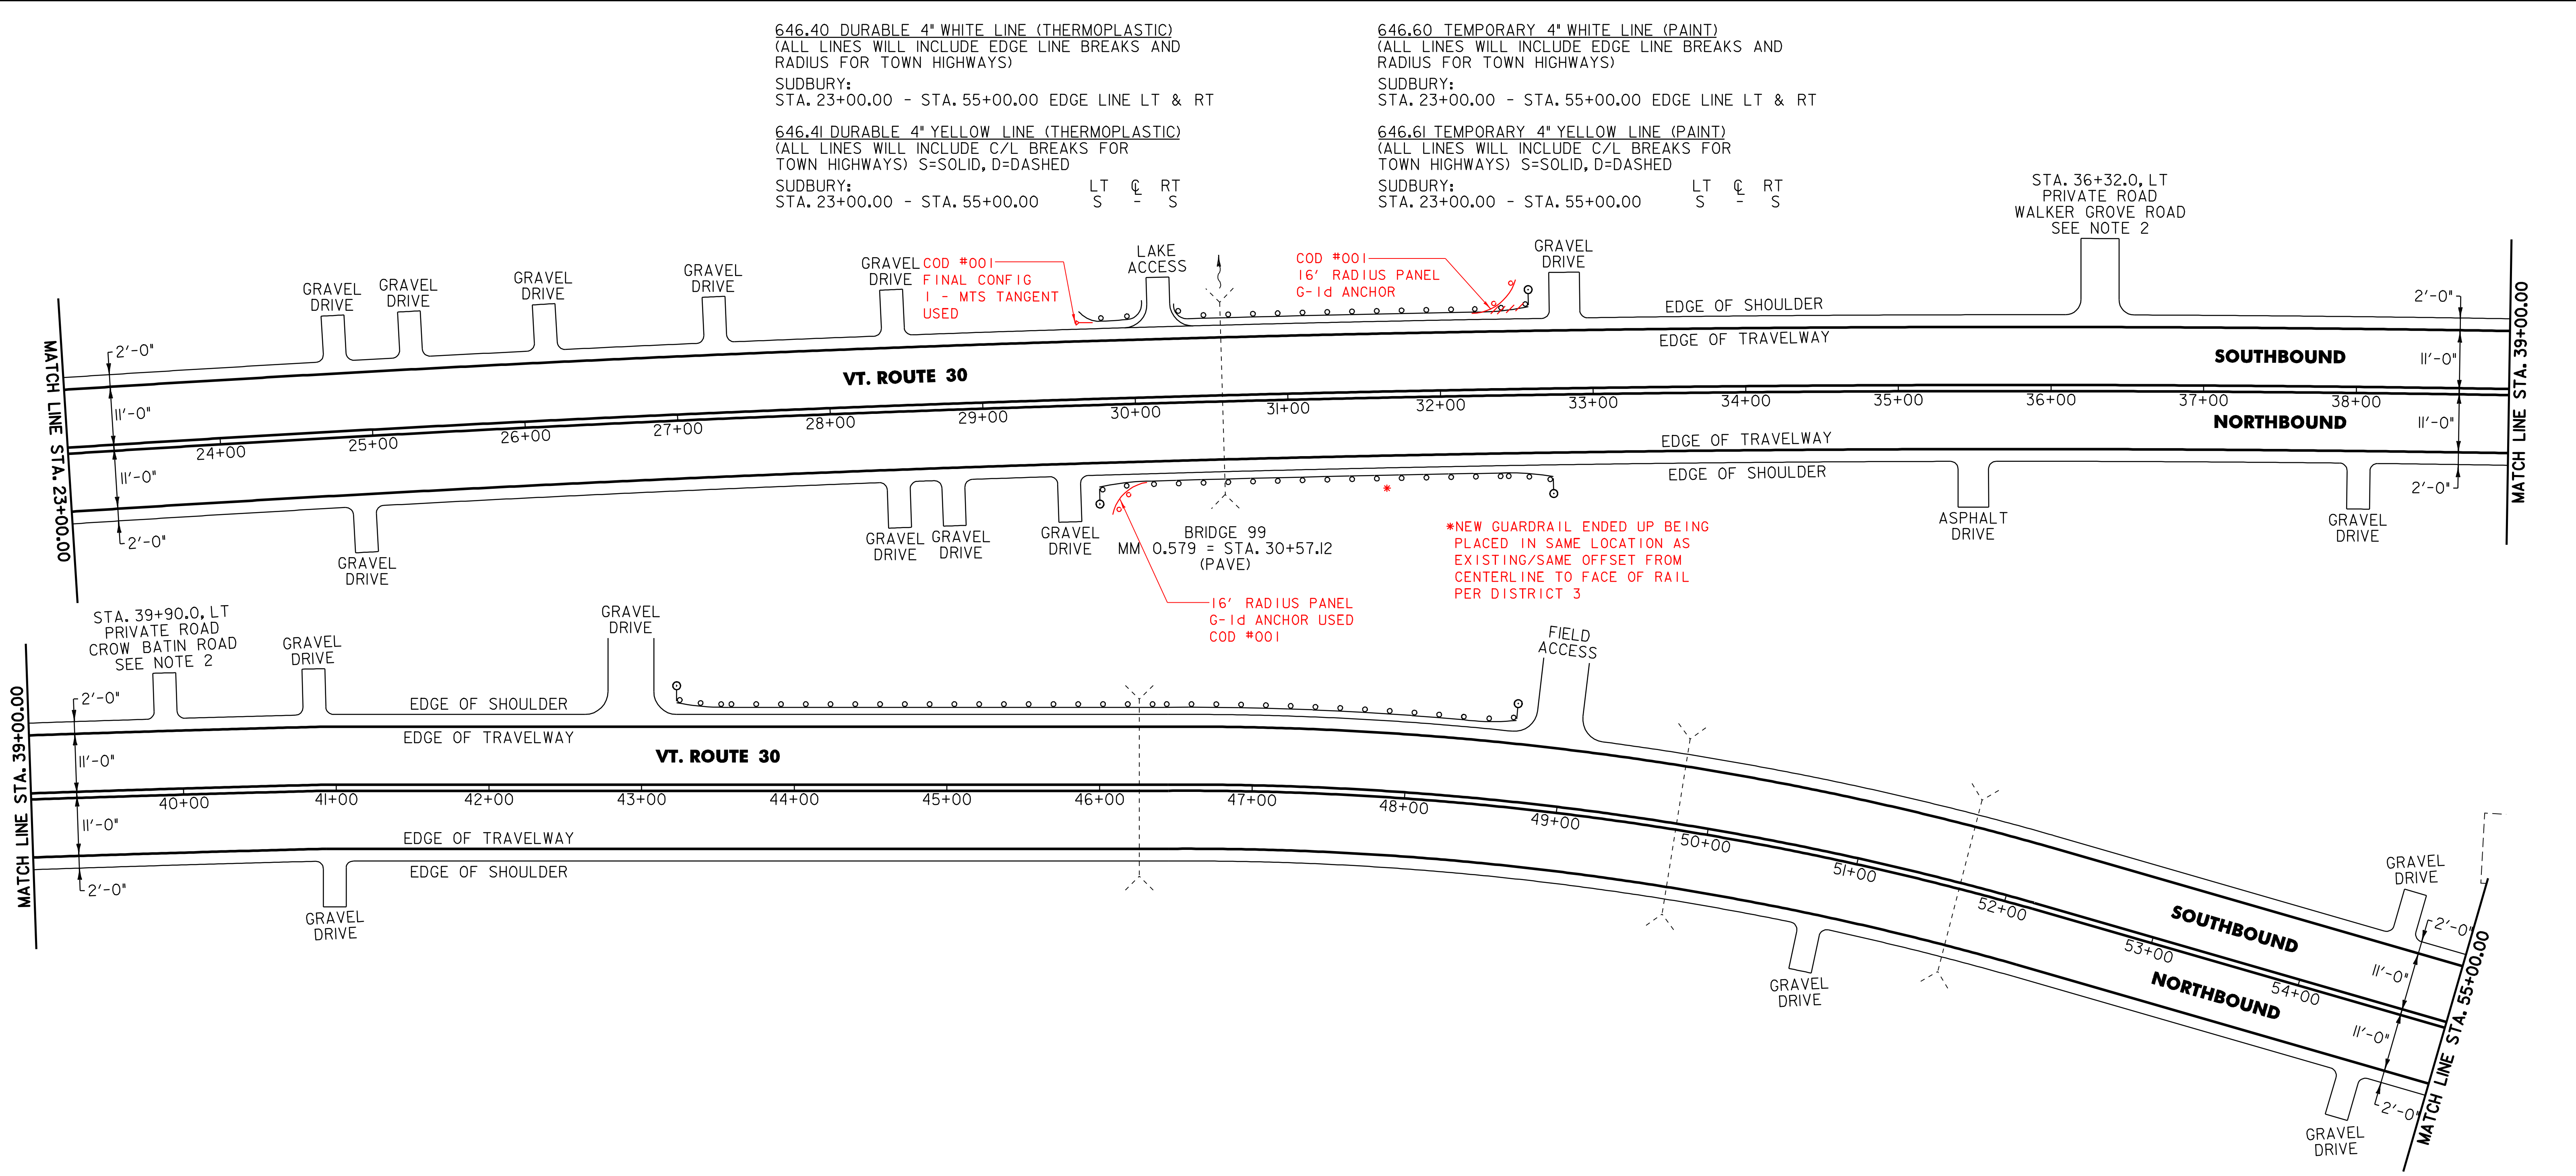

62I.20 STEEL BEAM GUARDRAIL (GALVANIZED)

SUDBURY:
 STA. 29+5I.0 - STA. 30+04.0 LT 41.5 LF
 STA. 30+10.5 - STA. 32+35.5 RT (225.0 LF)
 STA. 30+19.0 - STA. 32+20.5 LT (201.5 LF)

62I.20 STEEL BEAM GUARDRAIL (GALVANIZED) (MOD. - 8' POSTS)

SUDBURY:
 STA. 43+60.5 - STA. 48+35.5 LT (475.0 LF)

62I.505 MANUFACTURED TERMINAL SECTION (FLARED)

SUDBURY:
 STA. 29+73.0 - STA. 30+10.5 RT
 STA. 32+20.5 - STA. 32+58.5 LT
 STA. 32+35.5 - STA. 32+73.0 RT
 STA. 43+23.0 - STA. 43+60.5 LT
 STA. 48+35.5 - STA. 48+73.0 LT

62I.60 ANCHOR FOR STEEL BEAM RAIL

SUDBURY:
 STA. 29+63.2 LT
 STA. 29+93.3 LT
 STA. 30+29.7 LT

62I.80 REMOVAL & DISPOSAL OF GUARDRAIL

SUDBURY:
 STA. 29+65.0 - STA. 30+02.0 LT (37.0 LF)
 STA. 29+74.0 - STA. 32+73.0 RT (299.0 LF)
 STA. 30+19.0 - STA. 32+18.0 LT (199.0 LF)
 STA. 43+23.0 - STA. 48+72.0 LT (549.0 LF)

676.I0 DELINEATORS WITH STEEL POSTS

TYPE I WHITE

SUDBURY:
 STA. 29+73.0 RT
 STA. 32+58.5 LT
 STA. 32+73.0 RT
 STA. 43+23.0 LT
 STA. 48+73.0 LT

NOTES:

- THE CONTRACTOR SHOULD BE AWARE THAT EXISTING BURIED UTILITIES (SUCH AS PHONE CABLE, FIBER OPTIC CABLE, ETC.) ARE LOCATED ADJACENT TO VT. ROUTE 30 WITHIN THE PROJECT LIMITS. THE CONTRACTOR IS RESPONSIBLE FOR CONTACTING "DIG SAFE" AT 1-888-344-7233 TO DETERMINE THE EXACT LOCATIONS OF THESE UTILITIES PRIOR TO INSTALLING GUARDRAIL, CLEANING DITCHES OR PERFORMING ANY OTHER OPERATIONS THAT MAY DISTURB THE EXISTING SUBSURFACE CONDITIONS.
- PROVIDE A 15 FT WIDE 1/4" TYPE IV APRON FOR THE EXISTING PRIVATE ROAD. ANY REQUIRED EXCAVATION SHALL BE PERFORMED AS DIRECTED BY THE RESIDENT ENGINEER AND PAID FOR UNDER ITEM 608.25 ALL PURPOSE EXCAVATOR RENTAL, TYPE I.

PROJECT LAYOUT SHEET

PROJECT NAME: CASTLETON - SUDBURY

PROJECT NUMBER: STP 2402(I)S

FILE NAME: p04c028.dgn

PROJECT LEADER: D.E.G.

DESIGNED BY: D.W.E.

IPARM FILE: p04c028I16.1

PLOT DATE: 11-JUN-2007 13:33

DRAWN BY: C.A.K.

CHECKED BY: D.E.G.

SHEET 28 OF 92