


646.40 DURABLE 4" WHITE LINE (THERMOPLASTIC)  
 (ALL LINES WILL INCLUDE EDGE LINE BREAKS AND  
 RADIUS FOR TOWN HIGHWAYS)  
 SUDBURY:  
 STA. 87+00.00 - STA. 119+00.00 EDGE LINE LT & RT

646.60 TEMPORARY 4" WHITE LINE (PAINT)  
 (ALL LINES WILL INCLUDE EDGE LINE BREAKS AND  
 RADIUS FOR TOWN HIGHWAYS)  
 SUDBURY:  
 STA. 87+00.00 - STA. 119+00.00 EDGE LINE LT & RT

646.41 DURABLE 4" YELLOW LINE (THERMOPLASTIC)  
 (ALL LINES WILL INCLUDE C/L BREAKS FOR  
 TOWN HIGHWAYS) S=SOLID, D=DASHED  
 SUDBURY:  
 STA. 87+00.00 - STA. 119+00.00 LT C RT  
 S - S

646.61 TEMPORARY 4" YELLOW LINE (PAINT)  
 (ALL LINES WILL INCLUDE C/L BREAKS FOR  
 TOWN HIGHWAYS) S=SOLID, D=DASHED  
 SUDBURY:  
 STA. 87+00.00 - STA. 119+00.00 LT C RT  
 S - S

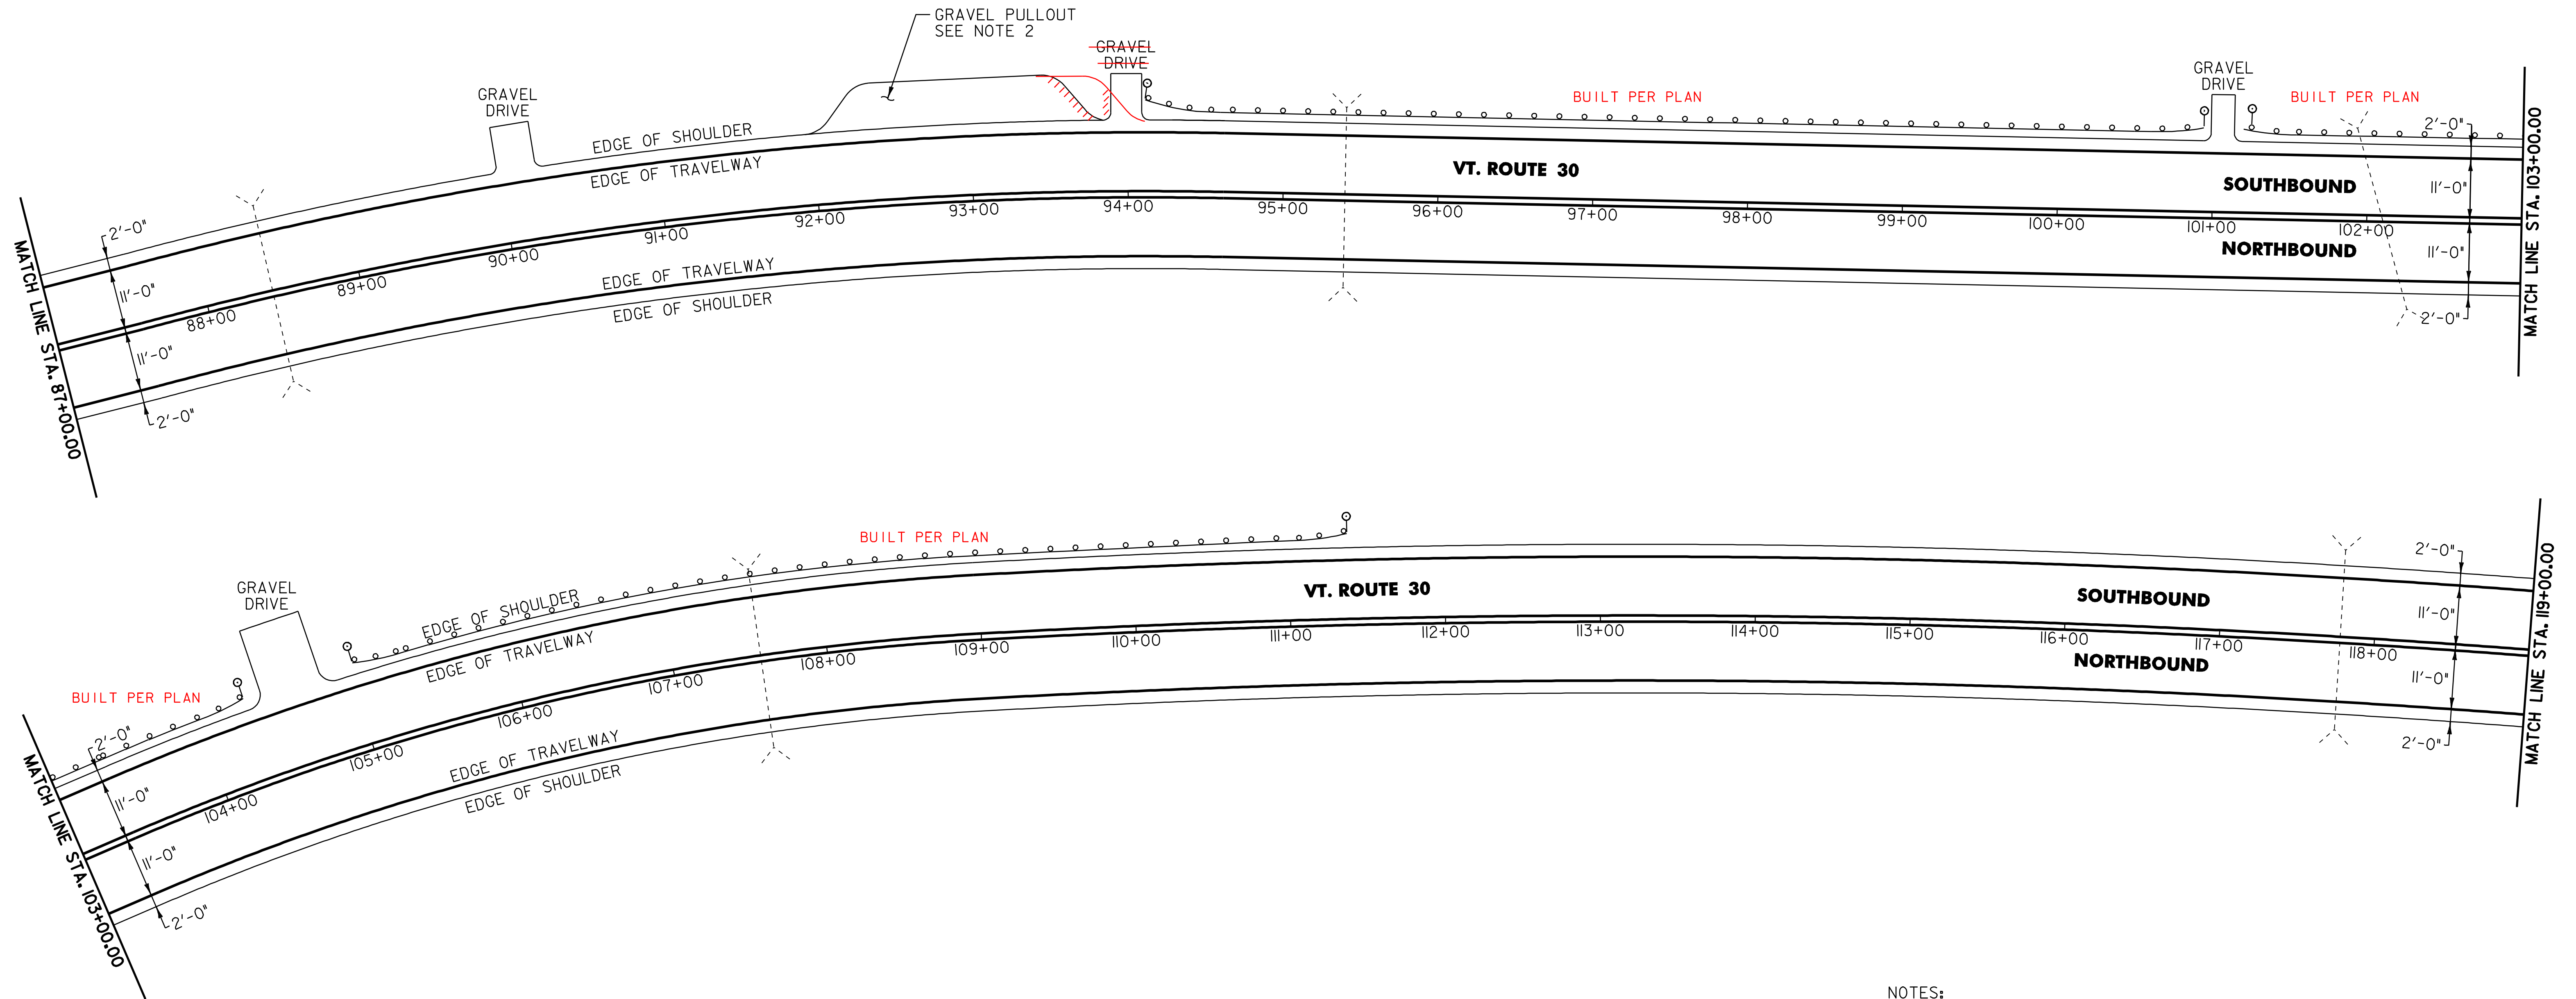

621.20 STEEL BEAM GUARDRAIL (GALVANIZED) (MOD. - 8' POSTS)  
 SUDBURY:  
 STA. 94+47.5 - STA. 100+35.0 LT (587.5 LF)  
 STA. 101+58.0 - STA. 103+95.5 LT (237.0 LF)  
 STA. 105+36.5 - STA. 110+99.0 LT (562.5 LF)

621.80 REMOVAL & DISPOSAL OF GUARDRAIL  
 SUDBURY:  
 STA. 94+83.0 - STA. 100+85.0 LT (602.0 LF)  
 STA. 101+93.0 - STA. 104+33.0 LT (240.0 LF)  
 STA. 104+99.0 - STA. 108+59.0 LT (360.0 LF)

621.505 MANUFACTURED TERMINAL SECTION (FLARED)  
 SUDBURY:  
 STA. 94+10.0 - STA. 94+47.5 LT  
 STA. 101+20.5 - STA. 101+58.0 LT  
 STA. 103+95.5 - STA. 104+33.0 LT  
 STA. 104+99.0 - STA. 105+36.5 LT  
 STA. 110+99.0 - STA. 111+36.5 LT

676.10 DELINEATORS WITH STEEL POSTS  
 TYPE I WHITE  
 SUDBURY:  
 STA. 94+10.0 LT  
 STA. 100+85.0 LT  
 STA. 101+20.5 LT  
 STA. 104+33.0 LT  
 STA. 104+99.0 LT  
 STA. 111+36.5 LT

621.505 MANUFACTURED TERMINAL SECTION (TANGENT)  
 SUDBURY:  
 STA. 100+35.0 - STA. 100+85.0 LT

NOTES:

1. THE CONTRACTOR SHOULD BE AWARE THAT EXISTING BURIED UTILITIES (SUCH AS PHONE CABLE, FIBER OPTIC CABLE, ETC.) ARE LOCATED ADJACENT TO VT. ROUTE 30 WITHIN THE PROJECT LIMITS. THE CONTRACTOR IS RESPONSIBLE FOR CONTACTING "DIG SAFE" AT 1-888-344-7233 TO DETERMINE THE EXACT LOCATIONS OF THESE UTILITIES PRIOR TO INSTALLING GUARDRAIL, CLEANING DITCHES OR PERFORMING ANY OTHER OPERATIONS THAT MAY DISTURB THE EXISTING SUBSURFACE CONDITIONS.
2. PROVIDE A 5 FT WIDE 1/4" TYPE IV APRON FOR EXISTING GRAVEL PULLOUT. ANY REQUIRED EXCAVATION SHALL BE PERFORMED AS DIRECTED BY THE RESIDENT ENGINEER AND PAID FOR UNDER ITEM 608.25 ALL PURPOSE EXCAVATOR RENTAL, TYPE 1.

**PROJECT LAYOUT SHEET**

PROJECT NAME: CASTLETON - SUDBURY

PROJECT NUMBER: STP 2402(1)S

FILE NAME: p04c028.dgn

PROJECT LEADER: D.E.G.

DESIGNED BY: D.W.E.

IPARM FILE: p04c028118.1

PLOT DATE: 11-JUN-2007 13:33

DRAWN BY: C.A.K.

CHECKED BY: D.E.G.

SHEET 30 OF 92