


646.40 DURABLE 4" WHITE LINE (THERMOPLASTIC)  
 (ALL LINES WILL INCLUDE EDGE LINE BREAKS AND  
 RADIUS FOR TOWN HIGHWAYS)  
 SUDBURY:  
 STA. 231+00.00 - STA. 263+00.00 EDGE LINE LT & RT

646.41 DURABLE 4" YELLOW LINE (THERMOPLASTIC)  
 (ALL LINES WILL INCLUDE C/L BREAKS FOR  
 TOWN HIGHWAYS) S=SOLID, D=DASHED  
 SUDBURY:  
 STA. 231+00.00 - STA. 263+00.00 LT C RT  
 S - S

646.60 TEMPORARY 4" WHITE LINE (PAINT)  
 (ALL LINES WILL INCLUDE EDGE LINE BREAKS AND  
 RADIUS FOR TOWN HIGHWAYS)  
 SUDBURY:  
 STA. 231+00.00 - STA. 263+00.00 EDGE LINE LT & RT

646.61 TEMPORARY 4" YELLOW LINE (PAINT)  
 (ALL LINES WILL INCLUDE C/L BREAKS FOR  
 TOWN HIGHWAYS) S=SOLID, D=DASHED  
 SUDBURY:  
 STA. 231+00.00 - STA. 263+00.00 LT C RT  
 S - S

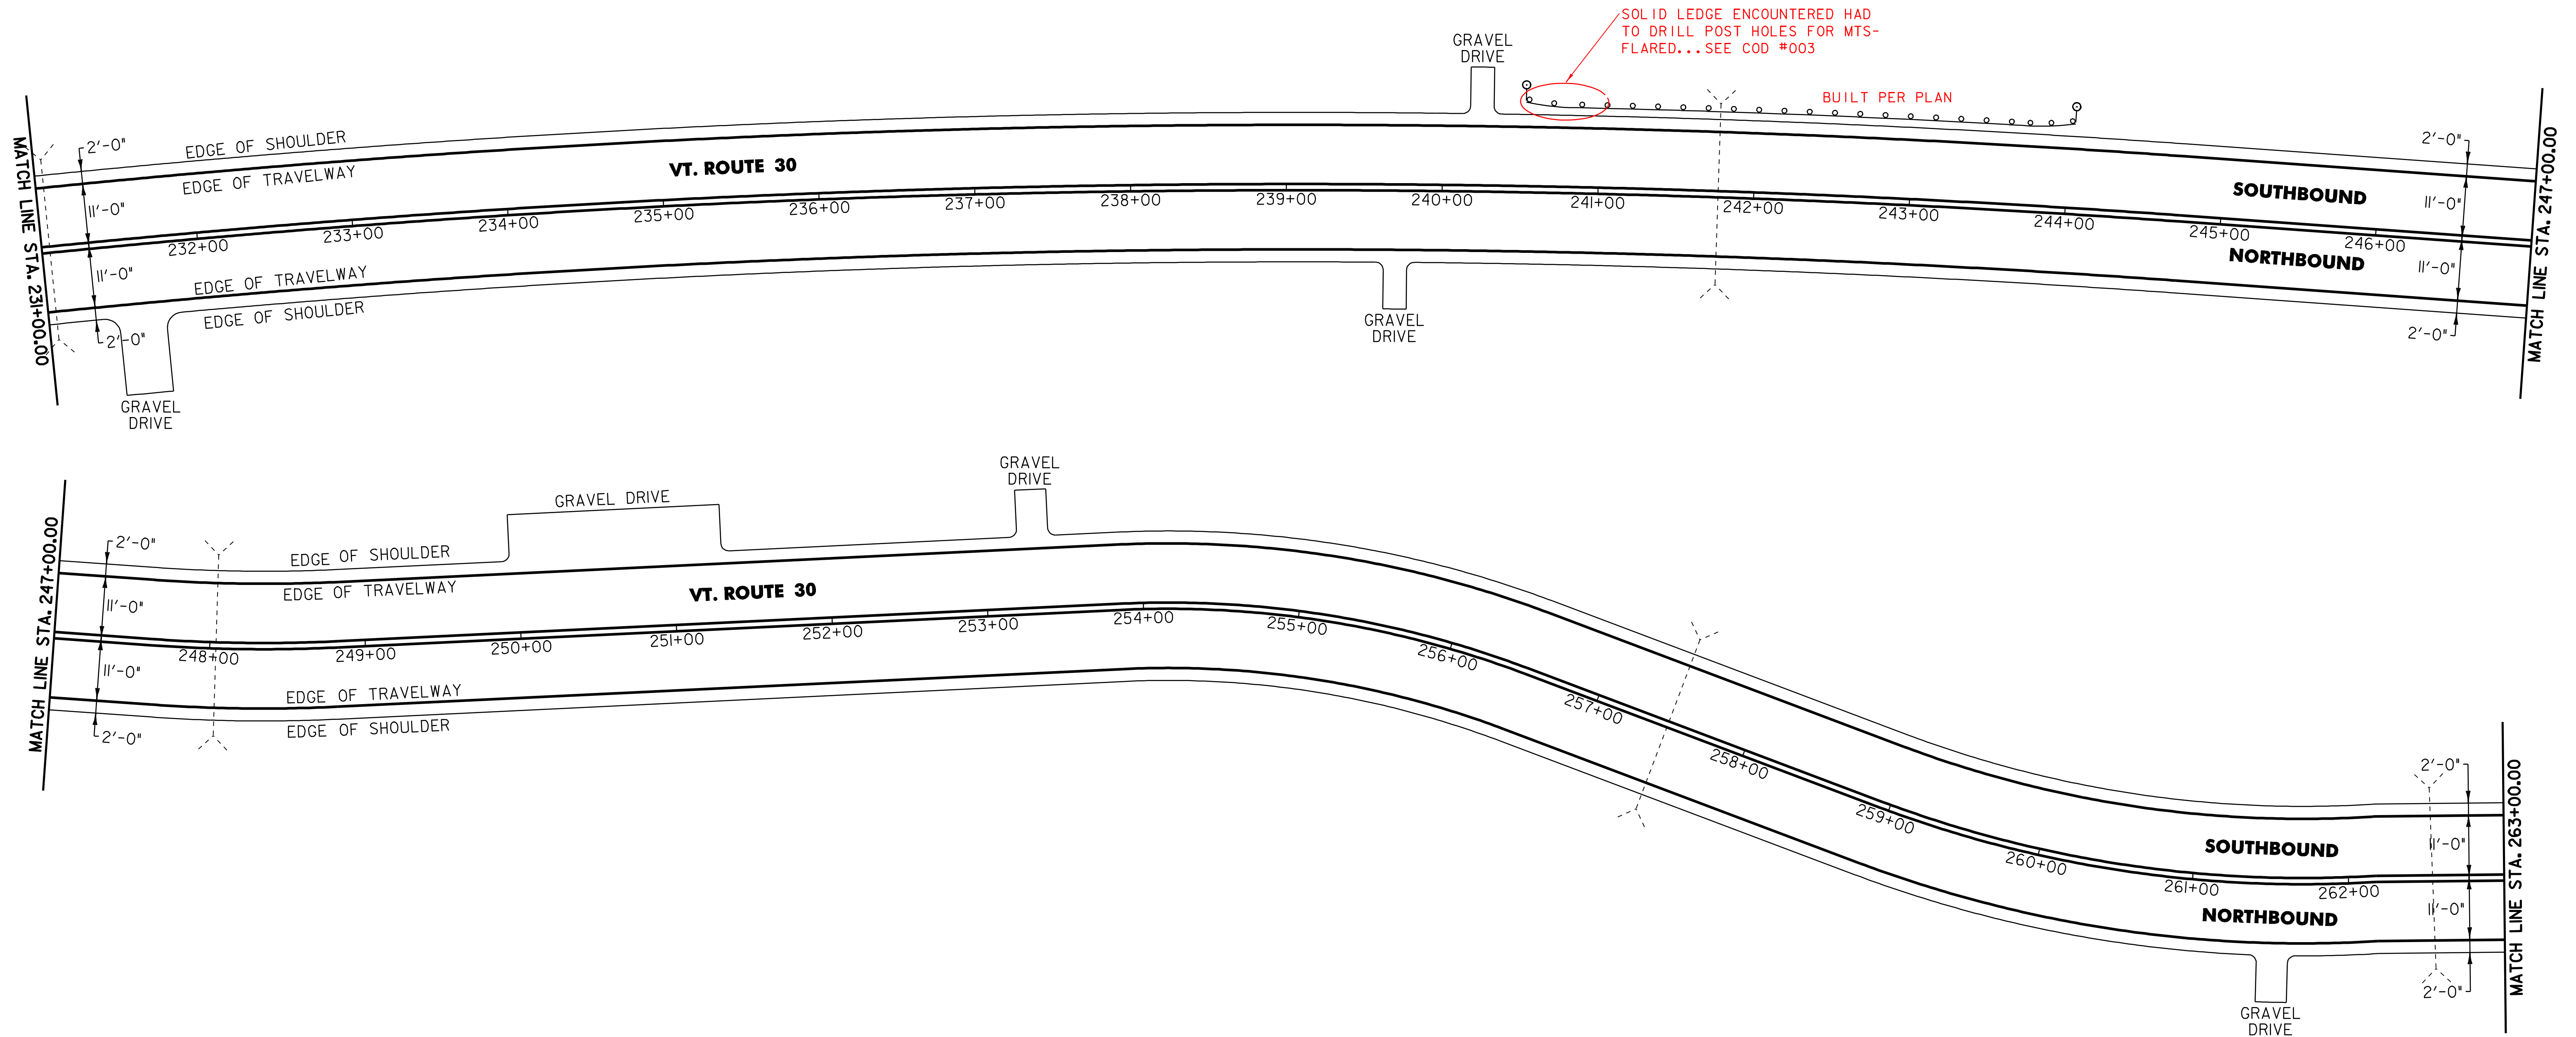

NOTE:

I. THE CONTRACTOR SHOULD BE AWARE THAT EXISTING BURIED UTILITIES (SUCH AS PHONE CABLE, FIBER OPTIC CABLE, ETC.) ARE LOCATED ADJACENT TO VT. ROUTE 30 WITHIN THE PROJECT LIMITS. THE CONTRACTOR IS RESPONSIBLE FOR CONTACTING "DIG SAFE" AT 1-888-344-7233 TO DETERMINE THE EXACT LOCATIONS OF THESE UTILITIES PRIOR TO INSTALLING GUARDRAIL, CLEANING DITCHES OR PERFORMING ANY OTHER OPERATIONS THAT MAY DISTURB THE EXISTING SUBSURFACE CONDITIONS.

621.20 STEEL BEAM GUARDRAIL (GALVANIZED)  
 SUDBURY:  
 STA. 240+87.5 - STA. 243+75.0 LT (287.5 LF)

621.505 MANUFACTURED TERMINAL SECTION (FLARED)  
 SUDBURY:  
 STA. 240+50.0 - STA. 240+87.5 LT  
 STA. 243+75.0 - STA. 244+12.5 LT

621.80 REMOVAL & DISPOSAL OF GUARDRAIL  
 SUDBURY:  
 STA. 241+06.0 - STA. 242+53.0 LT (147.0 LF)

676.10 DELINEATORS WITH STEEL POSTS  
 ♀ TYPE 1 WHITE  
 SUDBURY:  
 STA. 240+50.0 LT  
 STA. 244+12.5 LT

**PROJECT LAYOUT SHEET**

PROJECT NAME: CASTLETON - SUDBURY  
 PROJECT NUMBER: STP 2402(I)S  
 FILE NAME: p04c028.dgn  
 PROJECT LEADER: D.E.G.  
 DESIGNED BY: D.W.E.  
 IPARM FILE: p04c028123.1  
 PLOT DATE: 11-JUN-2007 13:34  
 DRAWN BY: C.A.K.  
 CHECKED BY: D.E.G.  
 SHEET 35 OF 92