

646.40 DURABLE 4" WHITE LINE (THERMOPLASTIC)  
 (ALL LINES WILL INCLUDE EDGE LINE BREAKS AND RADIUS FOR TOWN HIGHWAYS)  
 SUDBURY:  
 STA. 263+00.00 - STA. 295+00.00 EDGE LINE LT & RT

646.41 DURABLE 4" YELLOW LINE (THERMOPLASTIC)  
 (ALL LINES WILL INCLUDE C/L BREAKS FOR TOWN HIGHWAYS) S=SOLID, D=DASHED  
 SUDBURY:  
 STA. 263+00.00 - STA. 295+00.00 LT @ RT S - S  
 STA. 291+29.76 DOUBLE SOLID RT, VT. ROUTE 73

646.60 TEMPORARY 4" WHITE LINE (PAINT)  
 (ALL LINES WILL INCLUDE EDGE LINE BREAKS AND RADIUS FOR TOWN HIGHWAYS)  
 SUDBURY:  
 STA. 263+00.00 - STA. 295+00.00 EDGE LINE LT & RT

646.61 TEMPORARY 4" YELLOW LINE (PAINT)  
 (ALL LINES WILL INCLUDE C/L BREAKS FOR TOWN HIGHWAYS) S=SOLID, D=DASHED  
 SUDBURY:  
 STA. 263+00.00 - STA. 295+00.00 LT @ RT S - S  
 STA. 291+29.76 DOUBLE SOLID RT, VT. ROUTE 73

646.46 DURABLE 24" STOP BAR (THERMOPLASTIC)  
 SUDBURY:  
 STA. 291+29.76 RT, VT. ROUTE 73


646.66 TEMPORARY 24" STOP BAR (PAINT)  
 SUDBURY:  
 STA. 291+29.76 RT, VT. ROUTE 73

646.50 DURABLE LETTER OR SYMBOL (THERMOPLASTIC)  
 SUDBURY:  
 STA. 291+29.76 RT, VT. ROUTE 73, "S,T,O,P" (4 EA)

646.70 TEMPORARY LETTER OR SYMBOL (PAINT)  
 SUDBURY:  
 STA. 291+29.76 RT, VT. ROUTE 73, "S,T,O,P" (4 EA)

675.50 REMOVING SIGNS  
 AS SHOWN - 9

675.60 ERECTING SALVAGED SIGNS  
 AS SHOWN - 5

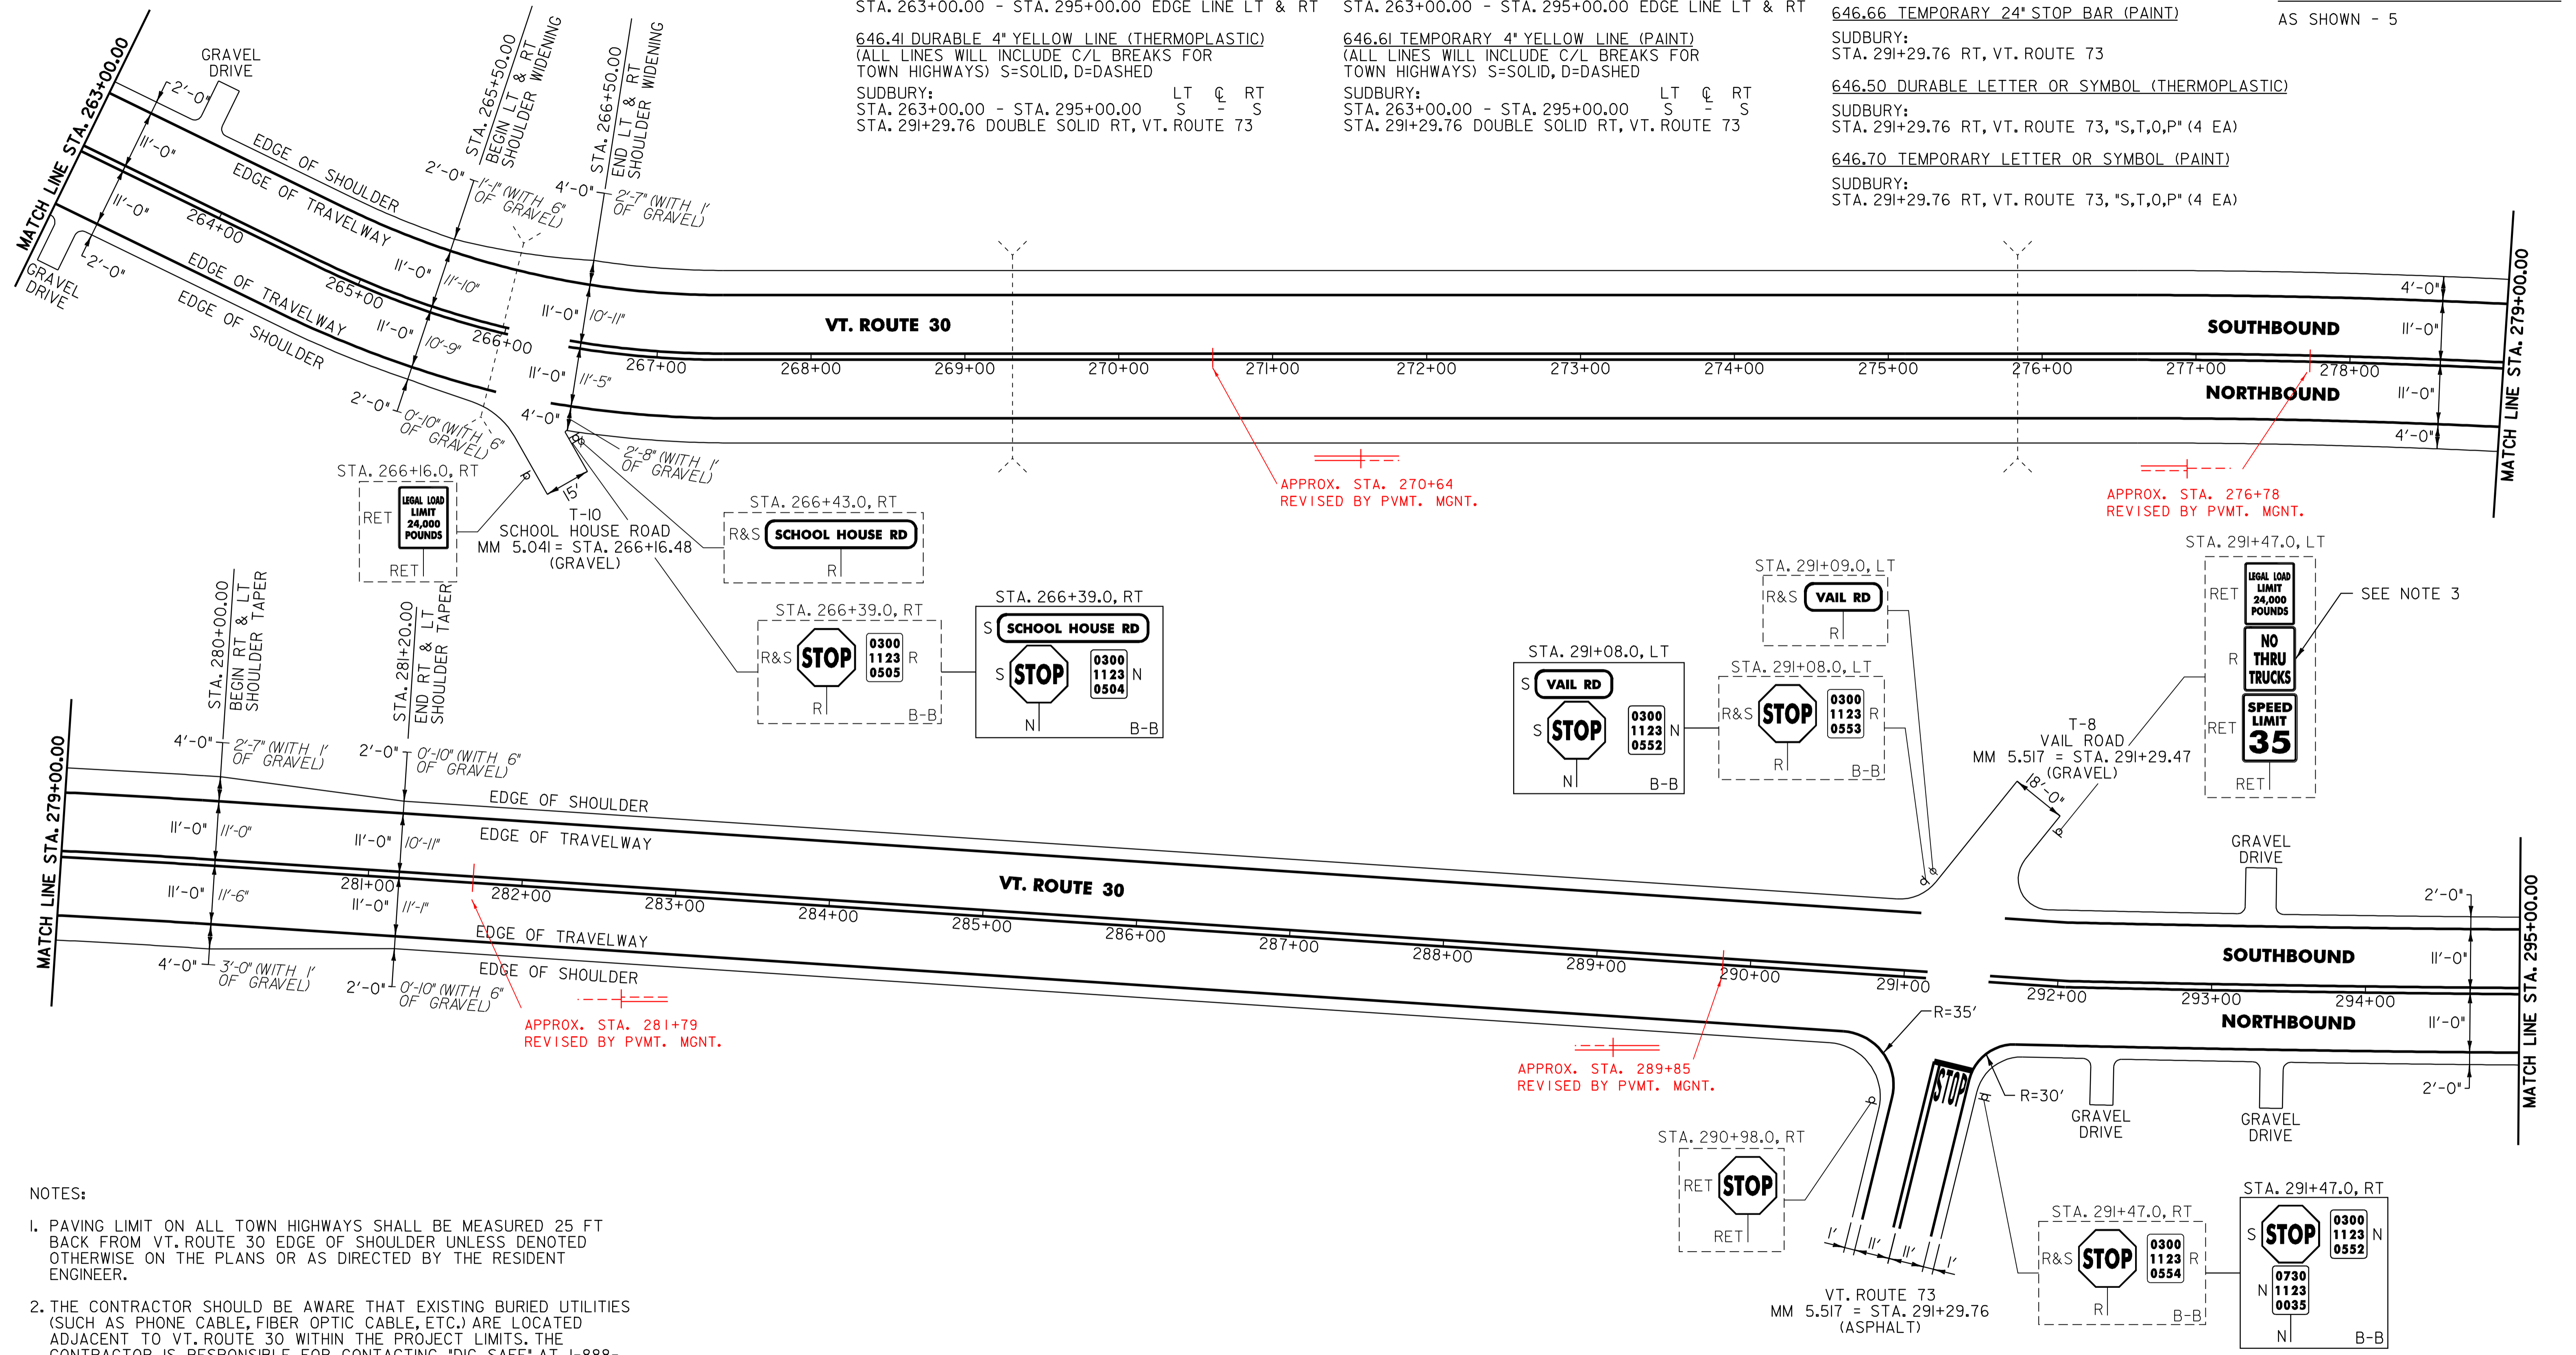

- NOTES:
- PAVING LIMIT ON ALL TOWN HIGHWAYS SHALL BE MEASURED 25 FT BACK FROM VT. ROUTE 30 EDGE OF SHOULDER UNLESS DENOTED OTHERWISE ON THE PLANS OR AS DIRECTED BY THE RESIDENT ENGINEER.
  - THE CONTRACTOR SHOULD BE AWARE THAT EXISTING BURIED UTILITIES (SUCH AS PHONE CABLE, FIBER OPTIC CABLE, ETC.) ARE LOCATED ADJACENT TO VT. ROUTE 30 WITHIN THE PROJECT LIMITS. THE CONTRACTOR IS RESPONSIBLE FOR CONTACTING "DIG SAFE" AT 1-888-344-7233 TO DETERMINE THE EXACT LOCATIONS OF THESE UTILITIES PRIOR TO INSTALLING GUARDRAIL, CLEANING DITCHES OR PERFORMING ANY OTHER OPERATIONS THAT MAY DISTURB THE EXISTING SUBSURFACE CONDITIONS.
  - THE CONTRACTOR SHALL REMOVE THE EXISTING "NO THRU TRUCKS" SIGN AND RETURN IT TO THE TOWN OF SUDBURY. THE CONTRACTOR SHALL ARRANGE THE REMAINING SIGNS AS DIRECTED BY THE RESIDENT ENGINEER.

**SIGN LEGEND**  
 R = REMOVE  
 S = SALVAGE  
 N = NEW  
 RET = RETAIN  
 B-B = BACK TO BACK  
 EXISTING = - - - - -  
 NEW = \_\_\_\_\_

<b>PROJECT LAYOUT SHEET</b>	PROJECT NAME: CASTLETON - SUDBURY	PLOT DATE: 11-JUN-2007 13:34
	PROJECT NUMBER: STP 2402(I)S	DRAWN BY: C.A.K.
	FILE NAME: p04c028.dgn	CHECKED BY: D.E.G.
	DESIGNED BY: D.W.E.	SHEET 36 OF 92