


**UTILITY NOTES**

- ① EXISTING ELECTRIC POLE 53 229X TO REMAIN
- ② EXISTING TELEPHONE POLE 191 229 A TO REMAIN
- ③ NEW ELECTRIC POLE 229  
NEW GUY WIRE (2)
- ④ EXISTING ELELCTRIC POLE 229 TO BE REMOVED  
EXISTING GUY WIRE (2) TO BE REMOVED
- ⑤ EXISTING TELEPHONE POLE TO REMAIN
- ⑥ EXISTING TELEPHONE POLE 192 TO REMAIN

THE CONTRACTOR SHOULD BE AWARE THAT EXISTING ACTIVE BURIED UTILITIES (SUCH AS PHONE CABLE, FIBER OPTIC CABLE, ETC.) ARE LOCATED ADJACENT TO VT. ROUTE 30 WITHIN THE PROJECT LIMITS SOUTH OF COMBINATION POLE 228. THE CONTRACTOR IS RESPONSIBLE FOR CONTACTING "DIG SAFE" AT 1-888-344-7233 TO DETERMINE THE EXACT LOCATIONS OF THESE UTILITIES PRIOR TO PERFORMING ANY OPERATION THAT MAY DISTURB THE EXISTING SUBSURFACE CONDITIONS.

NOTE: THIS PLAN SHEET HAS BEEN INCLUDED TO DISPLAY THE UTILITY RELOCATION ROUTE TO THE NECESSARY EXTENT. THERE WILL BE NO CONSTRUCTION ACTIVITIES ASSOCIATED WITH PROJECT ST 0161(23) OCCURRING IN THIS AREA. THEREFORE A CORRESPONDING PROFILE SHEET HAS NOT BEEN INCLUDED IN THIS PLAN SET.

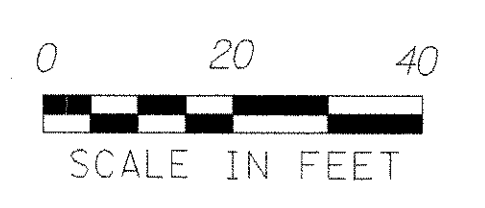

PROJECT NAME: HUBBARDTON	
PROJECT NUMBER: ST 0161(23)	
FILE NAME: PW/03c044/Design/d03c044bdr	PLOT DATE: 21-MAR-2006
PROJECT LEADER: K. UPMAL	DRAWN BY: J. DEVLIN
DESIGNED BY: J. DEVLIN	CHECKED BY: R. DELLASANTA
PLAN SHEET I	SHEET 61 OF 92