


REMOVAL AND DISPOSAL OF GUARDRAIL  
 STA 5+43.2 - 8+50.0 LT  
 STA 4+92.6 - 8+50.0 RT

BOX BEAM GUARDRAIL (MOD. - 7' POSTS & 3' POST SPACING)  
 STA 4+74.1 - 8+50.0 RT  
 STA 5+89.1 - 8+50.0 LT

MANUFACTURED TERMINAL SECTION (MOD.)  
 STA 4+25.0 - 4+74.1 RT  
 STA 5+40.0 - 5+89.1 LT

CONSTRUCT DRIVEWAY PAVED ASPHON  
 STA 4+00.0 RT  
 STA 5+09.1 LT


STATION 3+75 BEGIN PROJECT  
 = STP 2402(1) S STA 88+73.50

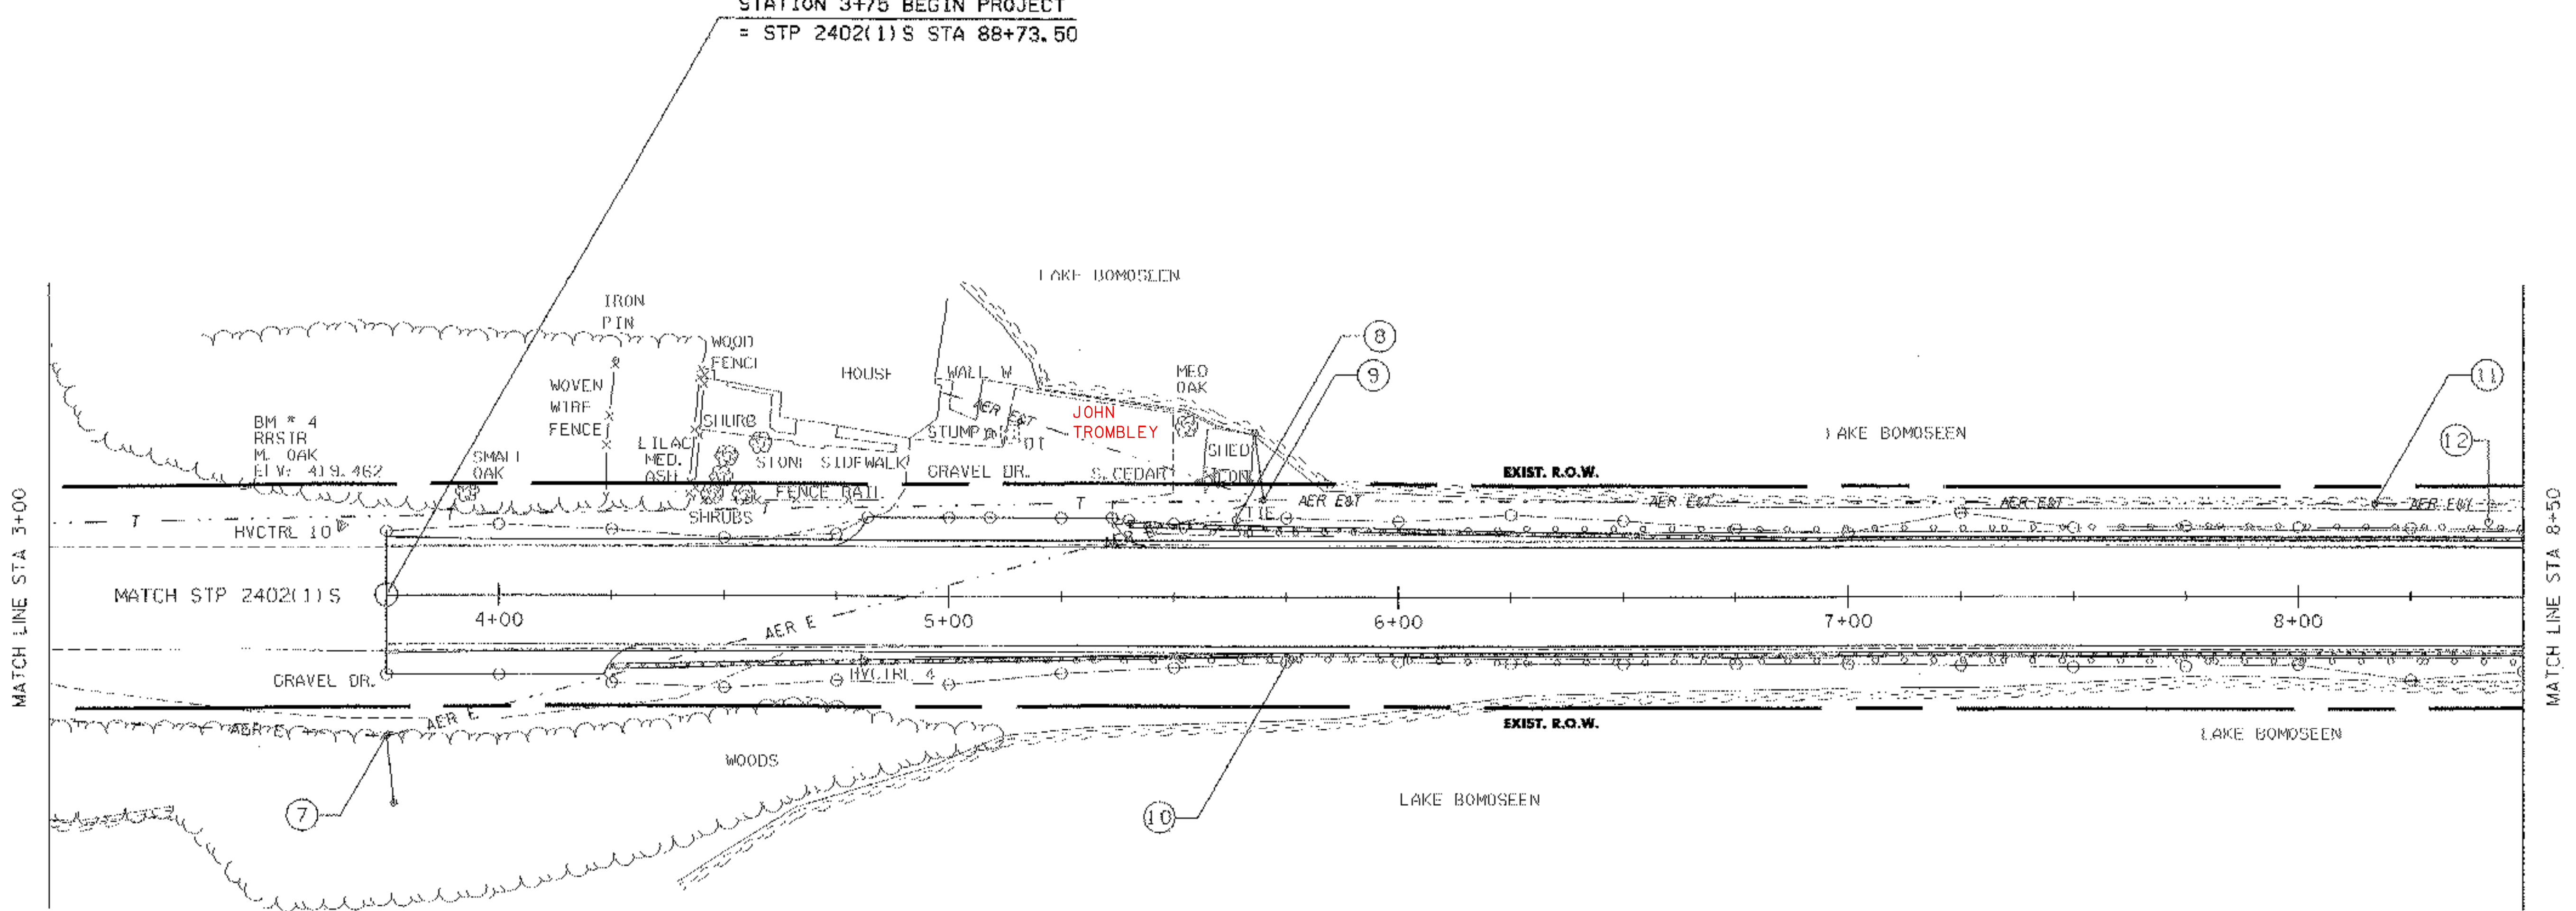

UTILITY NOTES

- ⑦ STA 3+75.00 RIGHT  
 NEW ELECTRIC POLE 228X  
 NEW GUY WIRE
- ⑧ STA 5+64.00 LEFT  
 EXISTING TELEPHONE POLE  
 TO BE REMOVED
- ⑨ STA 5+70.00 LEFT  
 NEW COMBINATION POLE 228  
 NEW GUY WIRE  
 END ACTIVE UNDERGROUND UTILITIES
- ⑩ STA 5+76.00 RIGHT  
 EXISTING ELECTRIC POLE 228  
 TO BE REMOVED
- ⑪ STA 8+17.00 LEFT  
 NEW COMBINATION POLE 227X
- ⑫ STA 8+42.00 LEFT  
 EXISTING TELEPHONE POLE 194  
 TO BE REMOVED

THE CONTRACTOR SHOULD BE AWARE THAT EXISTING ACTIVE BURIED UTILITIES (SUCH AS PHONE CABLE, FIBER OPTIC CABLE, ETC.) ARE LOCATED ADJACENT TO VT. ROUTE 30 WITHIN THE PROJECT LIMITS SOUTH OF COMBINATION POLE 228. THE CONTRACTOR IS RESPONSIBLE FOR CONTACTING "DIG SAFE" AT 1-888-344-7233 TO DETERMINE THE EXACT LOCATIONS OF THESE UTILITIES PRIOR TO PERFORMING ANY OPERATION THAT MAY DISTURB THE EXISTING SUBSURFACE CONDITIONS.

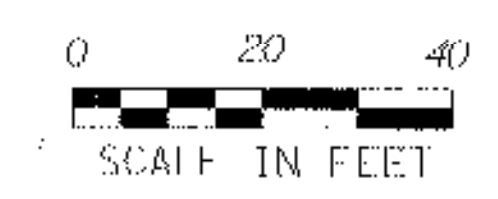

PROJECT NAME:	HUBBARDTON
PROJECT NUMBER:	ST 0161(23)
FILE NAME: PW/03c044/Design/d03c044bdr	PLOT DATE: 21-MAR-2006
PROJECT LEADER: K. UPMAL	DRAWN BY: J. DEVLIN
DESIGNED BY: J. DEVLIN	CHECKED BY: R. DELLASANTA
PLAN SHEET 2, STA 3+00 - 8+50	SHEET 62 OF 92