



**VT ROUTE 30  
GUARDRAIL DETAIL SHEET**

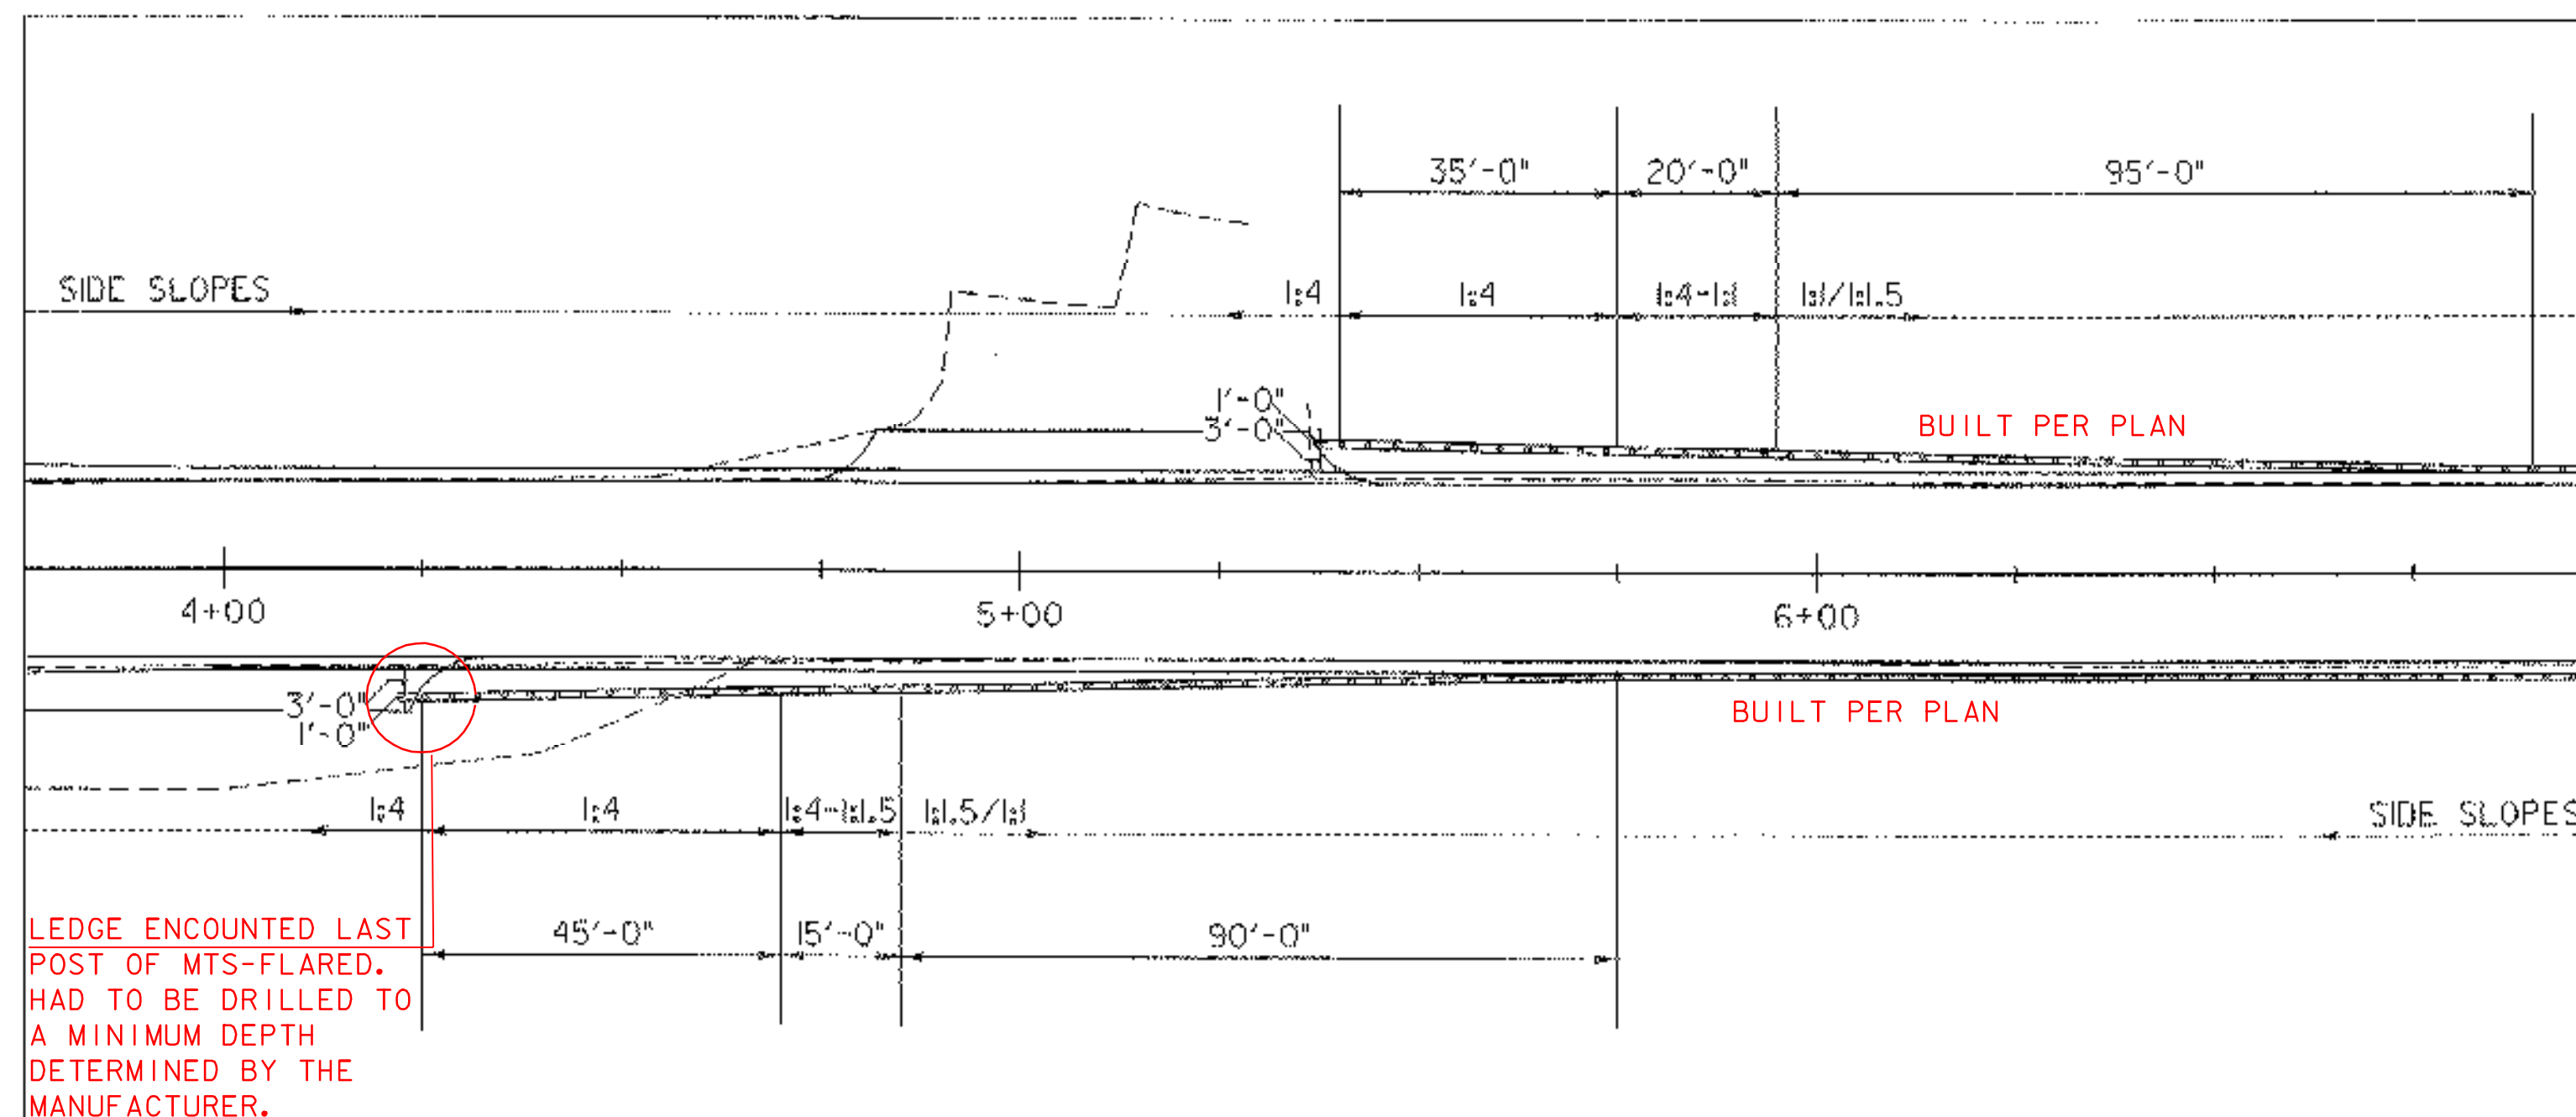

**MANUFACTURED END TERMINAL (MOD) GRADING DETAIL**

STA 4+25.0 - STA 4+74.1 RT  
STA 5+40.0 - STA 5+89.1 LT

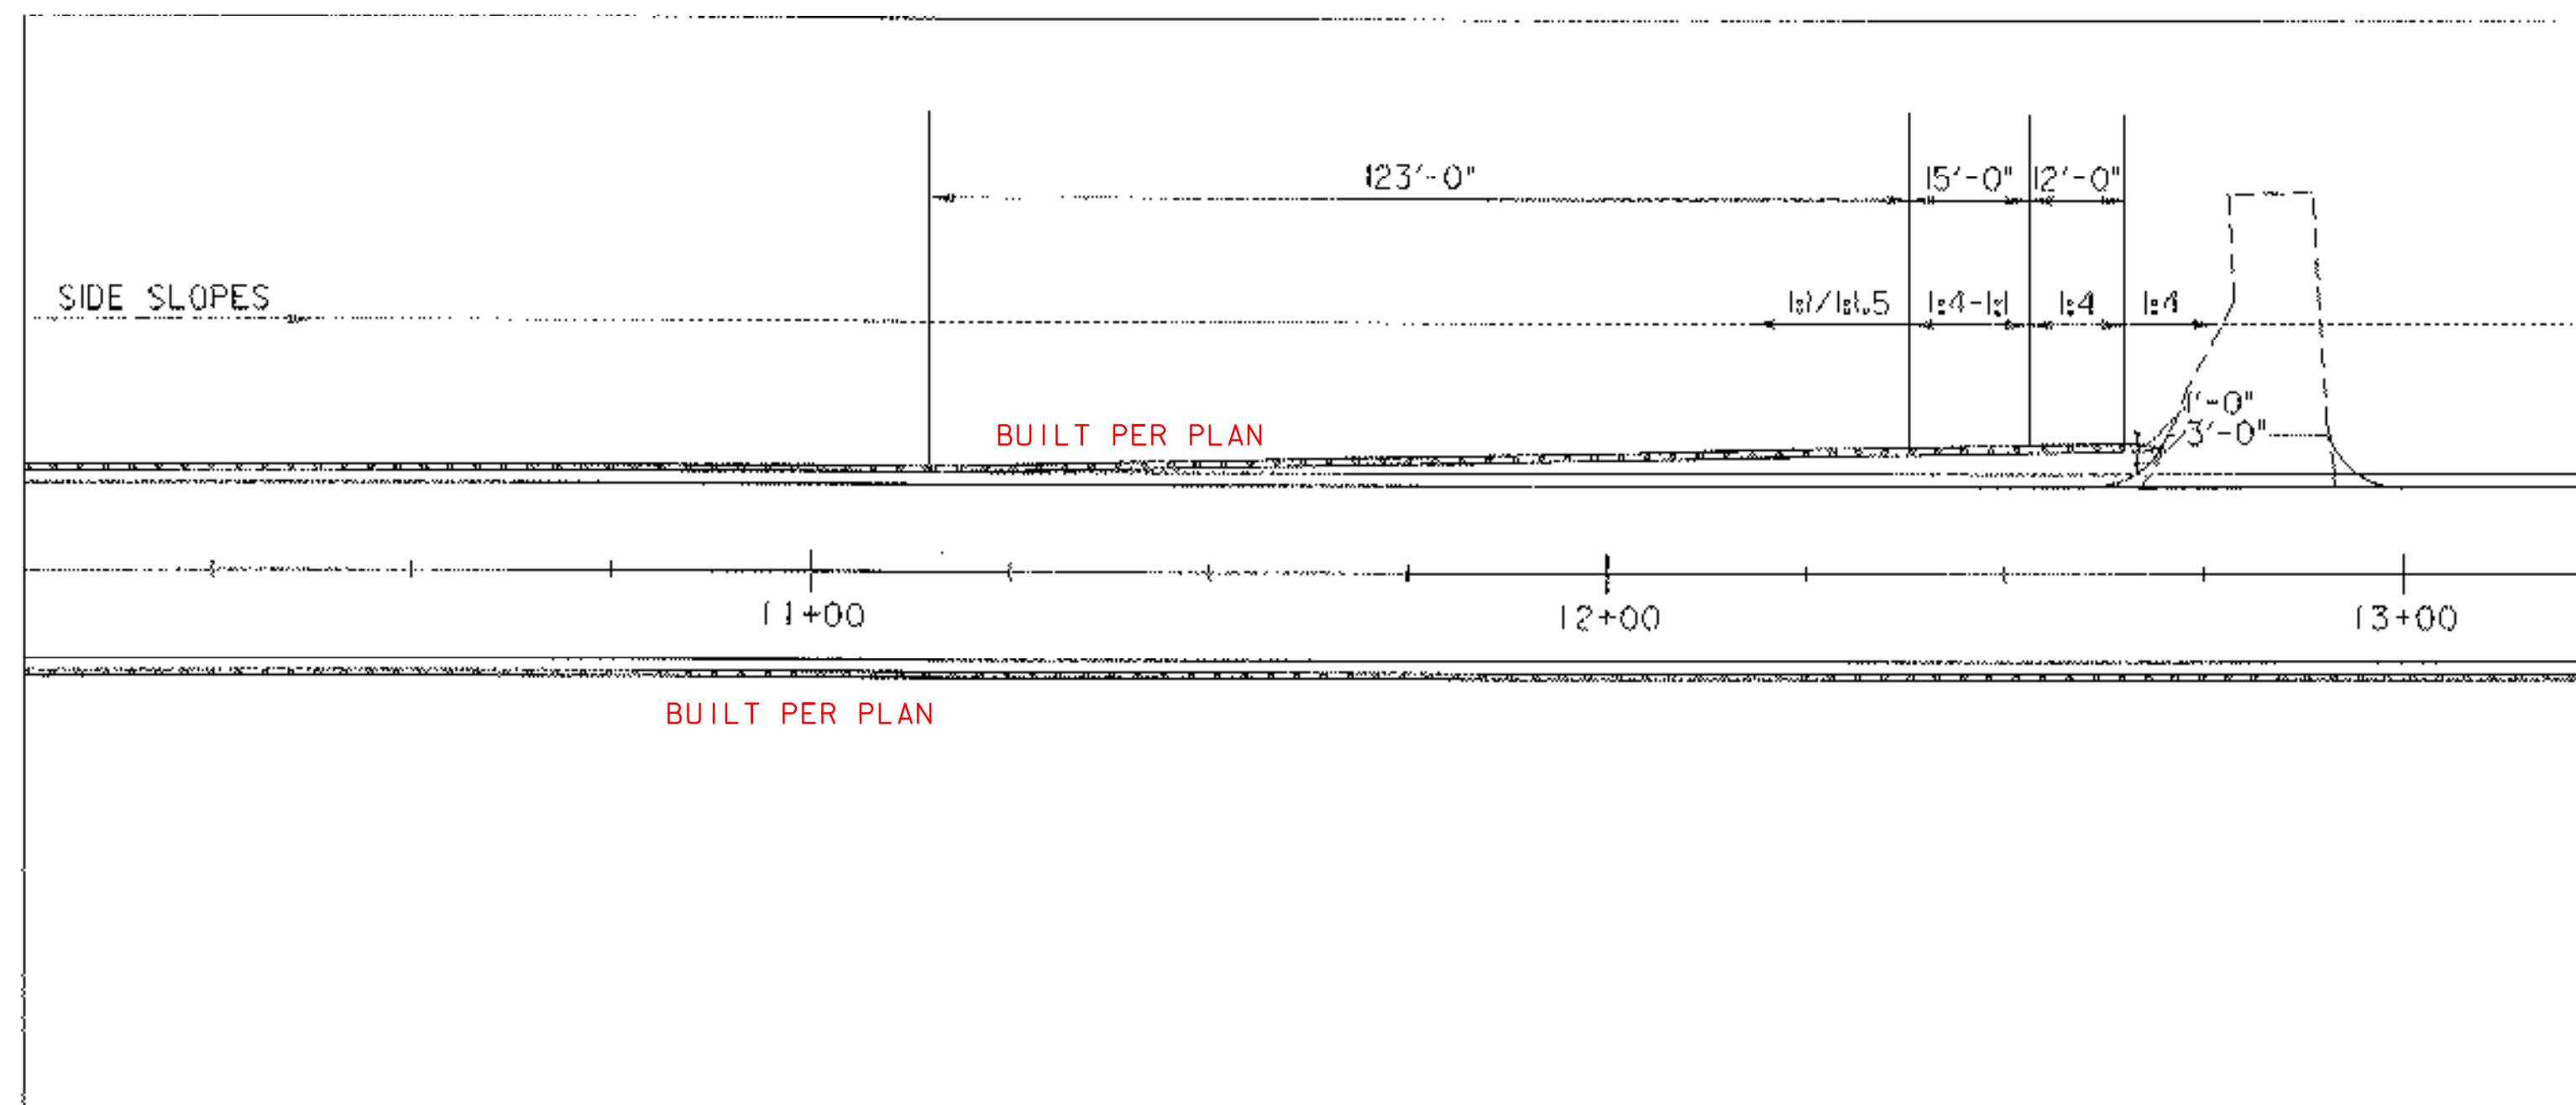

**MANUFACTURED END TERMINAL (MOD) GRADING DETAIL**

STA 12+15.9 - 12+65.0 LT

PROJECT NAME: HUBBARDTON  
PROJECT NUMBER: ST 016(23)

FILE NAME: PW/03c044/Design/d03c044typ PLOT DATE: 21-MAR-2006  
PROJECT LEADER: K. LIPMAL DRAWN BY: J. DEVLIN  
DESIGNED BY: J. DEVLIN CHECKED BY: R. DELLASANTA  
GUARDRAIL DETAIL SHEET 1 SHEET 68 OF 92