
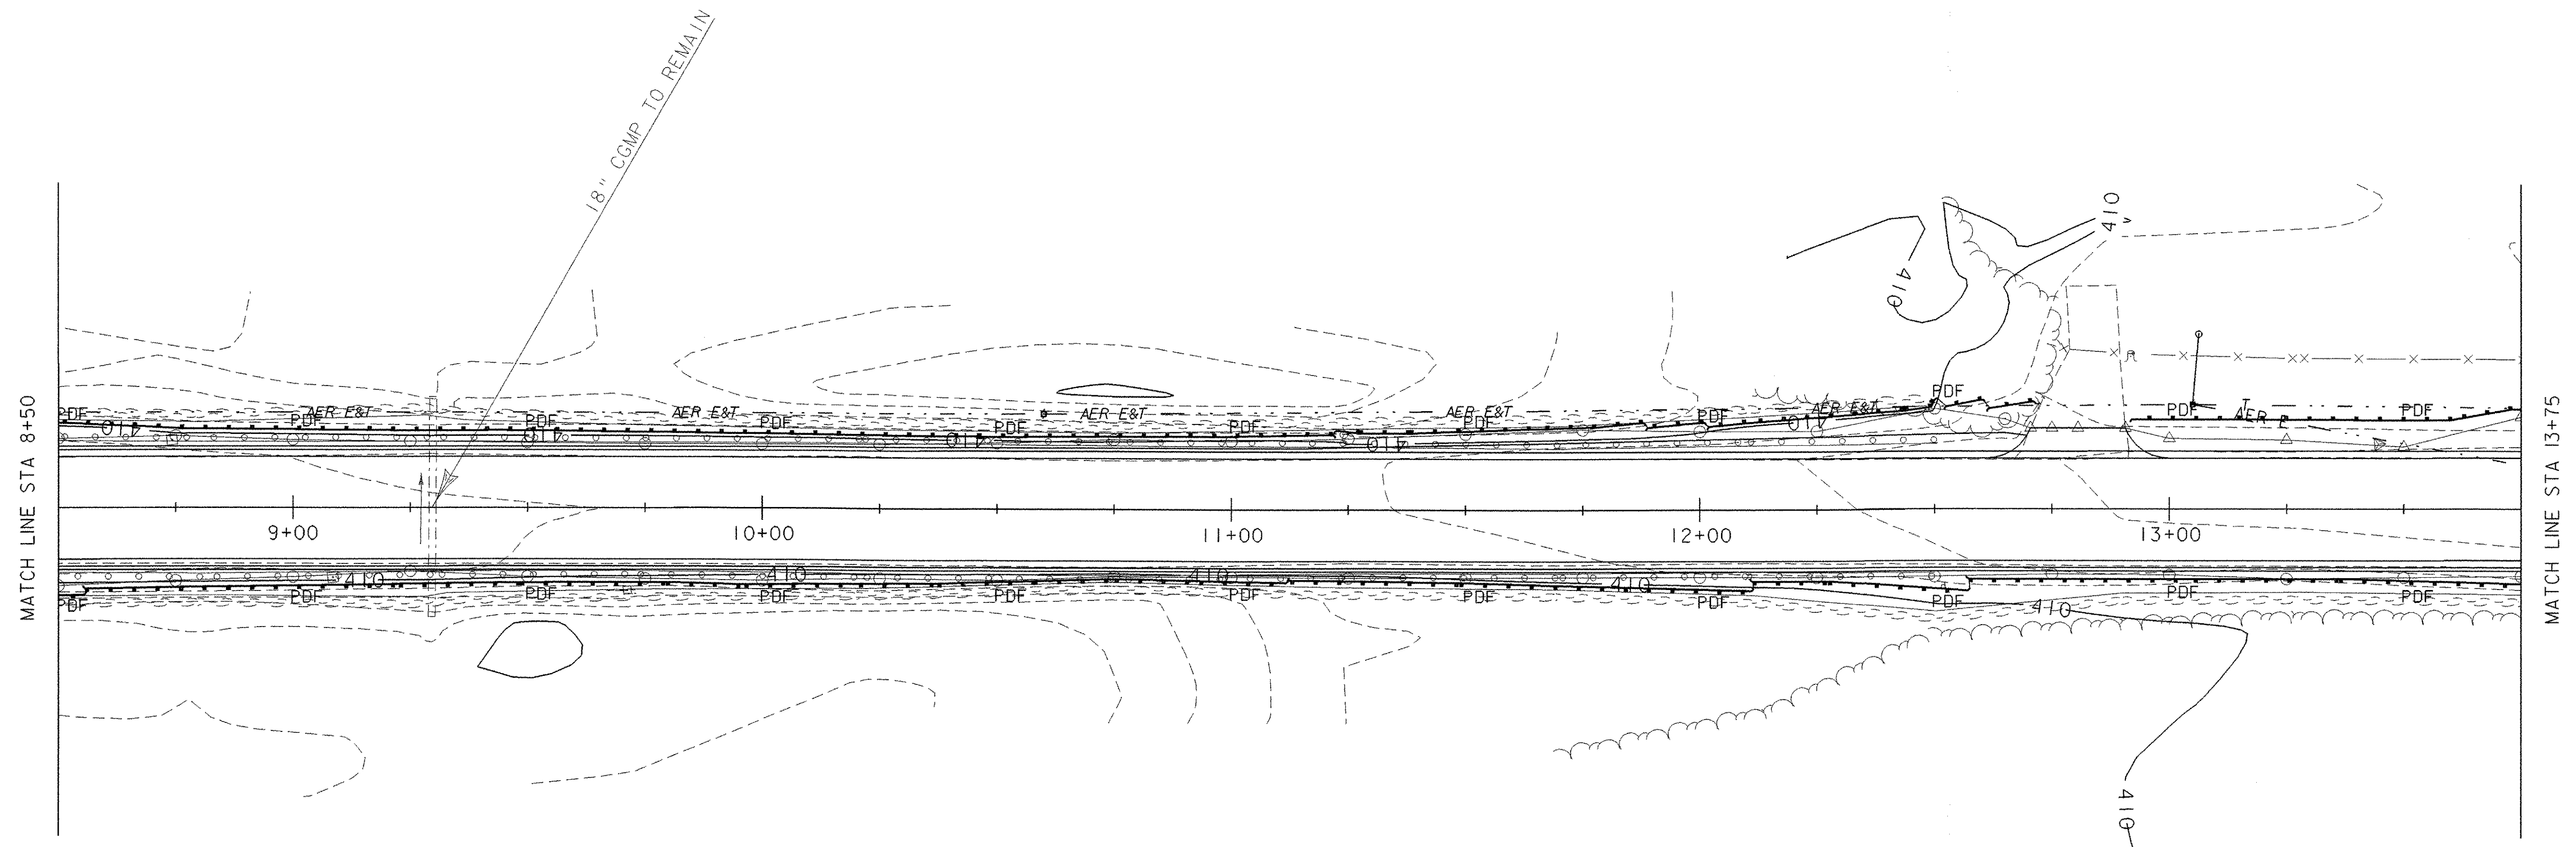


MISCELLANEOUS FENCE (MOD. - SEDIMENT LOG)

STA 8+50.0 - STA 11+21.6 LT
 STA 8+50.0 - STA 8+55.3 RT
 STA 8+55.9 - STA 11+11.4 RT
 STA 11+12.8 - STA 12+10.8 RT
 STA 11+22.8 - STA 11+87.7 LT
 STA 11+89.2 - STA 12+00.6 LT
 STA 12+02.2 - STA 12+49.9 LT
 STA 12+11.4 - STA 12+56.8 RT
 STA 12+52.7 - STA 12+59.9 LT
 STA 12+57.4 - STA 13+75.0 RT
 STA 12+61.8 - STA 12+70.6 LT
 STA 12+92.4 - STA 13+75.0 LT

SNOW FENCE (MOD. - PDF)

STA 8+50.0 - STA 12+70.6 LT
 STA 8+50.0 - STA 13+75.0 RT
 STA 12+92.4 - STA 13+75.0 LT

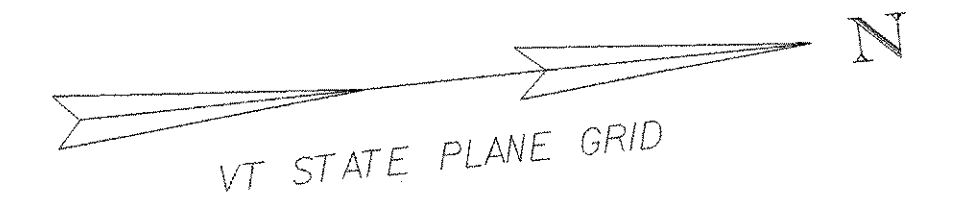

LEGEND	
	PERMANENT SLOPE LIMITS
	MISCELLANEOUS FENCE (MOD. - SEDIMENT LOG) + SNOW FENCE (MOD. - PDF)
	SNOW FENCE (MOD. - PDF)



PROJECT NAME:	HUBBARDTON
PROJECT NUMBER:	ST 016I(23)
FILE NAME:	/03c044/Design/d03c044erobdr
PLOT DATE:	21-MAR-2006
PROJECT LEADER:	K. UPMAL
DRAWN BY:	J. DEVLIN
DESIGNED BY:	J. DEVLIN
CHECKED BY:	R. DELLASANTA
EPSC PLAN SHEET	2
SHEET	76 OF 92