




M:\PROJECTS\03c044\CONSTRUCTION\FINAL XS\c03c044FXS.DGN
 FINAL CROSS SECTIONS FOR HUBBARDTON ST 0161 (23)
 DONE BY JOSH HULETT FOUND IN THE ABOVE FILE.

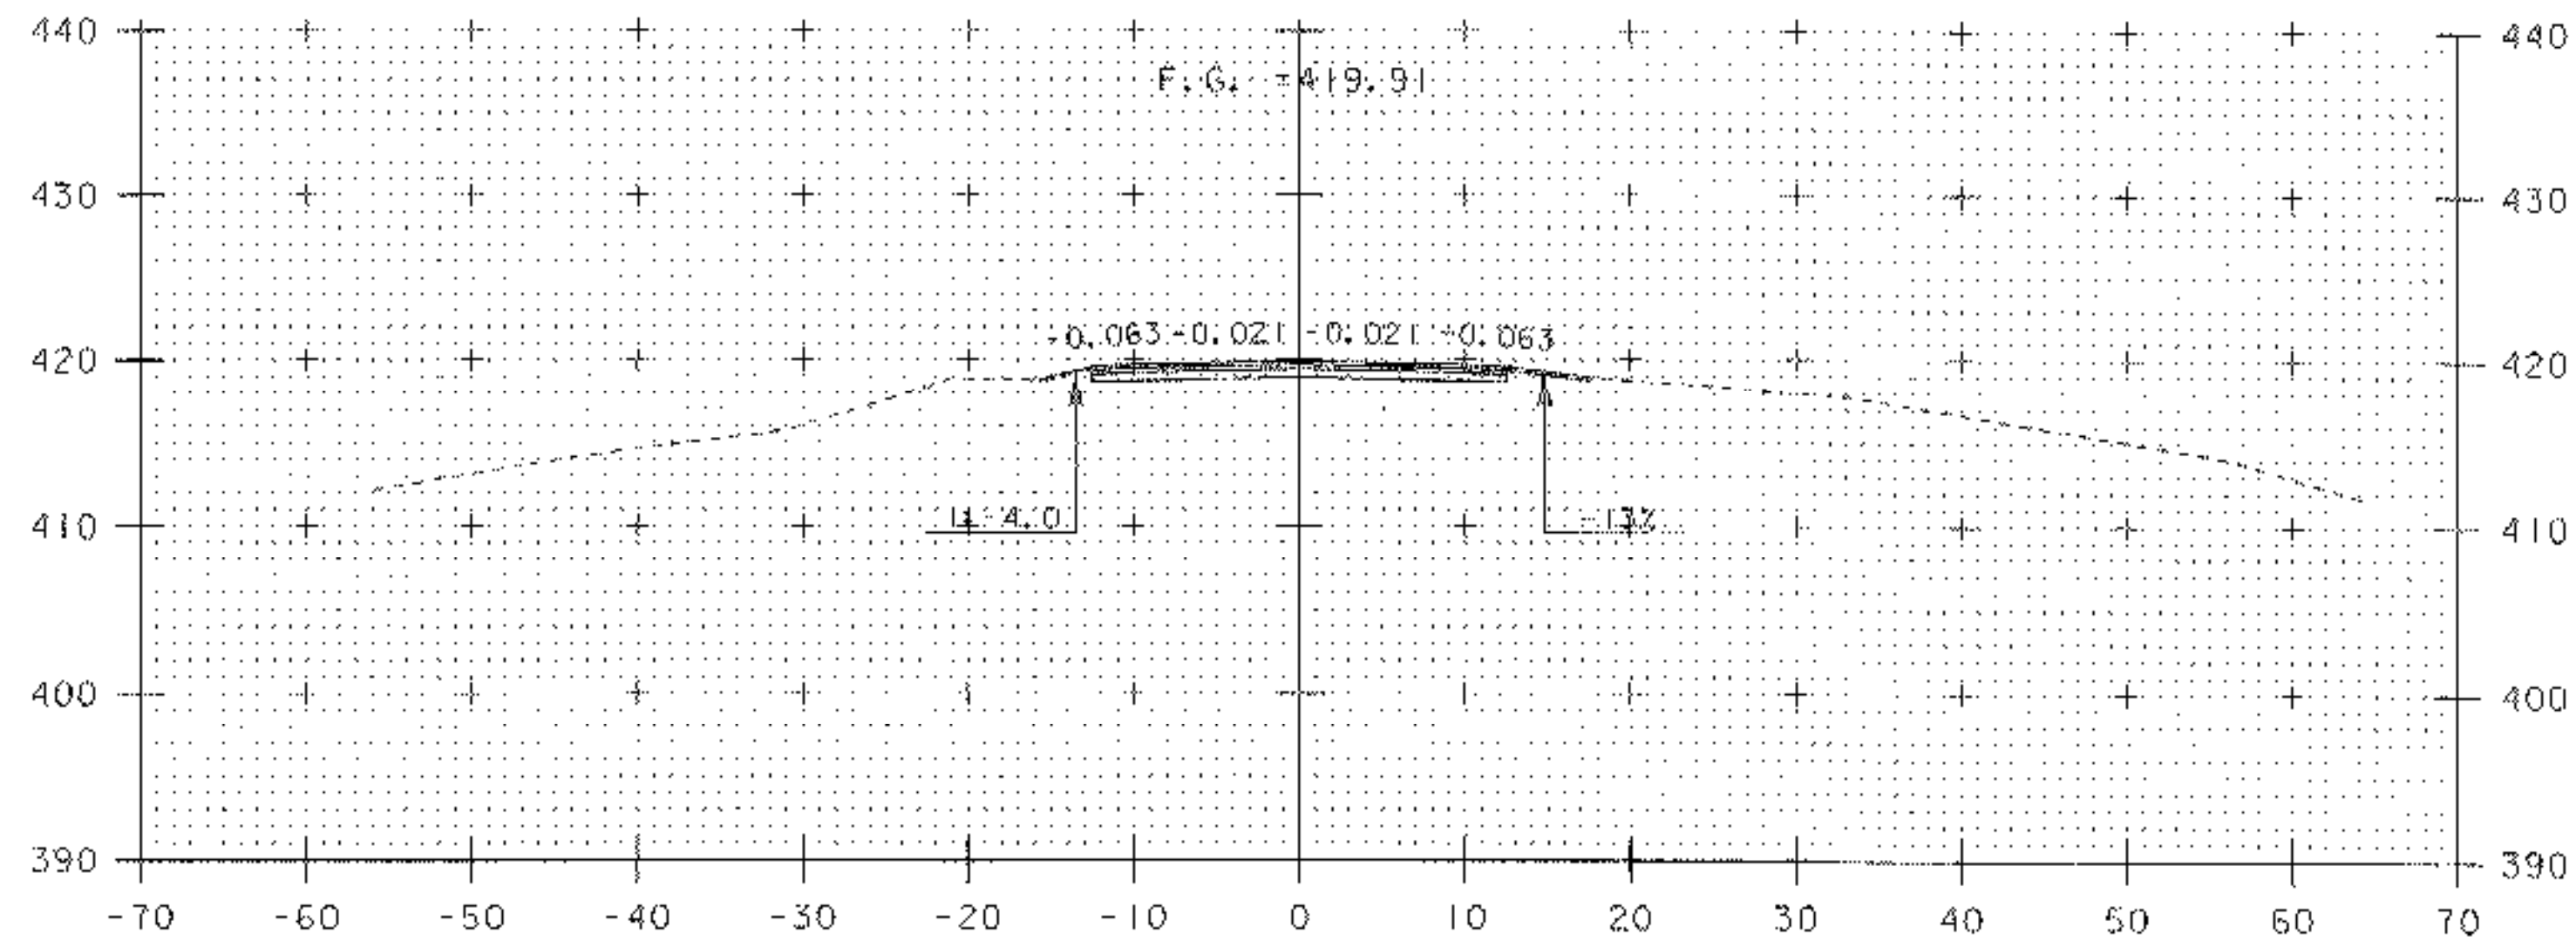


4+00
 GRAVEL PULLOUT RIGHT

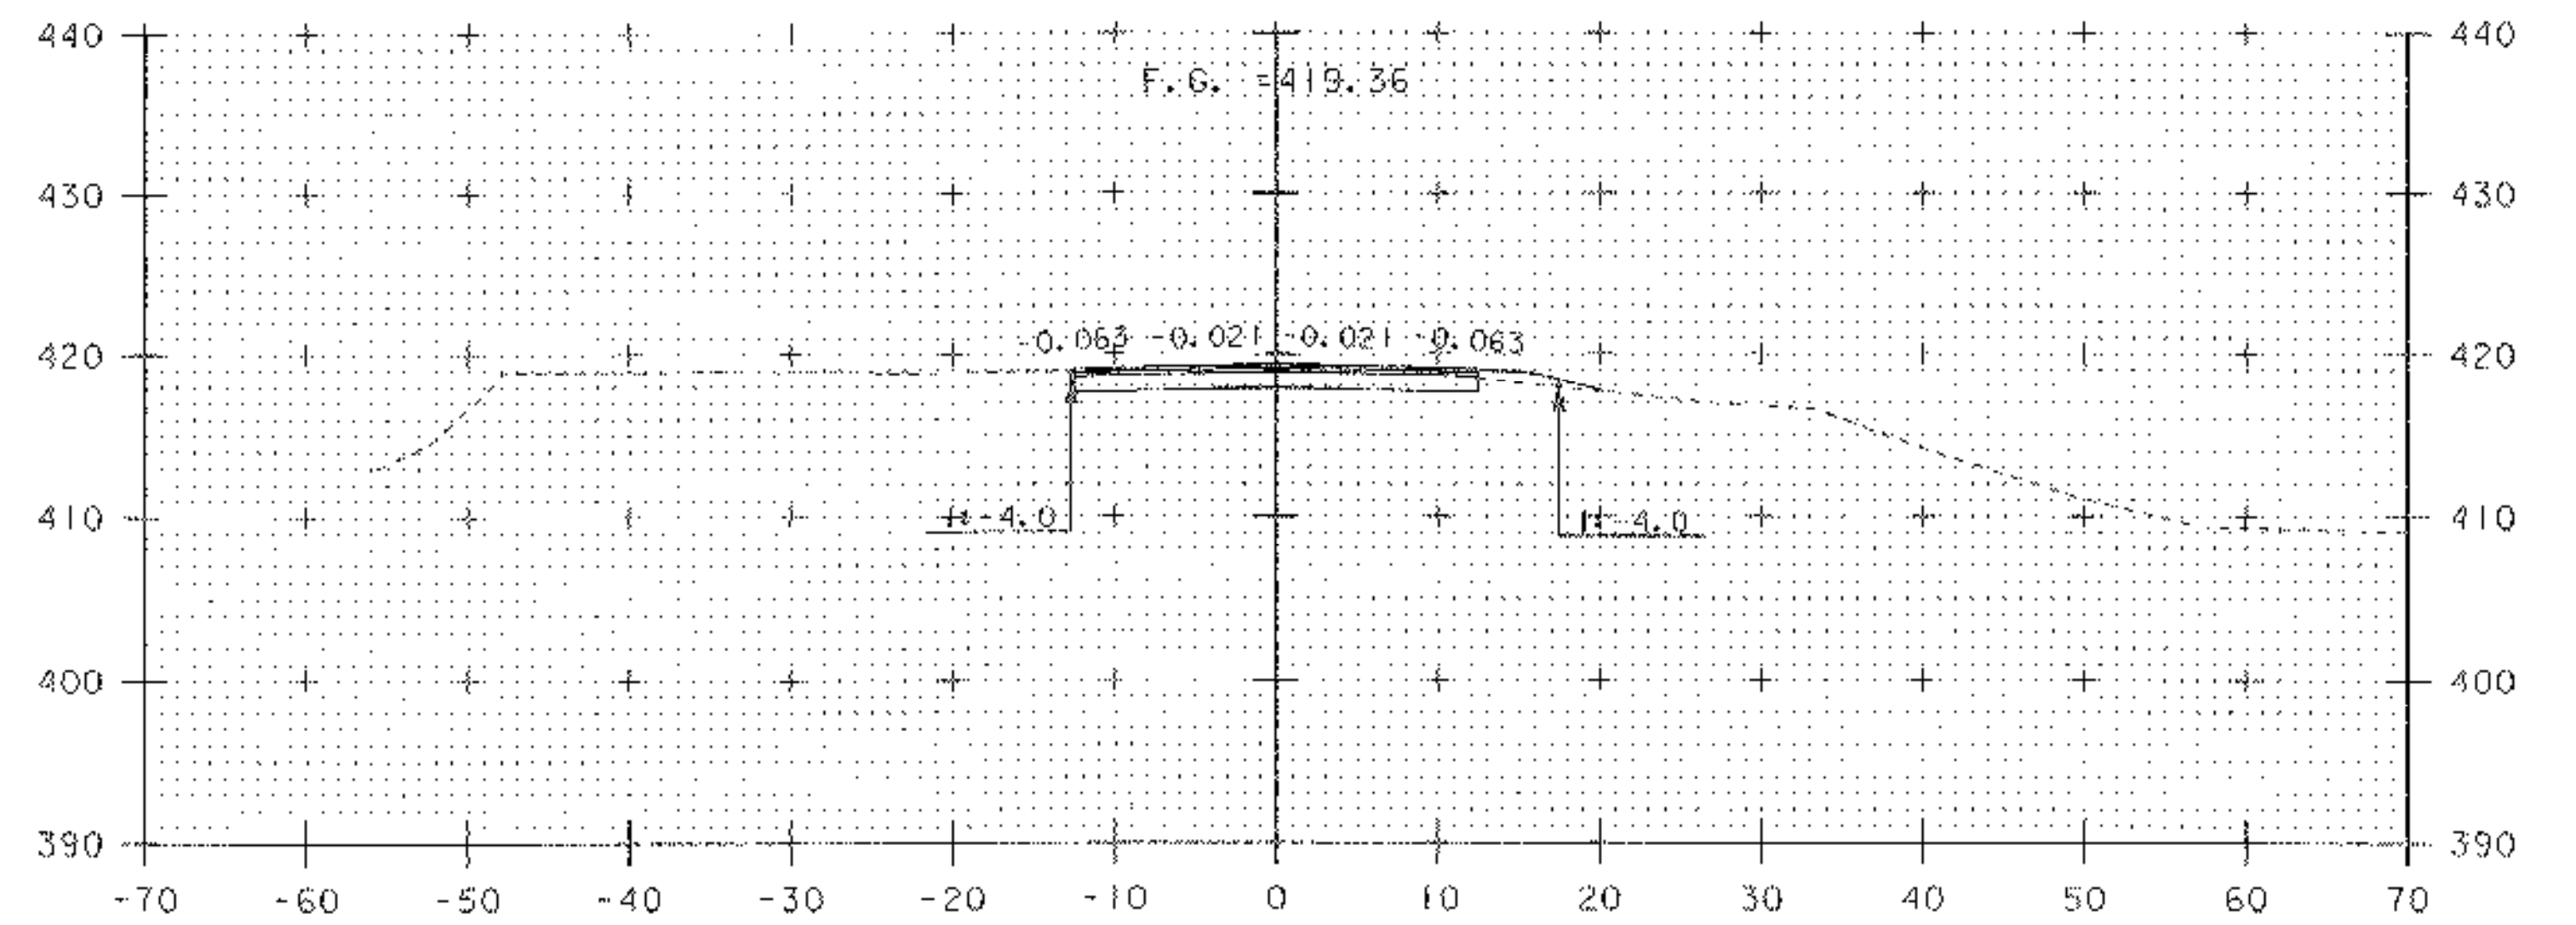

4+50

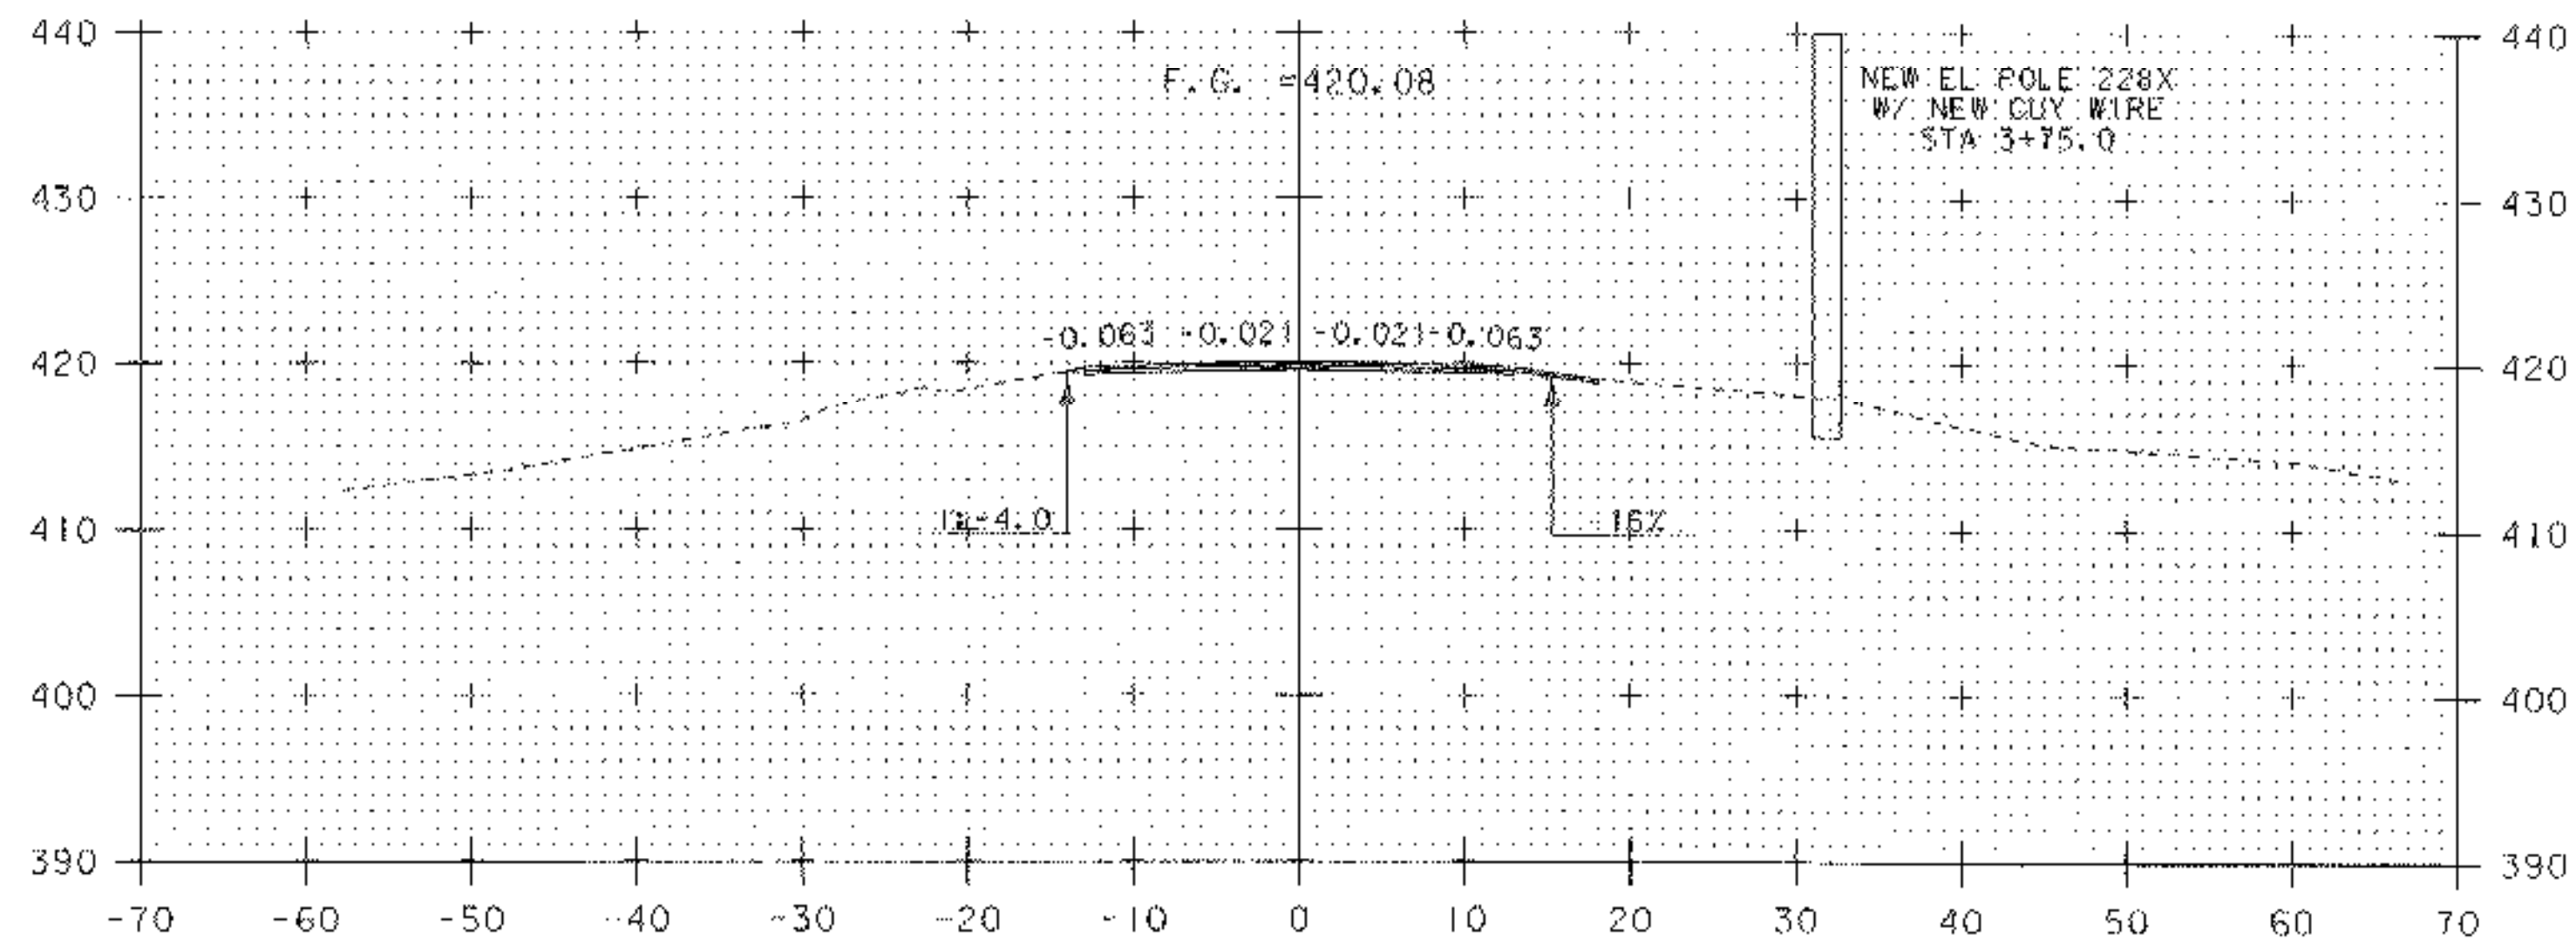

3+75
 GRAVEL PULLOUT RIGHT
 BEGIN PROJECT
 MATCH STP 2402 (1) S STA 88+73.50

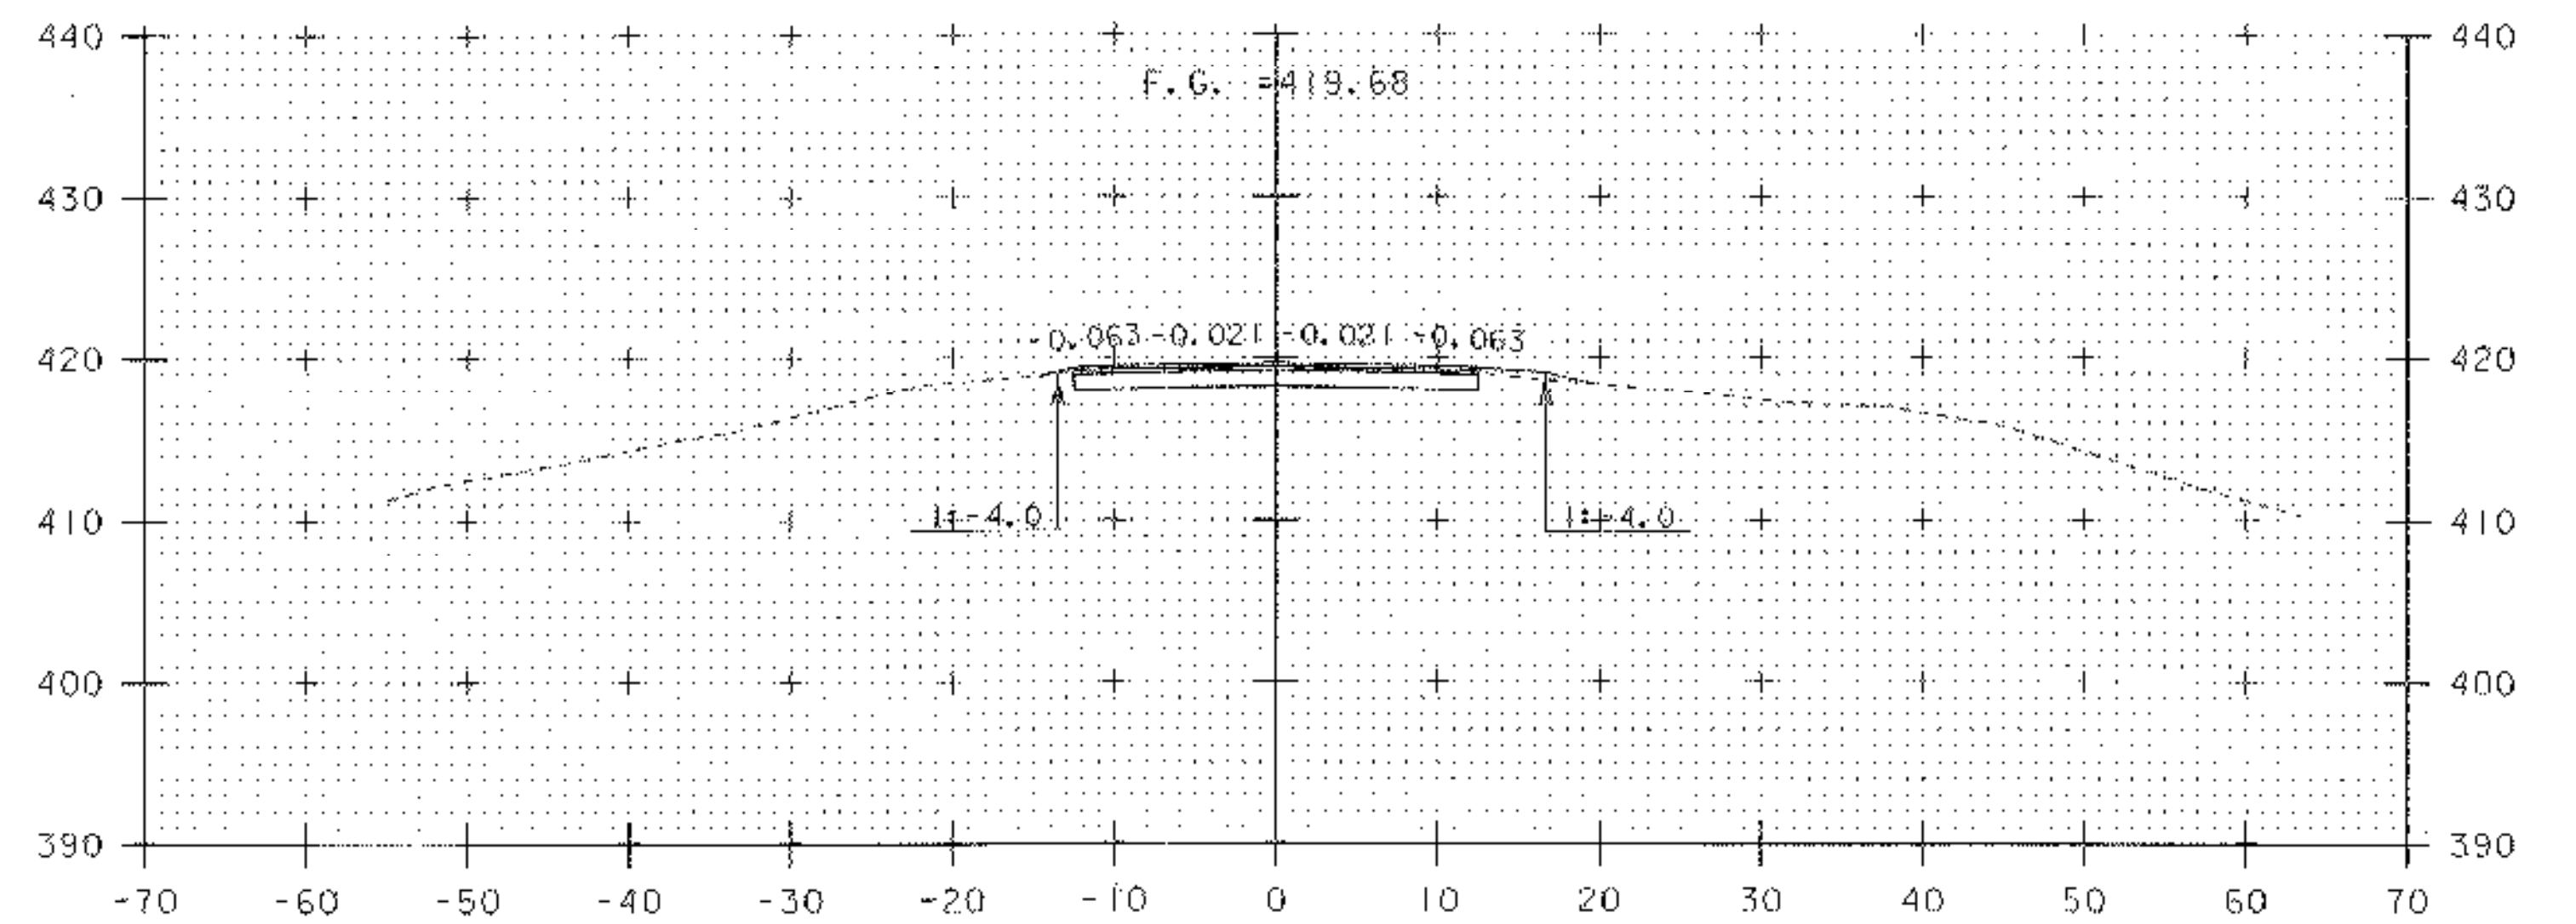

4+25



PROJECT NAME:	HUBBARDTON	FILE NAME:	PW\03c044\Design\d03c044xs	PLT DATE:	21-MAR-2006
PROJECT NUMBER:	ST 0161(23)	PROJECT LEADER:	K. UPMAL	DRAWN BY:	J. DEVLIN
		DESIGNED BY:	J. DEVLIN	CHECKED BY:	R. DELI ASANTA
		CROSS SECTIONS STA	3+75 - 4+50	SHEET	79 OF 92