




M:\PROJECTS\03c044\CONSTRUCTION\FINAL XS\c03c044FXS.DGN  
 FINAL CROSS SECTIONS FOR HUBBARDTON ST 0161 (23)  
 DONE BY JOSH HULETT FOUND IN THE ABOVE FILE.

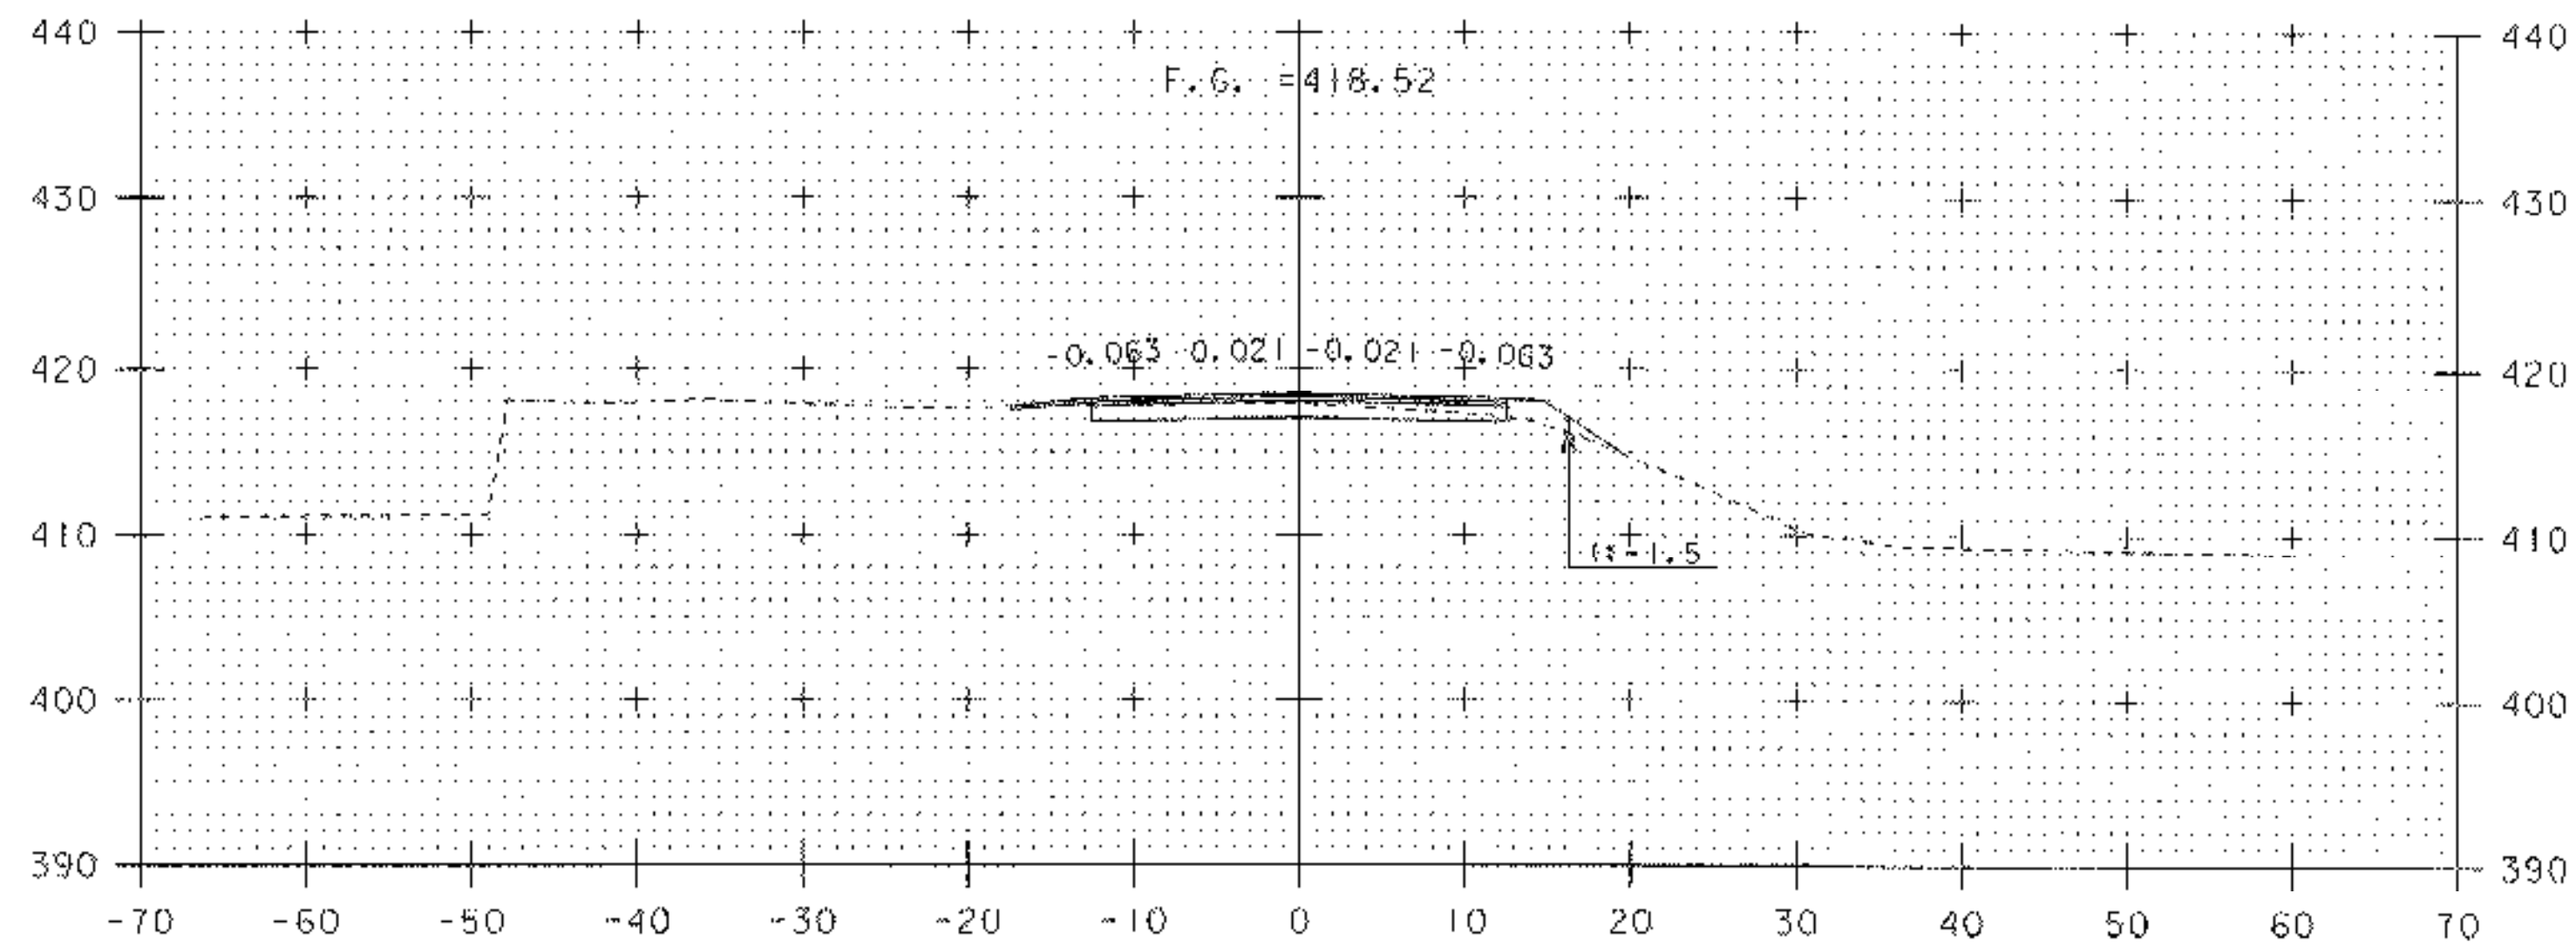


5+00

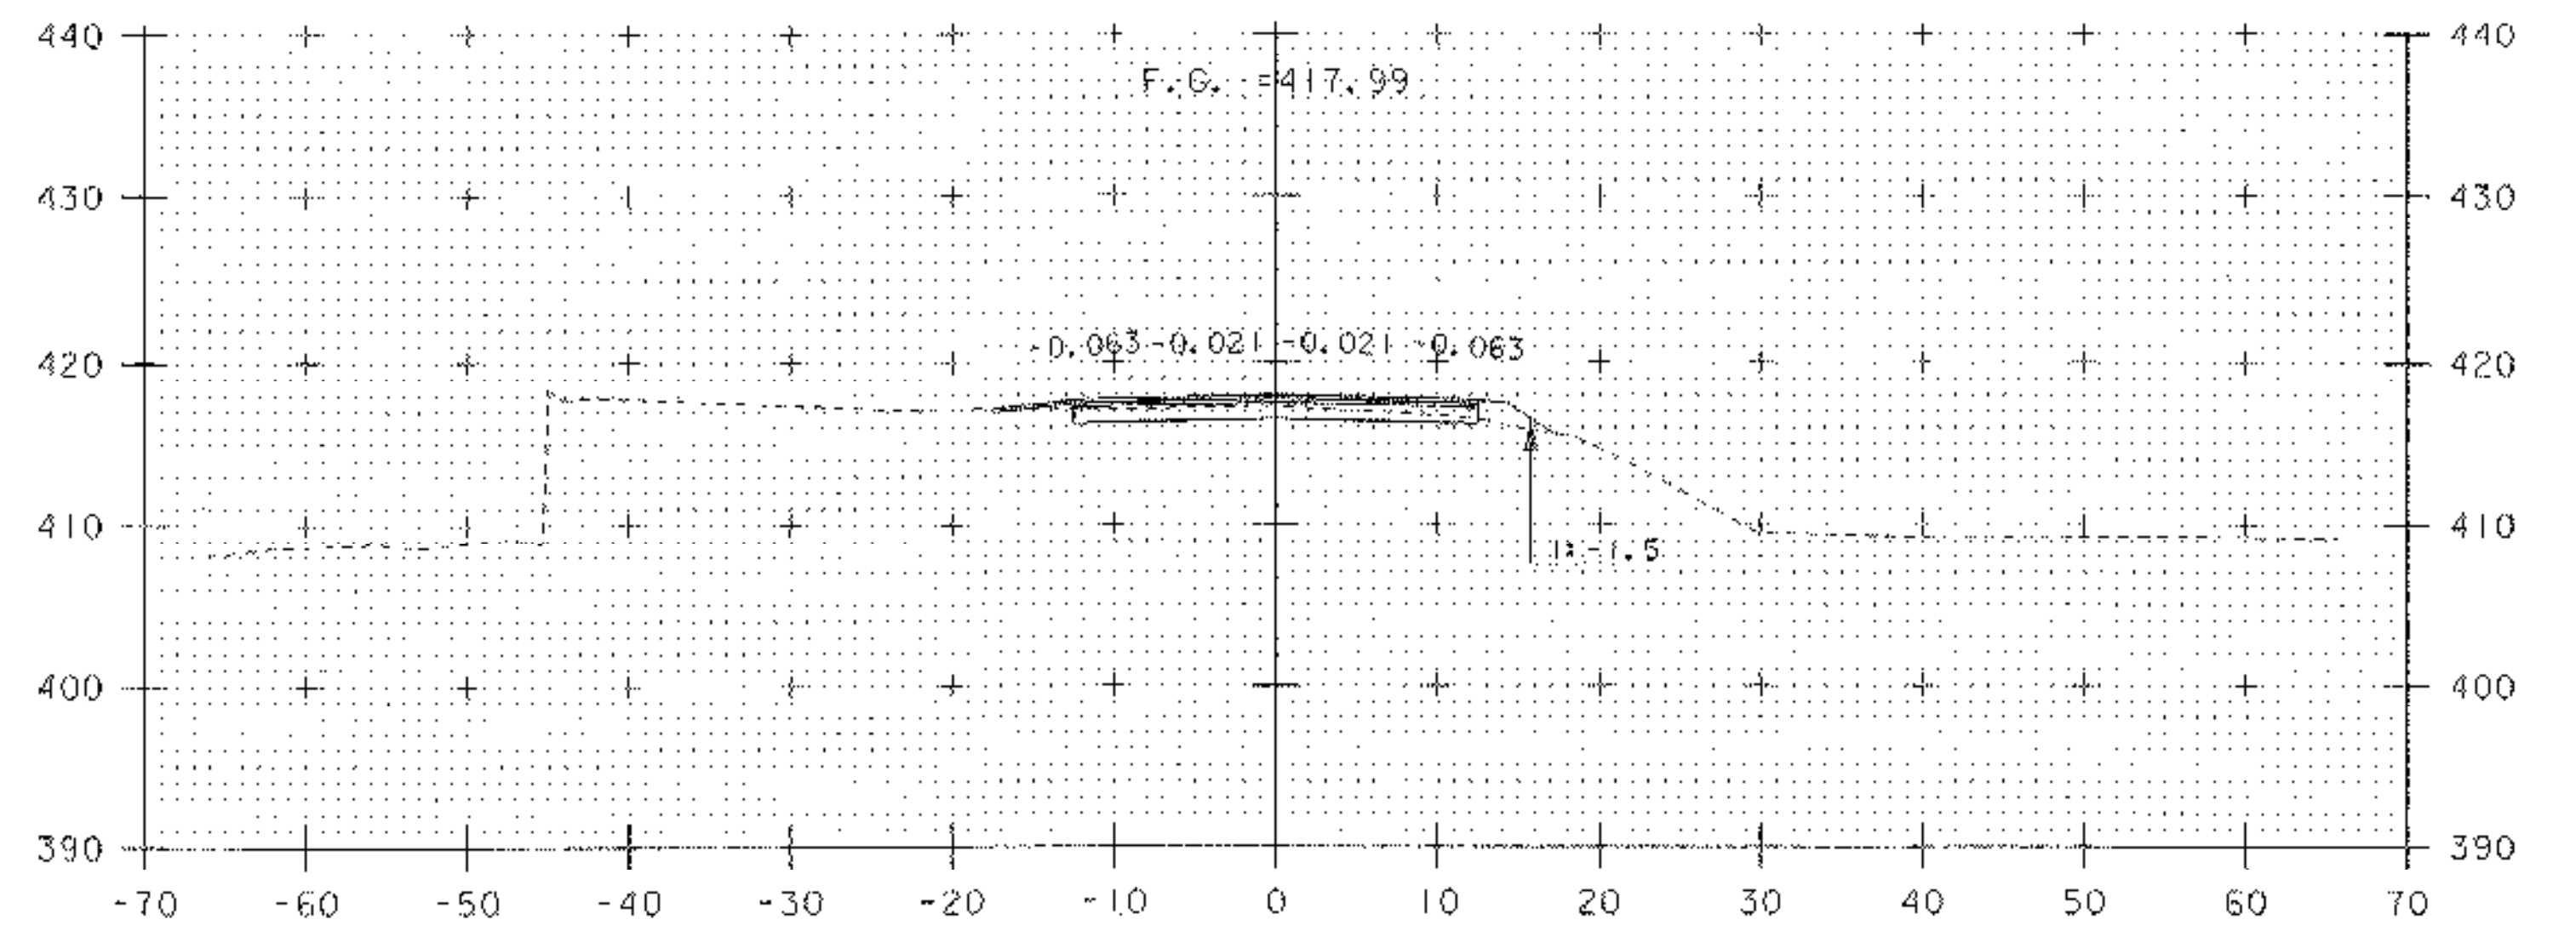


5+25

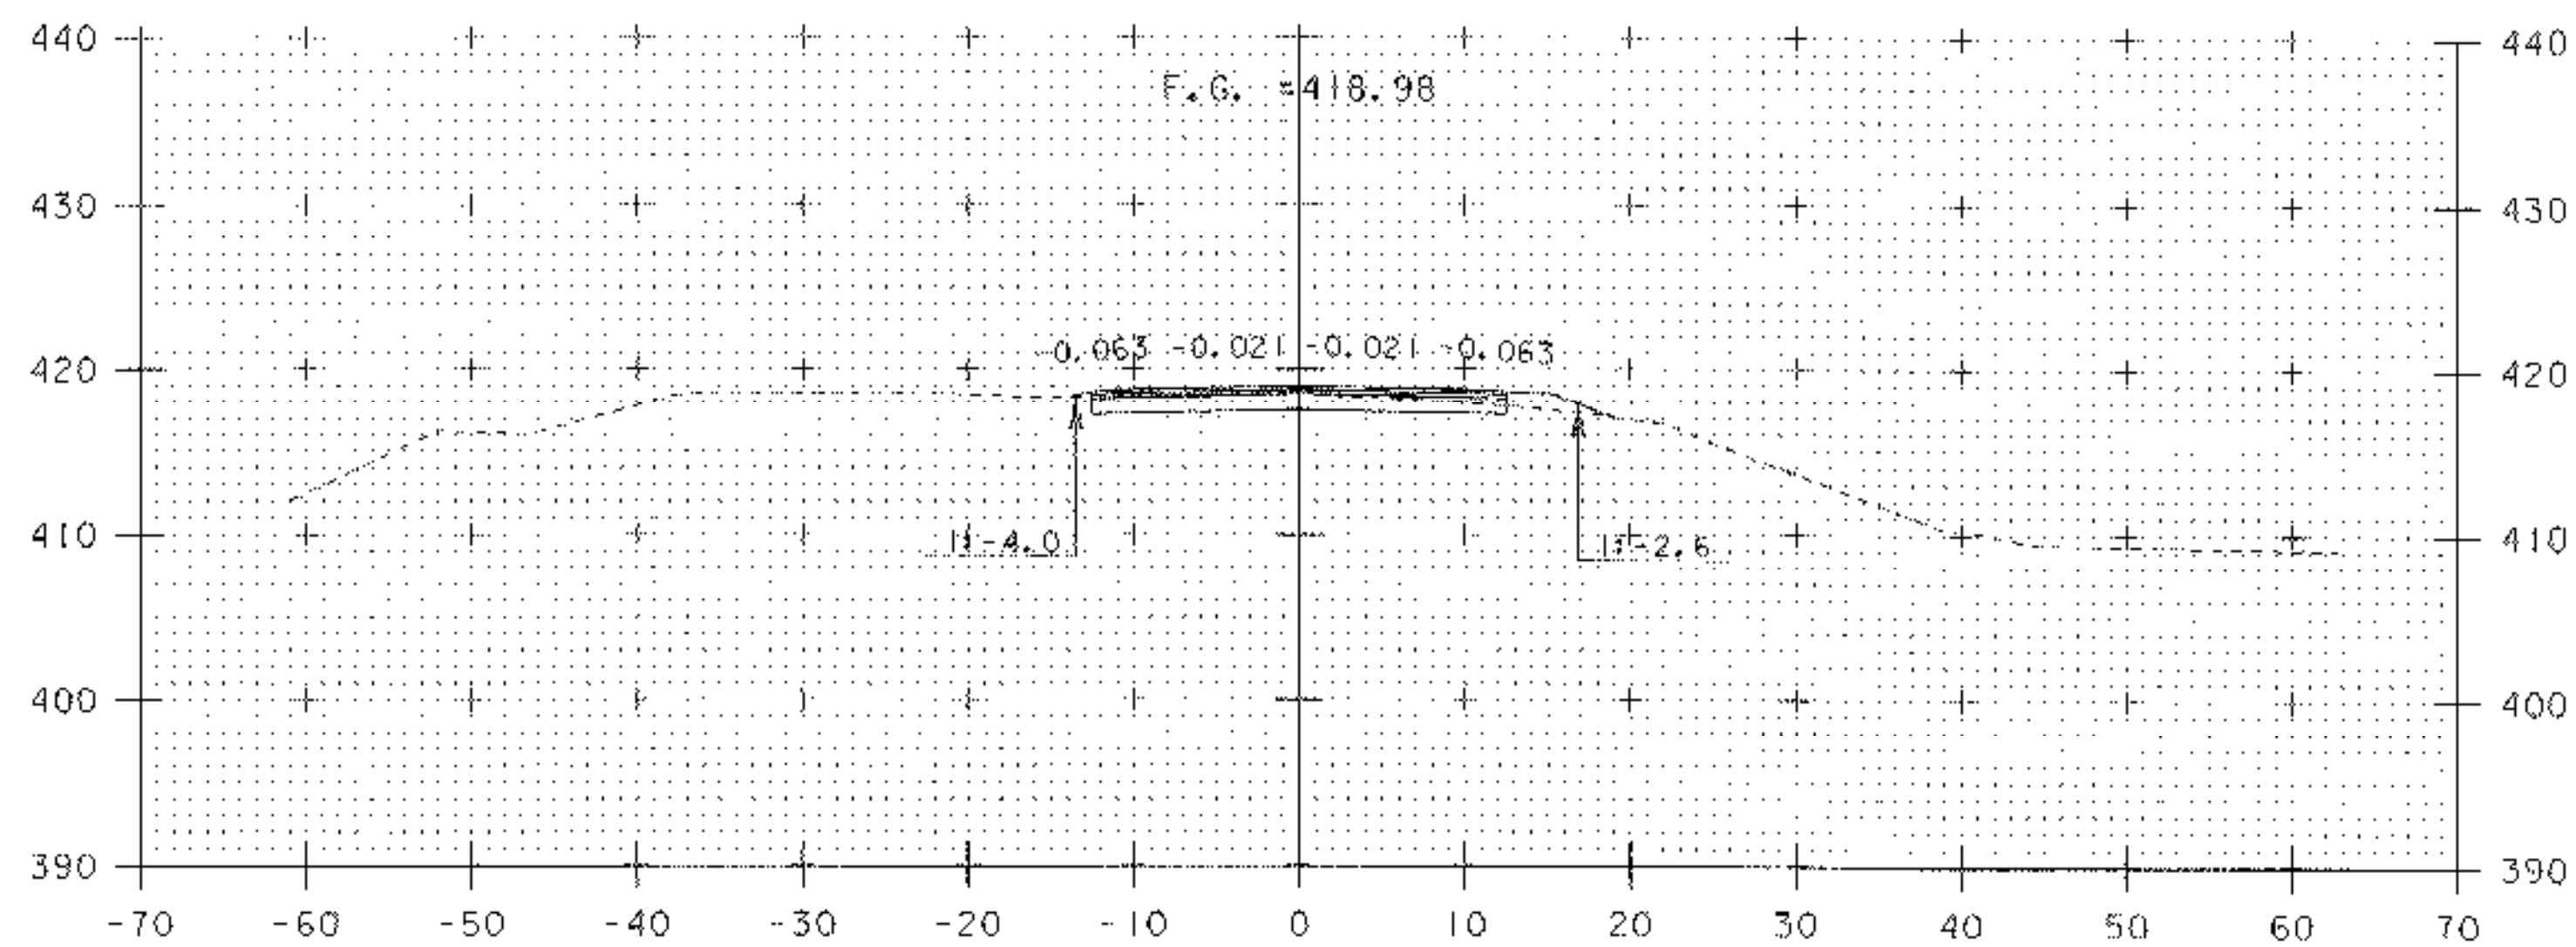

4+75

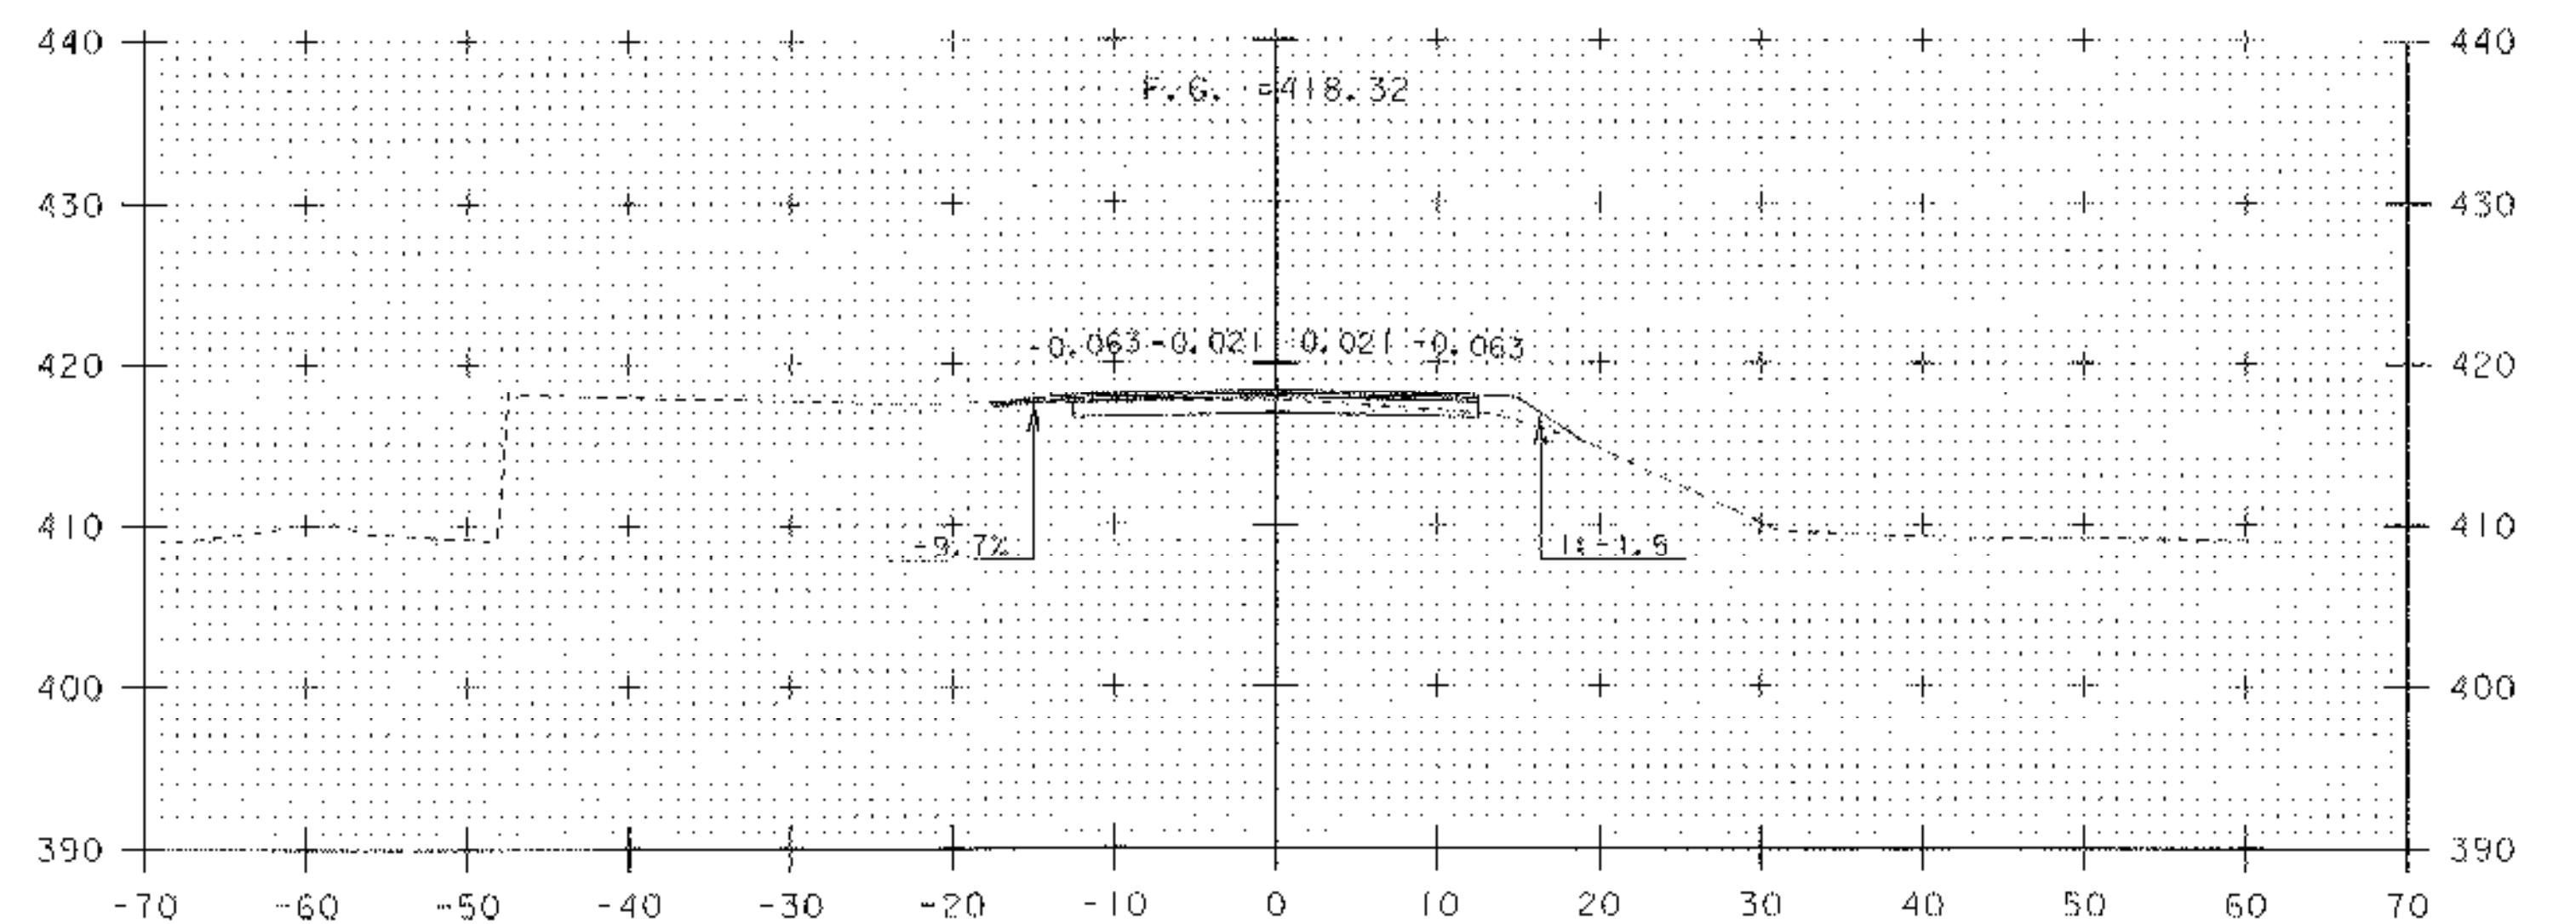

5+10  
DRIVE LEFT

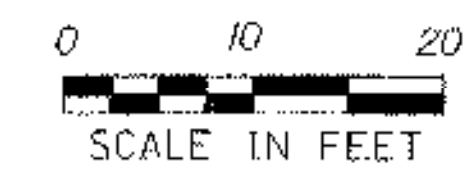

PROJECT NAME:	HUBBARDTON	PLOT DATE:	21-MAR-2006
PROJECT NUMBER:	ST 0161(23)	DRAWN BY:	J. DEVLIN
FILE NAME:	PW\03c044\Design\d03c044xs	CHECKED BY:	R. DELLASANTA
PROJECT LEADER:	K. UPMAL	CROSS SECTIONS STA	4+75 - 5+25
DESIGNED BY:	J. DEVLIN	SHEET	80 OF 92