




M:\PROJECTS\03c044\CONSTRUCTION\FINAL XS\c03c044FXS.DGN  
 FINAL CROSS SECTIONS FOR HUBBARDTON ST 0161 (23)  
 DONE BY JOSH HULETT FOUND IN THE ABOVE FILE.

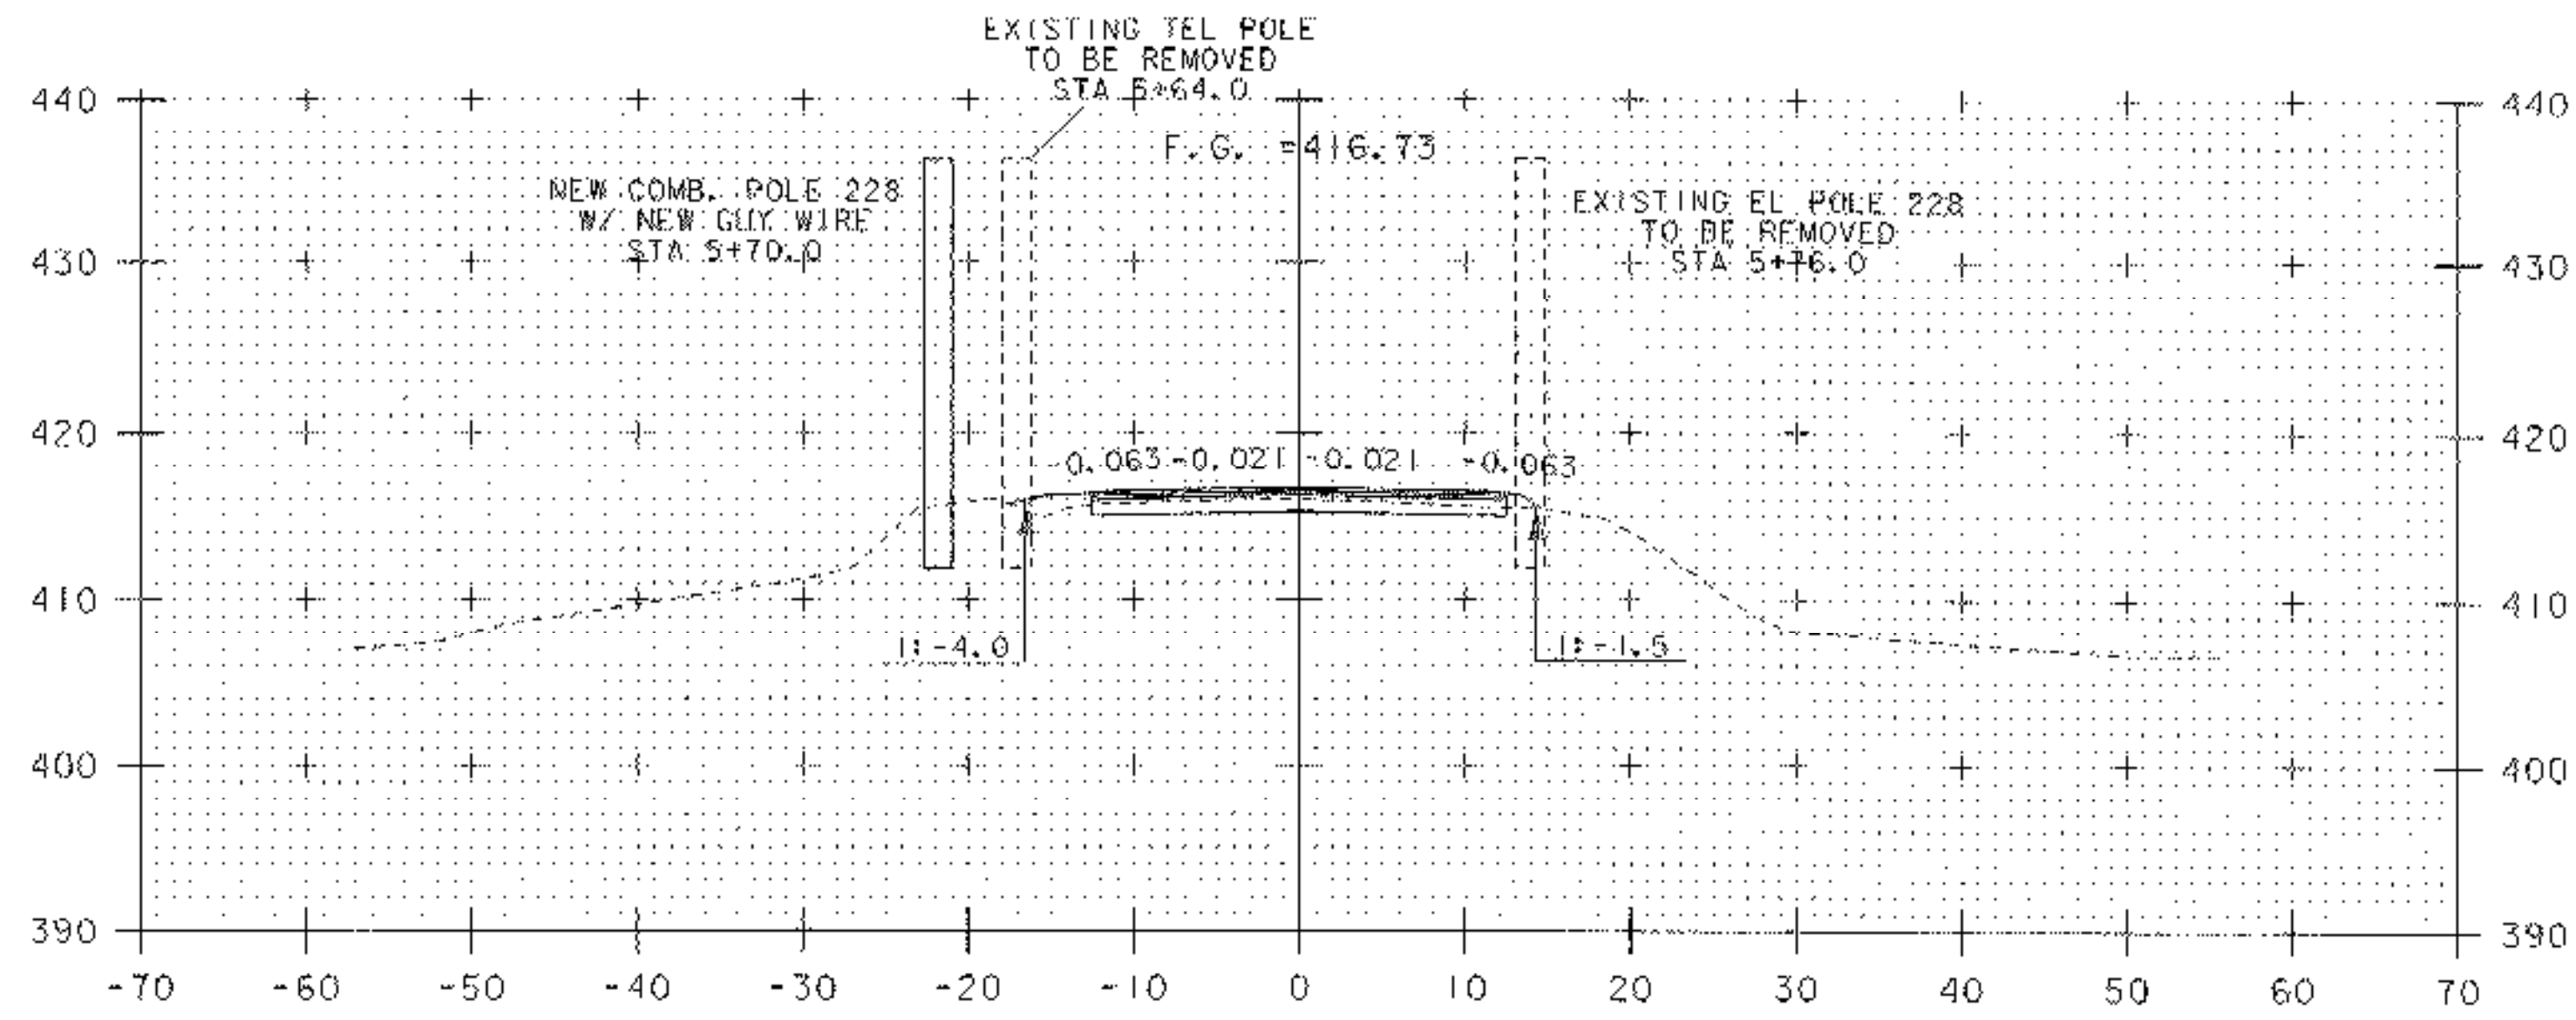


5+75

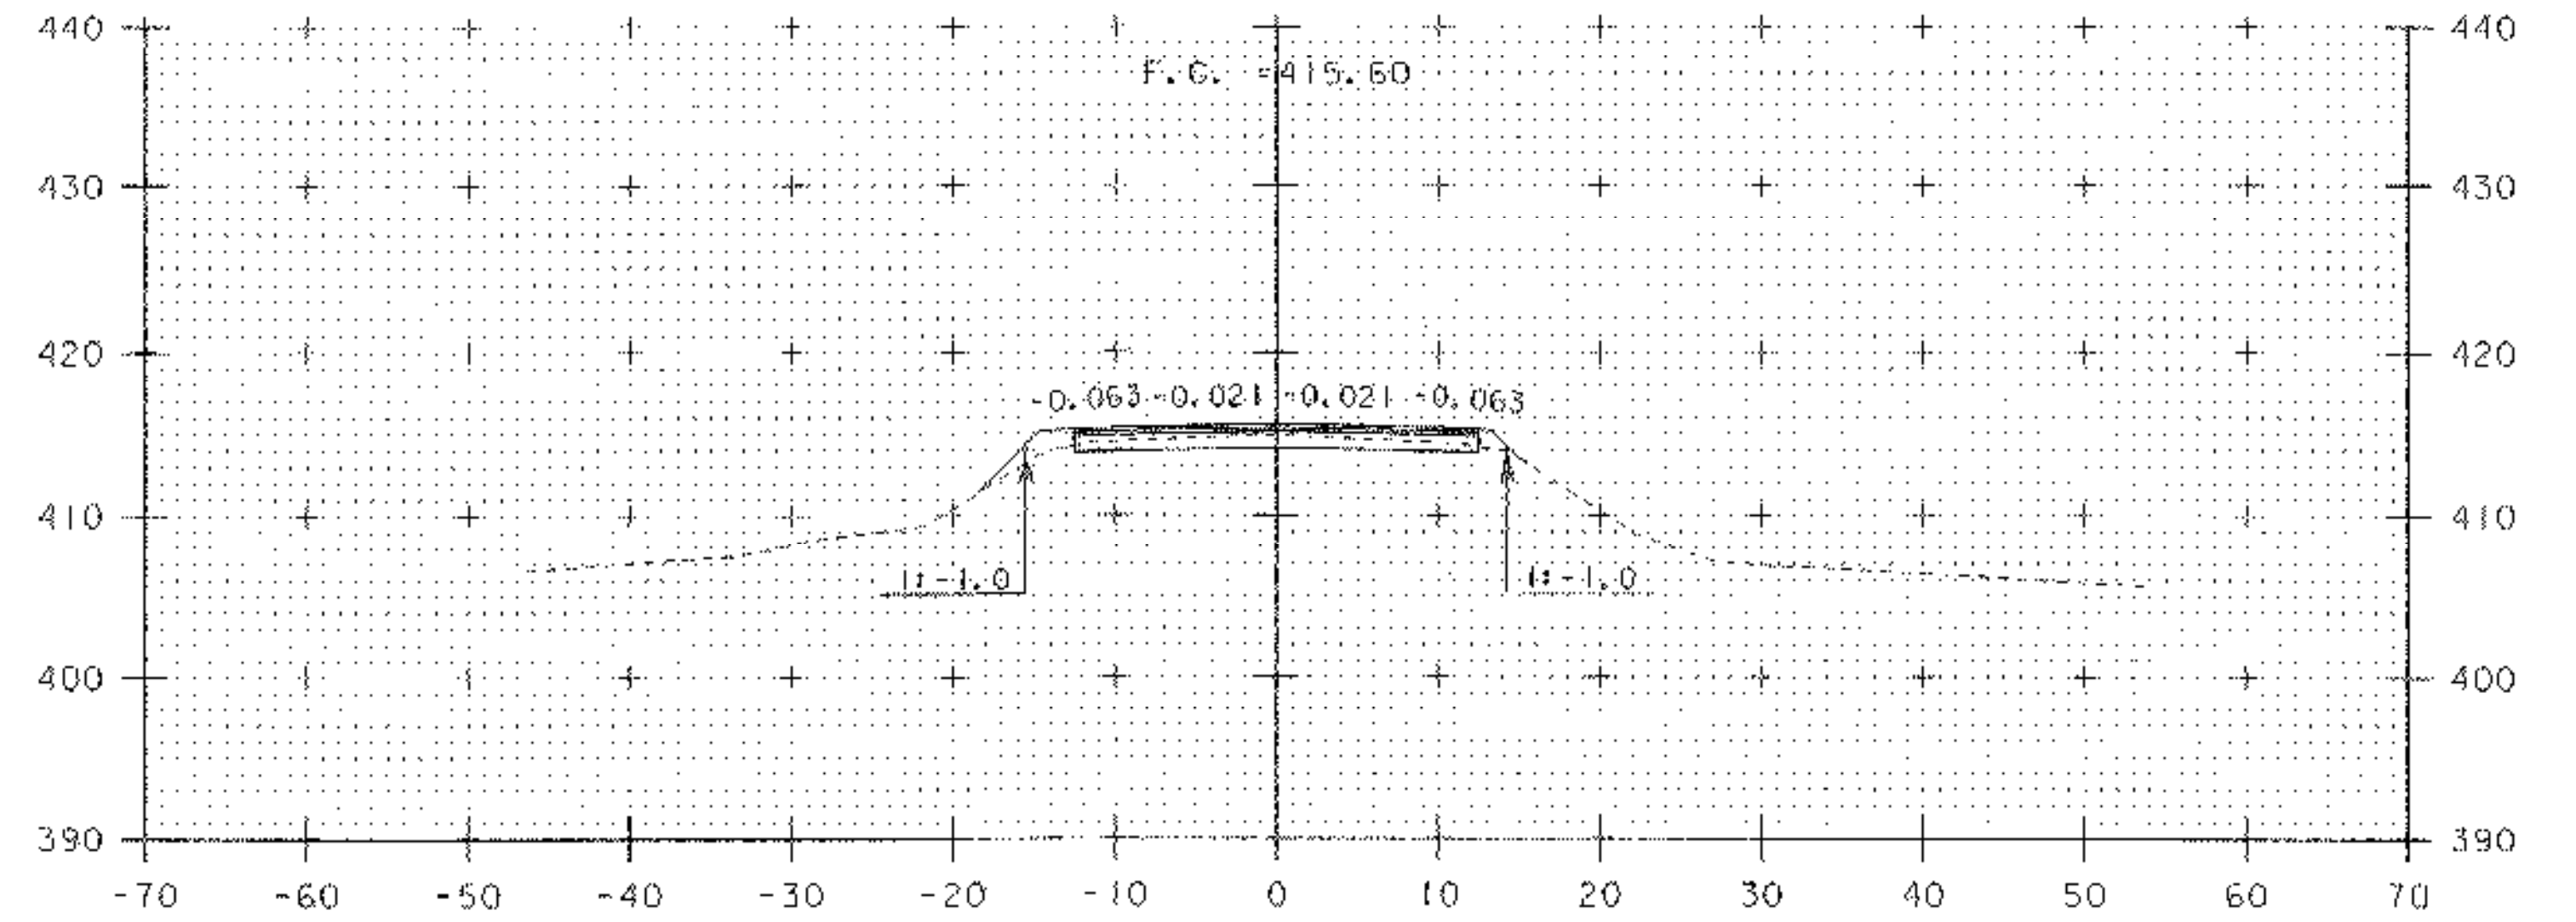

6+25

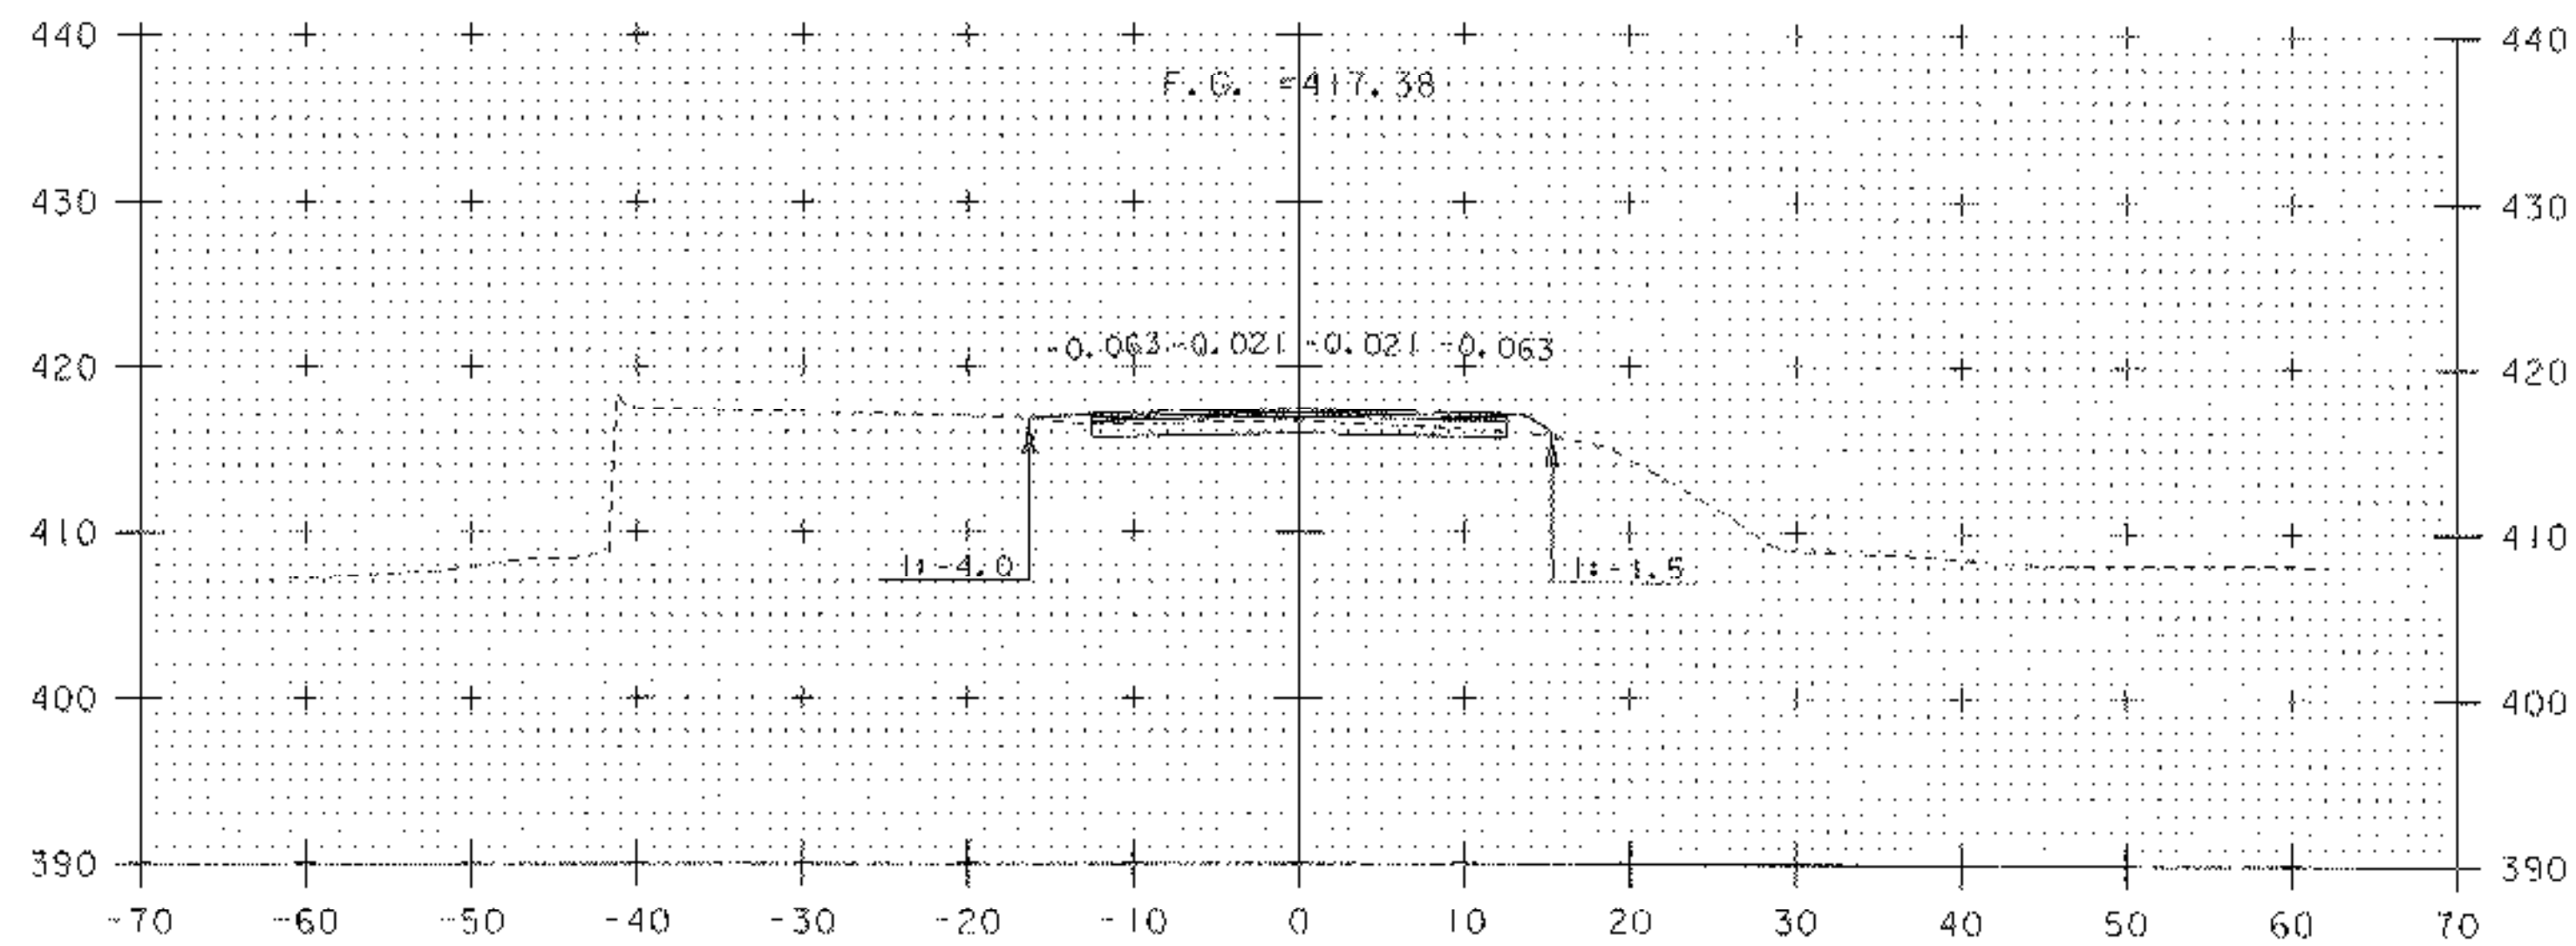

5+50

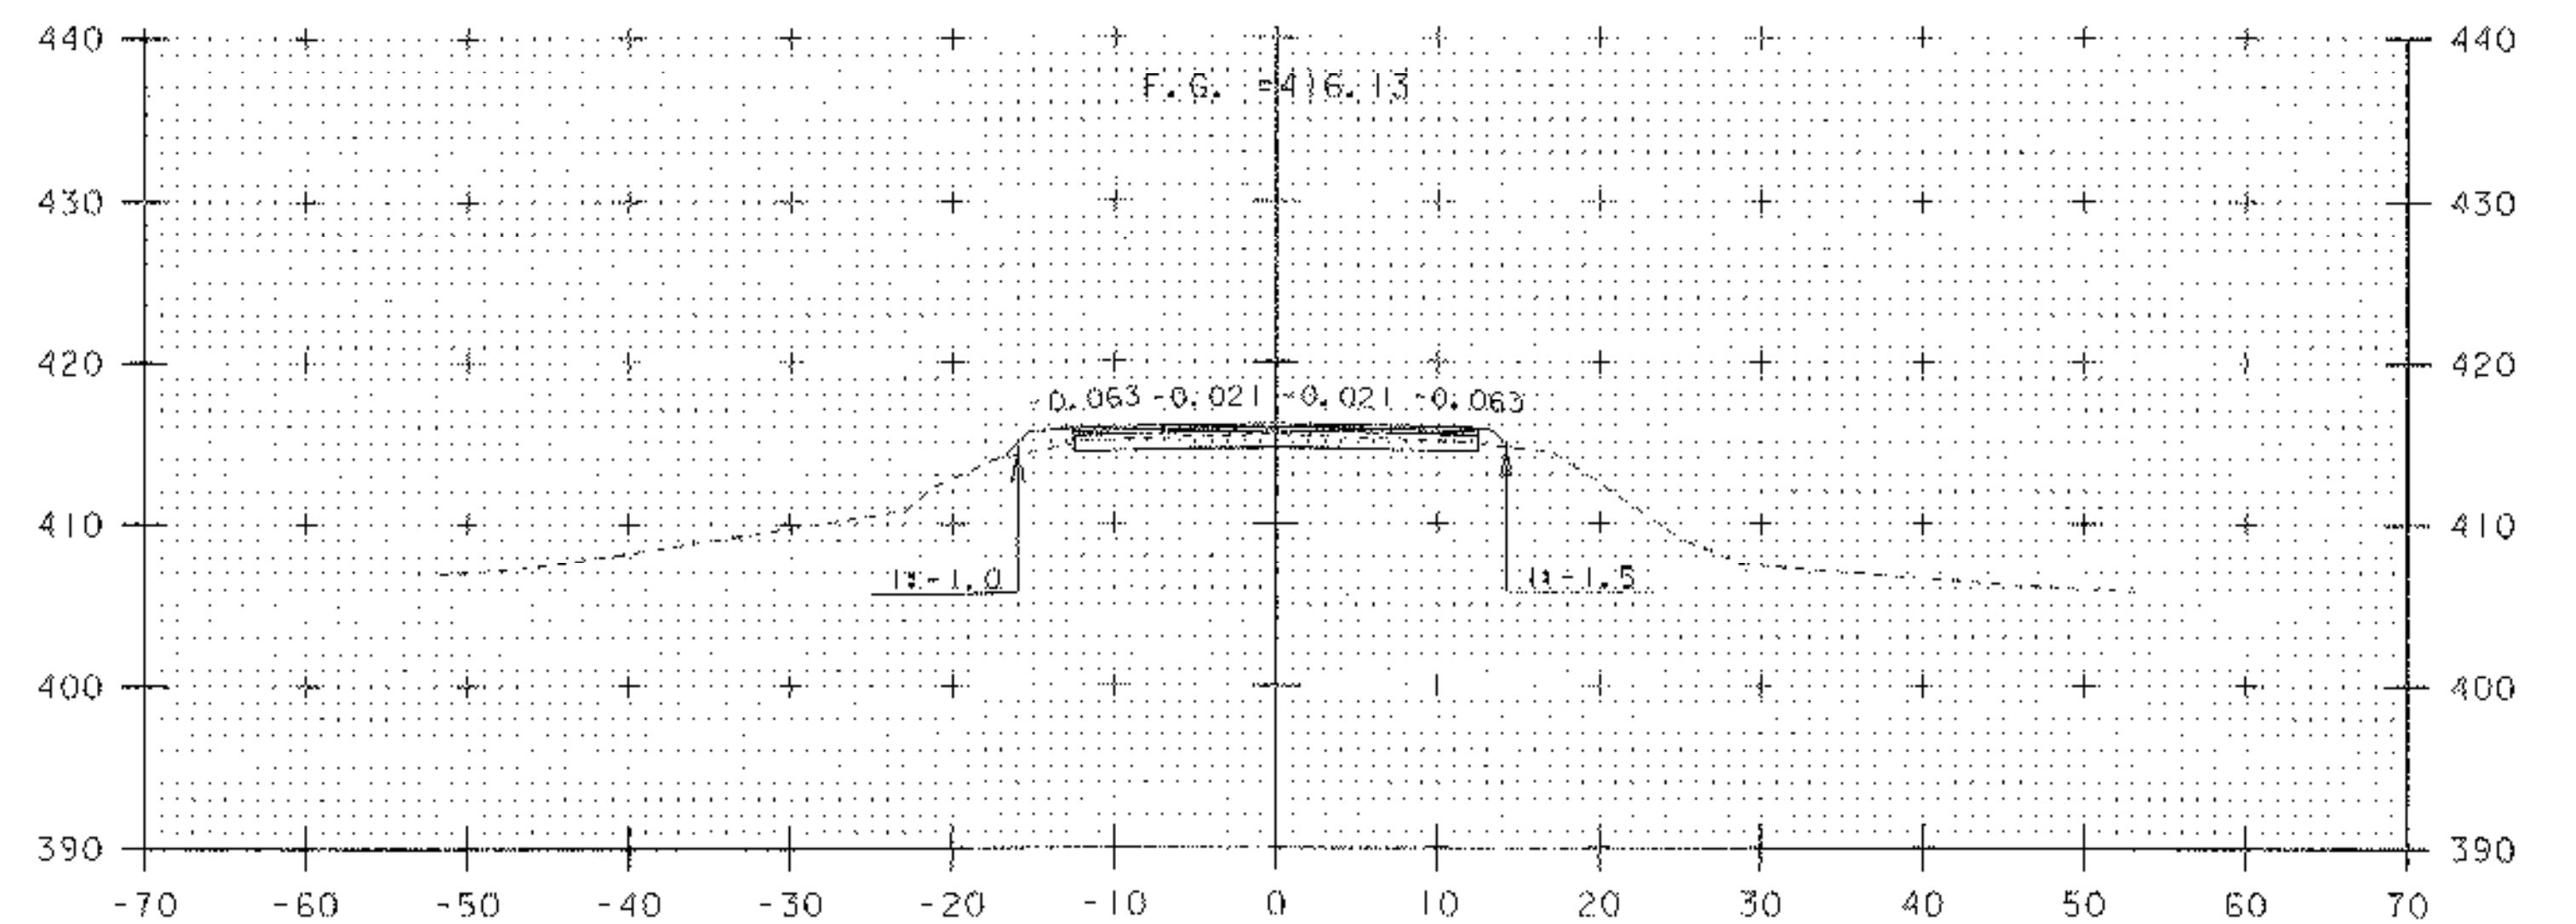

6+00



PROJECT NAME:	HUBBARDTON	PLLOT DATE:	21-MAR-2006
PROJECT NUMBER:	ST 0161(23)	DRAWN BY:	J. DEVLIN
FILE NAME:	PW\03c044\Design\03c044xs	DESIGNED BY:	J. DEVLIN
CROSS SECTIONS STA 5+50 - 6+25		CHECKED BY:	R. DELLASANTA
		SHEET	81 OF 92