




M:\PROJECTS\03c044\CONSTRUCTION\FINAL XS\c03c044FXS.DGN
 FINAL CROSS SECTIONS FOR HUBBARDTON ST 0161 (23)
 DONE BY JOSH HULETT FOUND IN THE ABOVE FILE.

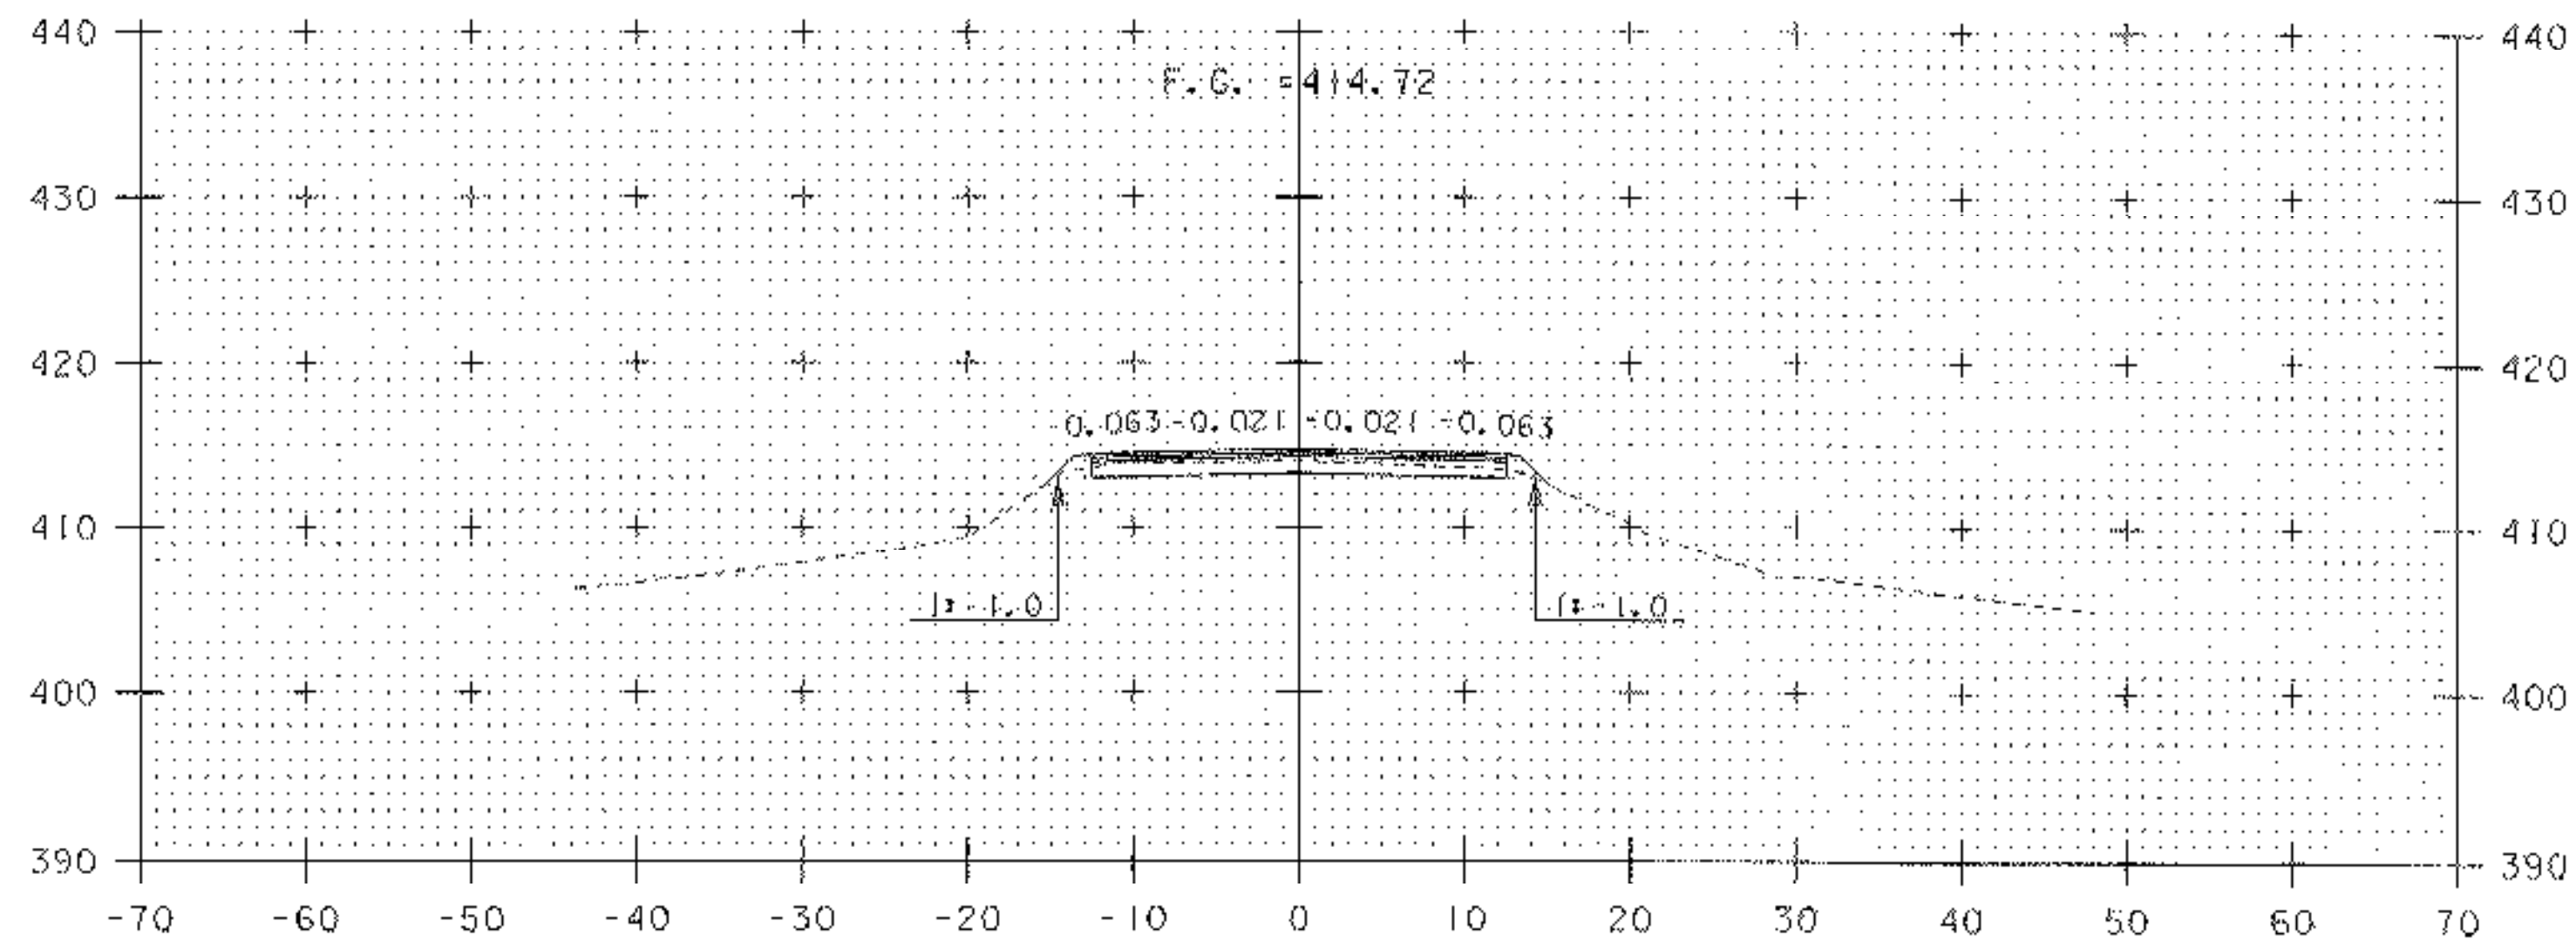


6+75

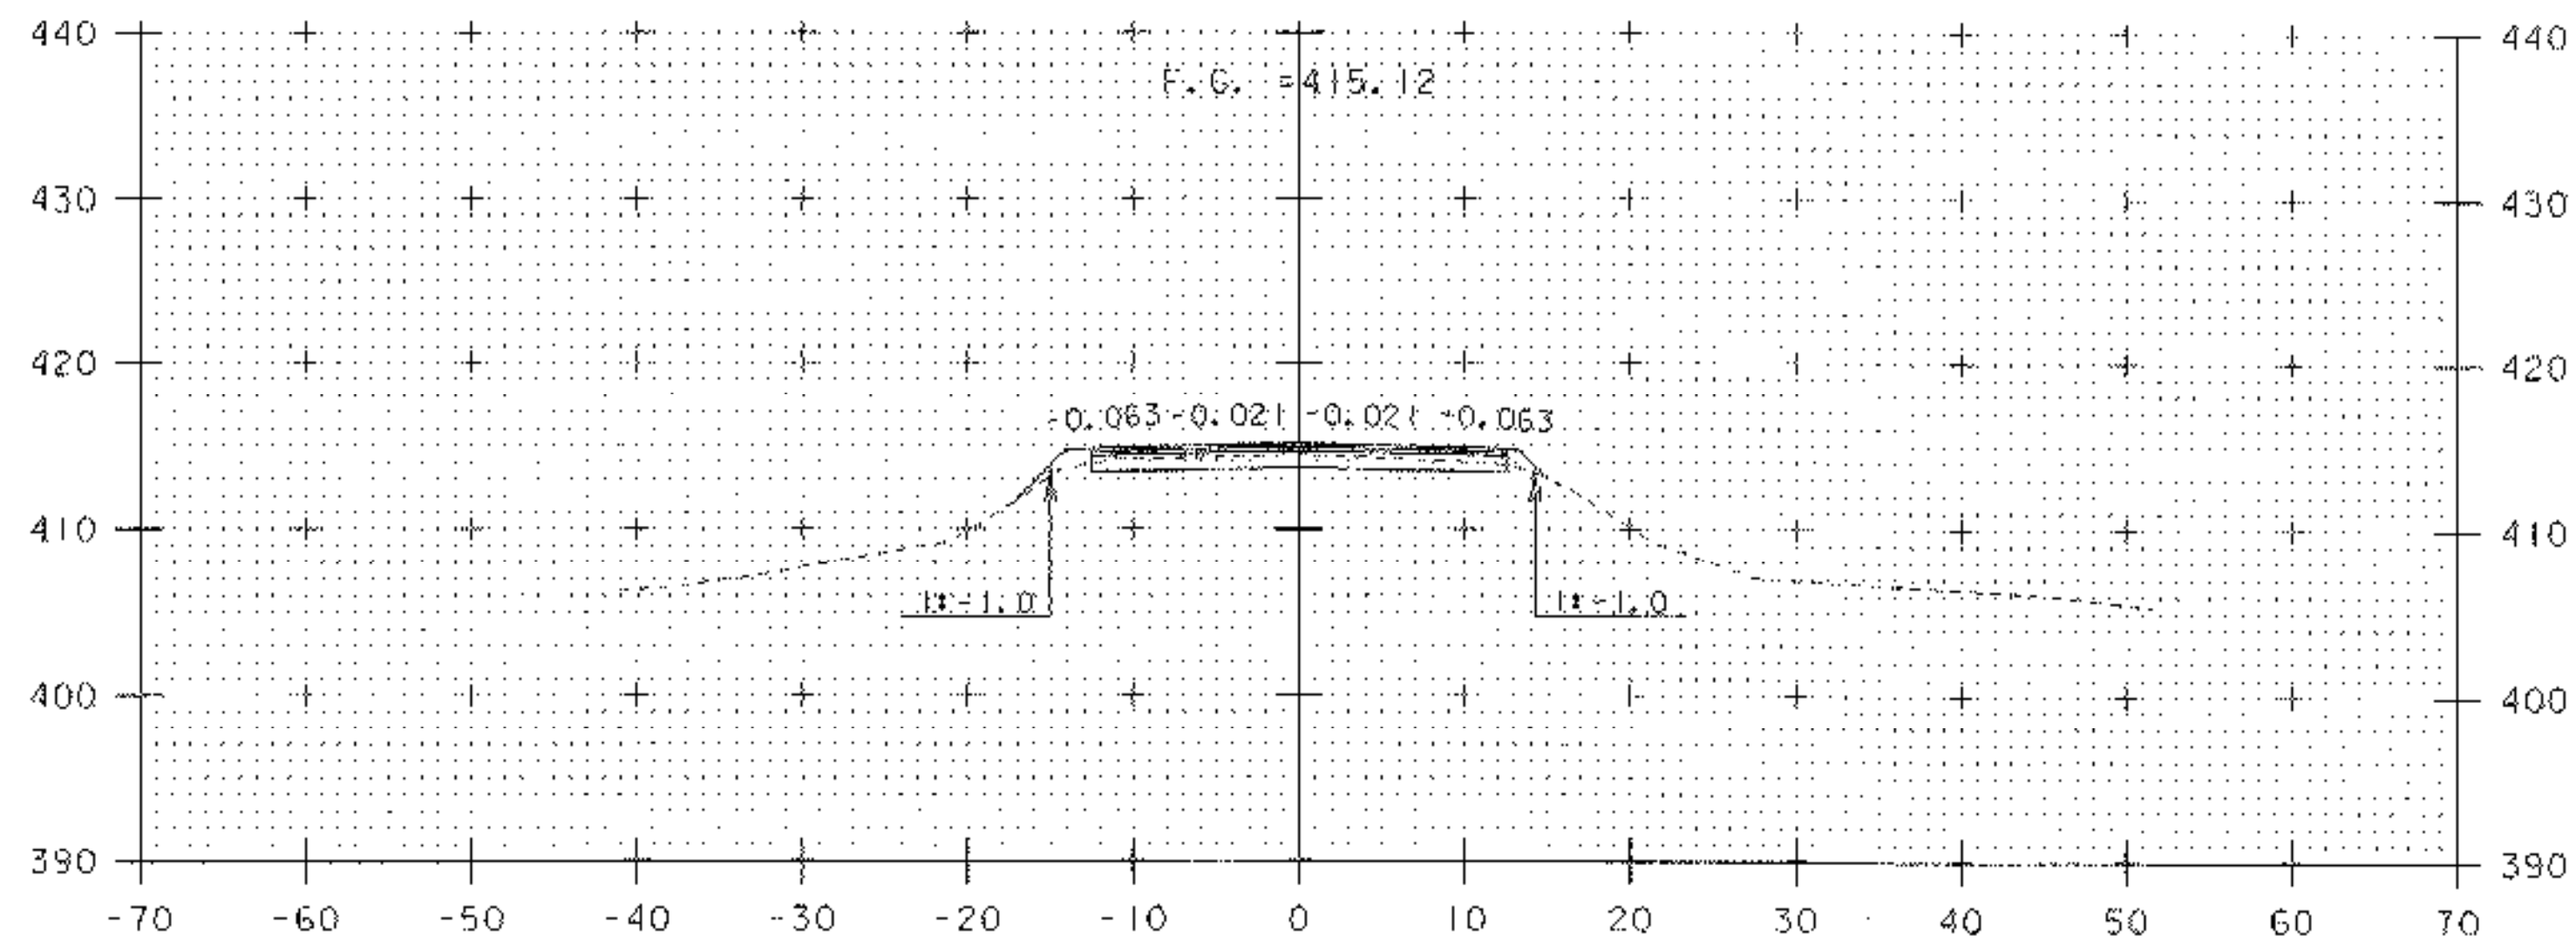

6+50

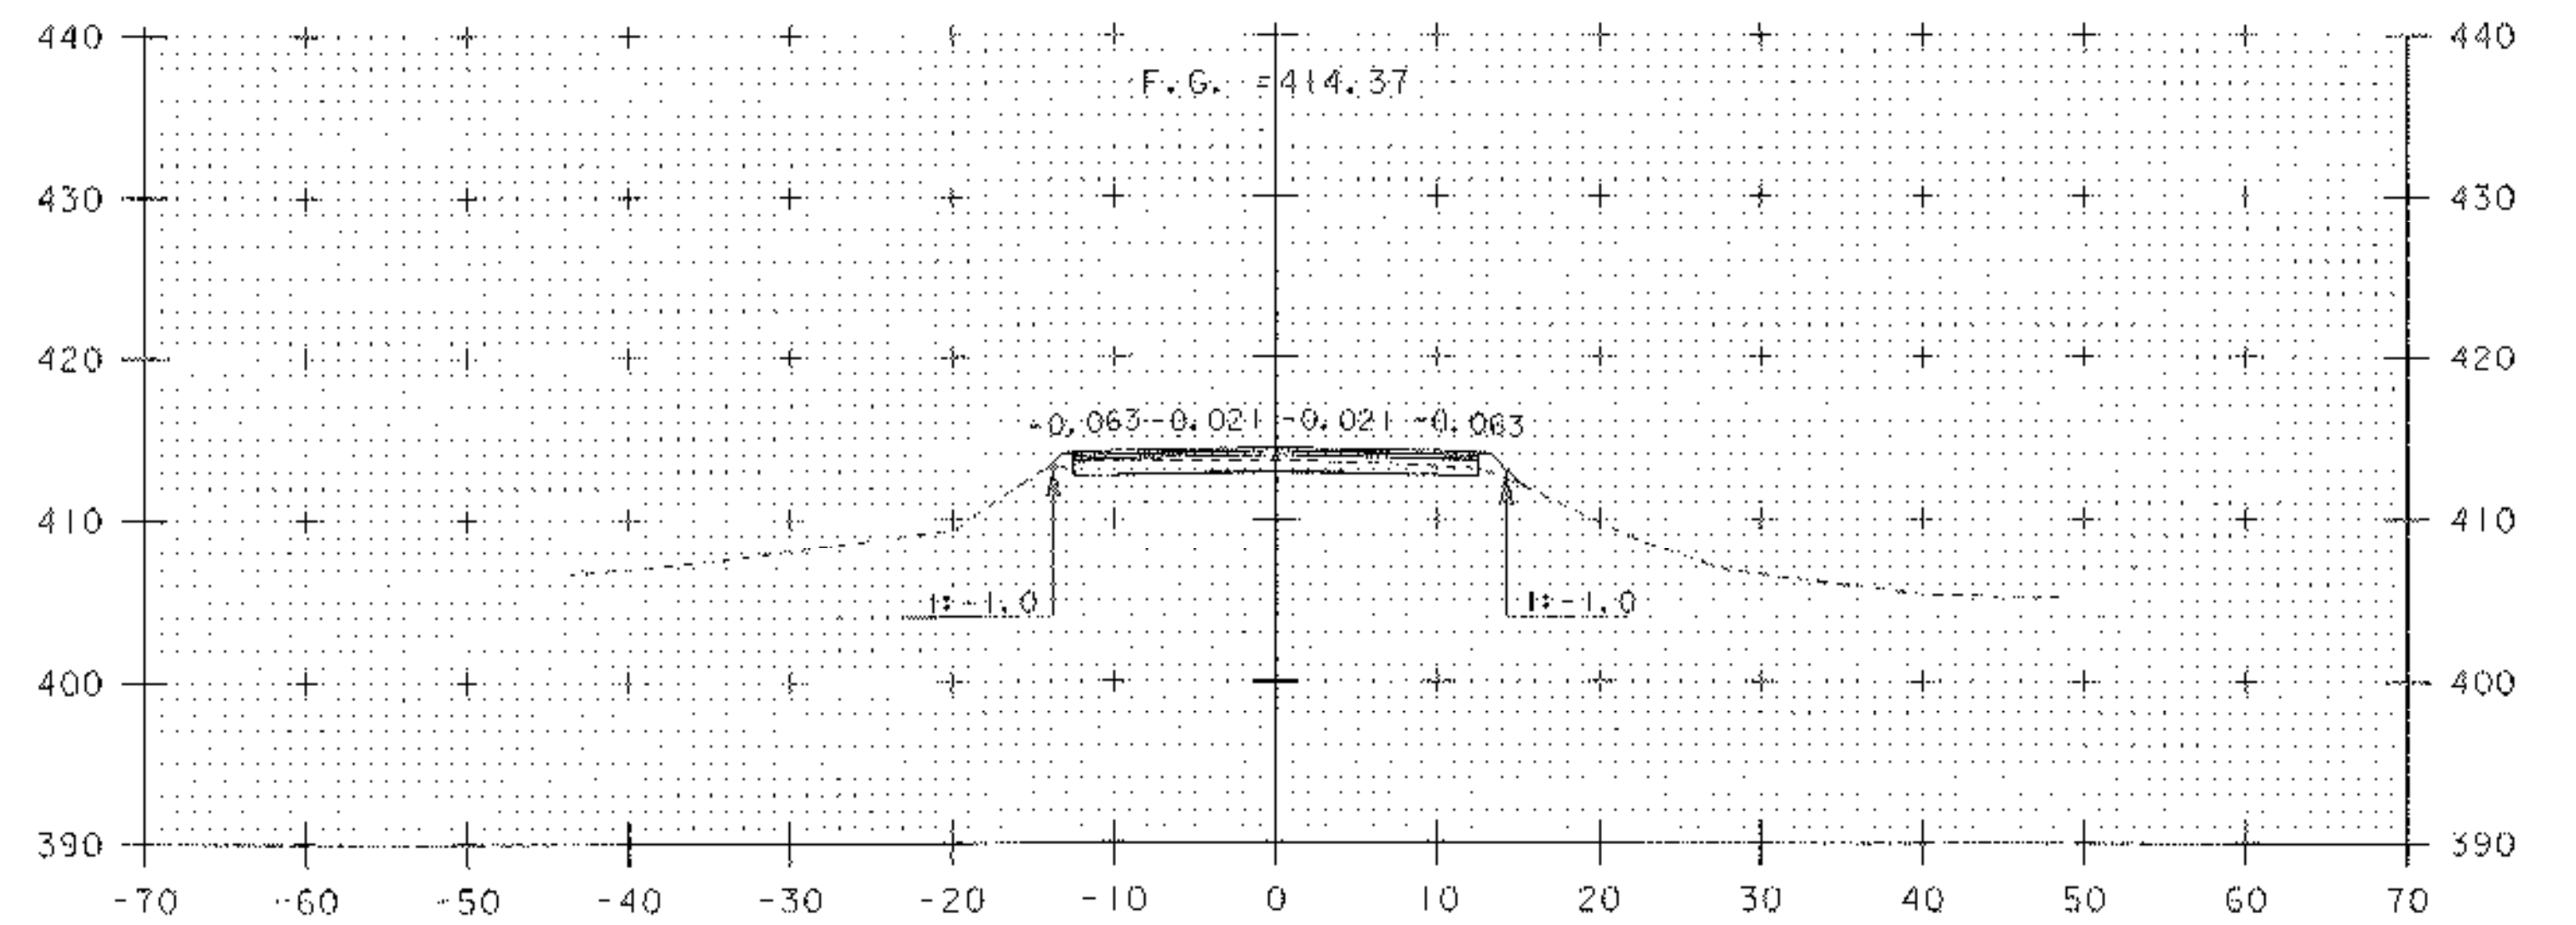

7+00

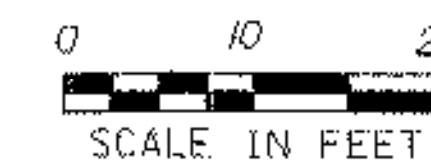

PROJECT NAME:	HUBBARDTON	PLOT DATE:	21-MAR-2006
PROJECT NUMBER:	ST 0161(23)	DRAWN BY:	J. DEVLIN
FILE NAME:	PW/03c044/Design/d03c044xs	CHECKED BY:	R. DELLASANTA
PROJECT LEADER:	K. UPMAL	CROSS SECTIONS STA	6+50 - 7+00
DESIGNED BY:	J. DEVLIN	SHEET	82 OF 92