




M:\PROJECTS\03c044\CONSTRUCTION\FINAL XS\c03c044FXS.DGN
 FINAL CROSS SECTIONS FOR HUBBARDTON ST 0161(23)
 DONE BY JOSH HULETT FOUND IN THE ABOVE FILE.

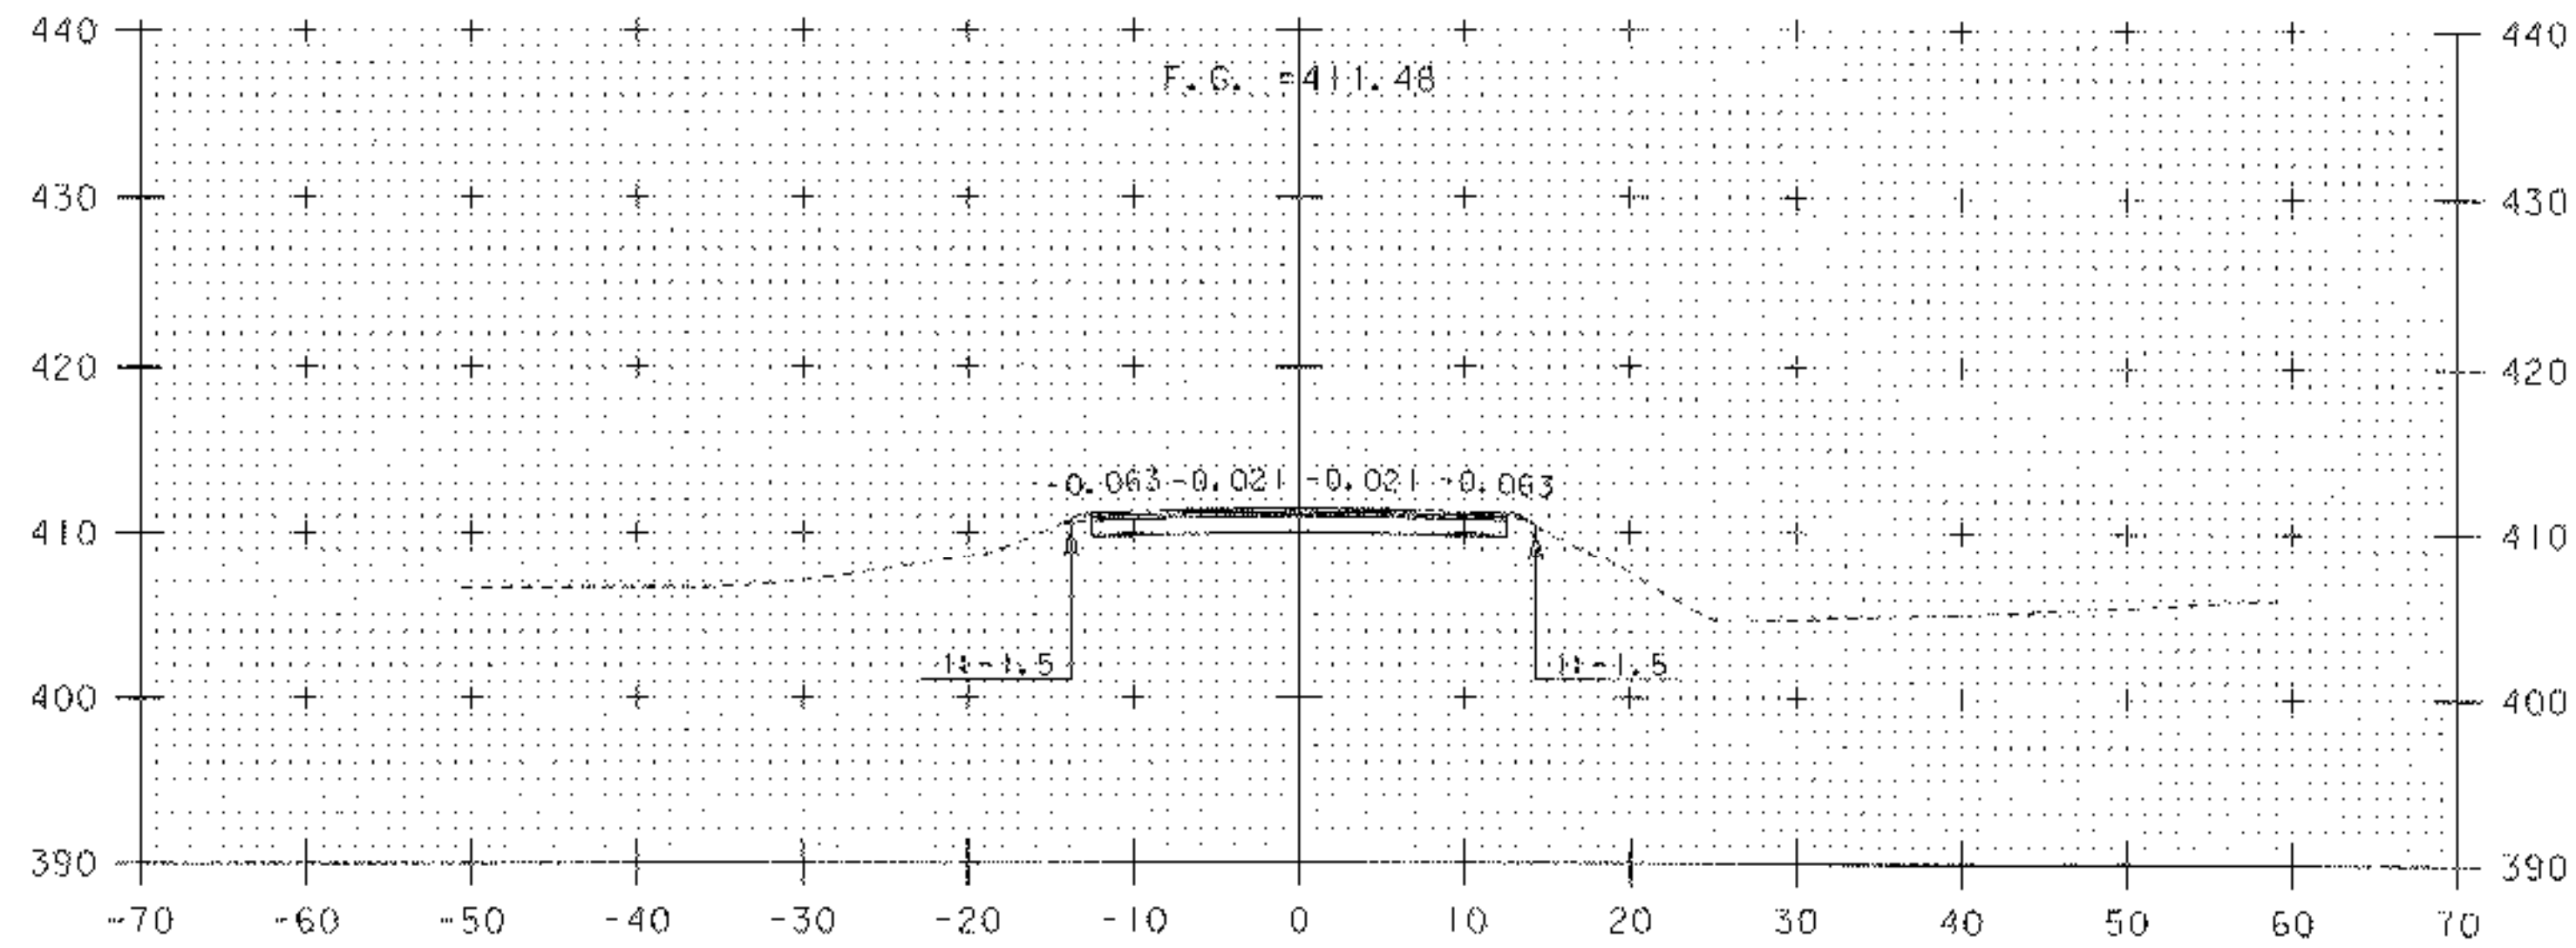


9+50

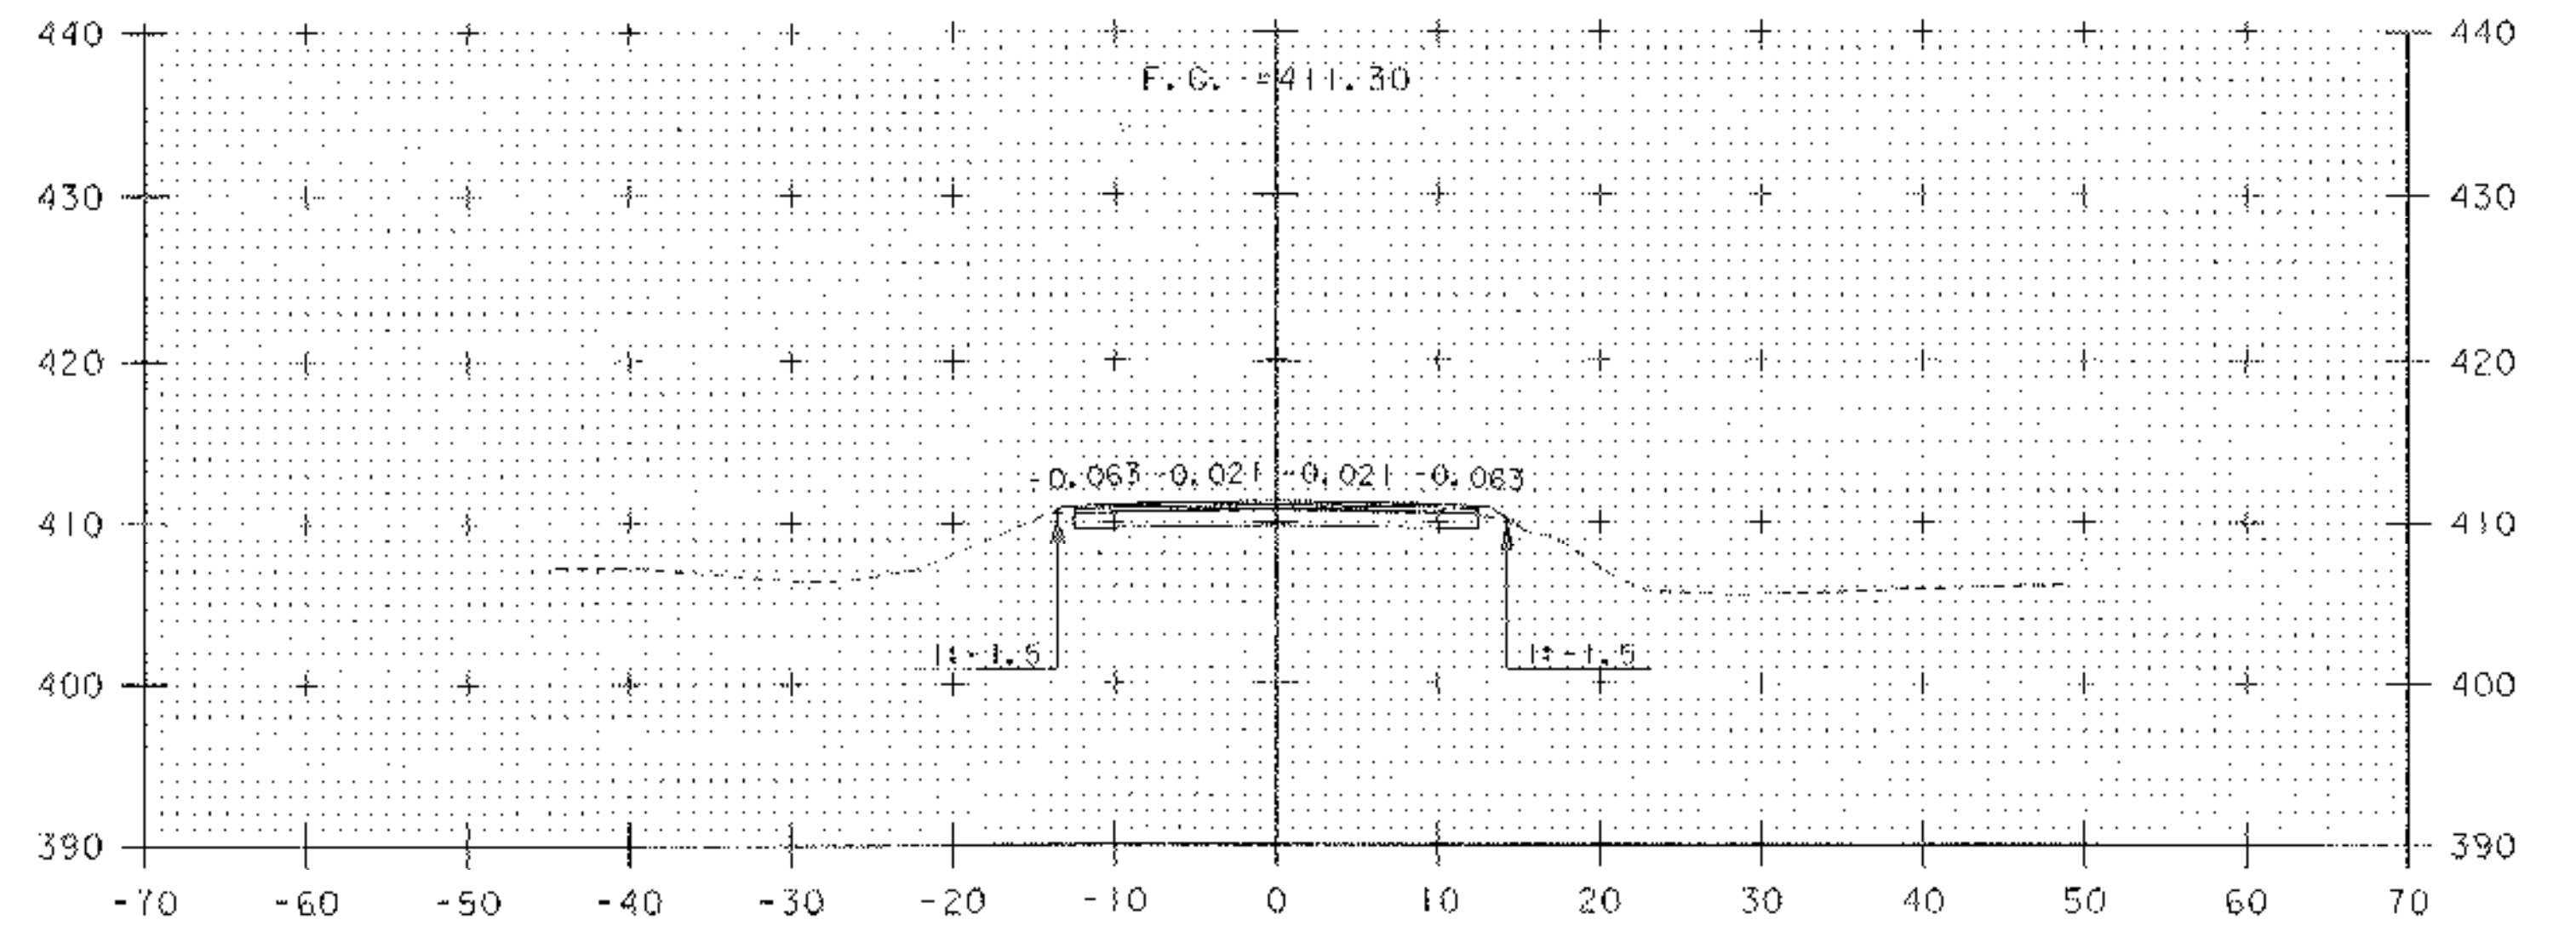


10+00

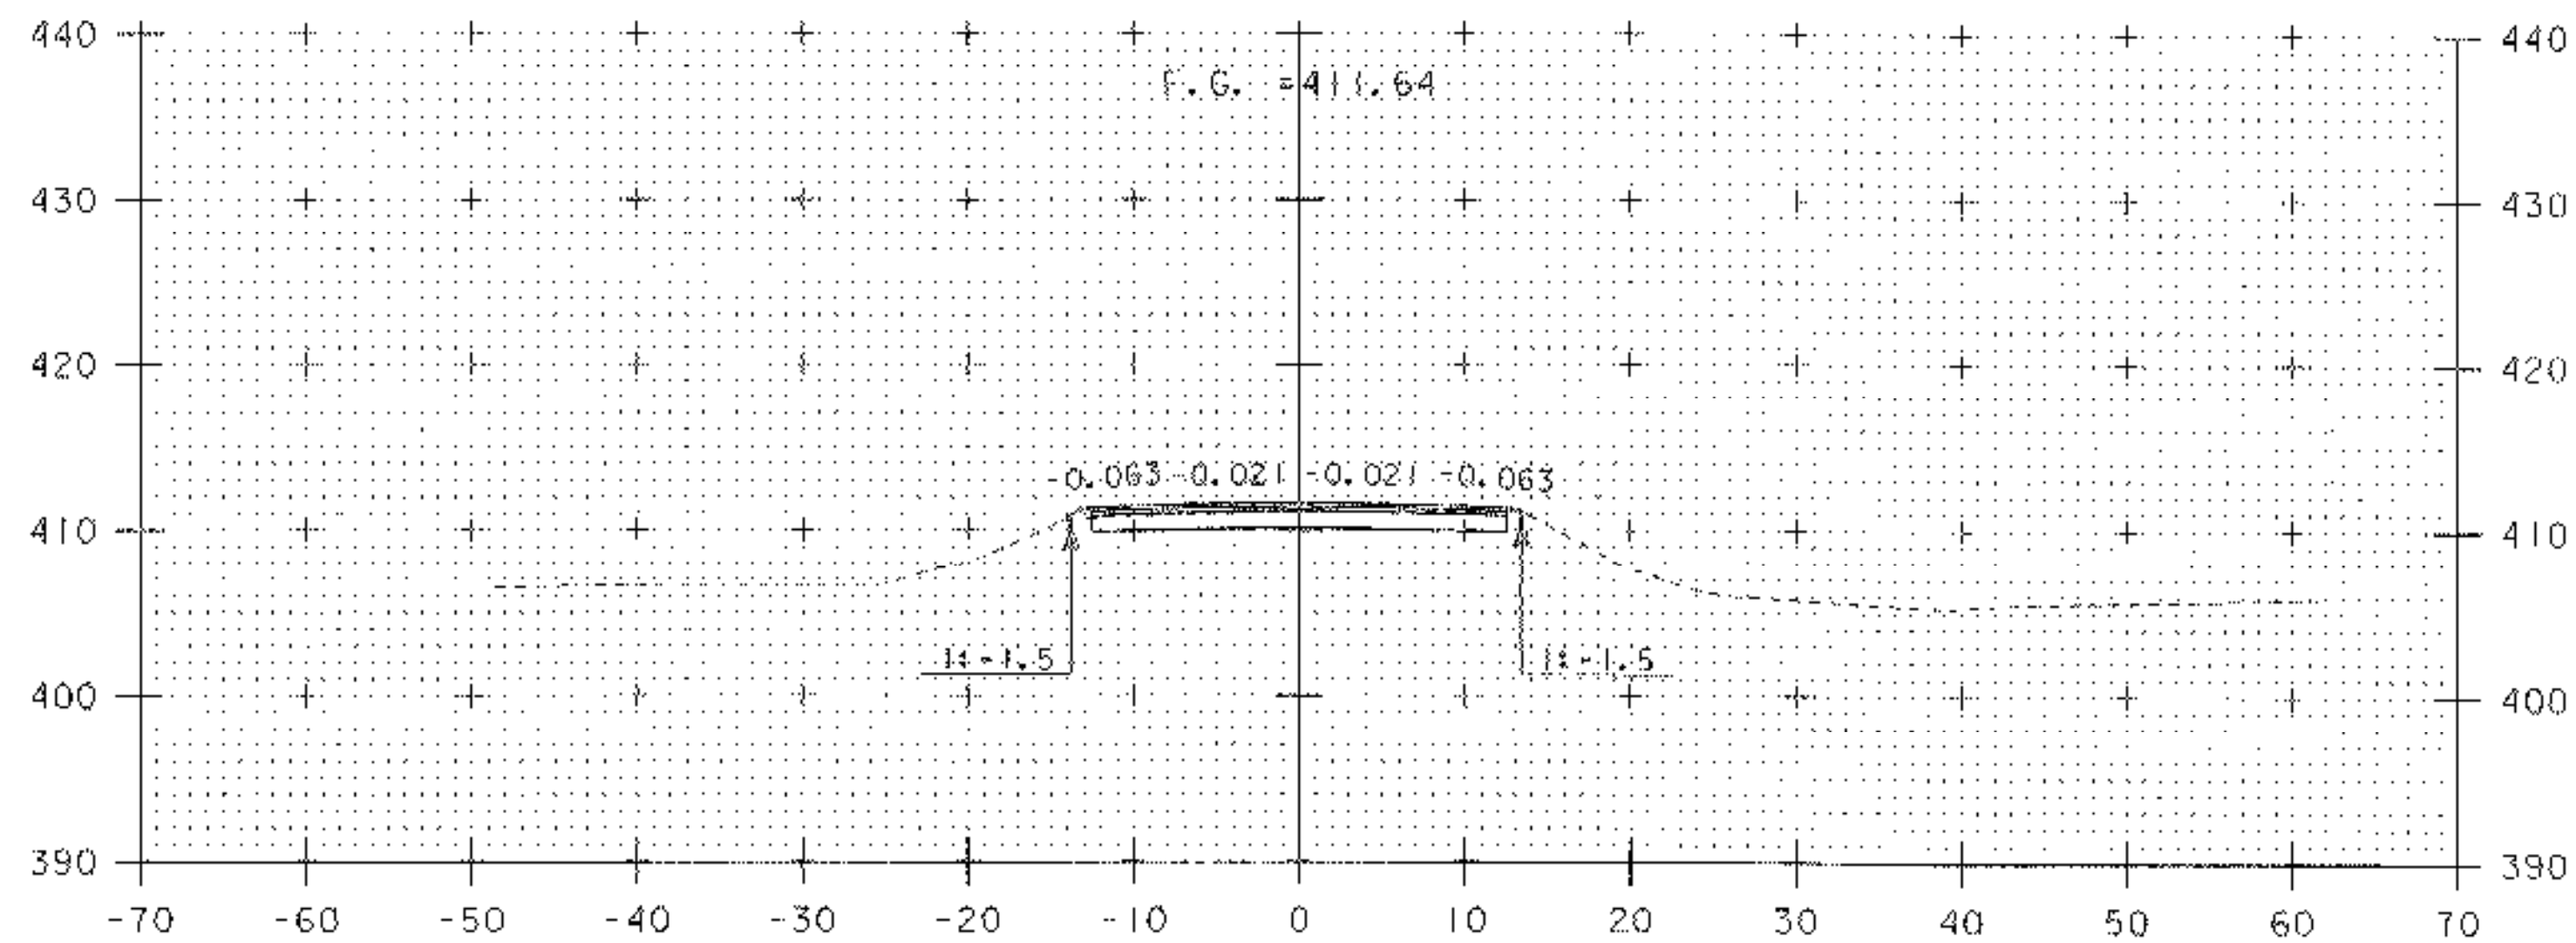

9+25

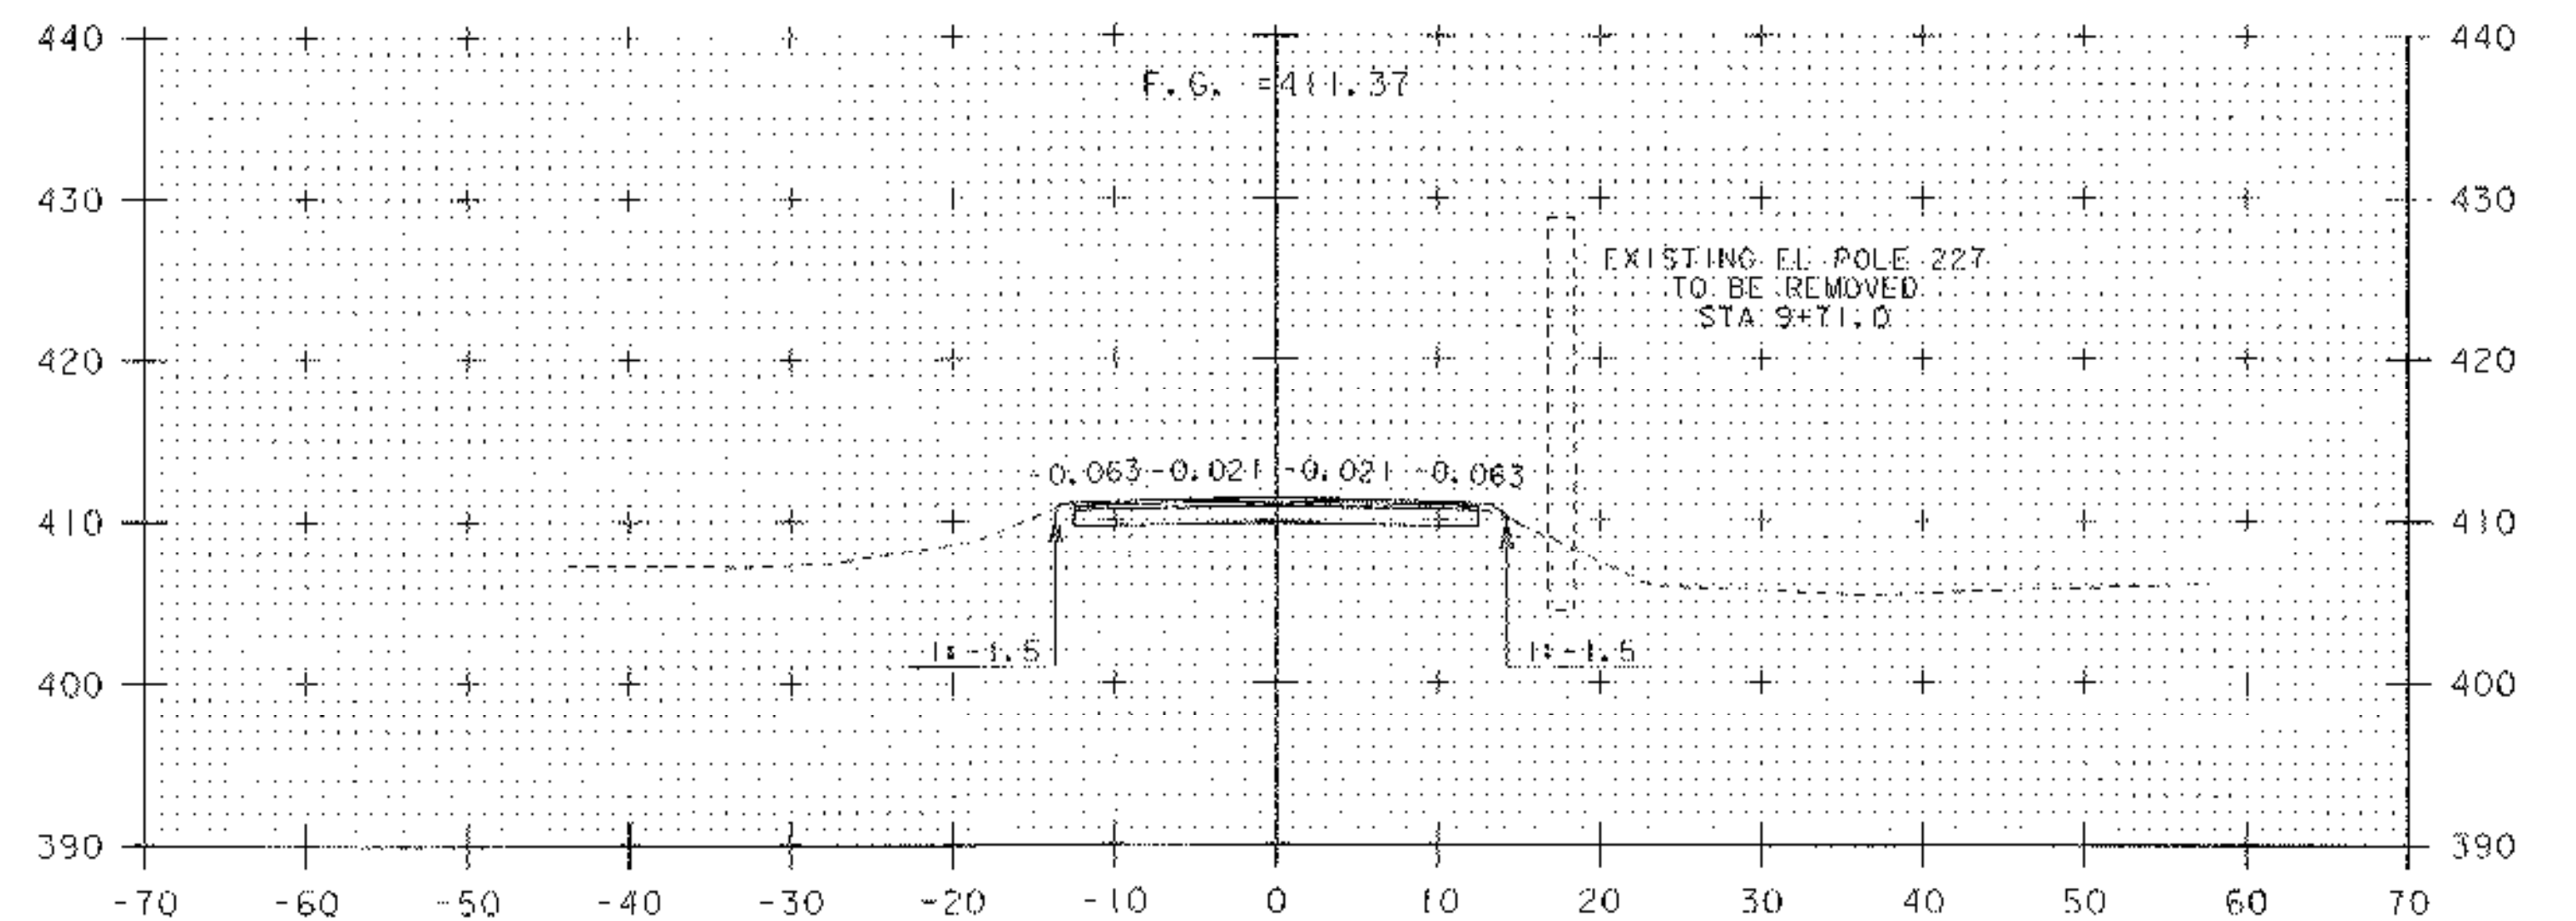

9+75

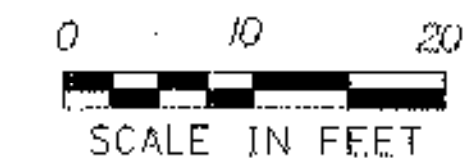

SCALE IN FEET

PROJECT NAME:	HUBBARDTON	PLOT DATE:	21-MAR-2006
PROJECT NUMBER:	ST 0161(23)	DRAWN BY:	J. DEVLIN
FILE NAME:	PW/03c044/Design/d03c044xs	CHECKED BY:	R. DELLASANTA
PROJECT LEADER:	K. UPMAL	CROSS SECTIONS STA 9+25 - 10+00	SHEET 85 OF 92
DESIGNED BY:	J. DEVLIN		