




M:\PROJECTS\03c044\CONSTRUCTION\FINAL XS\c03c044FXS.DGN  
 FINAL CROSS SECTIONS FOR HUBBARDTON ST 0161(23)  
 DONE BY JOSH HULETT FOUND IN THE ABOVE FILE.

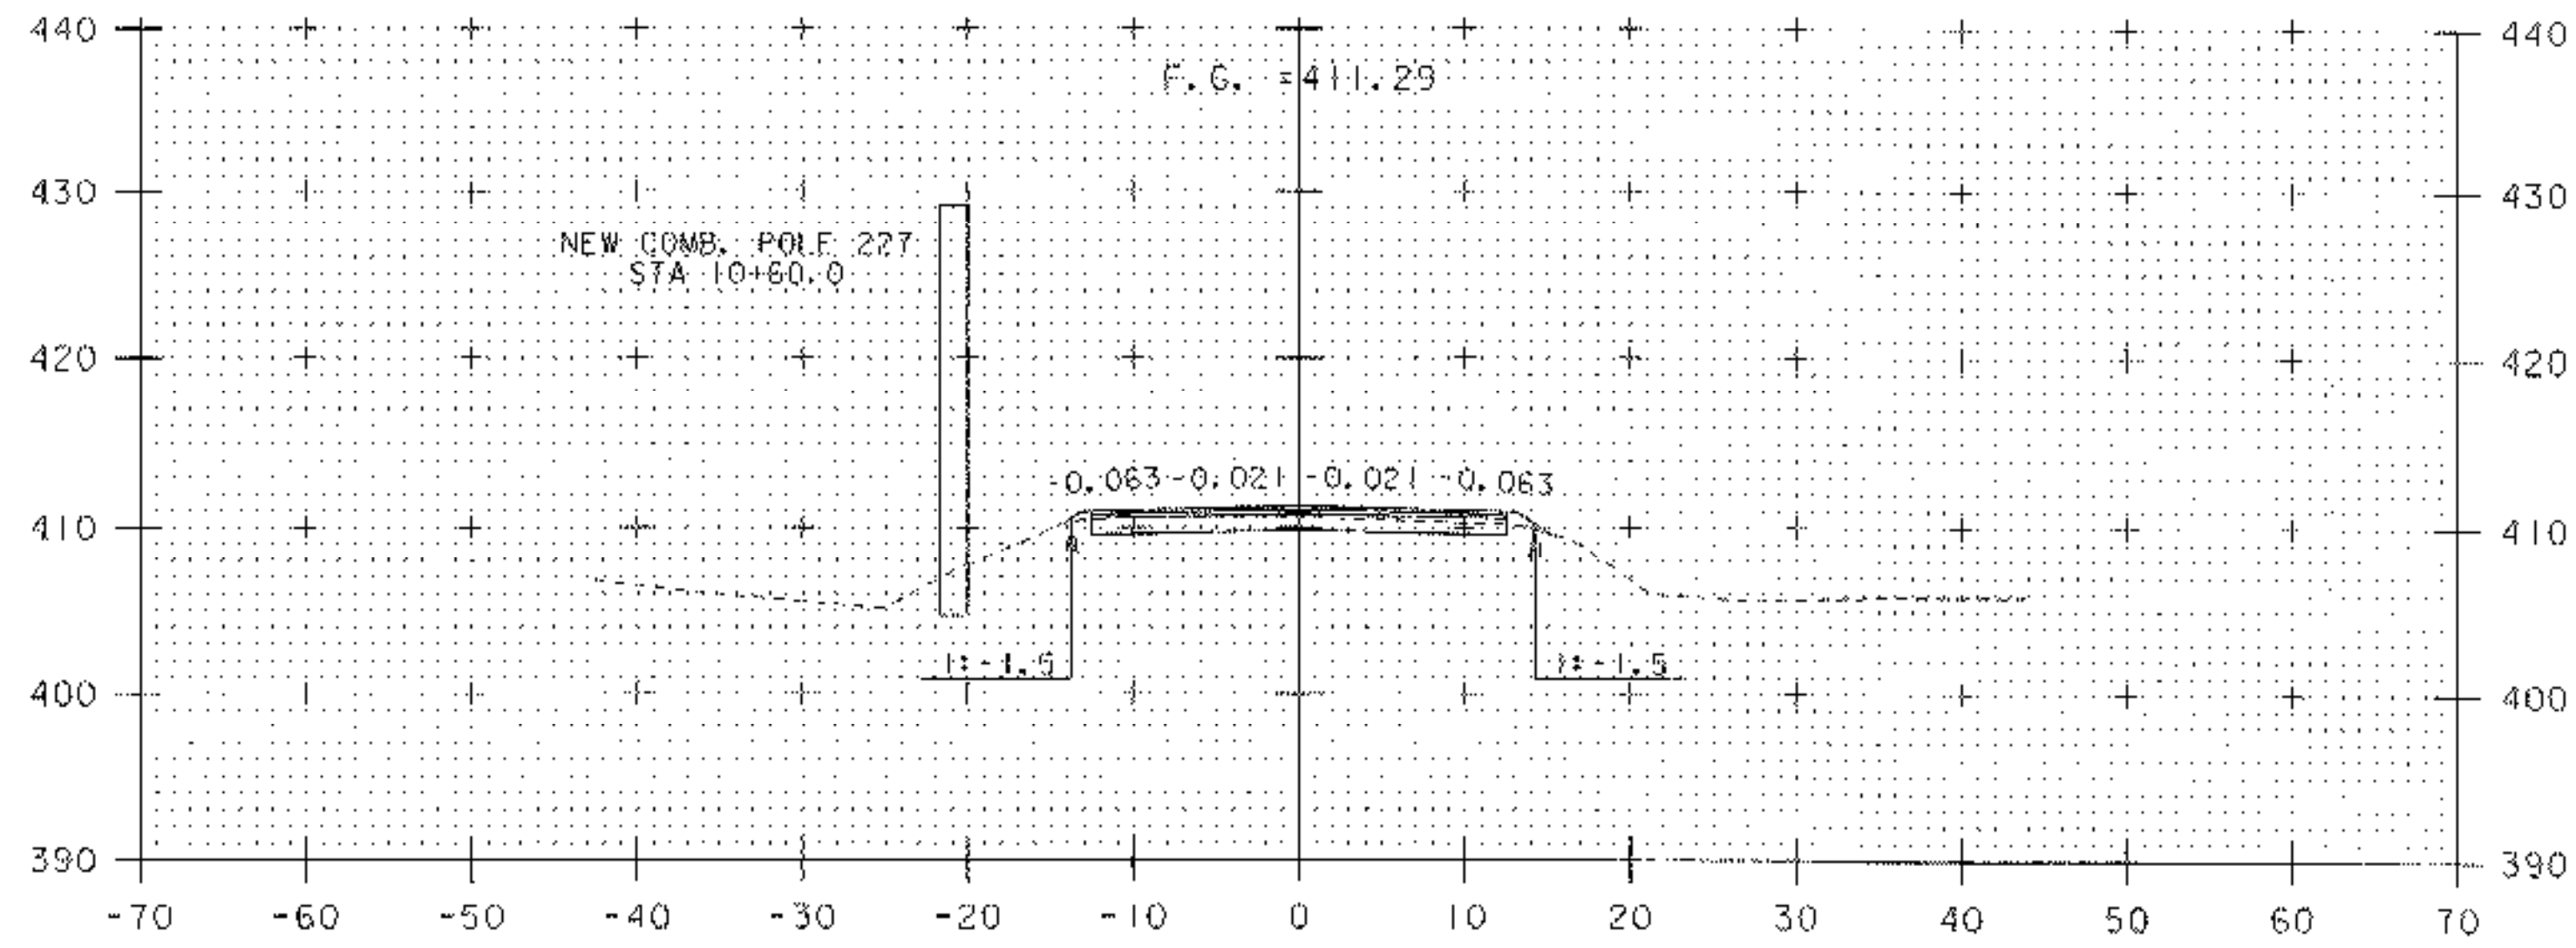


10+50

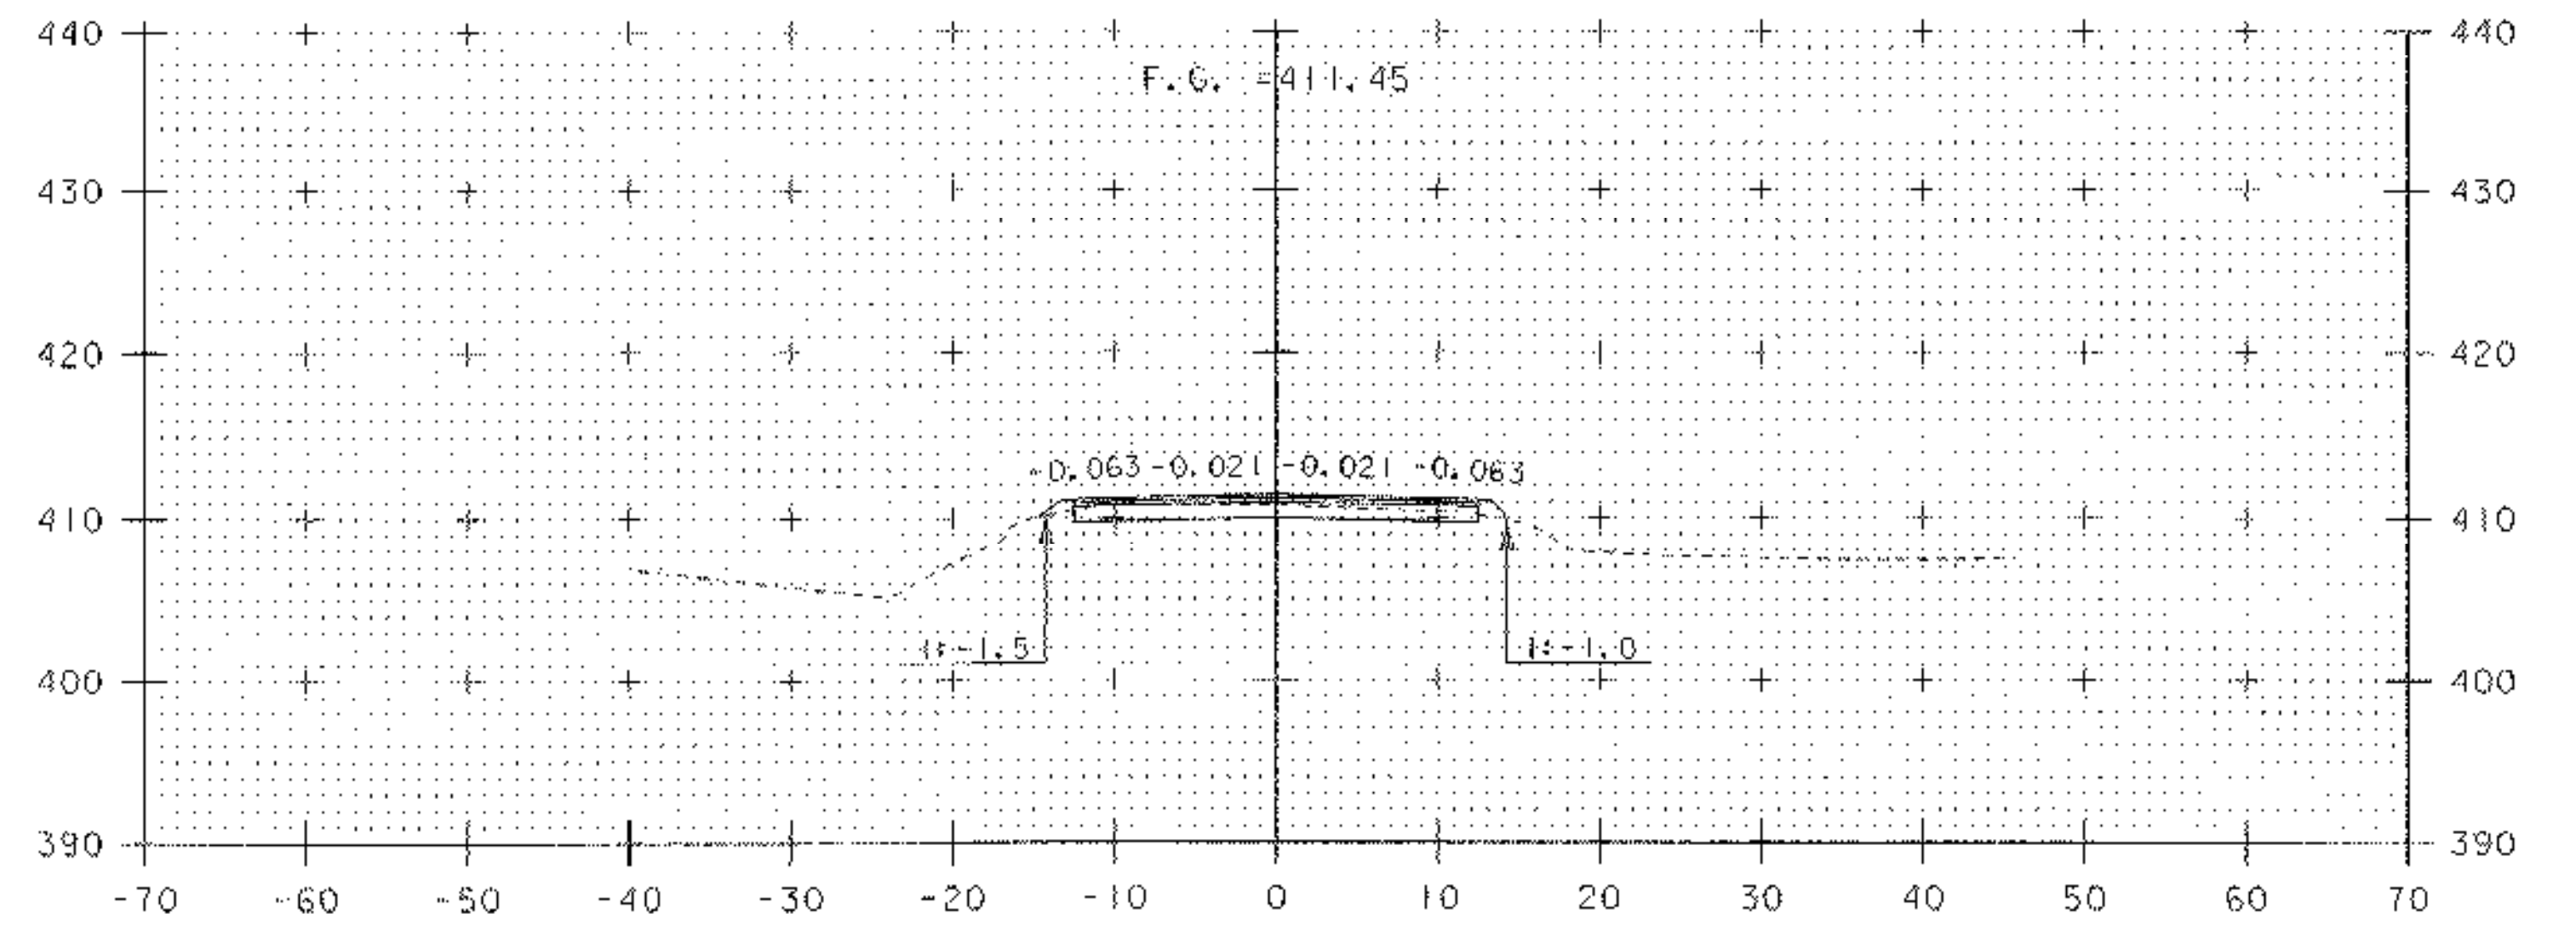


11+00

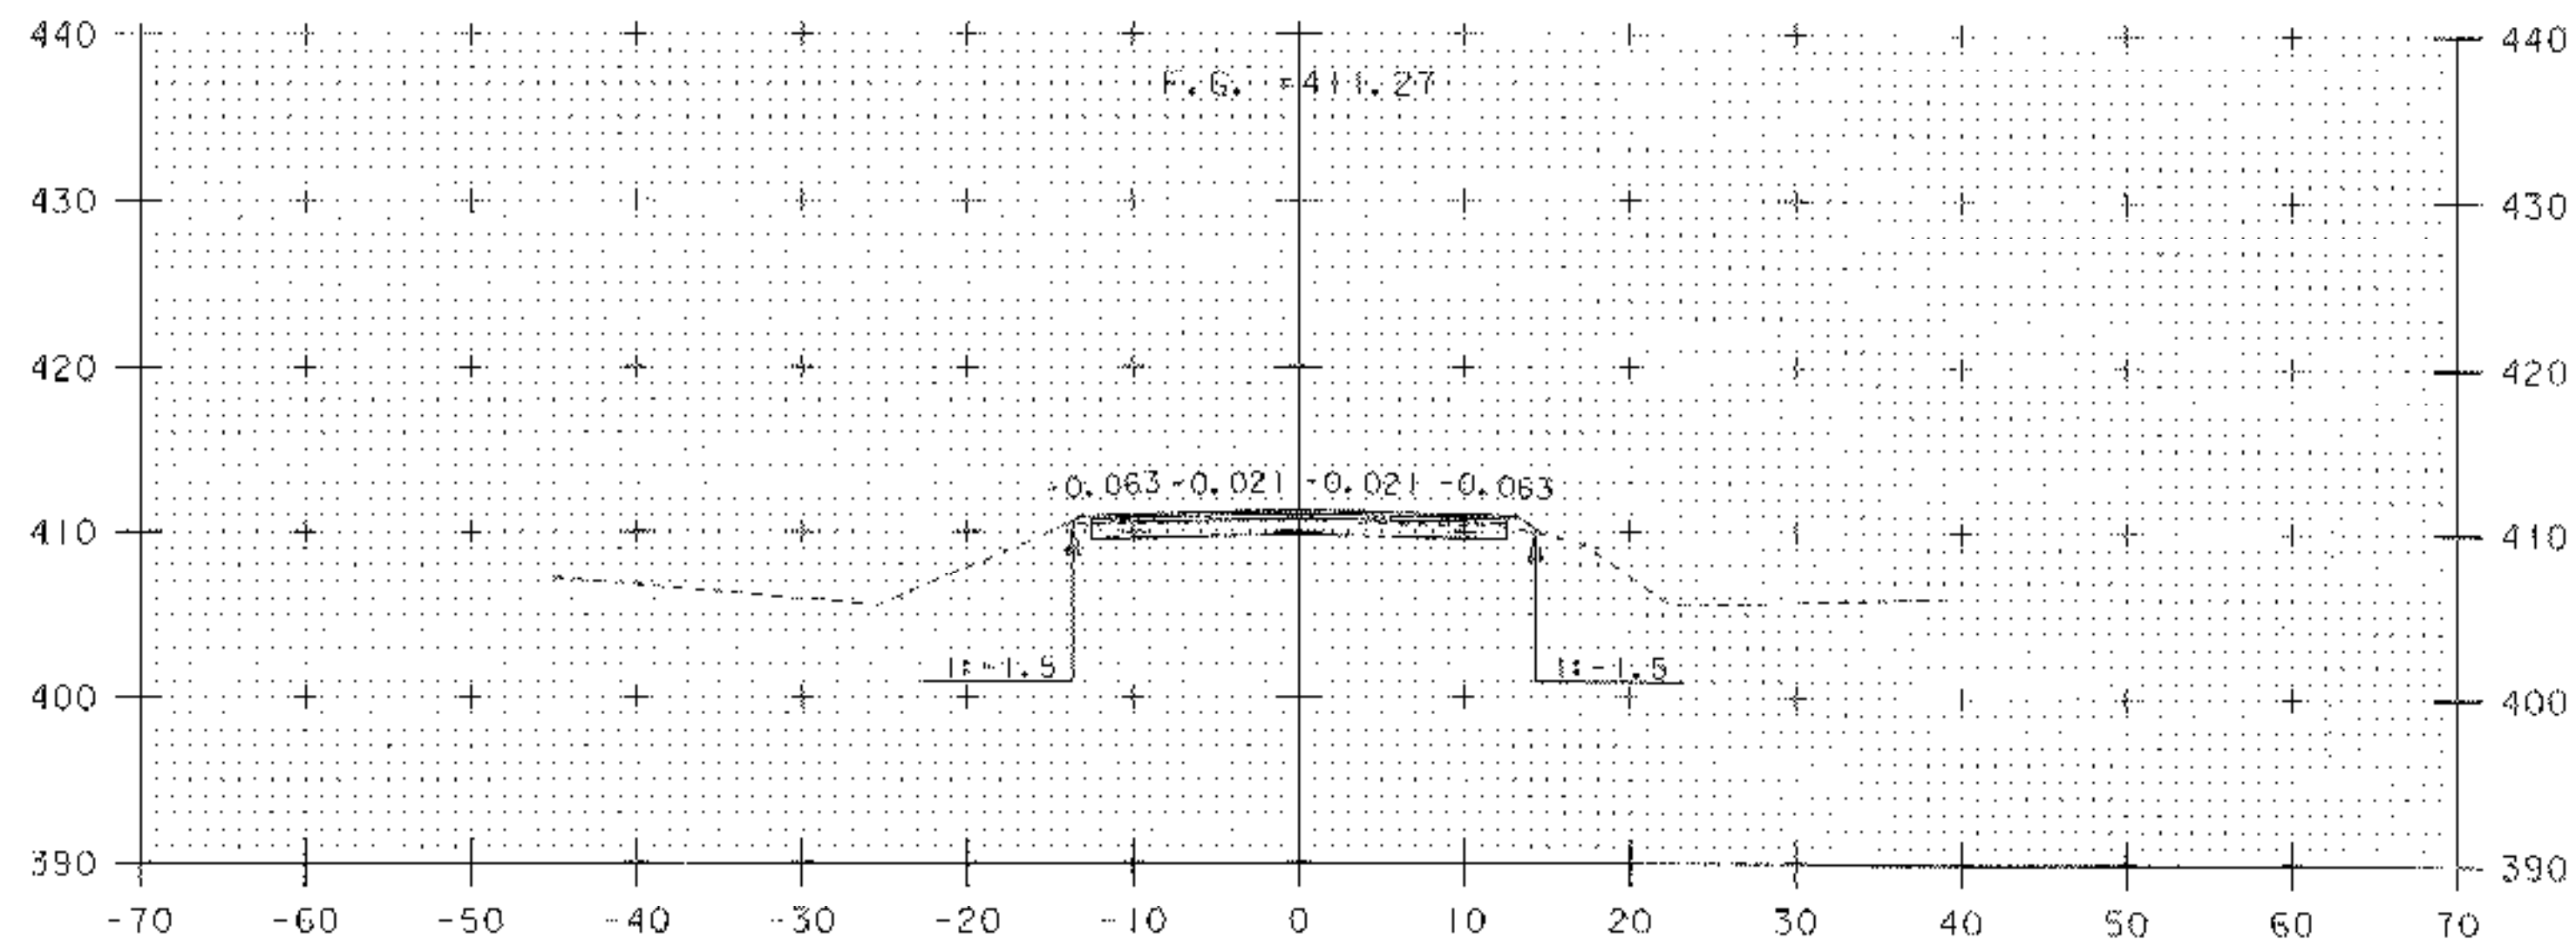

10+25

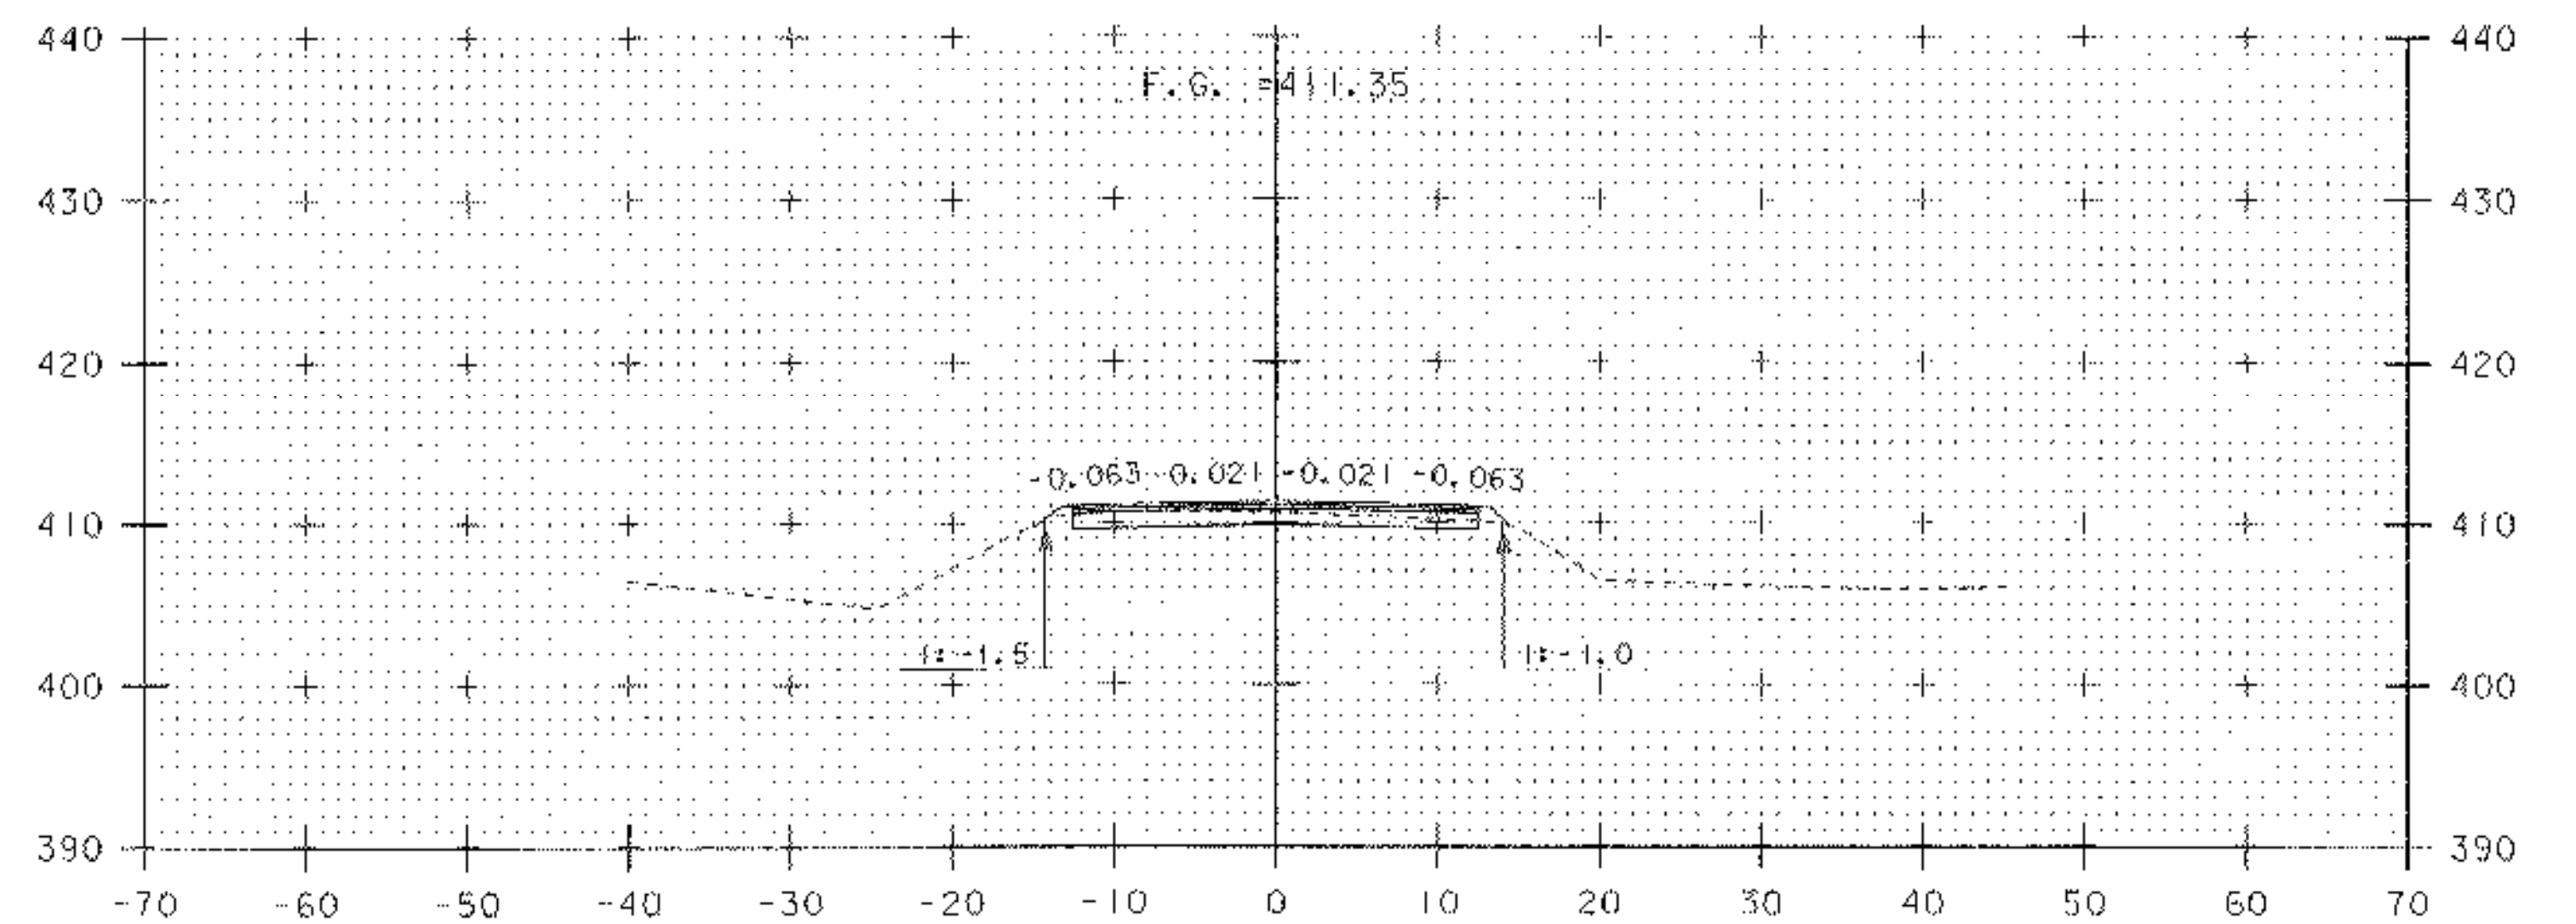

10+75

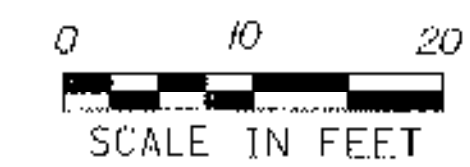

SCALE IN FEET

PROJECT NAME:	HUBBARDTON	PLOT DATE:	21-MAR-2006
PROJECT NUMBER:	ST 0161(23)	DRAWN BY:	J. DEVLIN
FILE NAME:	PW/03c044/Design/d03c044xs	DESIGNED BY:	J. DEVLIN
CROSS SECTIONS:	STA 10+25 - 11+00	CHECKED BY:	R. DELIASANTA
		SHEET:	86 OF 92