




M:\PROJECTS\03c044\CONSTRUCTION\FINAL XS\c03c044FXS.DGN
 FINAL CROSS SECTIONS FOR HUBBARDTON ST 0161 (23)
 DONE BY JOSH HULETT FOUND IN THE ABOVE FILE.

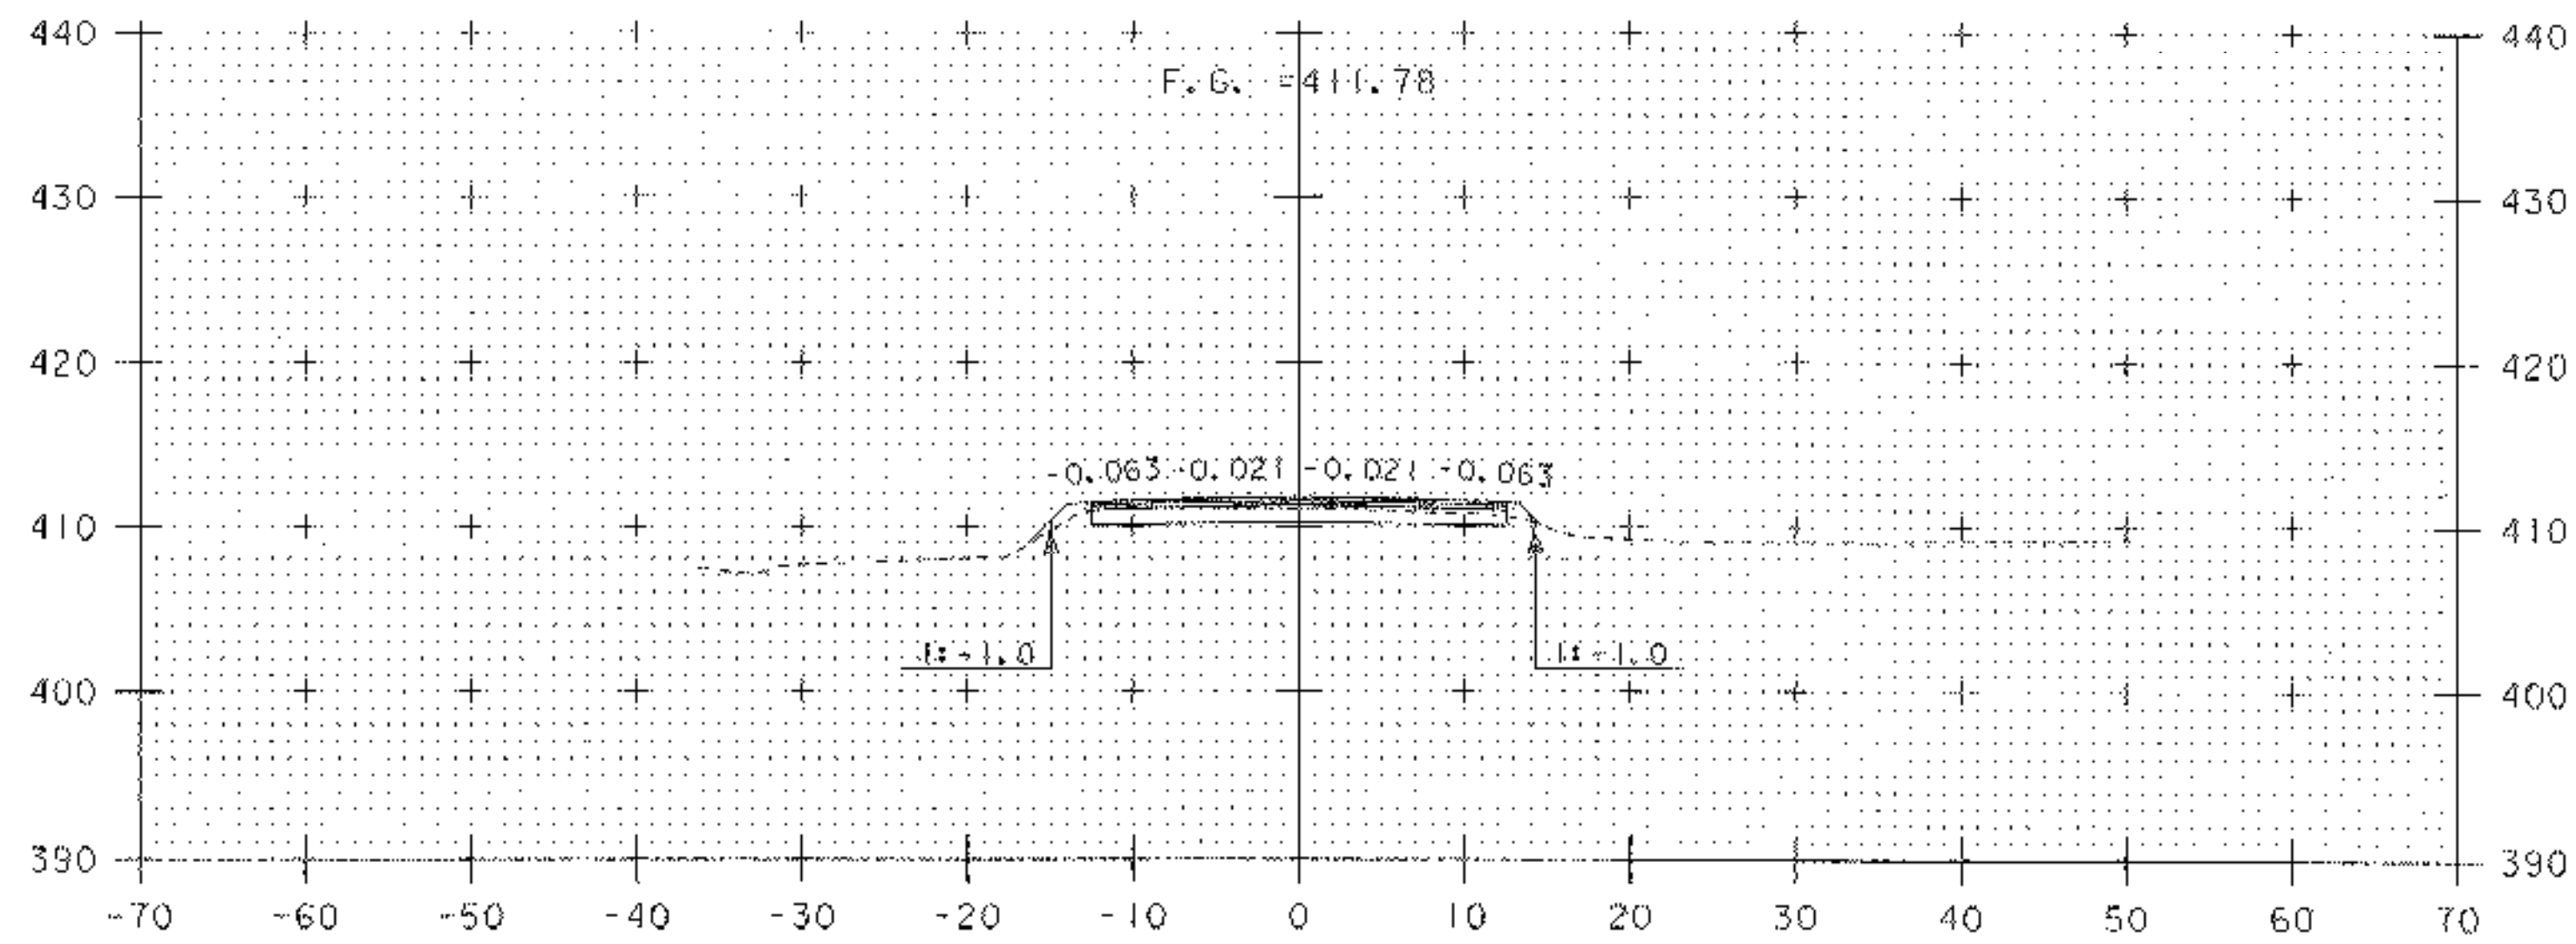


11+50

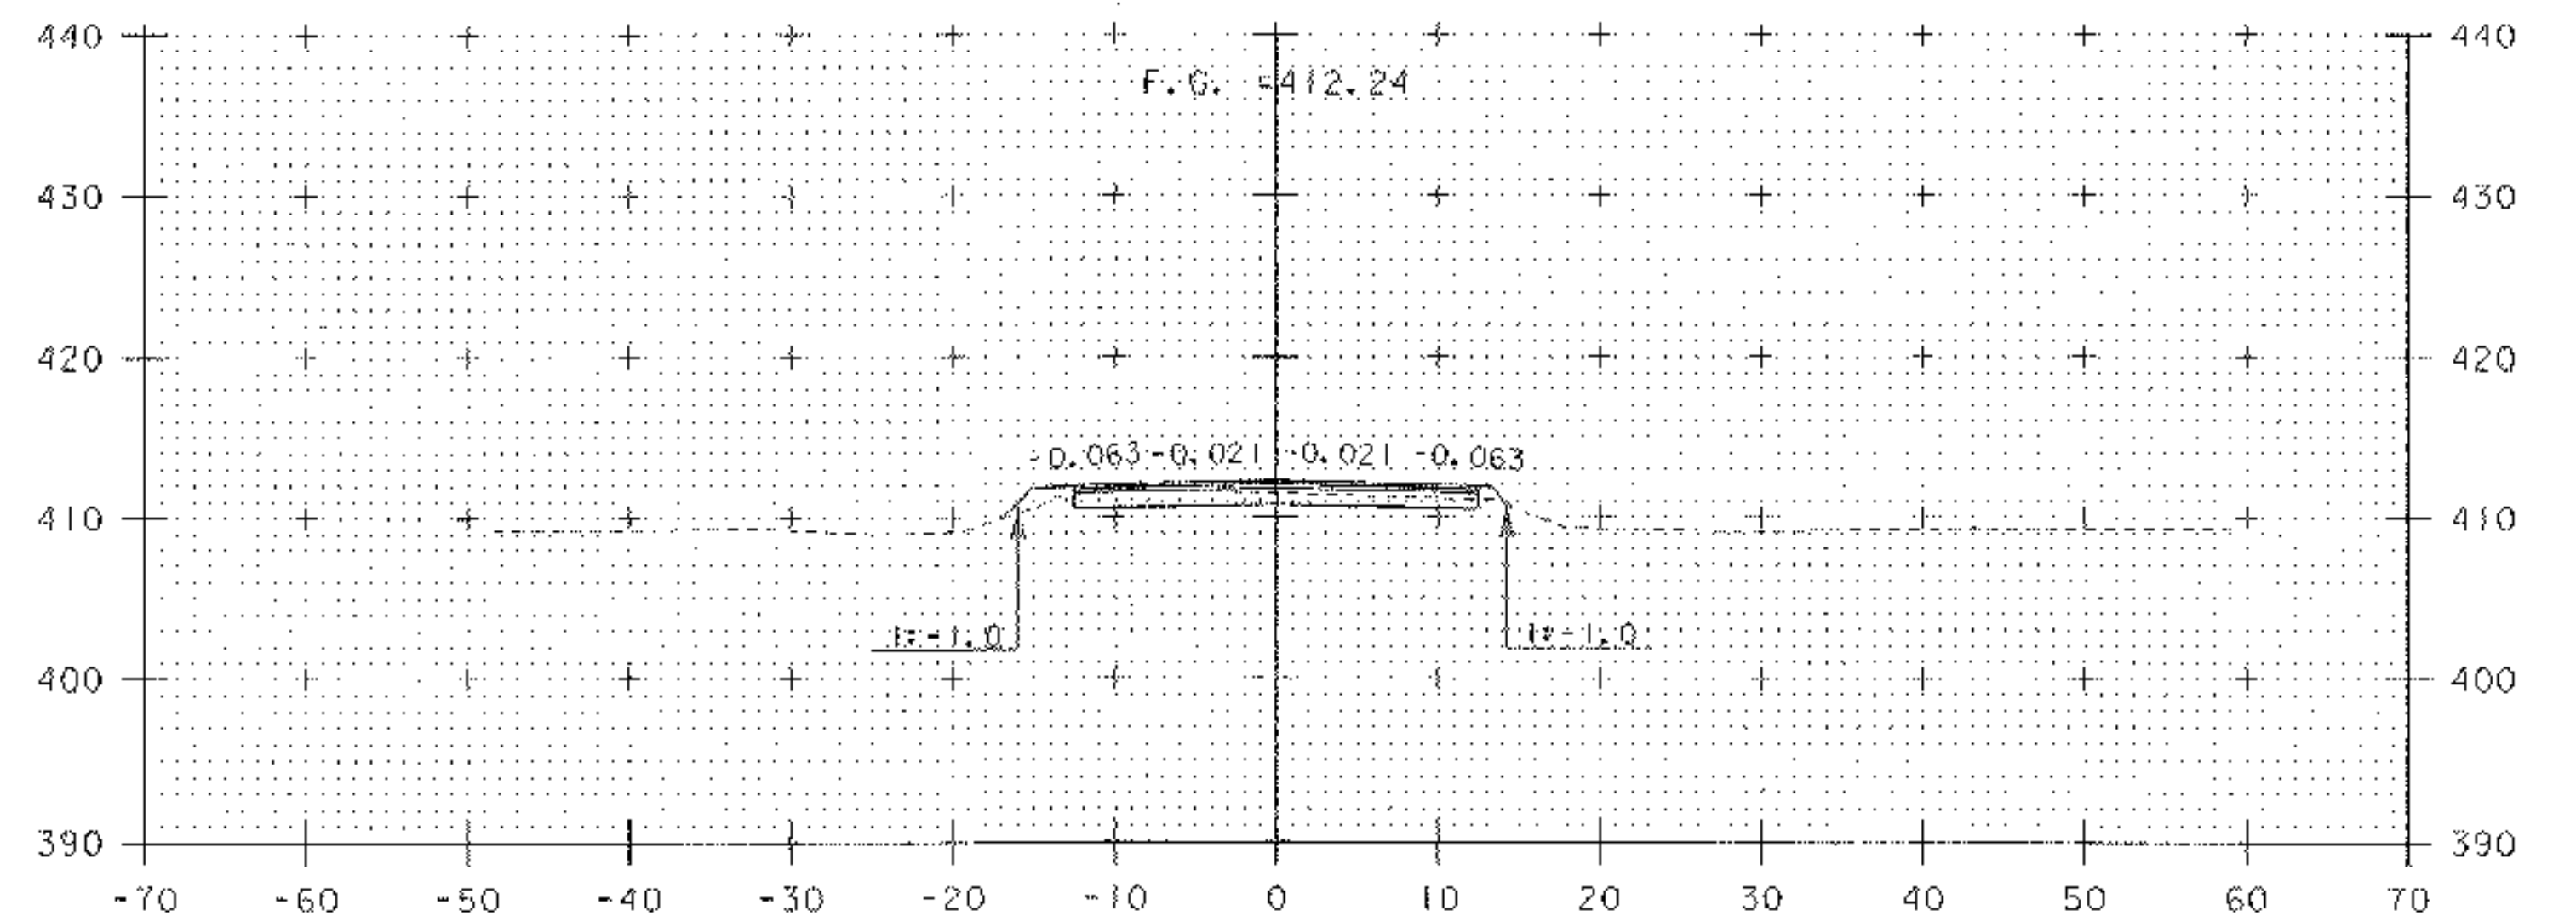


12+00

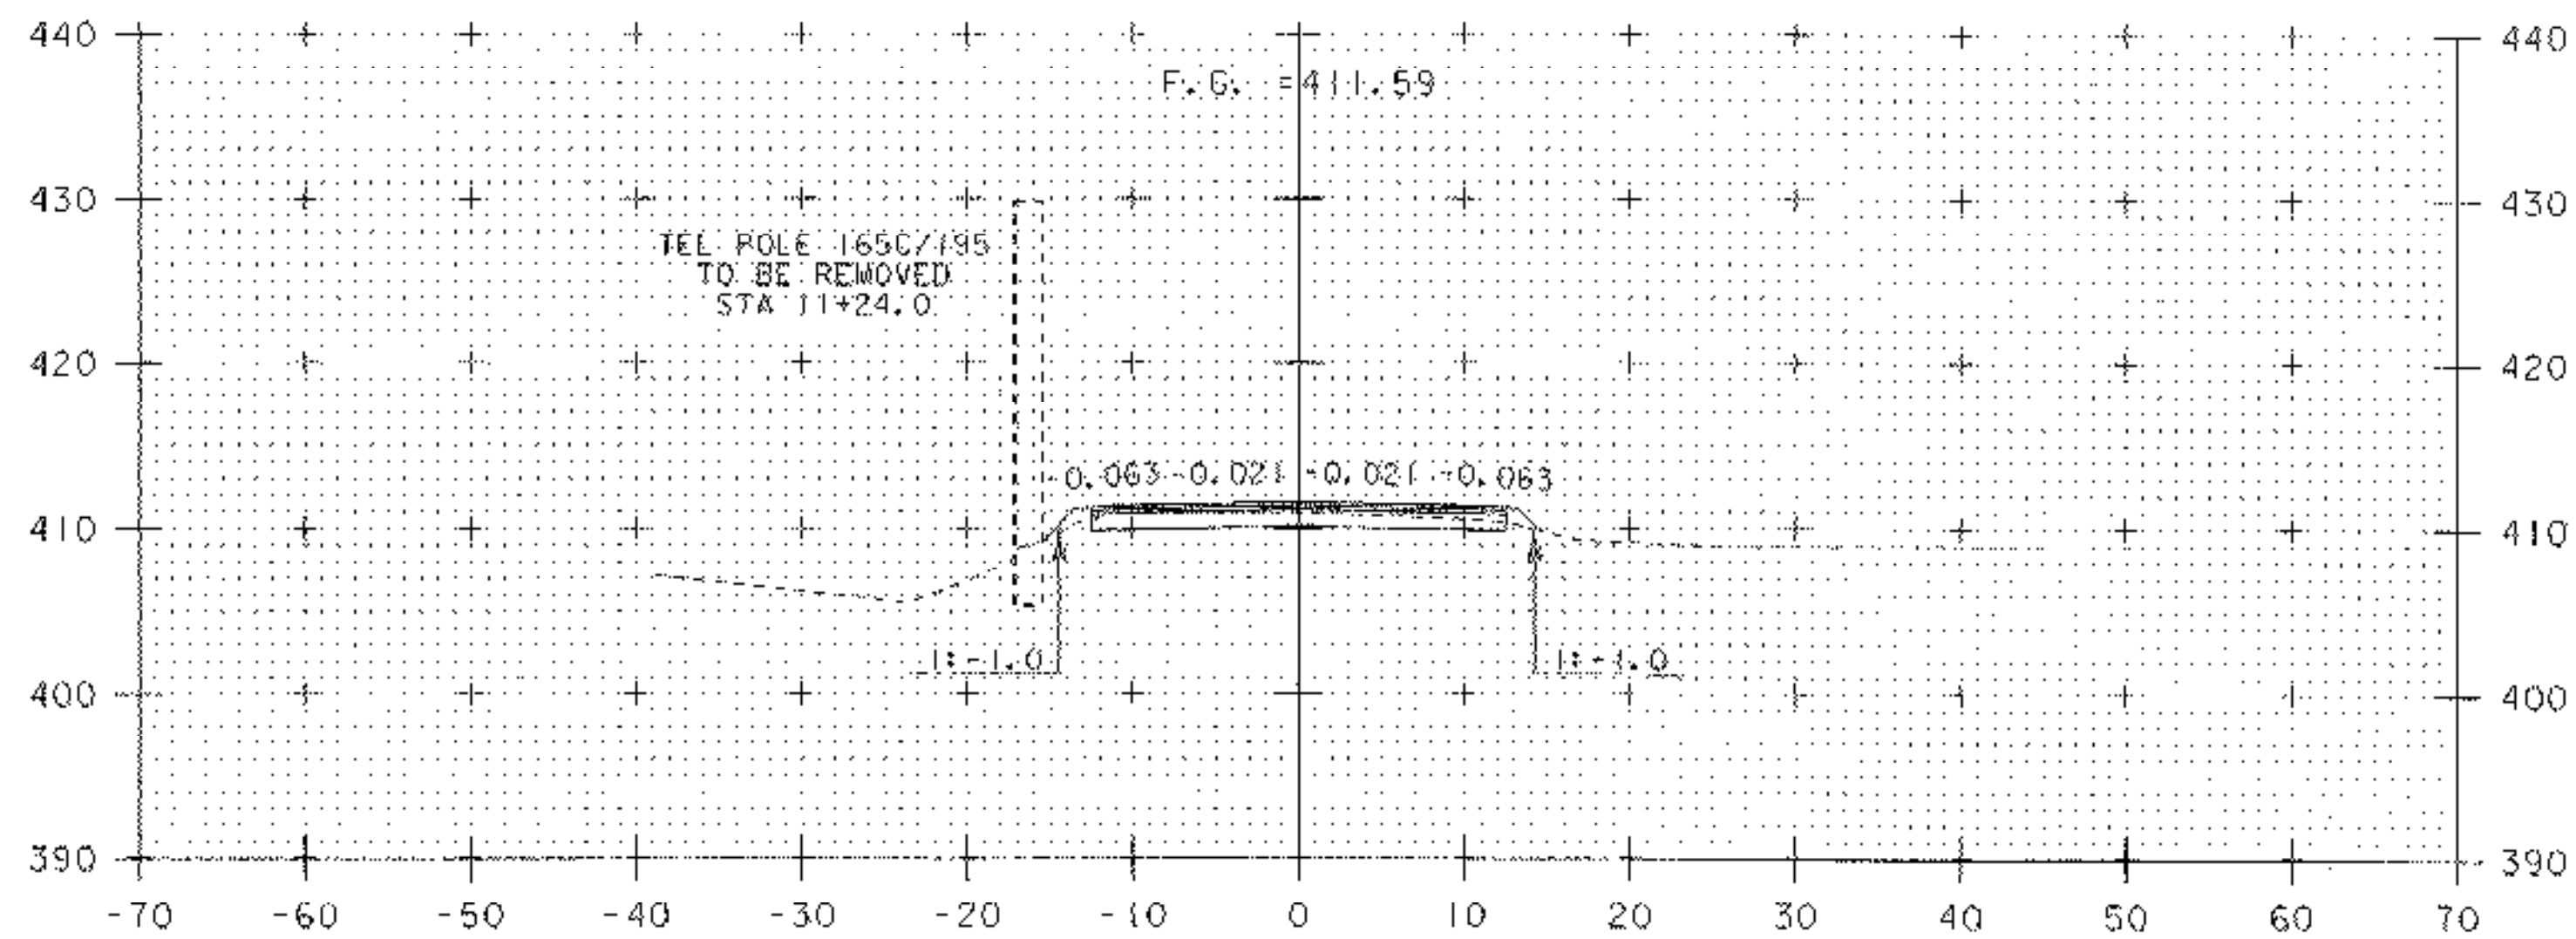

11+25

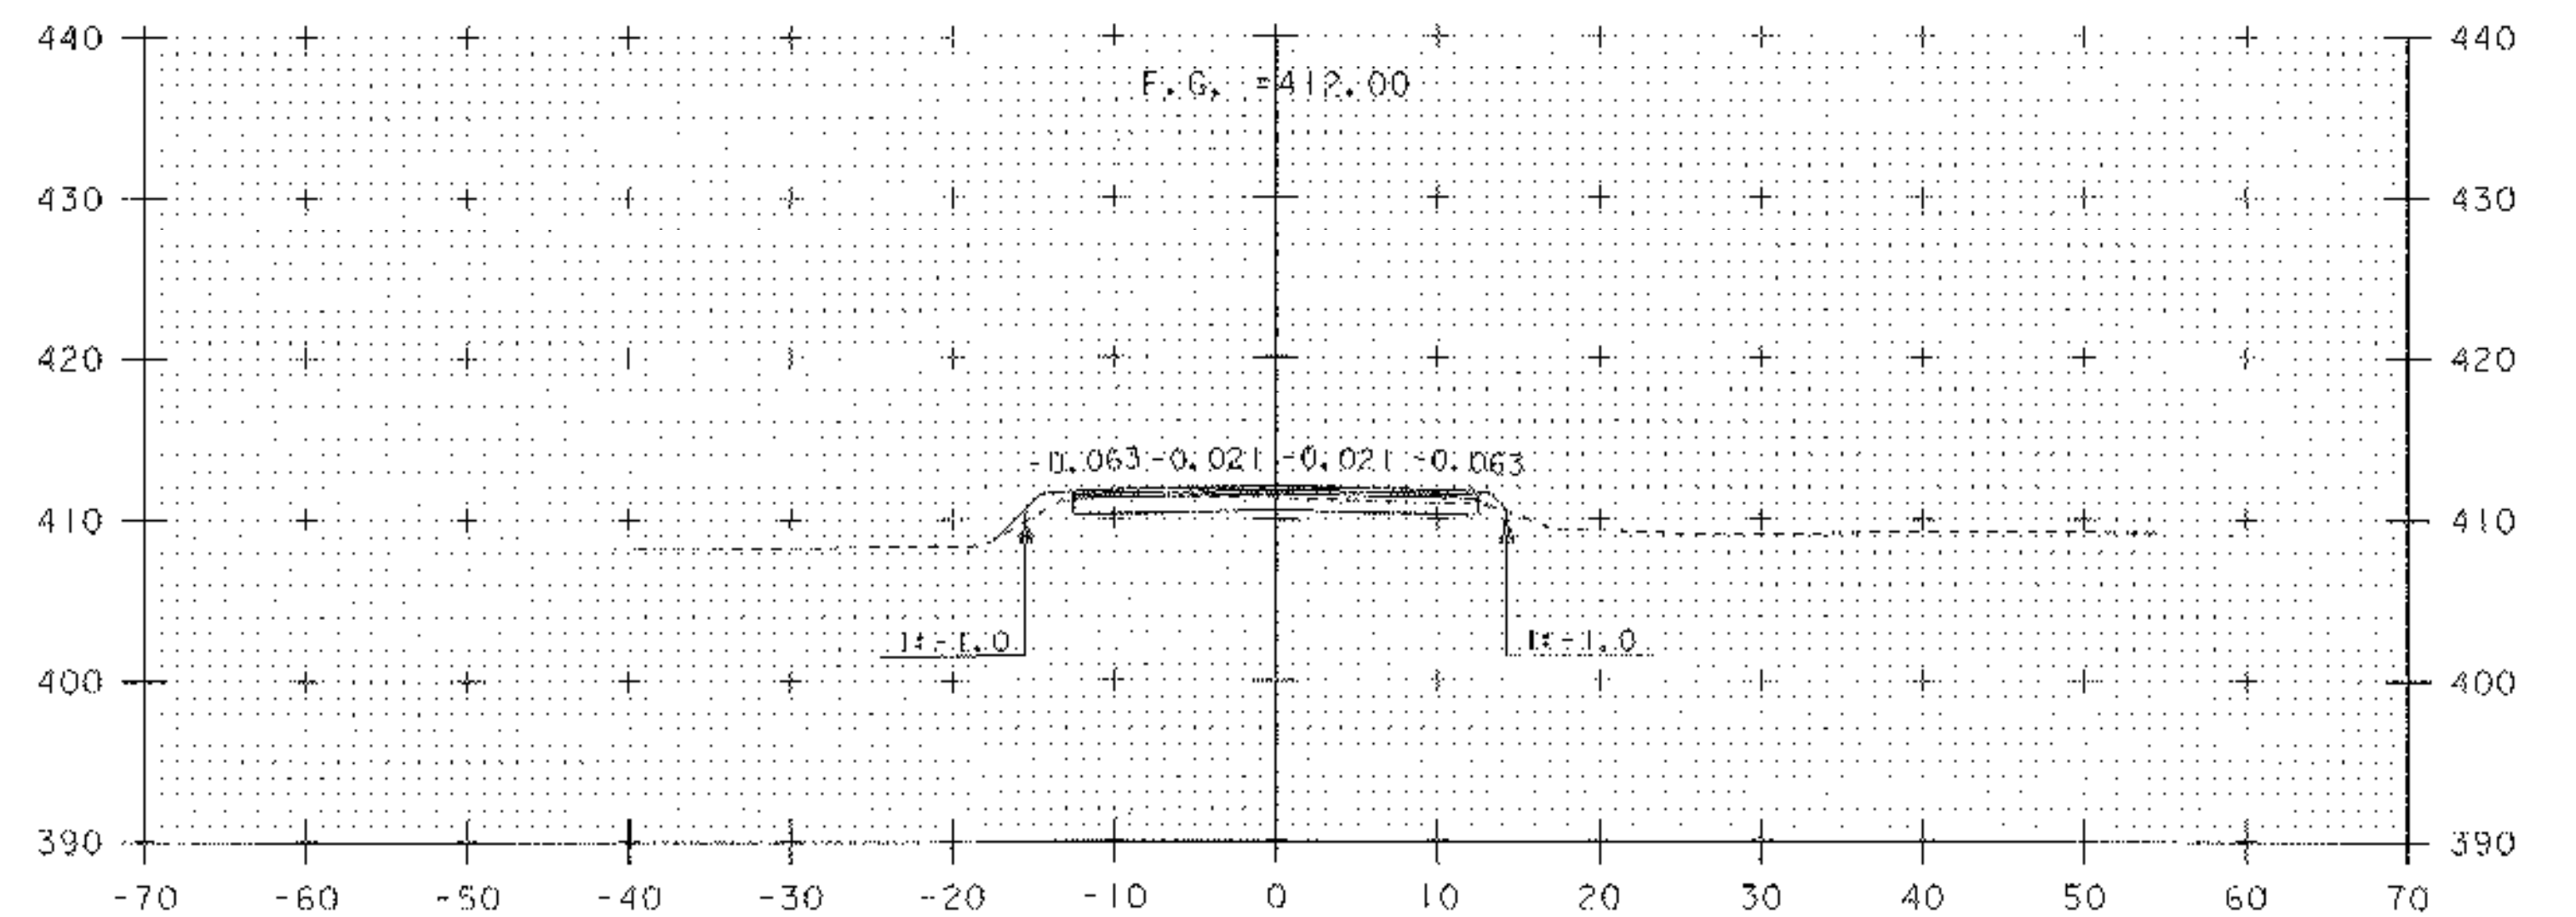

11+75

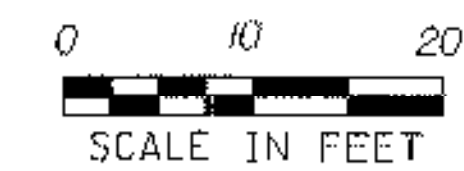

PROJECT NAME:	HUBBARDTON
PROJECT NUMBER:	ST 0161(23)
FILE NAME:	PW/03c044/Design/d03c044xs
PROJECT LEADER:	K. UPMAL
DESIGNED BY:	J. DEVLIN
CROSS SECTIONS STA 11+25 - 12+00	
PLOT DATE:	23-MAR-2006
DRAWN BY:	J. DEVLIN
CHECKED BY:	R. DELLASANTA
SHEET	87 OF 92