
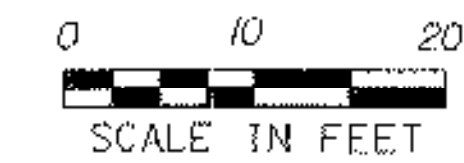
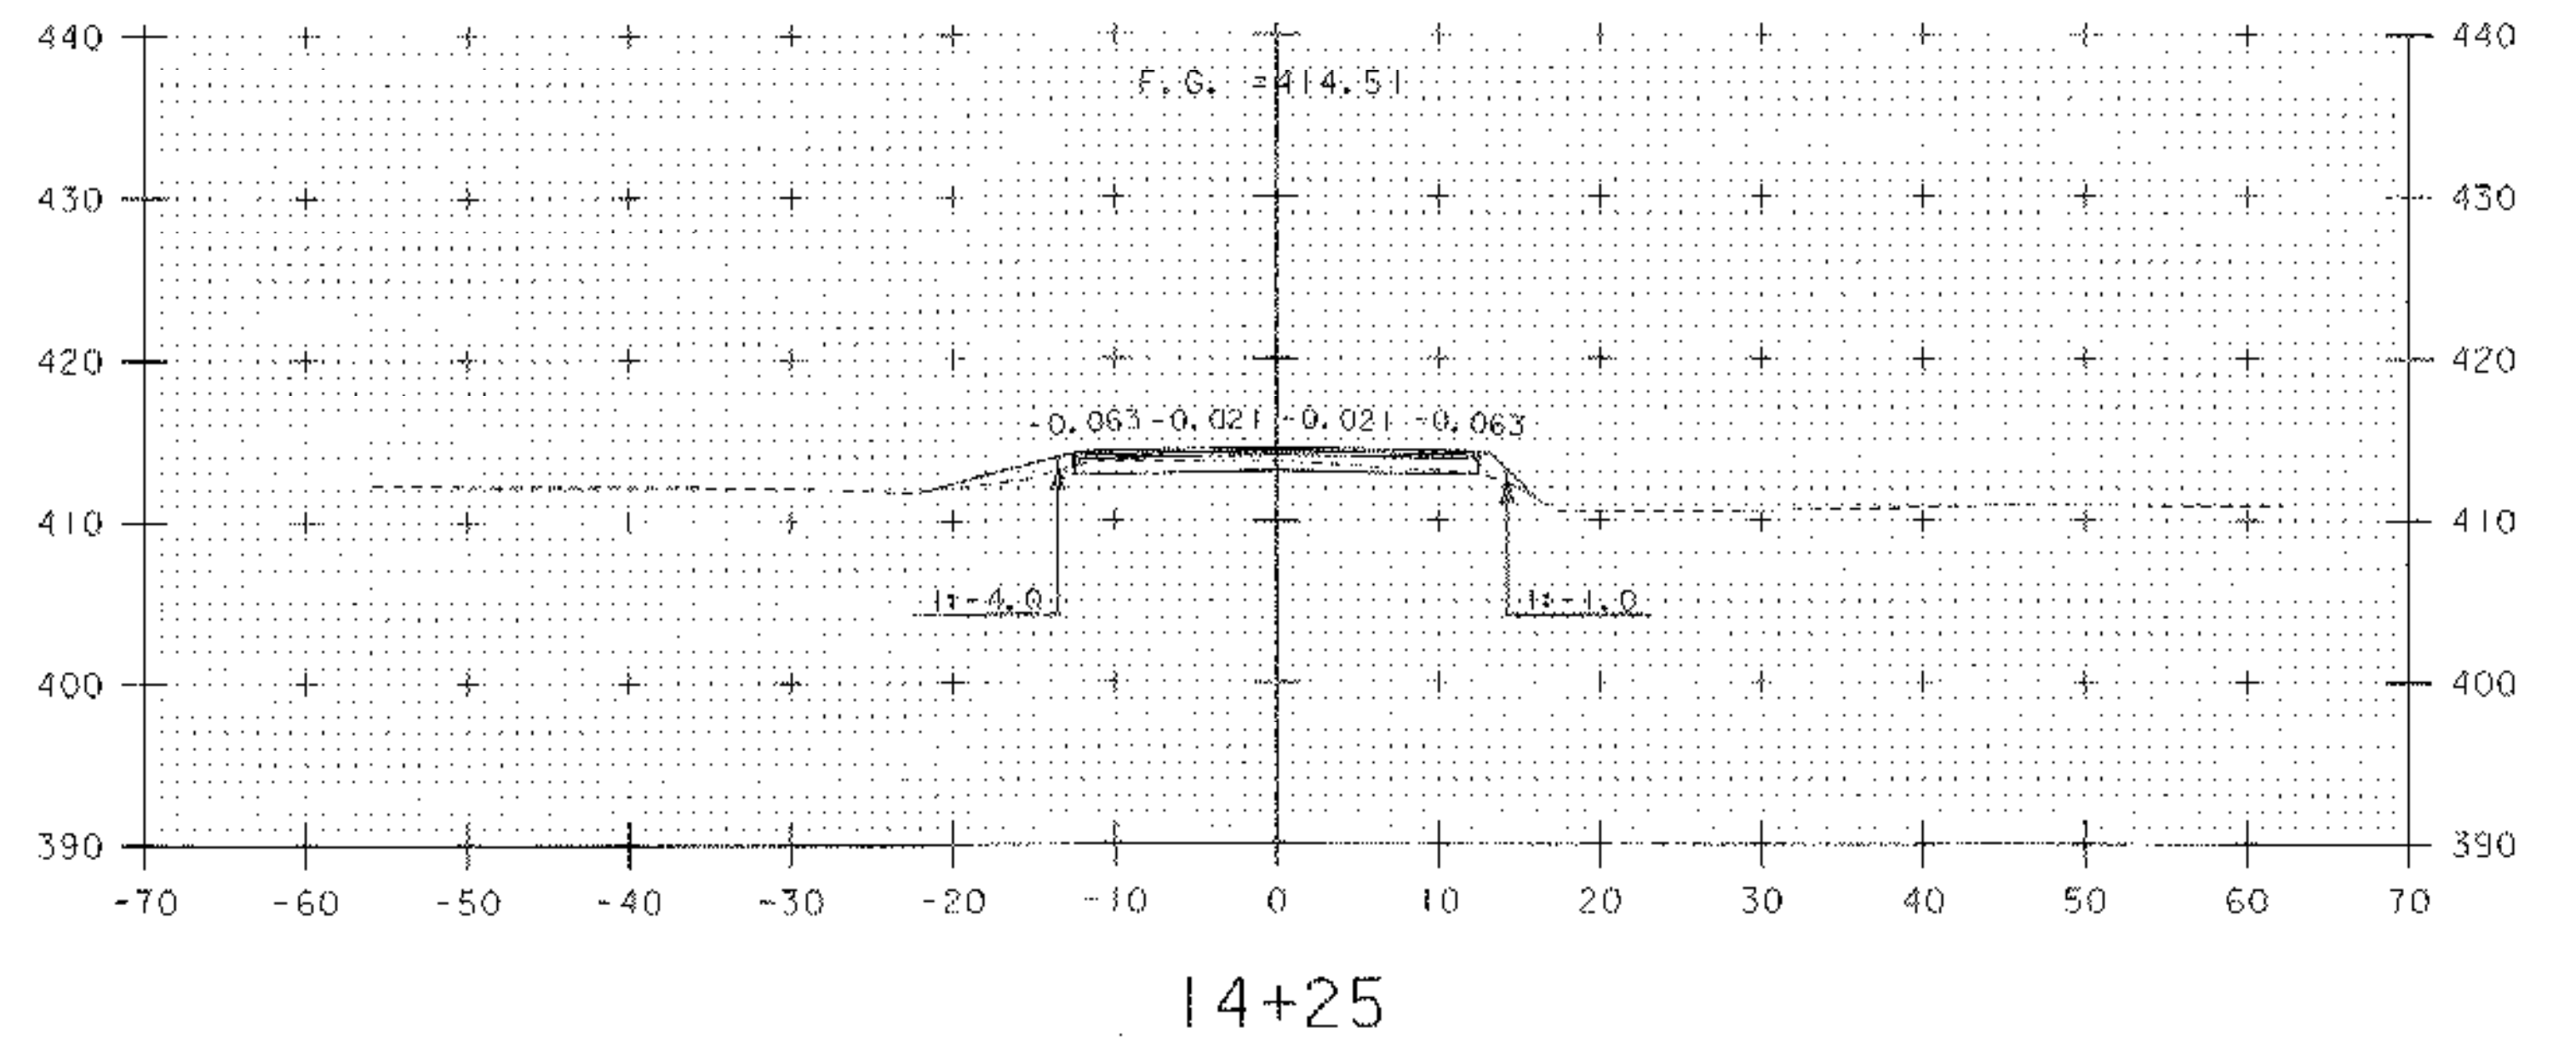
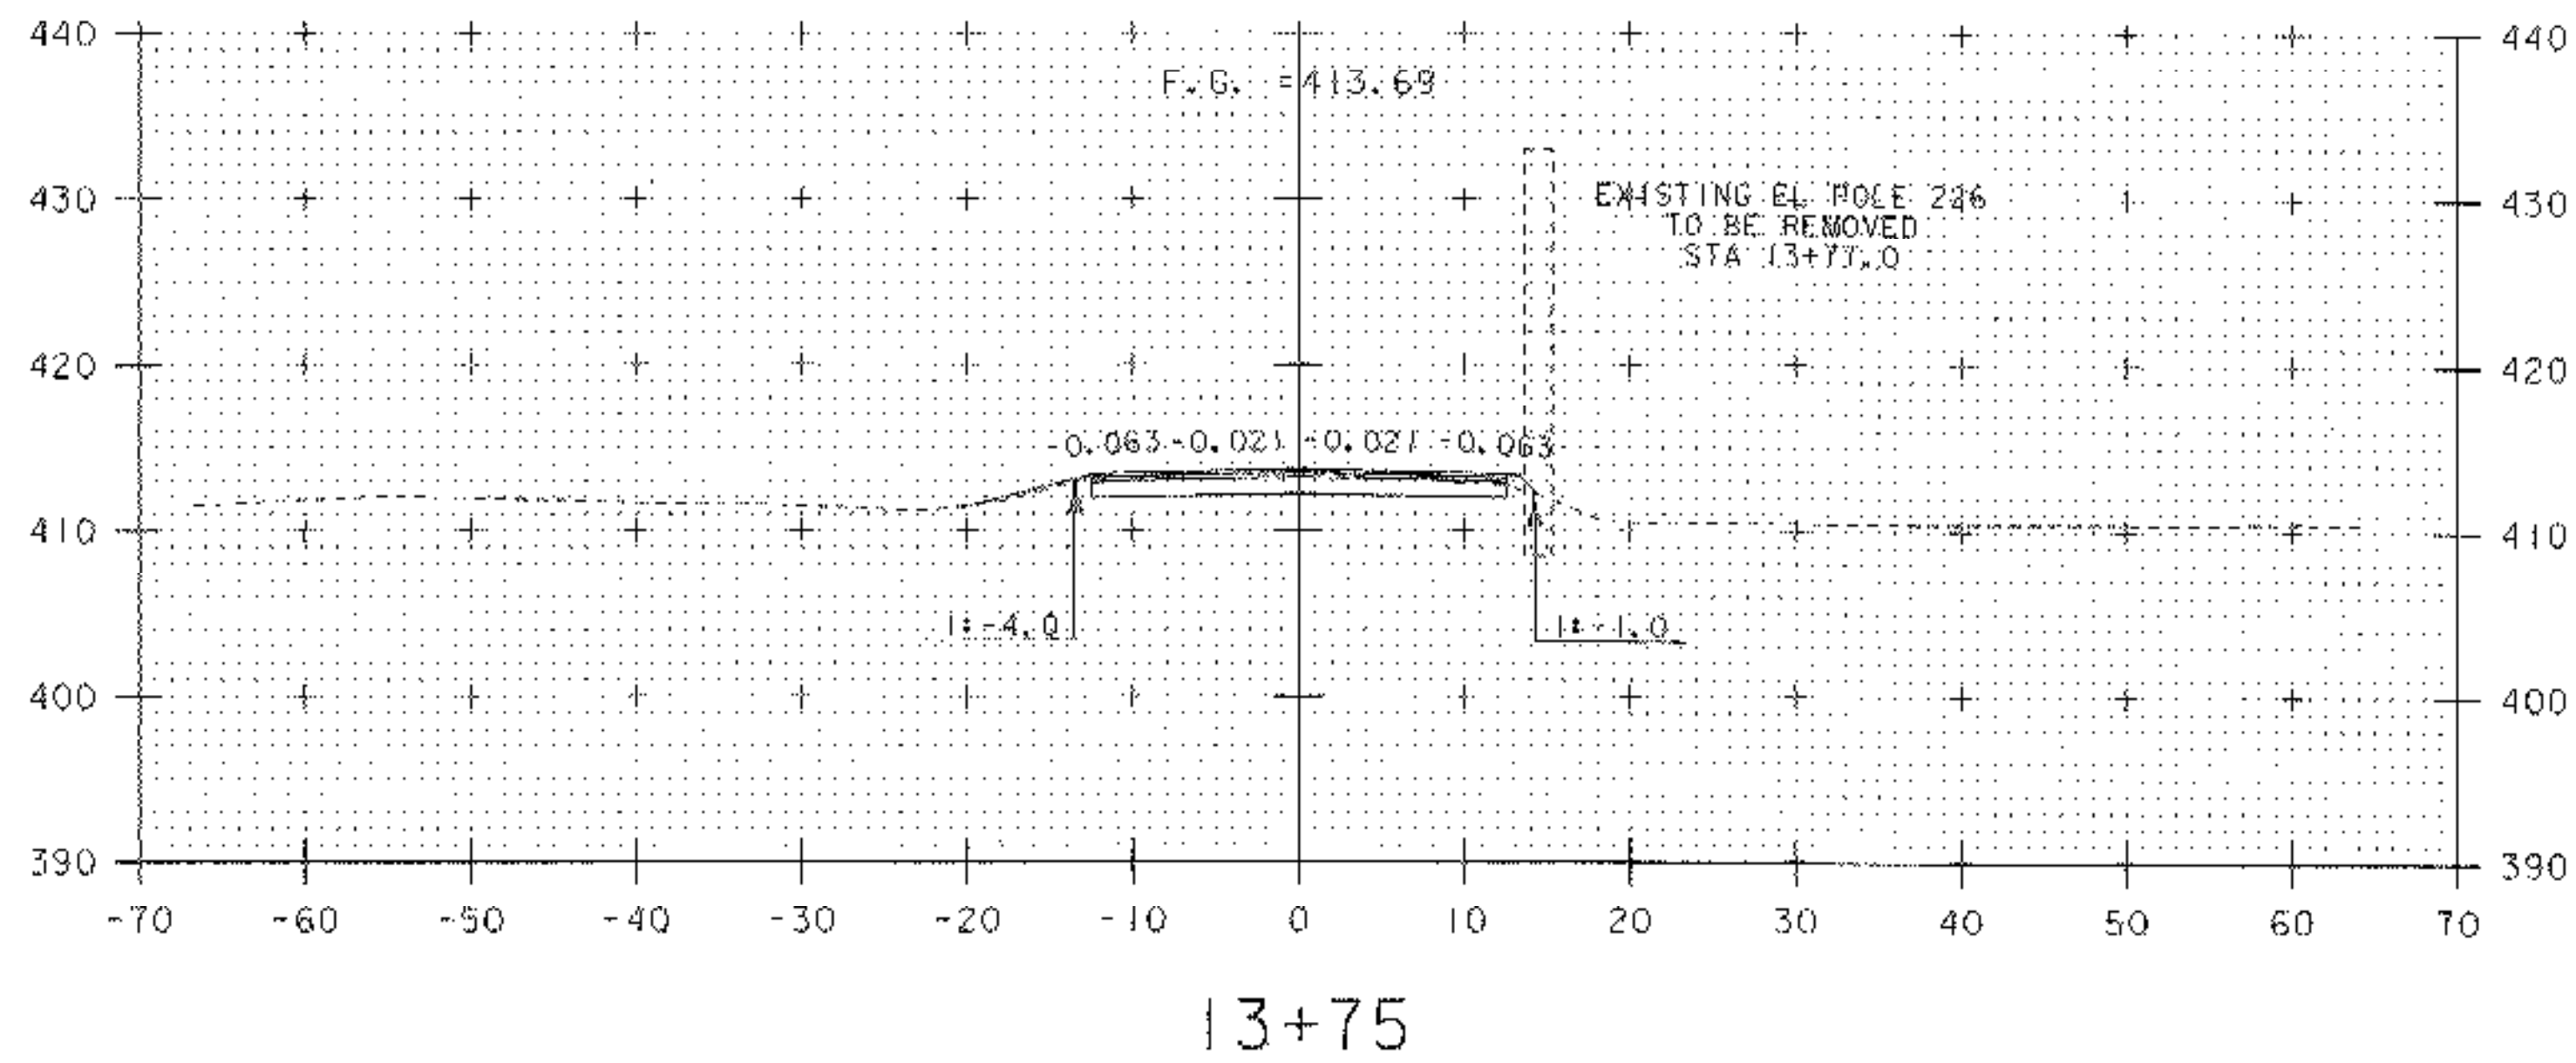
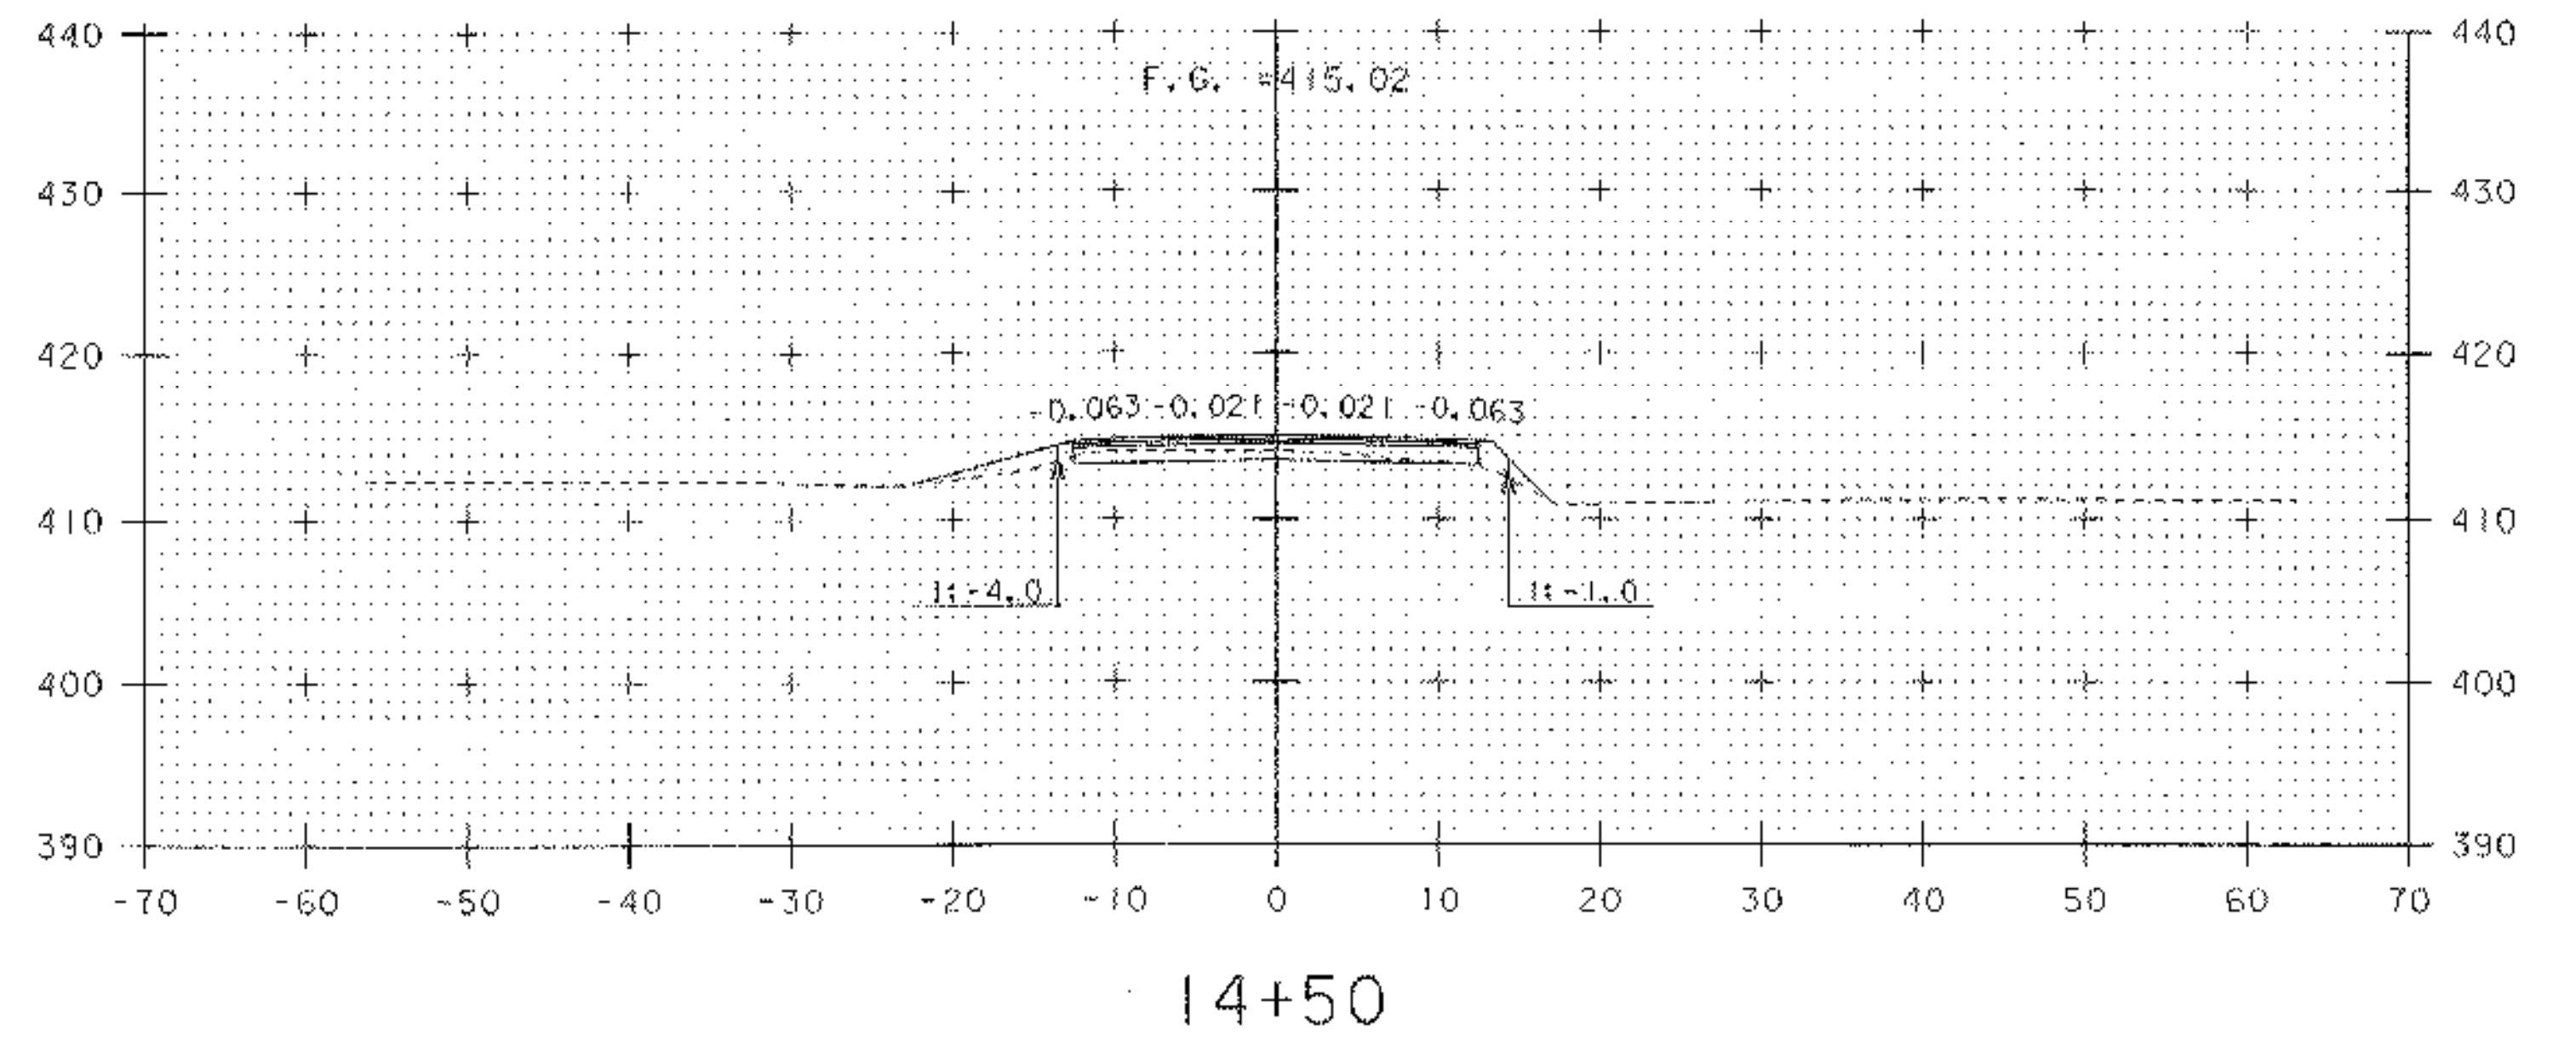


M:\PROJECTS\03c044\CONSTRUCTION\FINAL XS\c03c044FXS.DGN
 FINAL CROSS SECTIONS FOR HUBBARDTON ST 0161 (23)
 DONE BY JOSH HULETT FOUND IN THE ABOVE FILE.

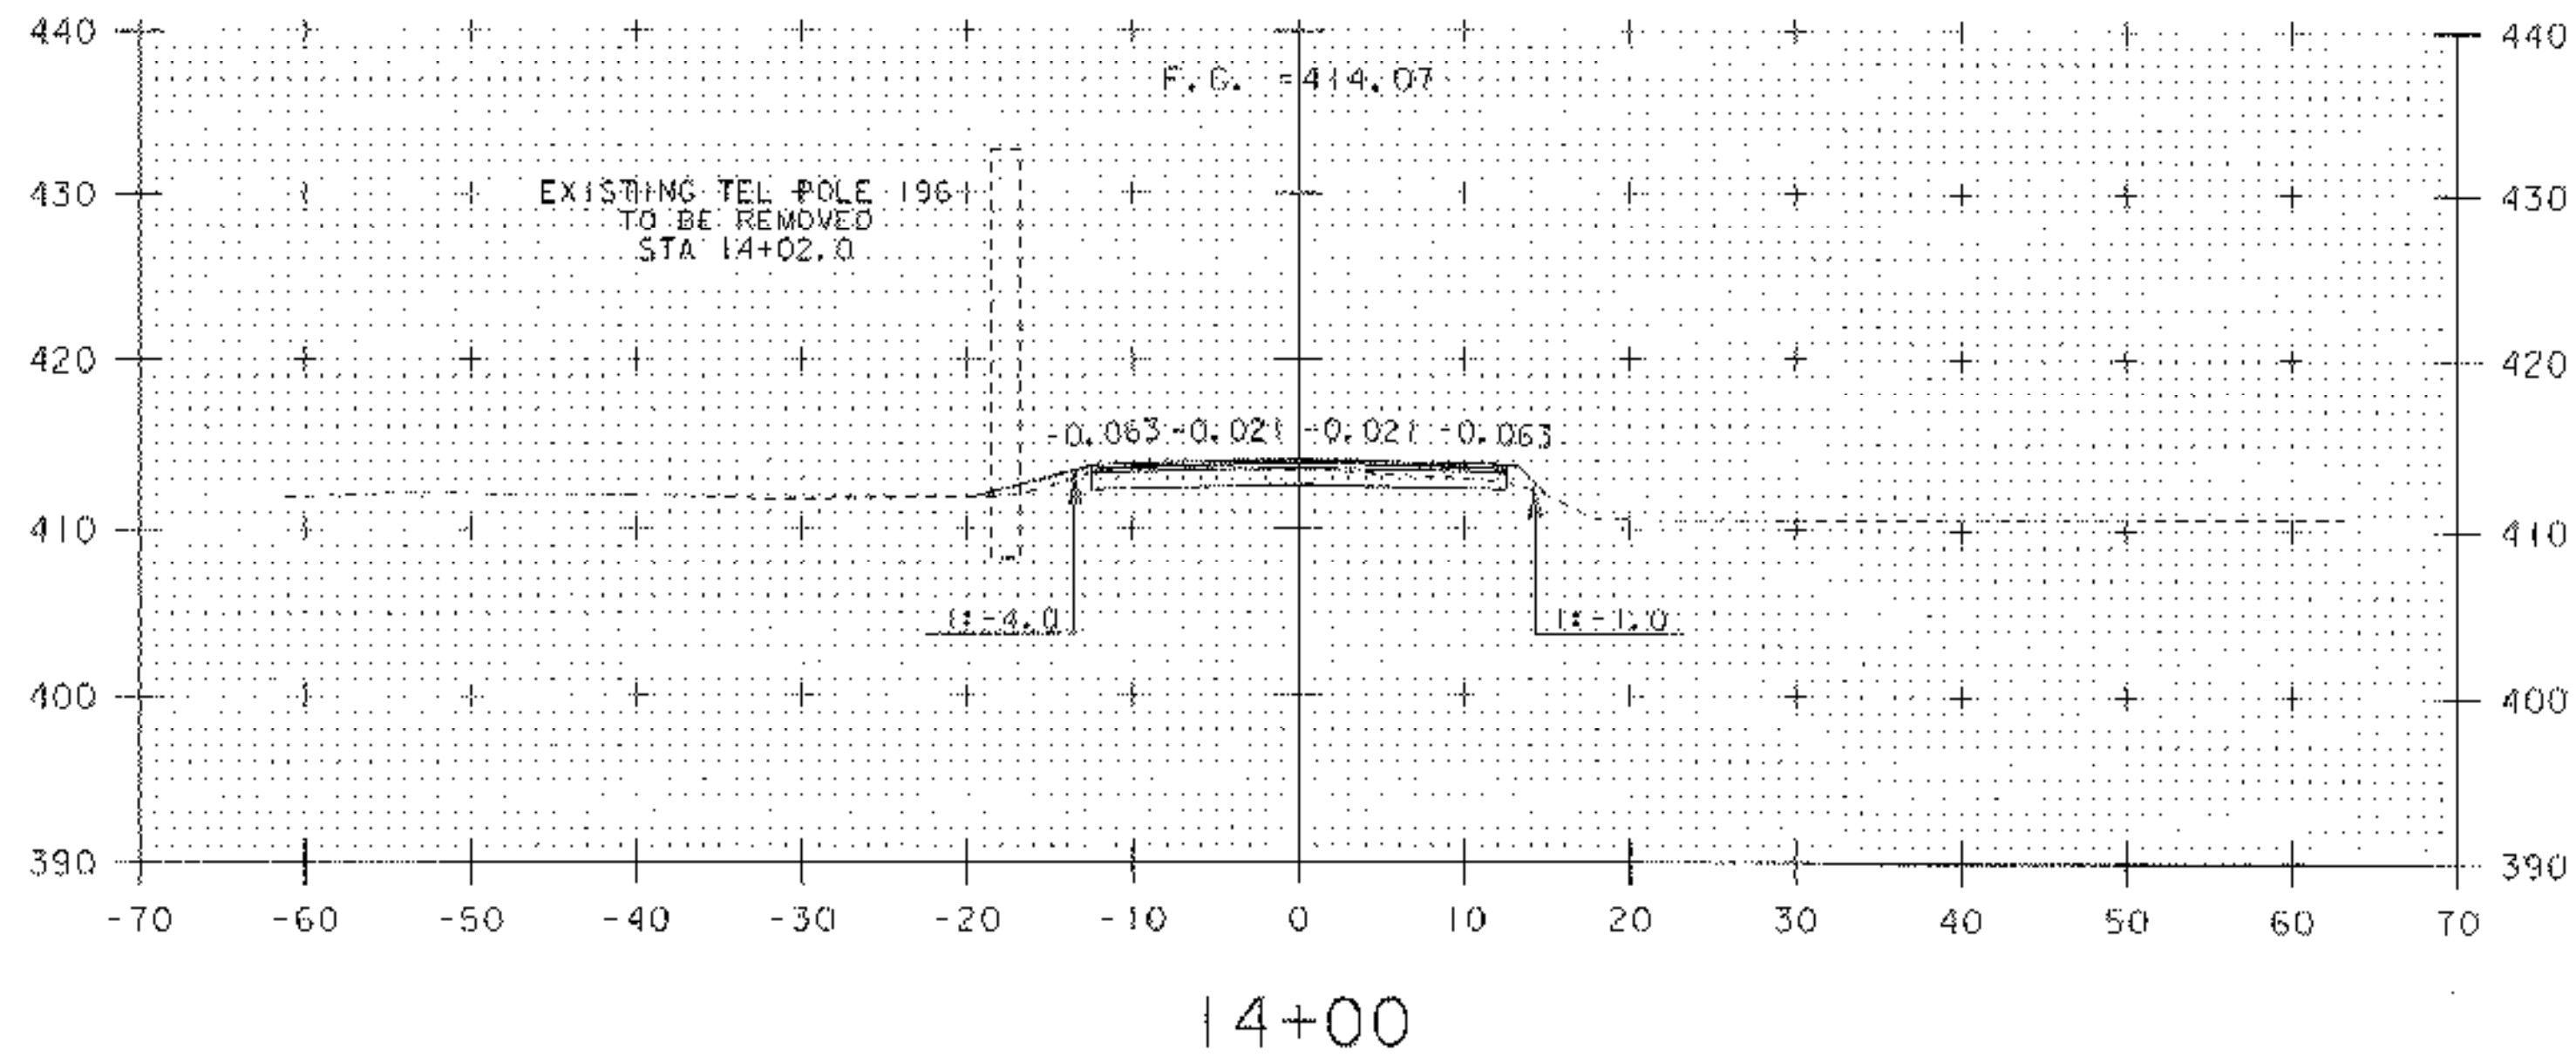

PROJECT NAME:	HUBBARDTON	PLOT DATE:	21-MAR-2006
PROJECT NUMBER:	ST 0161(23)	DRAWN BY:	J. DEVLIN
FILE NAME:	P:\03c044\Design\d03c044xs	DESIGNED BY:	J. DEVLIN
PROJECT LEADER:	K. UPMAL	CHECKED BY:	R. DELLASANTA
CROSS SECTIONS STA 13+75 - 14+50		SHEET 90 OF 92	