

TEMPORARY AND DURABLE 4 in YELLOW LINE
STA 417+00 TO 447+00
SOLID LT&RT


TEMPORARY AND DURABLE 4 in WHITE LINE
STA 417+00 TO 447+00
SOLID LT&RT

REMOVAL AND DISPOSAL OF GUIDE POSTS
STA 439+20 TO 441+73 RT - I3

MANUFACTURED TERMINAL SECTION (FLARED)
~~STA 438+40 TO 438+77 RT~~
~~STA 442+13 TO 442+50 RT~~

STEEL BEAM GUARD RAIL (GALVANIZED)
~~STA 438+77 TO 442+13 RT~~
439+01.5 ~ 441+64 RT

438+64 ~ 439+01.5 RT
441+64 ~ 442+01.5 RT

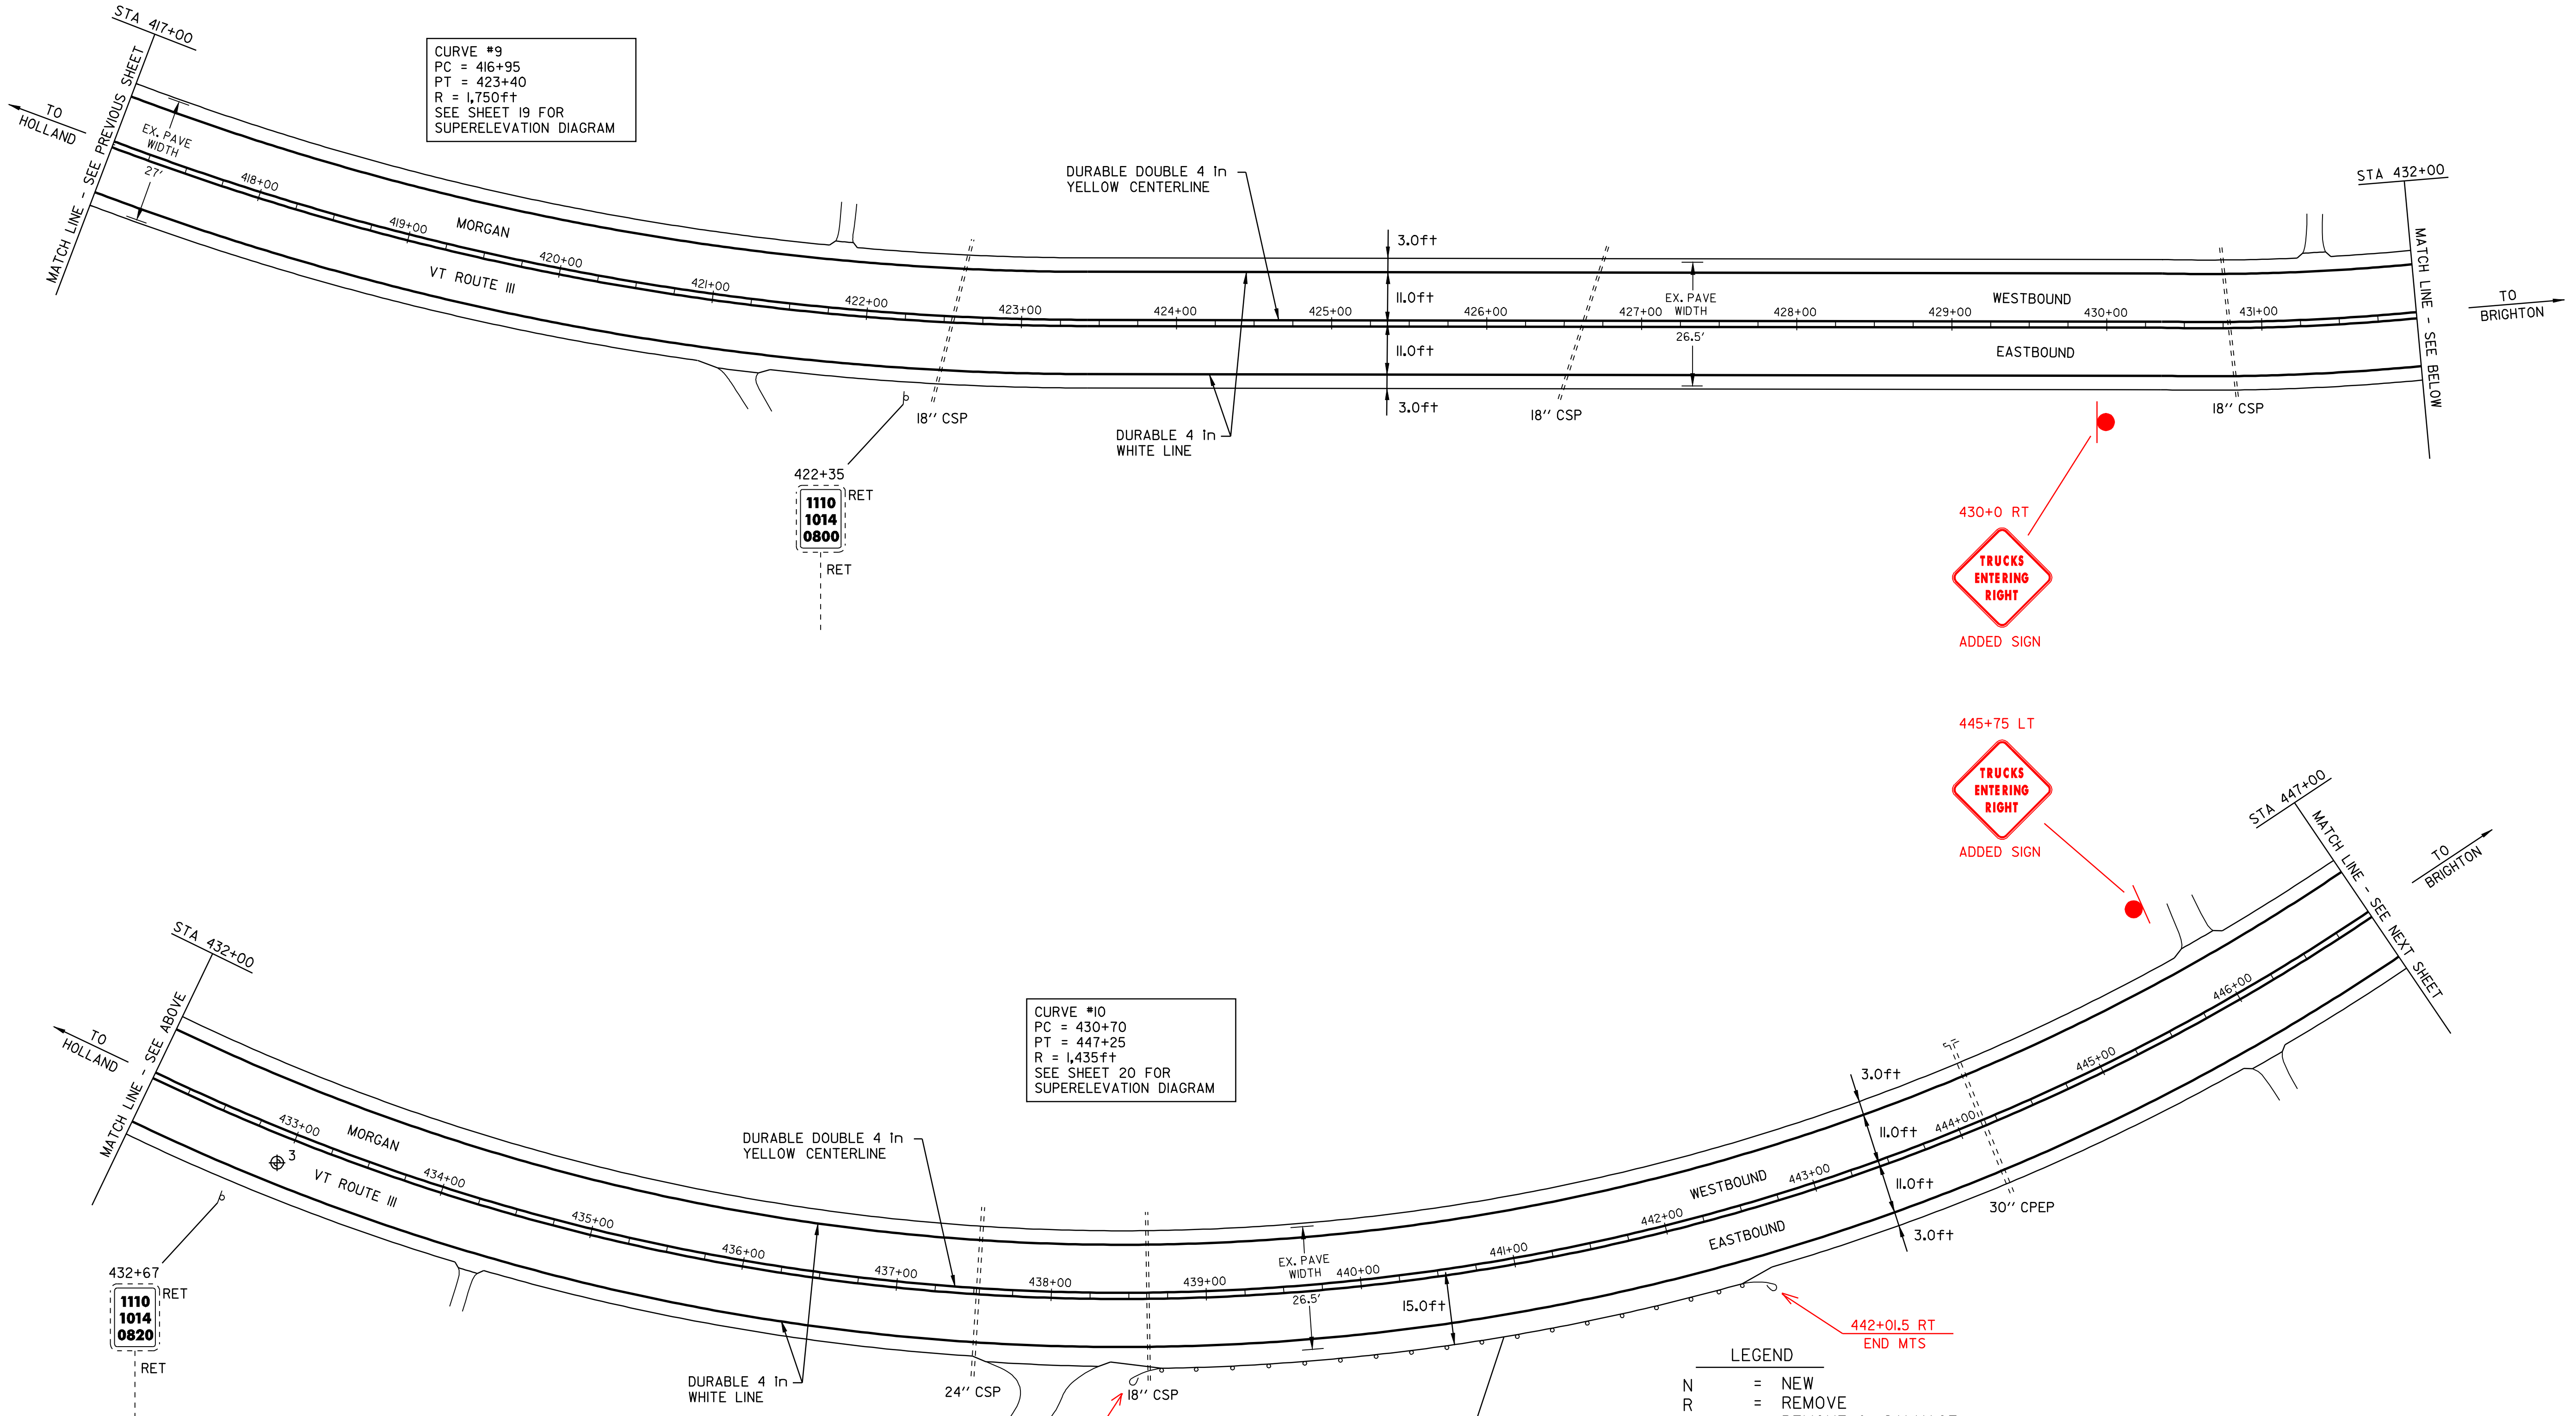

PAVEMENT CORES -

#	TOTAL DEPTH (in)	SOLID CORE	COMMENTS
3	5 1/2	YES	NON-DRAINABLE BASE, BOTTOM 2" BROKE UP

NOTE:
- NO PCC UNDER ANY CORES
- NO CORES OVER ASPHALTED (UNLESS NOTED)
- NO SHOULDER CORES

CURVE #10
PC = 430+70
PT = 447+25
R = 1,435ft
SEE SHEET 20 FOR SUPERELEVATION DIAGRAM

CURVE #9
PC = 416+95
PT = 423+40
R = 1,750ft
SEE SHEET 19 FOR SUPERELEVATION DIAGRAM

LEGEND

N	=	NEW
R	=	REMOVE
R&S	=	REMOVE & SALVAGE
S	=	SALVAGE
RET	=	RETAIN
B-T-O-B	=	BACK TO BACK
⊕	⊕	CATCH BASIN/DI
⊕	⊕	EXISTING THROAT DI
I		MARKER POST
⊗		UTILITY POLE
⊗		UTIL. POLE W/UNDERGROUND UTIL.
⊗		DRIVE

~~STA 438+40 TO 438+77 RT~~
INSTALL MANUFACTURED TERMINAL SECTION (FLARED)
STA 439+20 TO 441+73 RT
REMOVAL AND DISPOSAL OF GUIDE POSTS
~~STA 438+77 TO 442+13 RT~~
INSTALL STEEL BEAM GUARD RAIL (GALVANIZED)
~~STA 442+13 TO 442+50 RT~~
INSTALL MANUFACTURED TERMINAL SECTION (FLARED)

PAVING PROJECT LAYOUT SHEET #4

DESIGNED BY BCE/PJM DATE 8-05
 DRAWN BY C.E.A., INC. DATE 8-05
 DESIGN FILE NO. /pave/04c036/p04c036.dgn
 PRF FILE p04c036i04.r DATE PLOTTED II-JUN-2007 14:
 PROJ. NAME **MORGAN - BRIGHTON**
 PROJ. NO. **STP 2404(1)S**
 SHEET **11** OF **26** SHEETS