
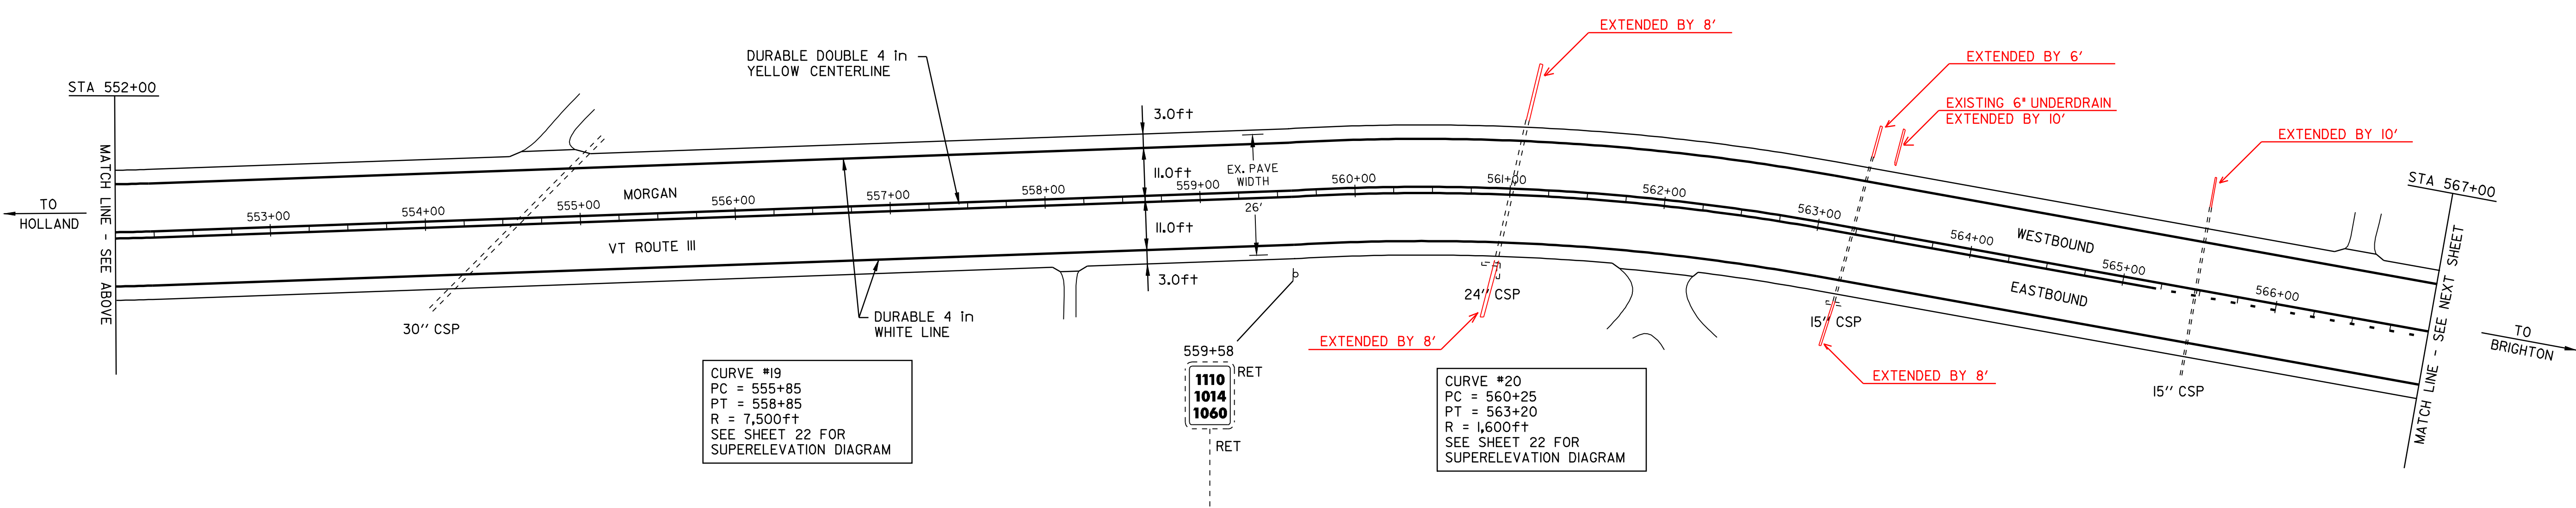


TEMPORARY AND DURABLE 4 in YELLOW LINE
 STA 537+00 TO 542+70 DASHED LT & SOLID RT
 STA 542+70 TO 565+20 SOLID LT&RT
 STA 565+20 TO 567+00 SOLID LT & DASHED RT

TEMPORARY AND DURABLE 4 in WHITE LINE
 STA 537+00 TO 567+00 SOLID LT&RT

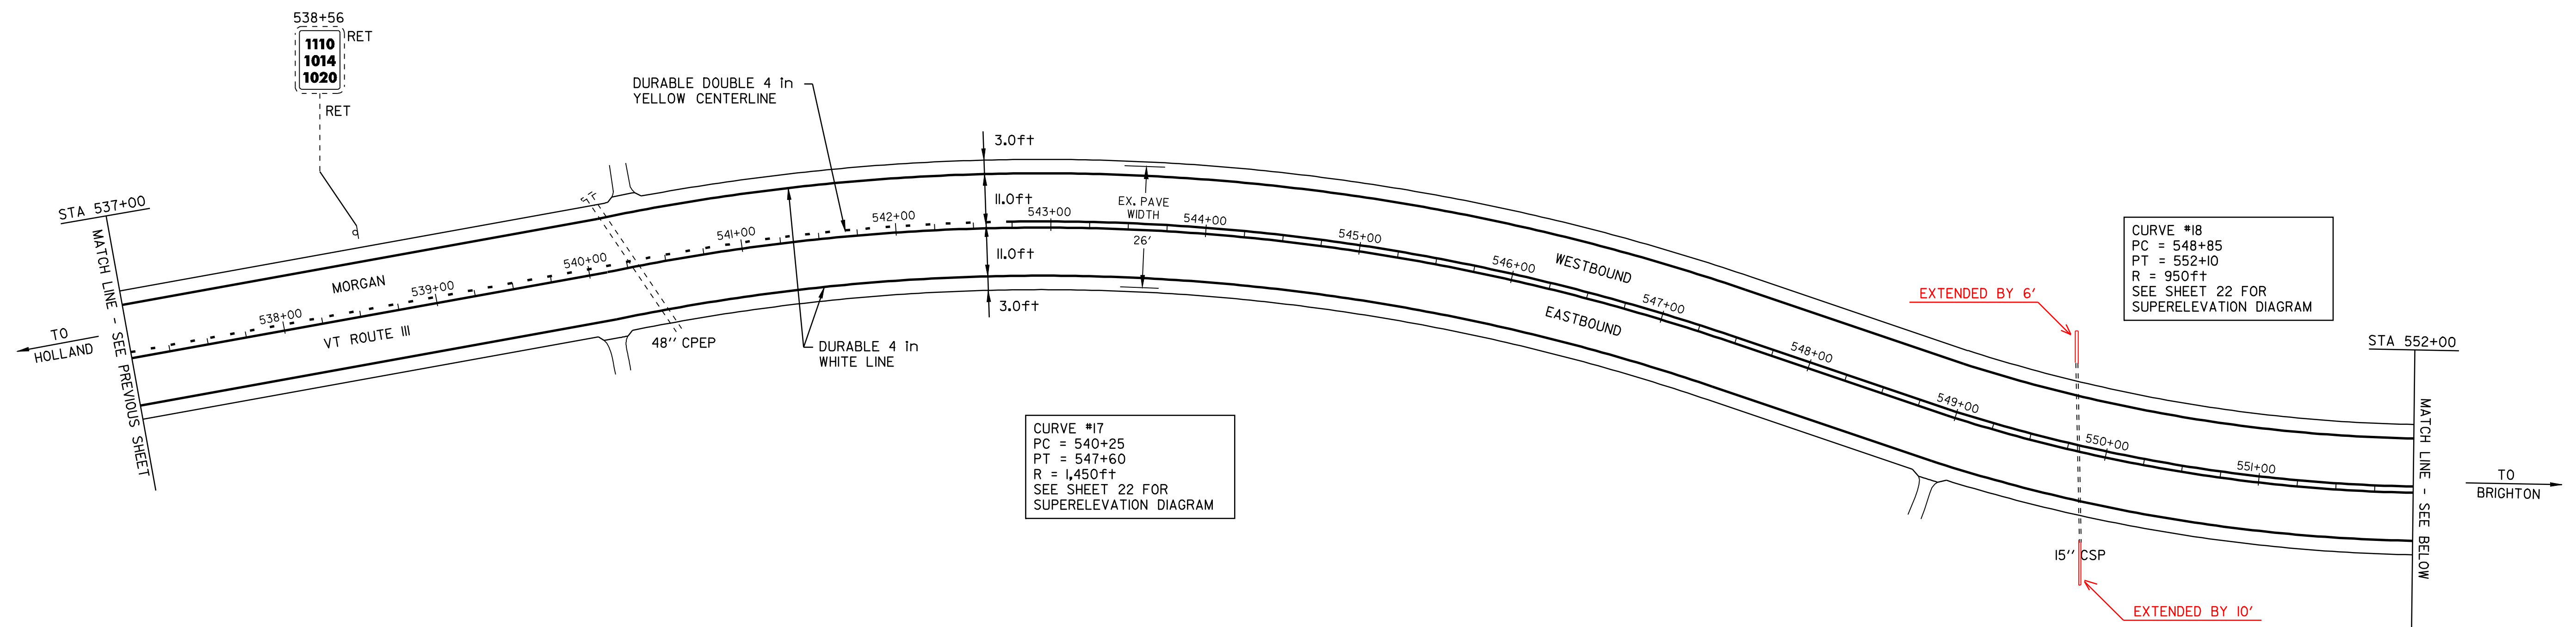

- LEGEND
- N = NEW
 - R = REMOVE
 - R&S = REMOVE & SALVAGE
 - S = SALVAGE
 - RET = RETAIN
 - B-TO-B = BACK TO BACK
 - ⊕ ⊞ □ = CATCH BASIN/DI
 - ⊕ □ = EXISTING THROAT DI
 - I = MARKER POST
 - ⊗ = UTILITY POLE
 - ⊗/I = UTIL. POLE W/UNDERGROUND UTIL.
 - ⌌ = DRIVE

PAVING PROJECT LAYOUT SHEET #8

DESIGNED BY BCE/PJM DATE 8-05

DRAWN BY C.E.A., INC. DATE 8-05

DESIGN FILE NO. /pave/04c036/p04c036.dgn

PRF FILE p04c036i08.1 DATE PLOTTED II-JUN-2007 14:44

PROJ. NAME **MORGAN - BRIGHTON**

PROJ. NO. **STP 2404(1)S**

SHEET **15** OF **26** SHEETS