

TEMPORARY AND DURABLE 4 in YELLOW LINE  
 STA 0+00 to 7+05  
 SOLID LT&RT

TEMPORARY AND DURABLE LETTER OR SYMBOL  
 STA 7+02 RT  
 "STOP"

TEMPORARY AND DURABLE 4 in WHITE LINE  
 STA 0+00 to 7+05  
 SOLID LT&RT

TEMPORARY AND DURABLE 24 in STOP BAR  
 STA 7+02 RT  
 VT ROUTE 114

REMOVING SIGNS  
 2

REMOVAL AND DISPOSAL OF GUARD RAIL  
 STA 3+26 TO 4+76 RT  
 STA 3+30 TO 4+55 LT  
 STA 5+26 TO 6+51 RT  
 STA 5+05 TO 6+43 LT


MANUFACTURED TERMINAL SECTION (FLARED)  
 STA 3+26 TO 3+64 RT  
 STA 3+30 TO 3+68 LT  
 STA 6+05 TO 6+43 LT  
 STA 6+14 TO 6+51 RT

STEEL BEAM GUARD RAIL (GALVANIZED)  
 STA 3+64 TO 4+51 RT  
 STA 3+68 TO 4+30 LT  
 STA 5+30 TO 6+05 LT  
 STA 5+51 TO 6+14 RT

H.D. STEEL BEAM GUARD RAIL (GALVANIZED)  
 STA 4+30 TO 4+55 LT  
 STA 4+51 TO 4+76 RT  
 STA 5+05 TO 5+30 LT  
 STA 5+26 TO 5+51 RT

REMOVAL OF EXISTING RAILING  
 STA 4+55 TO 5+05 LT  
 STA 4+76 TO 5+26 RT

BRIDGE RAIL - H.D.S.B. FASCIA MOUNTED, MOD. 3  
 STA 4+76 TO 5+26 RT  
 STA 4+55 TO 5+05 LT

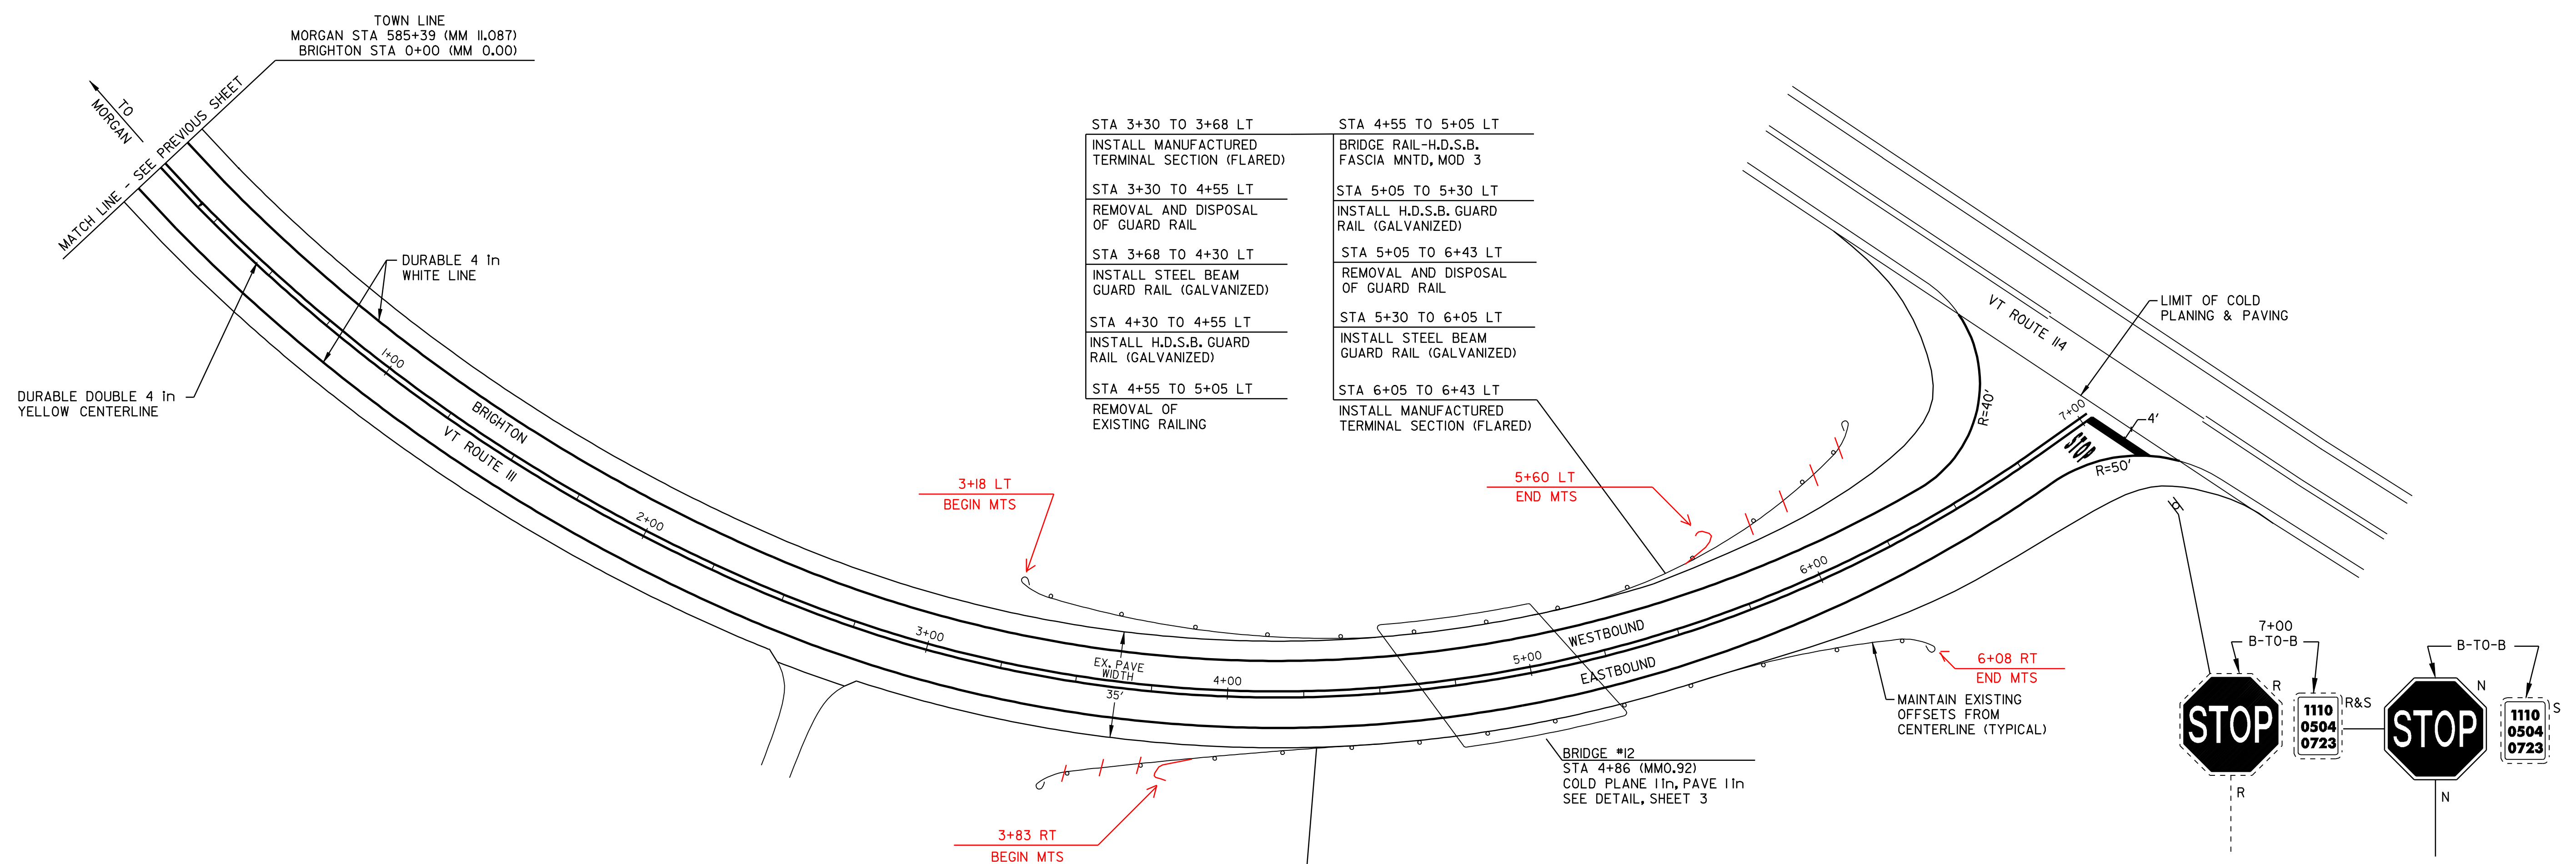

STA 3+30 TO 3+68 LT INSTALL MANUFACTURED TERMINAL SECTION (FLARED)	STA 4+55 TO 5+05 LT BRIDGE RAIL-H.D.S.B. FASCIA MNTD, MOD 3
STA 3+30 TO 4+55 LT REMOVAL AND DISPOSAL OF GUARD RAIL	STA 5+05 TO 5+30 LT INSTALL H.D.S.B. GUARD RAIL (GALVANIZED)
STA 3+68 TO 4+30 LT INSTALL STEEL BEAM GUARD RAIL (GALVANIZED)	STA 5+05 TO 6+43 LT REMOVAL AND DISPOSAL OF GUARD RAIL
STA 4+30 TO 4+55 LT INSTALL H.D.S.B. GUARD RAIL (GALVANIZED)	STA 5+30 TO 6+05 LT INSTALL STEEL BEAM GUARD RAIL (GALVANIZED)
STA 4+55 TO 5+05 LT REMOVAL OF EXISTING RAILING	STA 6+05 TO 6+43 LT INSTALL MANUFACTURED TERMINAL SECTION (FLARED)

STA 3+26 TO 3+64 RT INSTALL MANUFACTURED TERMINAL SECTION (FLARED)	STA 4+76 TO 5+26 RT BRIDGE RAIL-H.D.S.B. FASCIA MNTD, MOD 3
STA 3+26 TO 4+76 RT REMOVAL AND DISPOSAL OF GUARD RAIL	STA 5+26 TO 5+51 RT INSTALL H.D.S.B. GUARD RAIL (GALVANIZED)
STA 3+64 TO 4+51 RT INSTALL STEEL BEAM GUARD RAIL (GALVANIZED)	STA 5+26 TO 6+51 RT REMOVAL AND DISPOSAL OF GUARD RAIL
STA 4+51 TO 4+76 RT INSTALL H.D.S.B. GUARD RAIL (GALVANIZED)	STA 5+51 TO 6+14 RT INSTALL STEEL BEAM GUARD RAIL (GALVANIZED)
STA 4+76 TO 5+26 RT REMOVAL OF EXISTING RAILING	STA 6+14 TO 6+51 RT INSTALL MANUFACTURED TERMINAL SECTION (FLARED)

- LEGEND**
- N = NEW
  - R = REMOVE
  - R&S = REMOVE & SALVAGE
  - S = SALVAGE
  - RET = RETAIN
  - B-TO-B = BACK TO BACK
  - ⊕ ⊞ ⊠ CATCH BASIN/DI
  - ⊙ ⊞ EXISTING THROAT DI
  - I MARKER POST
  - ⊗ UTILITY POLE
  - ⊗ UTIL. POLE W/UNDERGROUND UTIL.
  - ⊗ DRIVE

## PAVING PROJECT LAYOUT SHEET #10

DESIGNED BY	BCE/PJM	DATE	8-05
DRAWN BY	C.E.A., INC.	DATE	8-05
DESIGN FILE NO.	/pave/04c036/p04c036.dgn		
PRF FILE	p04c036i10.1	DATE PLOTTED	II-JUN-2007 14:45
PROJ. NAME	<b>MORGAN - BRIGHTON</b>		
PROJ. NO.	<b>STP 2404(1)S</b>		
SHEET	17	OF	26 SHEETS