


ADJUST ELEVATION OF VALVE BOX

- STA. 31+37 RT (WSO)
- STA. 31+55 RT (WSO)
- STA. 31+60 RT (WSO)
- STA. 31+65 RT (WSO)
- STA. 32+34 RT (WSO)
- STA. 35+33 RT (WSO)
- STA. 39+73 LT (WSO)

CHANGING ELEVATION OF SEWER MANHOLE

- STA. 31+85 RT (T-23)
- STA. 36+87 LT (IN PAVED APRON)

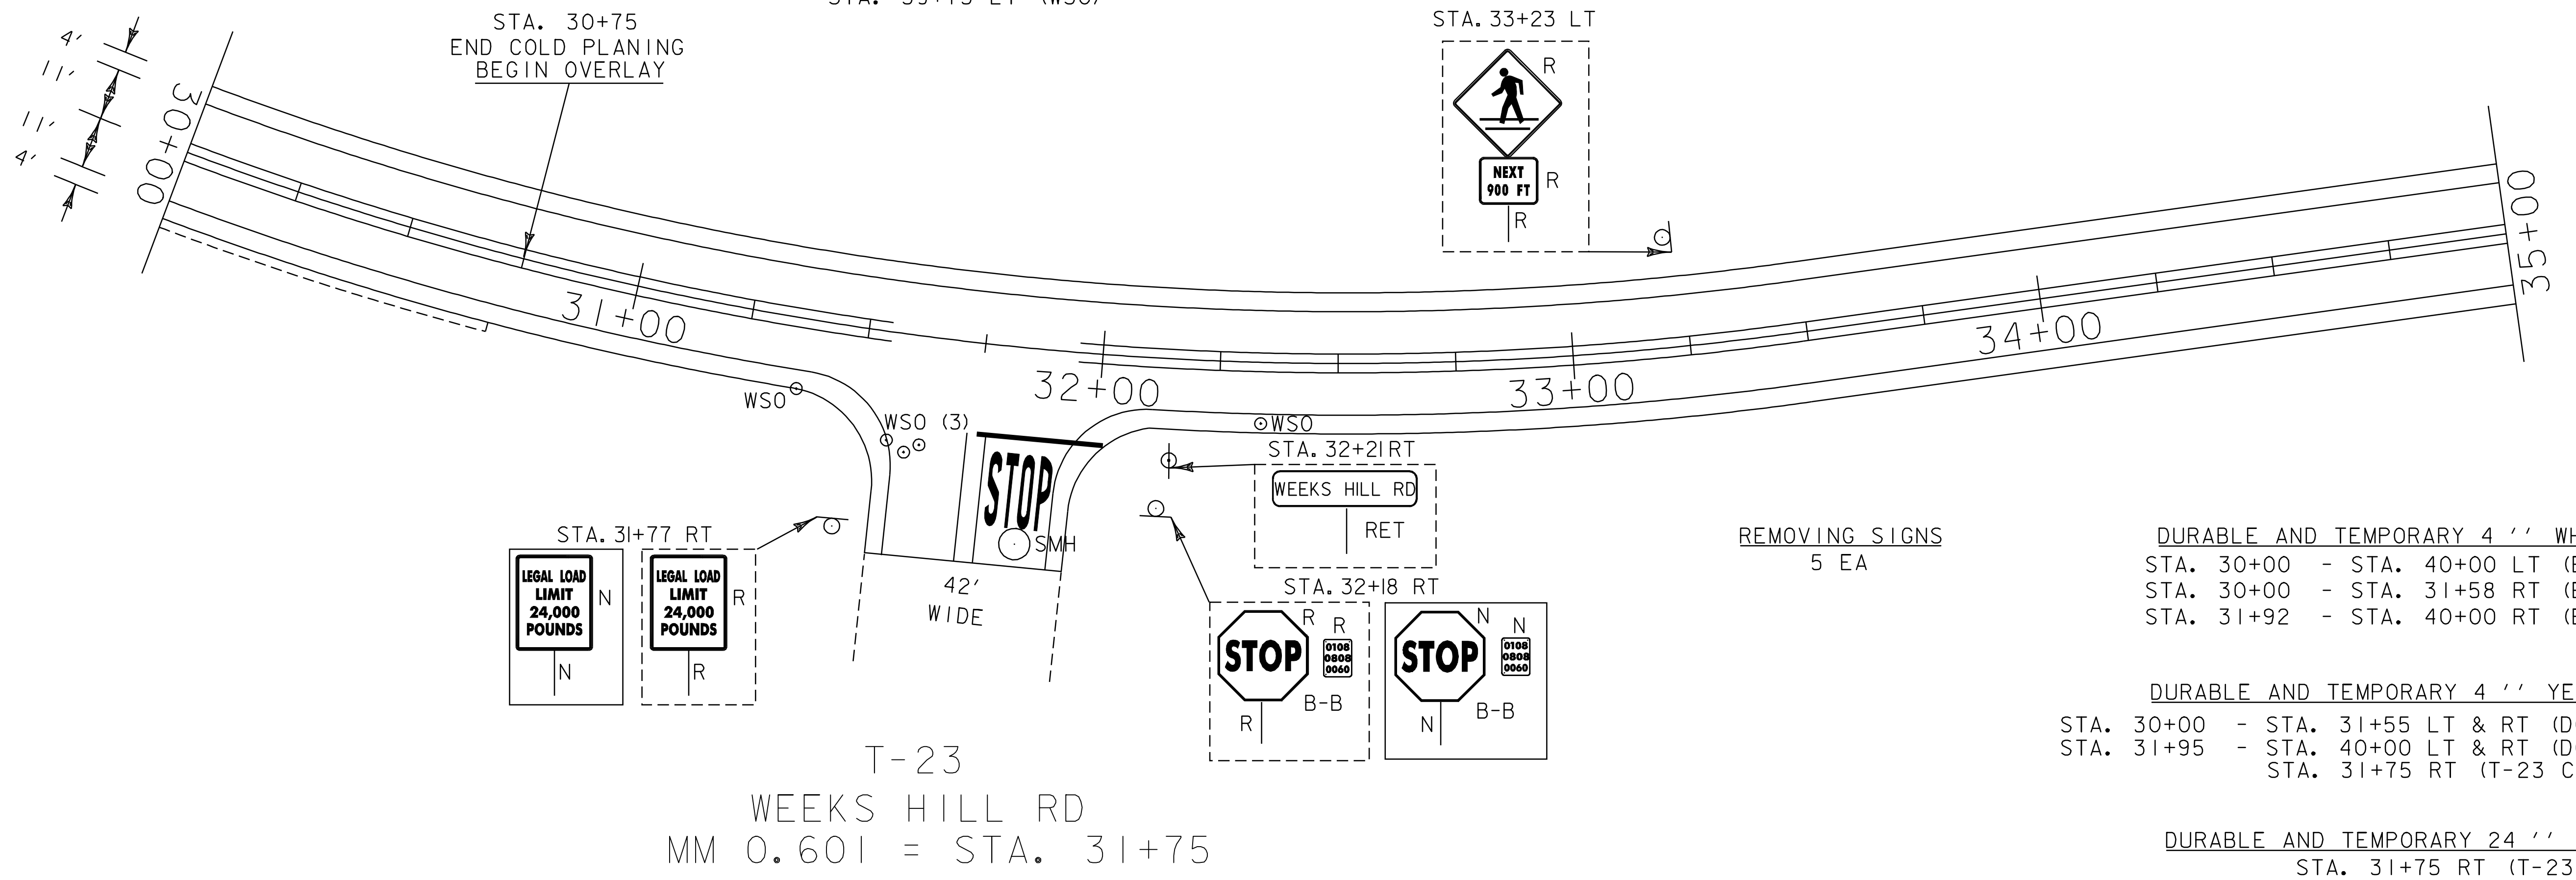


DURABLE AND TEMPORARY 4'' WHITE LINE
 STA. 30+00 - STA. 40+00 LT (EDGE LINE)
 STA. 30+00 - STA. 31+58 RT (EDGE LINE)
 STA. 31+92 - STA. 40+00 RT (EDGE LINE)

DURABLE AND TEMPORARY 4'' YELLOW LINE
 STA. 30+00 - STA. 31+55 LT & RT (DOUBLE YELLOW CL)
 STA. 31+95 - STA. 40+00 LT & RT (DOUBLE YELLOW CL)
 STA. 31+75 RT (T-23 CL)

DURABLE AND TEMPORARY 24'' STOP BAR
 STA. 31+75 RT (T-23)

DURABLE AND TEMPORARY LETTERS OR SYMBOLS
 STA. 31+75 RT (T-23) STOP

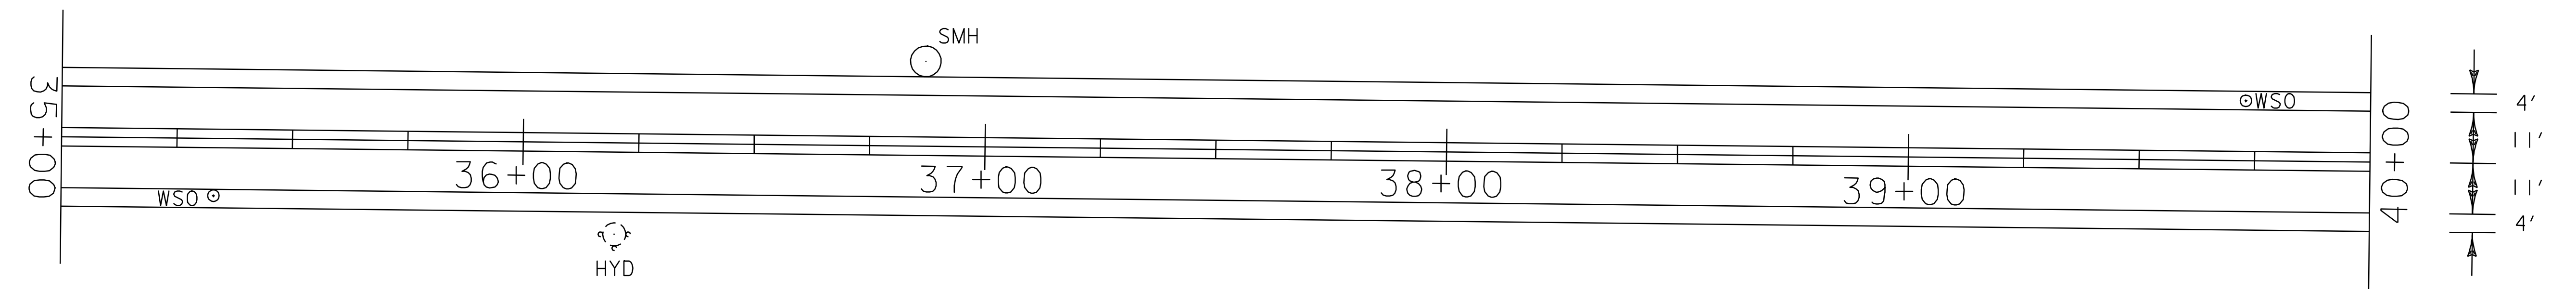

**PAVING
PROJECT
LAYOUT
#5**

PROJECT NAME: STOWE
 PROJECT NUMBER: AC STP 2407(I)S
 FILE NAME: p04c048.dgn
 PROJECT LEADER: WOOLLAVER
 DESIGNED BY: LOCKE
 p04c048i05.1
 PLOT DATE: 11-JUN-2007 13:44
 DRAWN BY: LOCKE
 CHECKED BY: PAVT MGMT
 SHEET 14 OF 69