

DURABLE AND TEMPORARY 4'' WHITE LINE
 STA. 120+00 - STA. 130+00 LT & RT (EDGE LINE)


DURABLE AND TEMPORARY 4'' YELLOW LINE
 STA. 120+00 - STA. 130+00 LT & RT (DOUBLE YELLOW CL)

CHANGING ELEVATION OF SEWER MANHOLE
 STA. 122+79 LT (IN PAVED APRON)

REMOVAL AND DISPOSAL OF GUARD RAIL
 STA. 127+77 - STA. 130+00 LT

STEEL BEAM GUARD RAIL (GALVANIZED)
 STA. 127+77 - STA. 130+00 LT

ANCHOR FOR STEEL BEAM GUARD RAIL
 STA. 127+89 LT

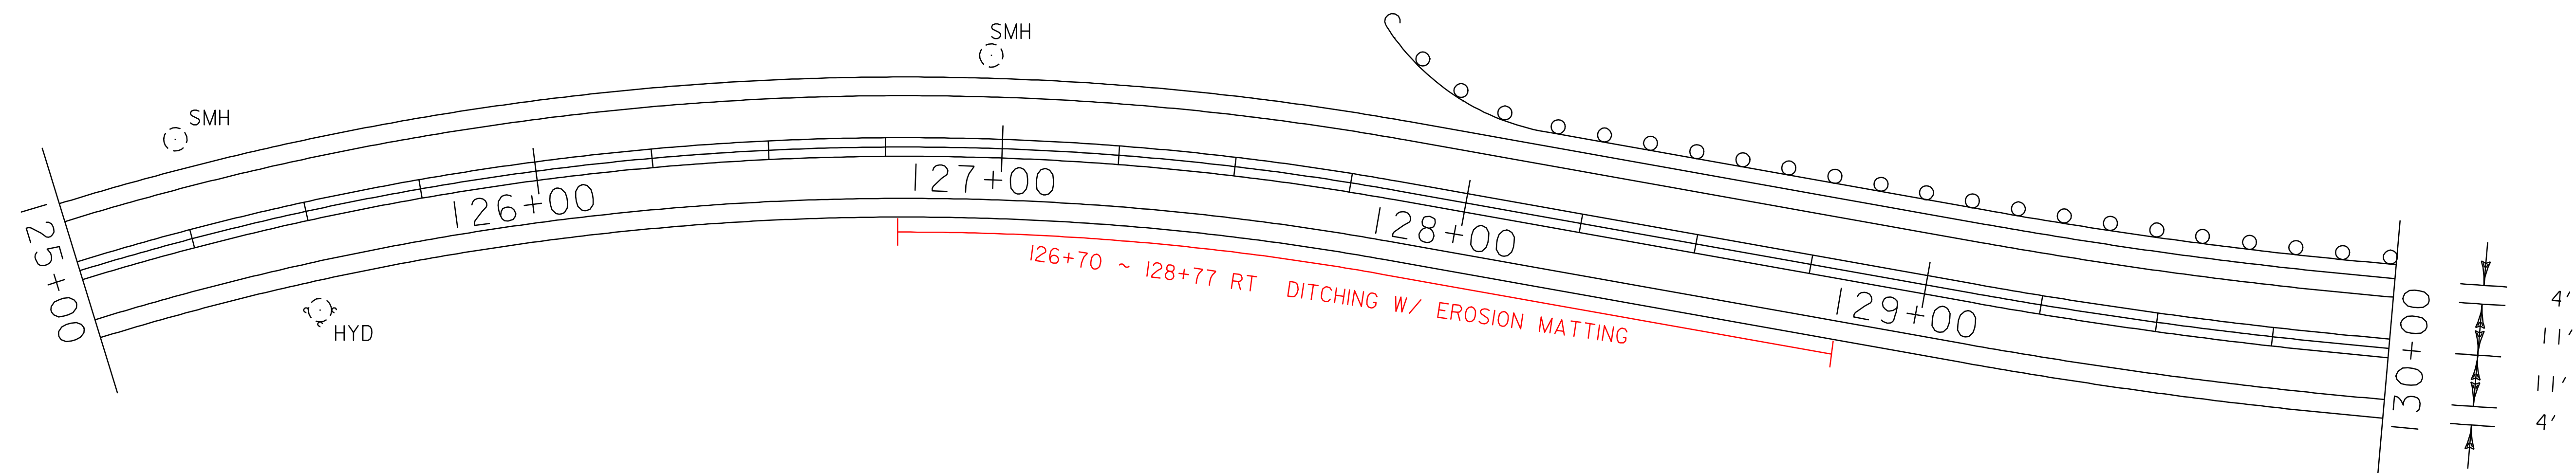

**PAVING
 PROJECT
 LAYOUT
 #14**

PROJECT NAME: STOWE
 PROJECT NUMBER: AC STP 2407(I)S

FILE NAME: p04c048.dgn
 PROJECT LEADER: WOOLAVER
 DESIGNED BY: LOCKE
 p04c048i14.i

PLOT DATE: 11-JUN-2007 13:44
 DRAWN BY: LOCKE
 CHECKED BY: PAVT MGMT
 SHEET 23 OF 69