


DURABLE AND TEMPORARY 4'' WHITE LINE
 STA. 140+00 - STA. 150+00 LT & RT (EDGE LINE)

DURABLE AND TEMPORARY 4'' YELLOW LINE
 STA. 140+00 - STA. 150+00 LT & RT (DOUBLE YELLOW CL)

REMOVAL AND DISPOSAL OF GUARD RAIL
 STA. 146+09 - STA. 150+00 LT

STEEL BEAM GUARD RAIL (GALVANIZED)
 STA. 146+09 - STA. 150+00 LT

ANCHOR FOR STEEL BEAM GUARD RAIL
 STA. 146+21 LT

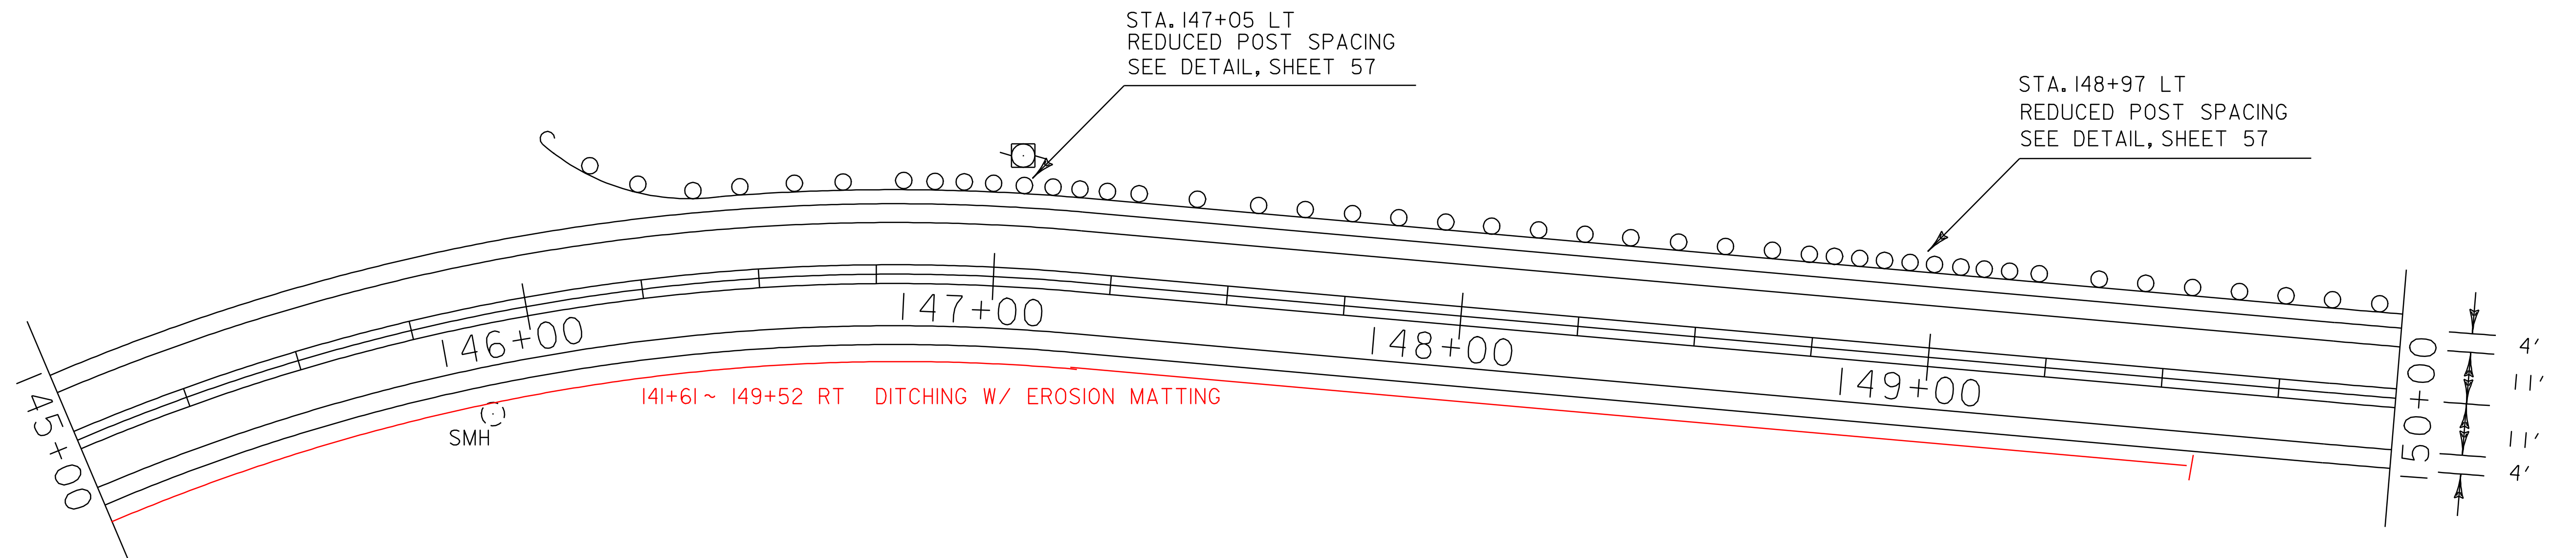

**PAVING
 PROJECT
 LAYOUT
 #16**

PROJECT NAME: STOWE
 PROJECT NUMBER: AC STP 2407(1)S

FILE NAME: p04c048.dgn
 PROJECT LEADER: WOOLAVER
 DESIGNED BY: LOCKE
 p04c048116.1

PLOT DATE: 11-JUN-2007 13:44
 DRAWN BY: LOCKE
 CHECKED BY: PAVT MGMT
 SHEET 25 OF 69